





AS-BUILT DRAWING OF FRONT ELEVATION 1/4"=1'-0"



AS-BUILT DRAWING OF RIGHT SIDE ELEVATION 1/8"=1'-0"

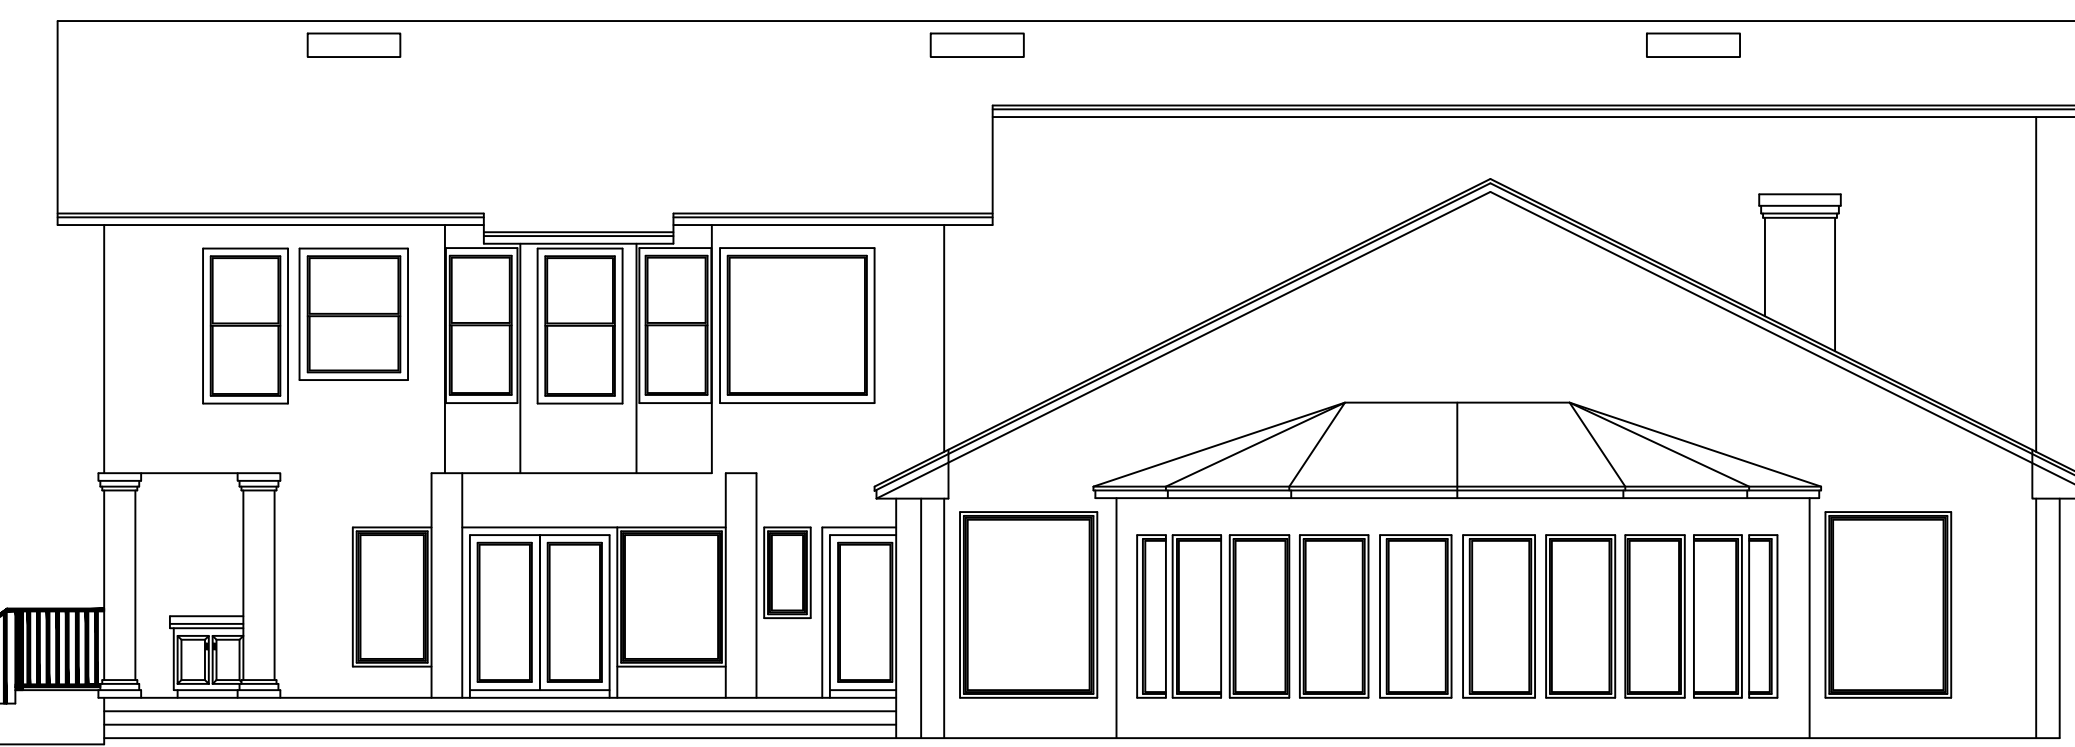

AS-BUILT DRAWING OF REAR ELEVATION 1/8"=1'-0"

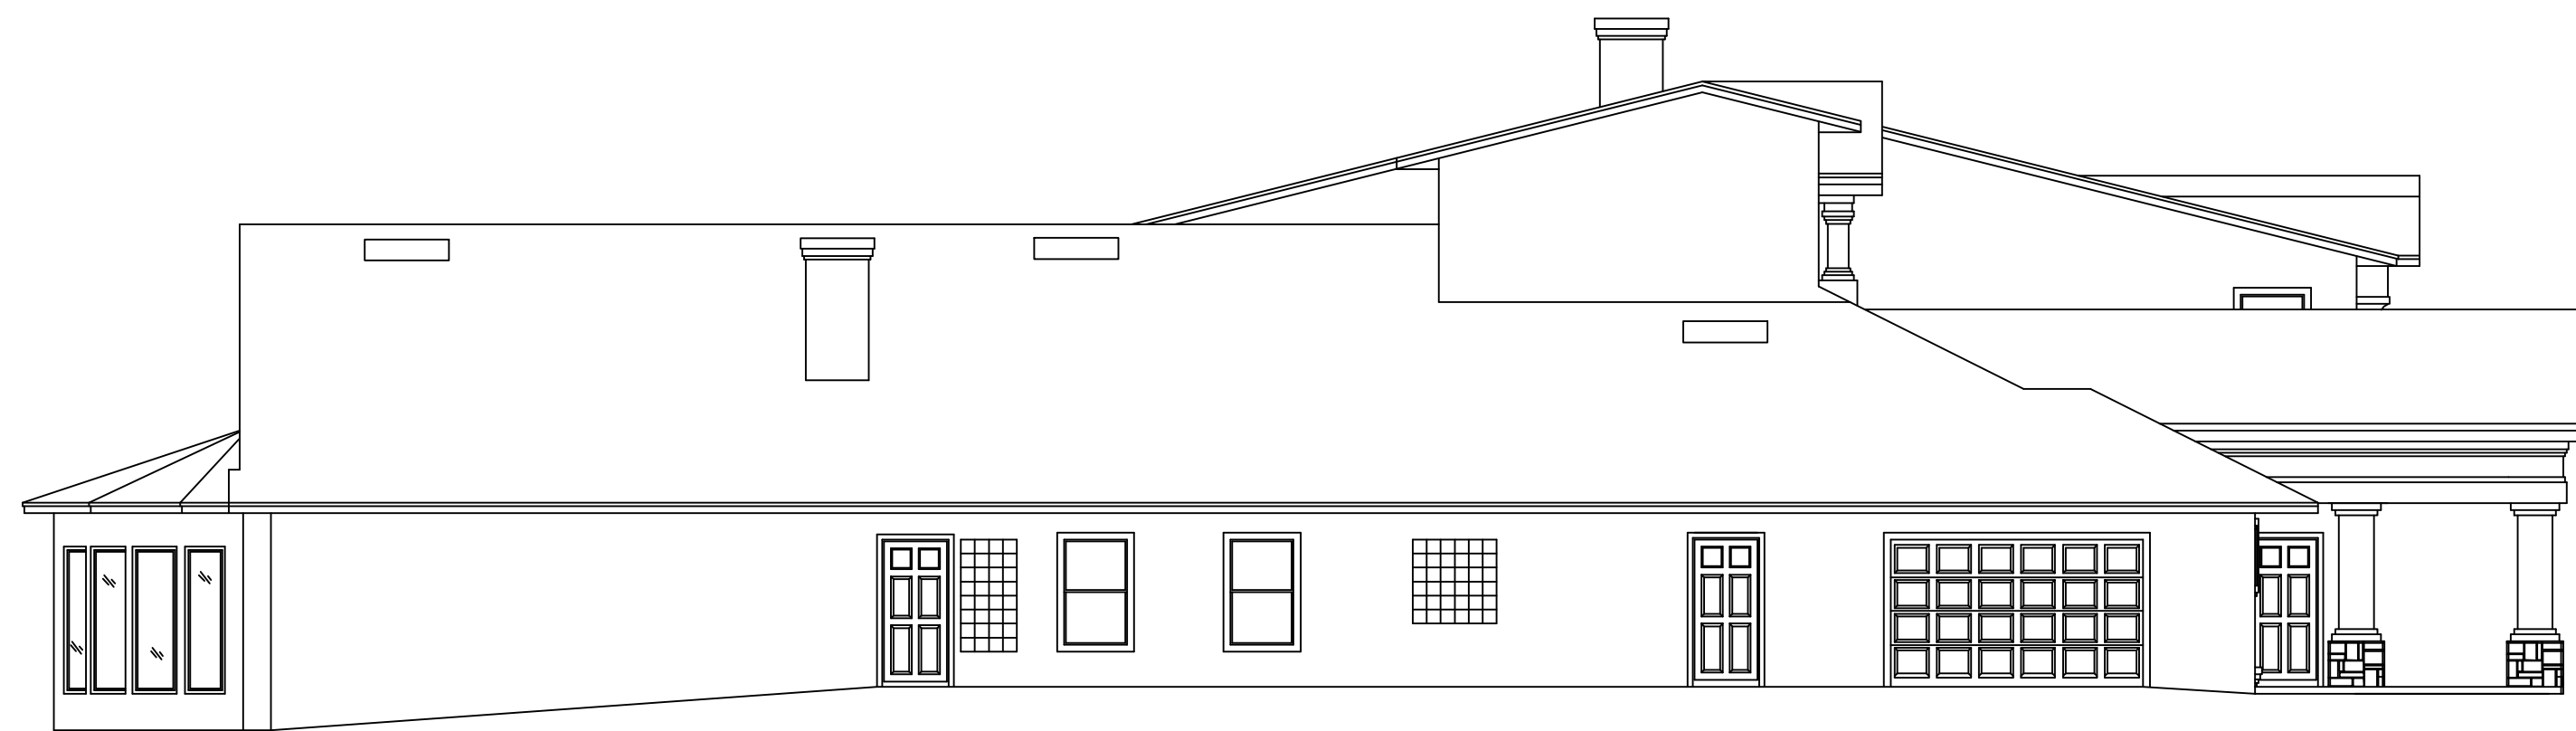

AS-BUILT DRAWING OF LEFT SIDE ELEVATION 1/8"=1'-0"


AS-BUILT SERVICES BY:  
ASBUILT PROFESSIONALS  
A SERVICE OF A.E.C. CONSULTANTS INC.  
WWW.ASBUILTPROFESSIONALS.COM  
866-903-8842  
TX, USA

AS-BUILT DRAWINGS: CLIENT NAME  
AS-BUILT LOCATION: FLORIDA

JOB NO.  
000-00-00

SHEET  
AB-1 of AB-1

AS-BUILT AREA DATA	
LIVING 1st FLOOR	5,801 S.F. ±
LIVING 2nd FLOOR	2,293 S.F. ±
LIVING TOTAL	8,094 S.F. ±
GARAGE	514 S.F. ±
ENTRY	363 S.F. ±
STORAGE	392 S.F. ±
LANAI	420 S.F. ±
GRAND TOTAL	9,783 S.F. ±

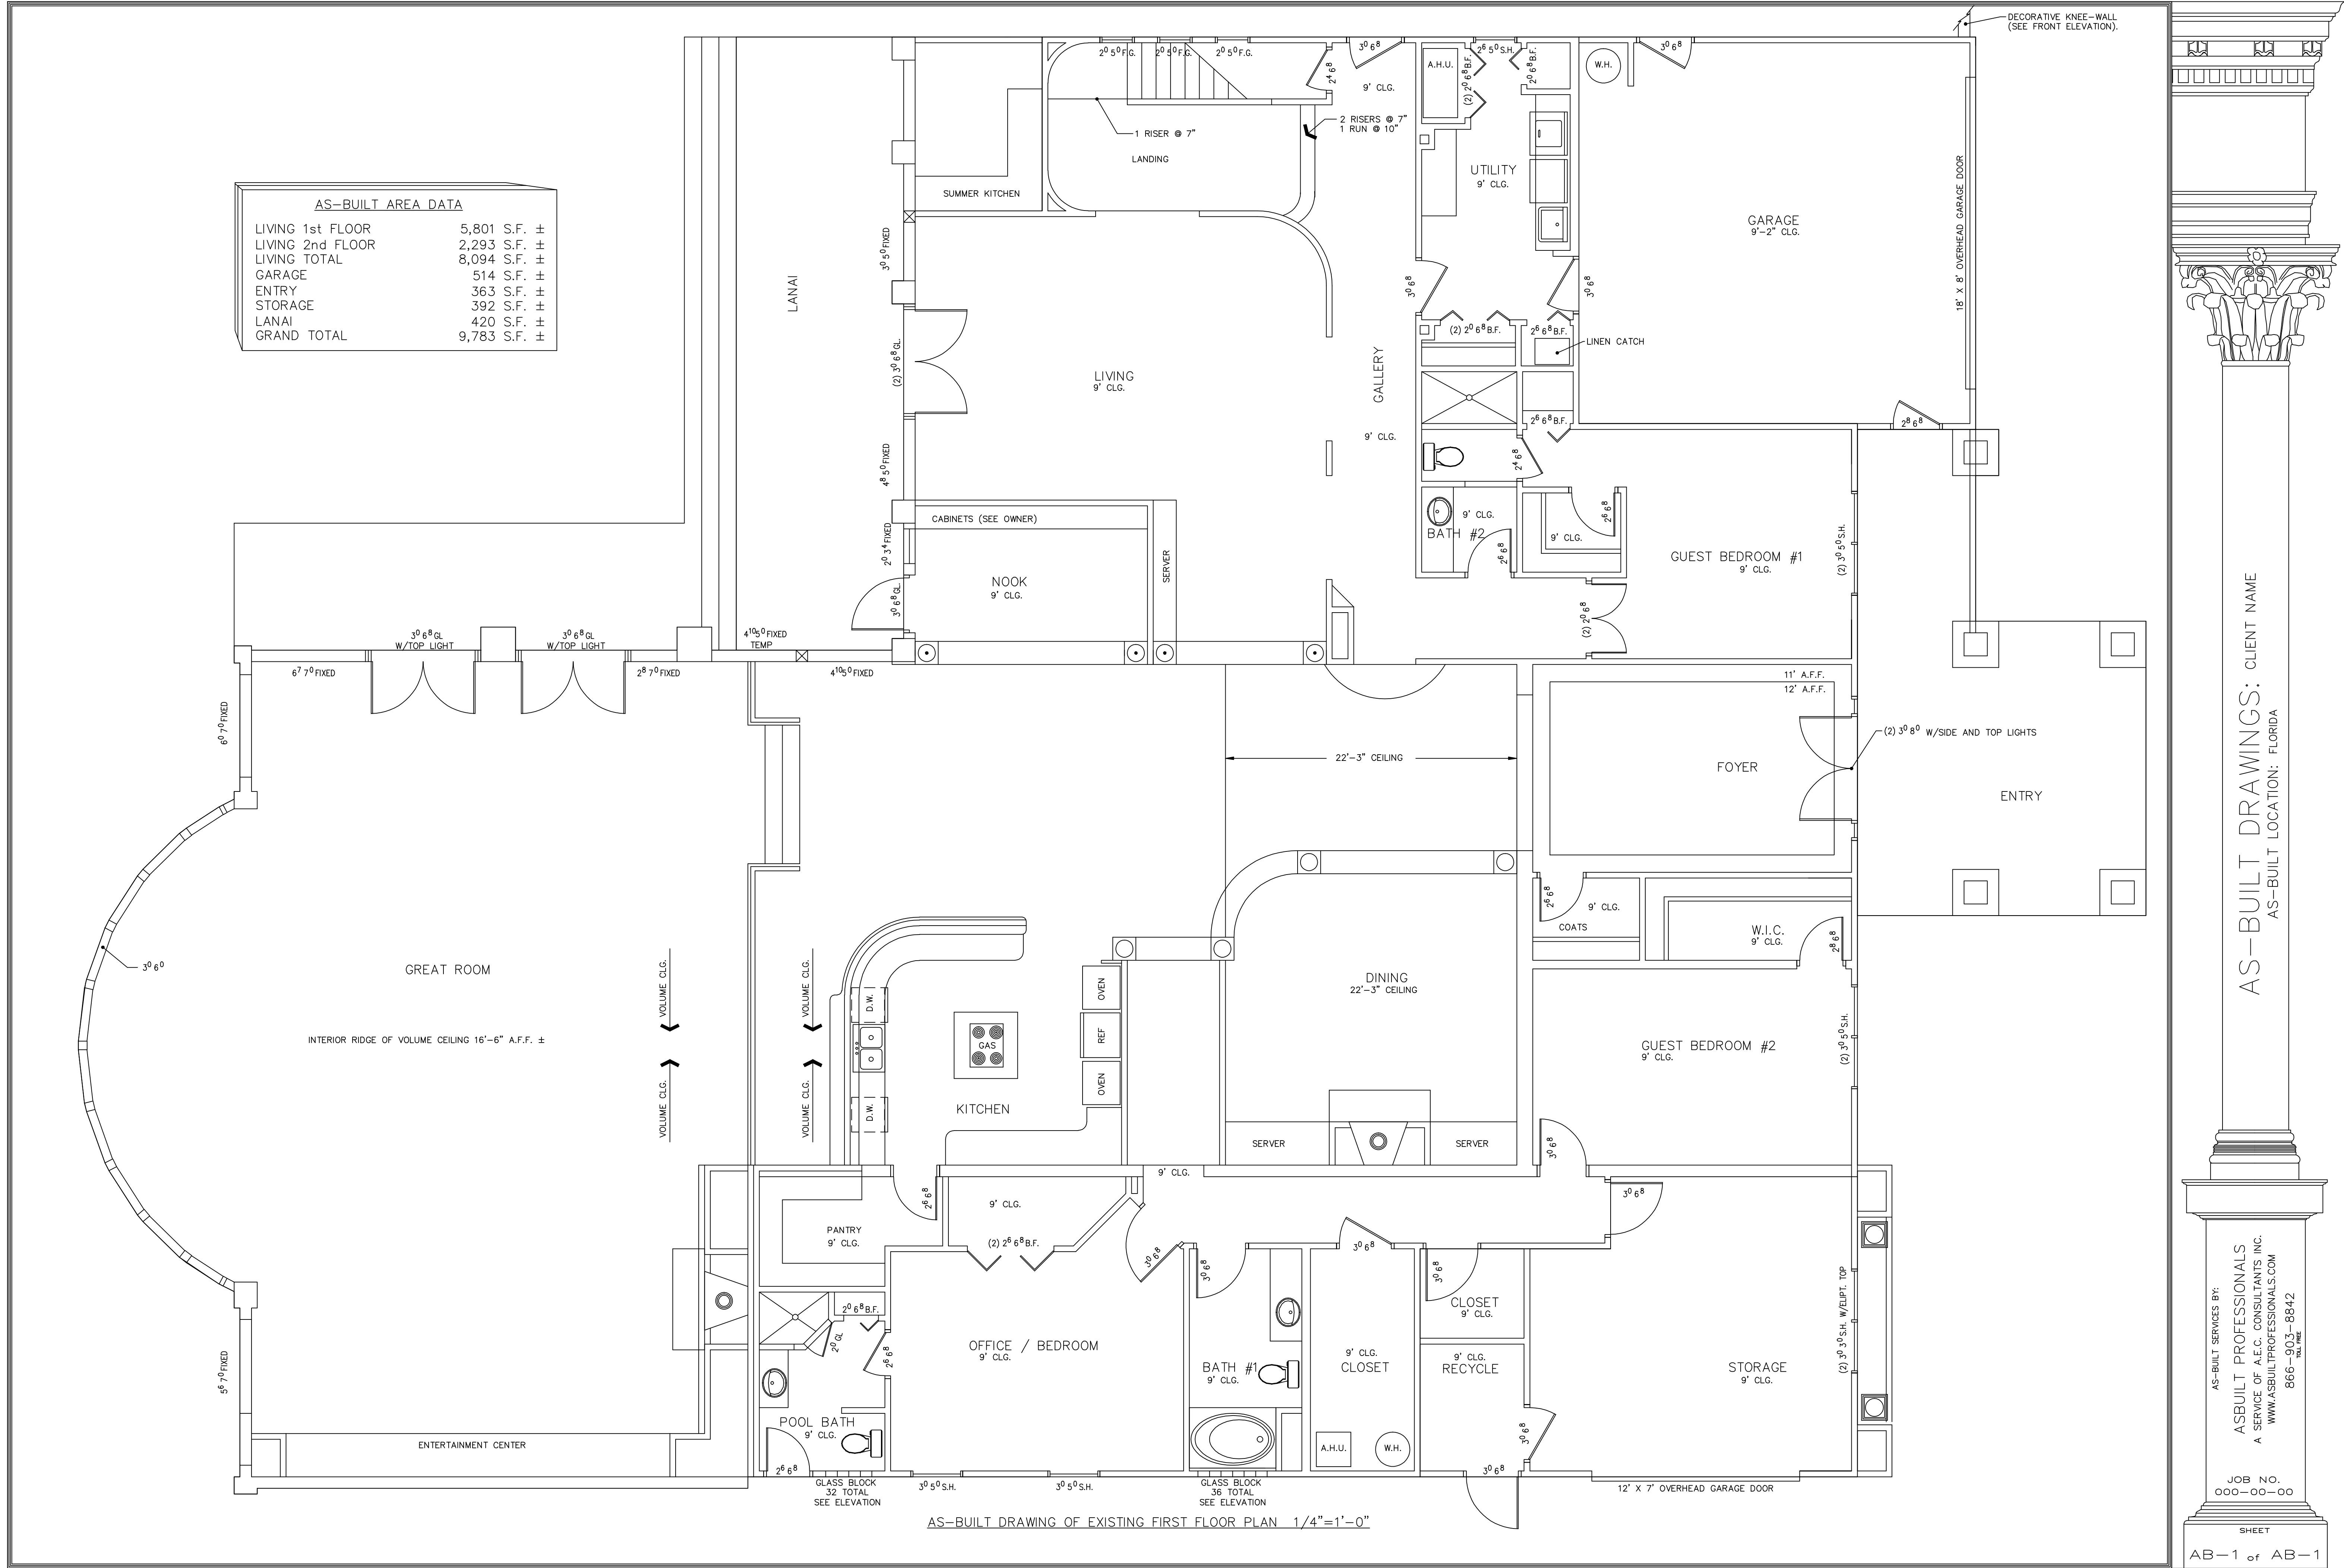


AS-BUILT DRAWING OF EXISTING FIRST FLOOR PLAN 1/4"=1'-0"

AS-BUILT SERVICES BY:  
**ASBUILT PROFESSIONALS**  
 A SERVICE OF A.E.C. CONSULTANTS INC.  
 WWW.ASBUILTPROFESSIONALS.COM  
 866-903-8842  
 INFLA, FL

AS-BUILT DRAWINGS: CLIENT NAME  
 AS-BUILT LOCATION: FLORIDA

JOB NO.  
 000-00-00

SHEET  
 AB-1 of AB-1

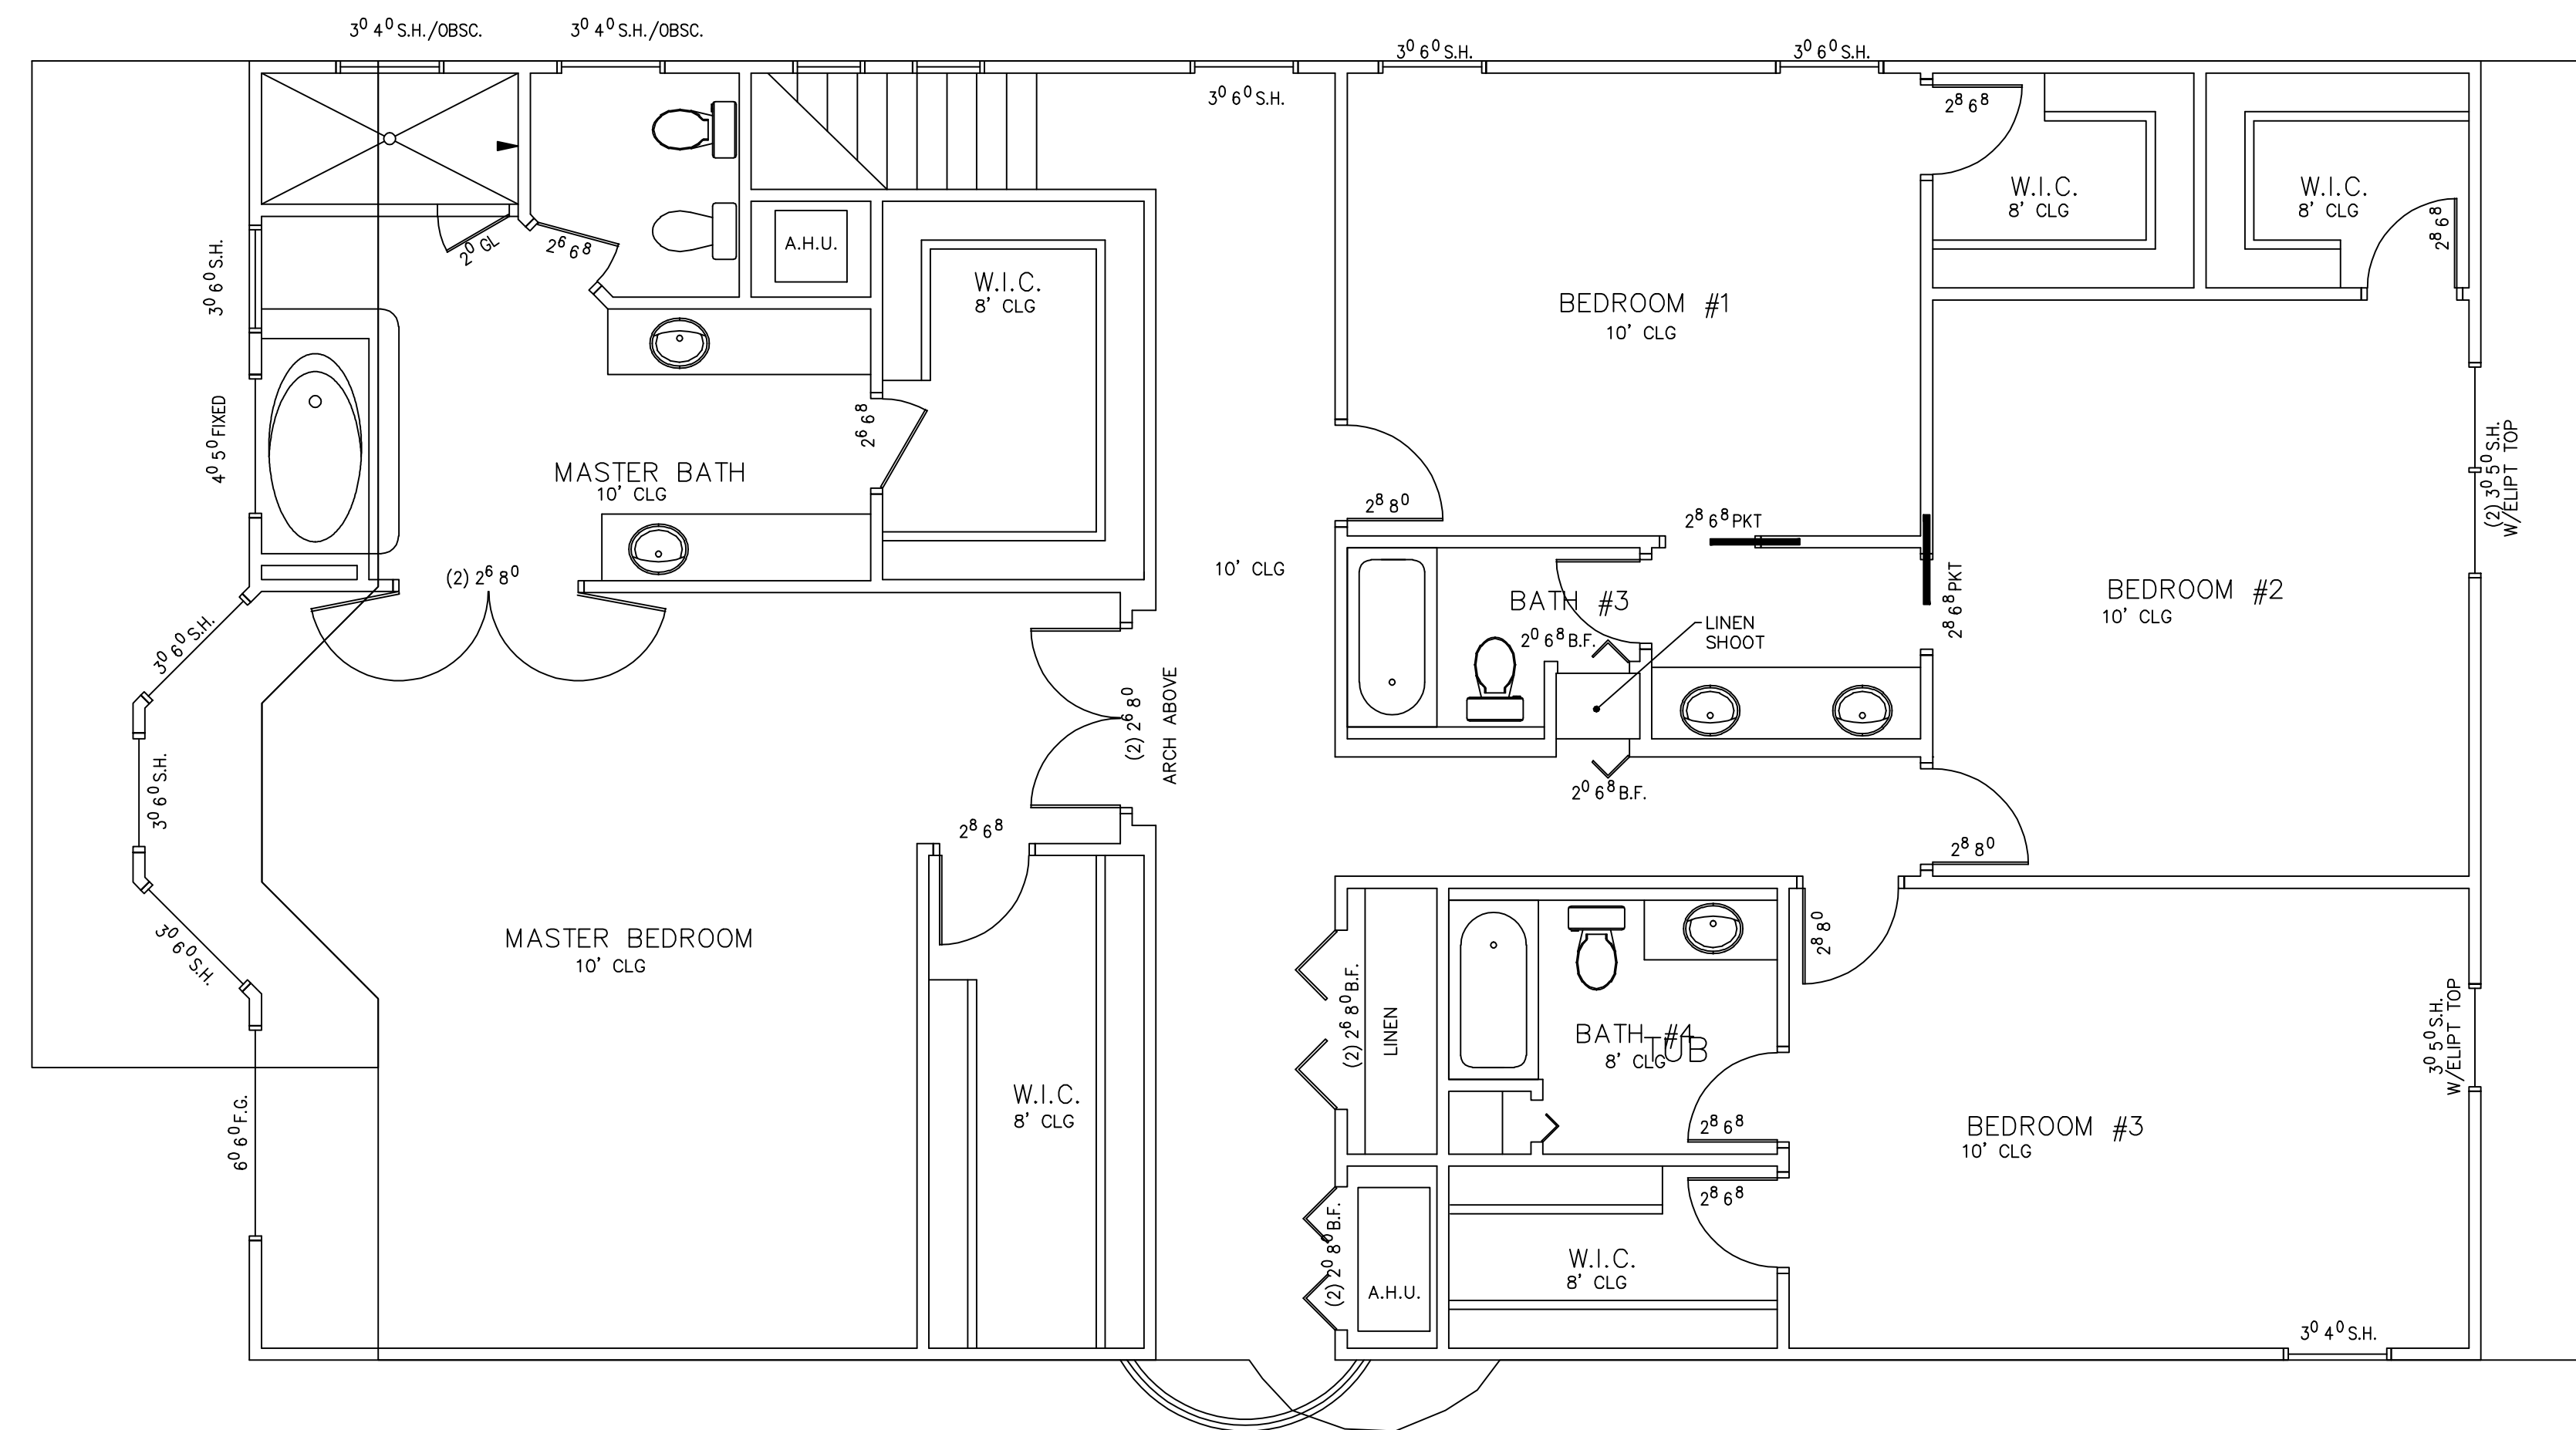


AS-BUILT DRAWING OF EXISTING SECOND FLOOR PLAN 1/4"=1'-0"

AS-BUILT SERVICES BY:  
**ASBUILT PROFESSIONALS**  
A SERVICE OF A.E.C. CONSULTANTS, INC.  
WWW.ASBUILTPROFESSIONALS.COM  
866-903-8842  
IND. REG.

AS-BUILT DRAWINGS: CLIENT NAME  
AS-BUILT LOCATION: FLORIDA

JOB NO.  
000-00-00

SHEET  
AB-1 of AB-1

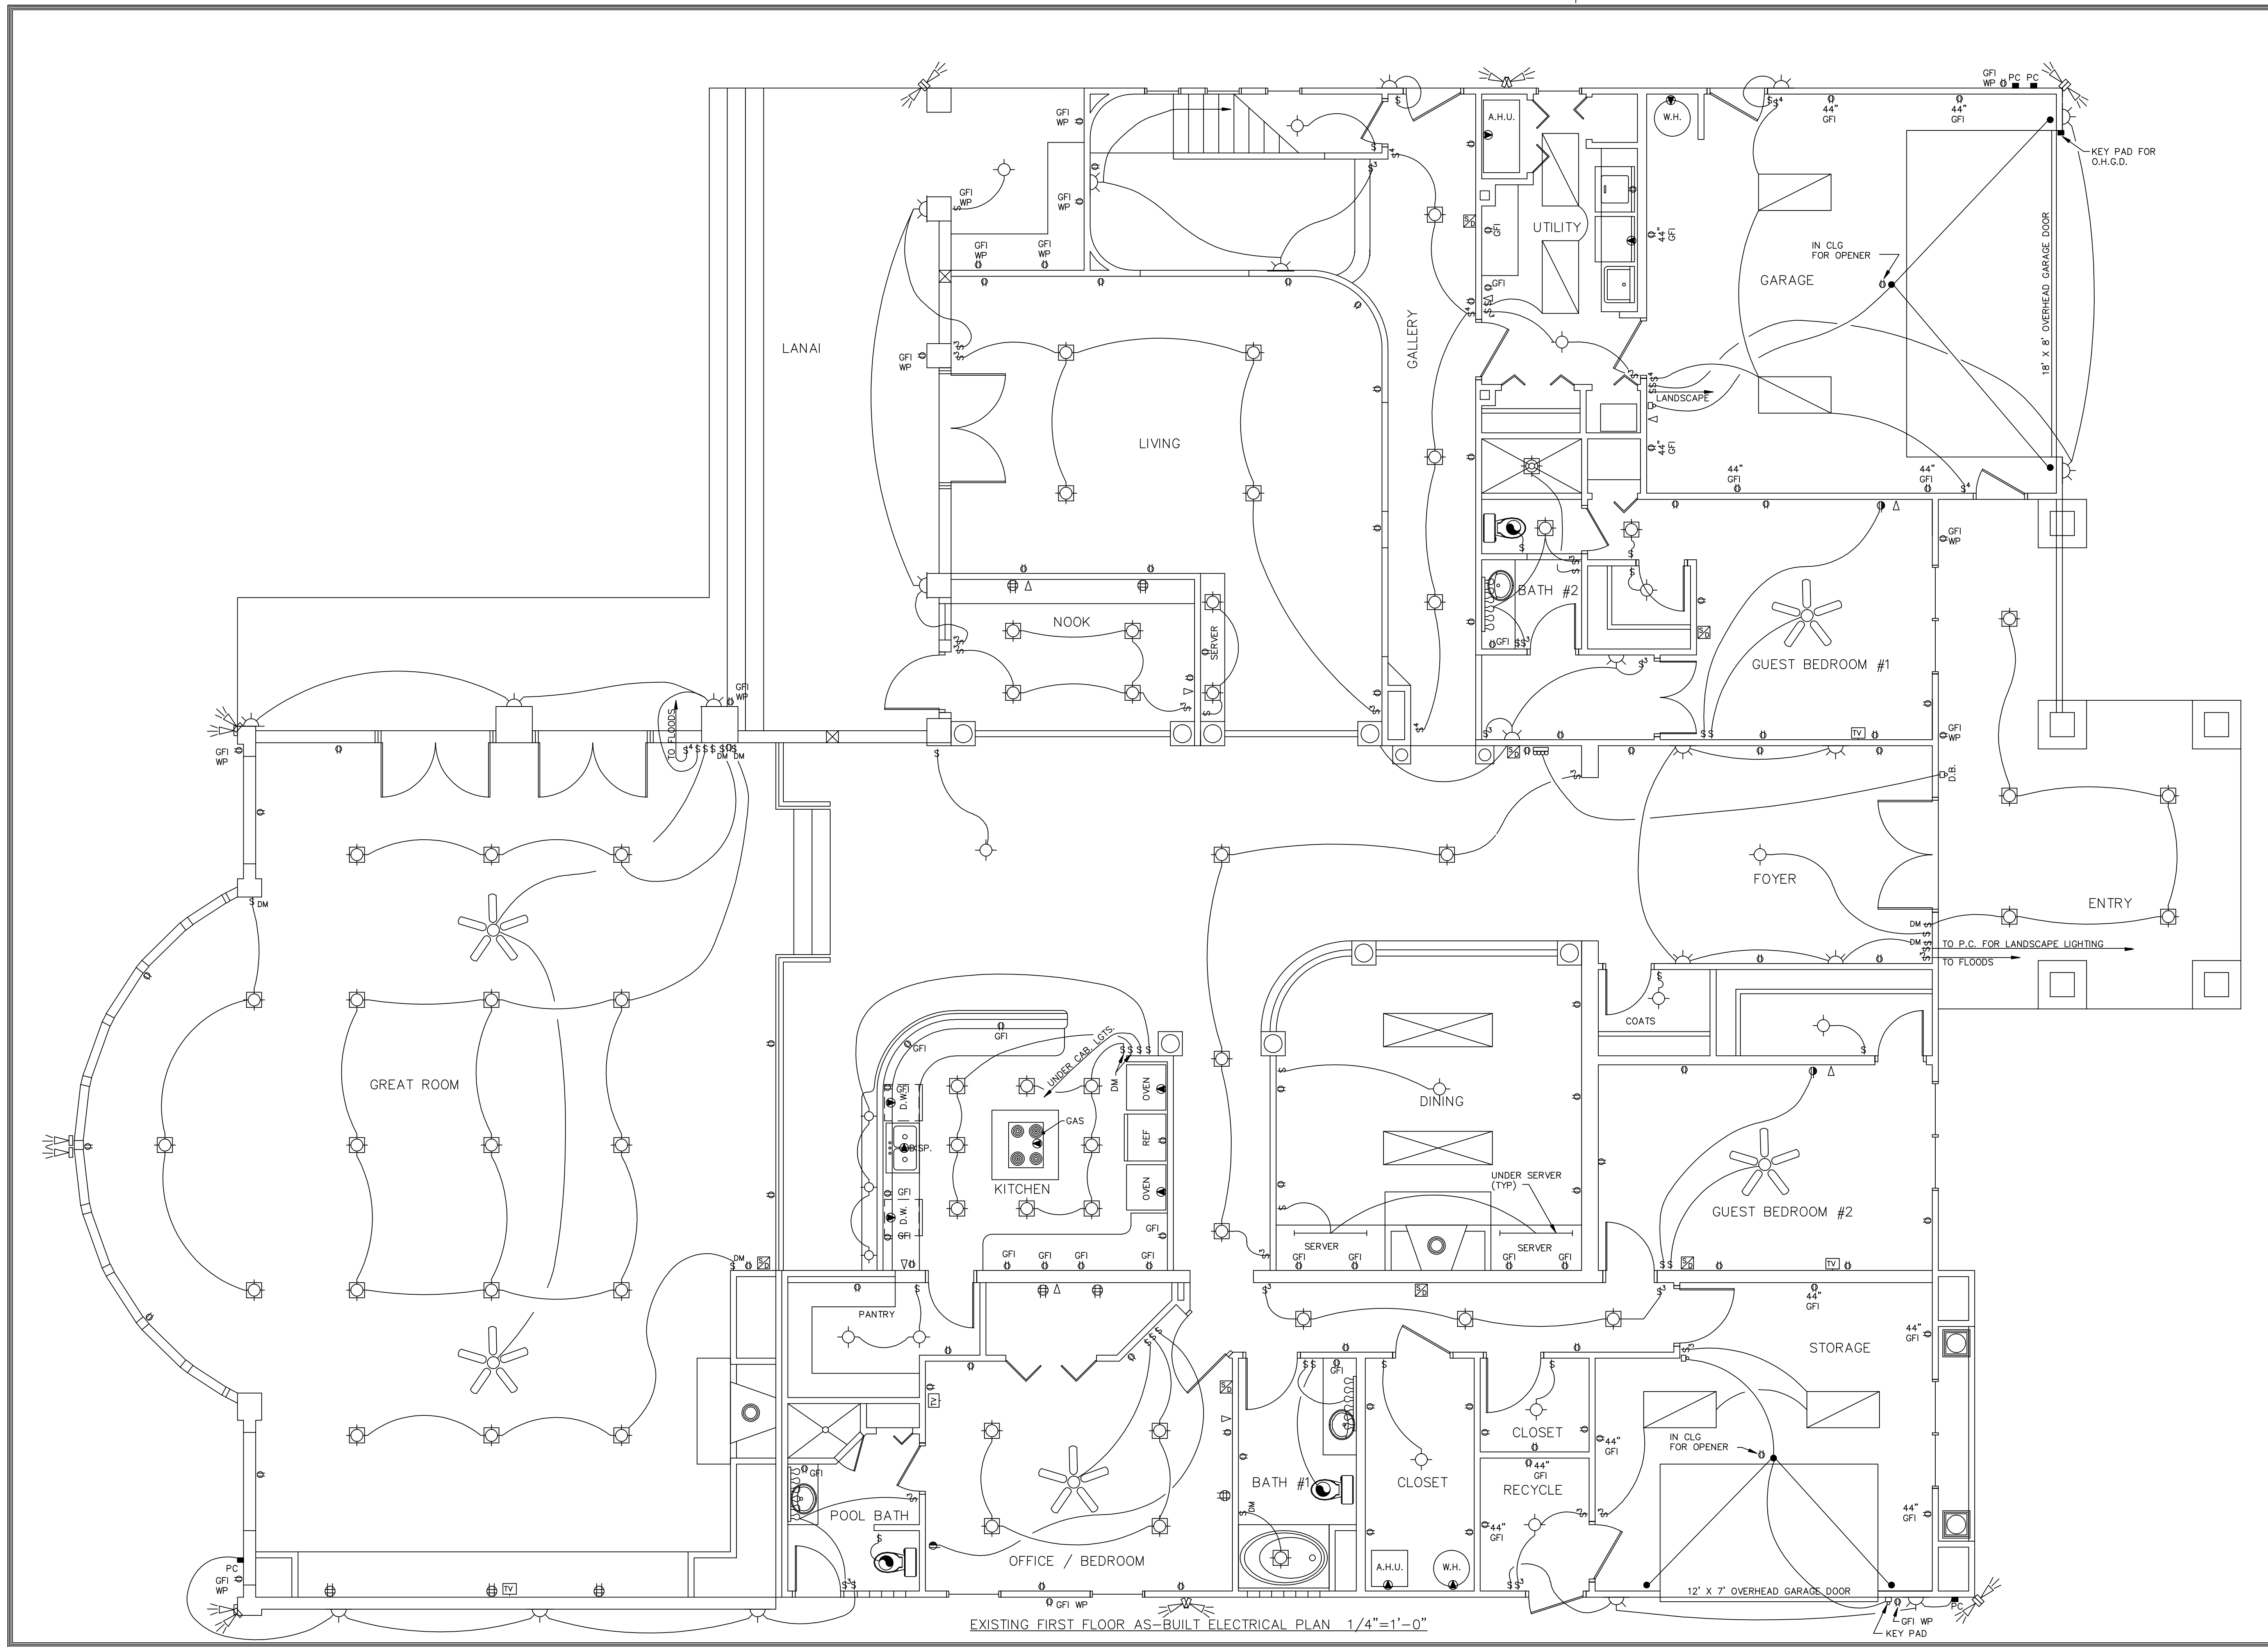


EXISTING FIRST FLOOR AS-BUILT ELECTRICAL PLAN 1/4"=1'-0"

AS-BUILT SERVICES BY:  
**ASBUILT PROFESSIONALS**  
 A SERVICE OF A.E.C. CONSULTANTS INC.  
 WWW.ASBUILTPROFESSIONALS.COM  
 866-903-8842  
 INFL. INC.

AS-BUILT DRAWINGS: CLIENT NAME  
 AS-BUILT LOCATION: FLORIDA

JOB NO.  
 000-00-00

SHEET  
 AB-1 of AB-1

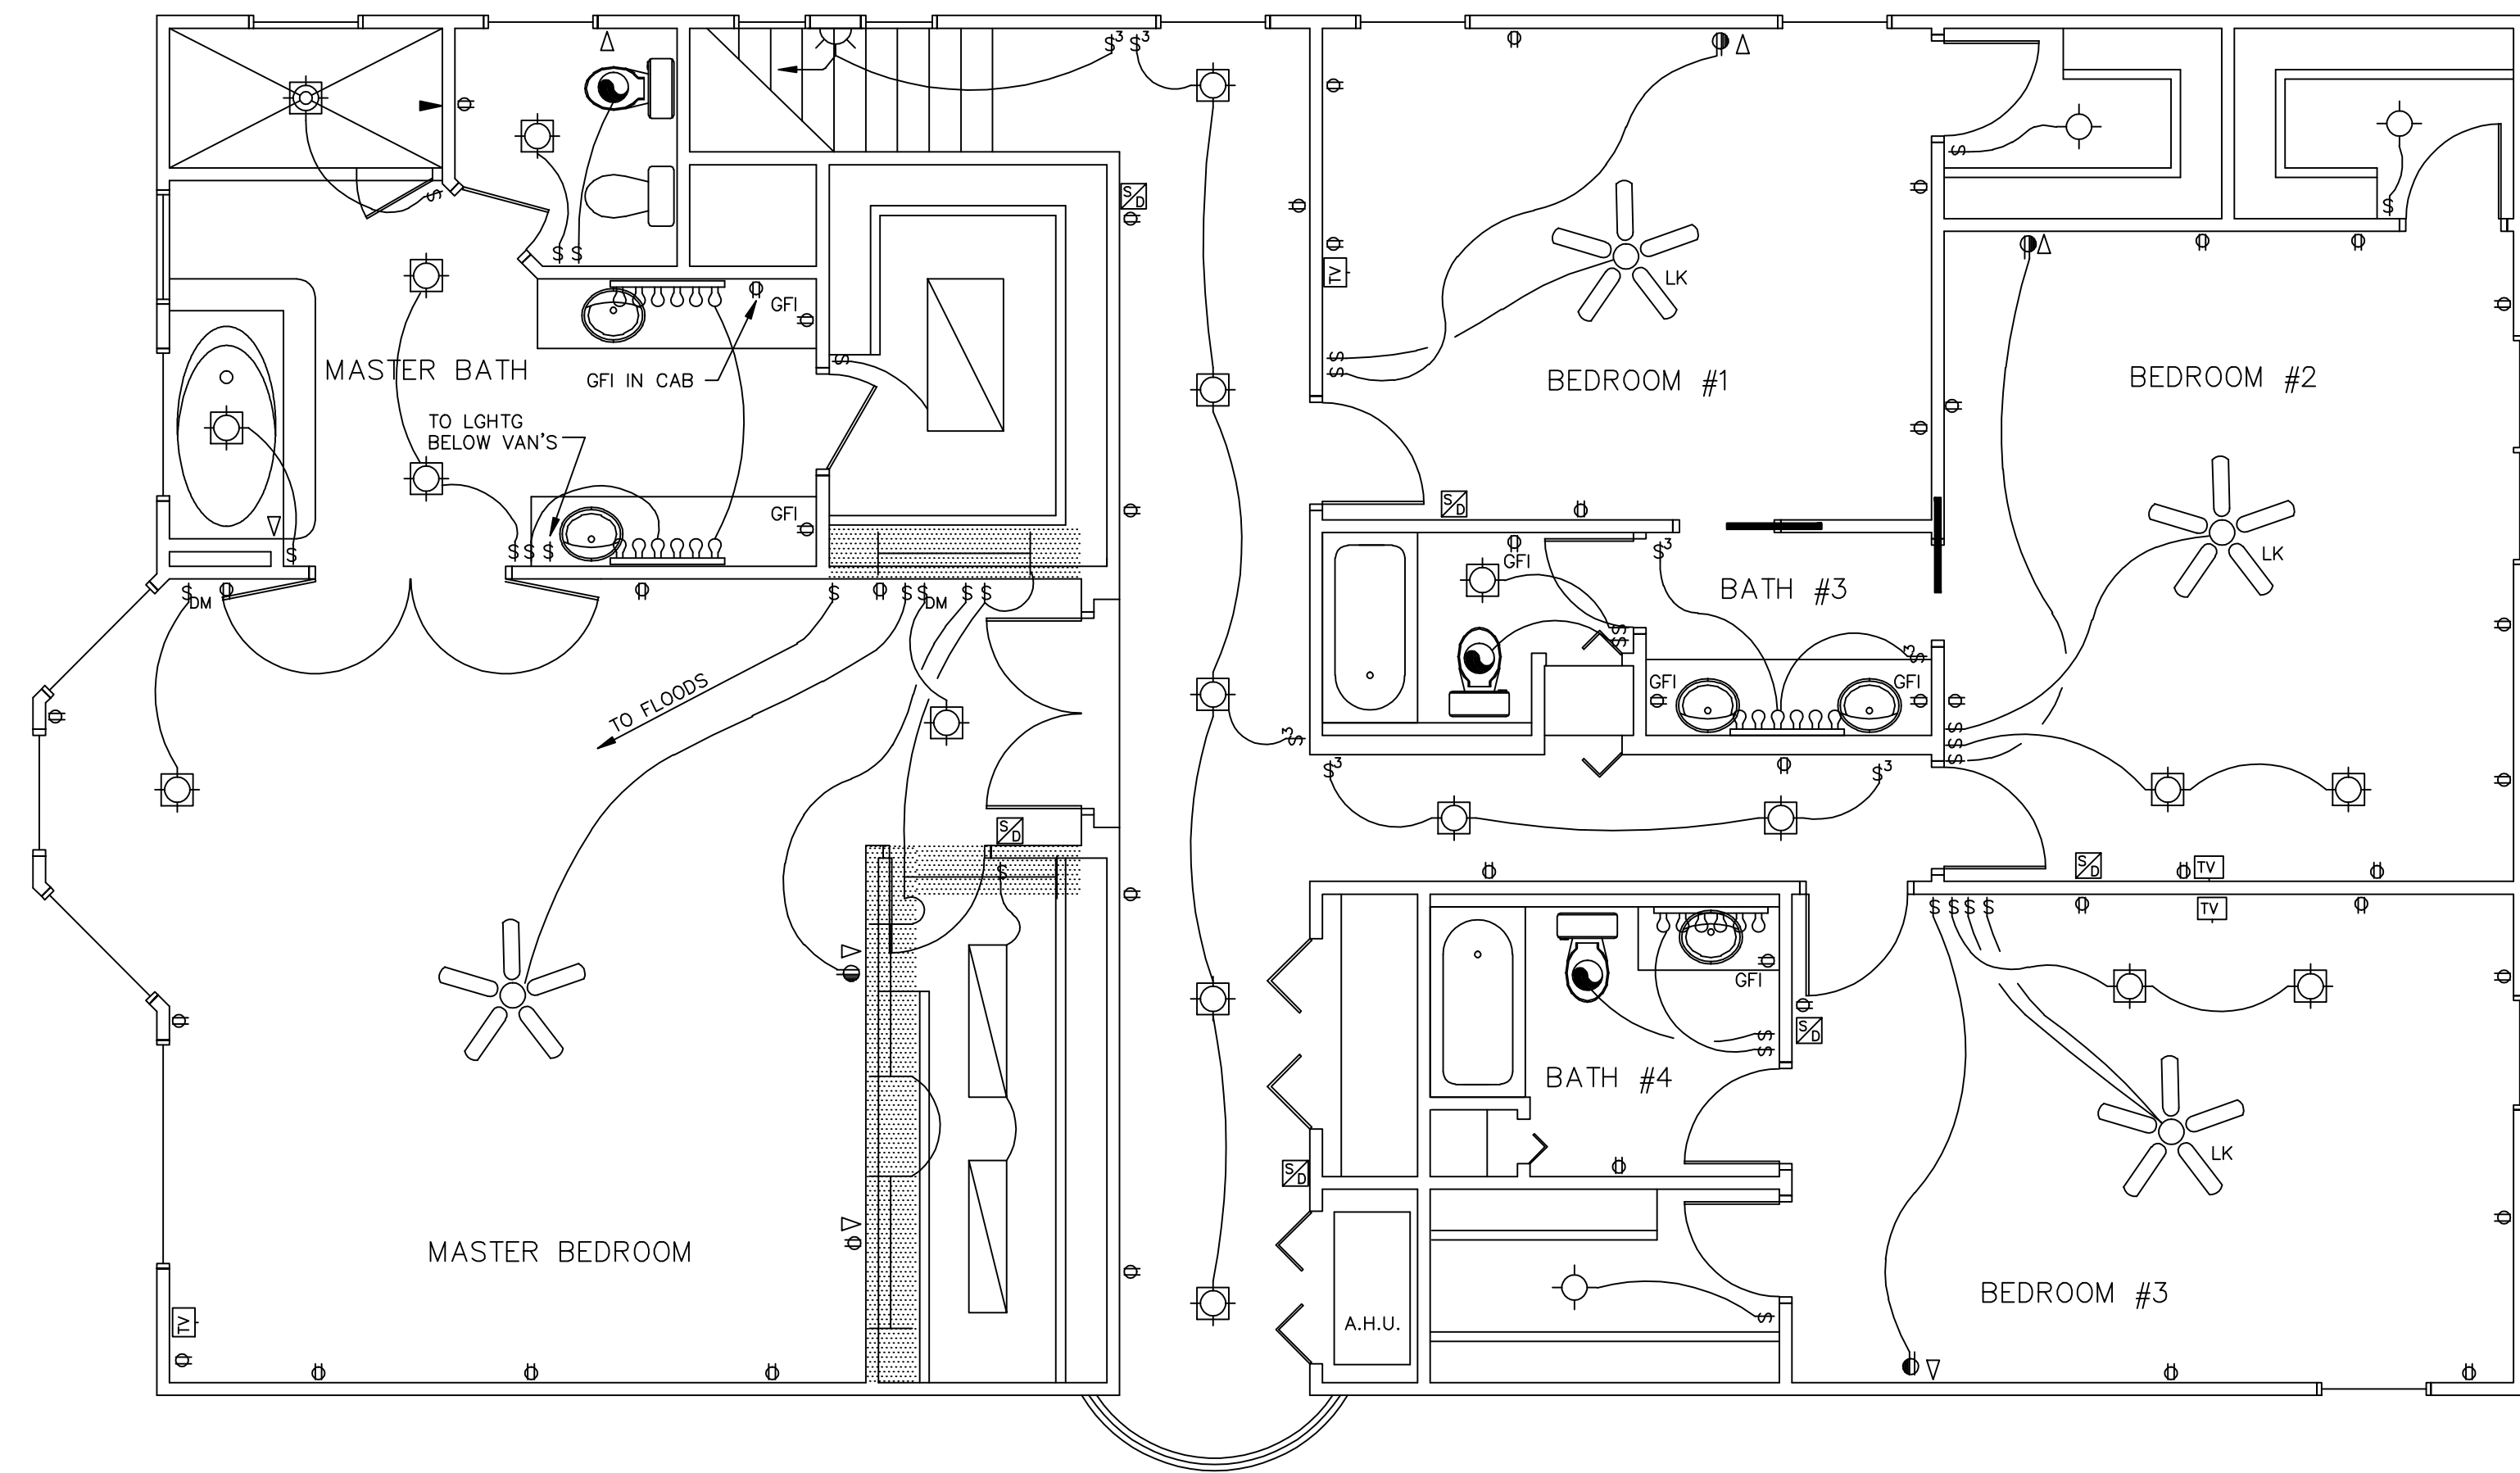

EXISTING SECOND FLOOR AS-BUILT ELECTRICAL PLAN 1/4"=1'-0"

AS-BUILT SERVICES BY:  
ASBUILT PROFESSIONALS  
A SERVICE OF A.E.C. CONSULTANTS, INC.  
WWW.ASBUILTPROFESSIONALS.COM  
866-903-8842  
FLA. REG. # 12117

AS-BUILT DRAWINGS: CLIENT NAME  
AS-BUILT LOCATION: FLORIDA

JOB NO.  
000-00-00

SHEET  
AB-1 of AB-1