


AS-BUILT FLOOR PLANS: CLIENT NAME
 AS-BUILT FLOOR PLAN LOCATION: BLANK FOR SECURITY


THIS AS-BUILT SERVICES BY:
 AS BUILT PROFESSIONALS
 A SERVICE OF A.E.C. CONSULTANTS INC.
 WWW.ASBUILTPROFESSIONALS.COM
 866-903-8842
 IN NJ

JOB NO.
 000-00-00


SHEET
 AB-1 of AB-1

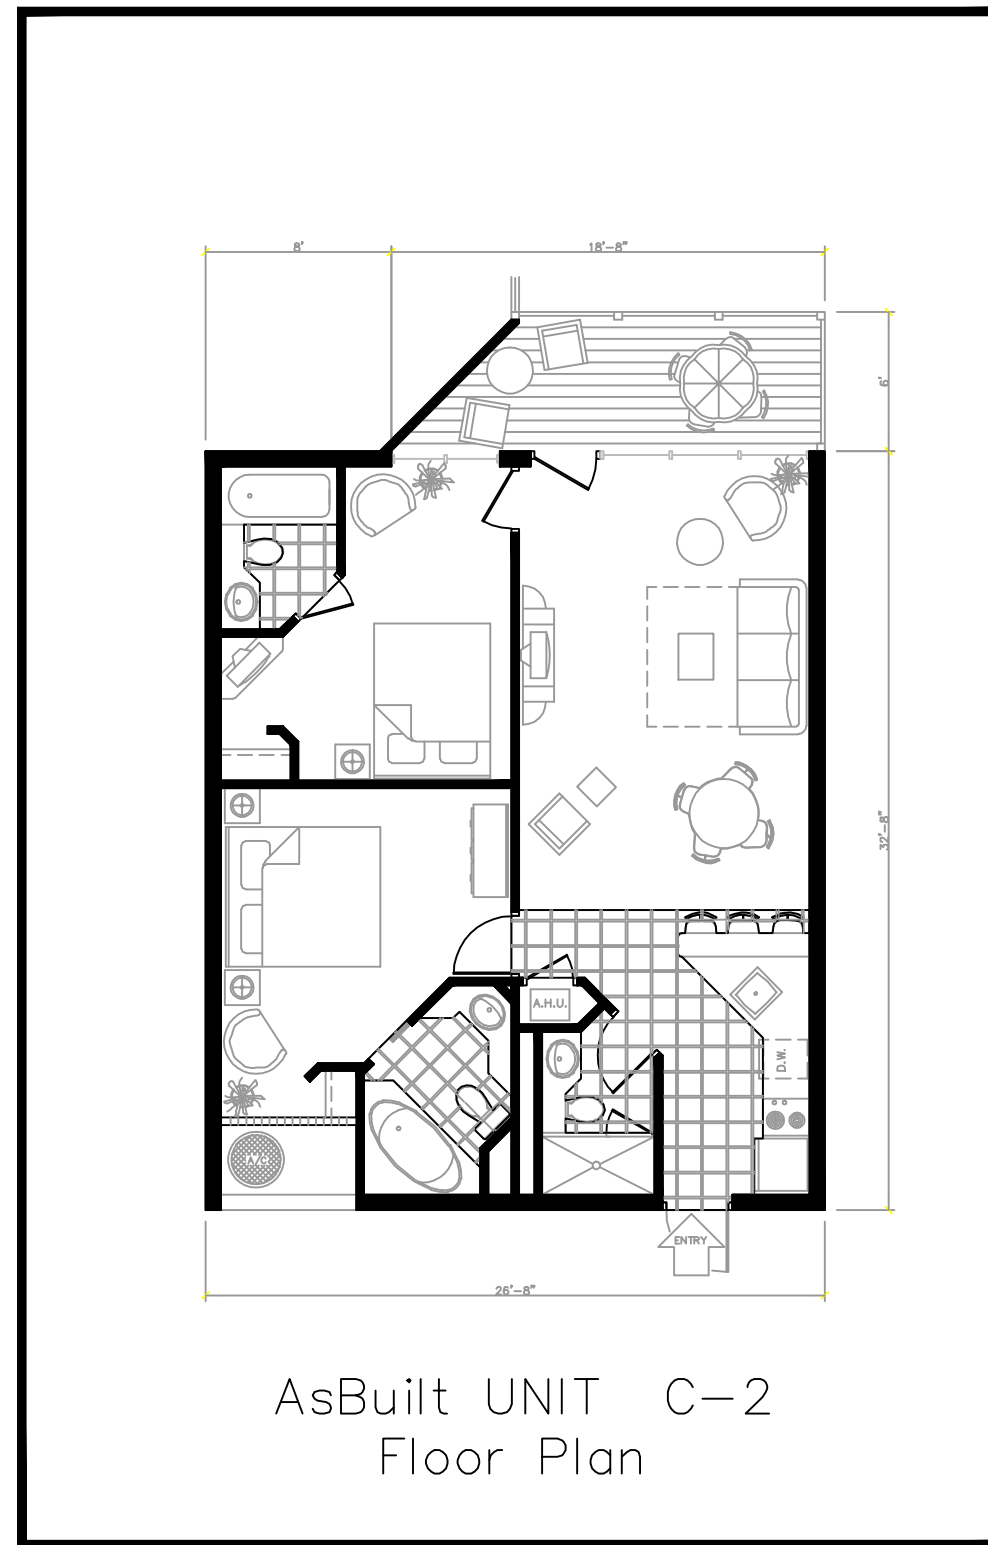


AsBuilt UNIT C-2
Floor Plan

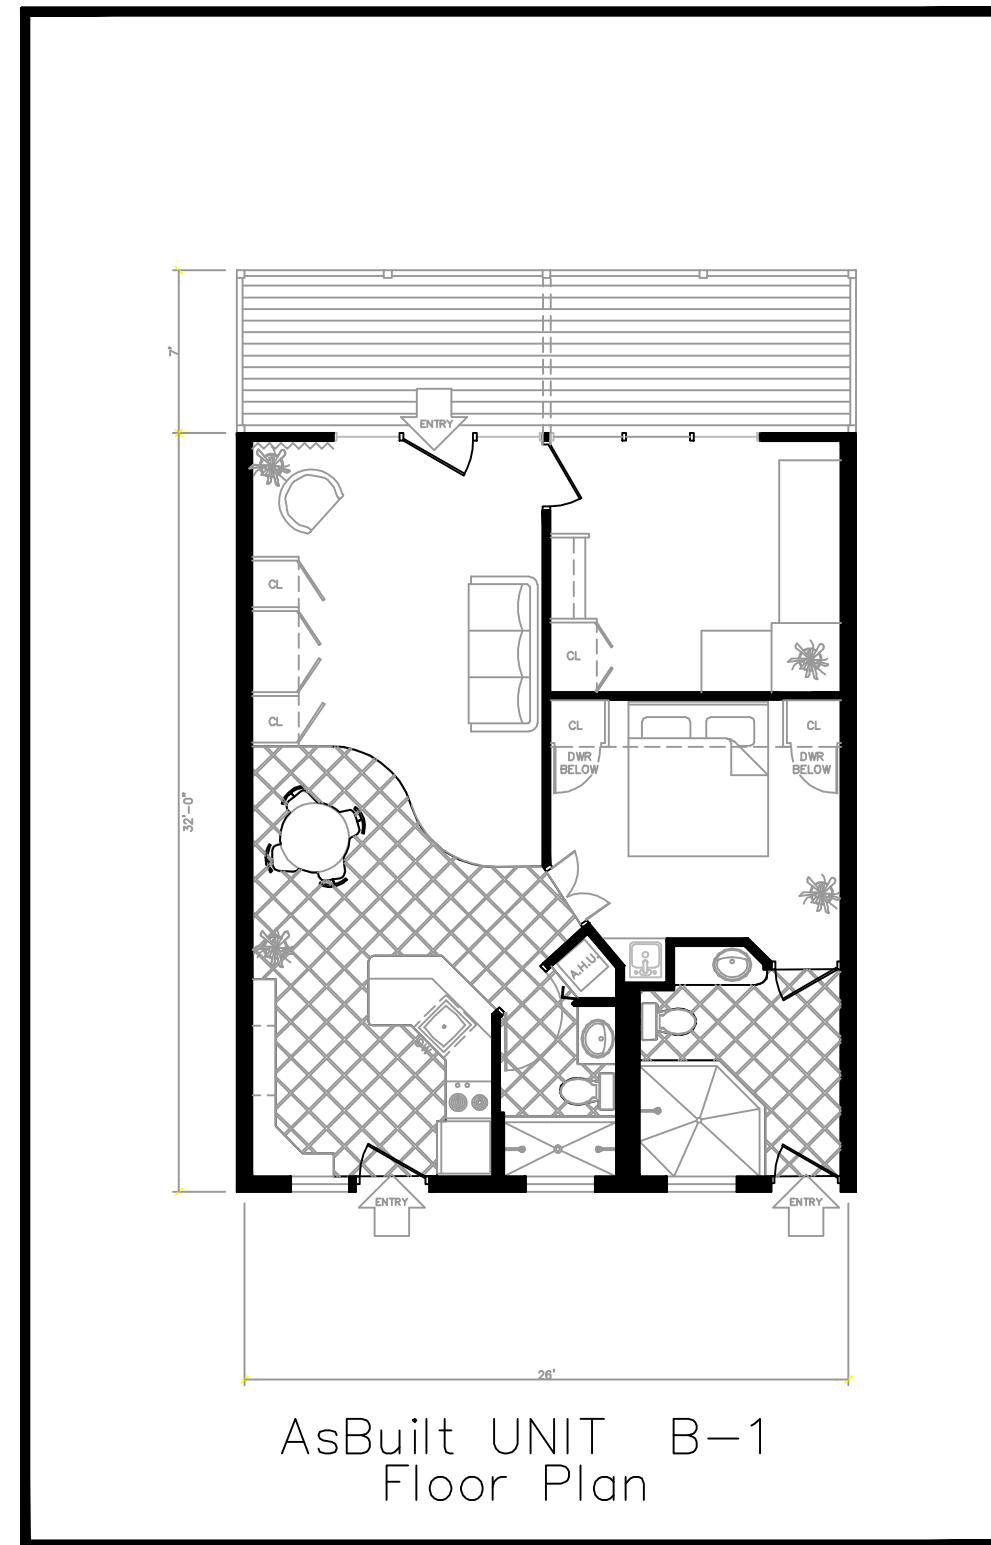


AsBuilt UNIT B-1
Floor Plan

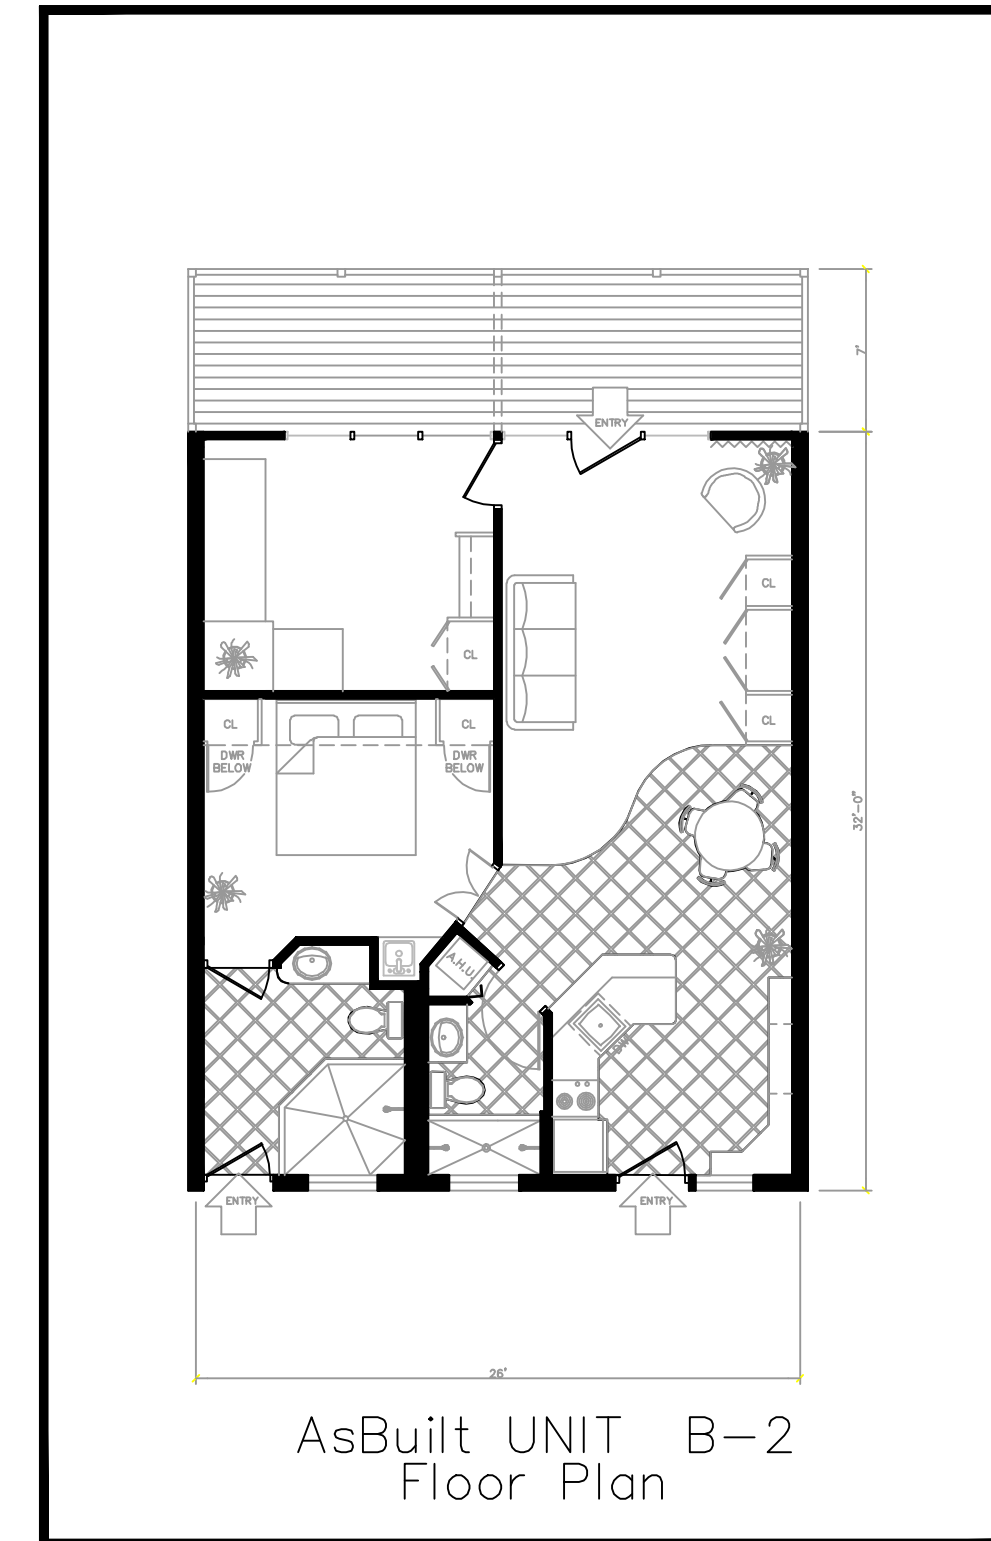

AsBuilt UNIT B-2
Floor Plan

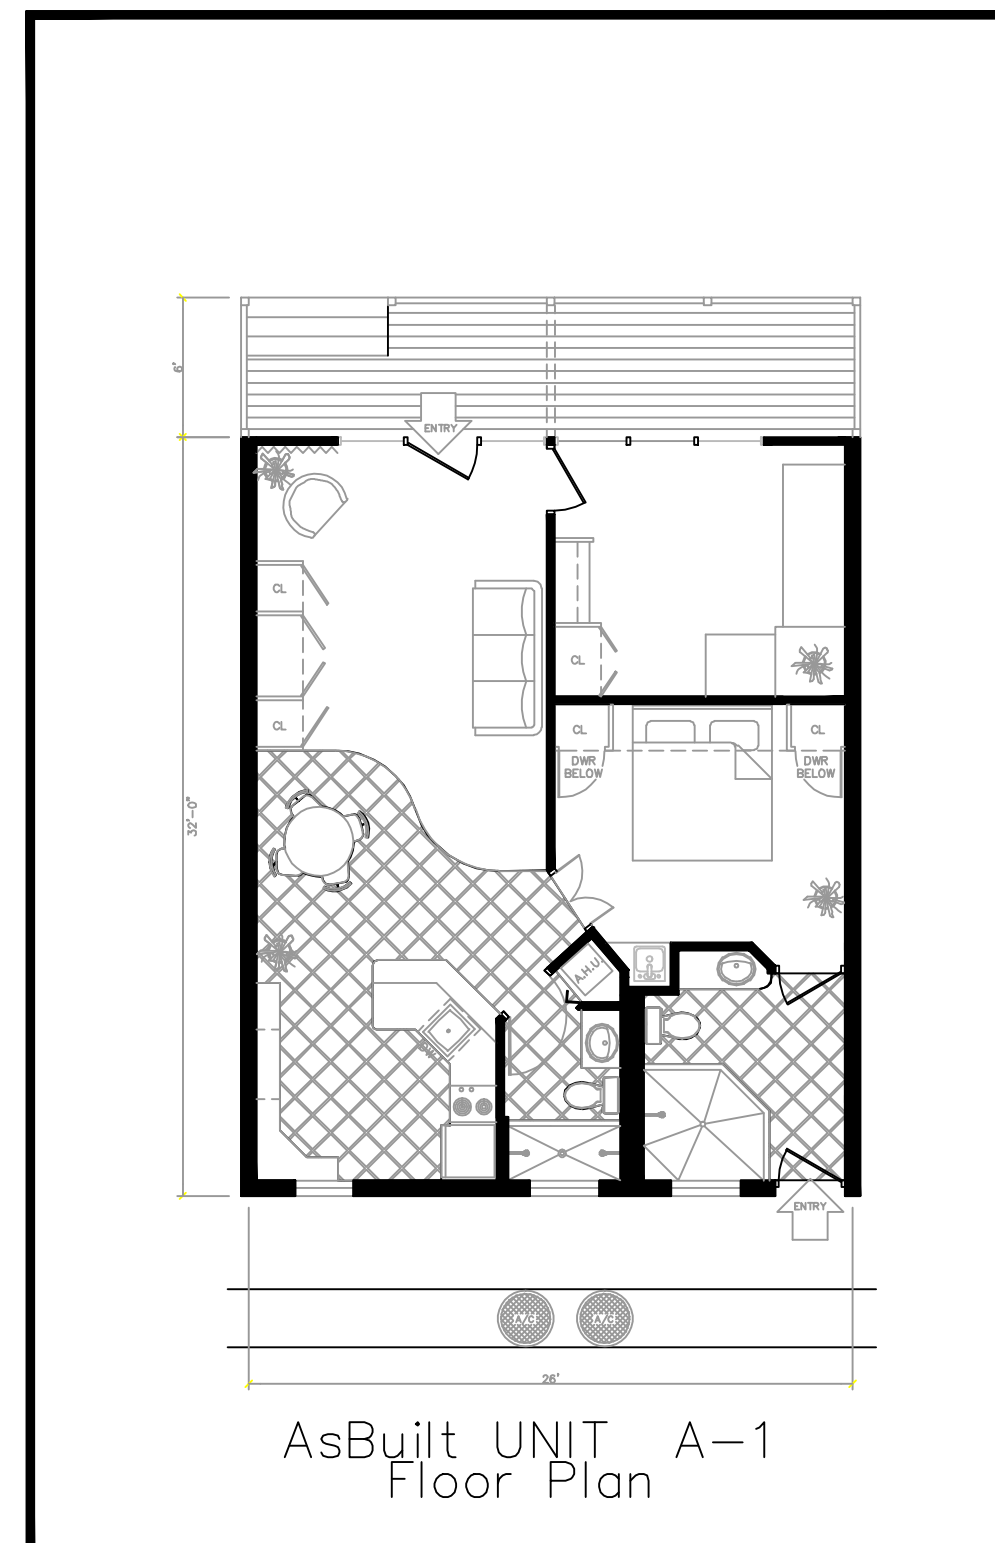

AsBuilt UNIT A-1
Floor Plan

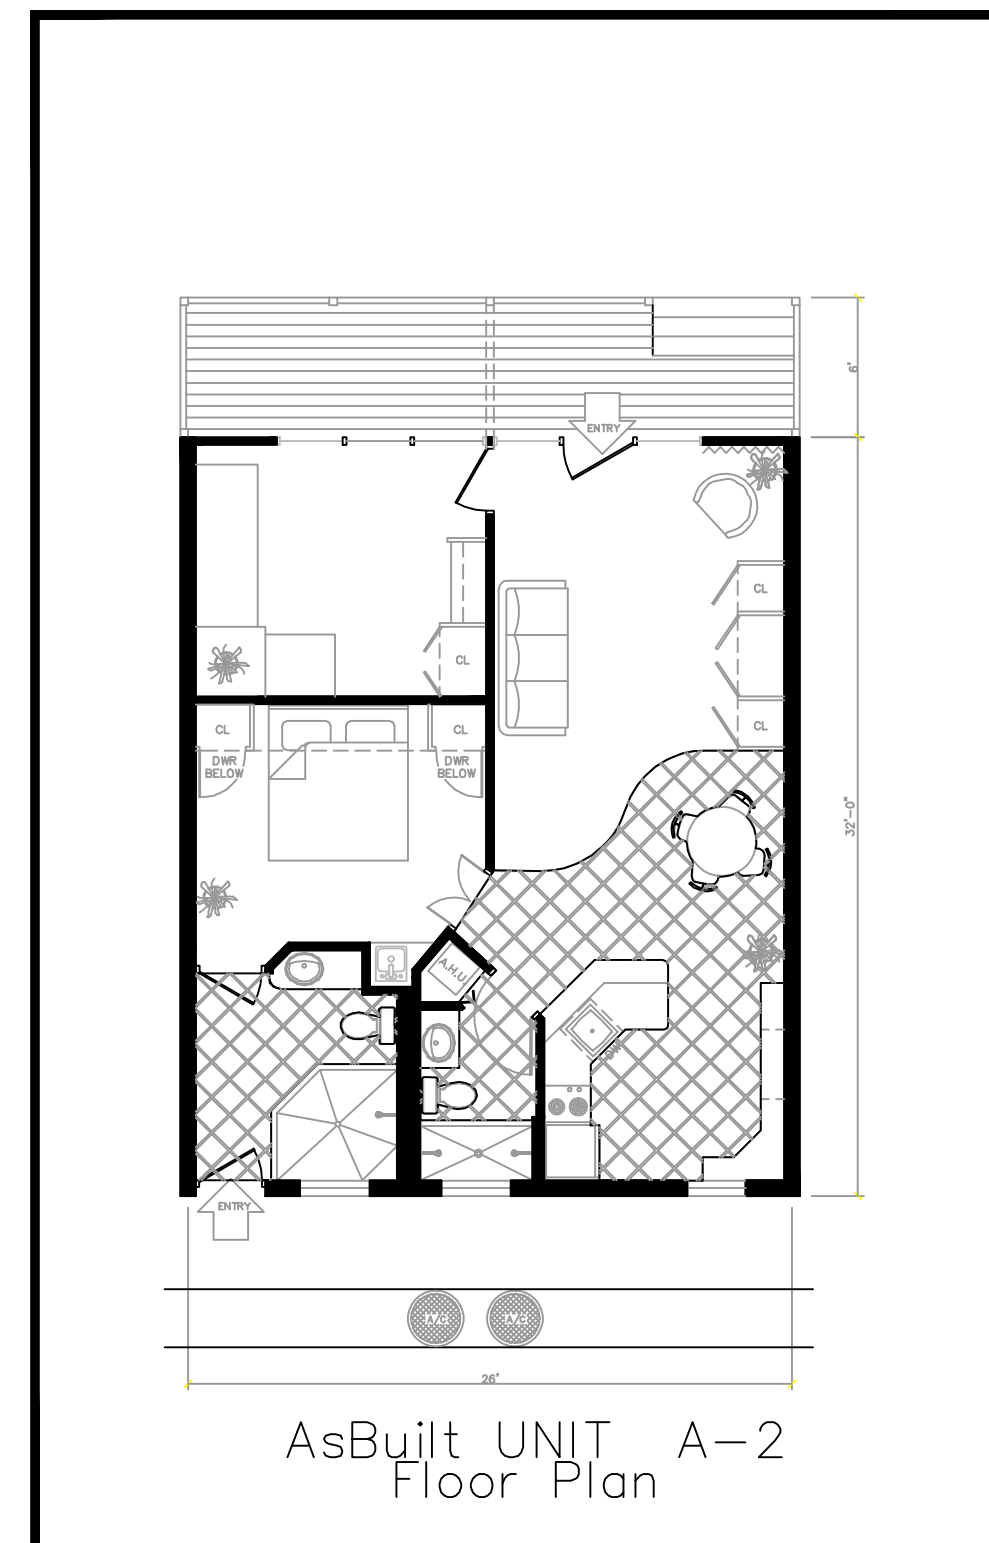

AsBuilt UNIT A-2
Floor Plan

AS-BUILT FLOOR PLANS: CLIENT NAME
AS-BUILT FLOOR PLAN LOCATION: BLANK FOR SECURITY

AS-BUILT SERVICES BY:
ASBUILT PROFESSIONALS
A SERVICE OF A.E.C. CONSULTANTS, INC.
WWW.ASBUILTPROFESSIONALS.COM
866-903-8842
INL/PLC

JOB NO.
000-00-00

SHEET

AB-1 of AB-1