




FRONT ELEVATION 1/8"=1'-0"

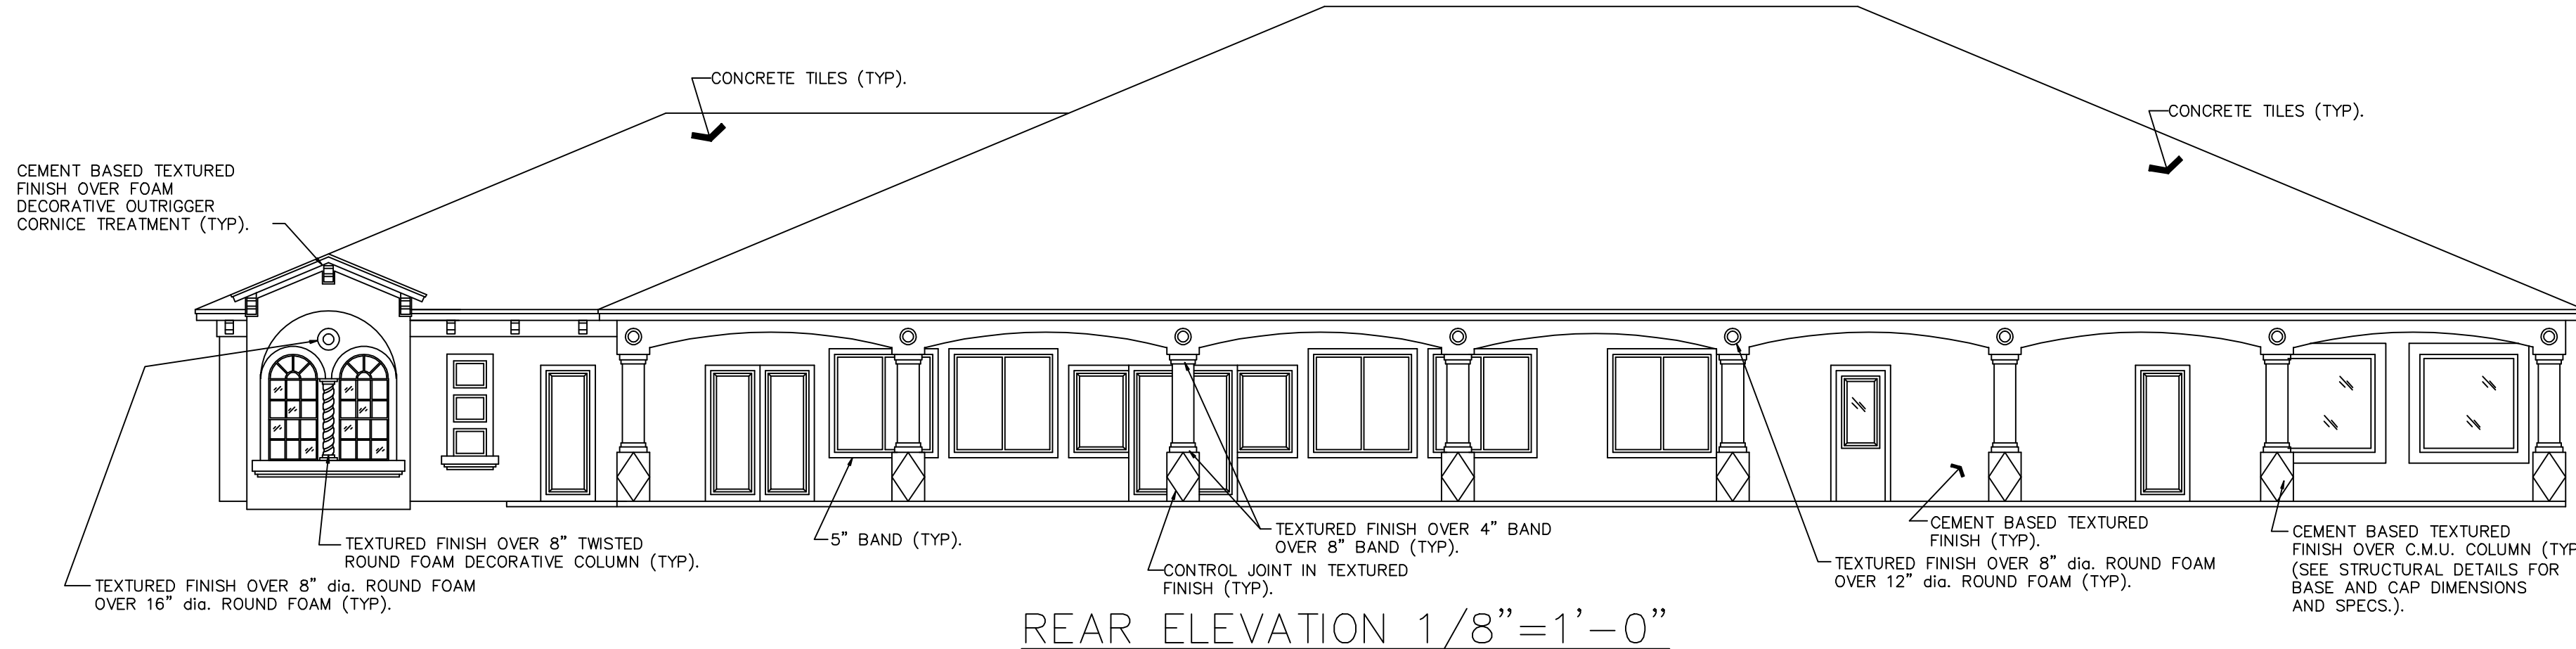


REAR ELEVATION 1/8"=1'-0"

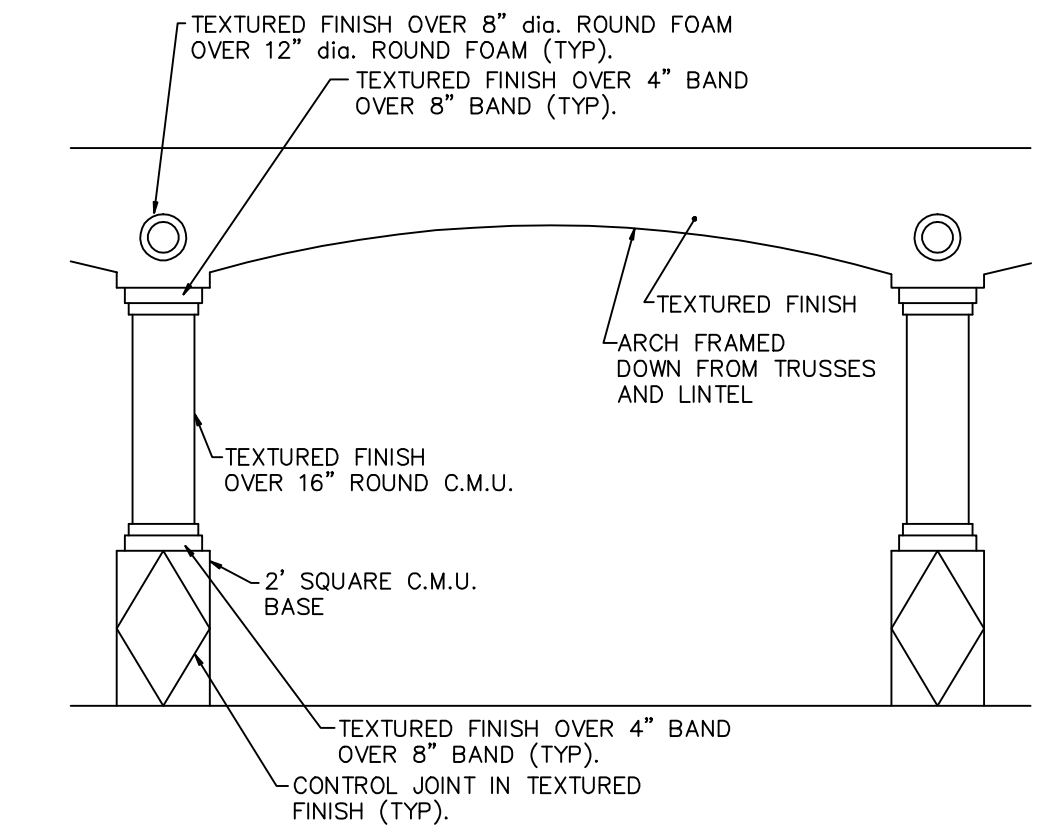

REAR COLUMN DETAIL 1/4"=1'-0"

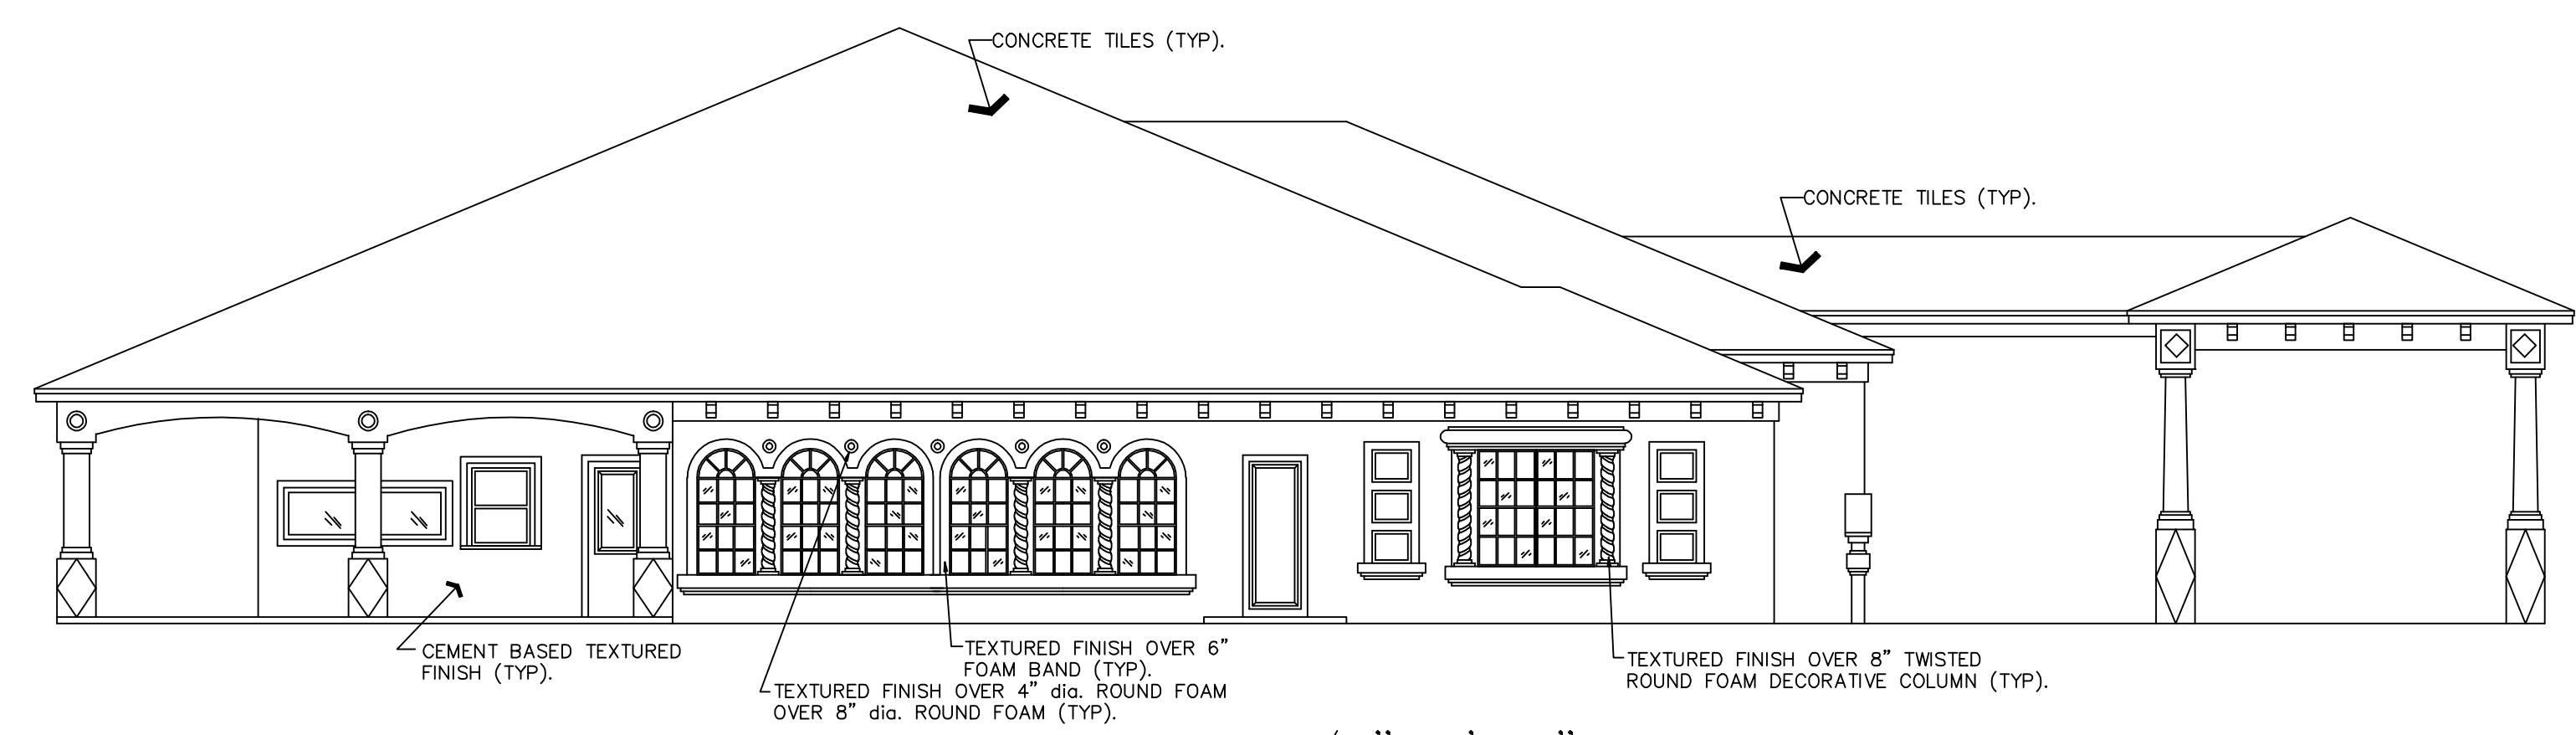

LEFT SIDE ELEVATION 1/8"=1'-0"

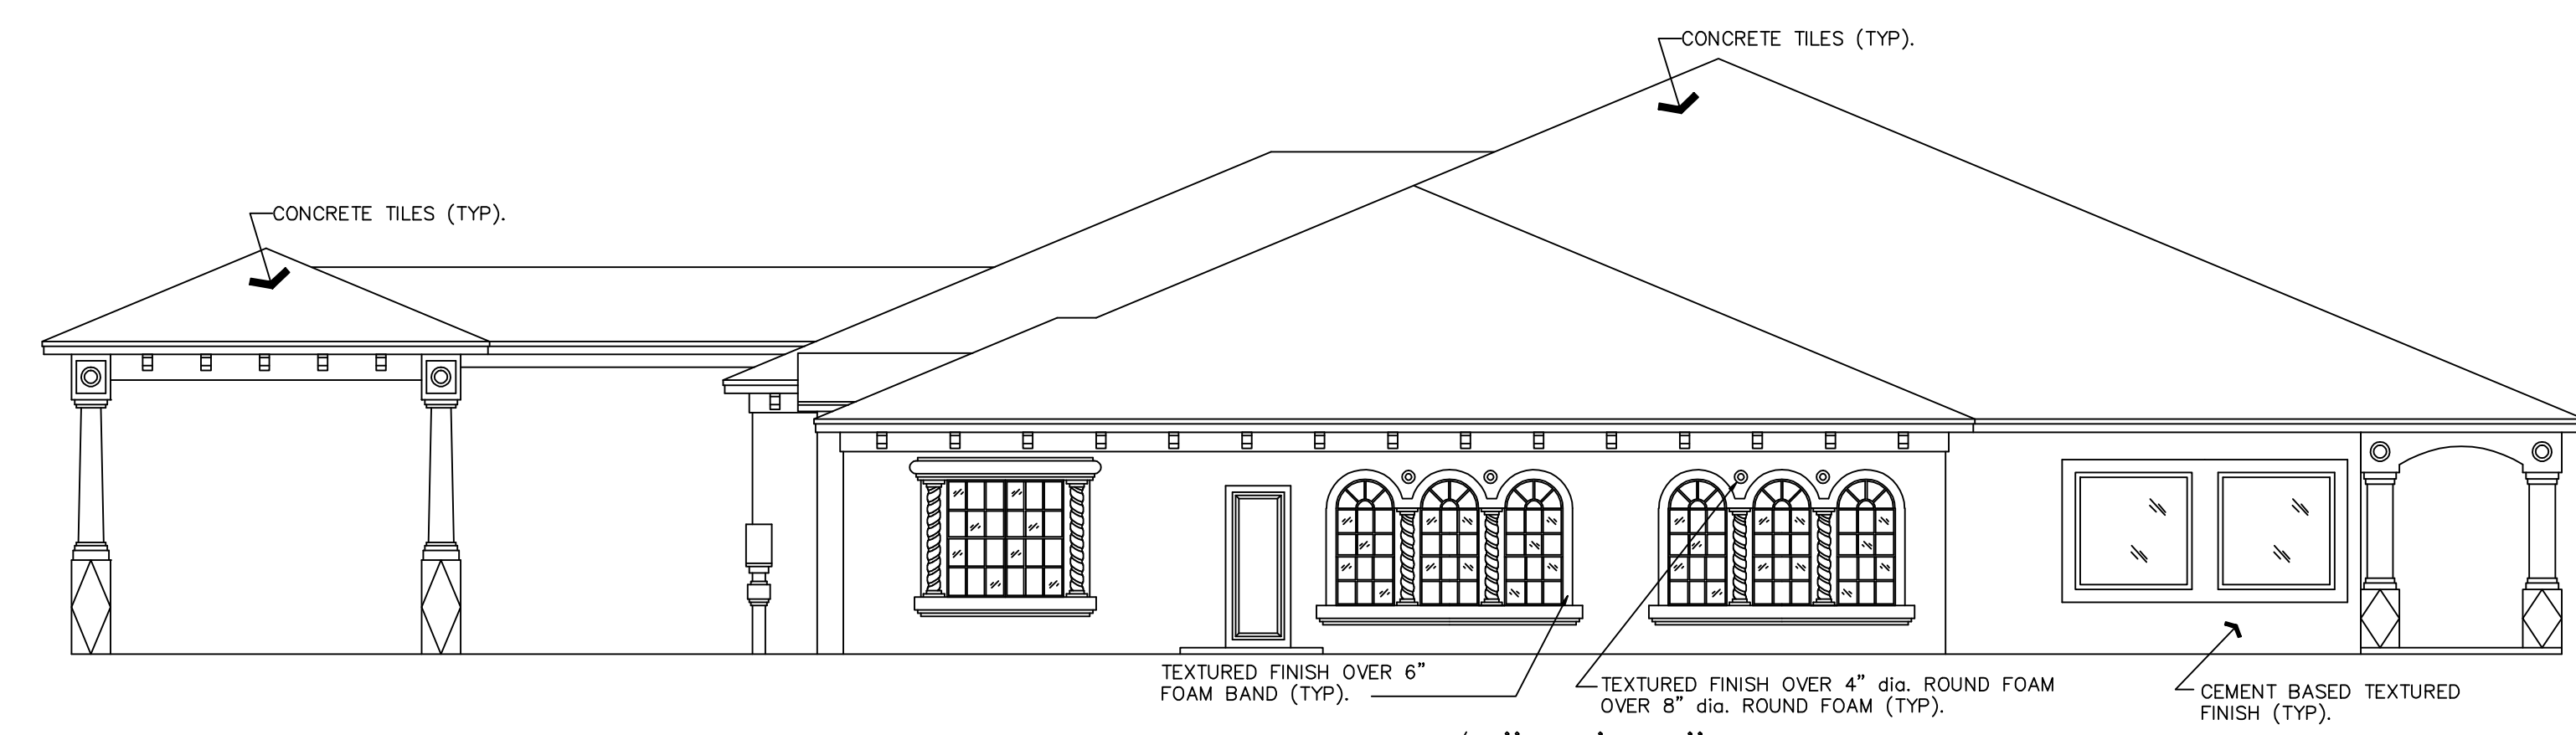

RIGHT SIDE ELEVATION 1/8"=1'-0"

PROJECT NAME: BLANK FOR SECURITY
PROJECT LOCATION BLANK FOR SECURITY

THIS AS-BUILT DRAWING WAS PREPARED BY:
AS BUILT PROFESSIONALS
A SERVICE OF A.E.C. CONSULTANTS, INC.
WWW.ASBUILTPROFESSIONALS.COM
866-903-8842
IND. REG.

JOB NO.
000-00-00

SHEET
AB-1 of AB-1