


FLOOR PLAN 1/16"=1'-0"


DOOR SCHEDULE										
U/L	STYLE	MATERIAL	#	H	W	LOADING	LOOSE	SPRINK	FRAME OR CASE EYE	HYDRANT
1	ALUM	WTL	36"	84"	36"	YES	YES	0	MIN	NO
2	ALUM	WTL	36"	84"	36"	YES	YES	0	MIN	NO
WINDOW SCHEDULE						
U/L	STYLE	#	H	FRAME	GLASS	COMMENTS
1	IMPACT	36"	48"	ALUM	WTL	IMPACT (TINTED)
2	IMPACT	36"	48"	ALUM	WTL	IMPACT (TINTED)
3	IMPACT	36"	48"	ALUM	WTL	IMPACT (TINTED)
DOOR NOTES:
 1. HOLLOW GLASS WITH WEATHER STRIPPING
 2. IMPACT GLASS

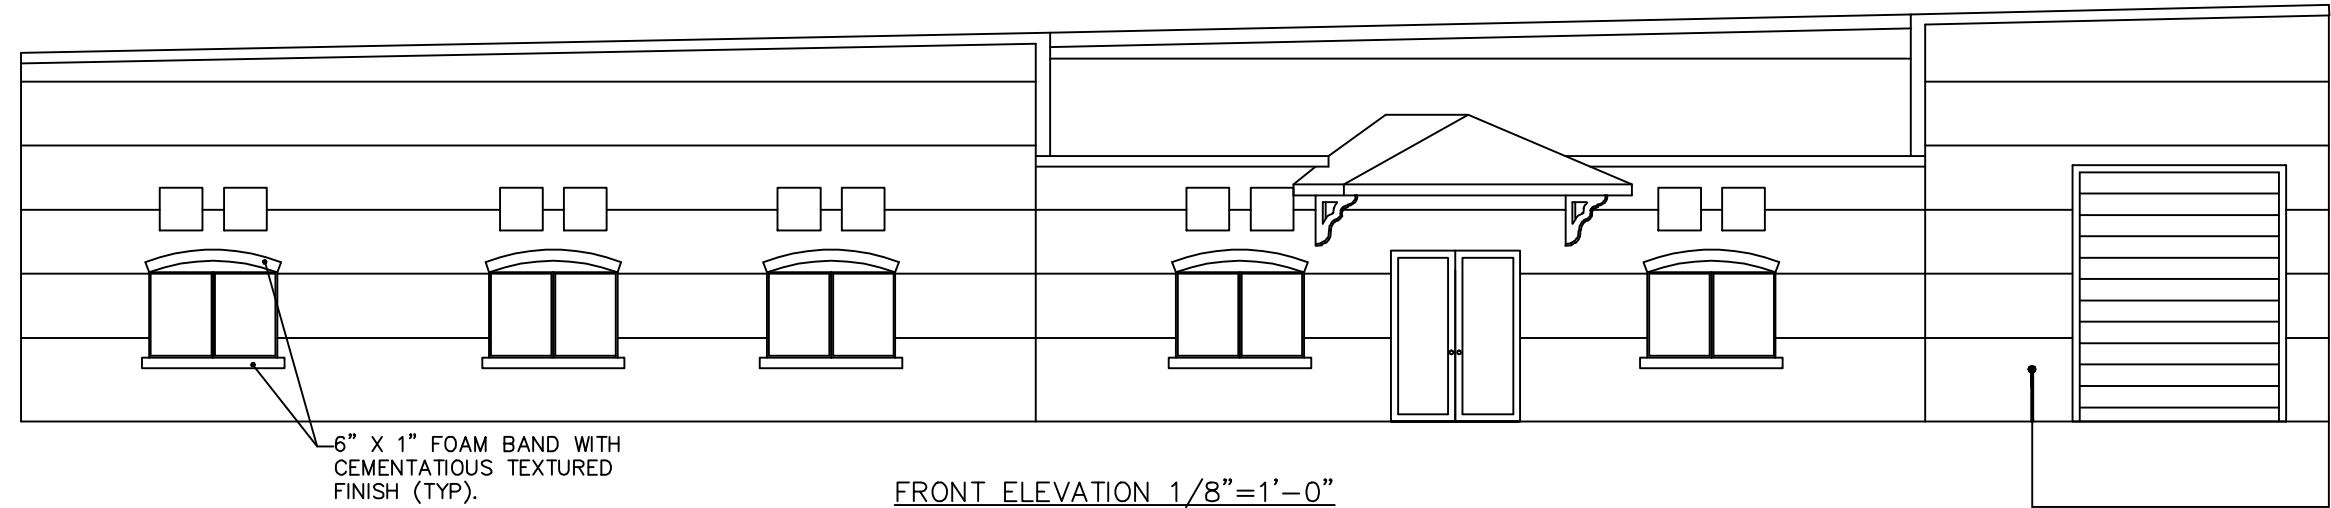


FRONT ELEVATION 1/8"=1'-0"

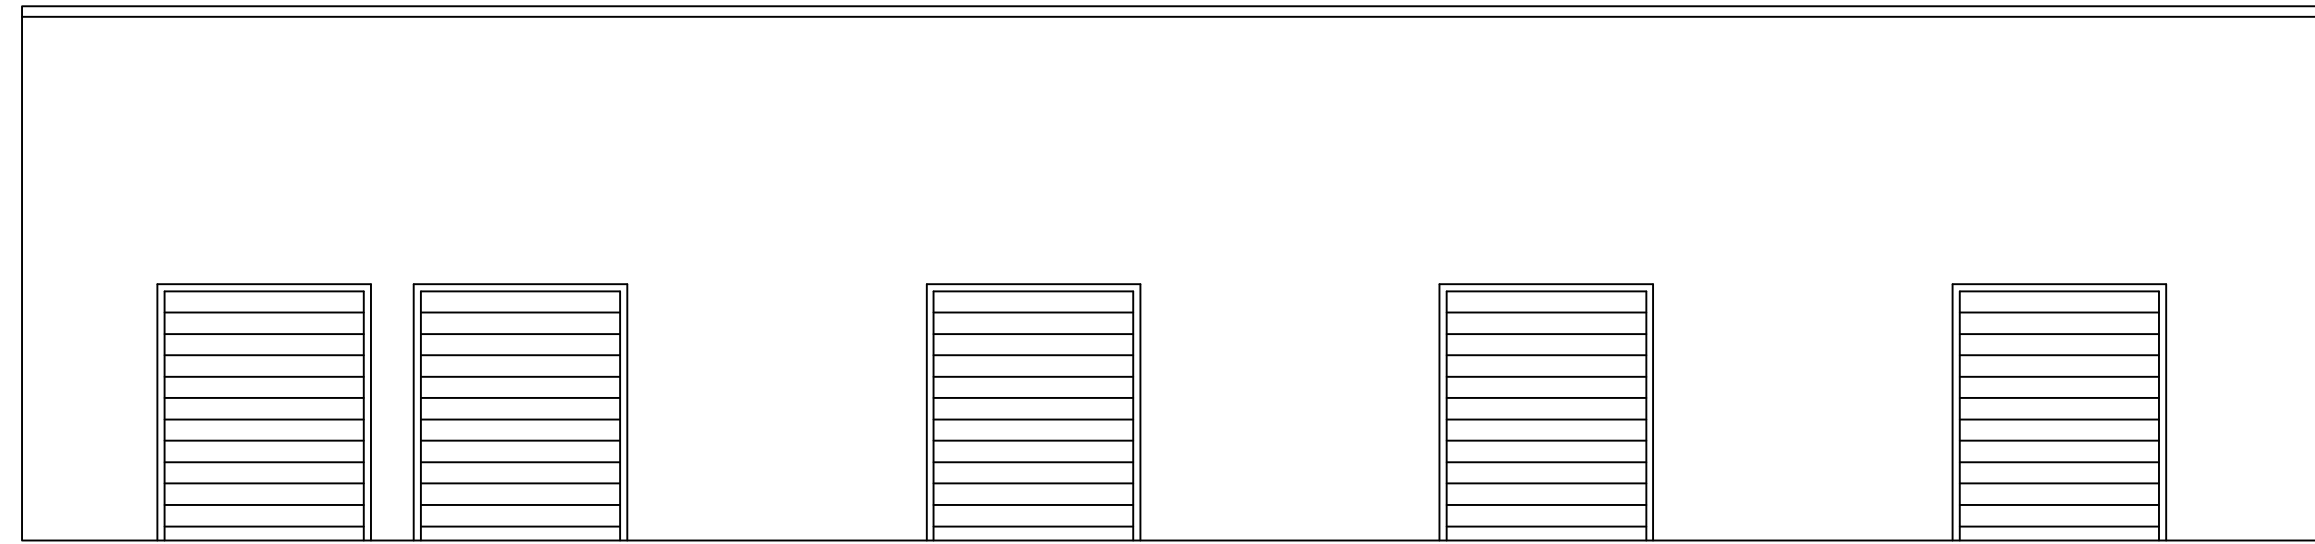

REAR ELEVATION 1/8"=1'-0"

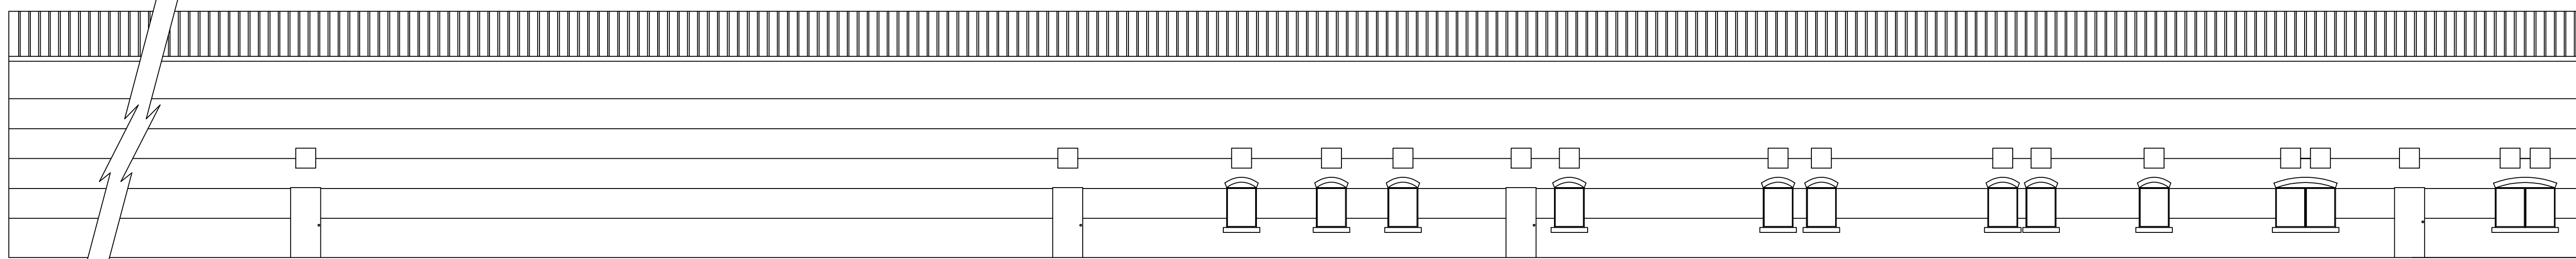

LEFT SIDE ELEVATION 1/8"=1'-0"

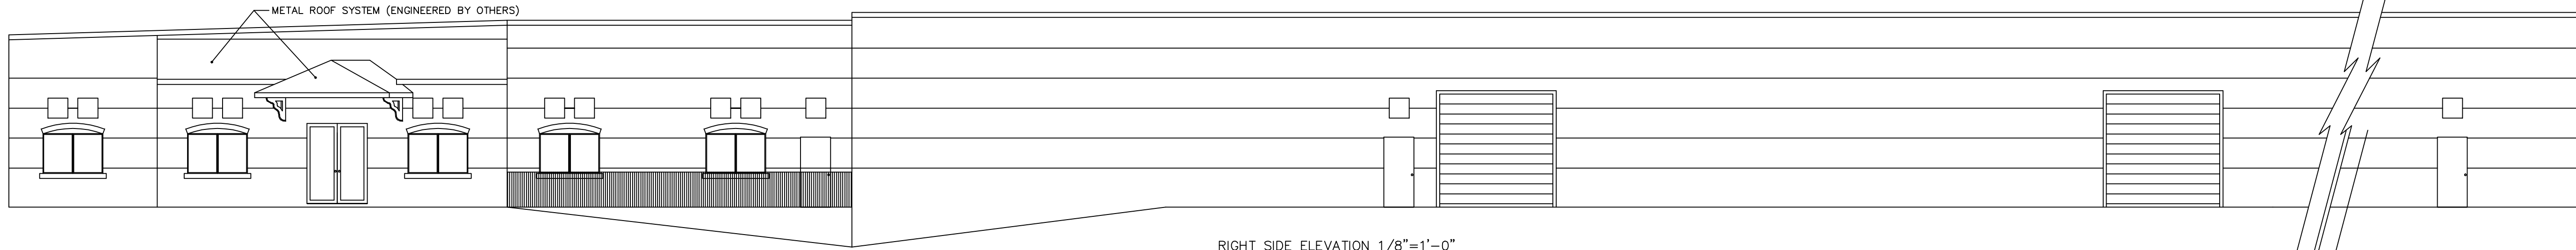

RIGHT SIDE ELEVATION 1/8"=1'-0"

PROJECT NAME: BLANK FOR SECURITY
 PROJECT LOCATION BLANK FOR SECURITY

THIS AS-BUILT DRAWING WAS PREPARED BY:
 AS BUILT PROFESSIONALS
 A SERVICE OF A.E.C. CONSULTANTS, INC.
 WWW.ASBUILTPROFESSIONALS.COM
 866-903-8842
 INLL, INC.

JOB NO.
 000-00-00

SHEET
 AB-1 of AB-1