



BUILDING # 1

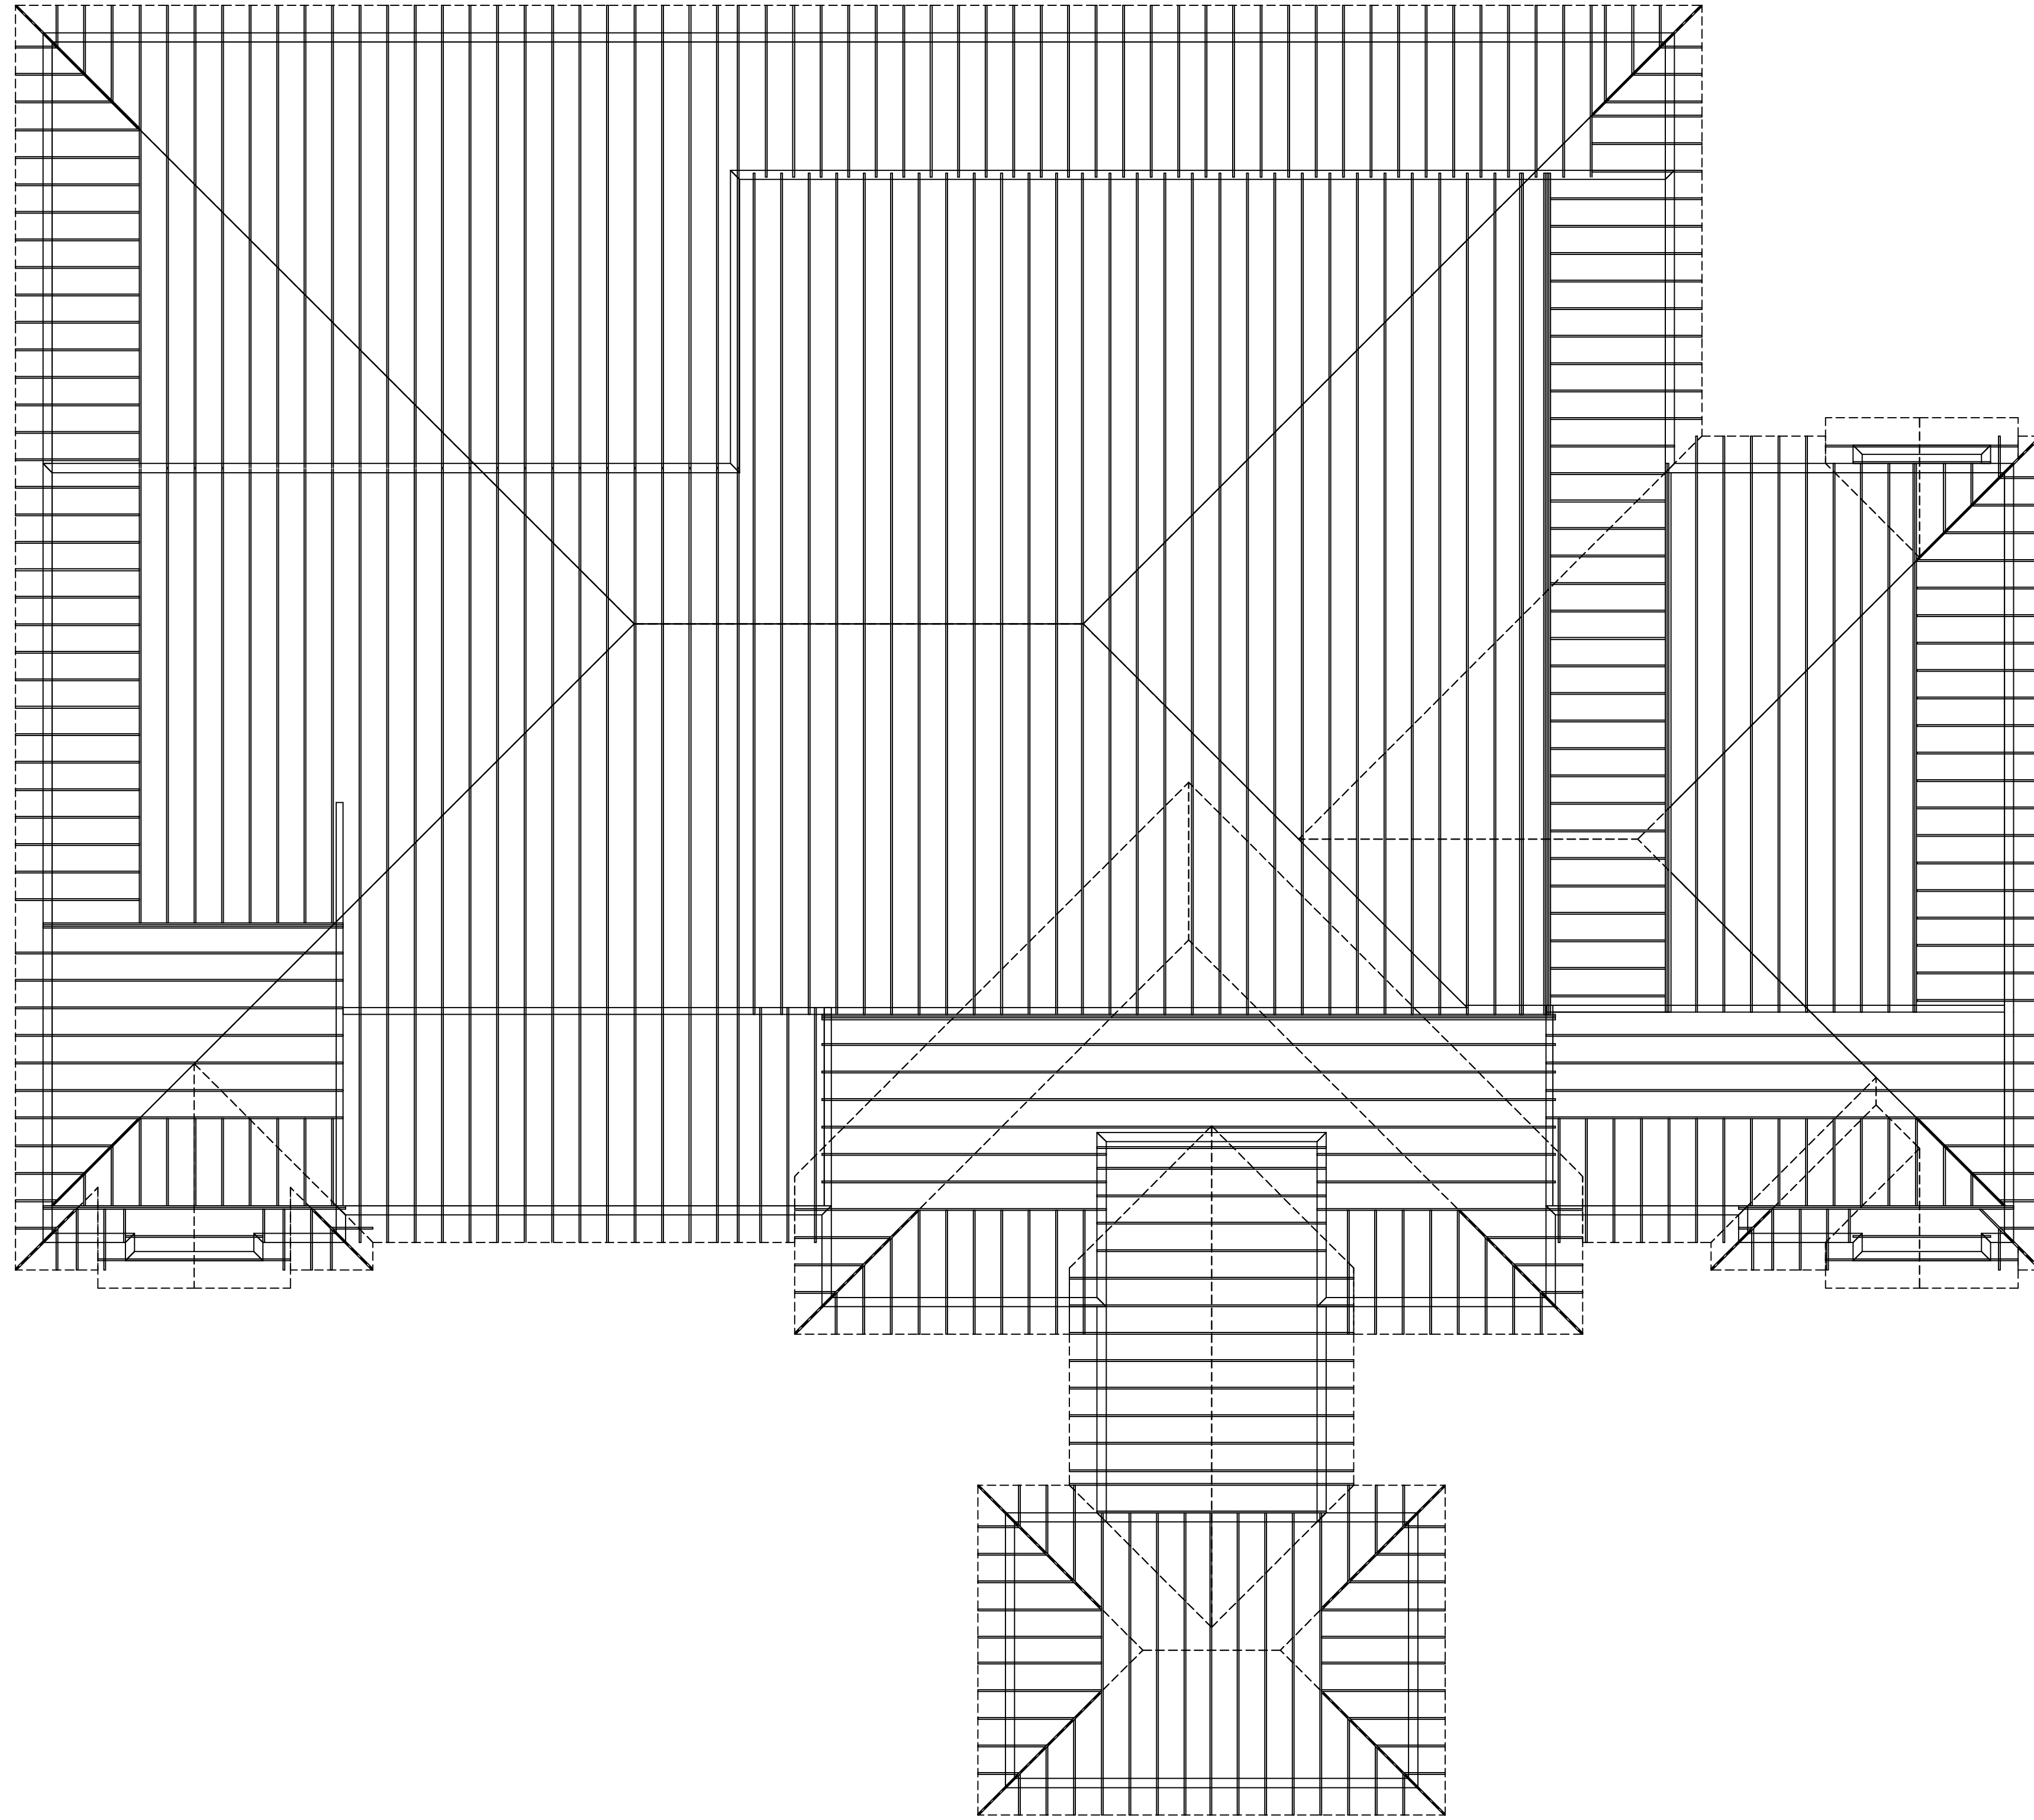

EXISTING ROOF FRAMING PLAN

BUILDING # 2

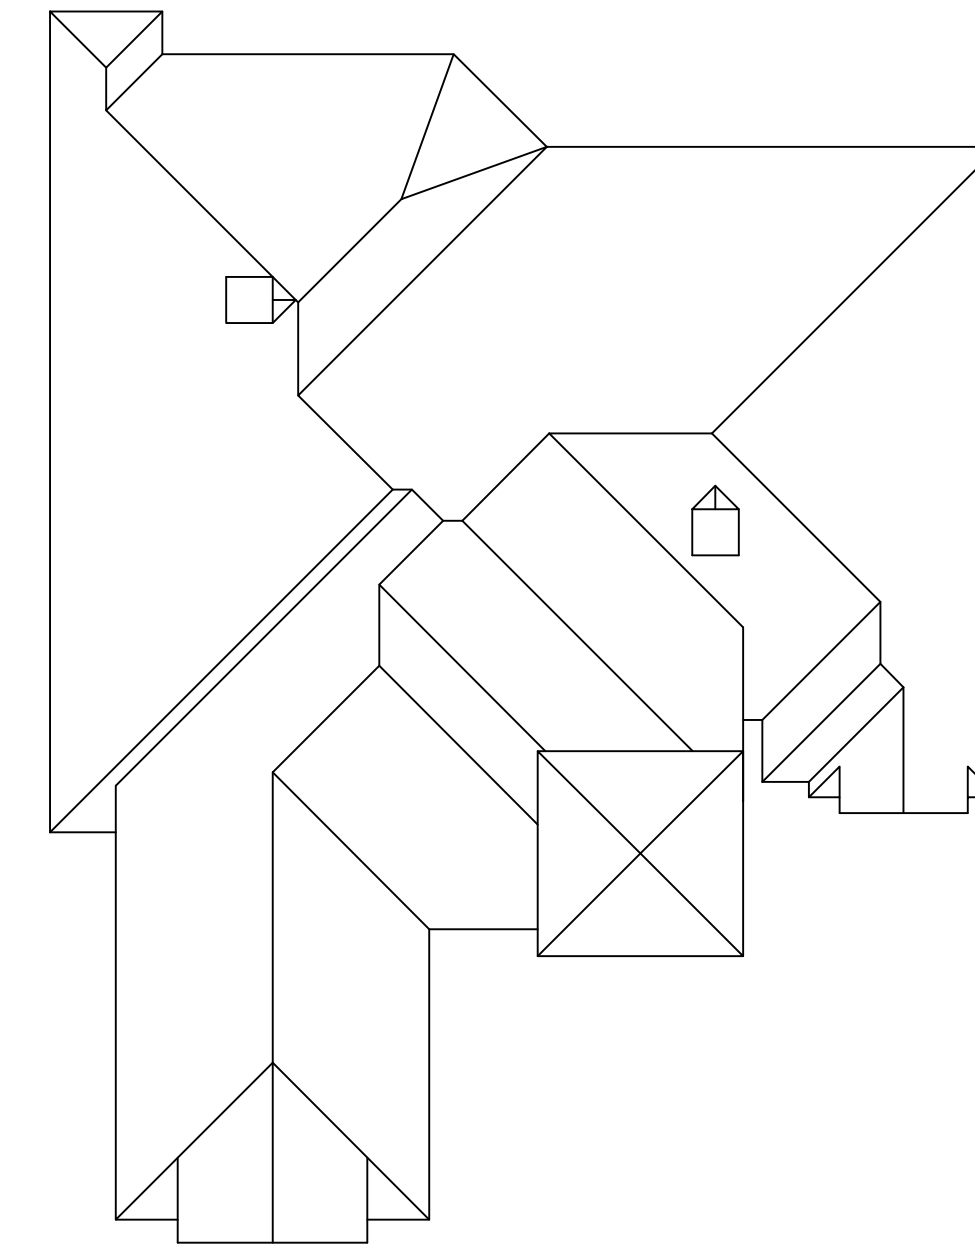

ROOF PLAN 1/16"=1'-0"

PROJECT NAME: BLANK FOR SECURITY
 PROJECT LOCATION BLANK FOR SECURITY

THIS AS-BUILT DRAWING WAS PREPARED BY:
 AS BUILT PROFESSIONALS
 A SERVICE OF A.E.C. CONSULTANTS, INC.
 WWW.ASBUILTPROFESSIONALS.COM
 866-903-8842
 INCL. PER.

JOB NO.
 000-00-00

SHEET

AB-1 of AB-1