



# EXISTING FLOOR PLAN

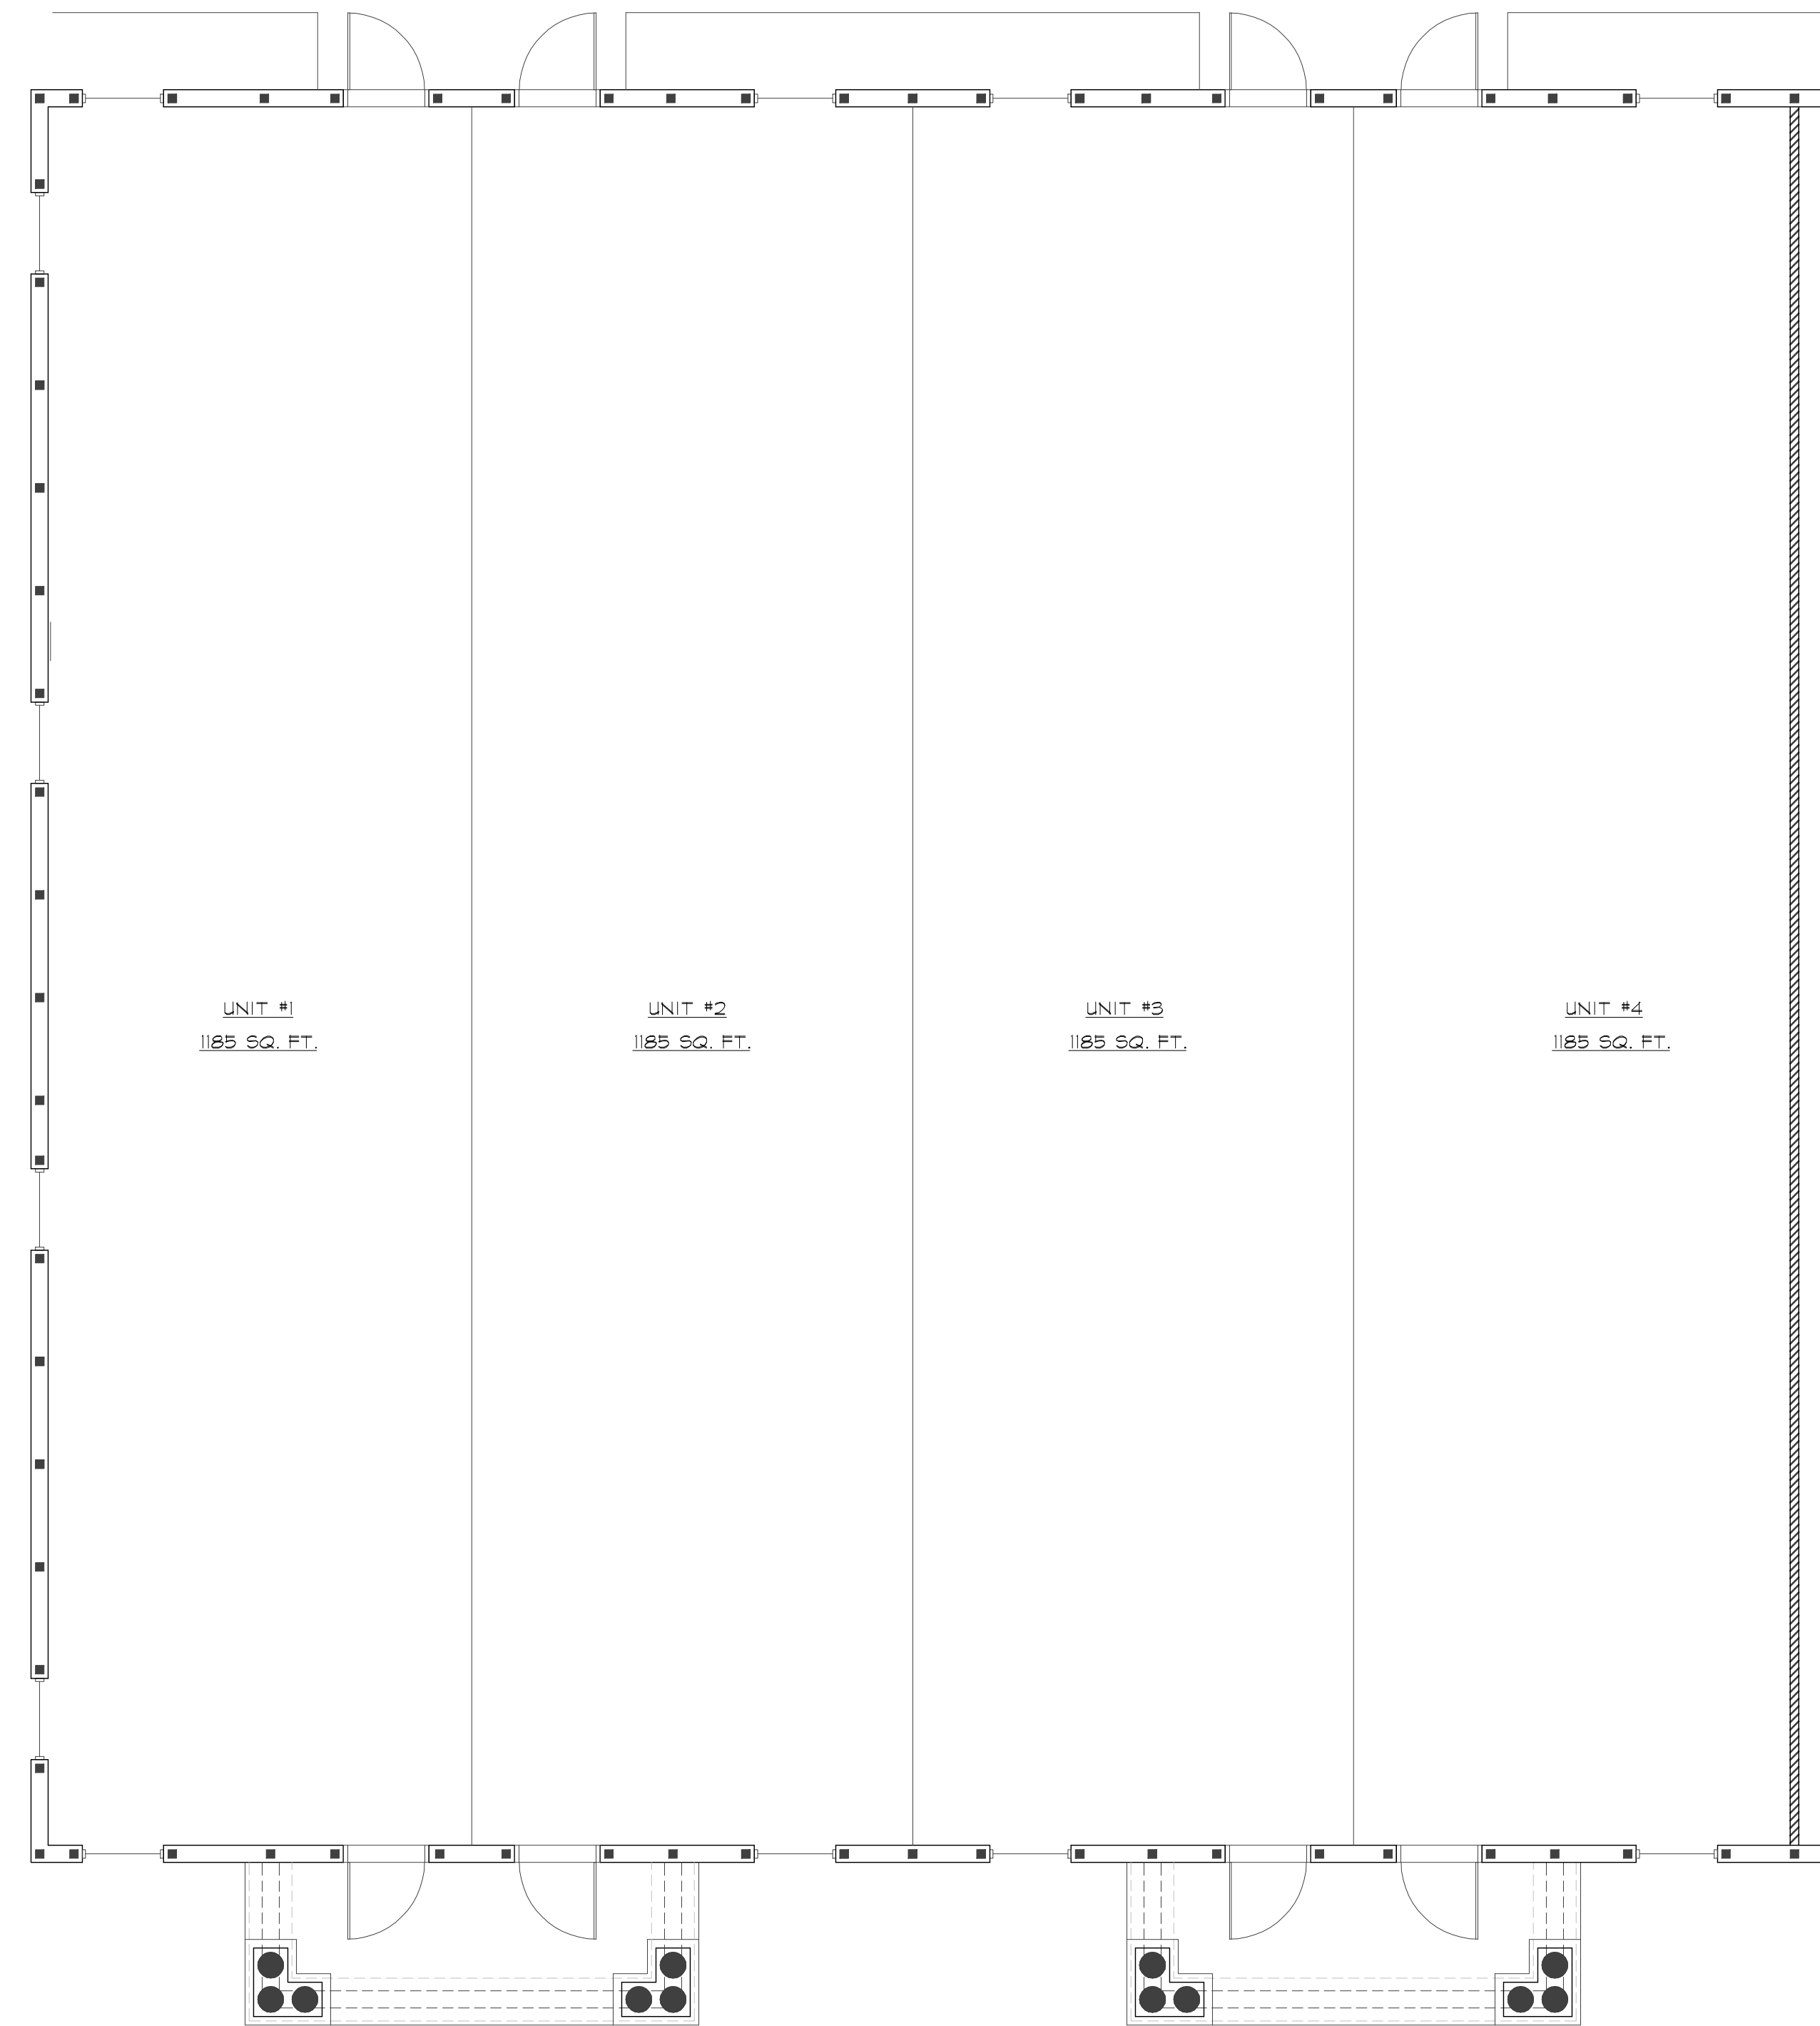

EXISTING UNITS 1, 2, 3, & 4 FLOOR PLAN 1/4"=1'-0"

# PROPOSED FLOOR PLAN

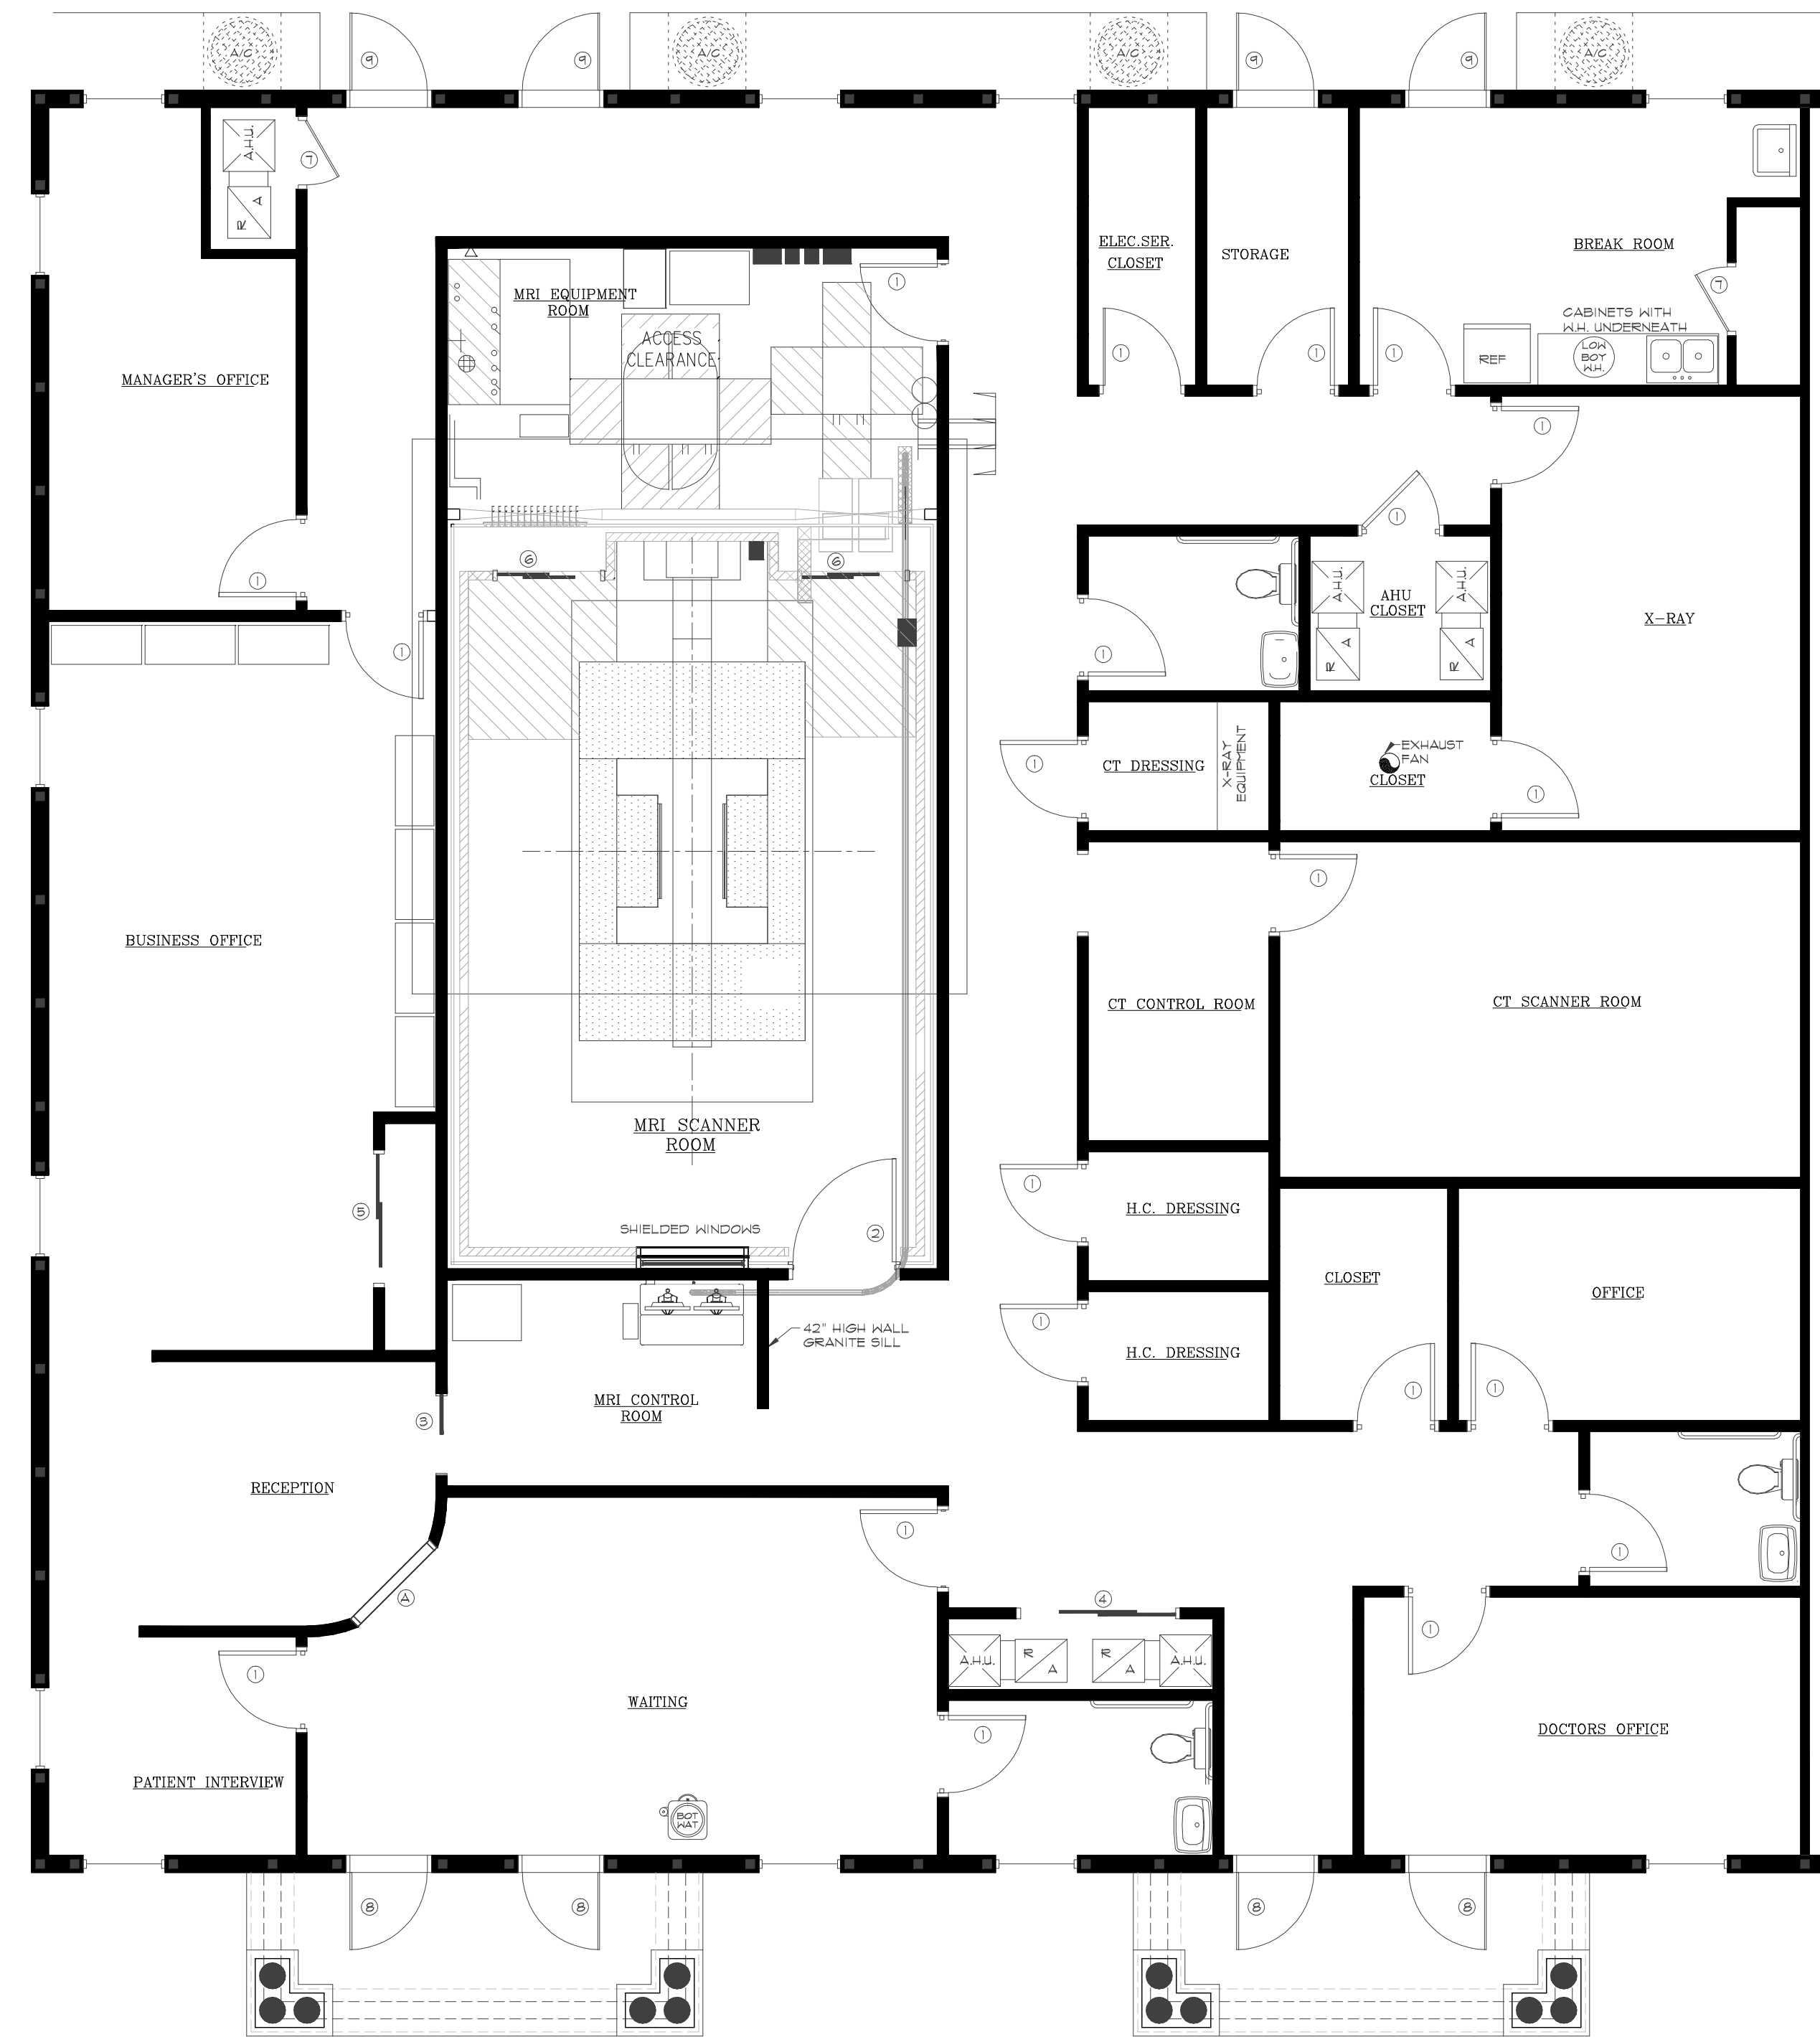

SPACE PLANNING LAYOUT #3  
UNITS 1, 2, 3, & 4 FLOOR PLAN 1/4"=1'-0"

PROJECT NAME: BLANK FOR SECURITY  
PROJECT LOCATION: BLANK FOR SECURITY

THIS AS-BUILT DRAWING WAS PREPARED BY:  
AS BUILT PROFESSIONALS  
A SERVICE OF A.E.C. CONSULTANTS INC.  
WWW.ASBUILTPROFESSIONALS.COM  
866.946.8642  
10/14/12

JOB NO.  
000-00-00

SHEET

AB-1 of AB-1