




FLOOR PLAN 24,000 SQ. FT. 1/16"=1'-0"

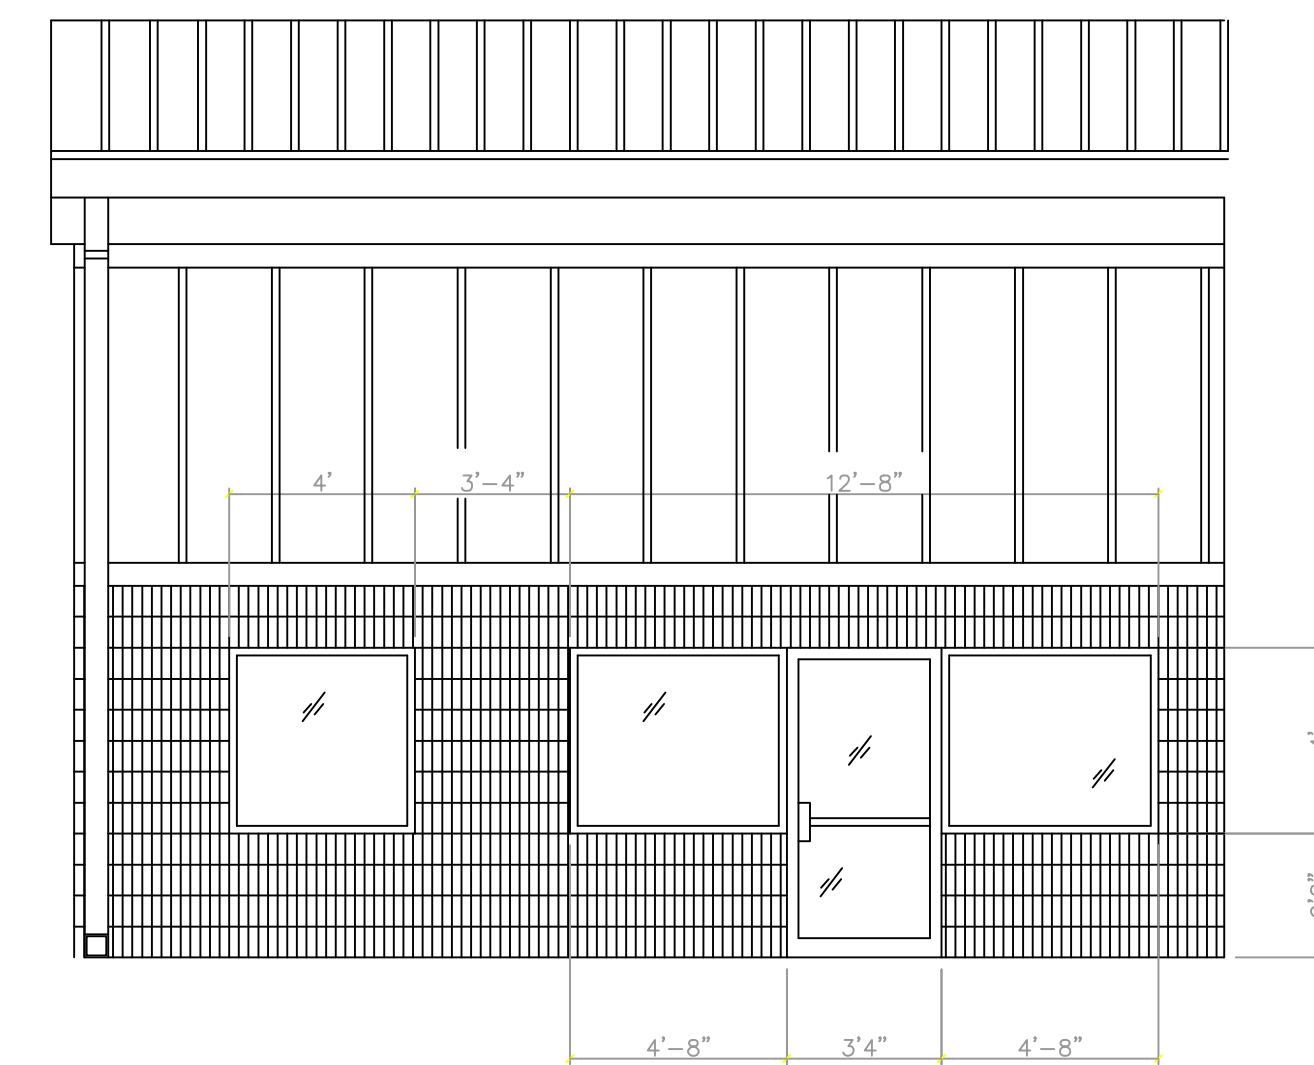


ENLARGED FRONT WINDOW/DOOR ELEVATION 1/4"=1'-0"

DOOR SCHEDULE									
LBL.	STYLE	W	H	LATCH AND LEVER	LOCKING DEVICE	FIRE RATING	VIEW PANEL	PANIC OR FIRE EXIT HARDWARE	HYDRAULIC DOOR CLOSER
A	ALUM GLASS	36"	80"	NO	YES	0 MIN.	YES	NO	YES
B	MTL FLUSH	36"	80"	YES	YES	0 MIN.	NO	NO	YES


WINDOW SCHEDULE						
LBL.	STYLE	W	H	FRAME	FRAME COLOR	SILL
1	SINGLE HUNG	48"	48"	ALUM.	WHITE	CULT. MARB.
2	SINGLE HUNG	56"	48"	ALUM.	WHITE	MARB.

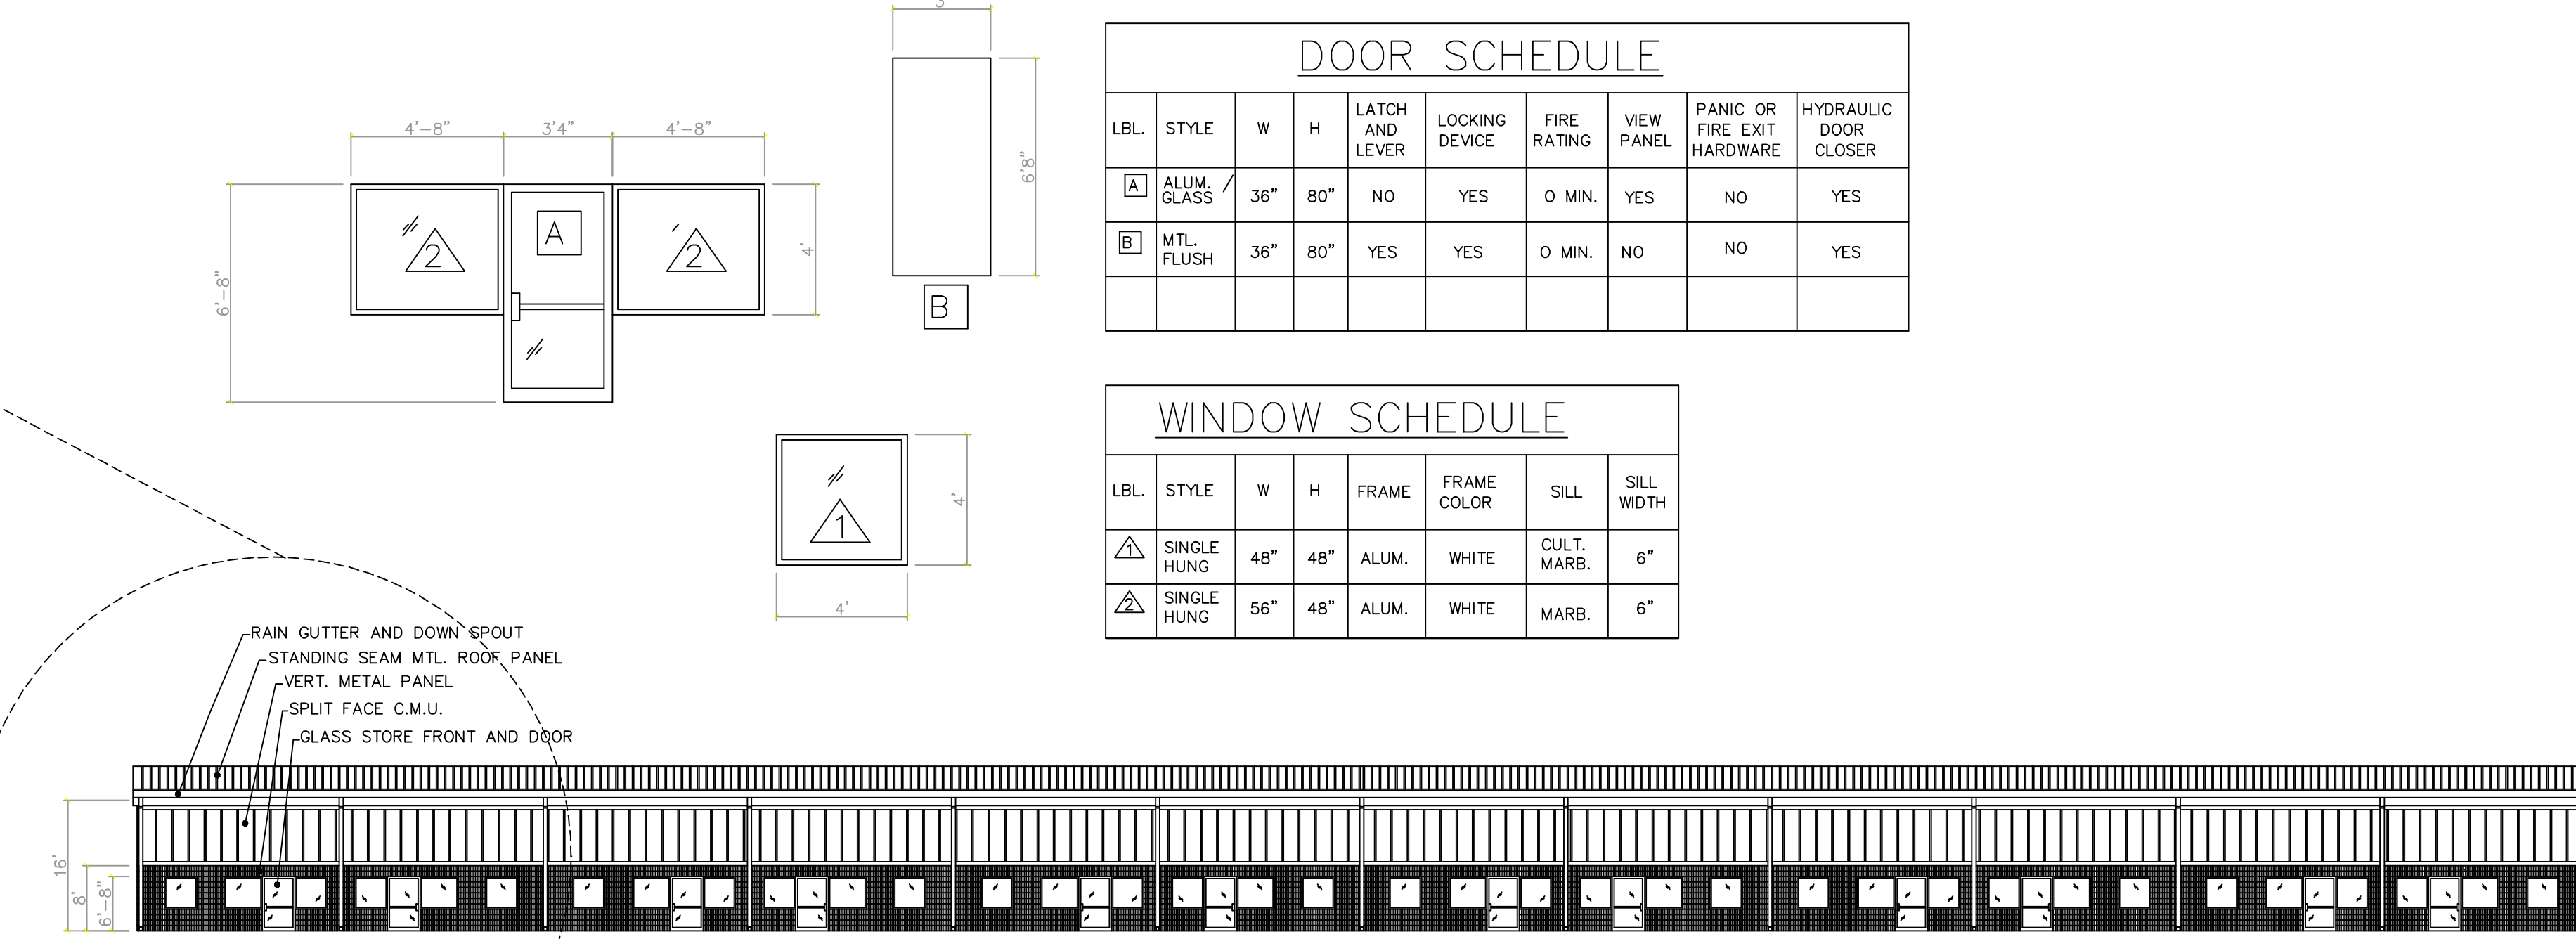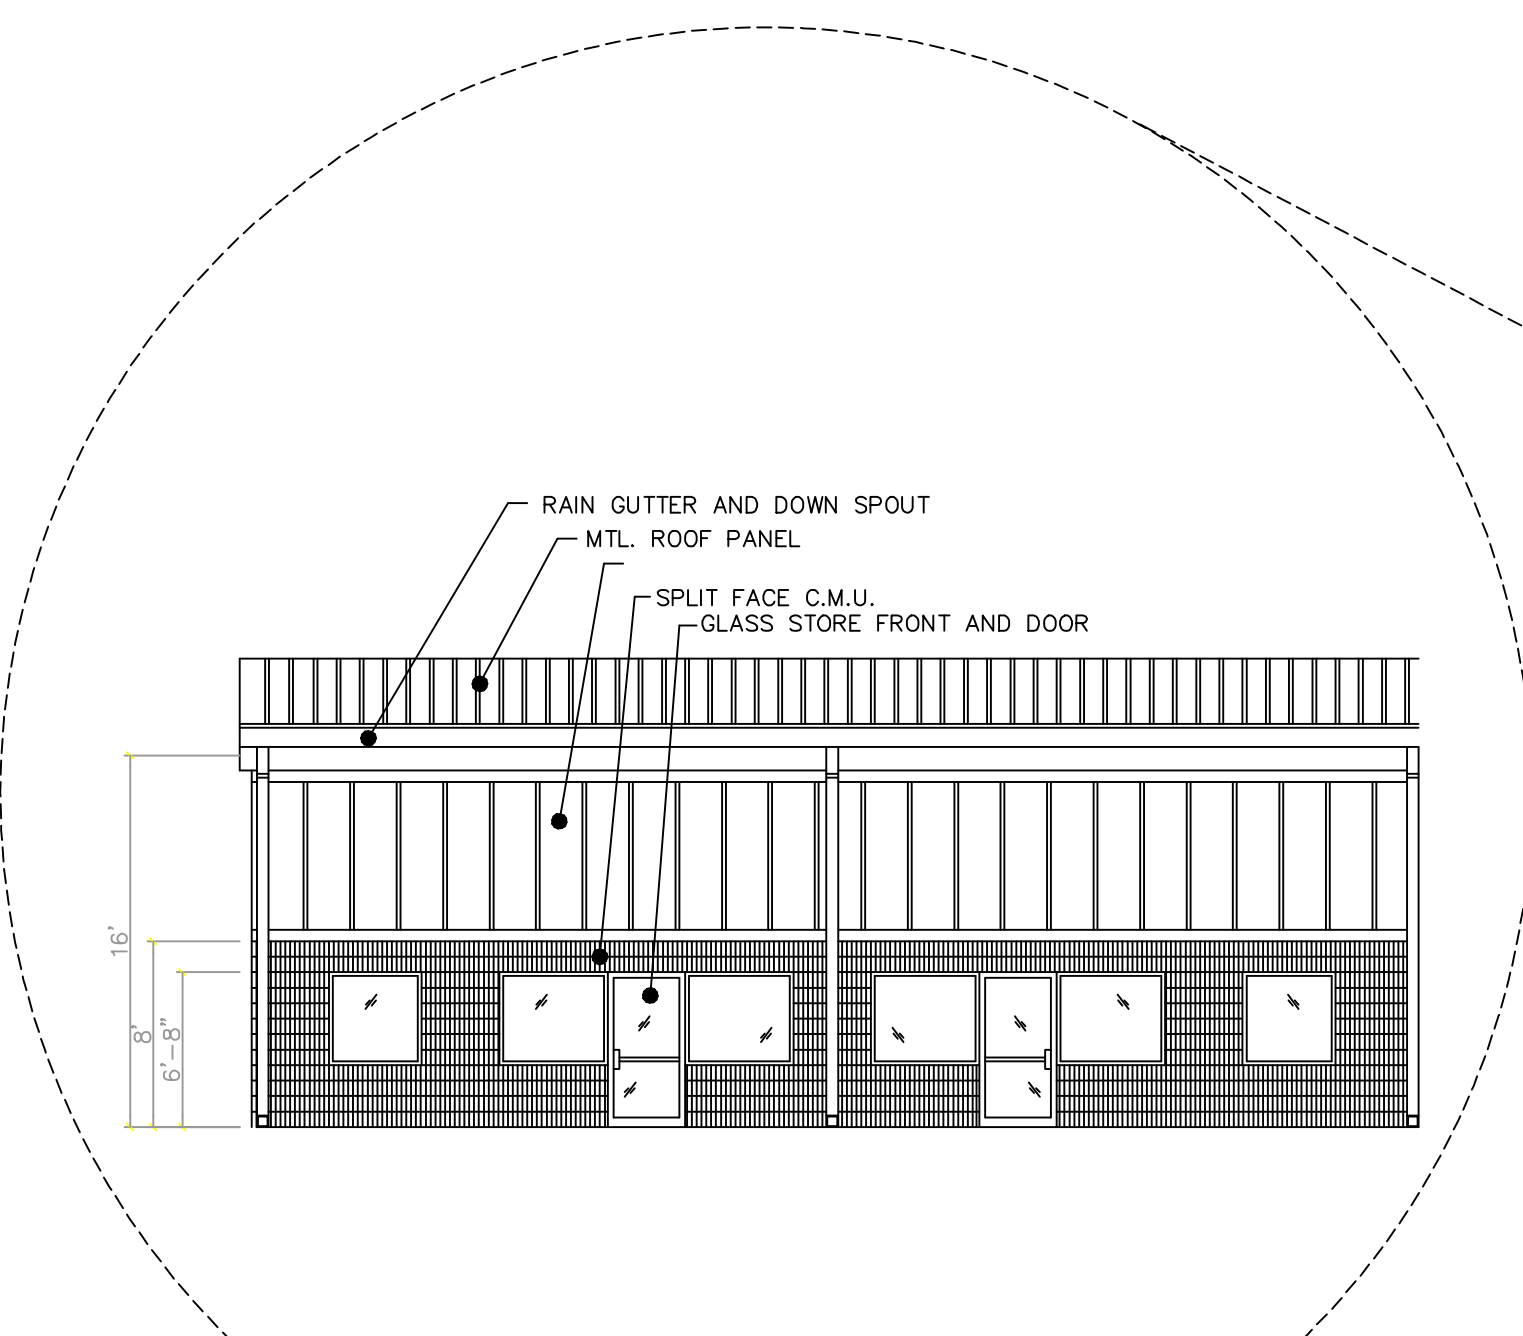


FRONT ELEVATION 1/16"=1'-0"

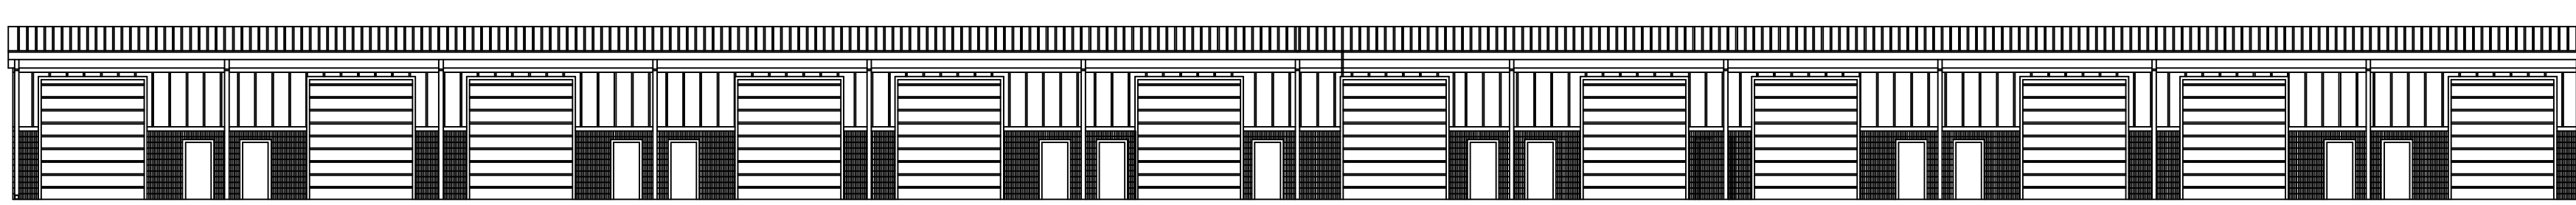


REAR ELEVATION 1/16"=1'-0"

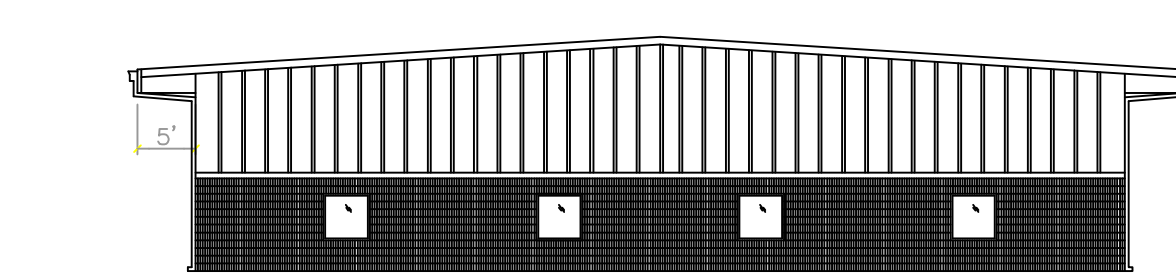


LEFT SIDE ELEVATION 1/16"=1'-0"

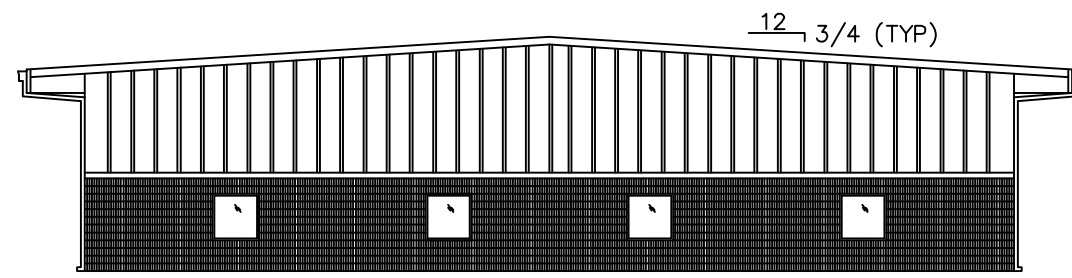

RIGHT SIDE ELEVATION 1/16"=1'-0"

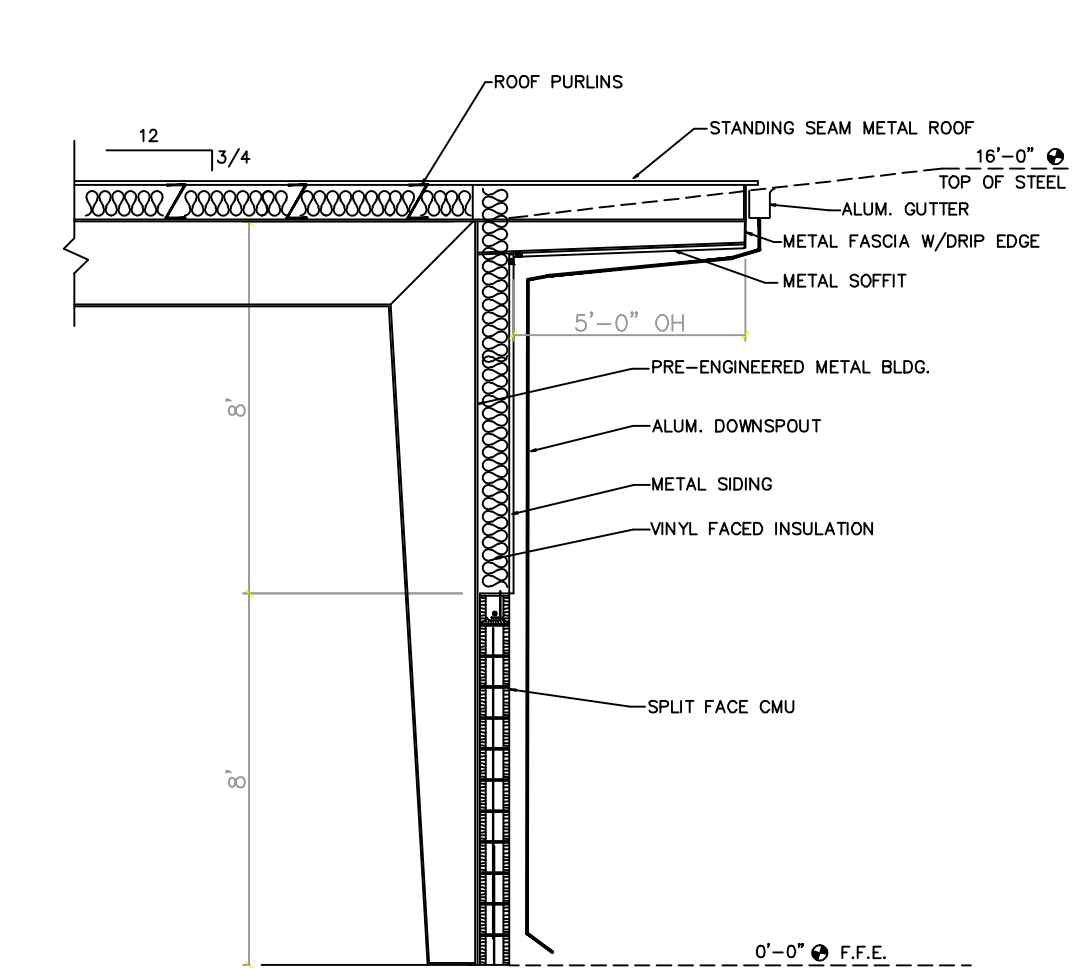

S-1 WALL SECTION 1/4" = 1'-0"

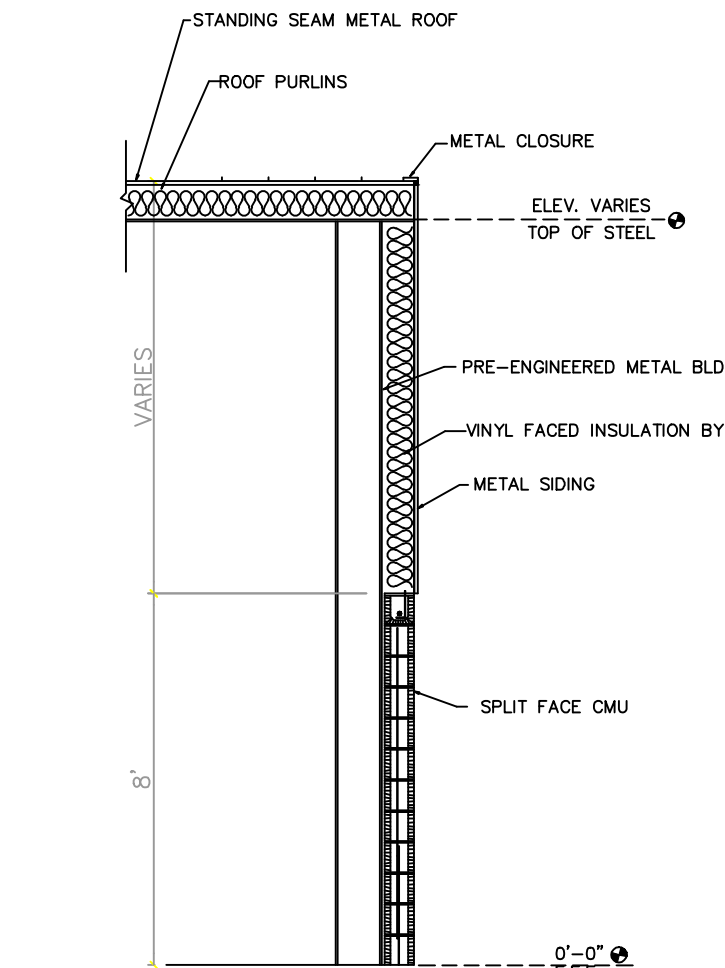

S-2 WALL SECTION 1/42" = 1'-0"

PROJECT NAME: BLANK FOR SECURITY
PROJECT LOCATION BLANK FOR SECURITY

THIS AS-BUILT DRAWING WAS PREPARED BY:
AS BUILT PROFESSIONALS
A SERVICE OF A.E.C. CONSULTANTS INC.
WWW.ASBUILTPROFESSIONALS.COM
866-903-8842
INL/ML

JOB NO.
000-00-00

SHEET
AB-1 of AB-1