




SECOND FLOOR PLAN 1/8"=1'-0" 

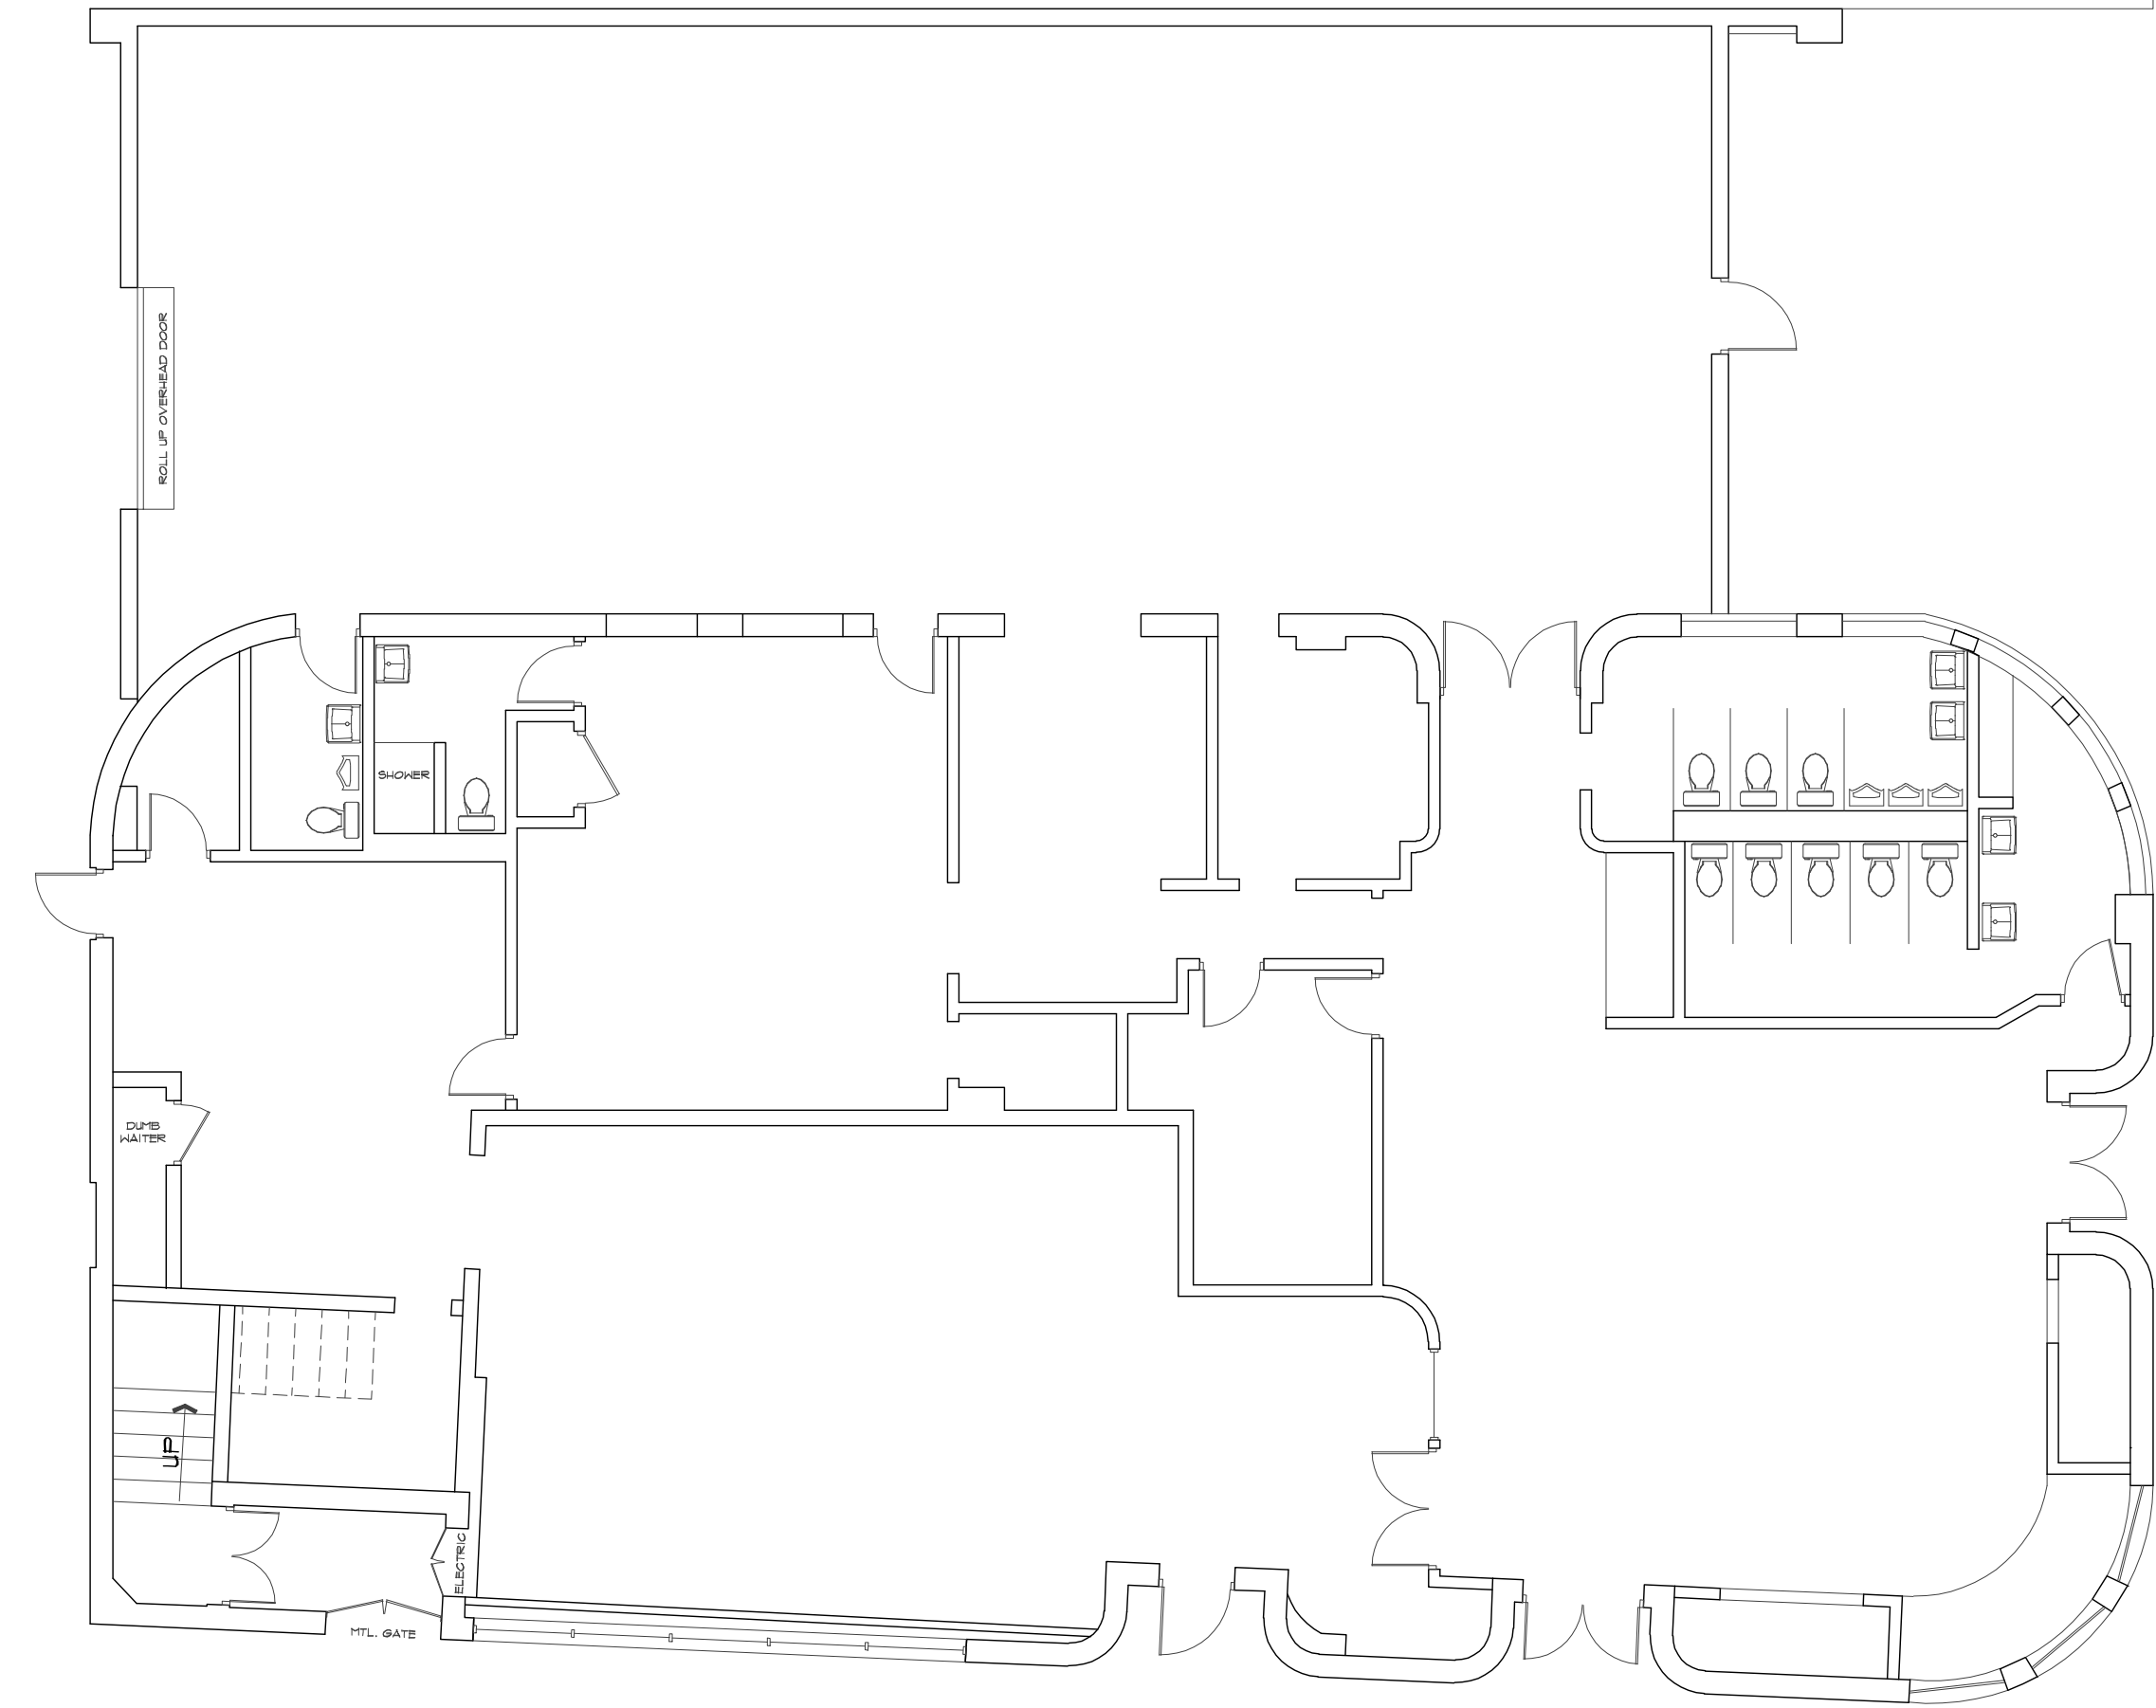

FIRST FLOOR PLAN 1/8"=1'-0" 

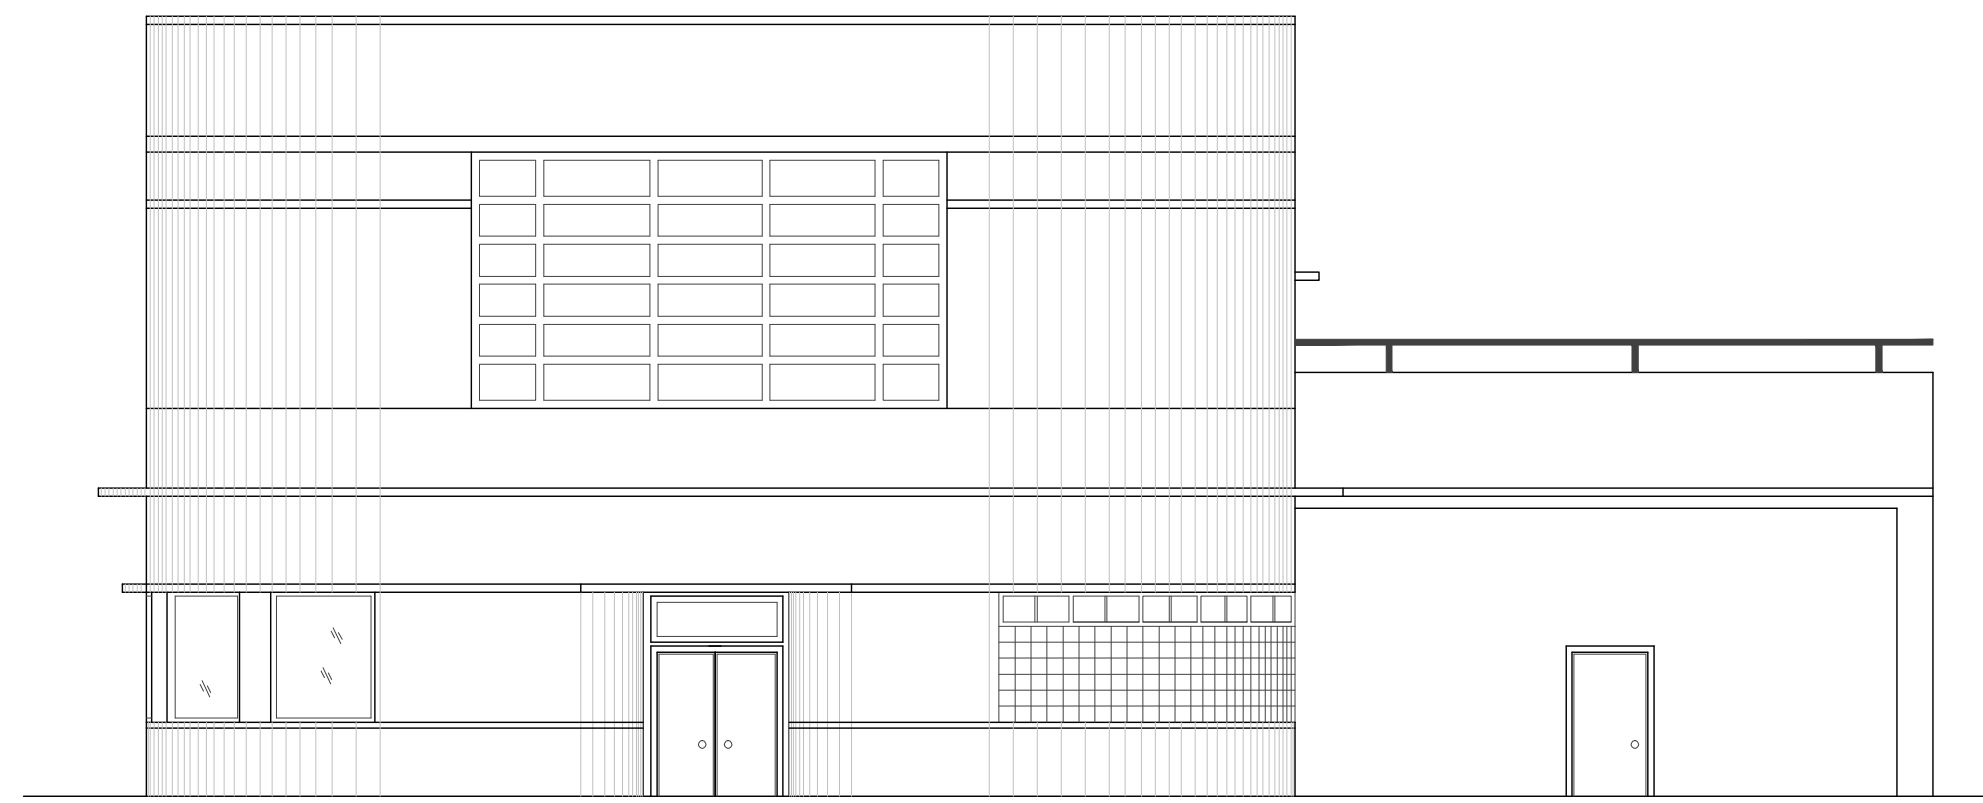


FRONT ELEVATION (INTERNATIONAL SPEEDWAY BLVD.) 1/8"=1'-0"

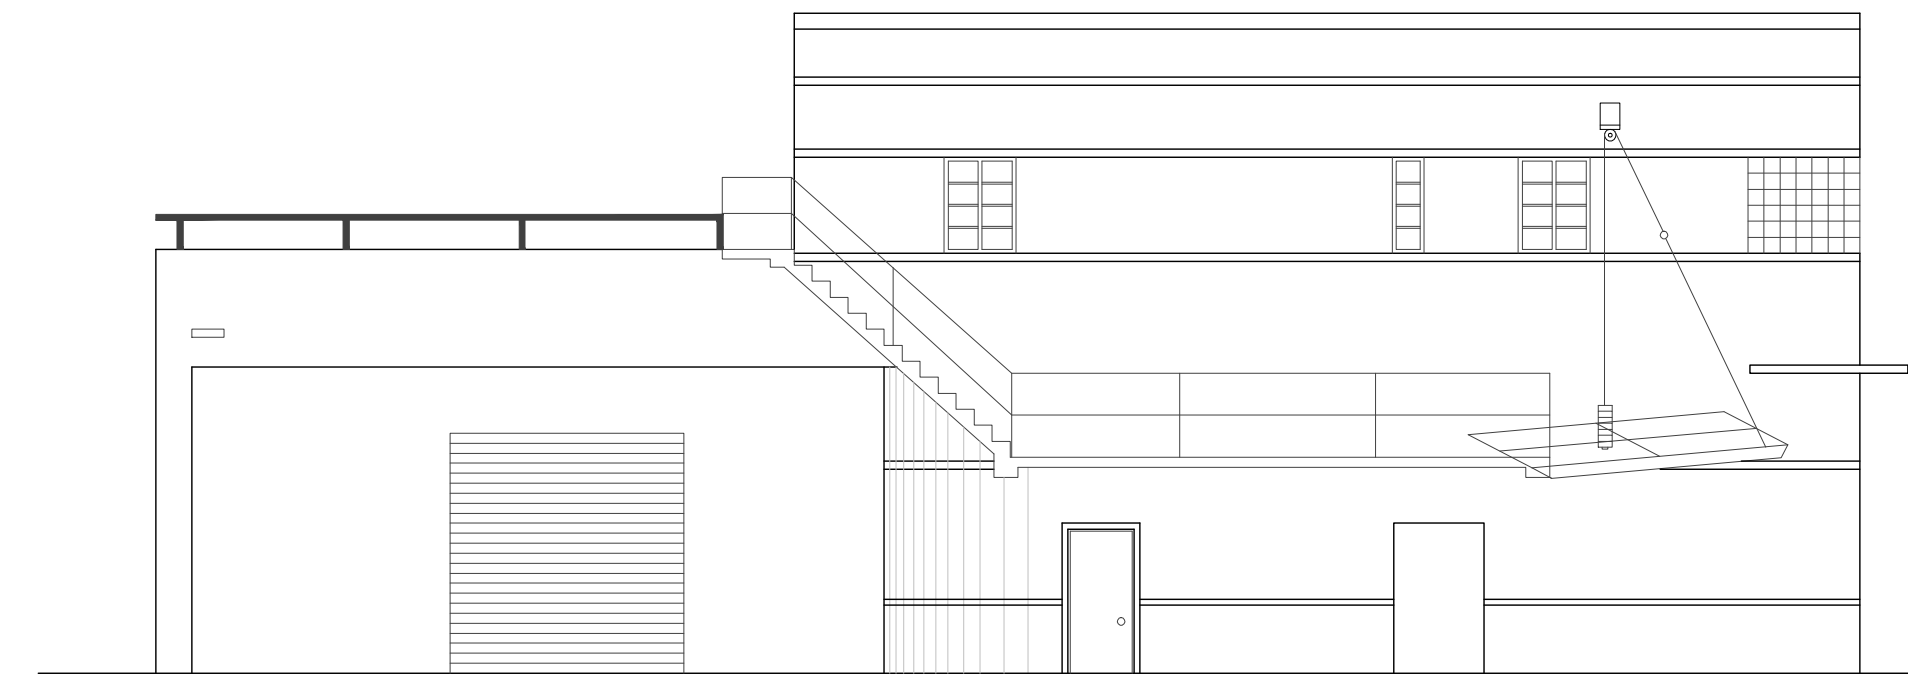


REAR ELEVATION 1/8"=1'-0"




LEFT SIDE ELEVATION 1/8"=1'-0"

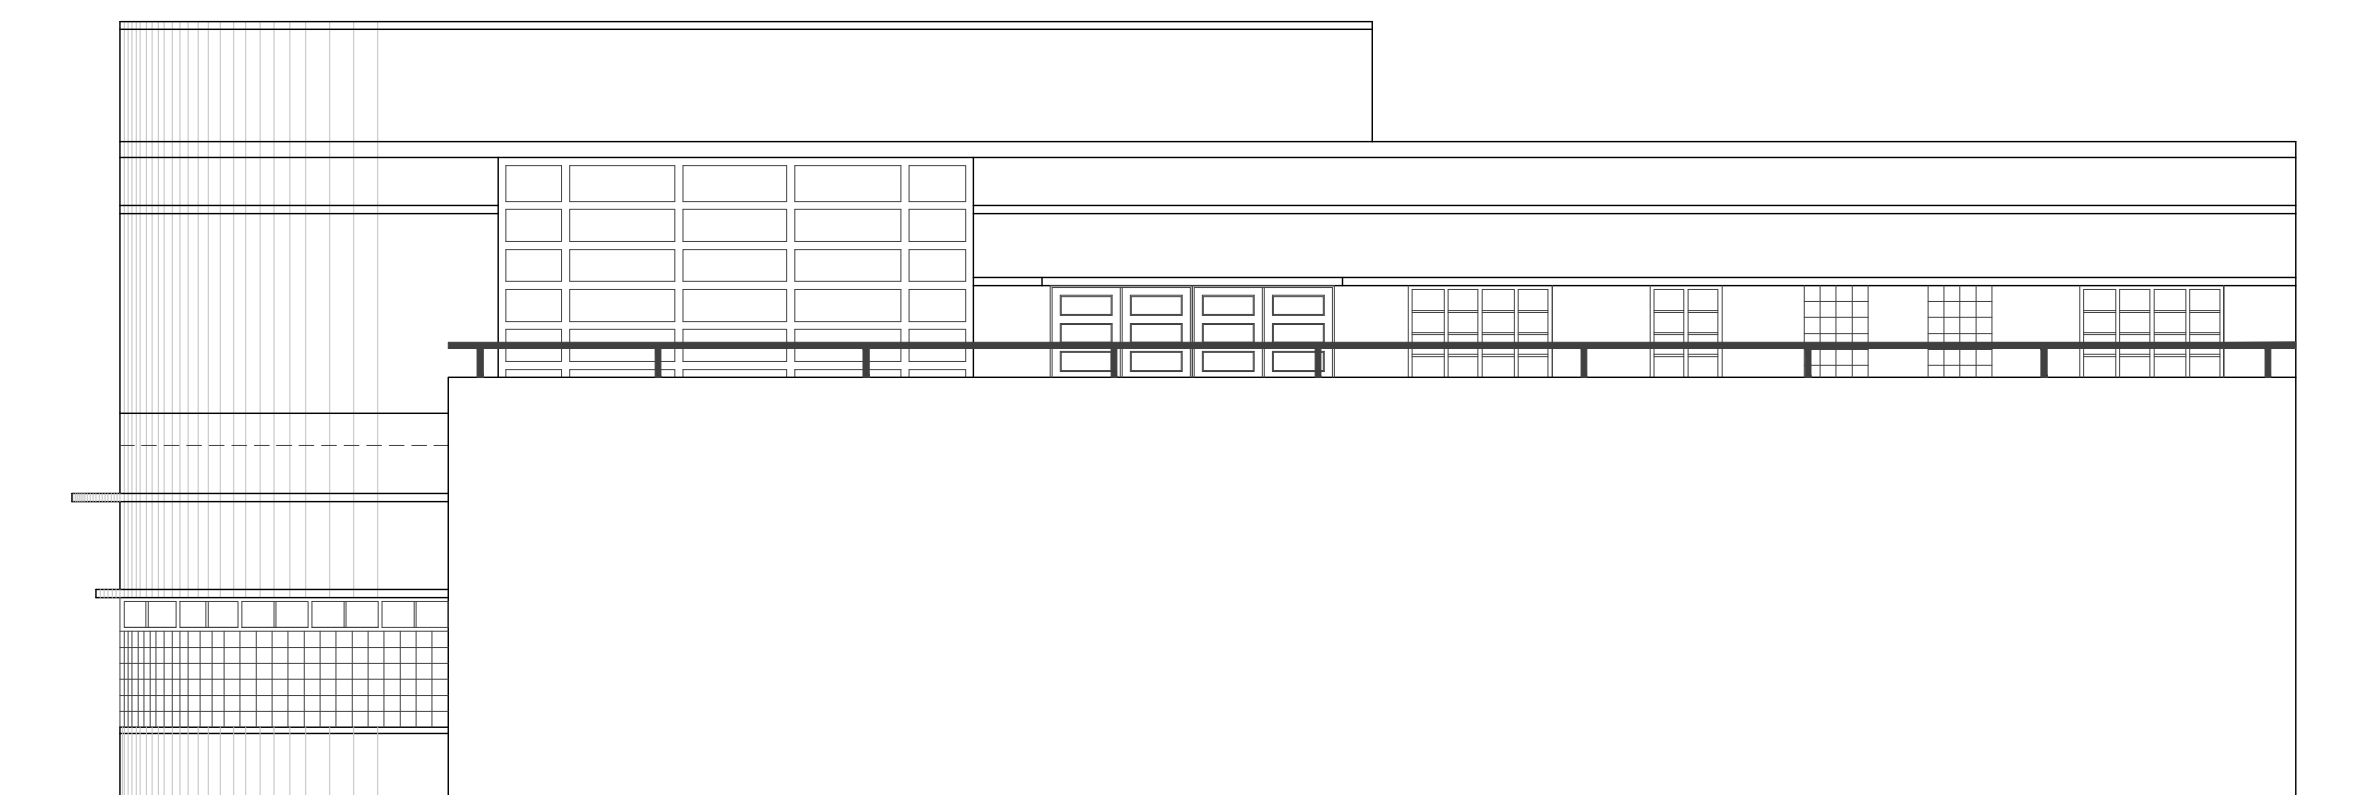

RIGHT SIDE ELEVATION 1/8"=1'-0"

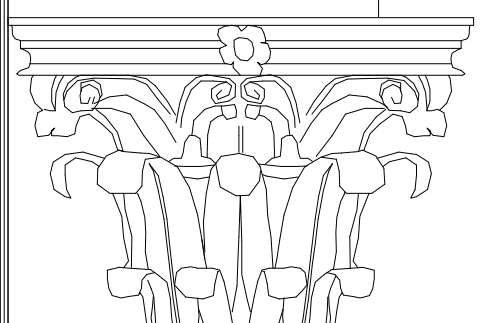

PROJECT NAME: BLANK FOR SECURITY
PROJECT LOCATION: BLANK FOR SECURITY

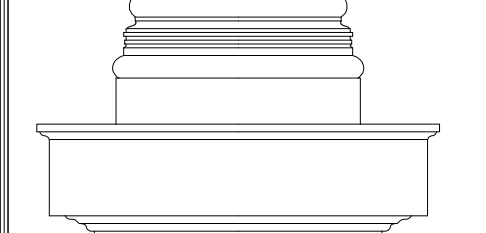

THIS AS-BUILT DRAWING WAS PREPARED BY:
AS BUILT PROFESSIONALS
A SERVICE OF A.B.C. CONSULTANTS INC.
WWW.ASBUILTPROFESSIONALS.COM
866.846.8642
10/1/2018

JOB NO.
000-00-00

SHEET

AB-1 of AB-1