



BOT OF ROOF EL = 20'-8"
 EAVE EL = 19'-10"
 TOP OF WINDOW EL = 17'-6"
 FINISHED FLOOR EL = 10'-6"
 TOP OF WINDOW EL = 7'-1"
 FINISHED FLOOR EL = 0'-0"

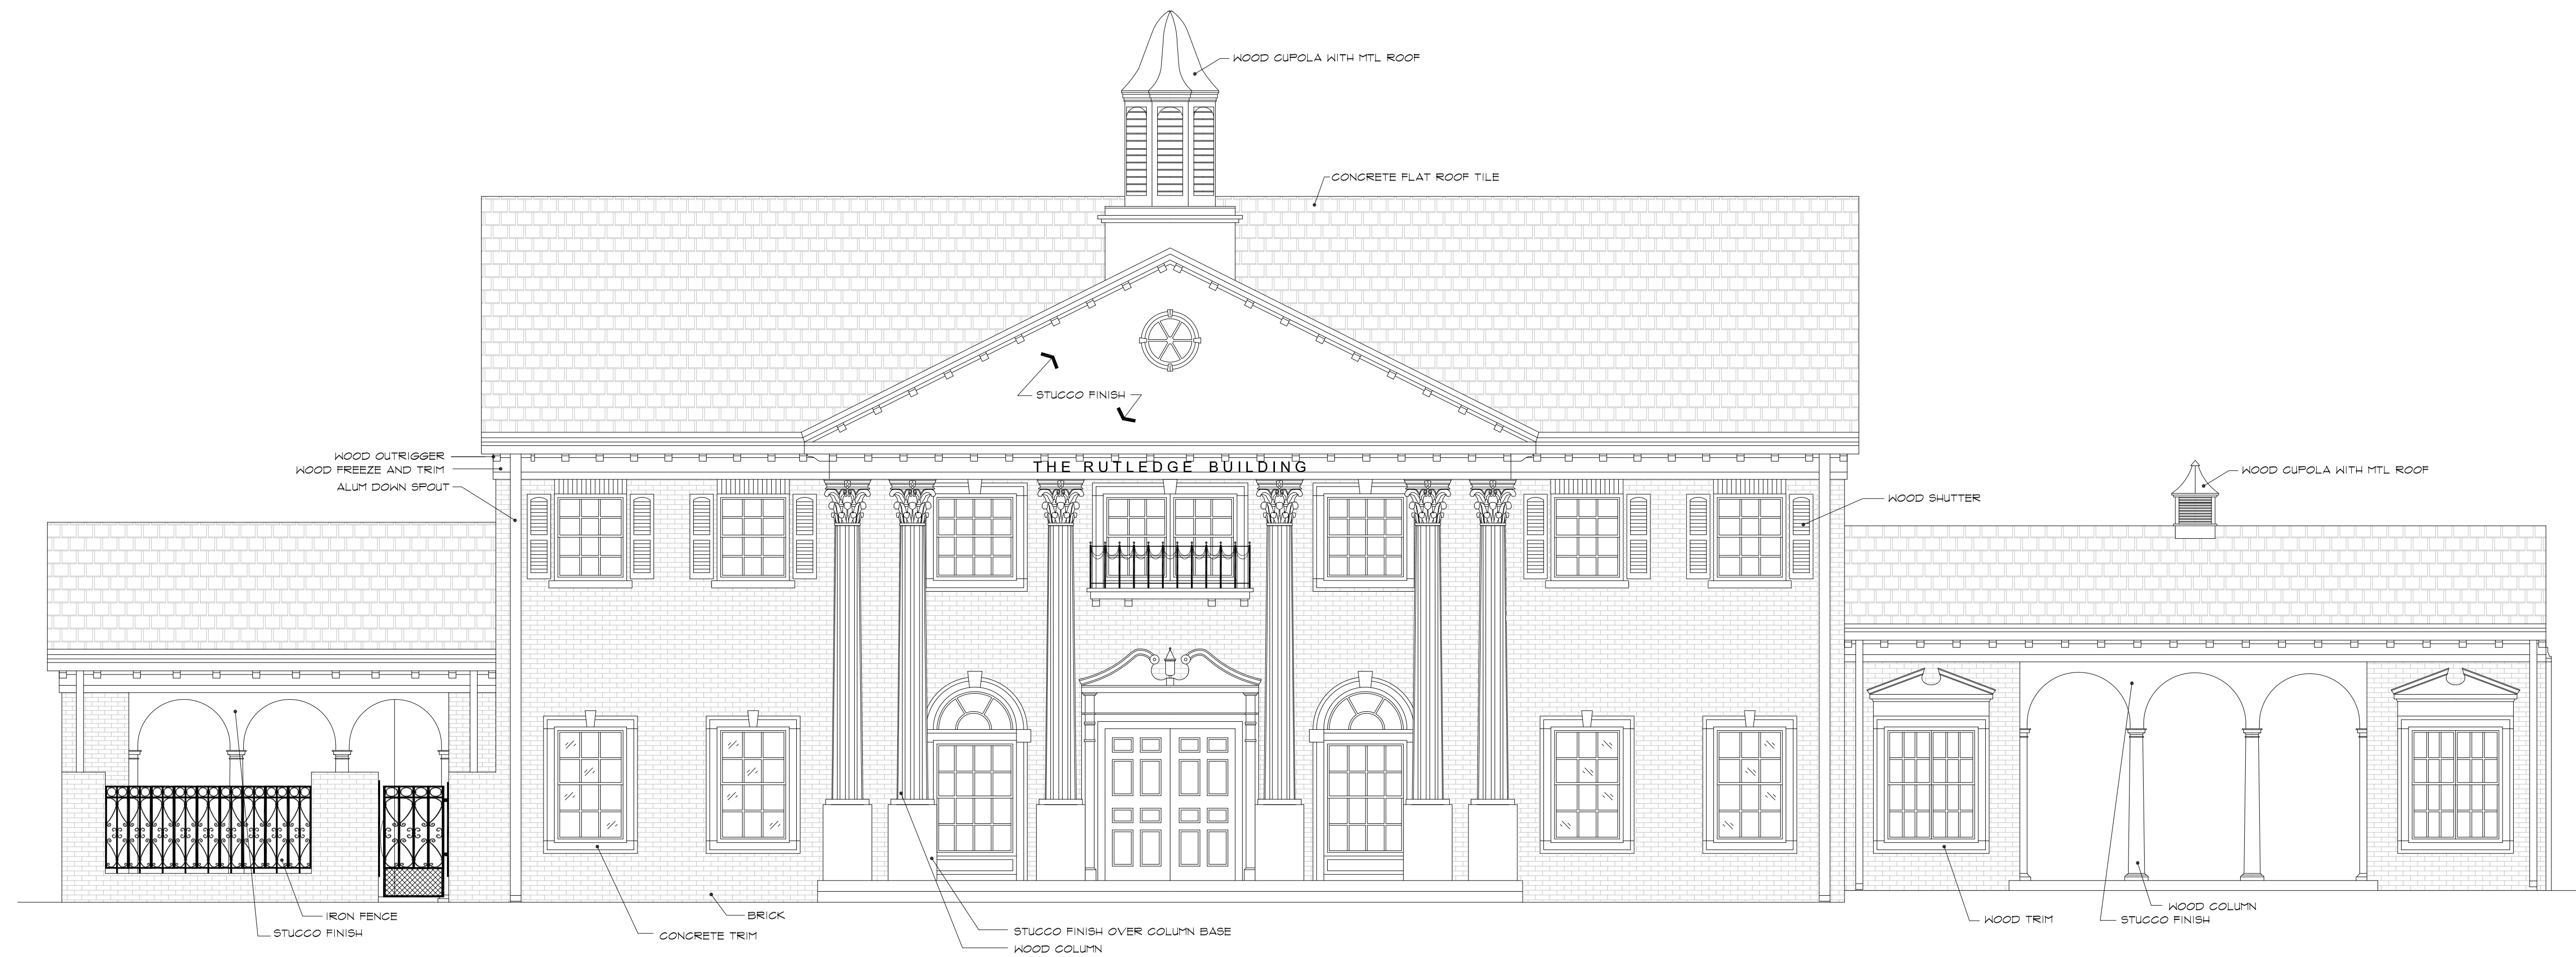

FRONT ELEVATION 1/4"=1'-0"

BOT OF ROOF EL = 20'-8"
 EAVE EL = 19'-10"
 TOP OF WINDOW EL = 17'-6"
 FINISHED FLOOR EL = 10'-6"
 TOP OF WINDOW EL = 7'-1"
 FINISHED FLOOR EL = 0'-0"

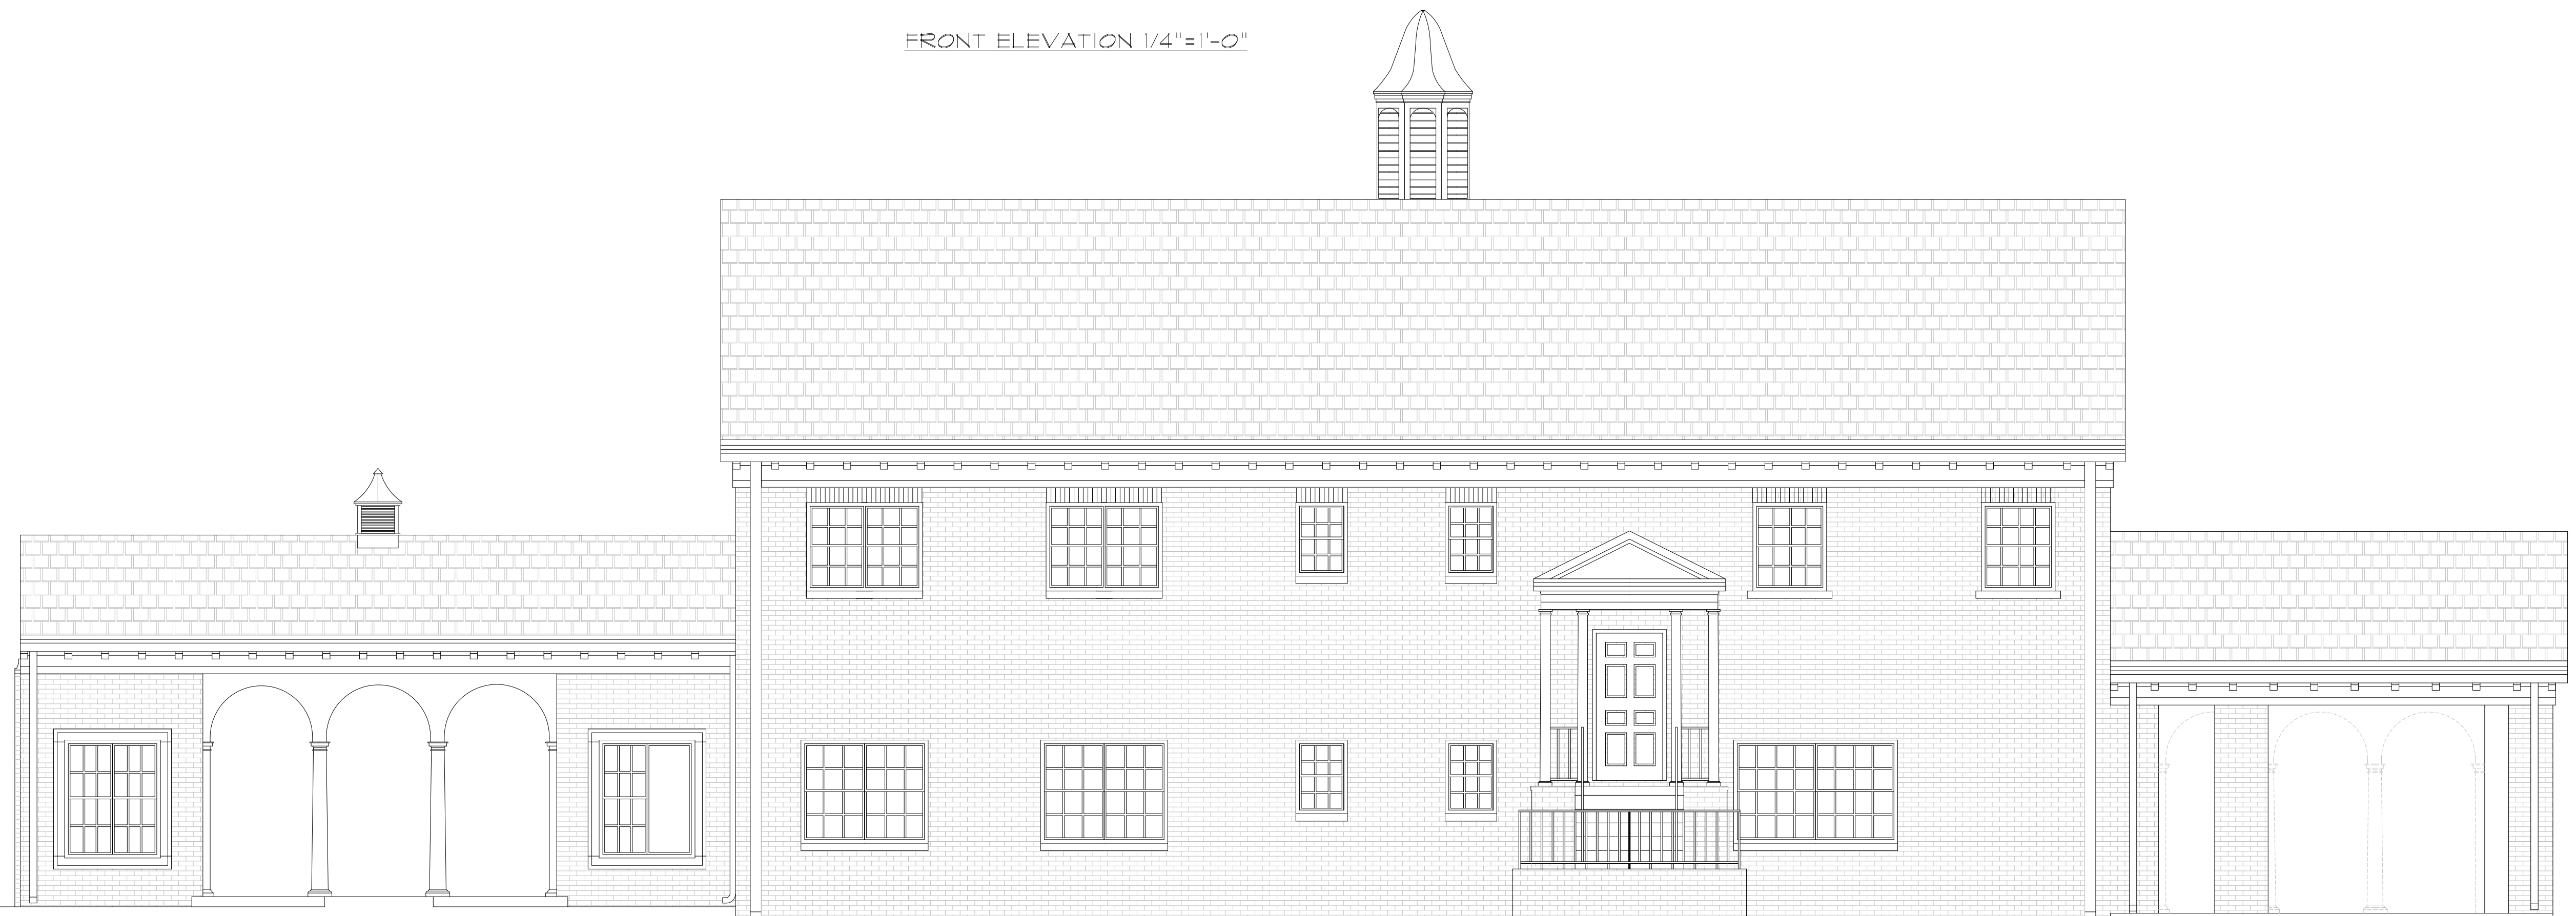

REAR ELEVATION 1/4"=1'-0"


PROJECT NAME: BLANK FOR SECURITY
 PROJECT LOCATION: BLANK FOR SECURITY

THIS AS-BUILT DRAWING WAS PREPARED BY:
 AS BUILT PROFESSIONALS
 A SERVICE OF A.E.C. CONSULTANTS INC.
 WWW.ASBUILTPROFESSIONALS.COM
 865-203-8842
 TXL, TEX

JOB NO.
 000-00-00


SHEET
 AB-1 of AB-1

BOT OF ROOF EL = 20'-8"
 EAVE EL = 18'-10"
 TOP OF WINDOW EL = 17'-6"
 FINISHED FLOOR EL = 10'-6"
 TOP OF WINDOW EL = 7'-11"
 FINISHED FLOOR EL = 0'-0"

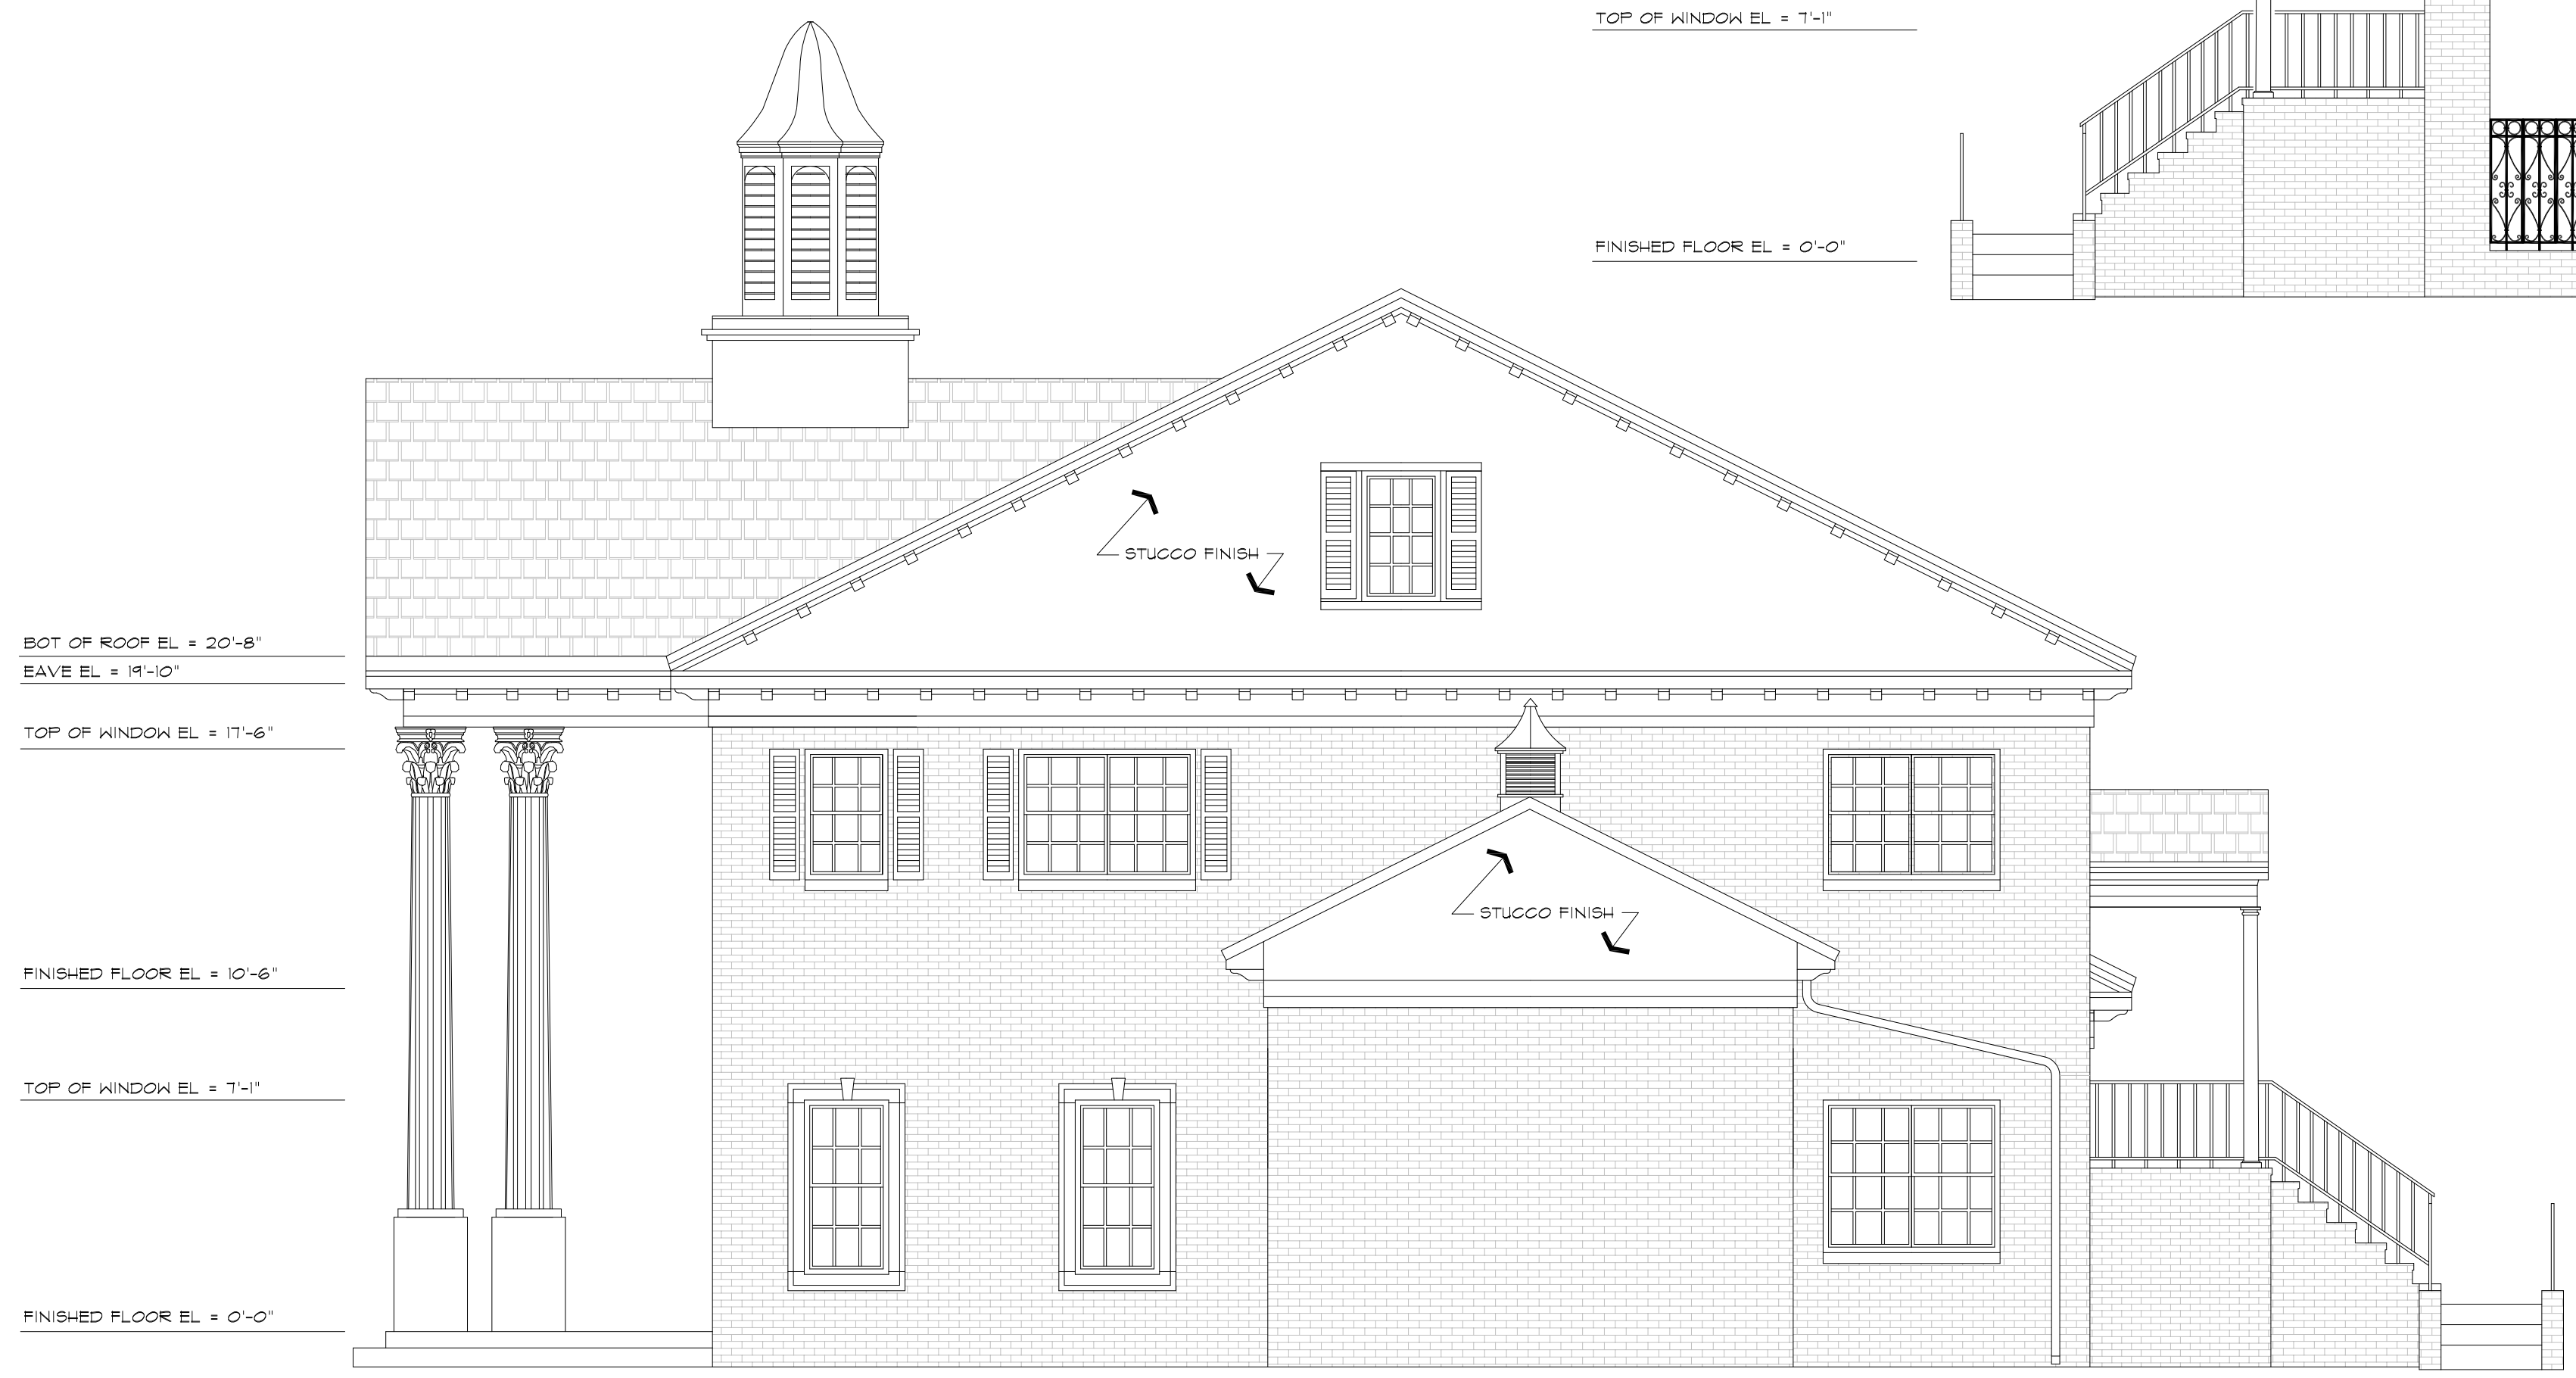

RIGHT SIDE ELEVATION 1/4"=1'-0"

BOT OF ROOF EL = 20'-8"
 EAVE EL = 18'-10"
 TOP OF WINDOW EL = 17'-6"
 FINISHED FLOOR EL = 10'-6"
 TOP OF WINDOW EL = 7'-11"
 FINISHED FLOOR EL = 0'-0"

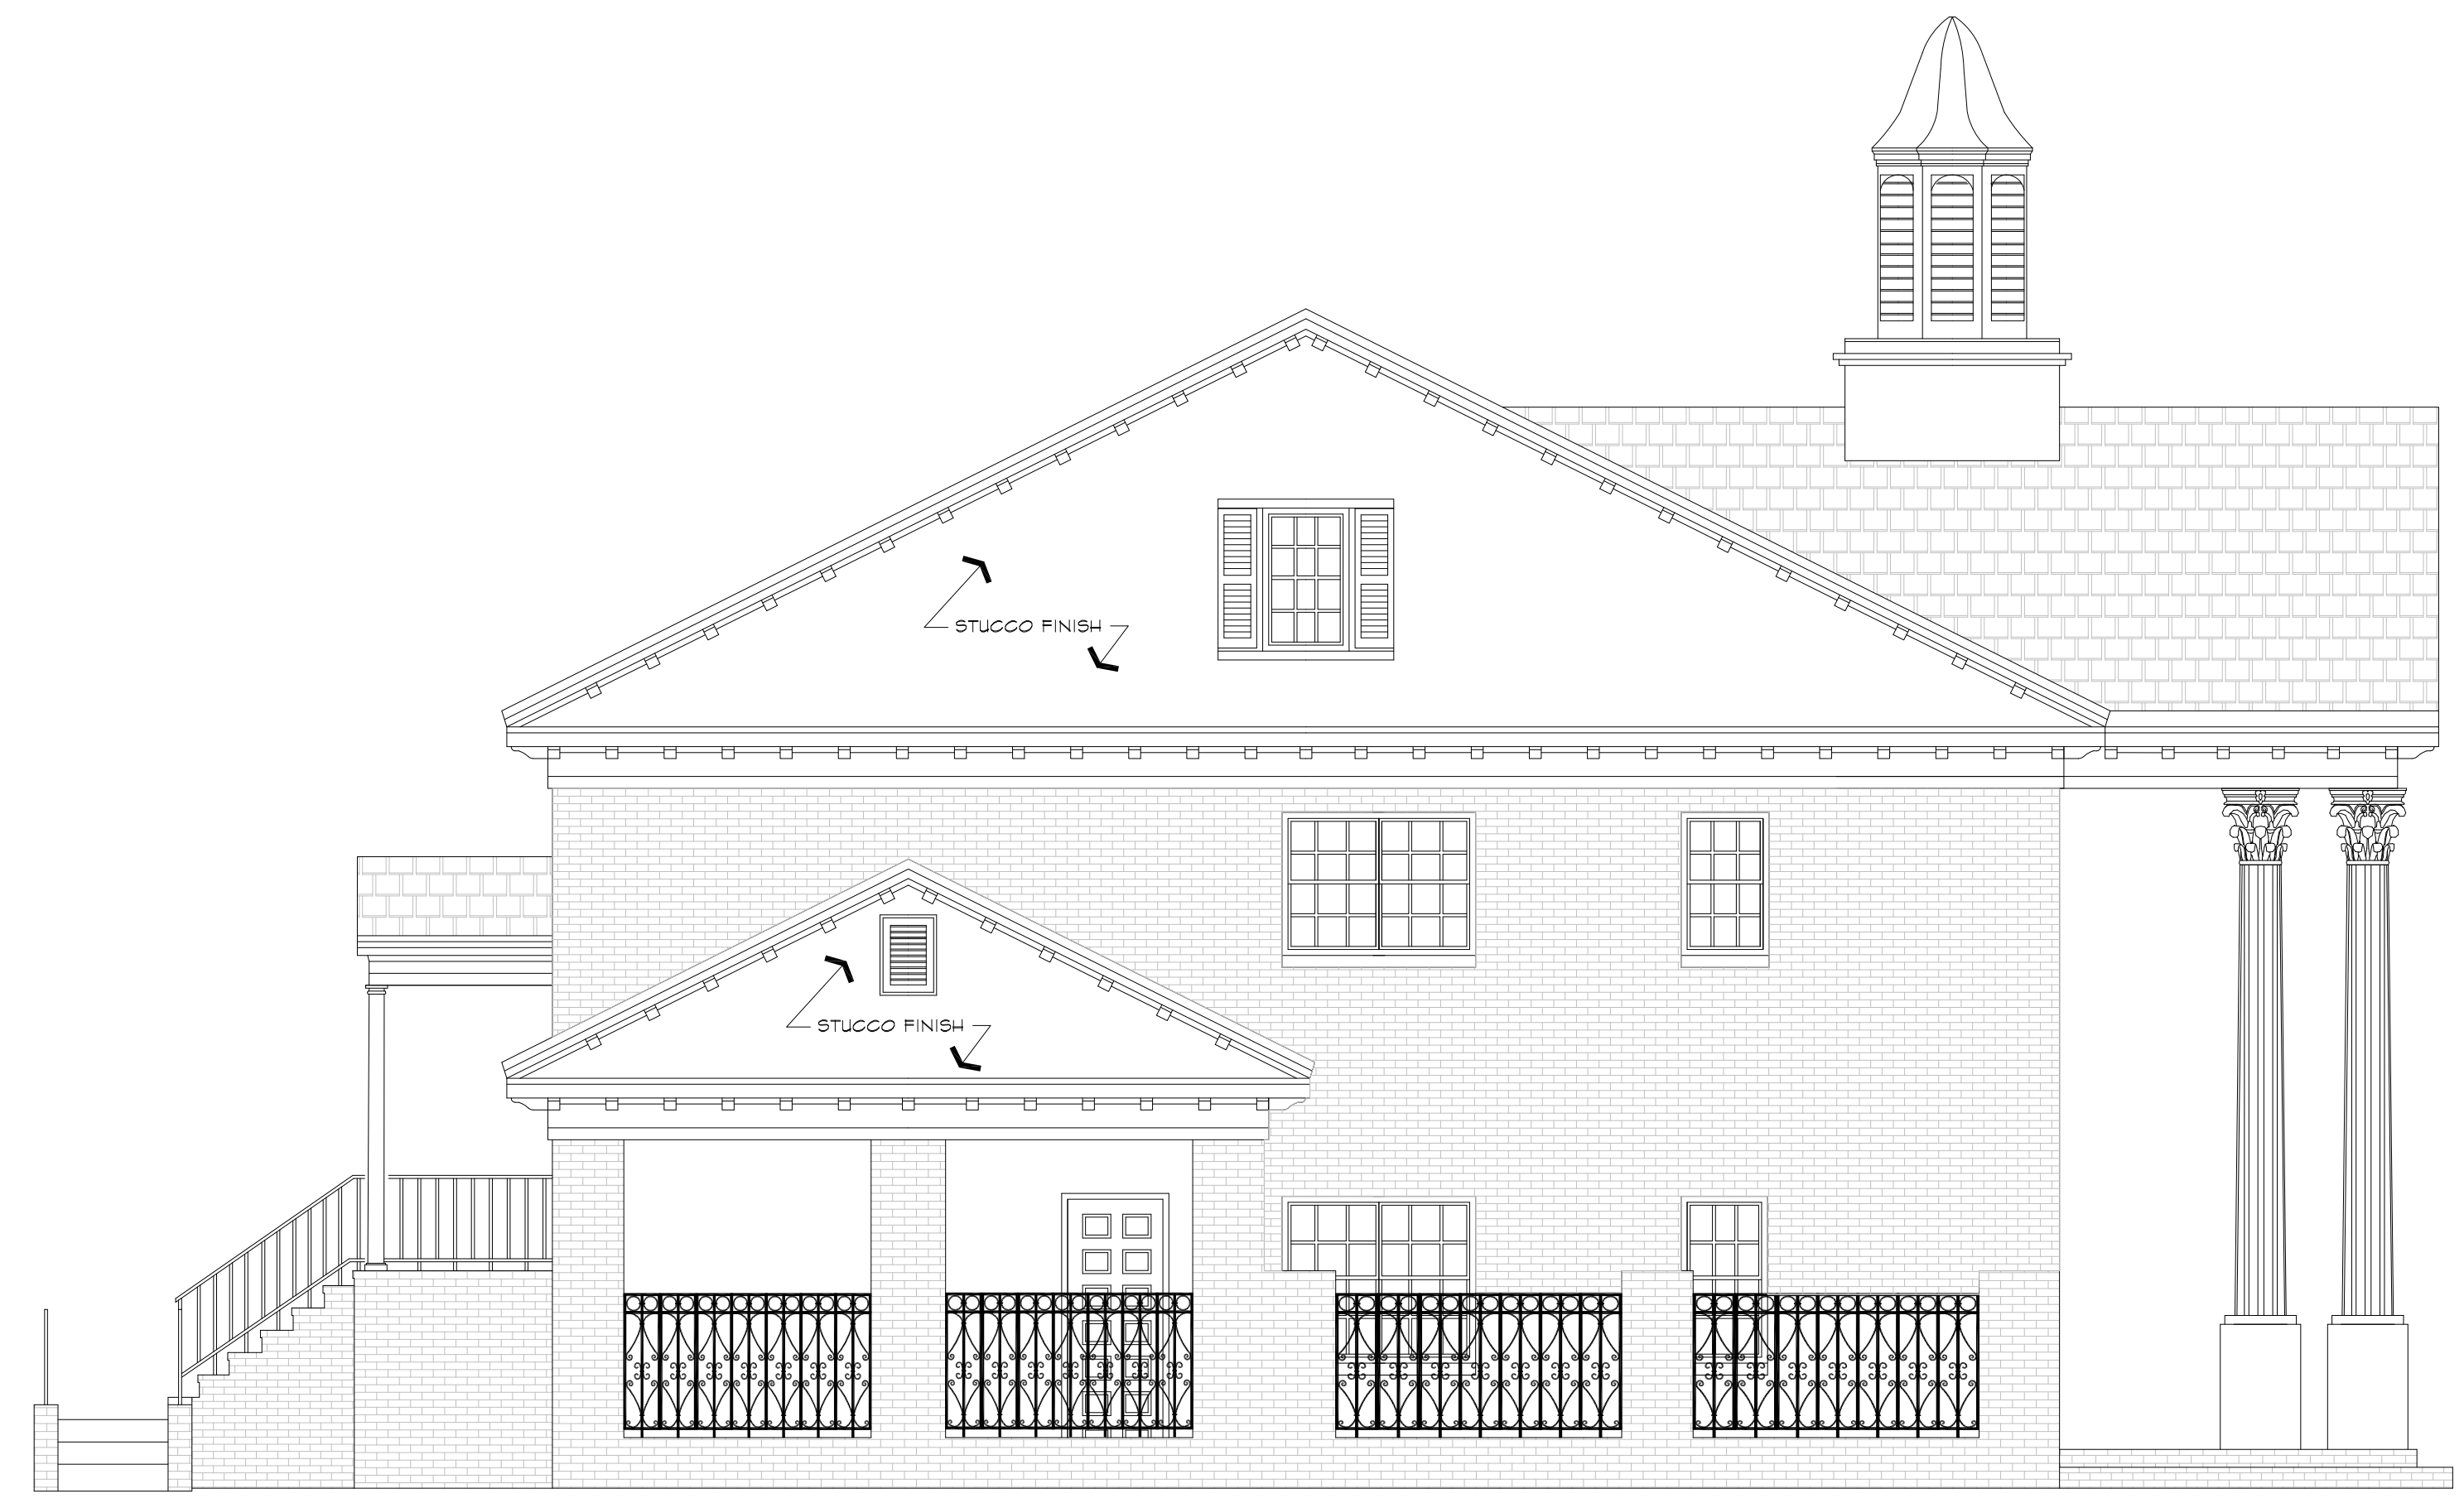


LEFT SIDE ELEVATION 1/4"=1'-0"

PROJECT NAME: BLANK FOR SECURITY
 PROJECT LOCATION: BLANK FOR SECURITY

THIS AS-BUILT DRAWING WAS PREPARED BY:
 AS BUILT PROFESSIONALS
 A SERVICE OF A.E.C. CONSULTANTS INC.
 WWW.ASBUILTPROFESSIONALS.COM
 866-203-8842
 TXL, TEX

JOB NO.
 000-00-00

SHEET
 AB-1 of AB-1

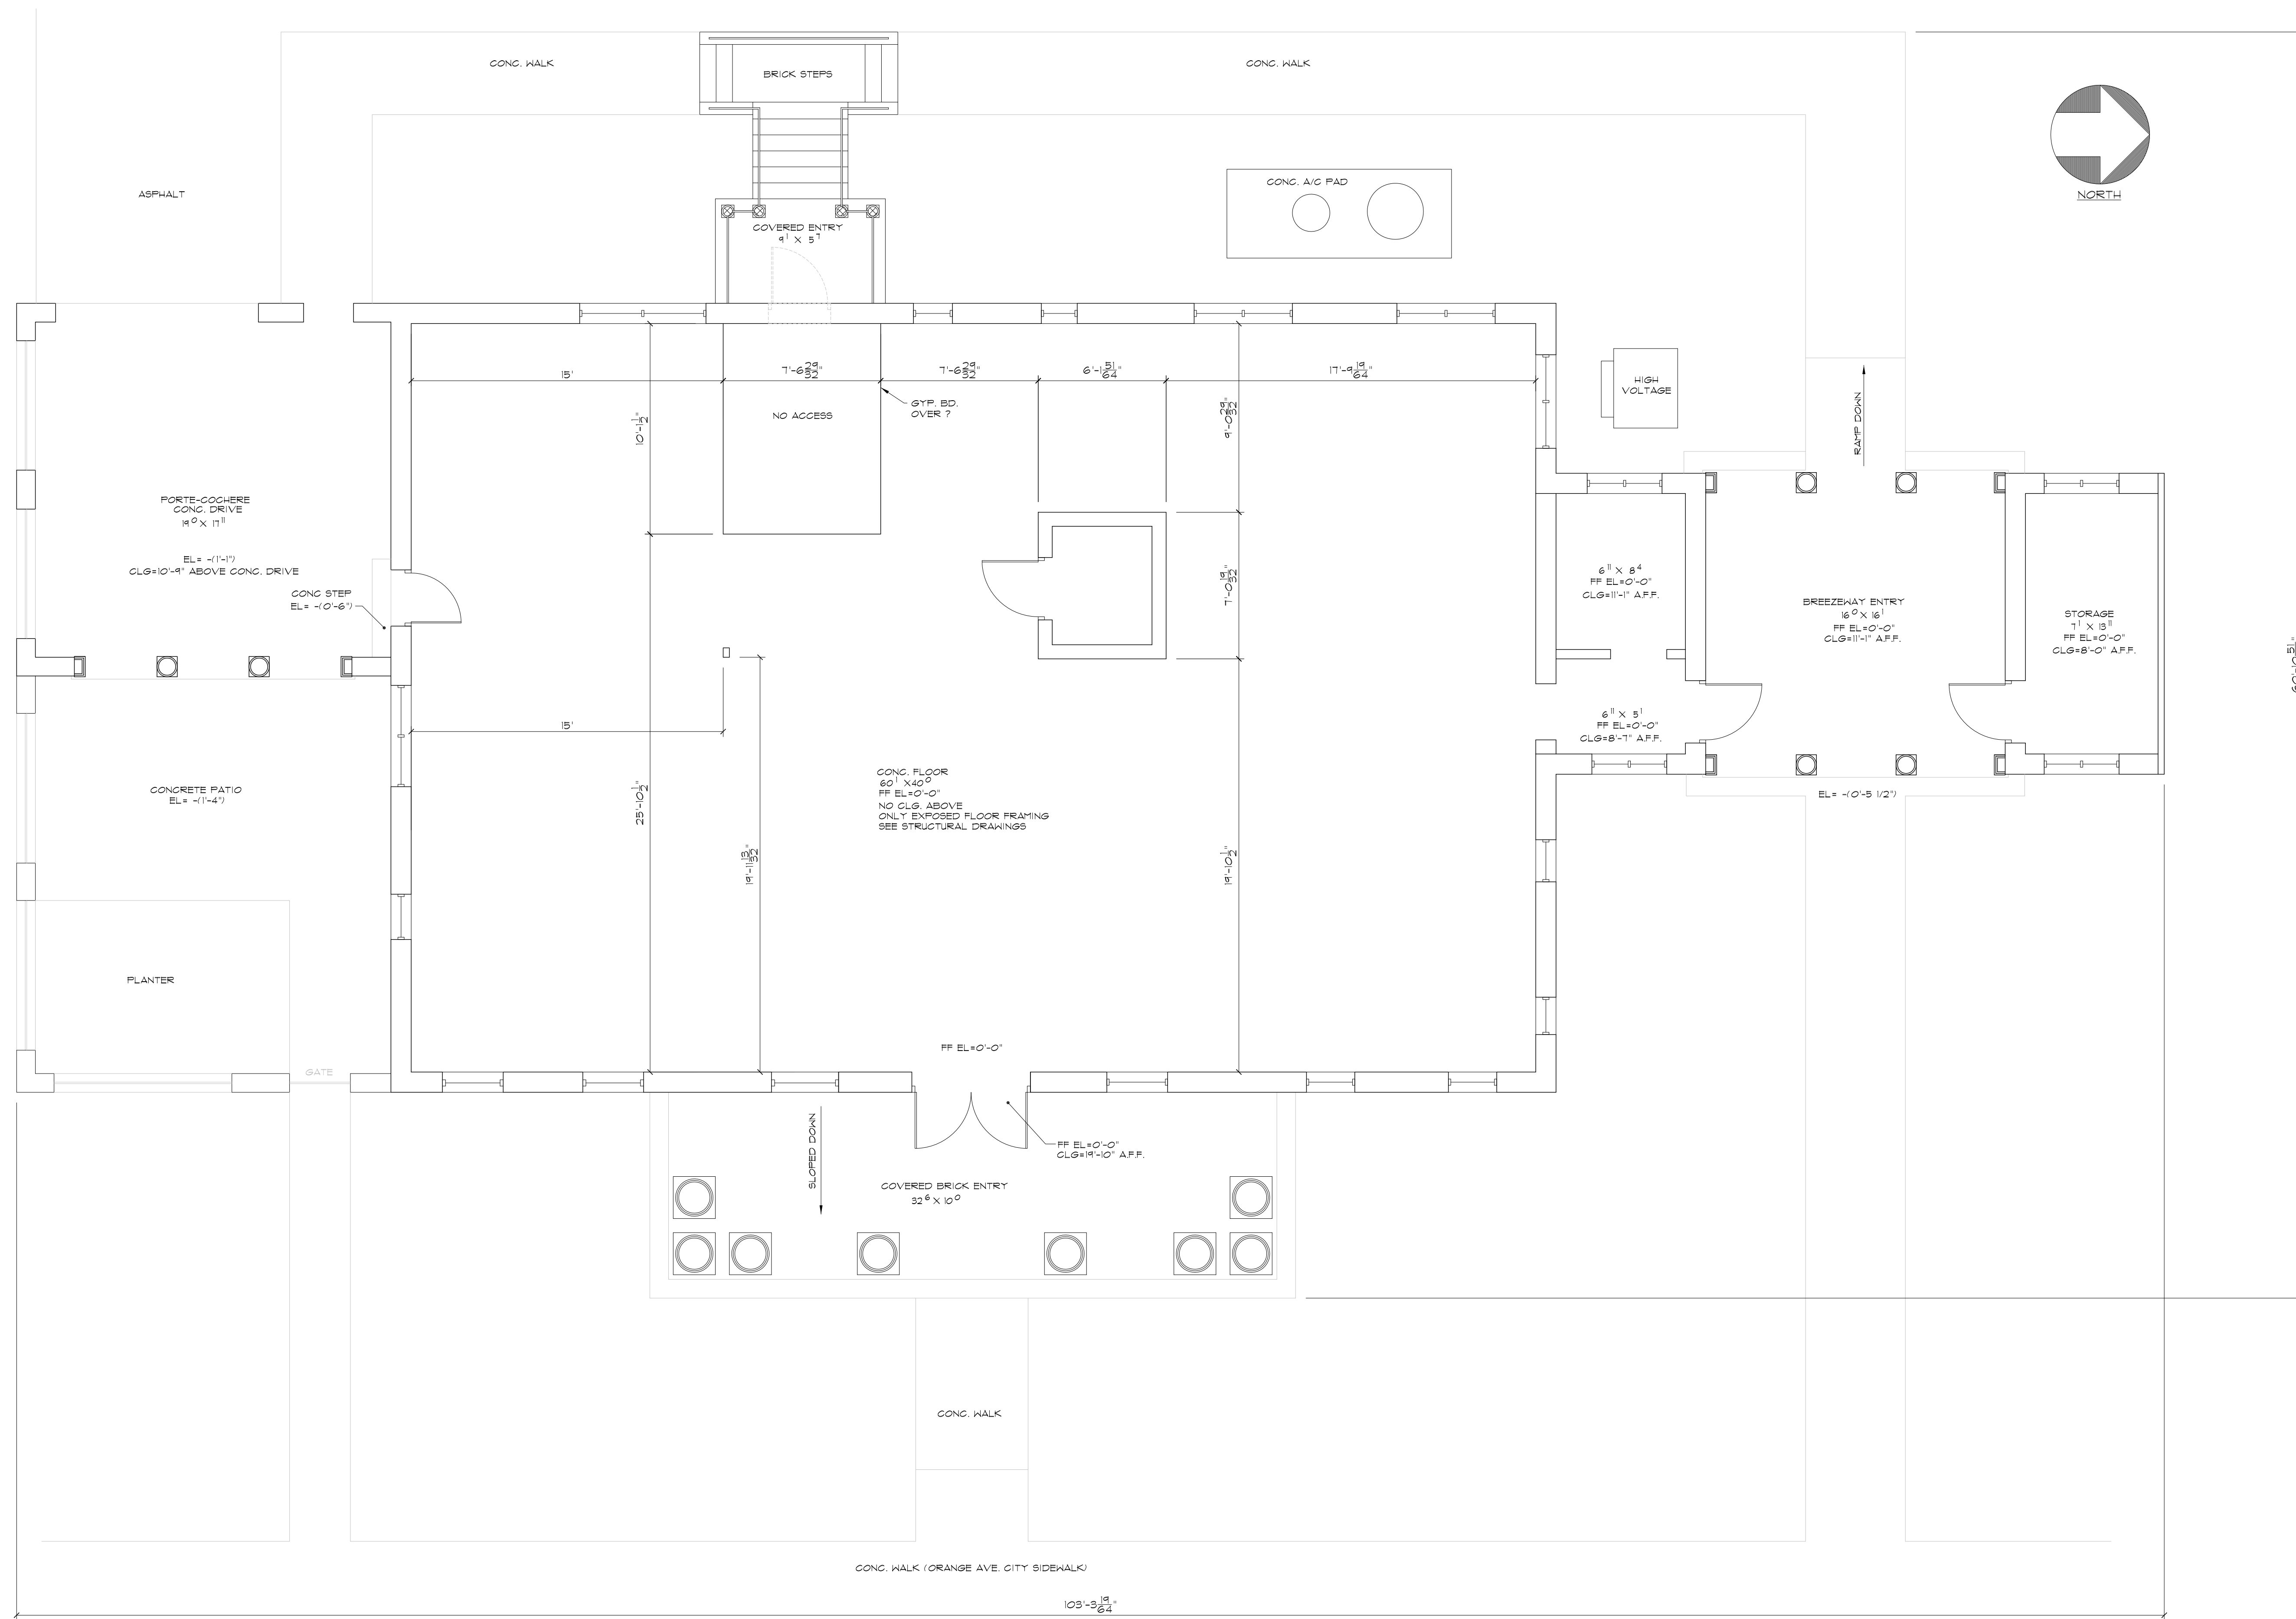



RUTLEDGE BUILDING FIRST FLOOR PLAN 1/4"=1'-0"

THIS AS-BUILT DRAWING WAS PREPARED BY:
AS BUILT PROFESSIONALS
 A SERVICE OF A.E.C. CONSULTANTS INC.
 WWW.ASBUILTPROFESSIONALS.COM
 865-203-8842
 TXL, TEX

PROJECT NAME: BLANK FOR SECURITY
PROJECT LOCATION: BLANK FOR SECURITY

JOB NO.
 000-00-00

SHEET
 AB-1 of AB-1

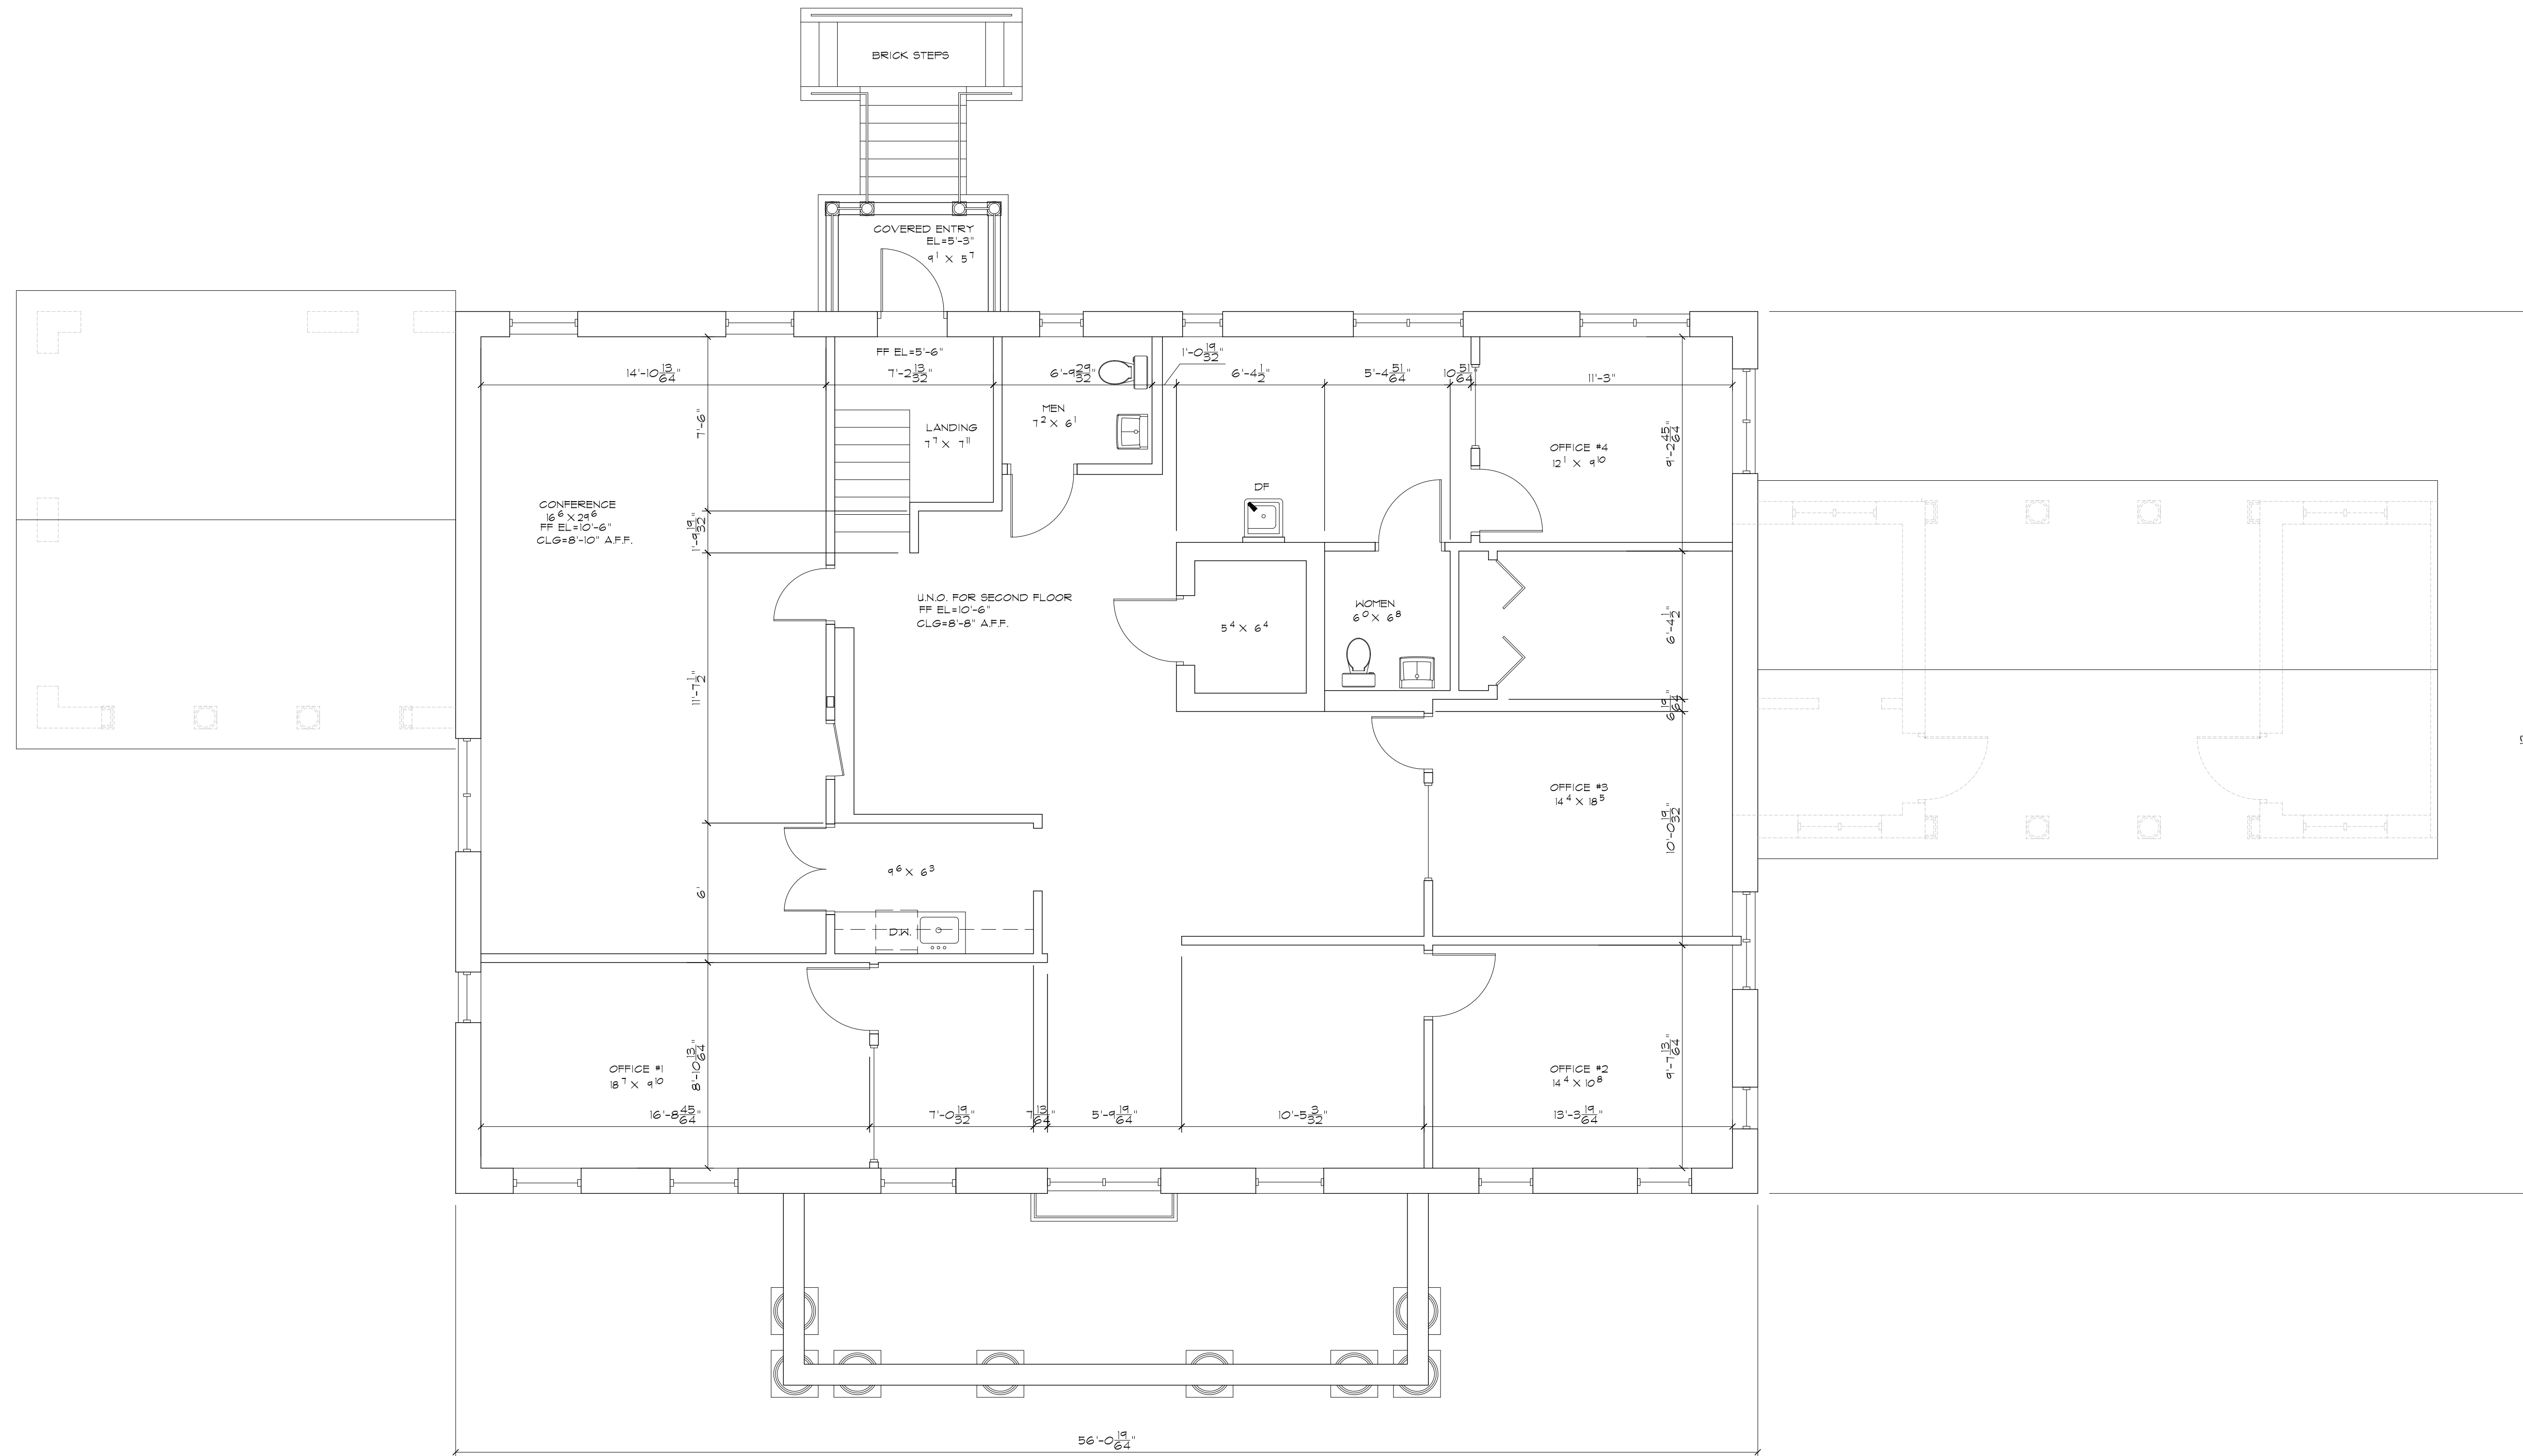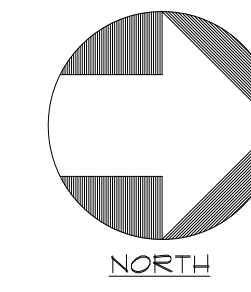

RUTLEDGE BUILDING SECOND FLOOR PLAN 1/4"=1'-0"



PROJECT NAME: BLANK FOR SECURITY
PROJECT LOCATION: BLANK FOR SECURITY

THIS AS-BUILT DRAWING WAS PREPARED BY:
AS BUILT PROFESSIONALS
A SERVICE OF A.E.C. CONSULTANTS INC.
WWW.ASBUILTPROFESSIONALS.COM
865-203-8842
TOL, INC.

JOB NO.
000-00-00

SHEET

AB-1 of AB-1

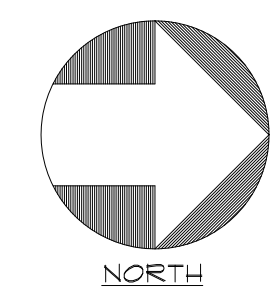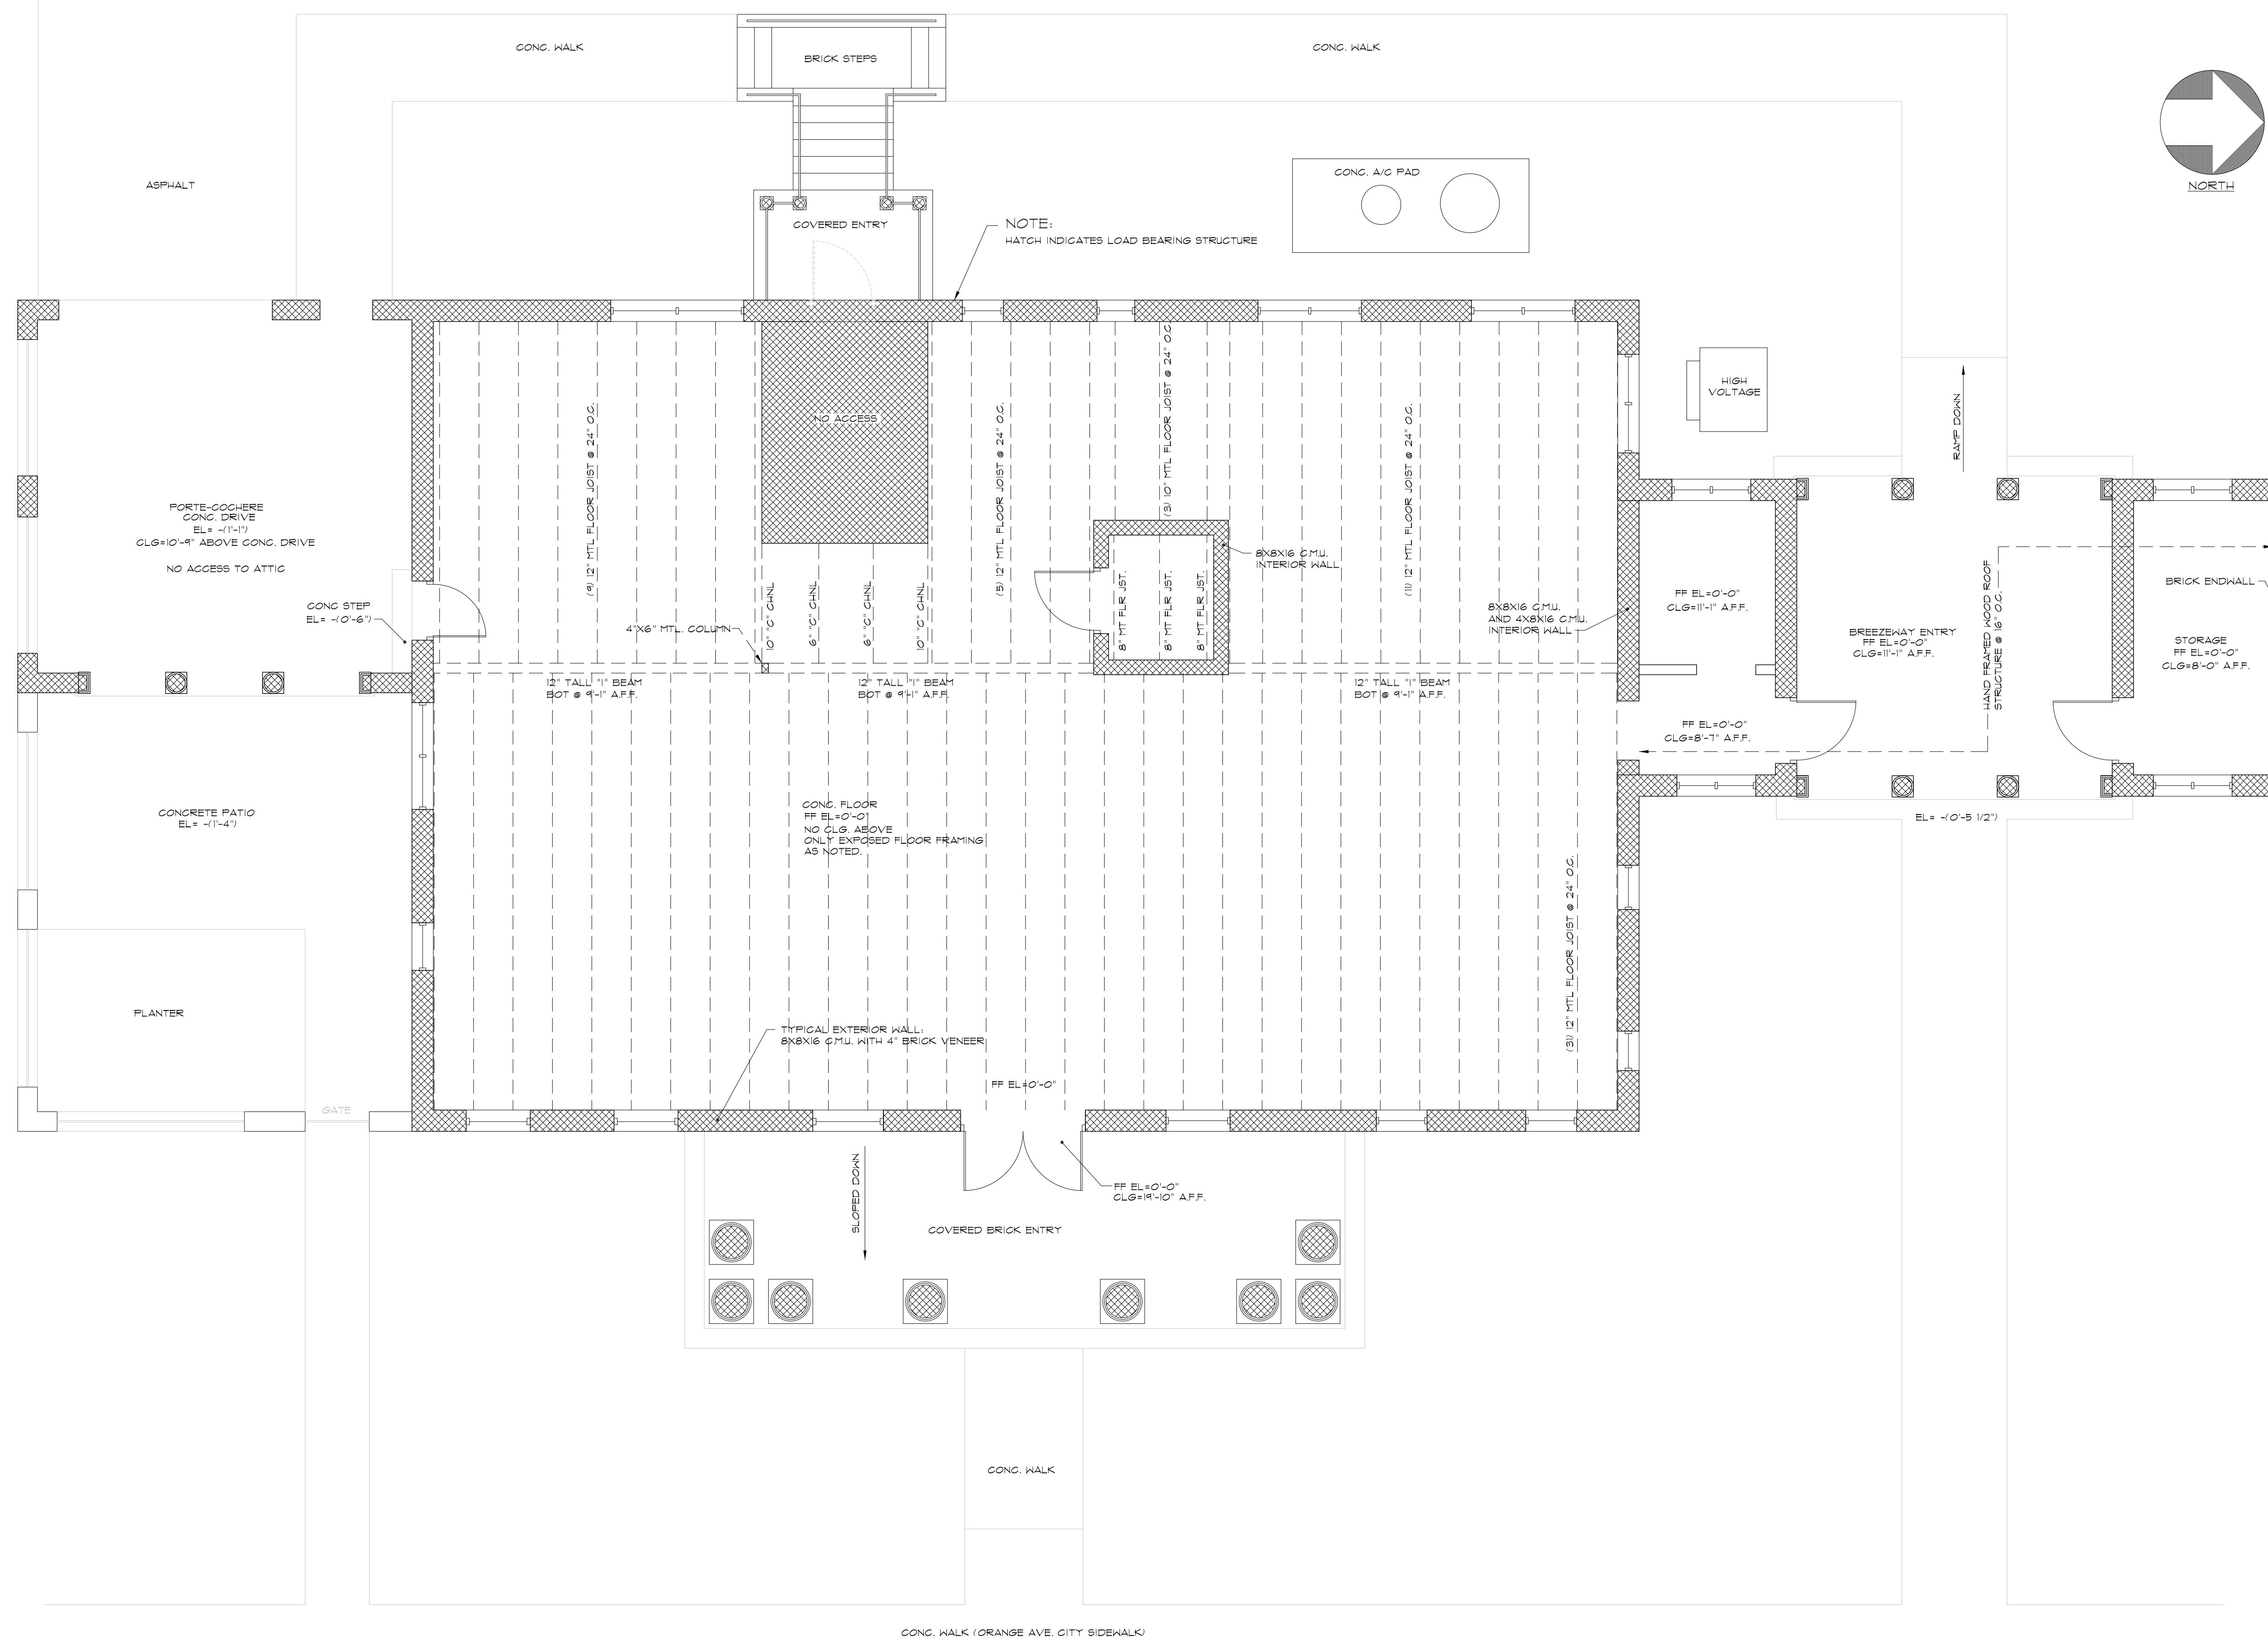



RUTLEDGE BUILDING FIRST FLOOR STRUCTURAL OBSERVATION PLAN 1/4"=1'-0"

PROJECT NAME: BLANK FOR SECURITY
 PROJECT LOCATION: BLANK FOR SECURITY

THIS AS-BUILT DRAWING WAS PREPARED BY:
AS BUILT PROFESSIONALS
 A SERVICE OF A.E.C. CONSULTANTS INC.
 WWW.ASBUILTPROFESSIONALS.COM
 865-203-8842
 TXL, TEX

JOB NO.
 000-00-00

SHEET
 AB-1 of AB-1

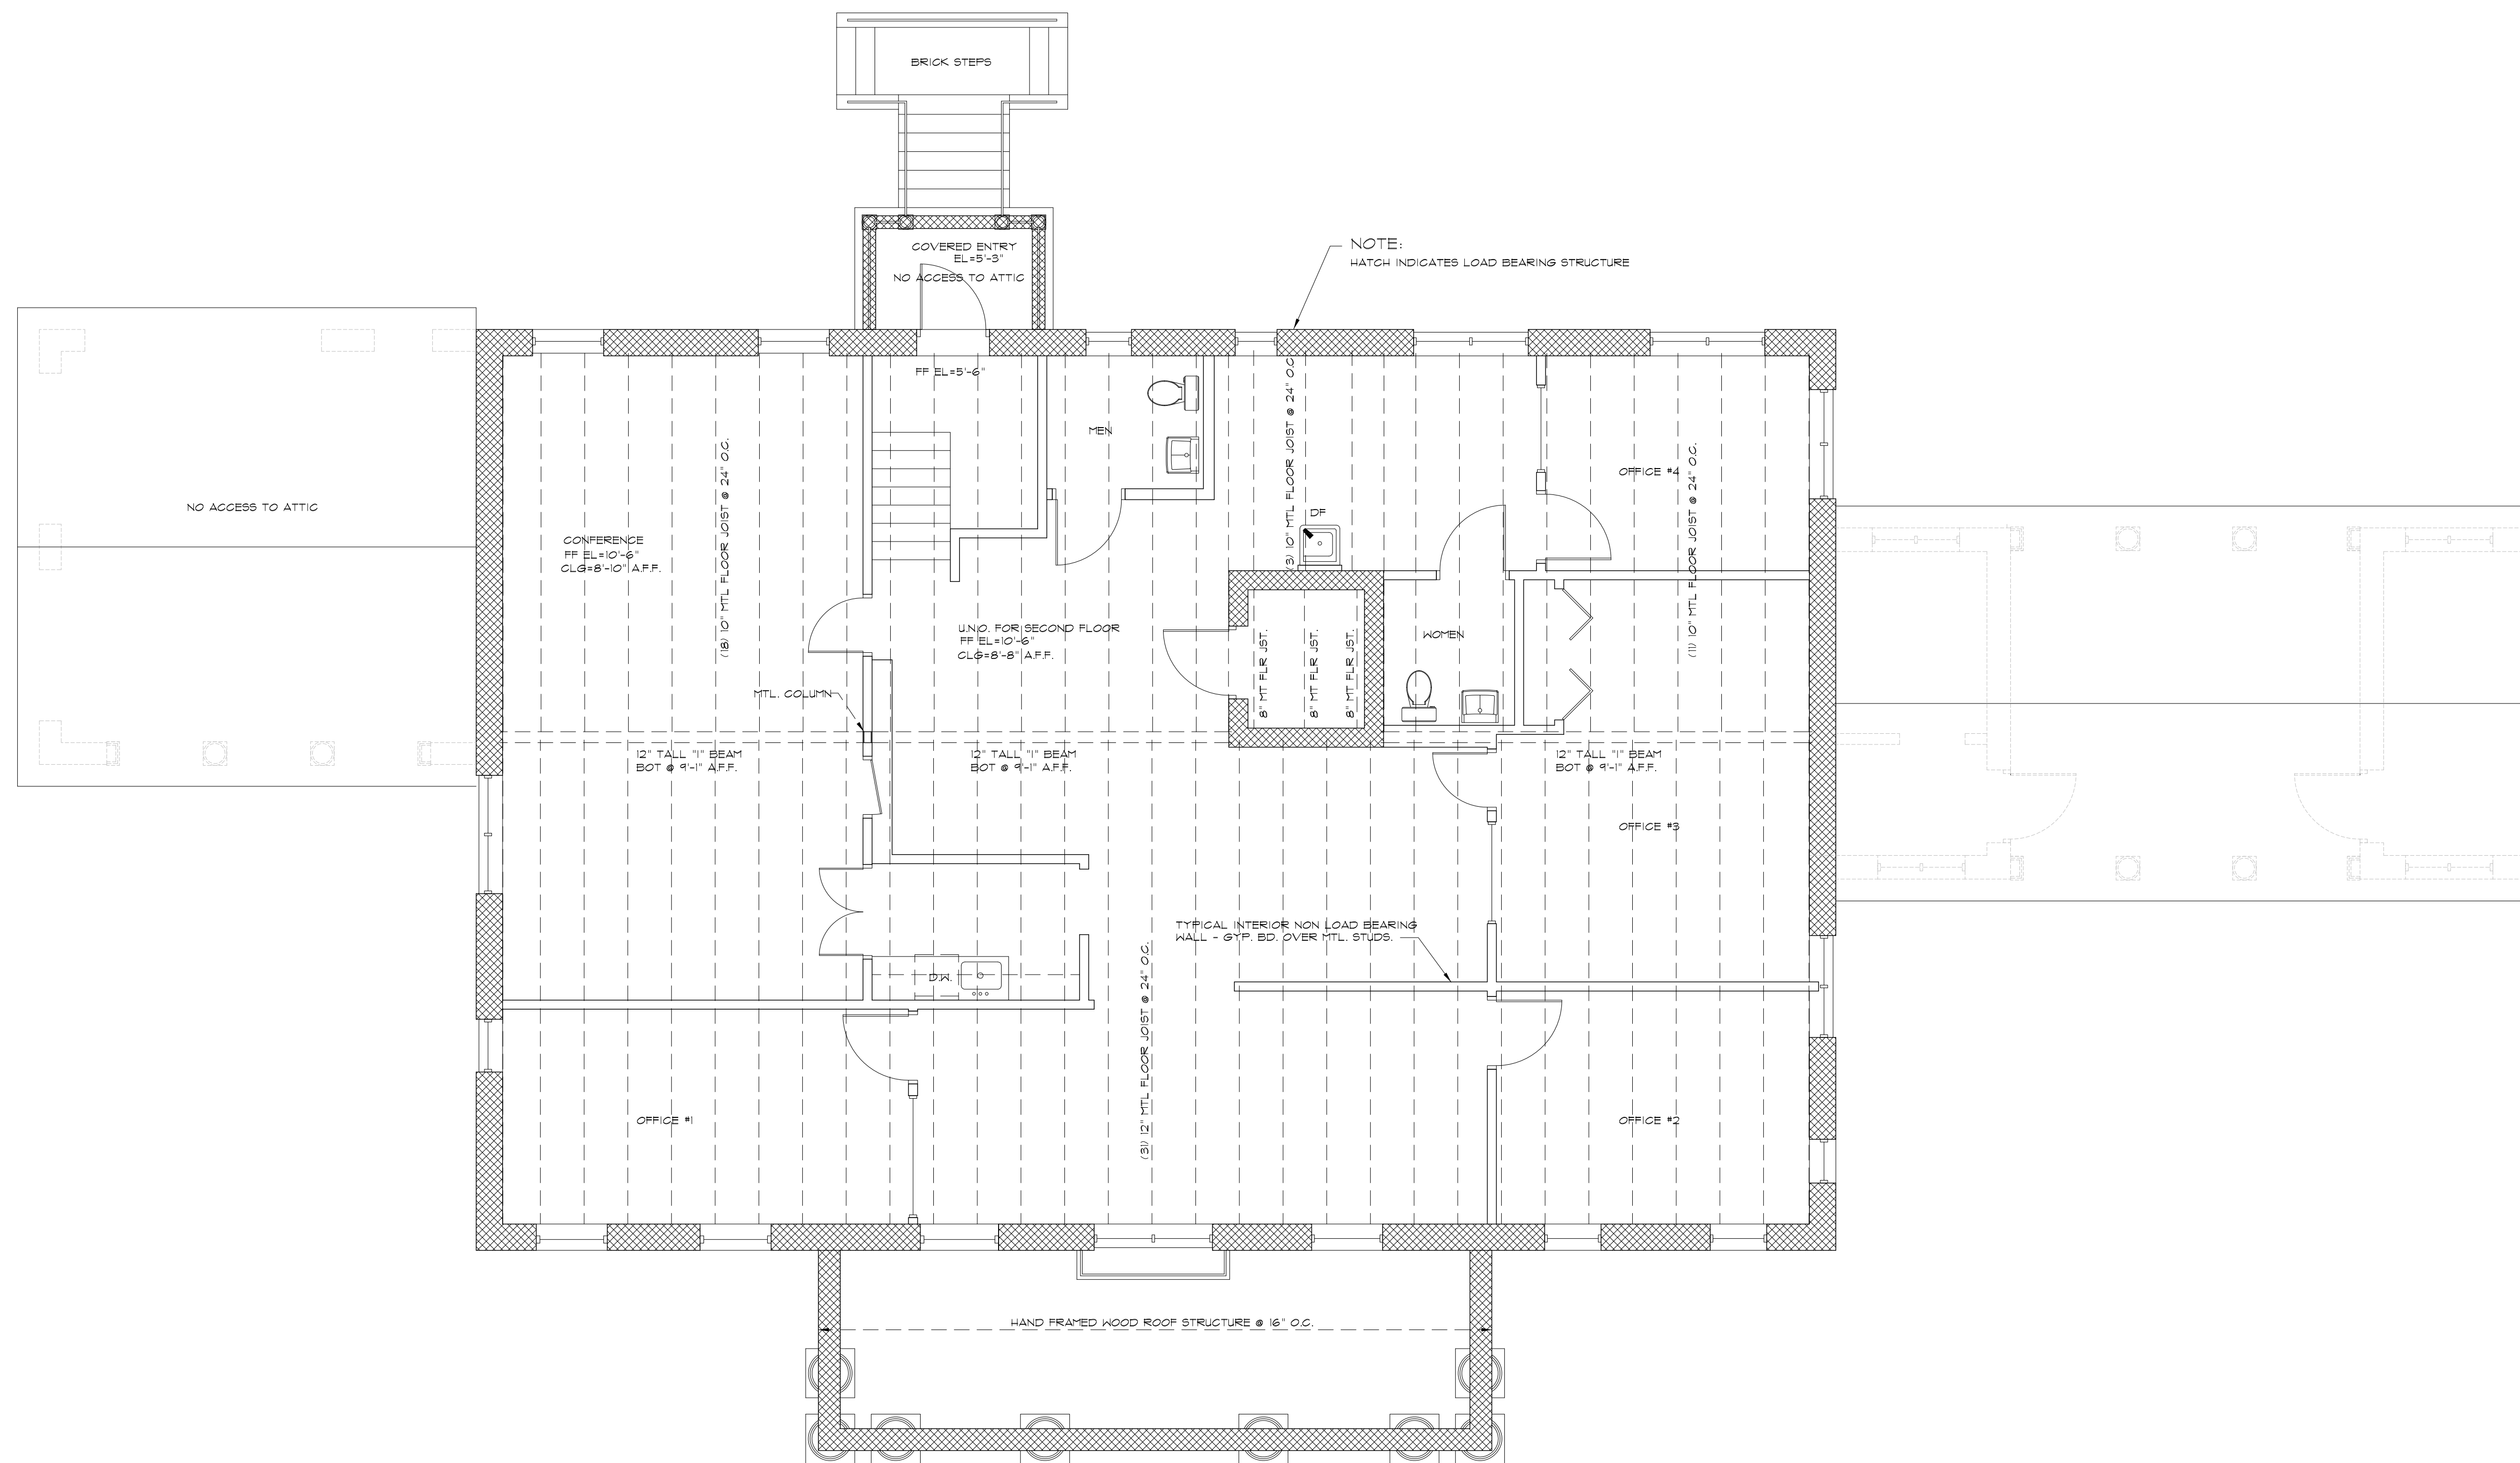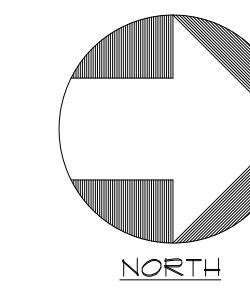


RUTLEDGE BUILDING SECOND FLOOR STRUCTURAL OBSERVATION PLAN 1/4"=1'-0"

PROJECT NAME: BLANK FOR SECURITY
PROJECT LOCATION: BLANK FOR SECURITY

THIS AS-BUILT DRAWING WAS PREPARED BY:
AS BUILT PROFESSIONALS
A SERVICE OF A.E.C. CONSULTANTS INC.
WWW.ASBUILTPROFESSIONALS.COM
865-203-8842
TOL, TEX

JOB NO.
000-00-00

SHEET
AB-1 of AB-1

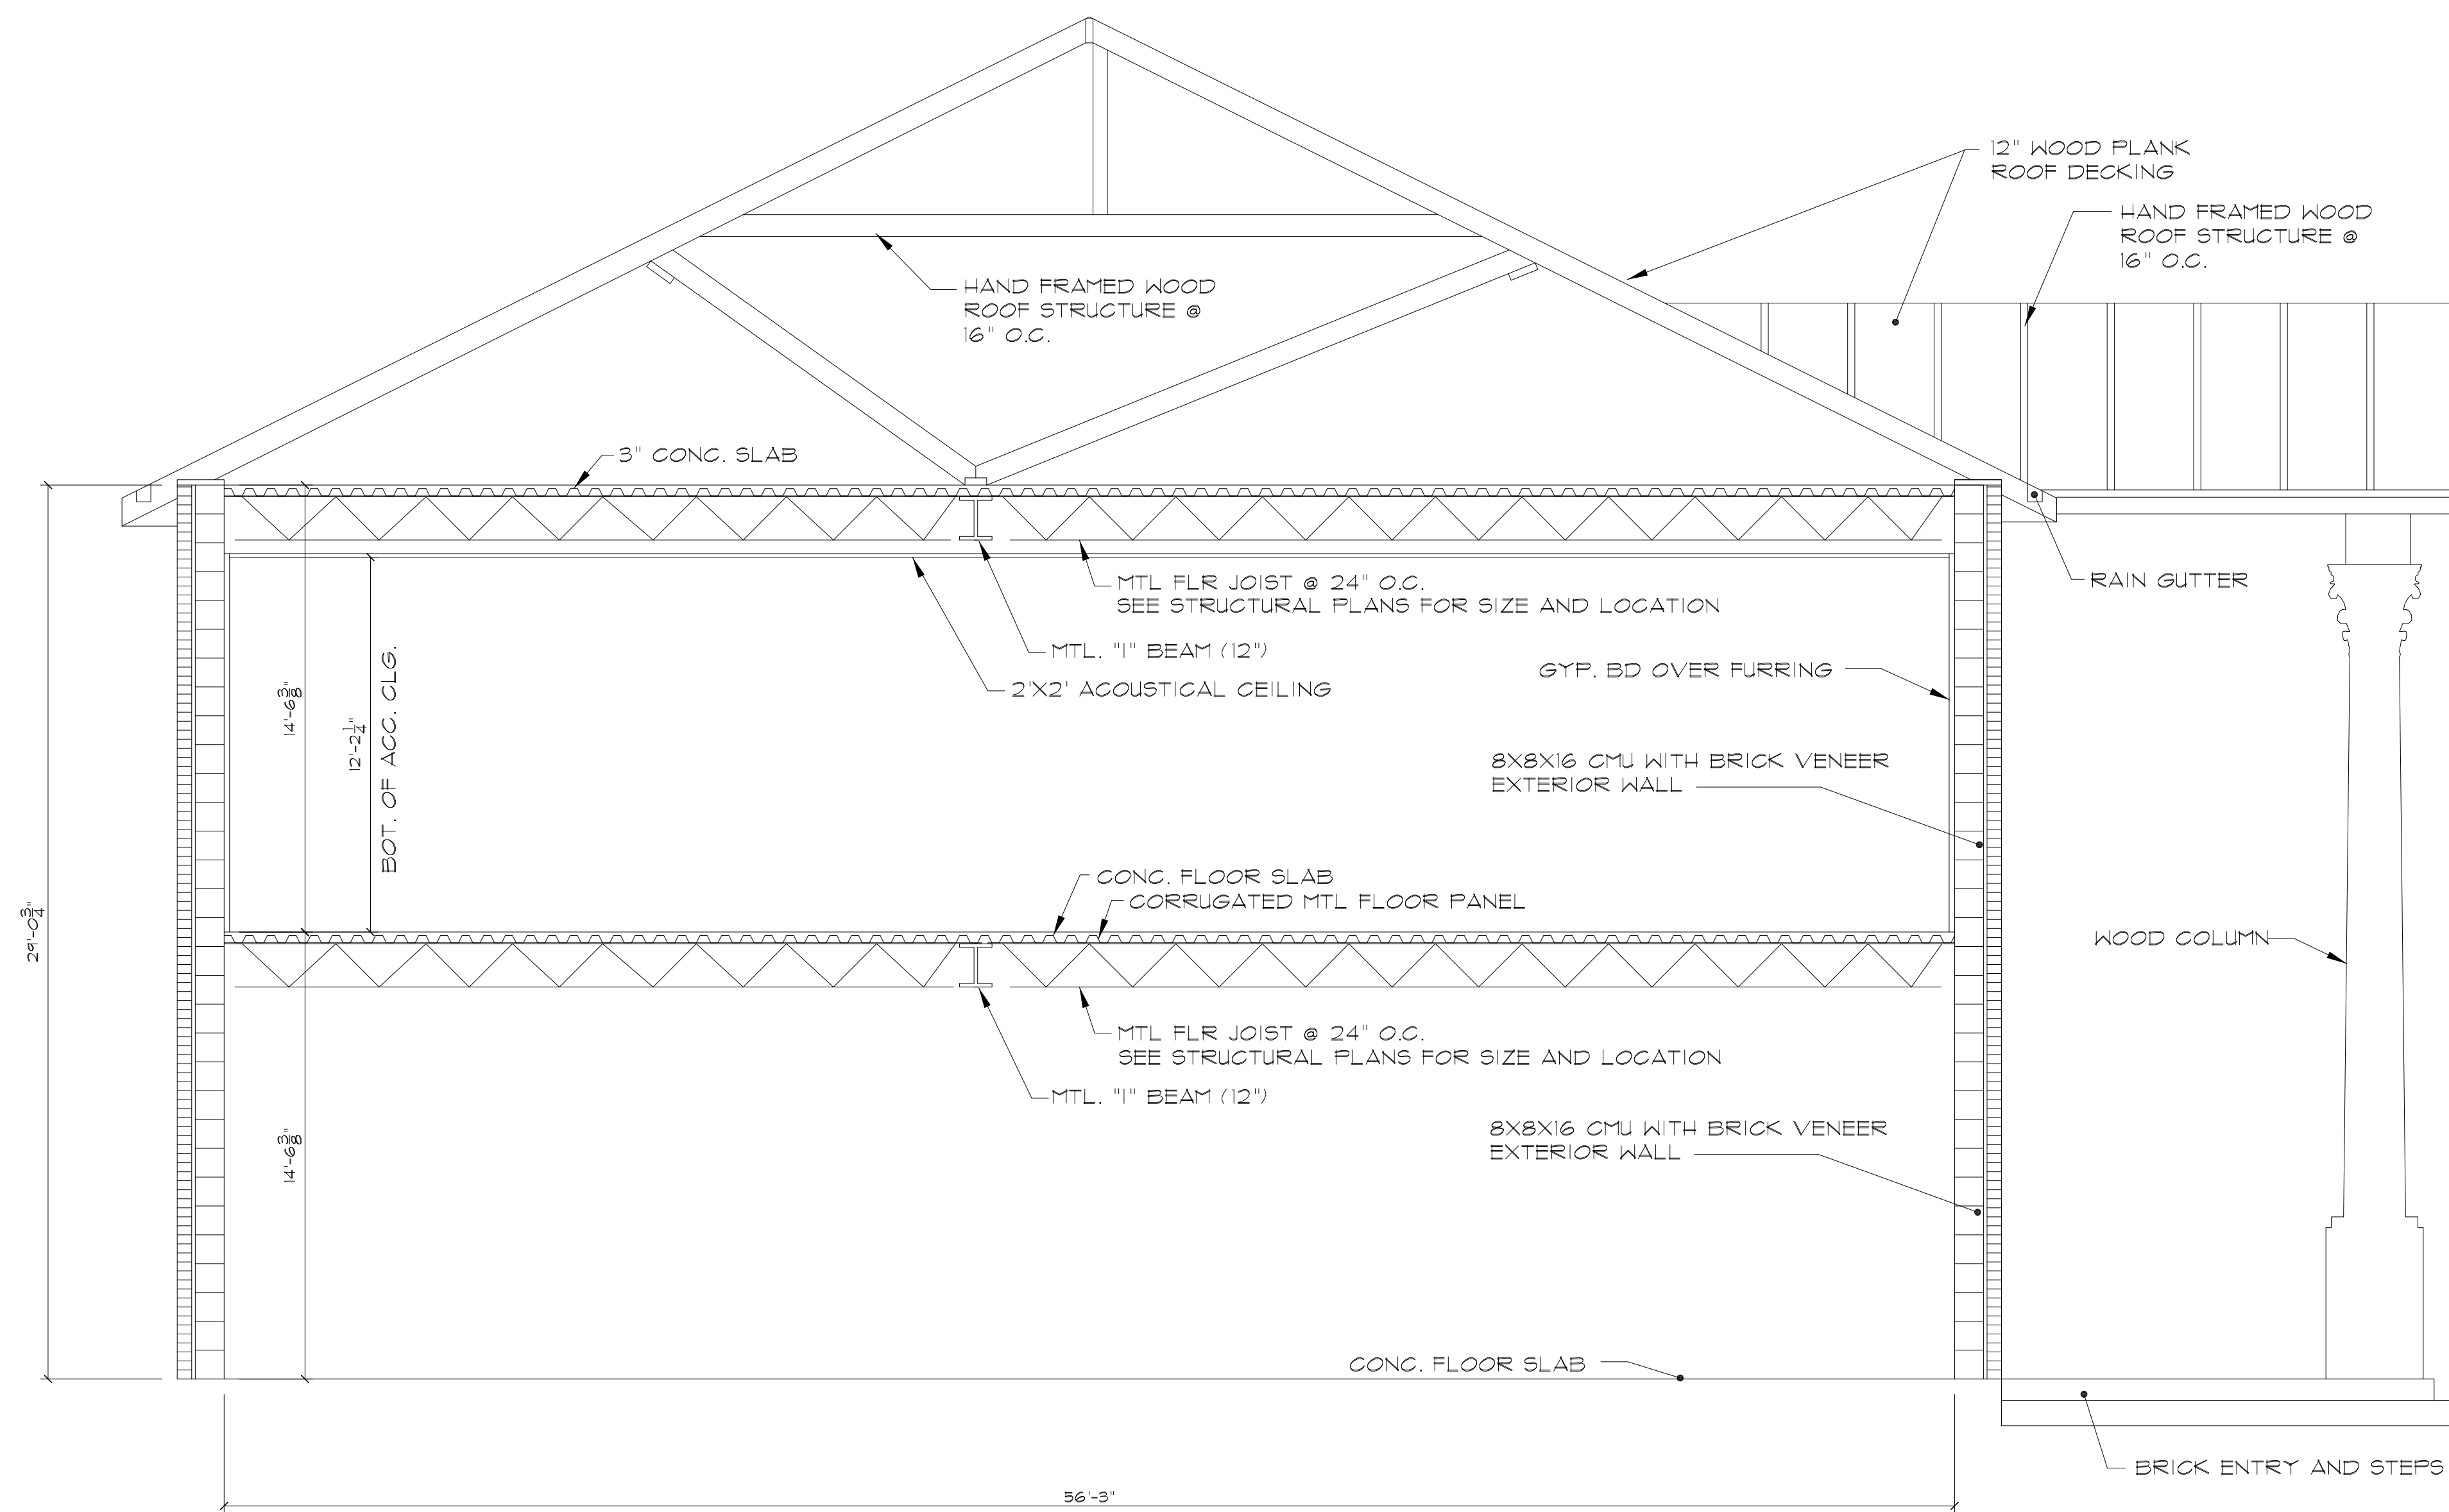

BUILDING SECTION 1/4" = 1'-0"

PROJECT NAME: BLANK FOR SECURITY
 PROJECT LOCATION: BLANK FOR SECURITY

THIS AS-BUILT DRAWING WAS PREPARED BY:
AS BUILT PROFESSIONALS
 A SERVICE OF A.E.C. CONSULTANTS INC.
 WWW.ASBUILTPROFESSIONALS.COM
 865-203-8842
 TXL, TX

JOB NO.
 000-00-00

SHEET
 AB-1 of AB-1