

AS-BUILT DOCUMENTATION

LEASING CENTER AND CLUBHOUSE CHARLOTTE, NORTH CAROLINA



LEASING CENTER




FITNESS CENTER

100% SUBMITTAL

DRAWING INDEX

- C-1 COVER SHEET | DRAWING INDEX
- AB-1 LEASING CENTER FLOOR PLAN WITH MEP
- AB-2 FITNESS CENTER FLOOR PLAN WITH MEP
- AB-3 LEASING CENTER ELEVATIONS
- AB-4 FITNESS CENTER ELEVATIONS
- AB-5 INTERIOR ELEVATIONS
- AB-6 LONGITUDINAL AND TRANSVERSE SECTIONS
- AB-7 LONGITUDINAL AND TRANSVERSE SECTIONS

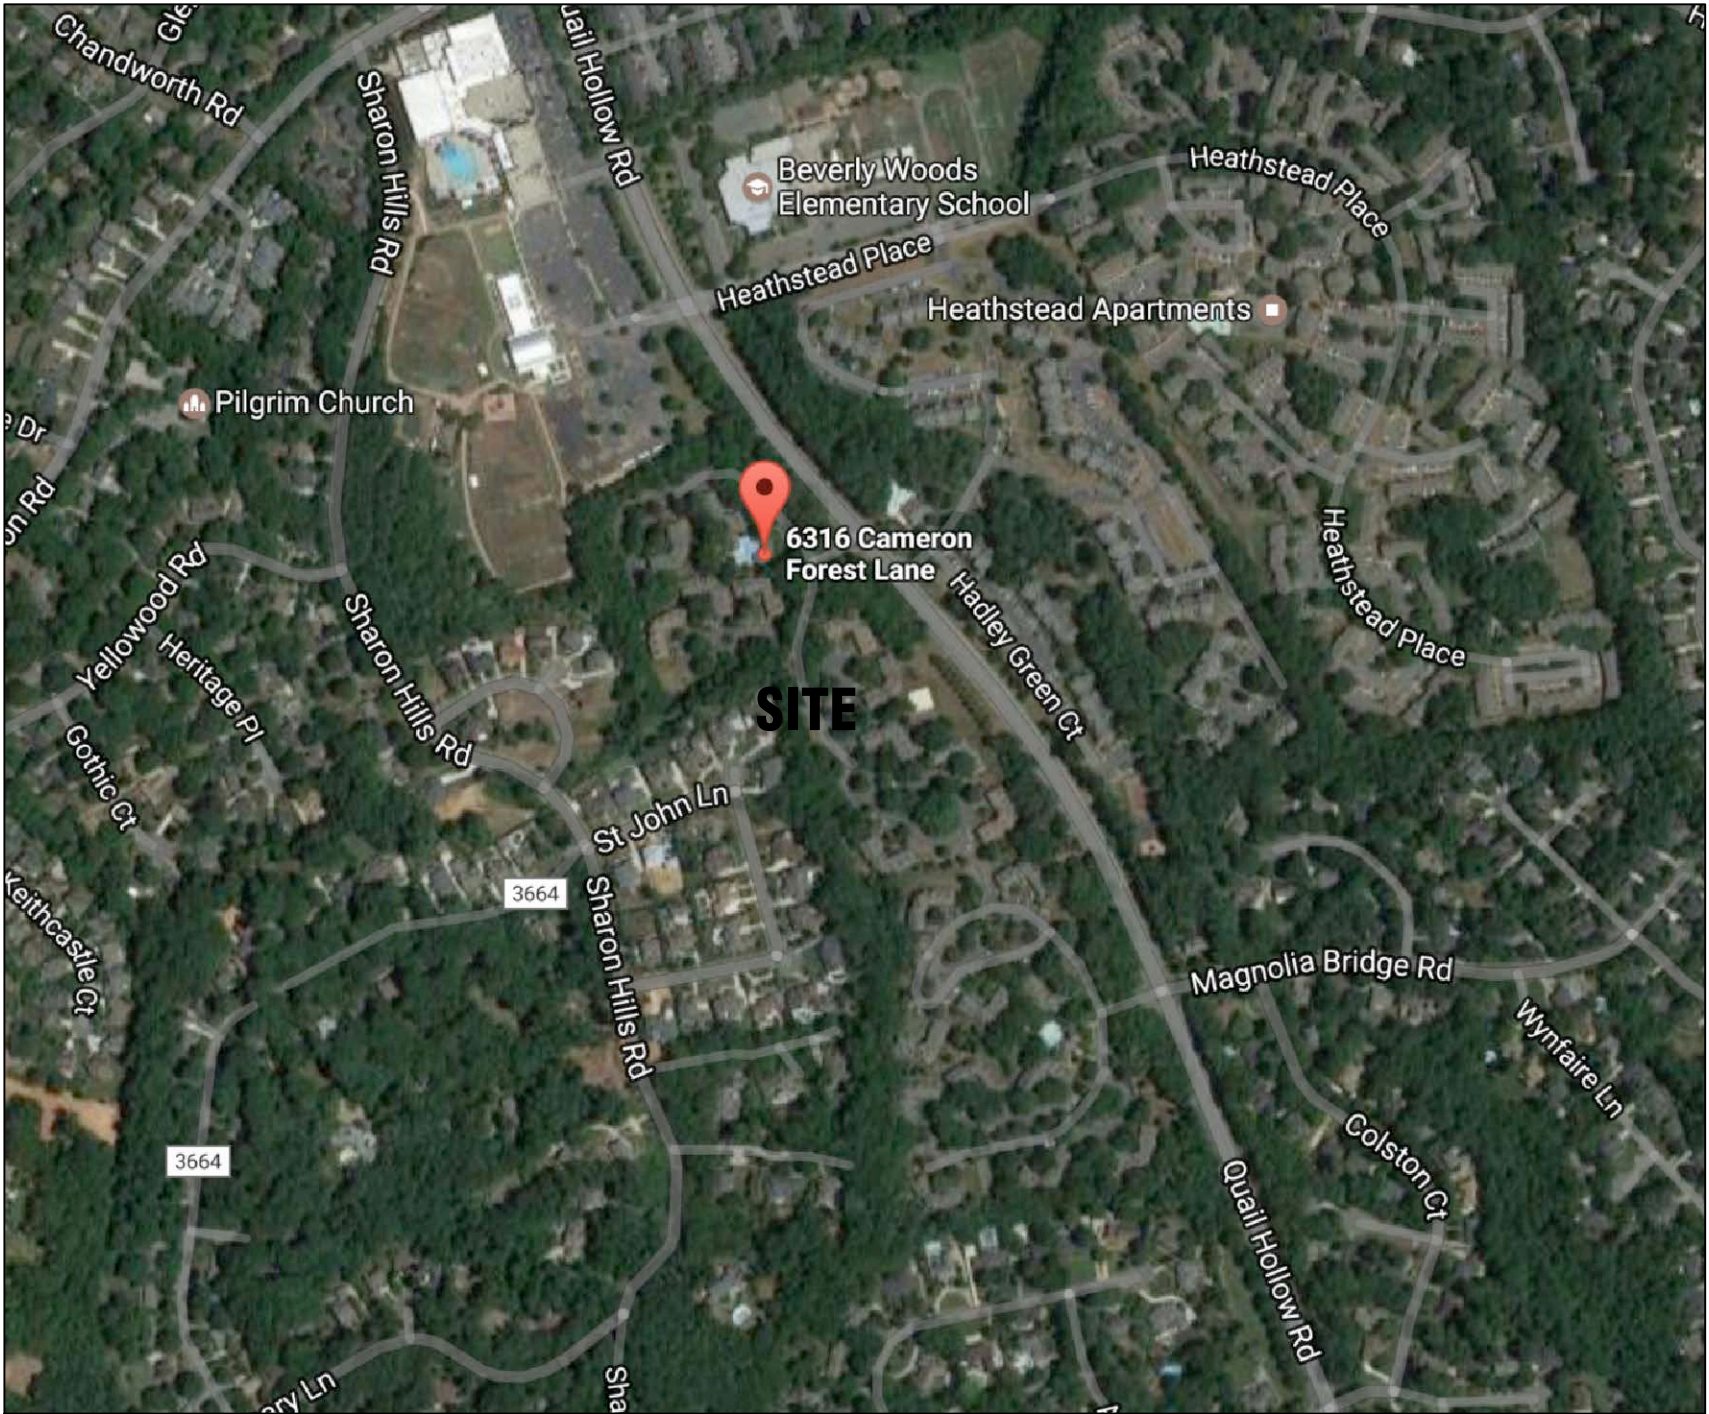

VICINITY MAP
NTS

SYMBOLS LEGEND

RCP			ELECTRIC	FIRE PROTECTION
	EXHAUST VENT		DATA OUTLET	
	CEILING MOUNTED LIGHT FIXTURE		TELEPHONE JACK	
	HANGING LIGHT FIXTURE		ELECTRIC SWITCH	
	CEILING MOUNTED DIRECTIONAL LIGHT		CABLE TELEVISION OUTLET	
	RECESSED CAN LIGHT		DUPLEX RECEPTACLE OUTLET	
	EYEBALL OR SMALL CAN LIGHT		SPECIAL PURPOSE CONNECTION OR OUTLET	
	PENDANT LIGHT		QUADRUPLUX RECEPTACLE OUTLET	
	INDIVIDUAL FLOOR, LAY-IN FIXTURE 4 BULB		FLOOR DUPLEX RECEPTACLE OUTLET	
	INDIVIDUAL FLOOR, HANGING FIXTURE 2 BULB		ELECTRIC PANEL	
	INDIVIDUAL FLOOR, FLUSH MOUNT FIXTURE		ELECTRIC METER	
	CAMERA		BUTTON SWITCH	
	MOTION DET.		DISCONNECT SWITCH	
	SUPPLY VENT		GROUND/FLOOR LIGHT	
	RETURN VENT		KEY PAD	
	RETURN VENT		CHIMES	
	SPEAKER			



844.272.8458
844-ASBUILT

© 2011 AEC CONSULTANTS INC

ARCHITECTURAL AS BUILT
ALEXANDER PLACE
CHARLOTTE, NORTH CAROLINA

COVER SHEET	
HL	PROJECT MANAGER
HL	PROJECT DIRECTOR
9-2-16-1	PROJECT NUMBER
AS NOTED	SCALE
CL	DRAWN BY
C-1	SHEET NUMBER



CONSULTANTS INC

© 2017 AEC CONSULTANTS INC.

CHARLOTTE, NORTH CAROLINA

SHEET TITLESHEET NUMBER

PHOTO DOCUMENTATION LEGEND

— INDICATES LOCATION OF CAMERA

— INDICATES DIRECTION OF CAMERA LENS
AND CORRESPONDING PHOTO / VIDEO
NUMBER

TYPES OF DOCUMENTATION



GROUND BASIN
PHOTO

GROUND BASED VIDEO

360° SHPER:
PHOTO

RIAL BAS
PHOTO

TRIAL BASED VIDEO


FITNESS CENTER FLOOR PLAN 1/4"=1'-0"






ARCHITECTURAL AS BUILT
ALEXANDER PLACE
CHARLOTTE, NORTH CAROLINA


AB-3

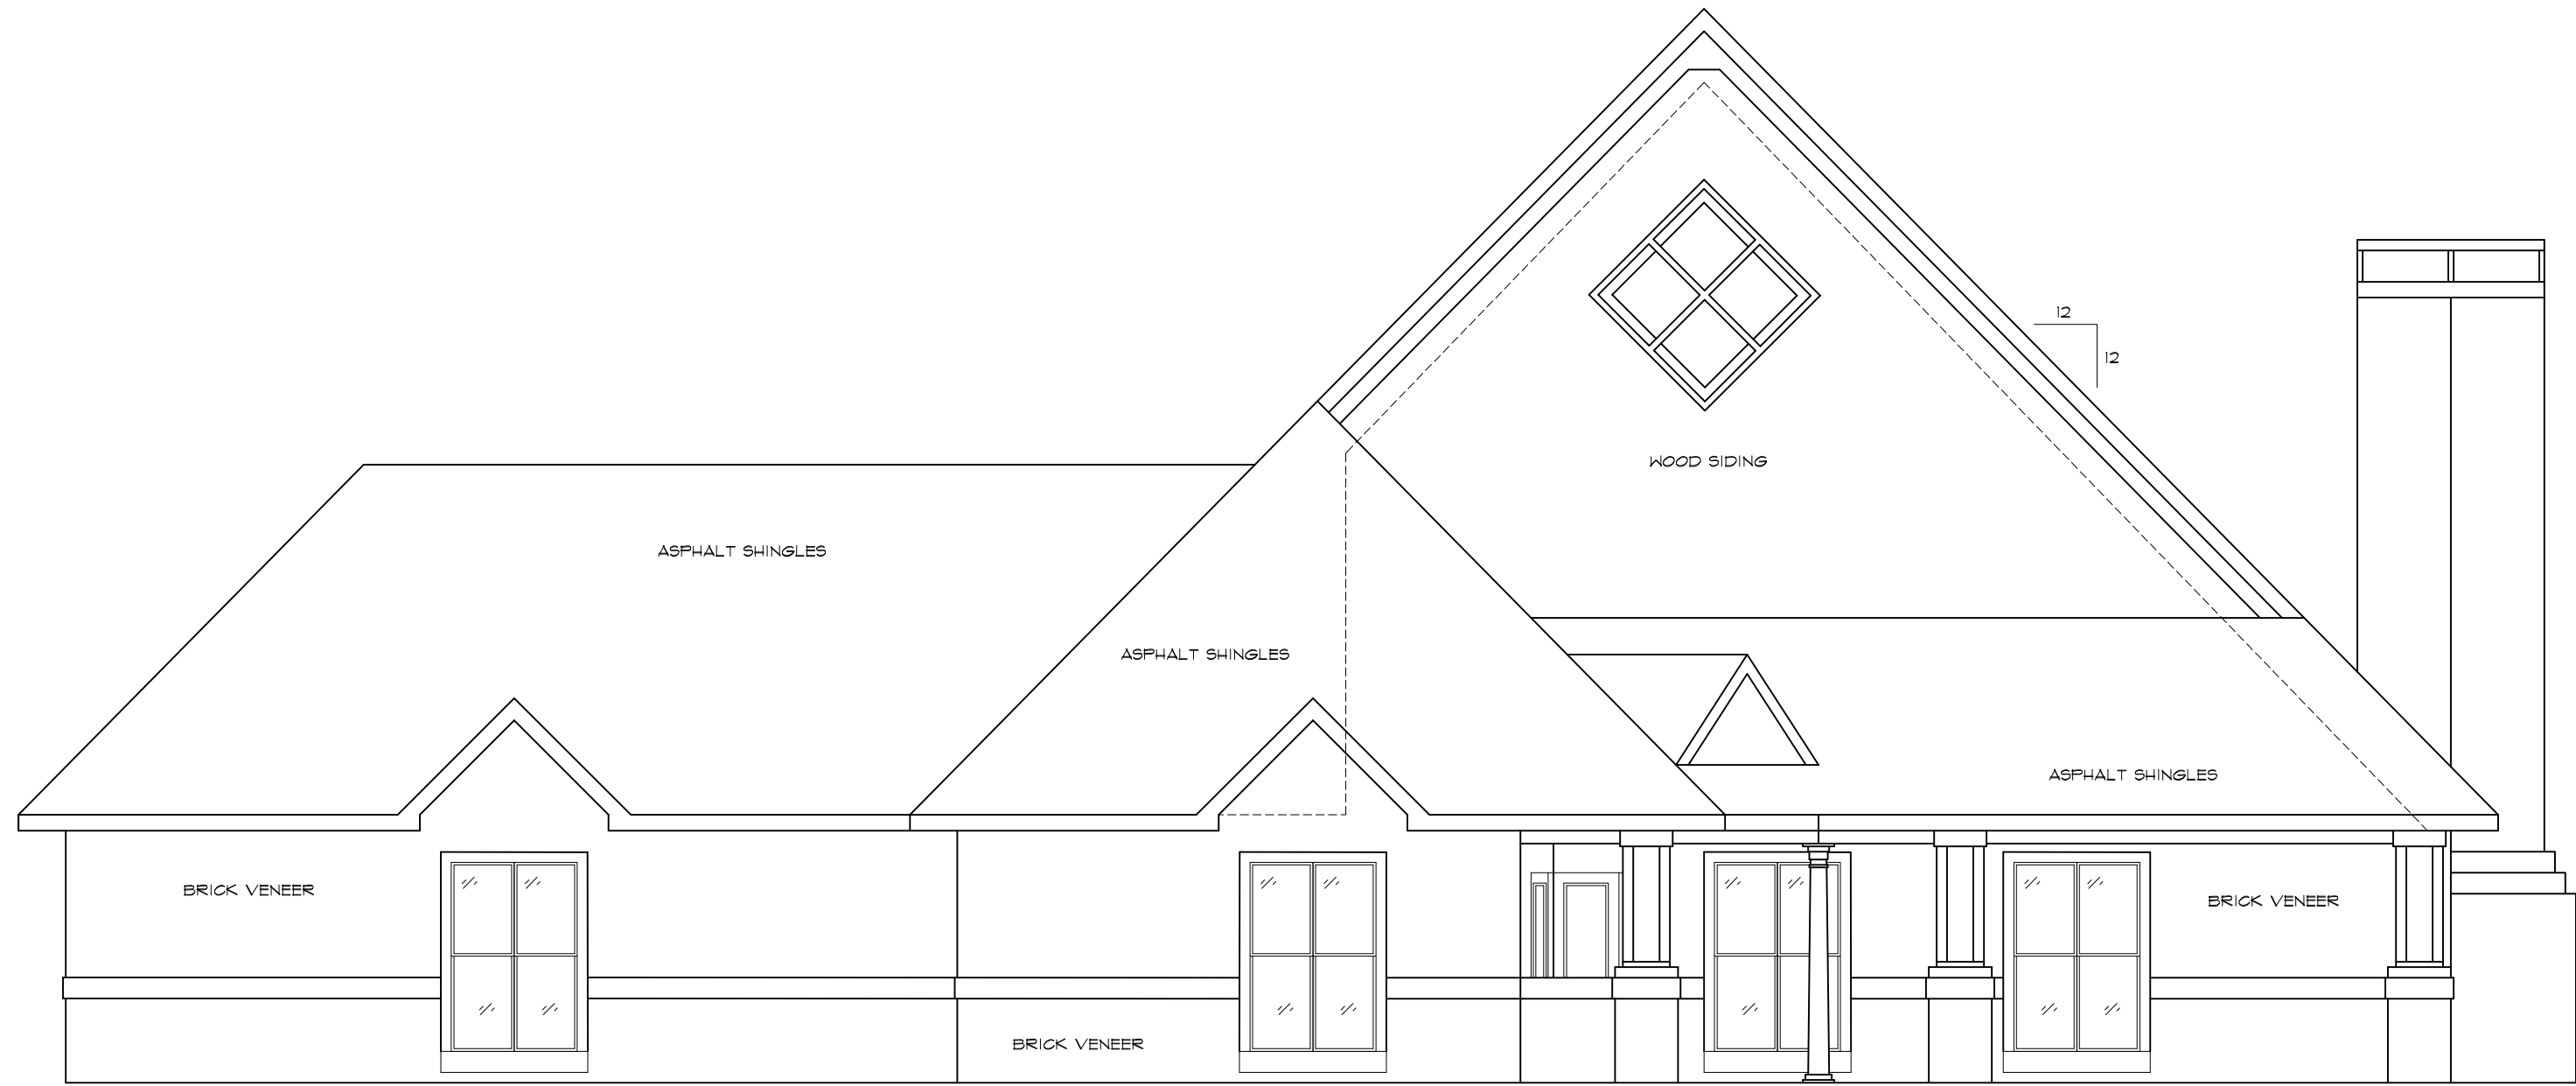

FITNESS CENTER FRONT ELEVATION 3/16"=1'-0"

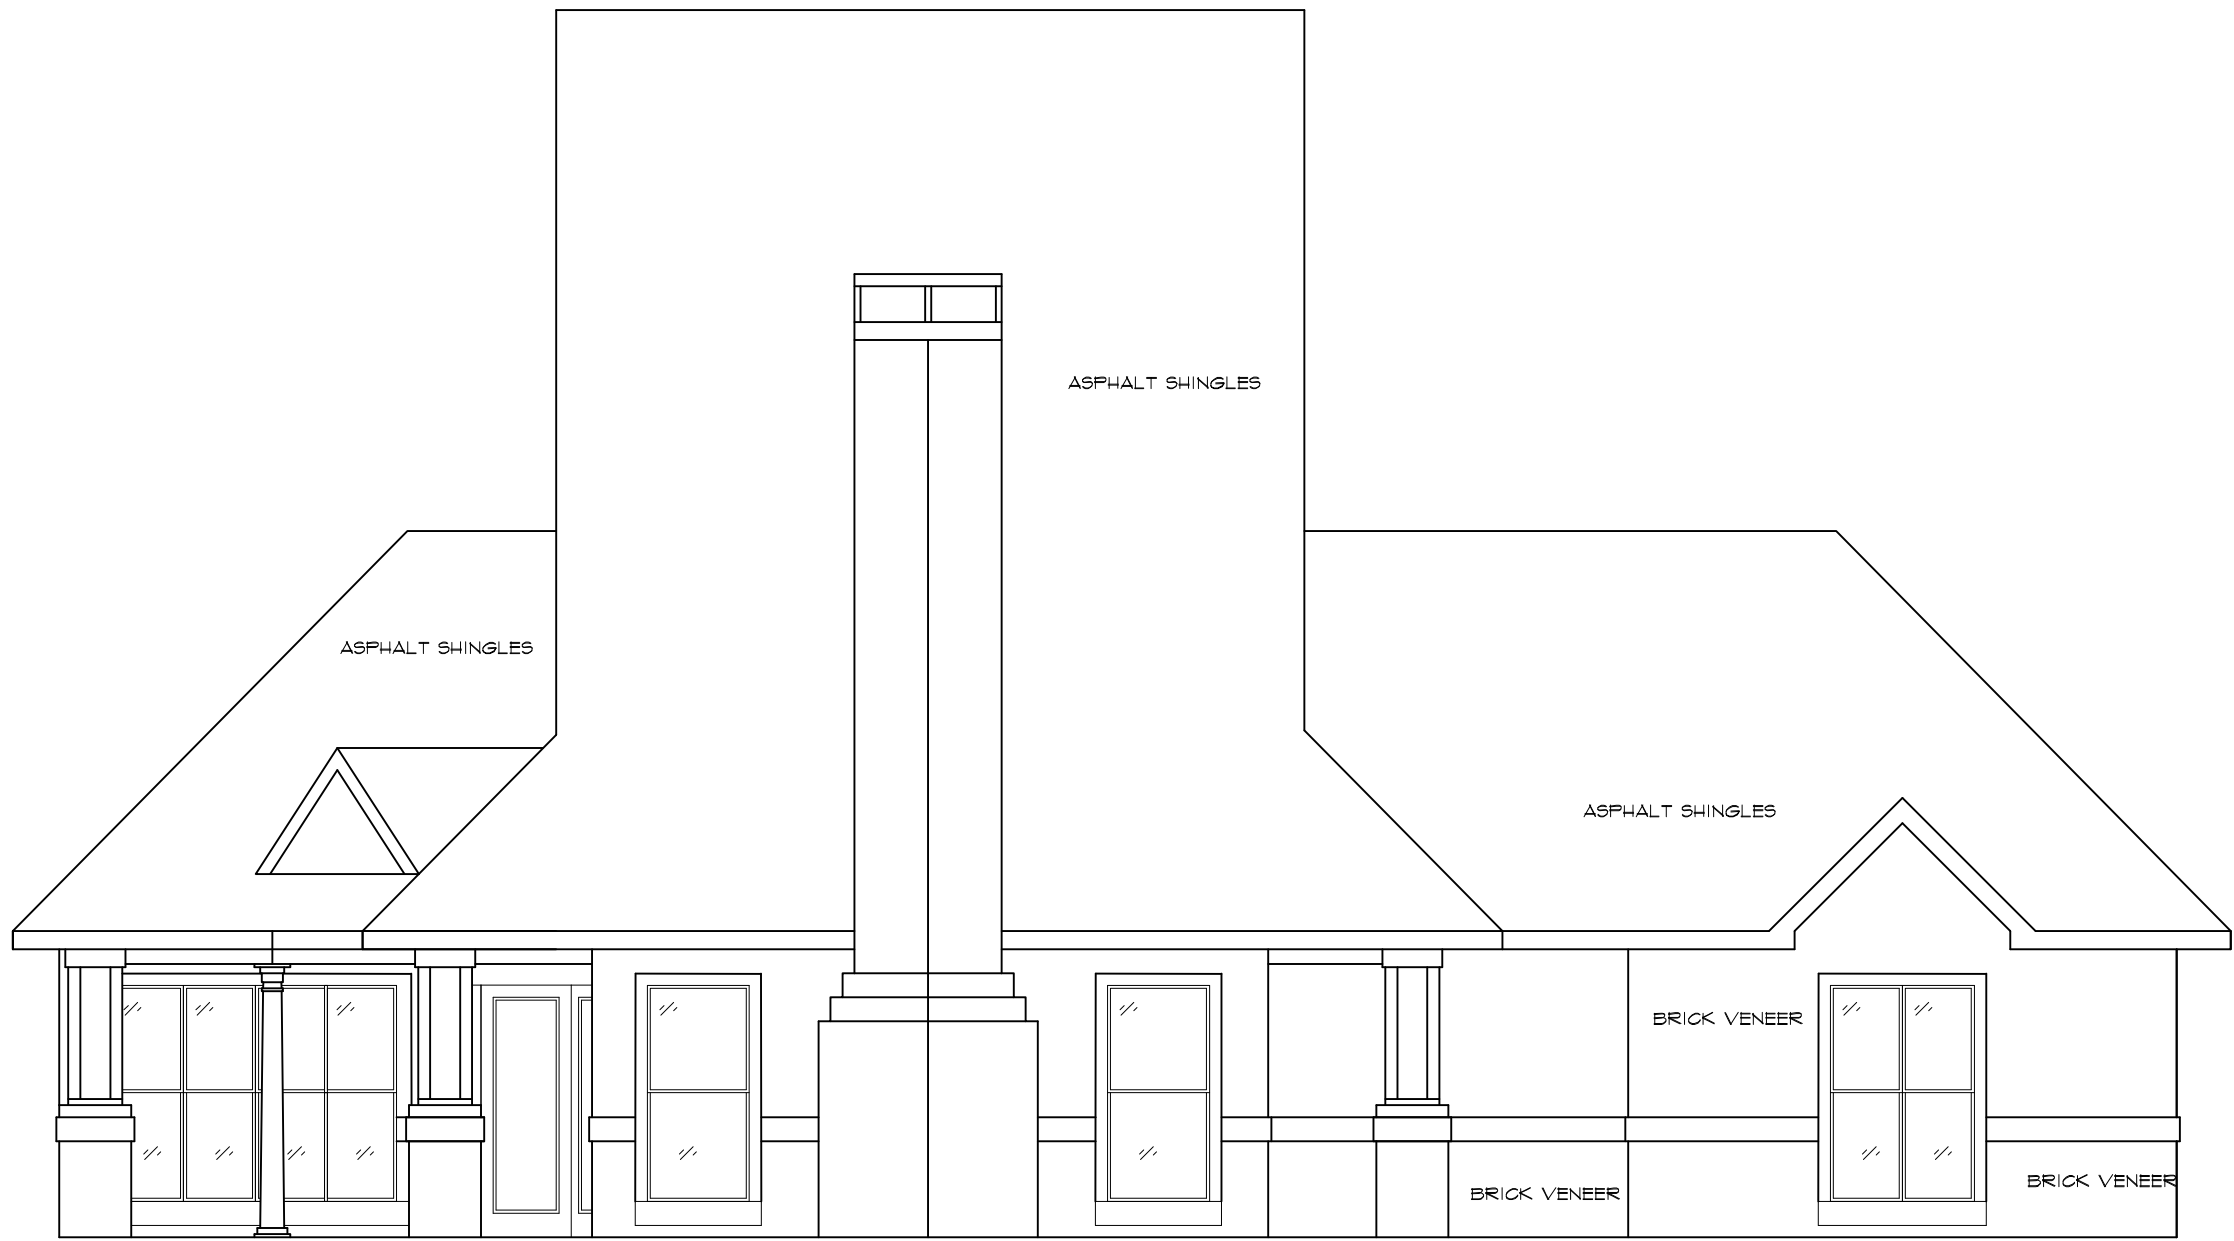

FITNESS CENTER RIGHT SIDE ELEVATION 3/16"=1'-0"

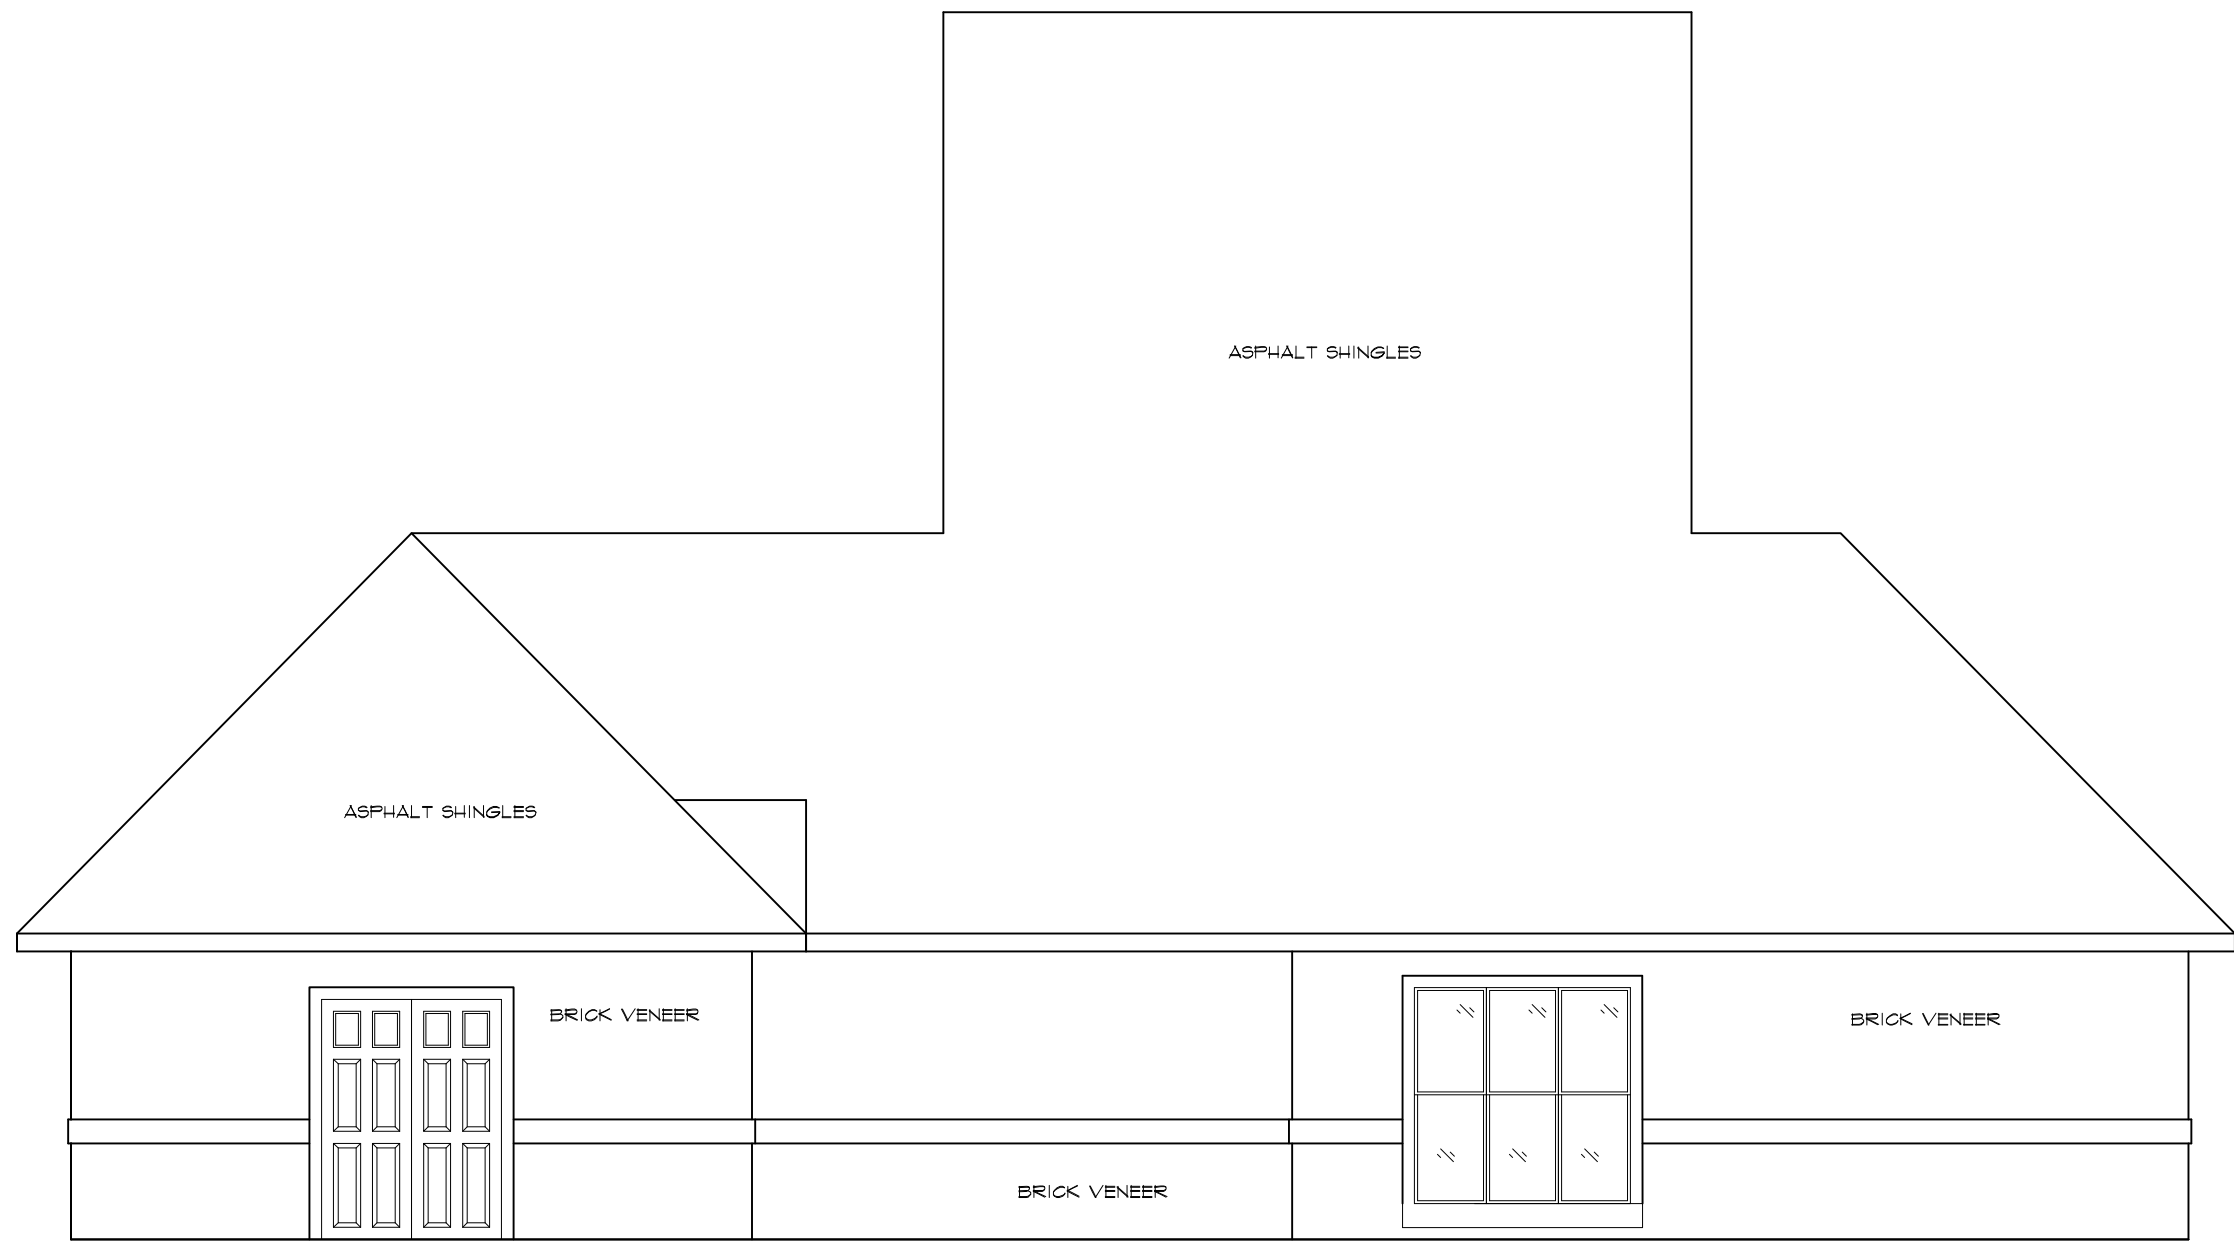


FITNESS CENTER LEFT SIDE ELEVATION 3/16"=1'-0"




FITNESS CENTER REAR ELEVATION 3/16"=1'-0"

ARCHITECTURAL AS BUILT
ALEXANDER PLACE
CHARLOTTE, NORTH CAROLINA


02	ADD PHOTO DOC KEY MAPS	
01	100% SUBMISSION	
NO.	ISSUES REVISIONS	DATE
		SHEET TITLE
HL	PROJECT MANAGER	
HL	PROJECT DIRECTOR	
9-2-16-1	PROJECT NUMBER	
AS NOTED	SCALE	
CL	DRAWN BY	
	SHEET NUMBER	

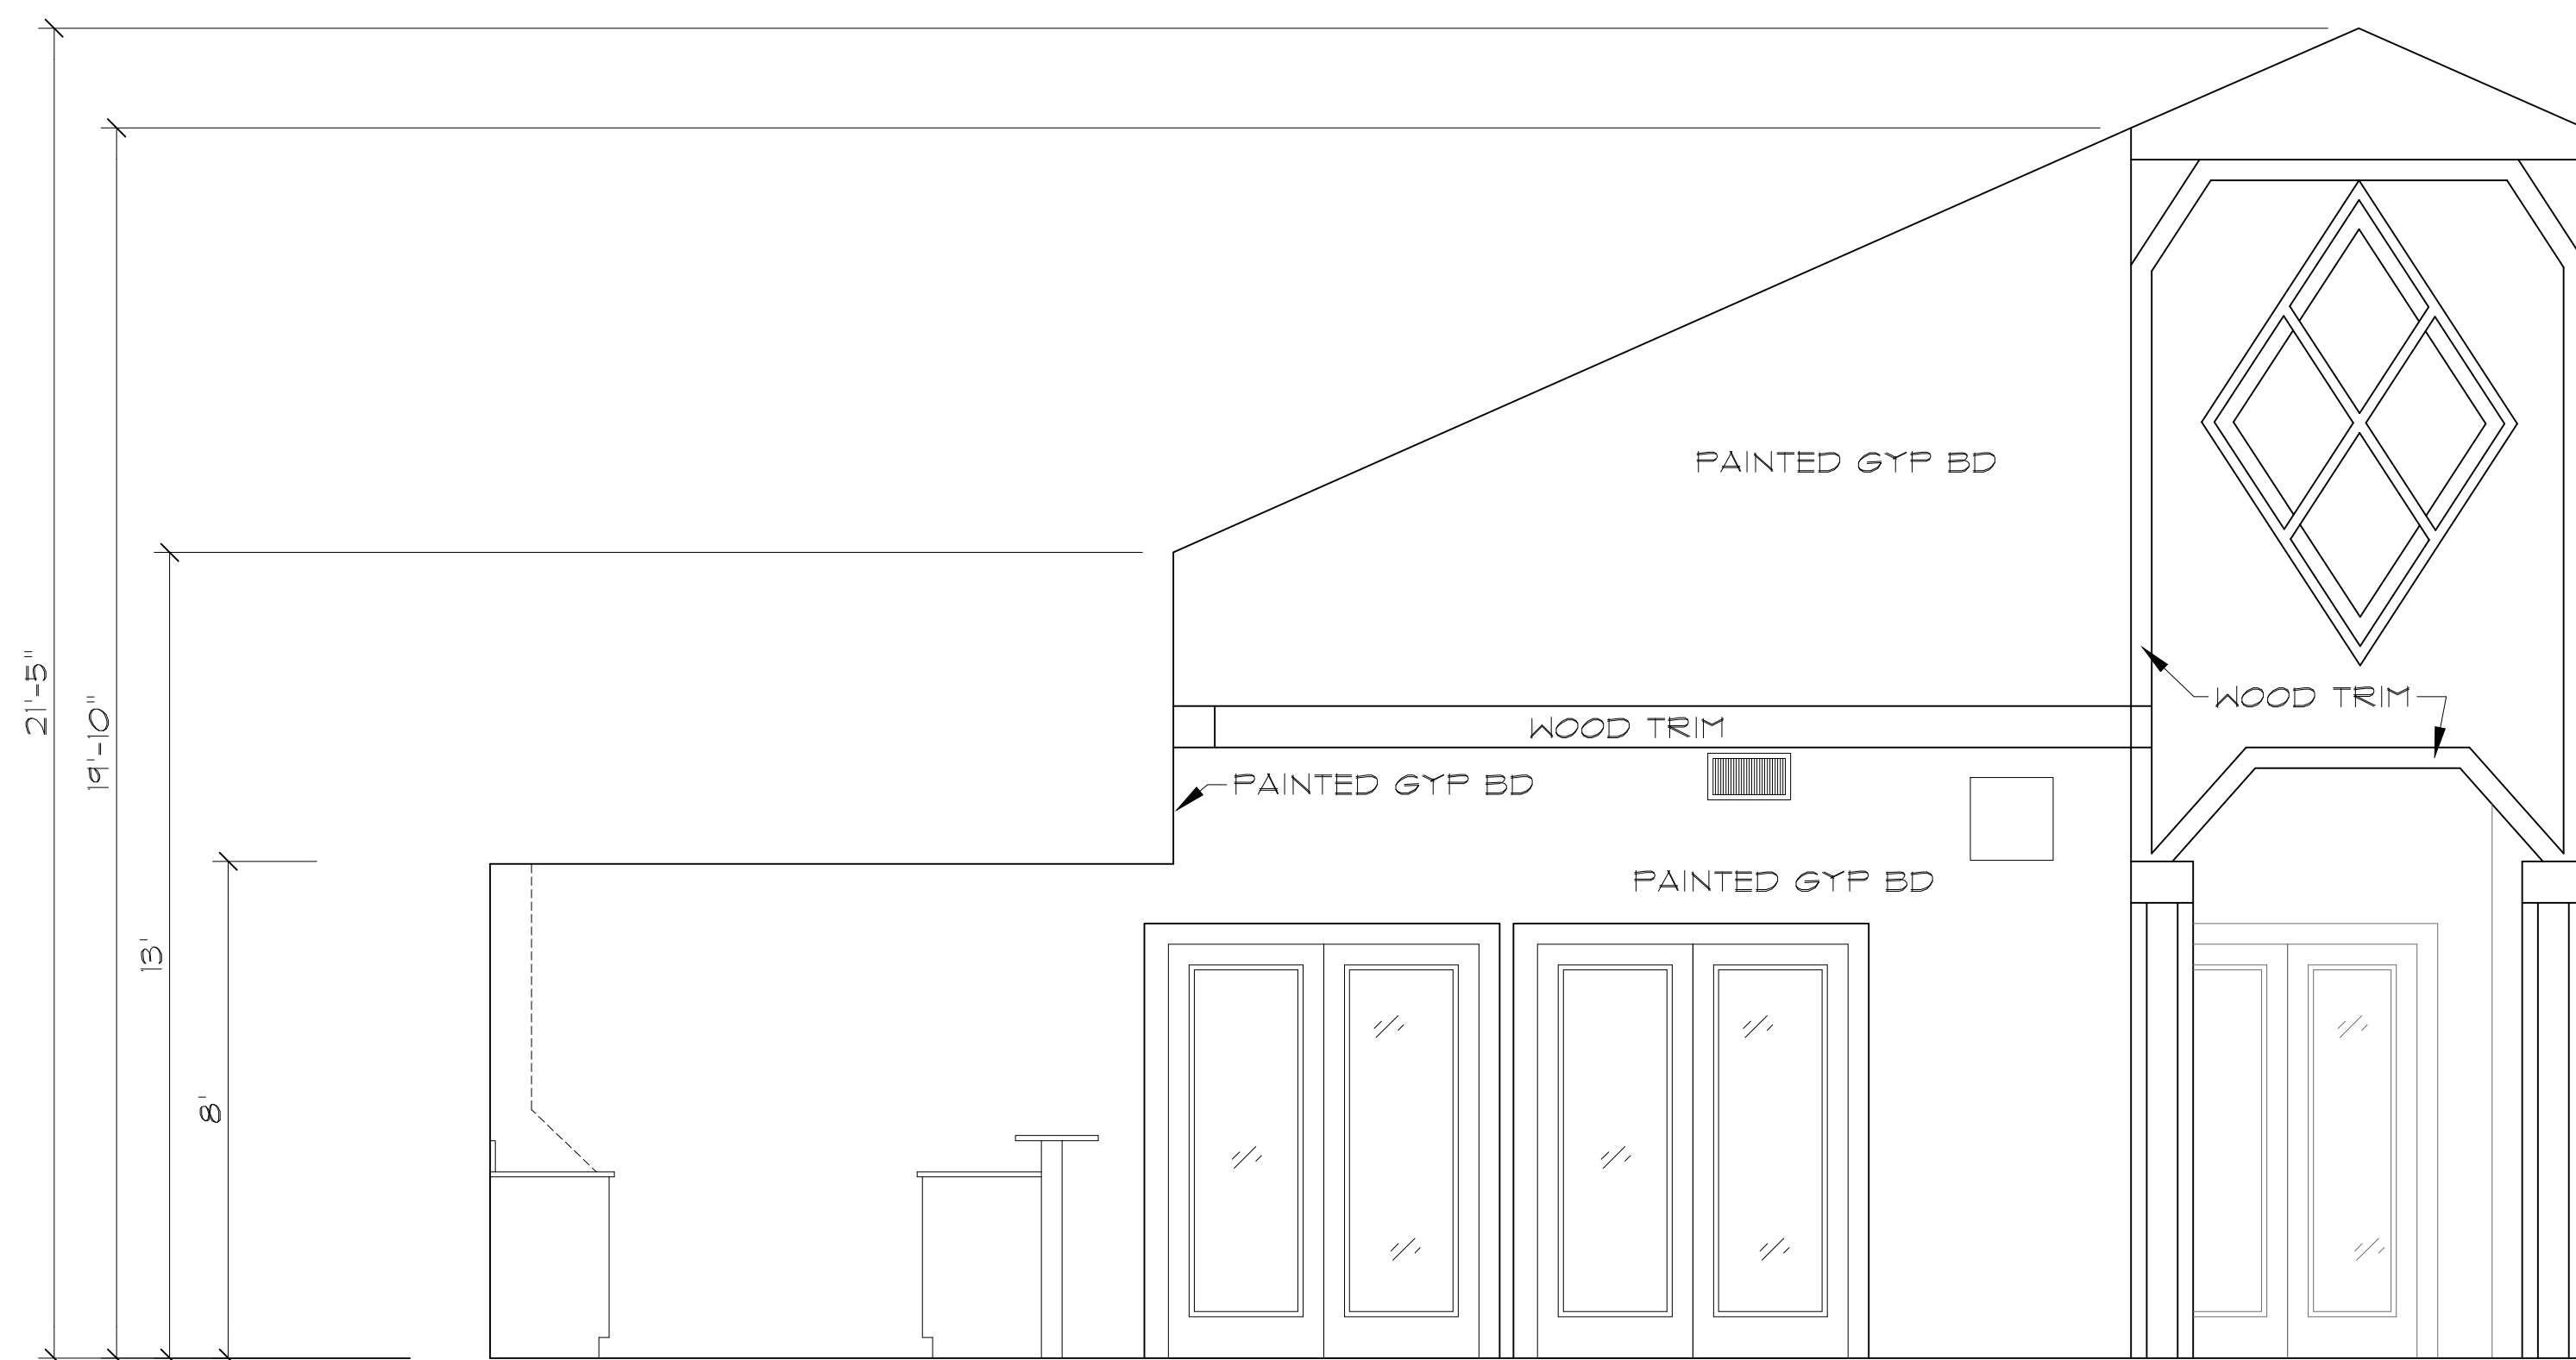


INTERIOR ELEVATION 1-B 3/8"=1'-0"

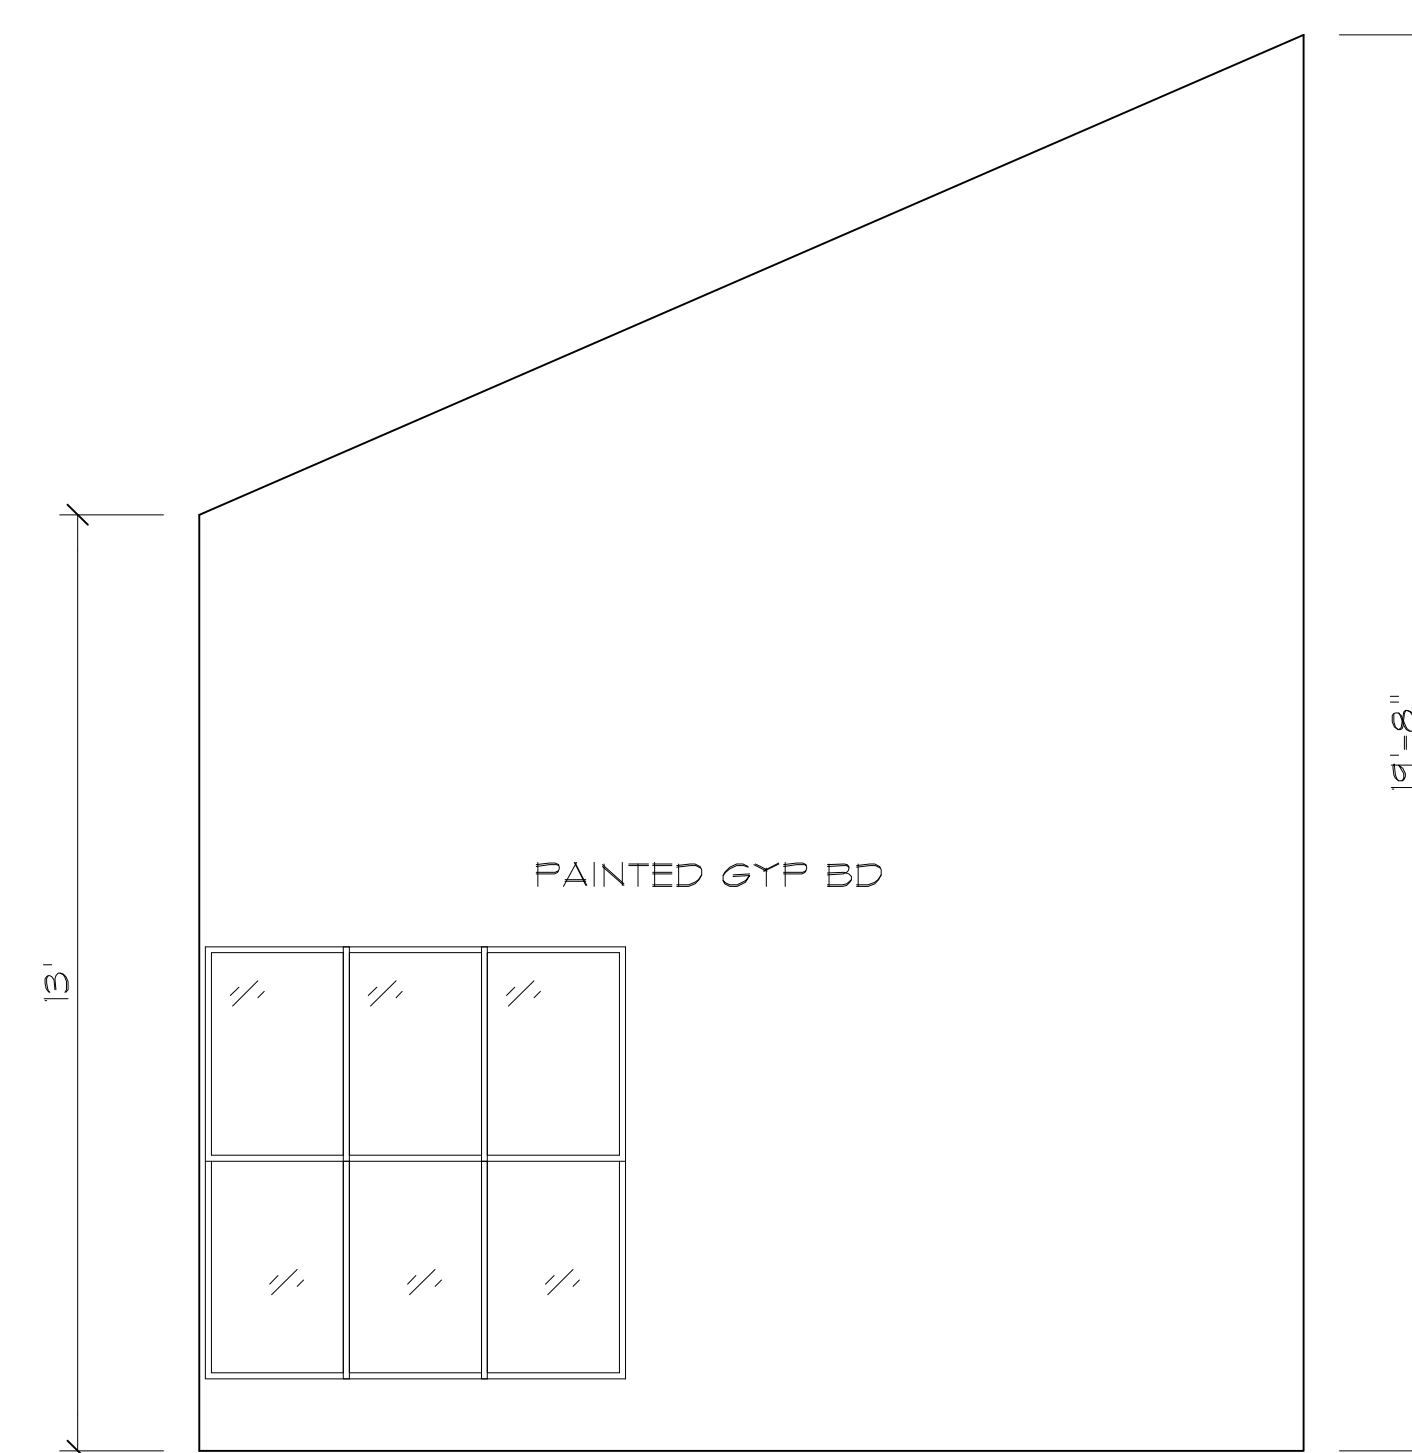

INTERIOR ELEVATION 3-D 3/8"=1'-0"

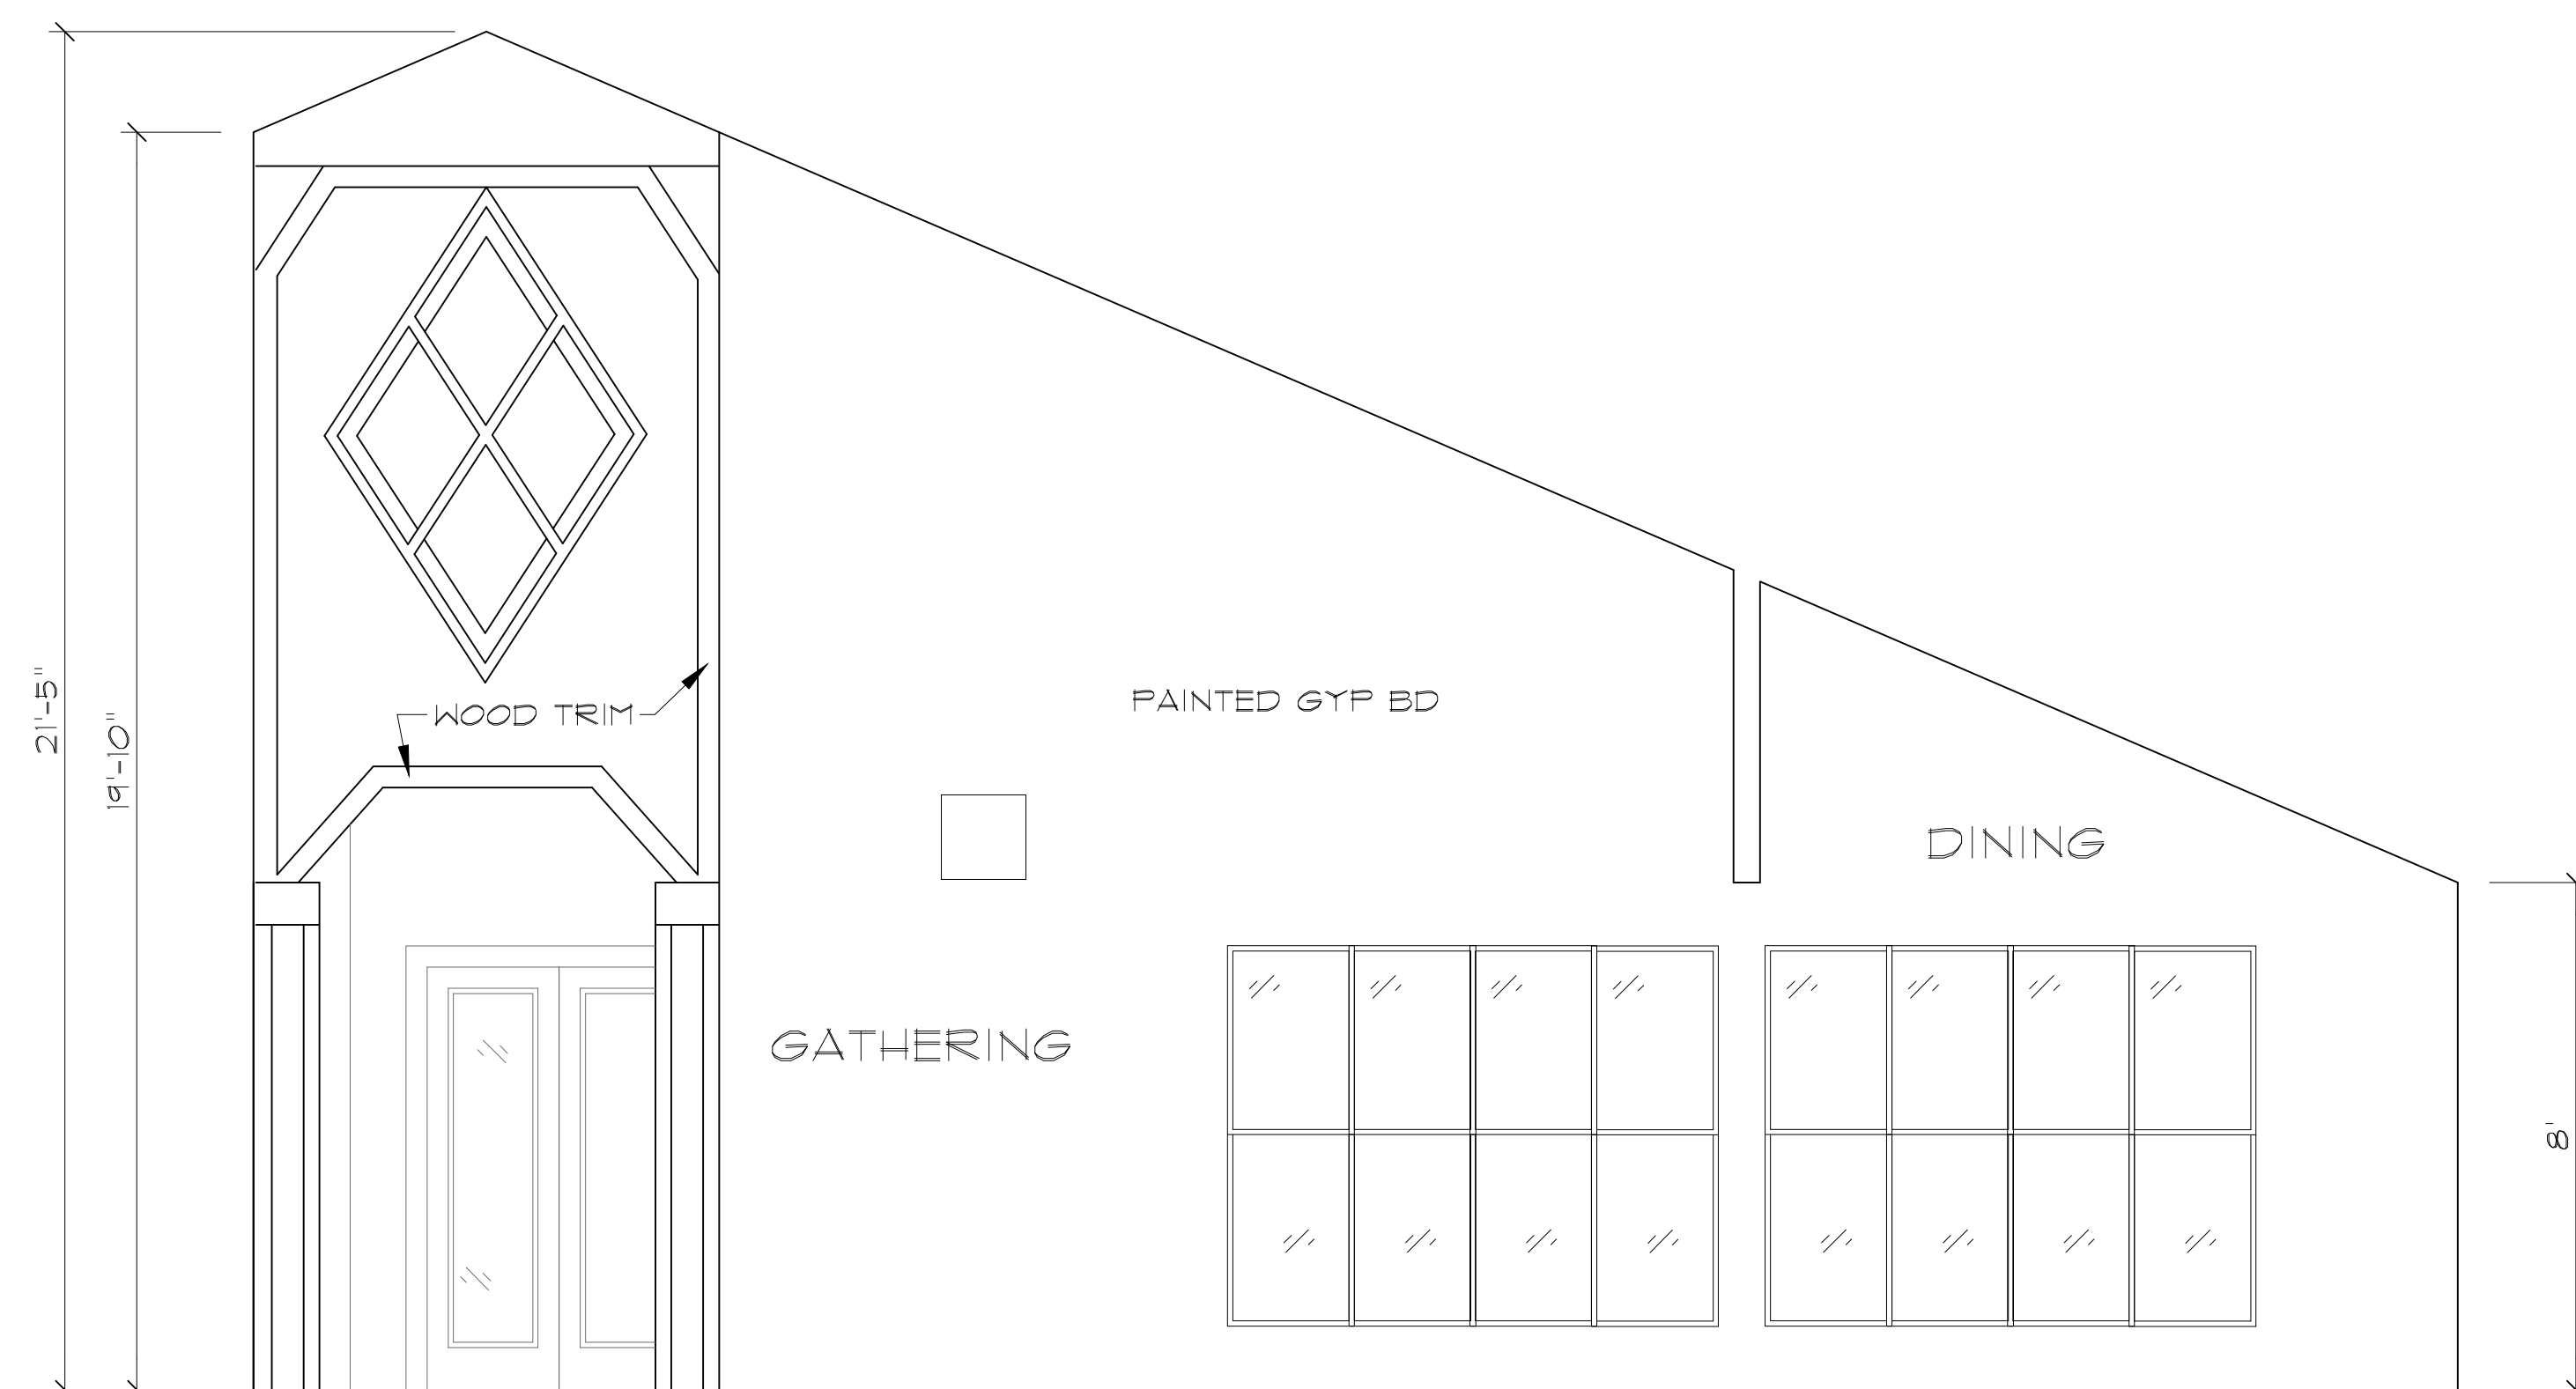

INTERIOR ELEVATION 1-C 3/8"=1'-0"

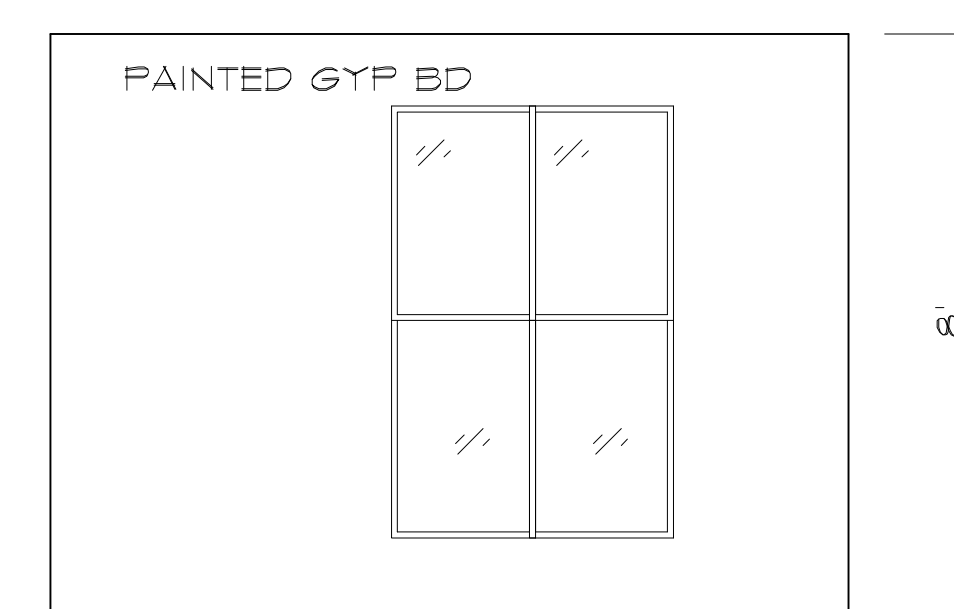


INTERIOR ELEVATION 2-A 3/8"=1'-0"

ARCHITECTURAL AS BUILT


ALEXANDER PLACE

CHARLOTTE, NORTH CAROLINA

02	ADD PHOTO DOC KEY MAPS	
01	100% SUBMISSION	
NO.	ISSUES REVISIONS	DATE
		SHEET TITLE
HL		PROJECT MANAGER
HL		PROJECT DIRECTOR
9-2-16-1		PROJECT NUMBER
AS NOTED		SCALE
CL		DRAWN BY
		SHEET NUMBER

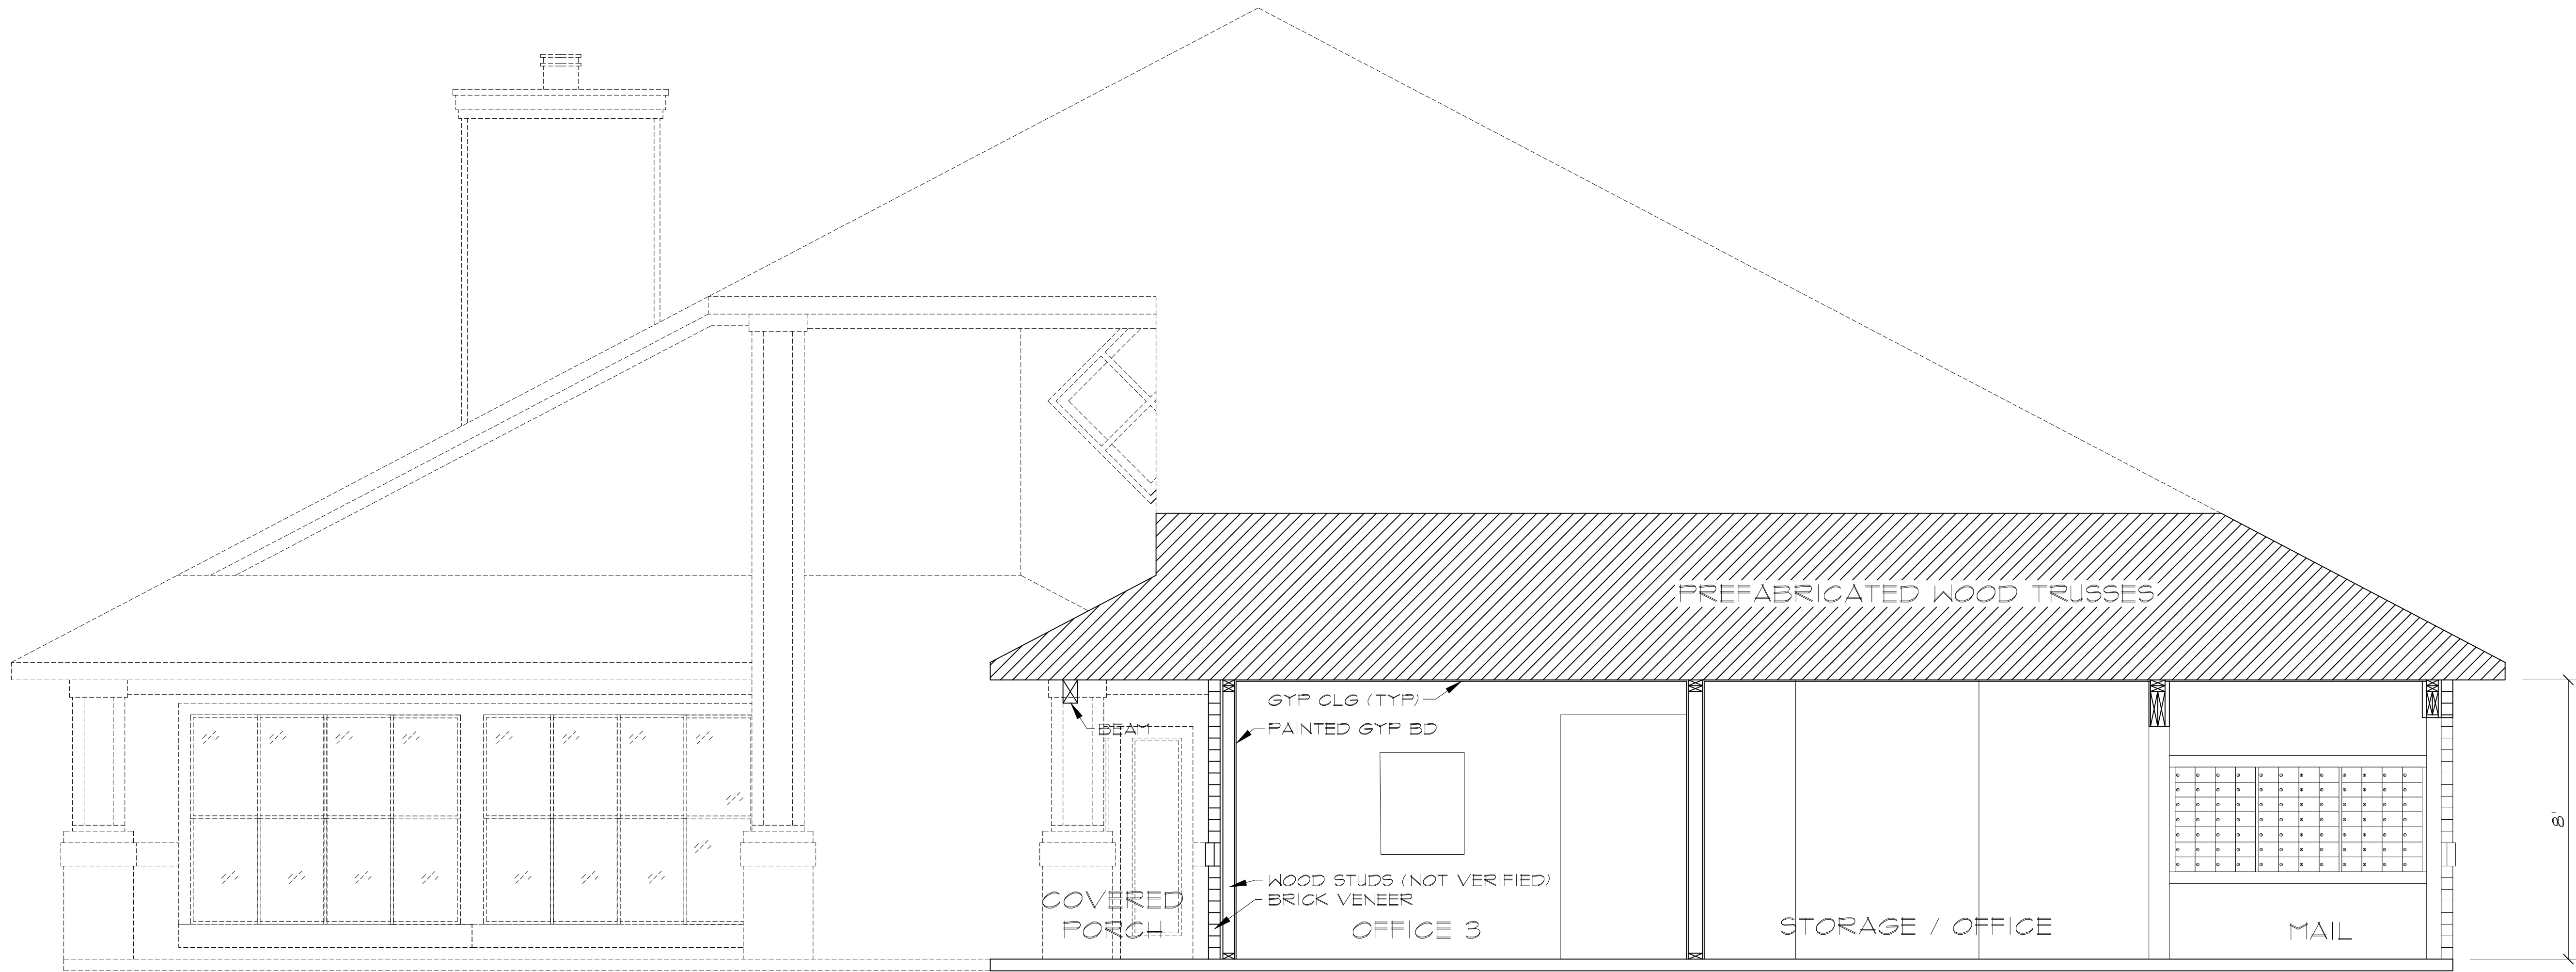

SECTION A-A 3/8"=1'-0"

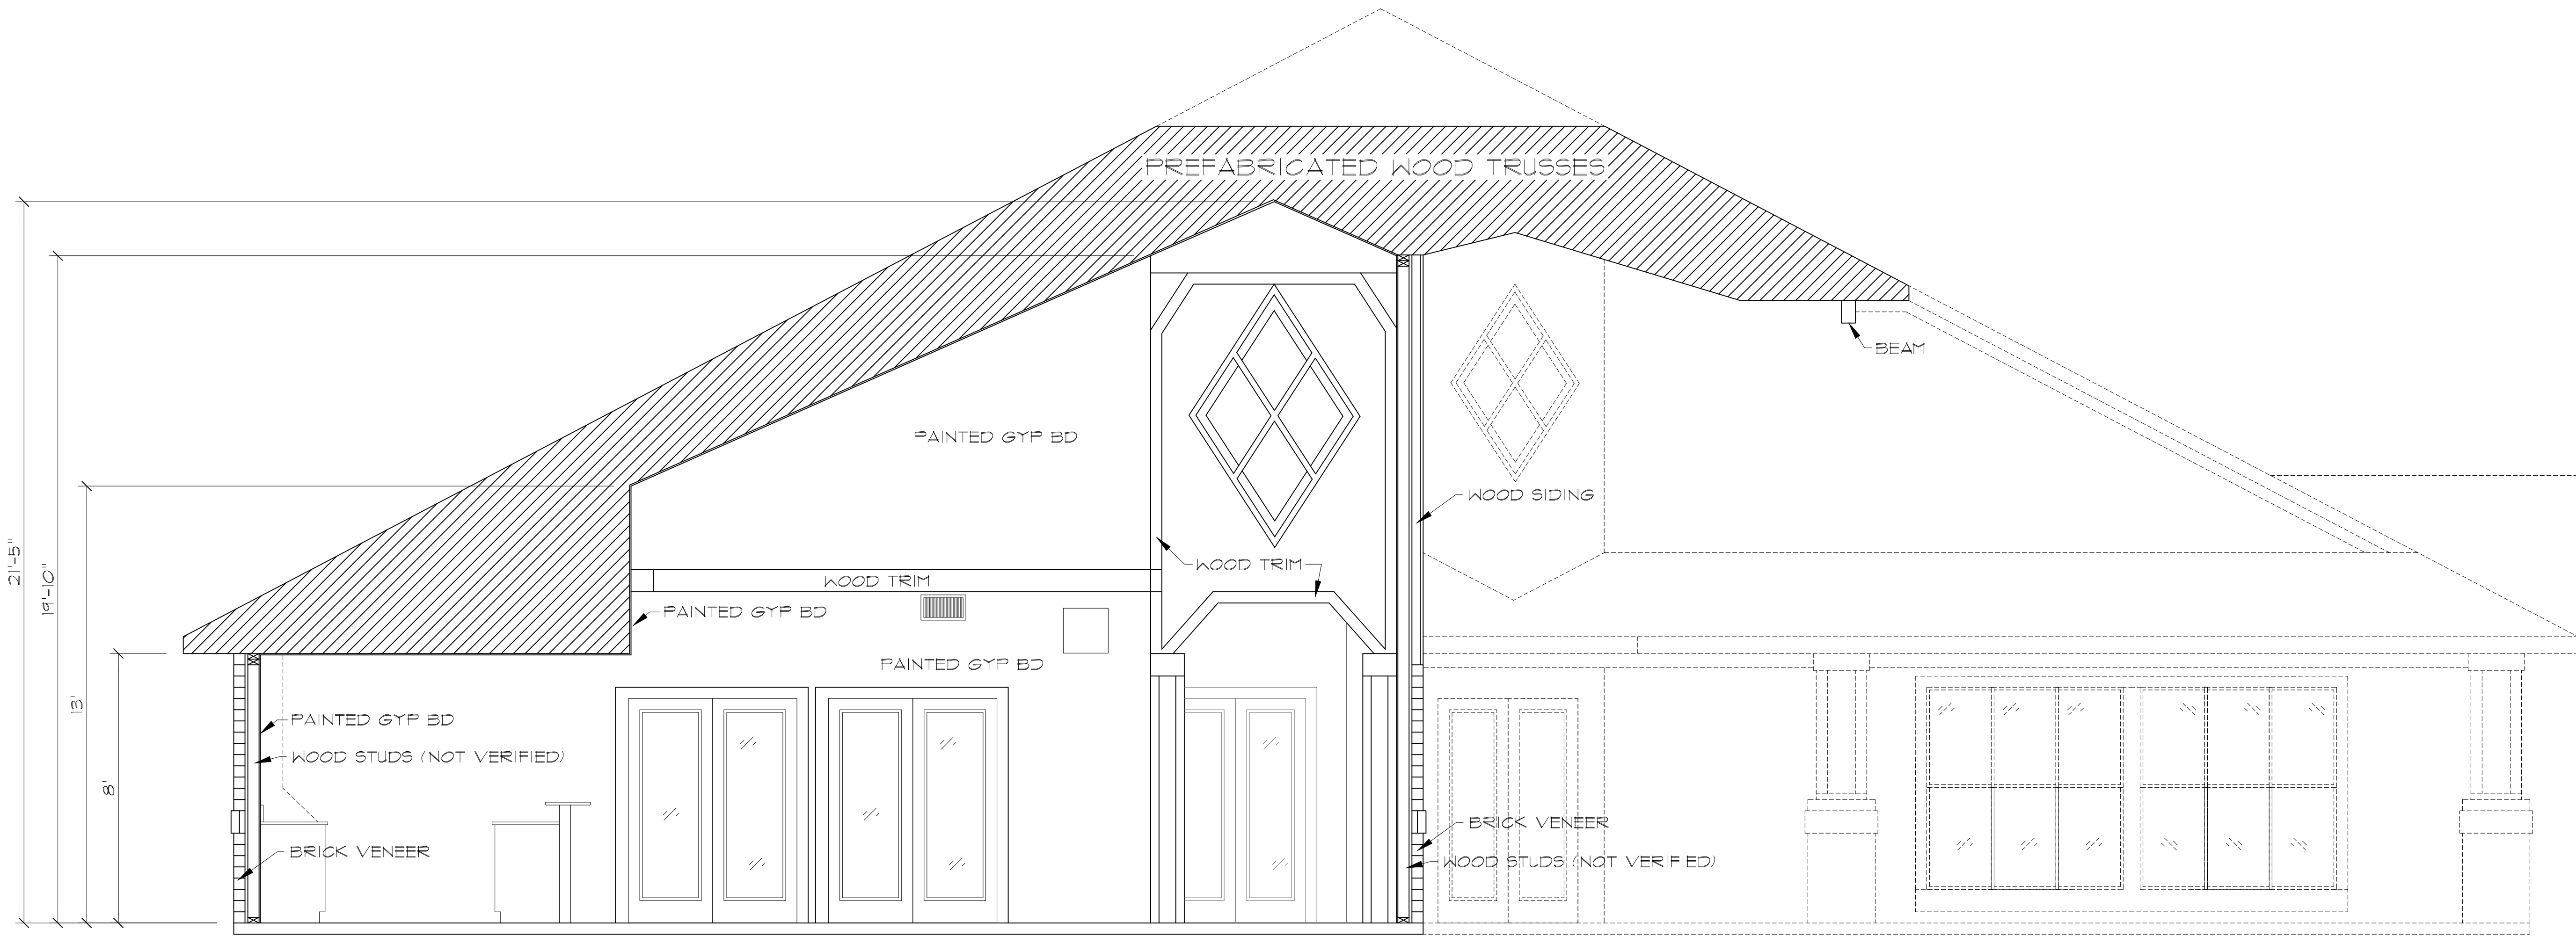

SECTION B-B 3/8"=1'-0"



© 2011 AEC CONSULTANTS INC.

ARCHITECTURAL AS BUILT
ALEXANDER PLACE
CHARLOTTE, NORTH CAROLINA

02 ADD PHOTO DOC KEY MAPS

01 100% SUBMISSION

NO. ISSUES | REVISIONS

DATE

SHEET TITLE

HL PROJECT MANAGER

HL PROJECT DIRECTOR



9-2-16-1 PROJECT NUMBER

AS NOTED SCALE

CL DRAWN BY

SHEET NUMBER

AB-6

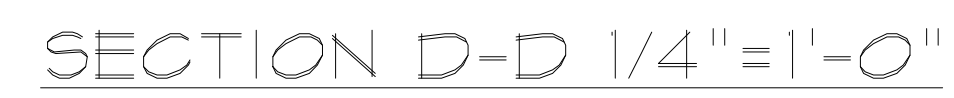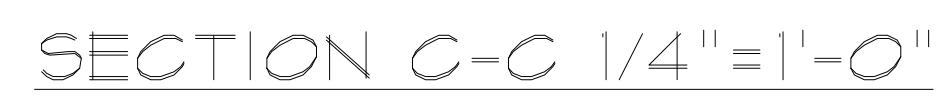


ARCHITECTURAL AS BUILT

ALEXANDER PLACE

CHARLOTTE, NORTH CAROLINA

AB-7

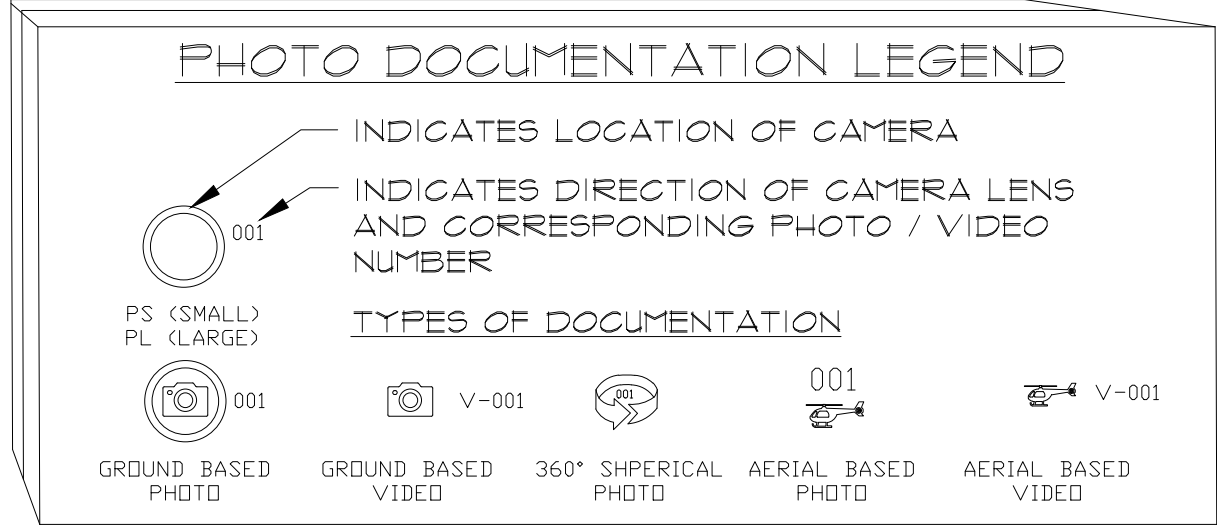

ARCHITECTURAL AS BUILT

ALEXANDER PLACE

CHARLOTTE, NORTH CAROLINA

02	ADD PHOTO DOC KEY MAPS	
01	100% SUBMISSION	
NO.	ISSUES REVISIONS	DATE
		SHEET TITLE
HL		PROJECT MANAGER
HL		PROJECT DIRECTOR
9-2-16-1		PROJECT NUMBER
AS NOTED		SCALE
CL		DRAWN BY
		SHEET NUMBER

AB-1