

# AS-BUILT DOCUMENTATION

MARRIETTA, GA 30067



100% SUBMITTAL

## DRAWING INDEX

- C-1 COVER SHEET | DRAWING INDEX
- AB-1 FIRST FLOOR PLAN
- AB-1a FIRST FLOOR PLAN CONTINUED
- AB-2 LOWER FLOOR PLAN
- AB-2a LOWER LEVEL PLAN CONTINUED
- AB-3 FIRST FLOOR REFLECTED CEILING PLAN
- AB-3a FIRST FLOOR REFLECTED CEILING PLAN CONTINUED
- AB-4 LOWER LEVEL REFLECTED CEILING PLAN
- AB-4a LOWER LEVEL REFLECTED CEILING PLAN CONTINUED
- AB-5 FRONT AND REAR ELEVATIONS
- AB-5a LEFT AND RIGHT ELEVATIONS

AREA DATA		
FIRST FLOOR		10,213 S.F. ±
LOWER LEVEL		11,676 S.F. ±
SERVICE PARKING AND PREP (LOWER LEVEL)		24,531 S.F. ±
OUTDOOR SHOW AREA		3,975 S.F. ±
GRAND TOTAL		50,461 S.F. ±

As BUILT

PROFESSIONALS

www.asbuiltprofessionals.com

A DIVISION OF:

AEC

CONSULTANTS INC

844.272.8458

844 AS BUILT


© 2019 AEC CONSULTANTS INC

ARCHITECTURAL AS BUILT  
SELECT LUXURY CARS  
MARRIETTA, GA 30060


01	100% SUBMISSION	SEE COVER SHEET
NO.	ISSUES   REVISIONS	DATE
		SHEET TITLE
COVER SHEET		
HL	PROJECT MANAGER	
HL	PROJECT DIRECTOR	
012317-1		PROJECT NUMBER
		SCALE
CL	DRAWN BY	
		SHEET NUMBER

C-1



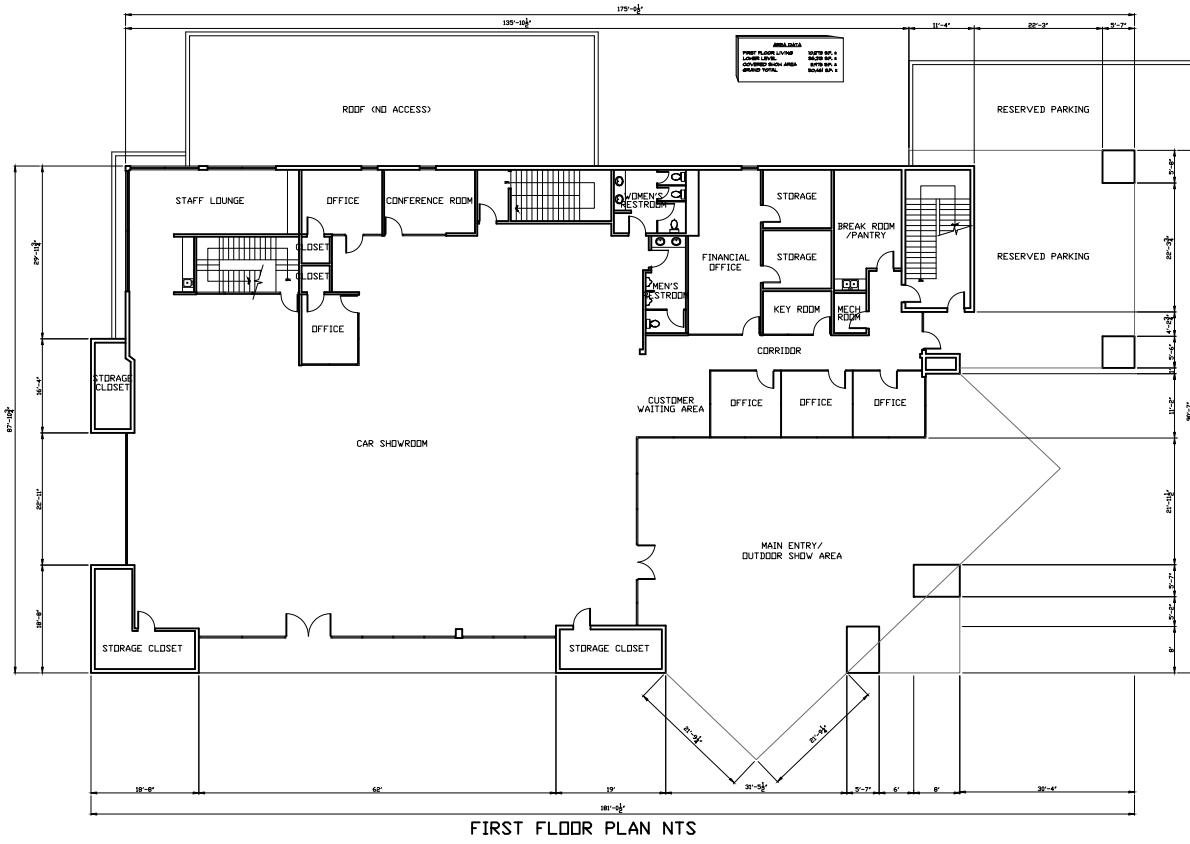

FIRST FLOOR PLAN NTS

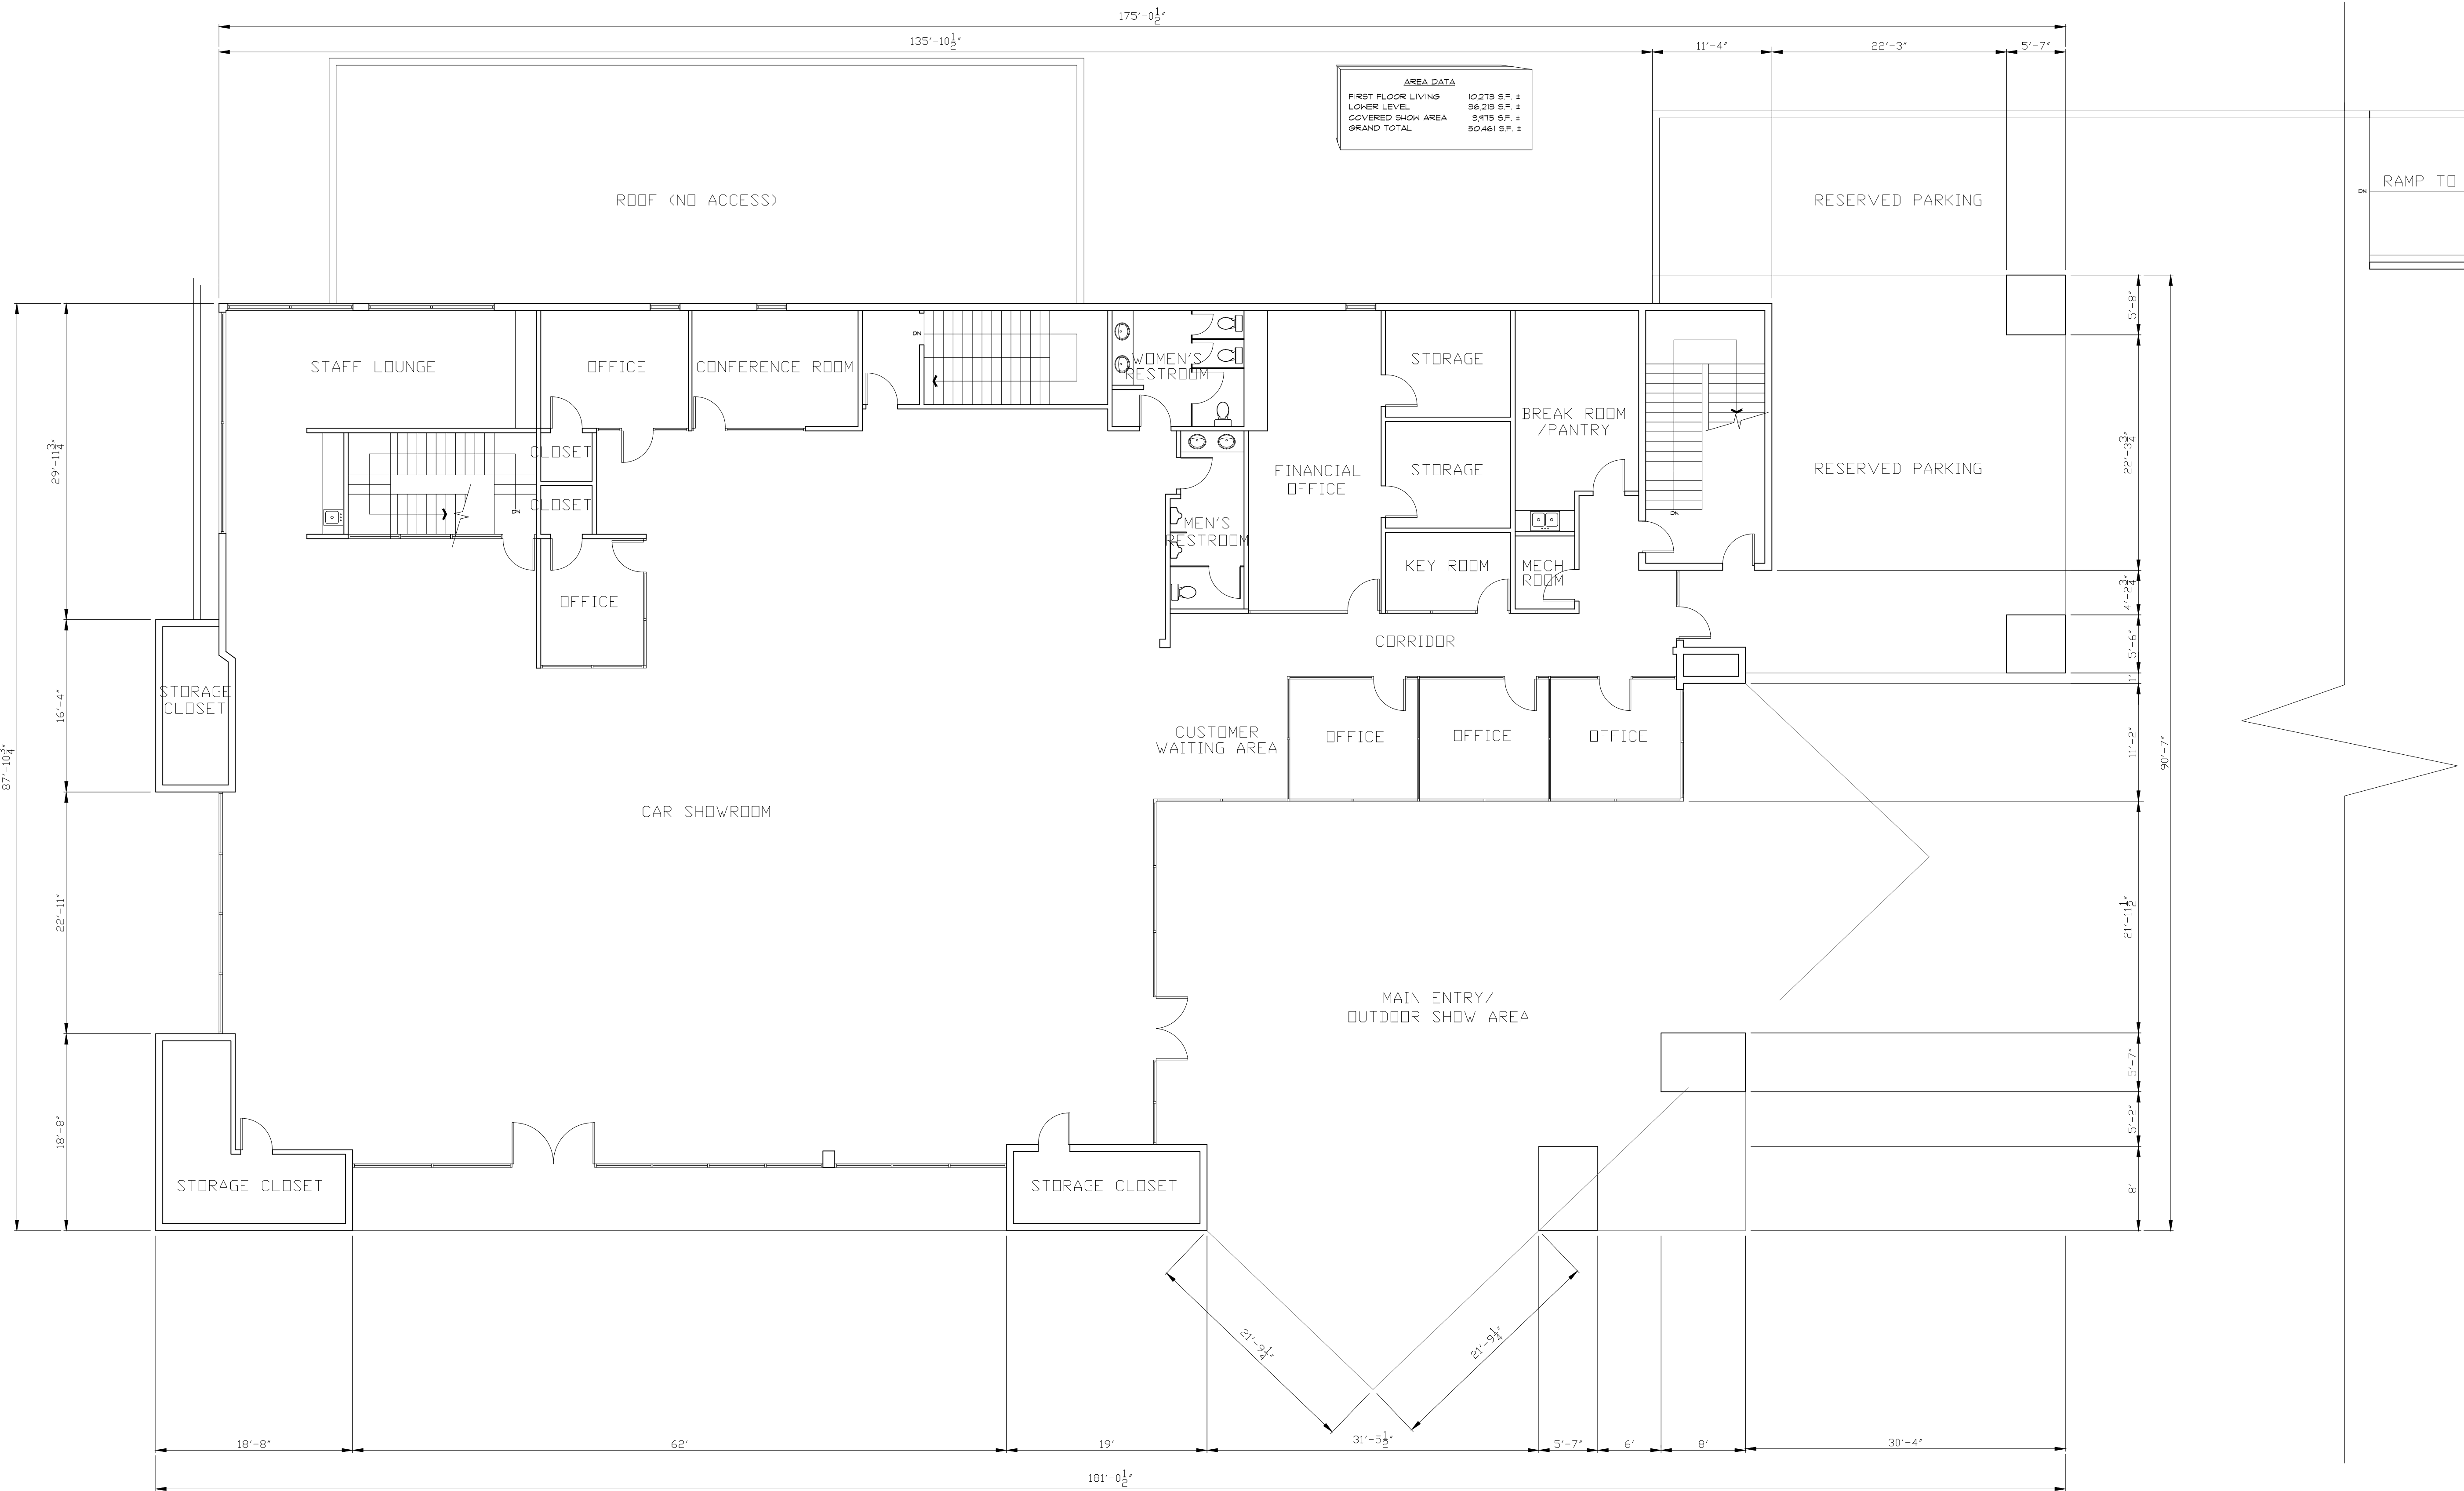

FIRST FLOOR PLAN

As BUILT

PROFESSIONALS

www.asbuiltprofessionals.com

A DIVISION OF:

AEC

CONSULTANTS INC

844.272.8458

844 AS BUILT

© 2019 AEC CONSULTANTS INC

ARCHITECTURAL AS BUILT  
SELECT LUXURY CARS



MARIETTA, GA 30060

01	100% SUBMISSION	SEE COVER SHEET
NO.	ISSUES   REVISIONS	DATE
		SHEET TITLE
HL	PROJECT MANAGER	
HL	PROJECT DIRECTOR	
012317-1	PROJECT NUMBER	
1/8"=1'-0"		SCALE
CL	DRAWN BY	
		SHEET NUMBER

AB-1



**MARRIETTA, GA 30060**

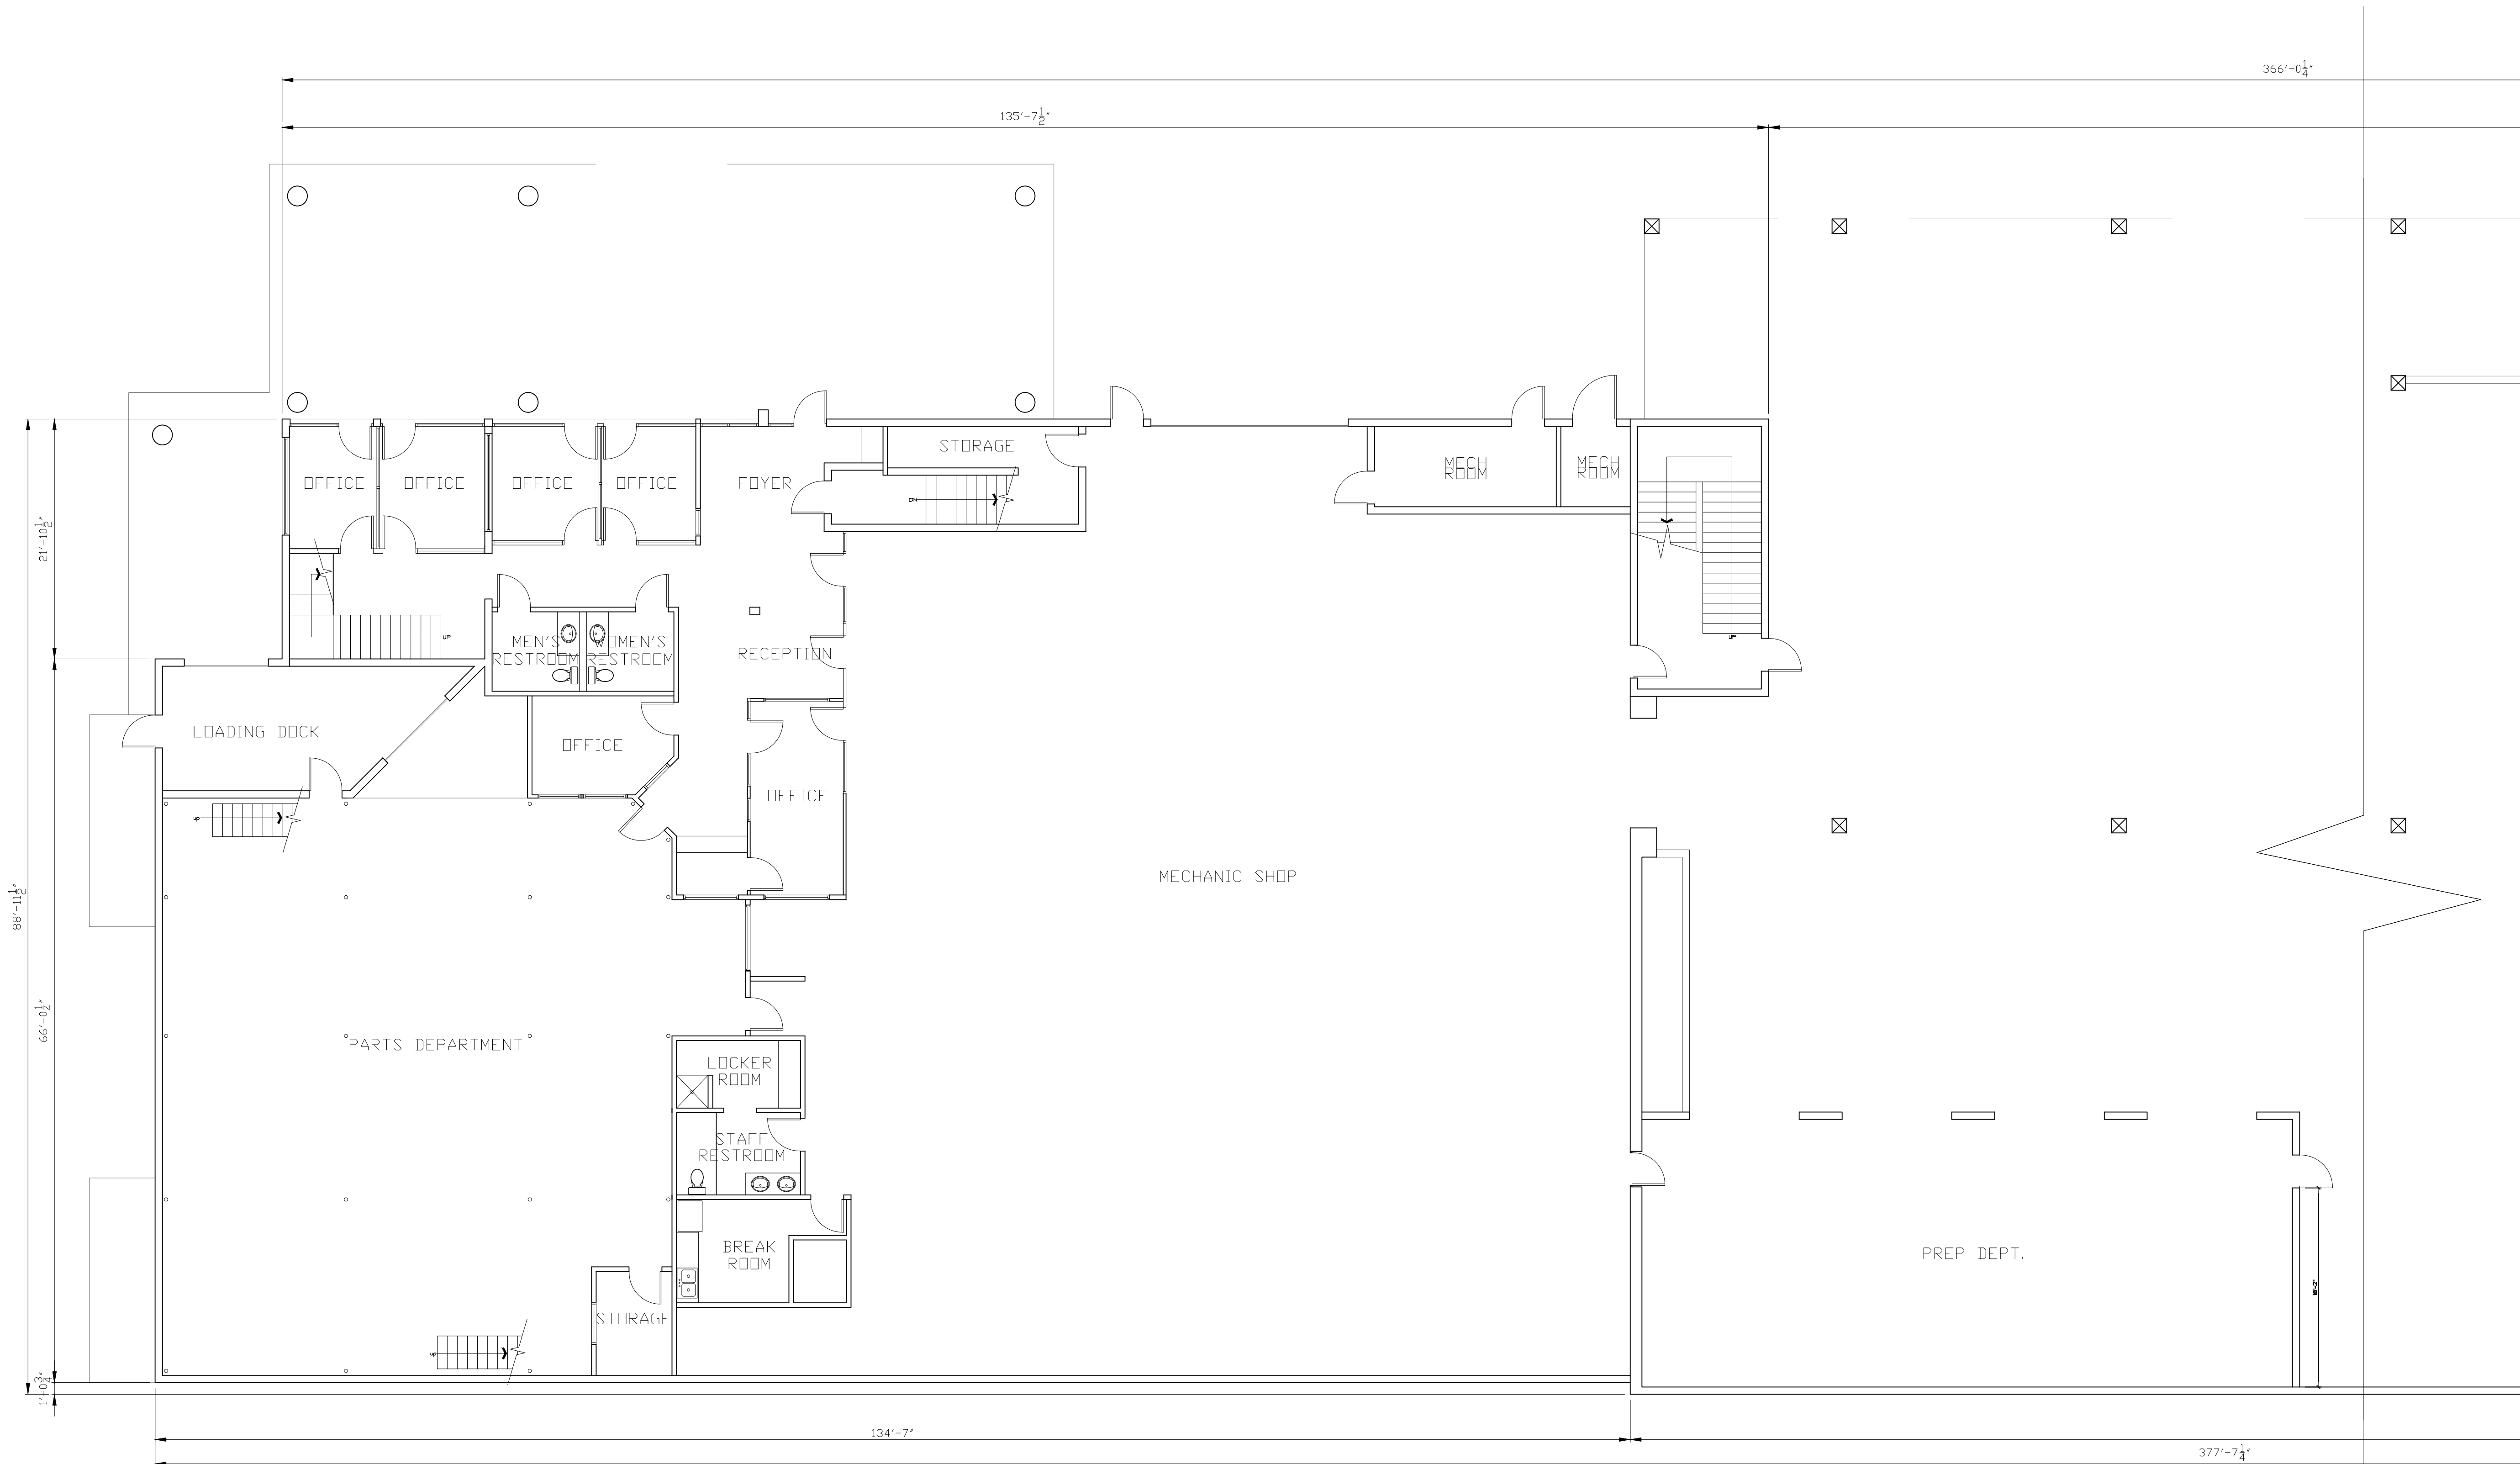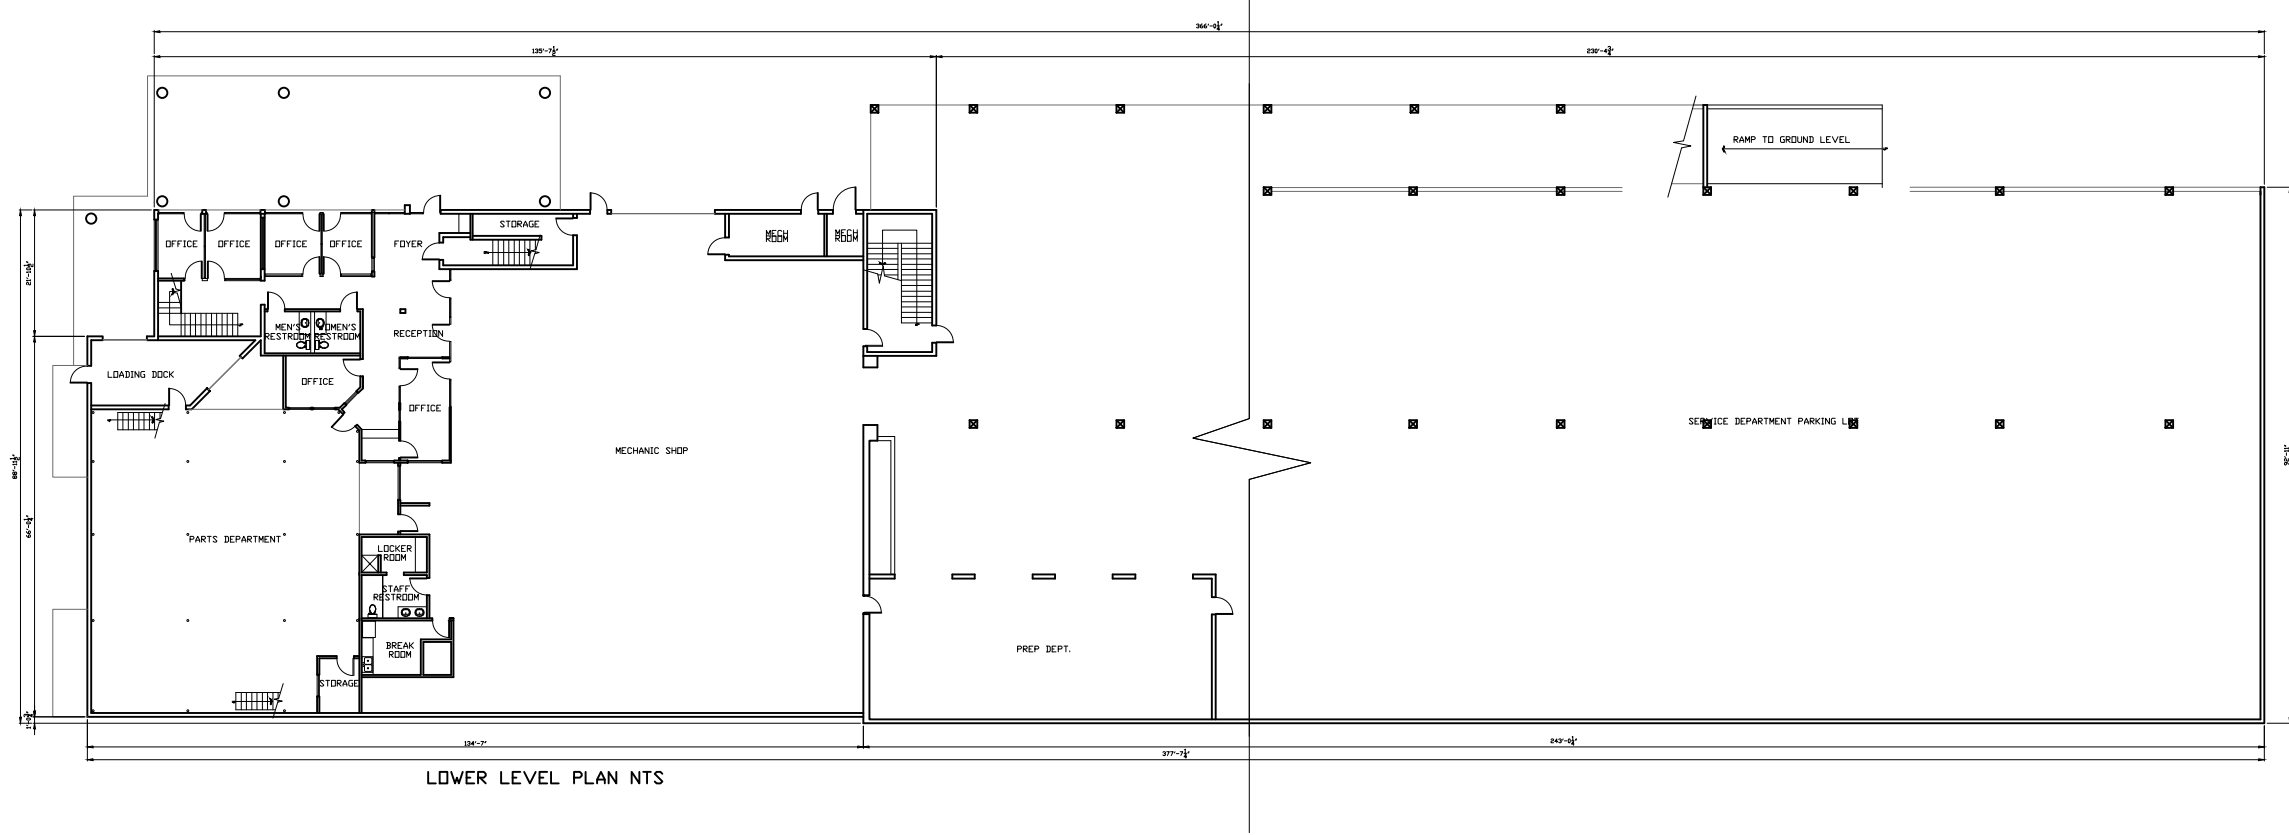

LOWER LEVEL PLAN

As BUILT

PROFESSIONALS

www.asbuiltprofessionals.com

A DIVISION OF:

AEC

CONSULTANTS INC

844.272.8458

844 AS BUILT


© 2019 AEC CONSULTANTS INC

ARCHITECTURAL AS BUILT  
SELECT LUXURY CARS

MARIETTA, GA 30060

01	100% SUBMISSION	SEE COVER SHEET
NO.	ISSUES   REVISIONS	DATE
		SHEET TITLE
HL	PROJECT MANAGER	
HL	PROJECT DIRECTOR	
012317-1	PROJECT NUMBER	
1/8"=1'-0"	SCALE	
CL	DRAWN BY	
	SHEET NUMBER	



AB-2

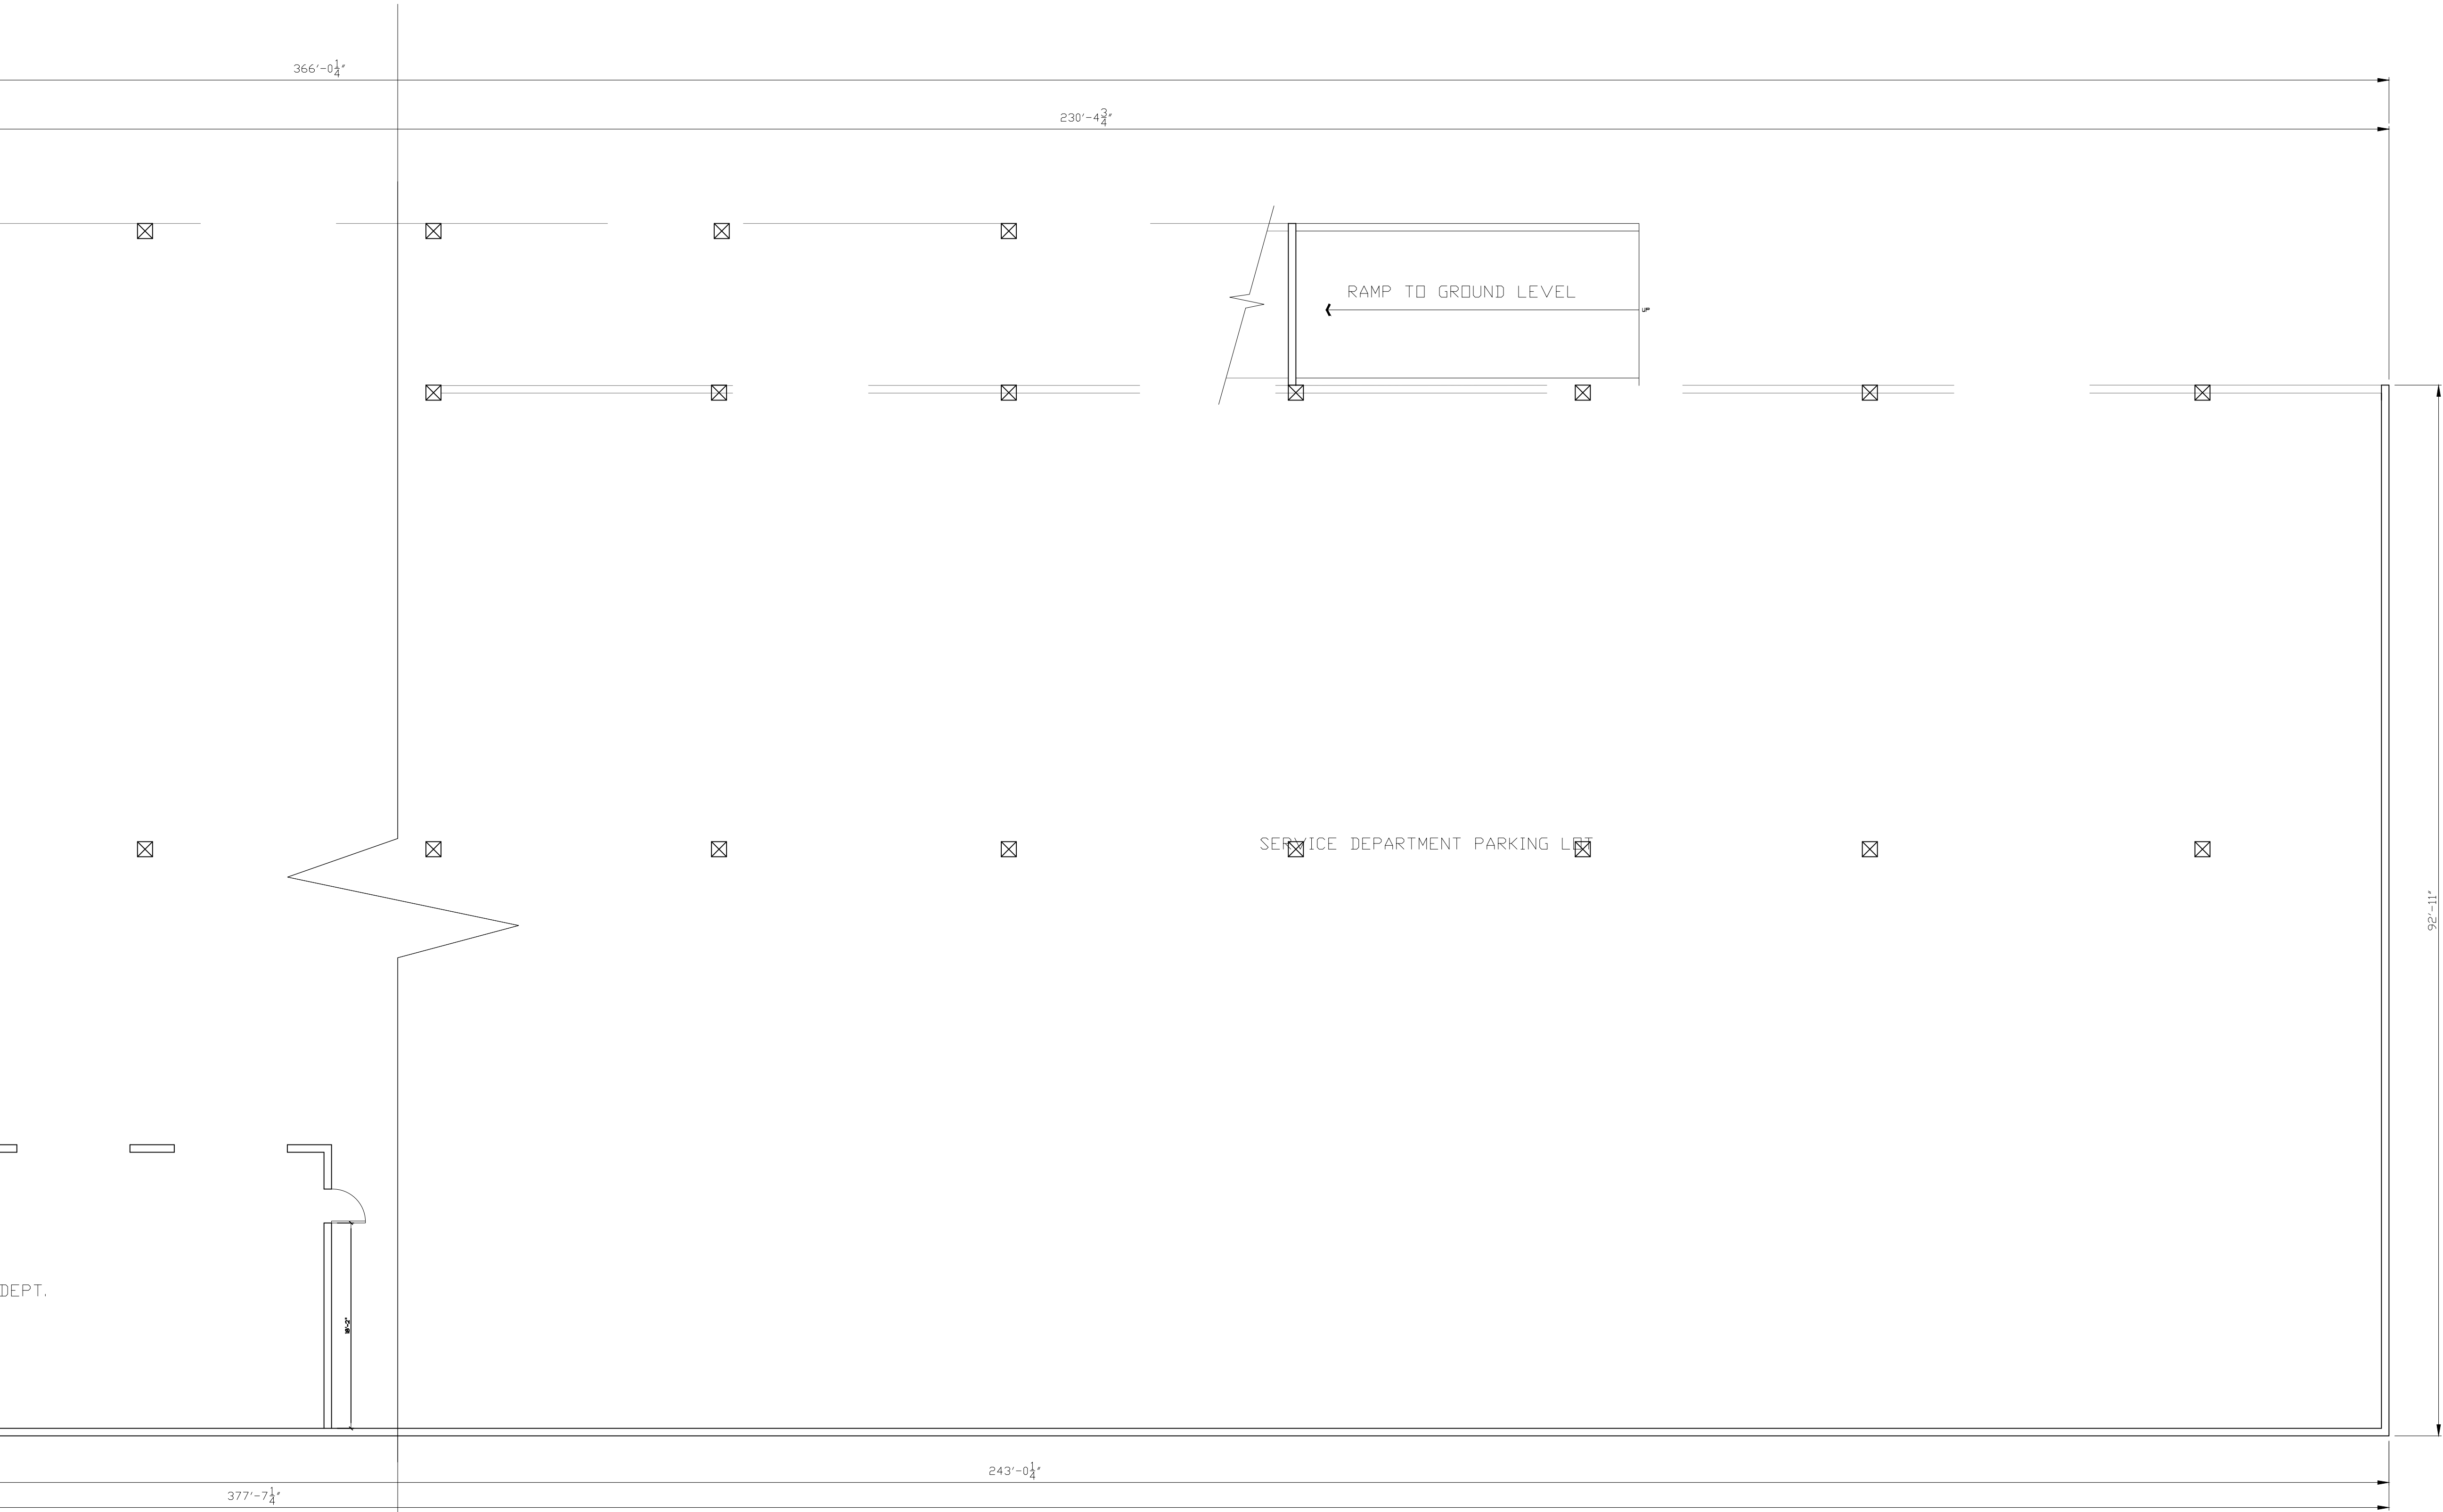

**ARCHITECTURAL AS BUILT  
SELECT LUXURY CARS**

01	100% SUBMISSION	SEE COVER SHEET
NO.	ISSUES   REVISIONS	DATE
		SHEET TITLE
HL		PROJECT MANAGER
HL		PROJECT DIRECTOR
012317-1		PROJECT NUMBER
<b>1/8"=1'-0"</b>		SCALE
CL		DRAWN BY
		SHEET NUMBER

# AB-2a

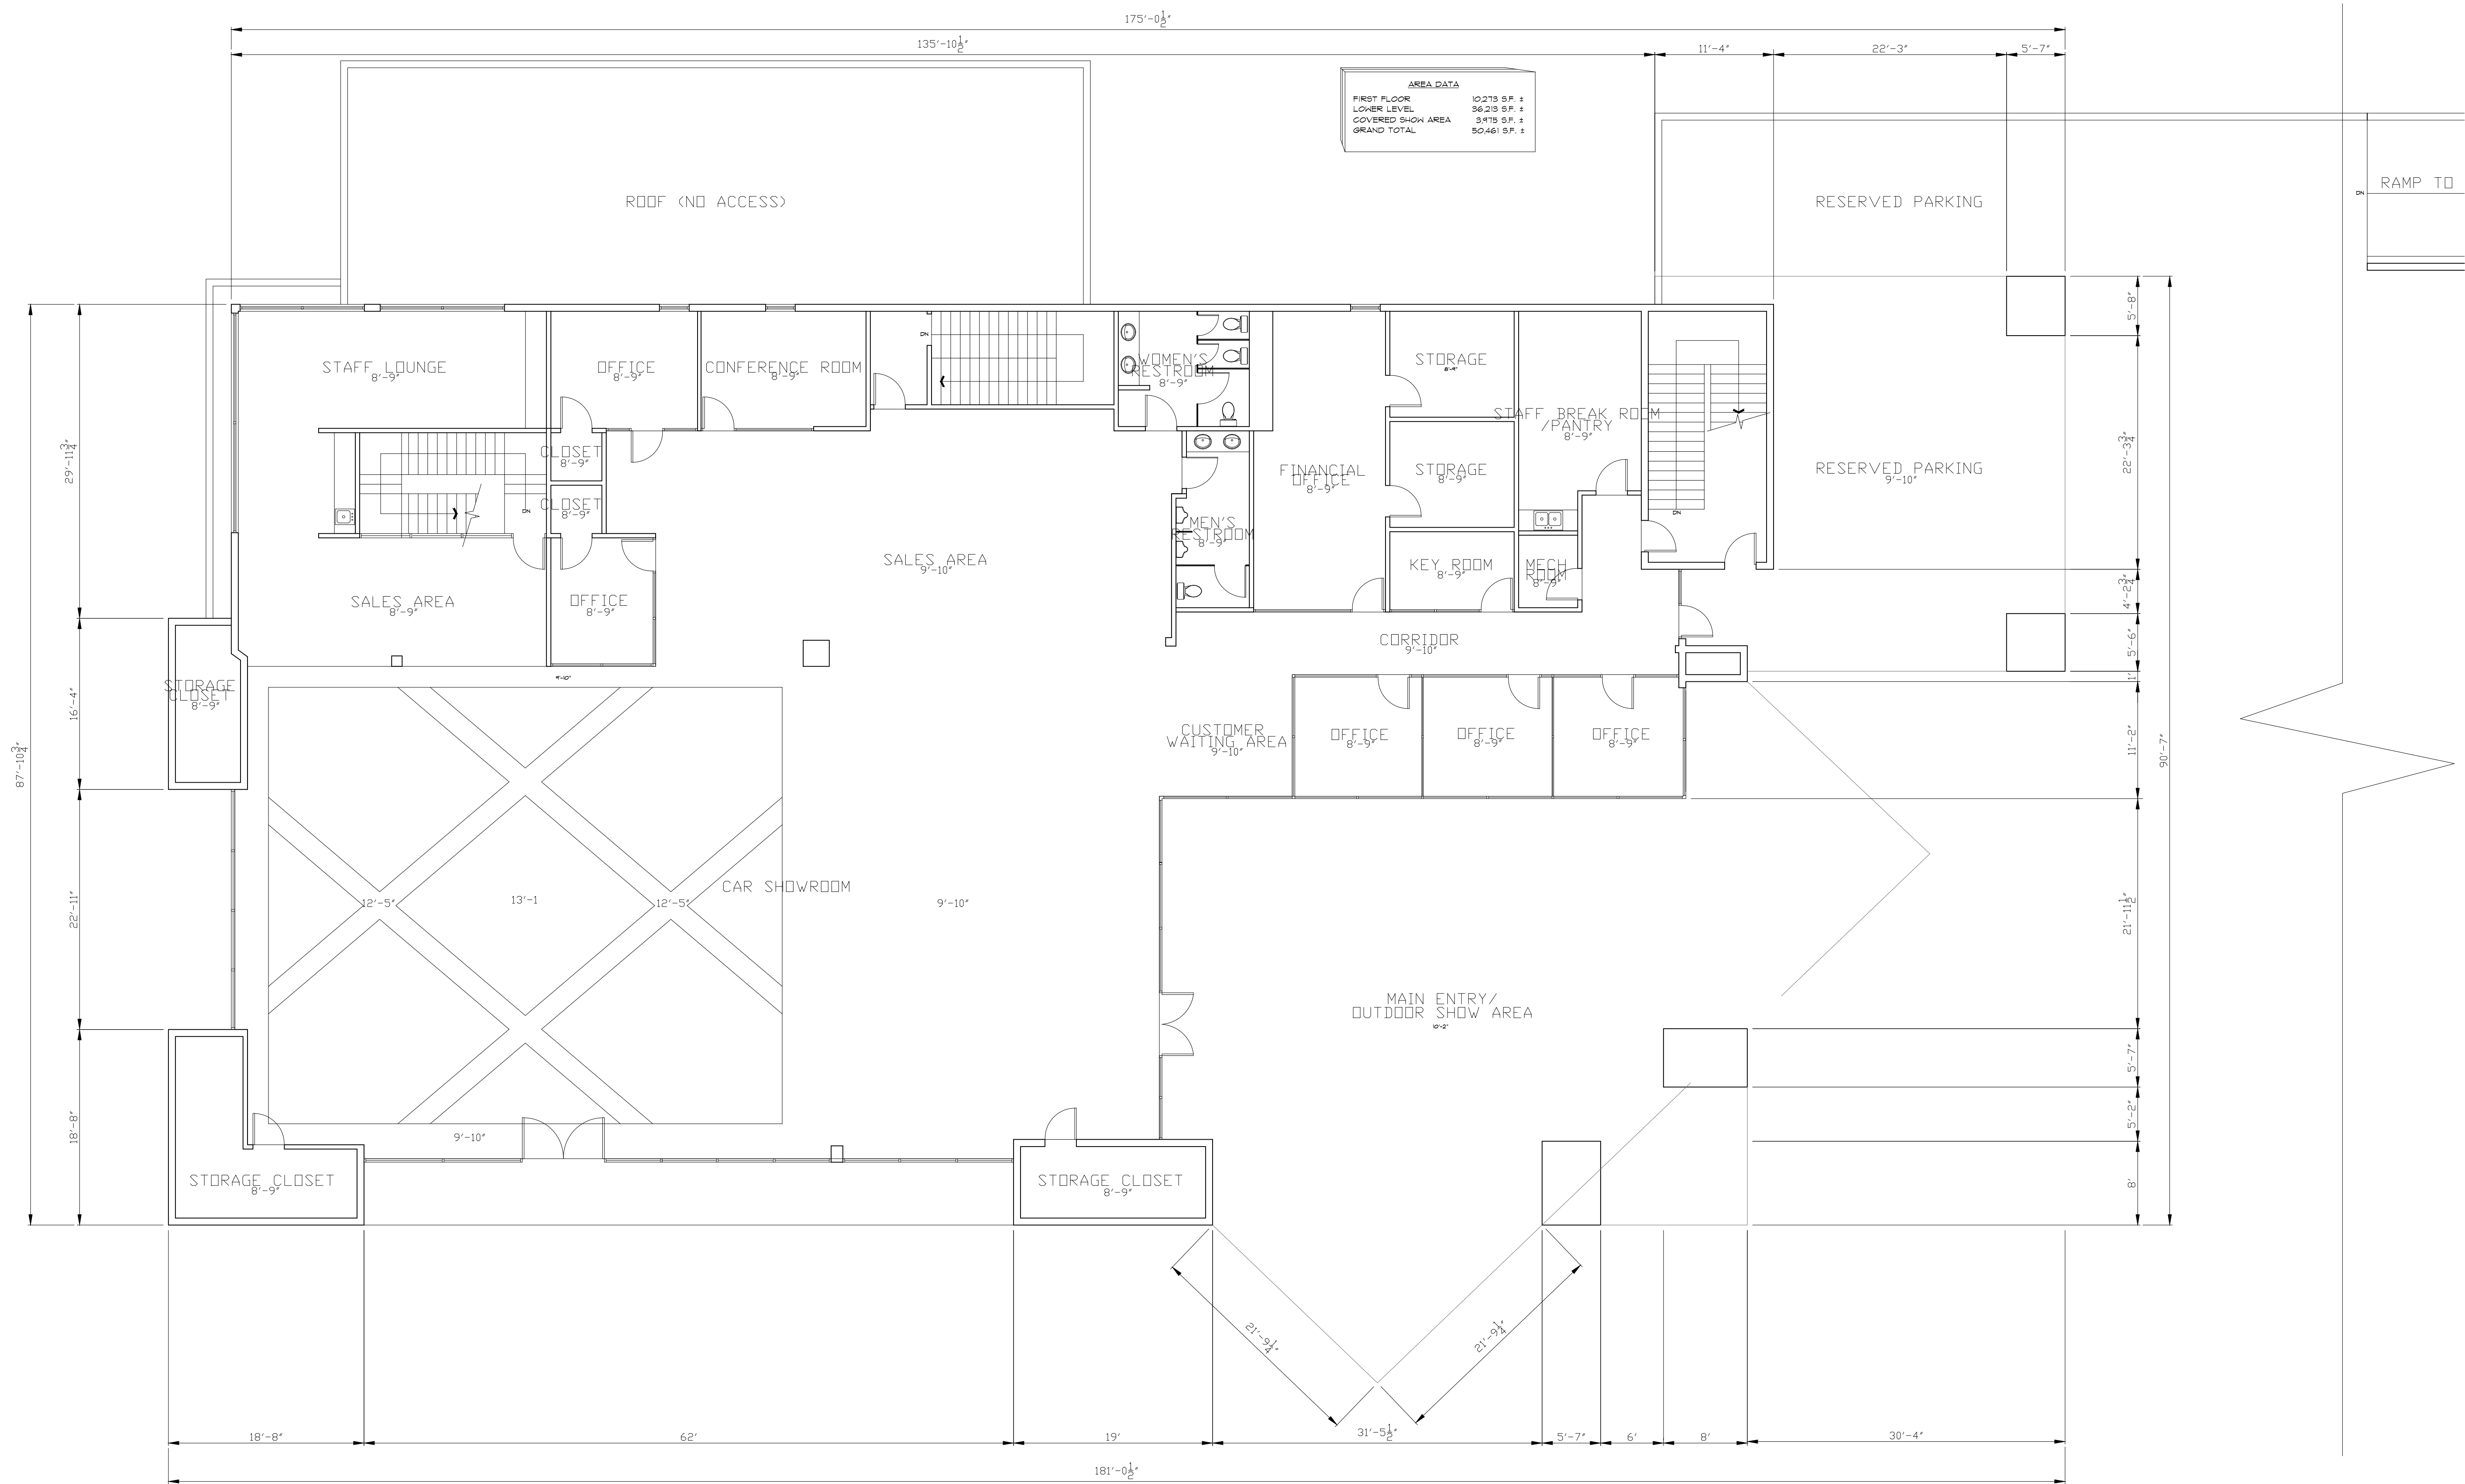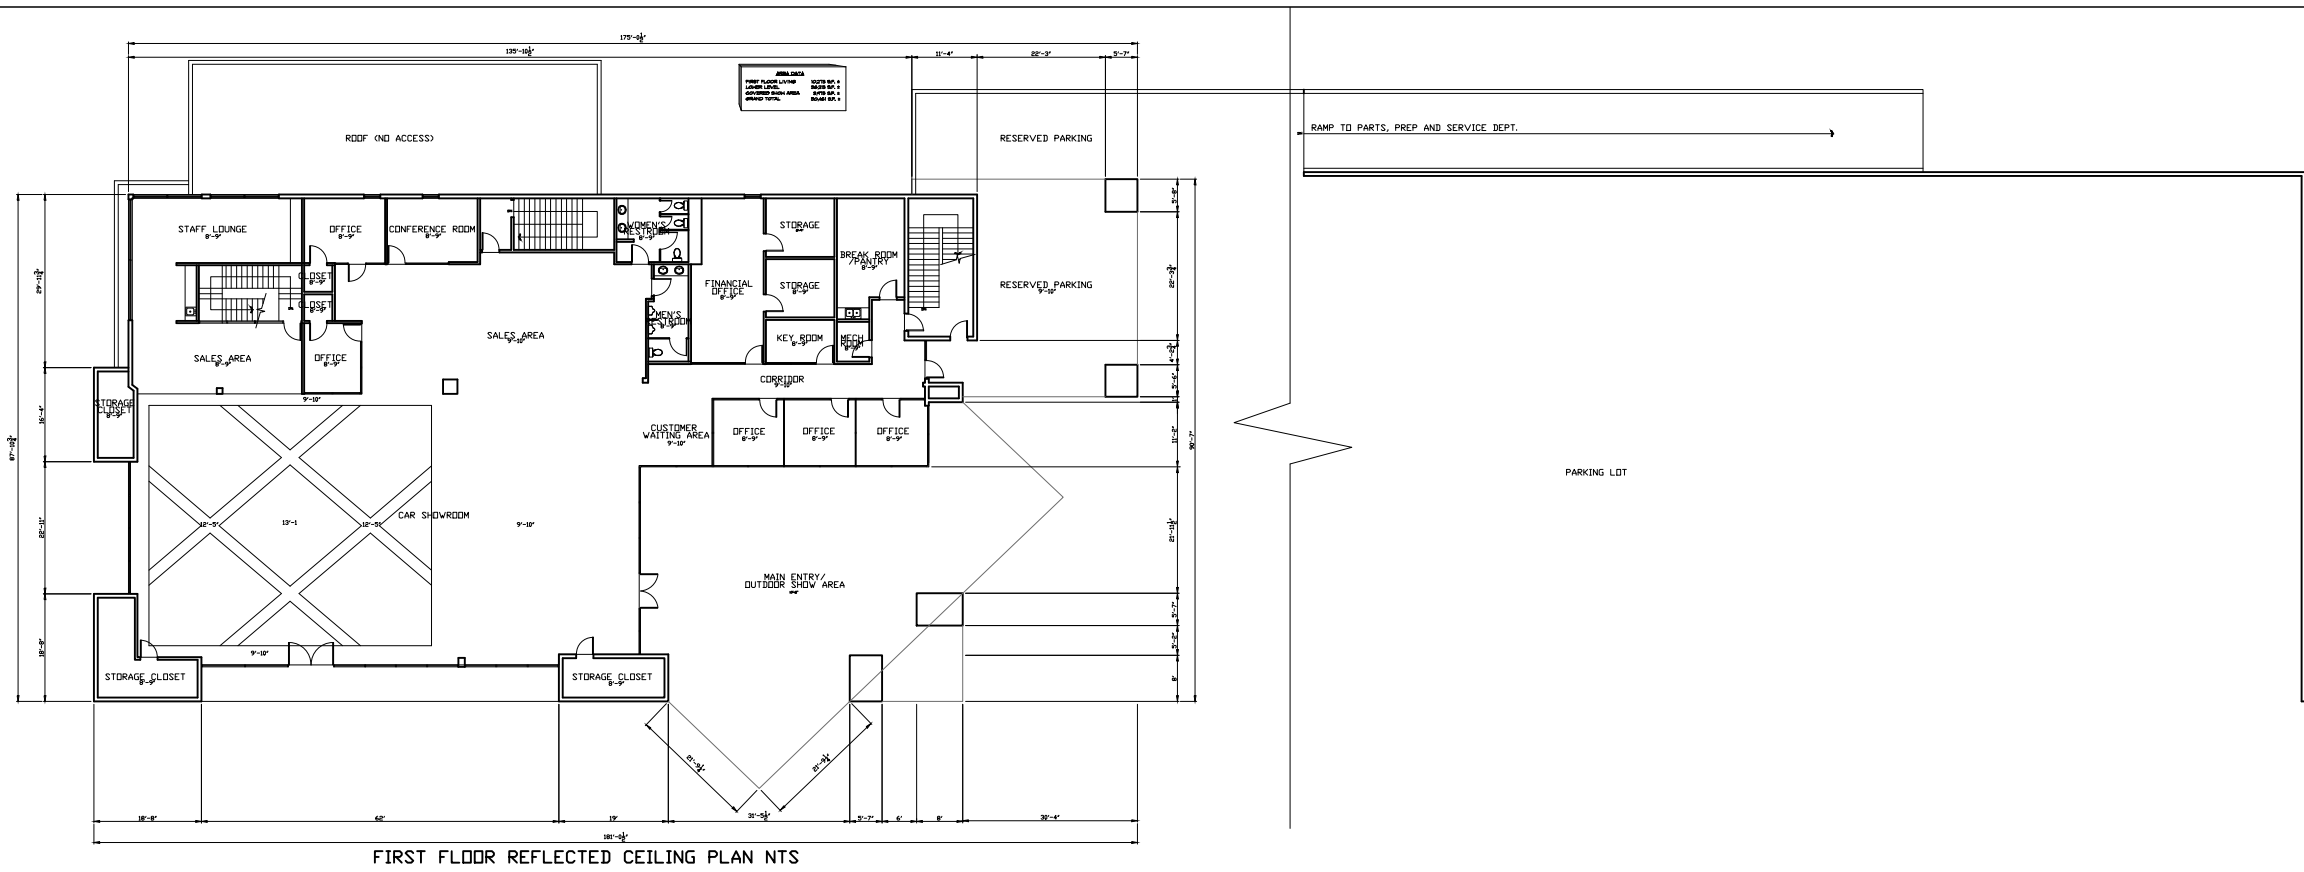

FIRST FLOOR REFLECTED CEILING PLAN

As BUILT

PROFESSIONALS

www.asbuiltprofessionals.com

A DIVISION OF:

AEC

CONSULTANTS INC

844.272.8458

844 AS BUILT



© 2019 AEC CONSULTANTS INC

ARCHITECTURAL AS BUILT  
SELECT LUXURY CARS

MARIETTA, GA 30060

01	100% SUBMISSION	SEE COVER SHEET
NO.	ISSUES   REVISIONS	DATE
		SHEET TITLE
HL	PROJECT MANAGER	
HL	PROJECT DIRECTOR	
012317-1	PROJECT NUMBER	
1/8"=1'-0"	SCALE	
CL	DRAWN BY	
		SHEET NUMBER

AB-3

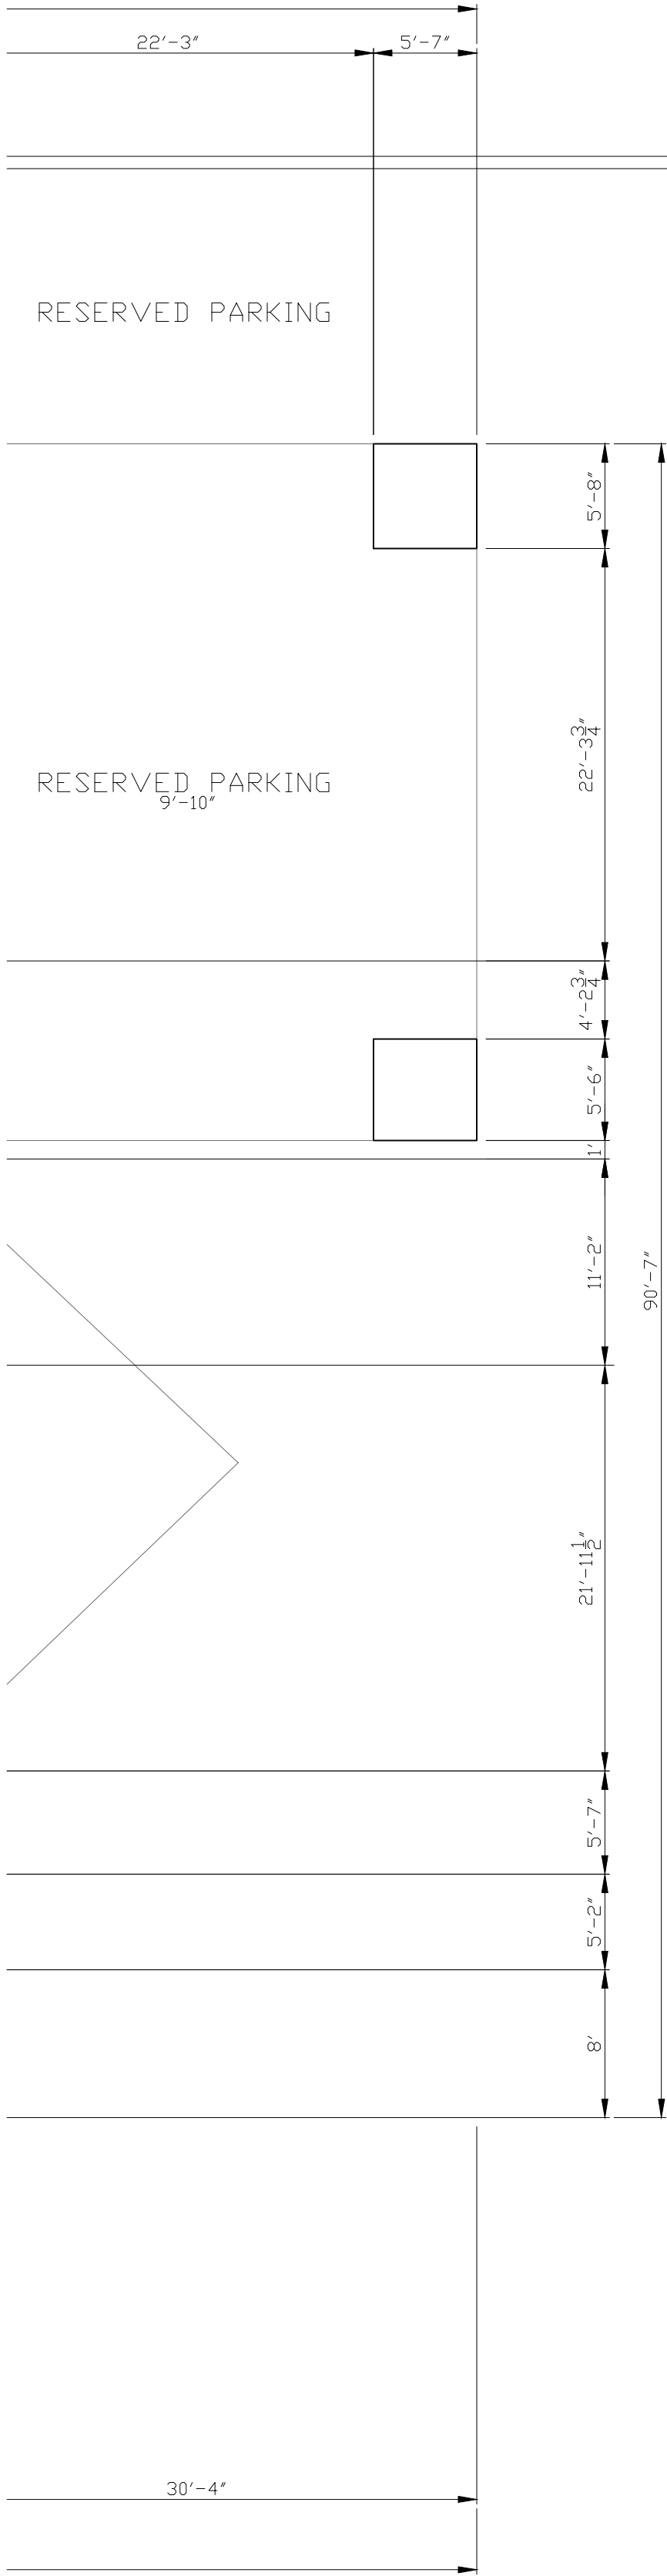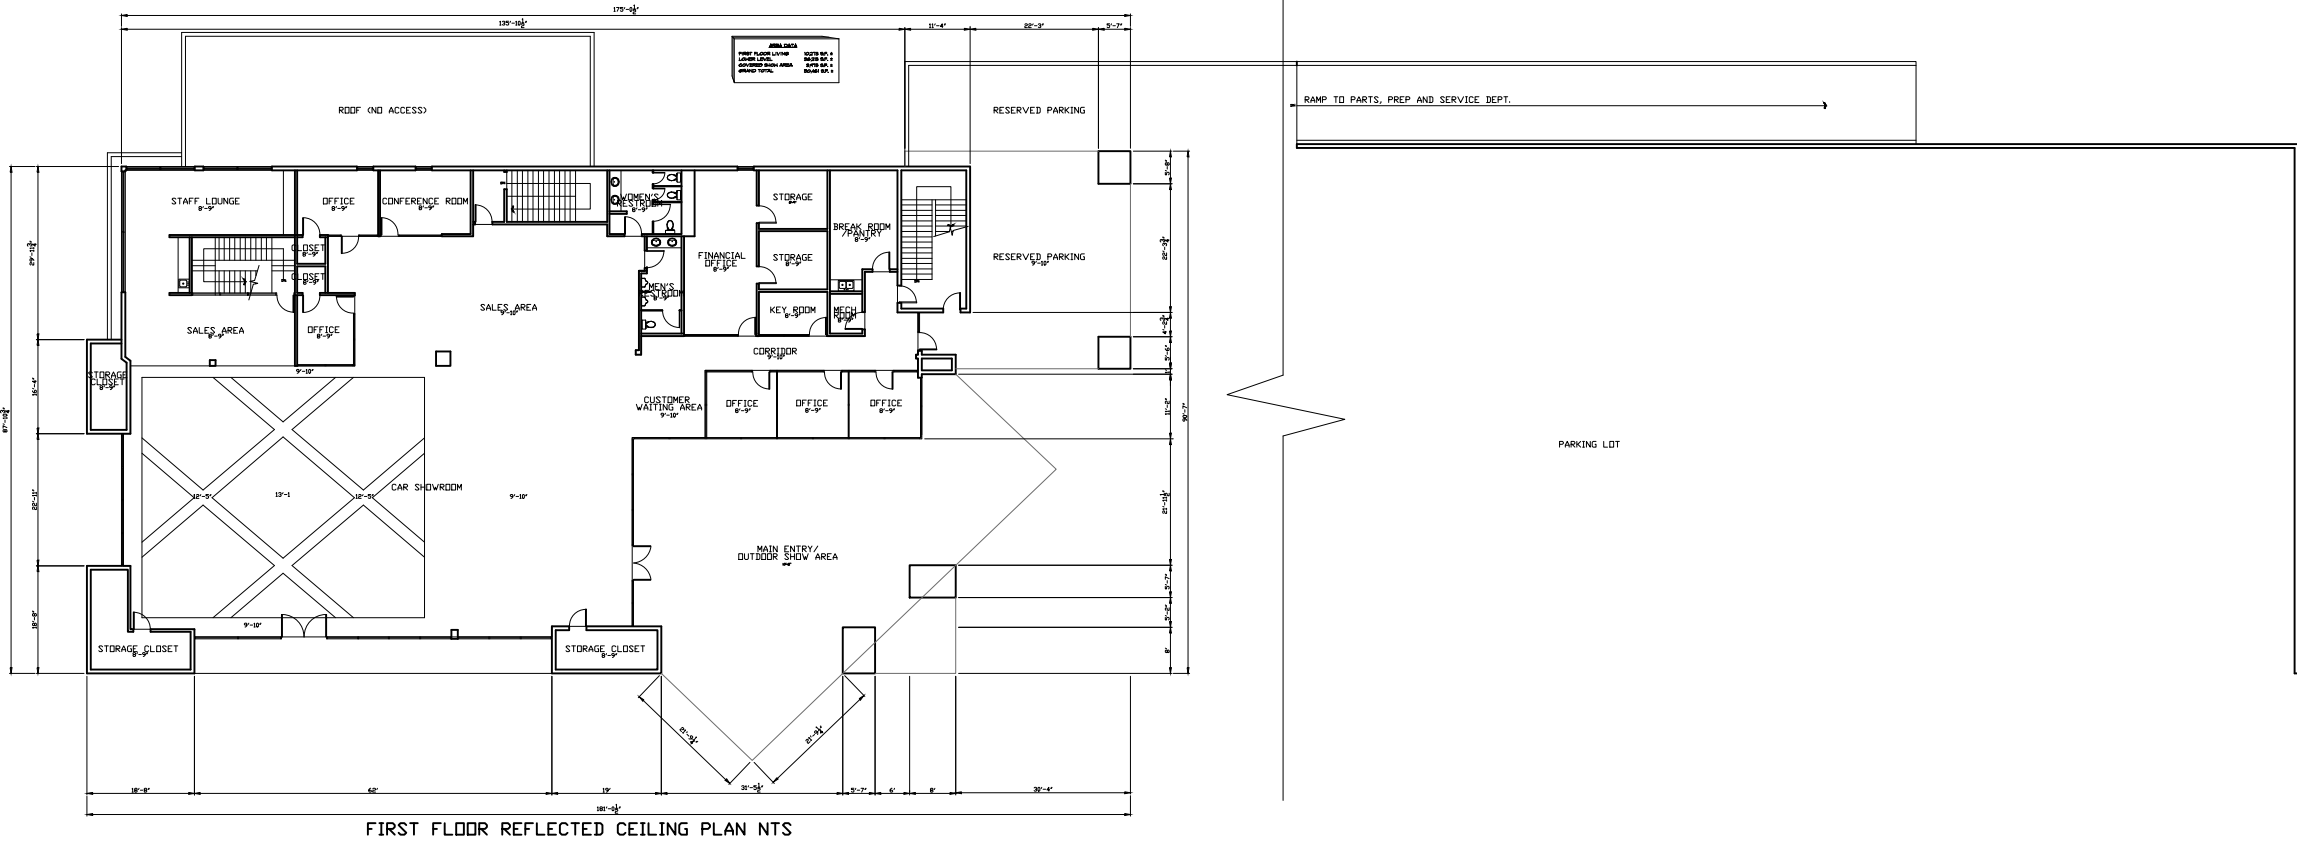

RAMP TO PARTS, PREP AND SERVICE DEPT.

PARKING LOT



© 2019 AEC CONSULTANTS INC.



ARCHITECTURAL AS BUILT  
SELECT LUXURY CARS

MARIETTA, GA 30060

01	100% SUBMISSION	SEE COVER SHEET
NO.	ISSUES   REVISIONS	DATE
		SHEET TITLE
HL	PROJECT MANAGER	
HL	PROJECT DIRECTOR	
012317-1	PROJECT NUMBER	
1/8"=1'-0"	SCALE	
CL	DRAWN BY	
		SHEET NUMBER

AB-3a



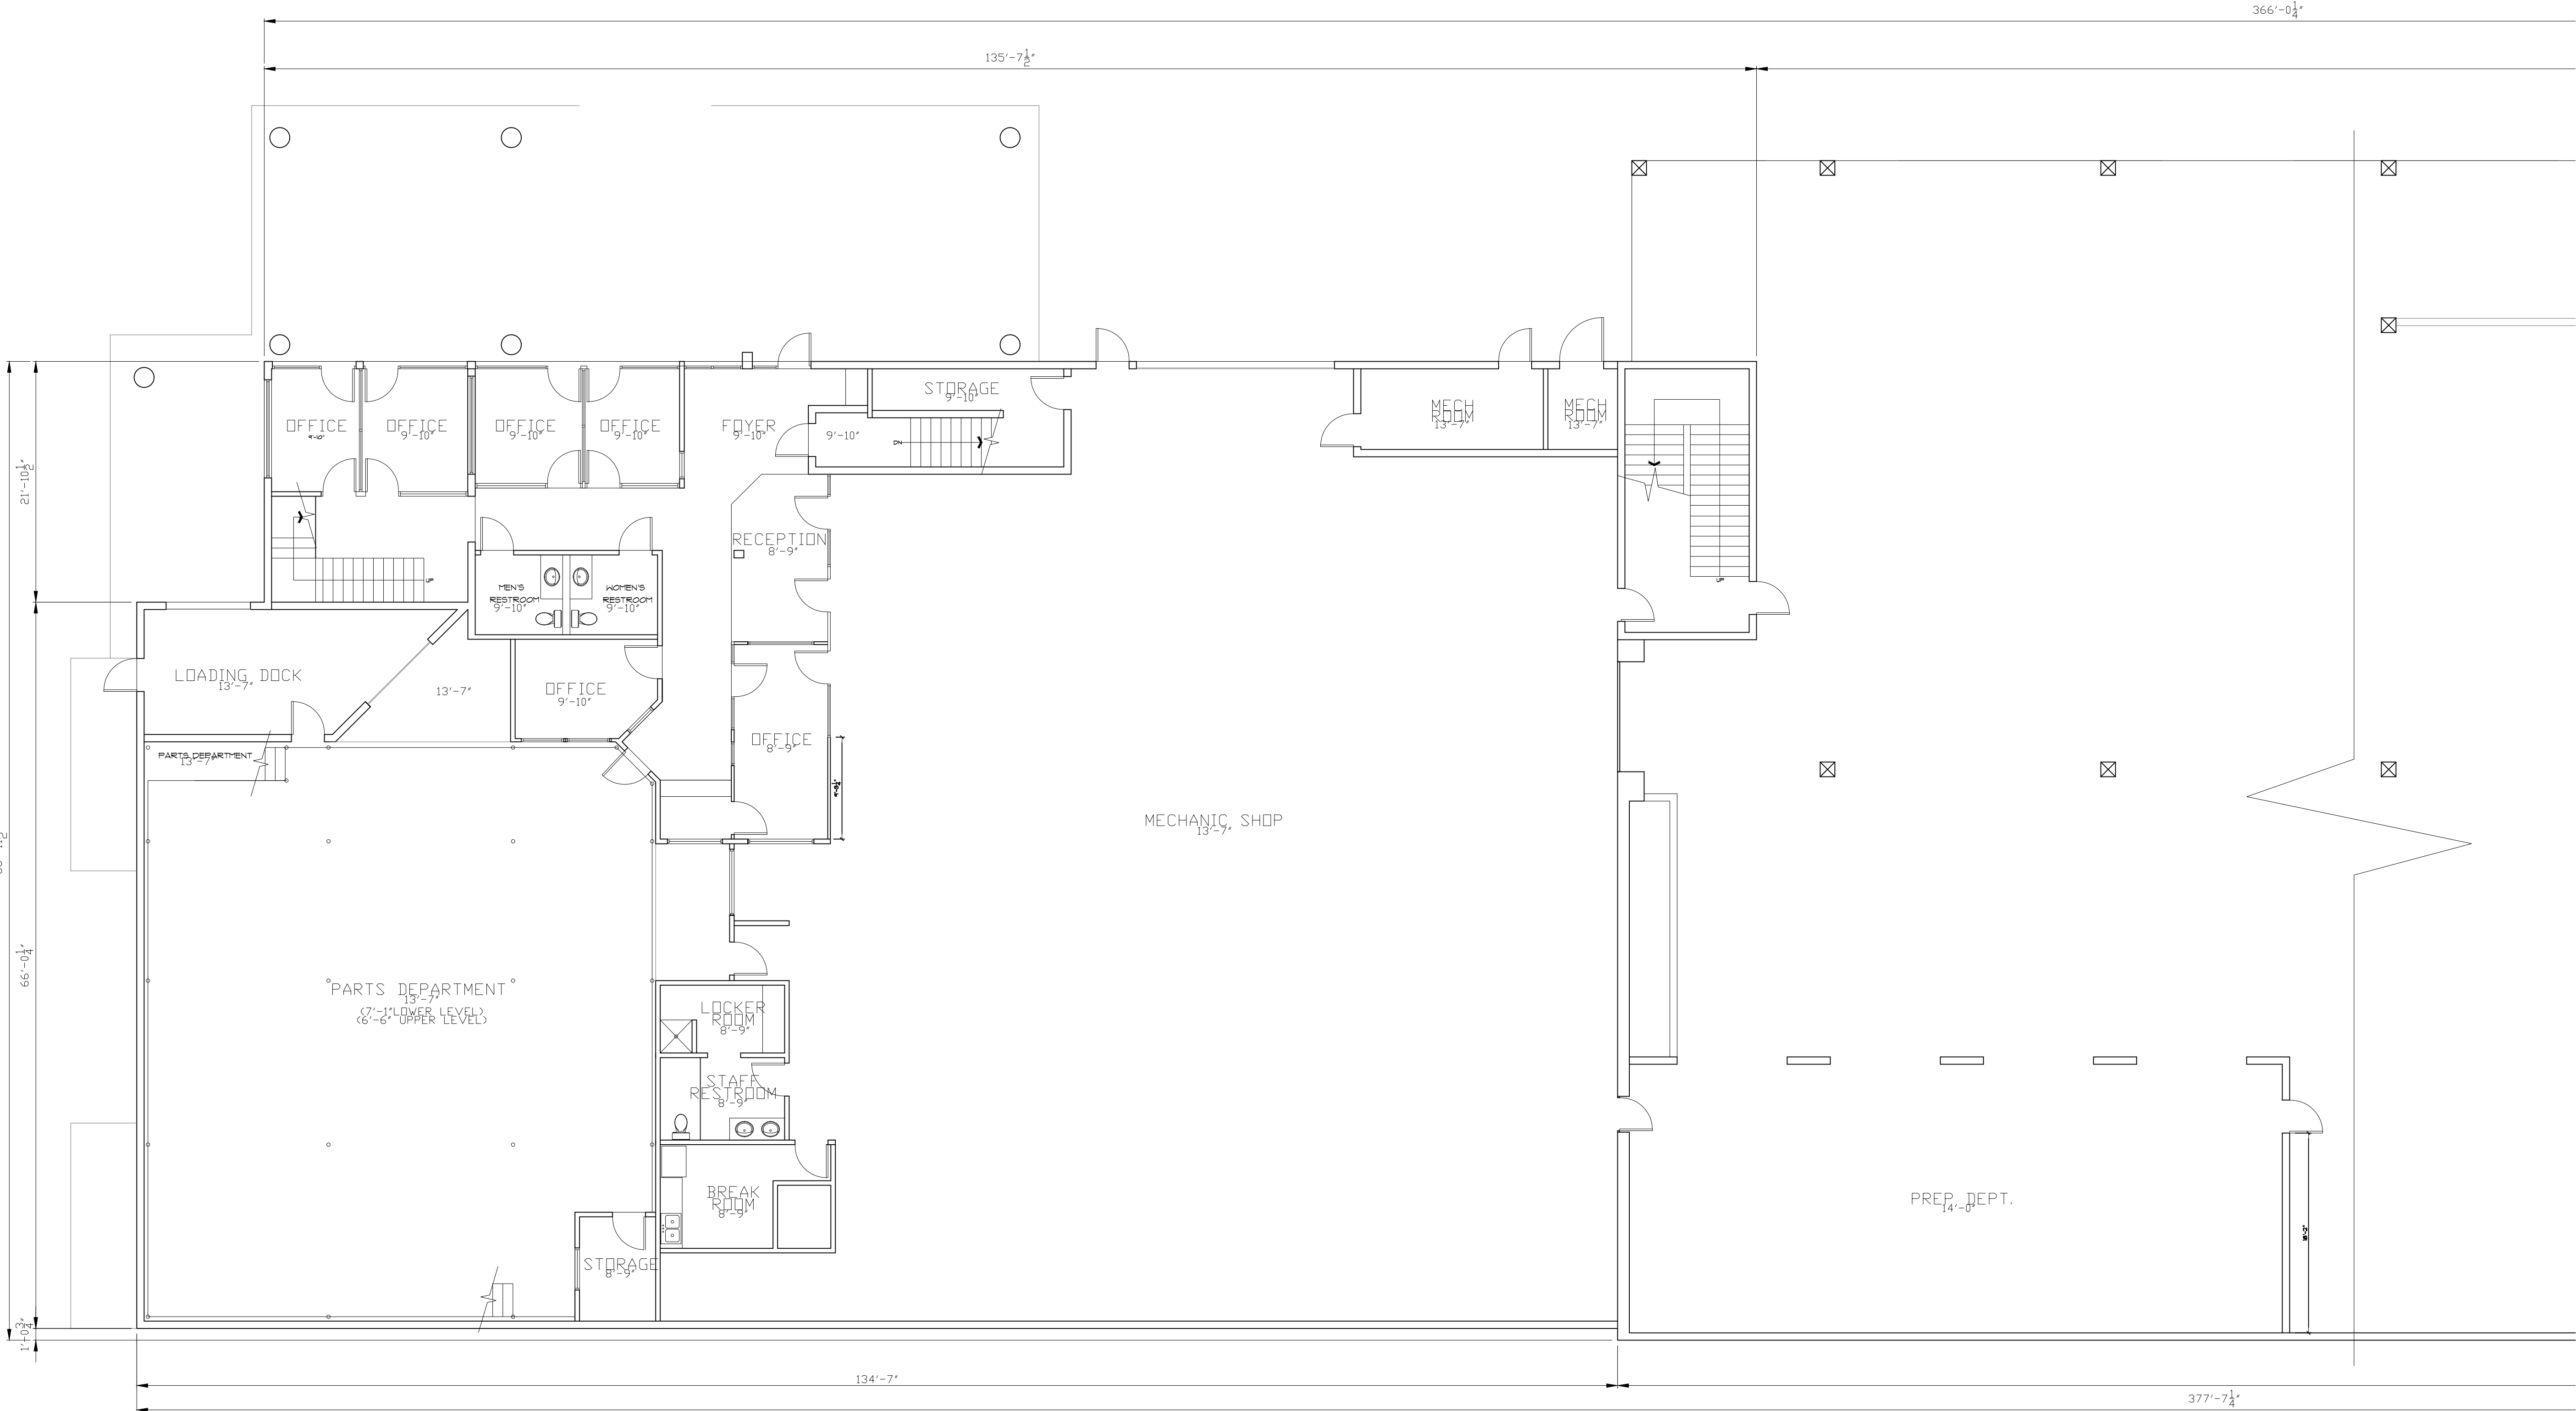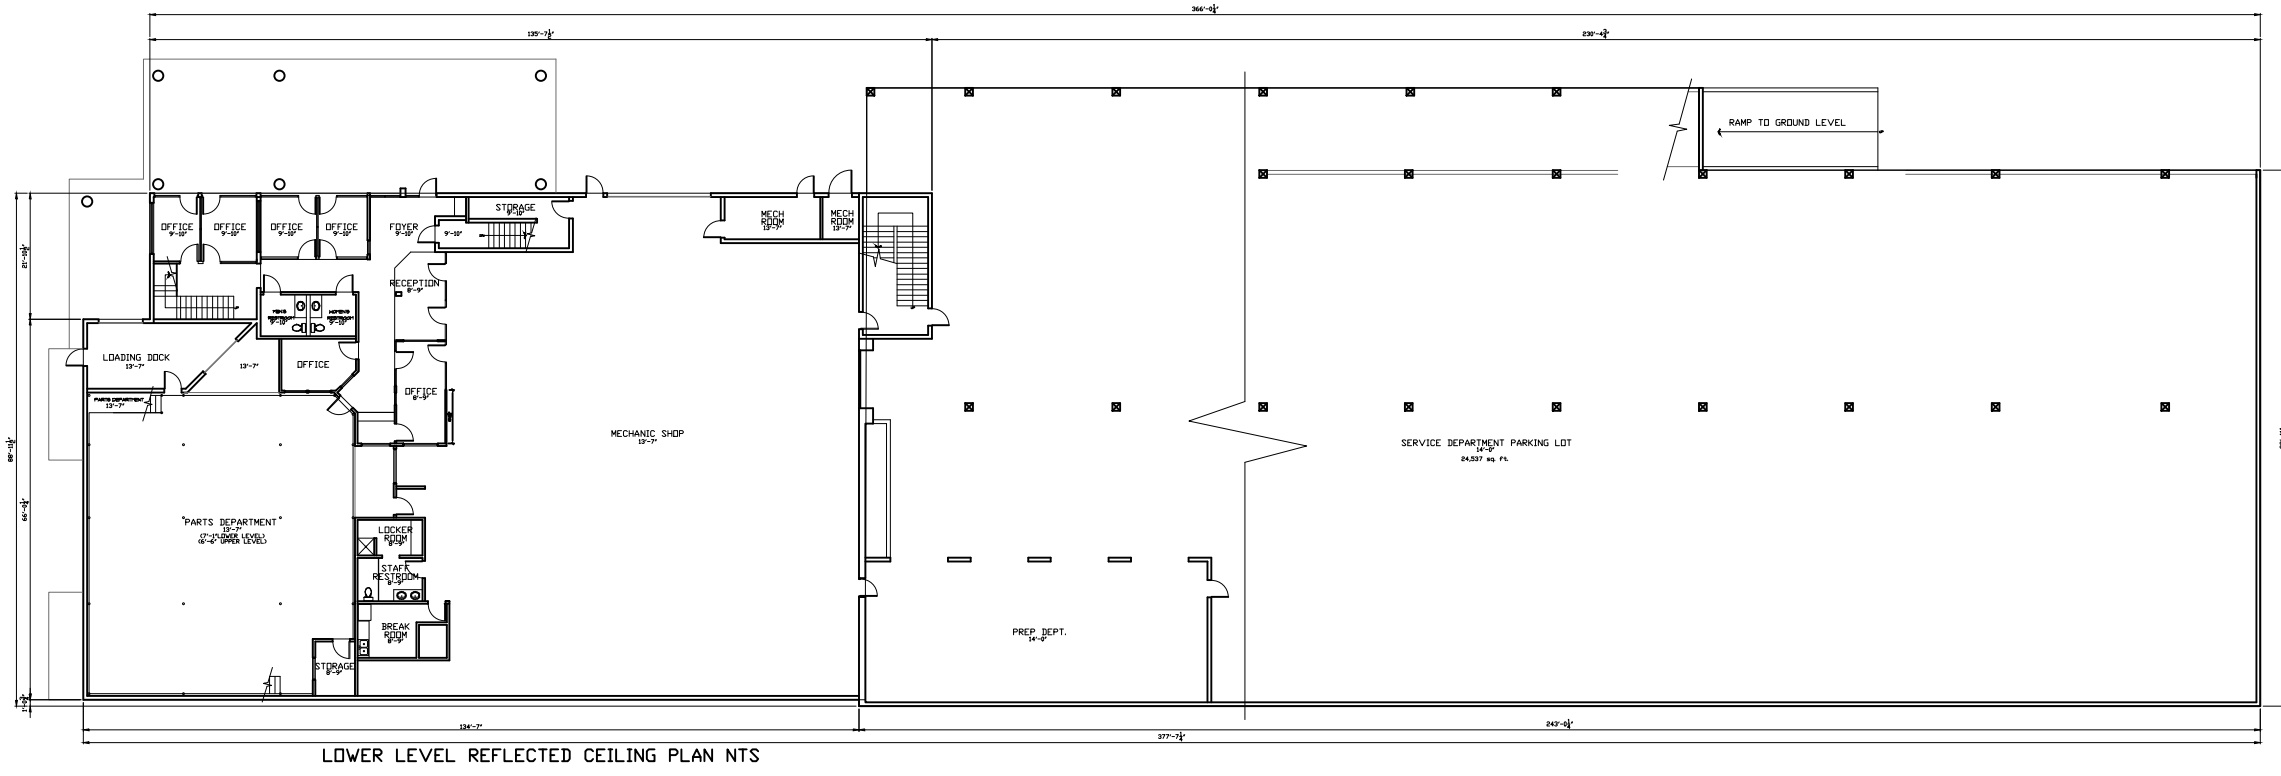

LOWER LEVEL REFLECTED CEILING PLAN

As BUILT

PROFESSIONALS

www.asbuiltprofessionals.com

A DIVISION OF:

AEC

CONSULTANTS INC

844.272.8458

844 AS BUILT

© 2019 AEC CONSULTANTS INC


ARCHITECTURAL AS BUILT  
SELECT LUXURY CARS

MARIETTA, GA 30060

01	100% SUBMISSION	SEE COVER SHEET
NO.	ISSUES   REVISIONS	DATE
		SHEET TITLE
HL	PROJECT MANAGER	
HL	PROJECT DIRECTOR	
012317-1	PROJECT NUMBER	
1/8"=1'-0"		
SCALE		
CL	DRAWN BY	
SHEET NUMBER		


AB-4



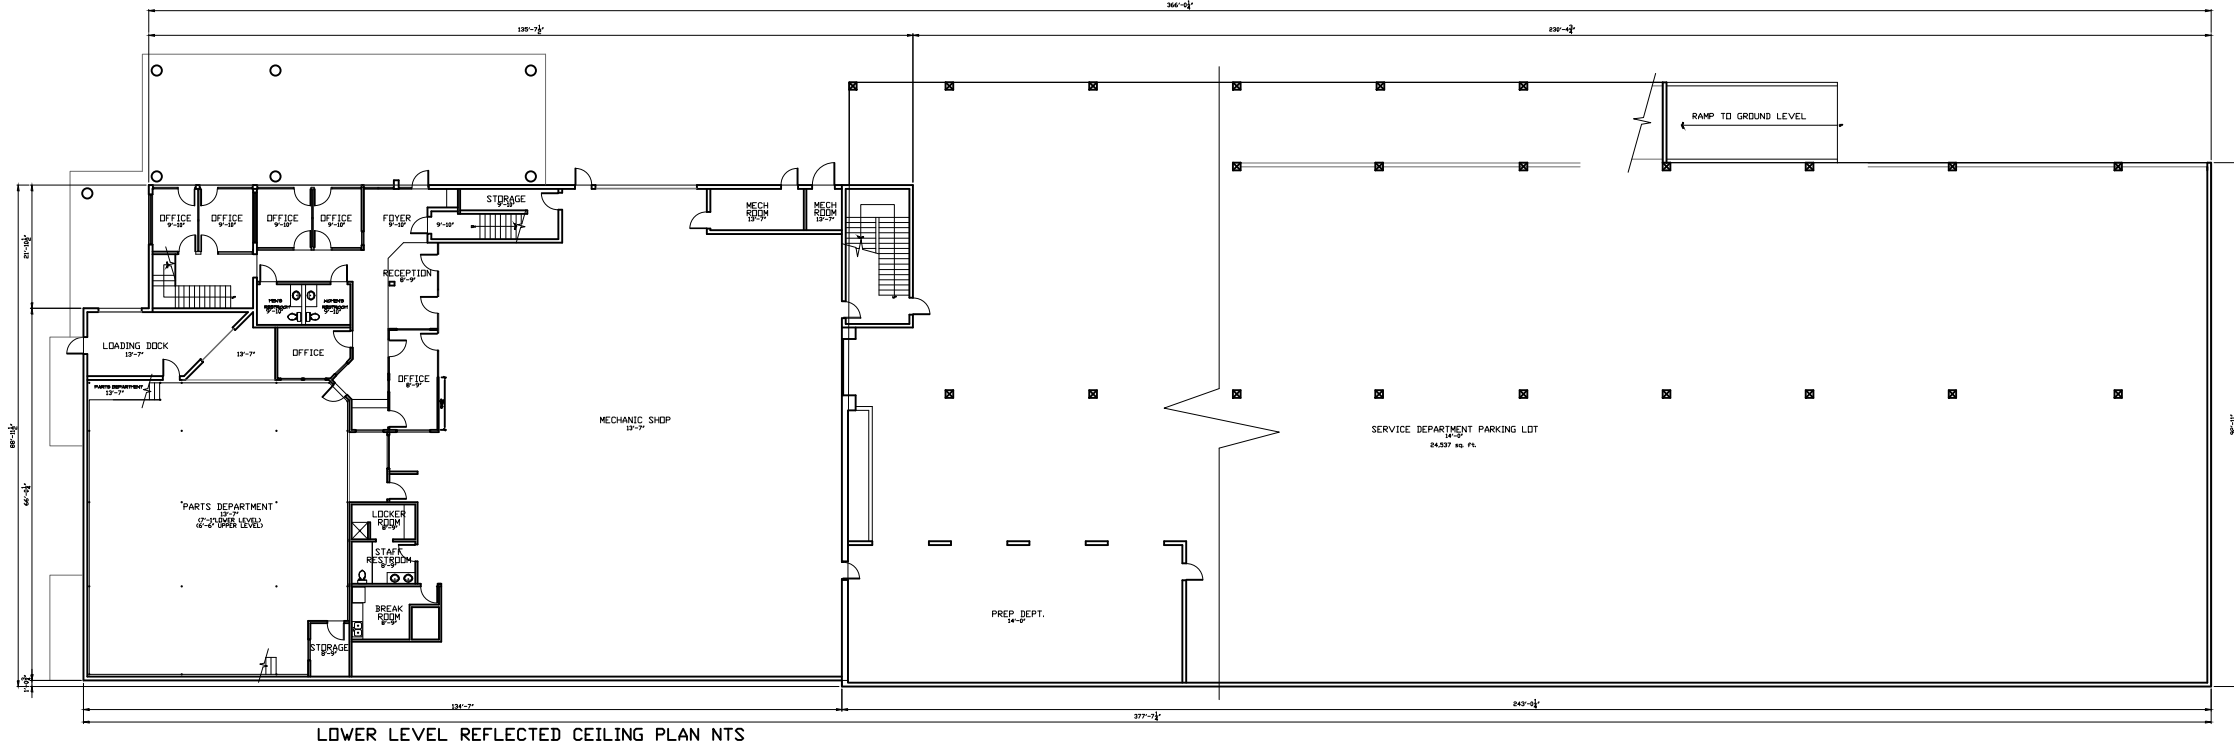

366'-0 1/4"

230'-4 3/4"

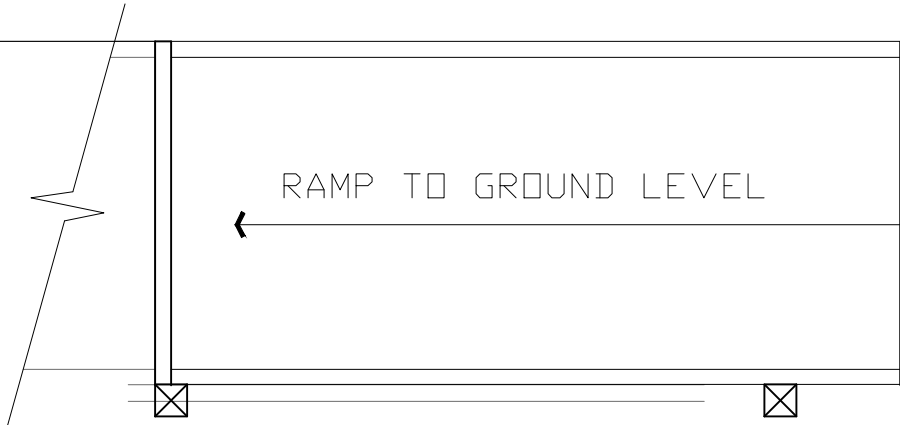

RAMP TO GROUND LEVEL

SERVICE DEPARTMENT PARKING LOT  
14'-0"

92'-11"

243'-0 1/4"

377'-7 1/4"

EP. DEPT.  
14'-0"

As BUILT

PROFESSIONALS

www.asbuiltprofessionals.com

A DIVISION OF:

AEC

CONSULTANTS INC

844.272.8458

844 AS BUILT

© 2019 AEC CONSULTANTS INC

ARCHITECTURAL AS BUILT  
SELECT LUXURY CARS

MARIETTA, GA 30060

01	100% SUBMISSION	SEE COVER SHEET
NO.	ISSUES   REVISIONS	DATE
		SHEET TITLE
HL	PROJECT MANAGER	
HL	PROJECT DIRECTOR	
012317-1	PROJECT NUMBER	
1/8"=1'-0"		
SCALE		
CL	DRAWN BY	
SHEET NUMBER		

AB-4a


A DIVISION OF



© 2019 AEC CONSULTANTS INC.



# ARCHITECTURAL AS BUILT SELECT LUXURY CARS

**MARRIETTA, GA 30060**

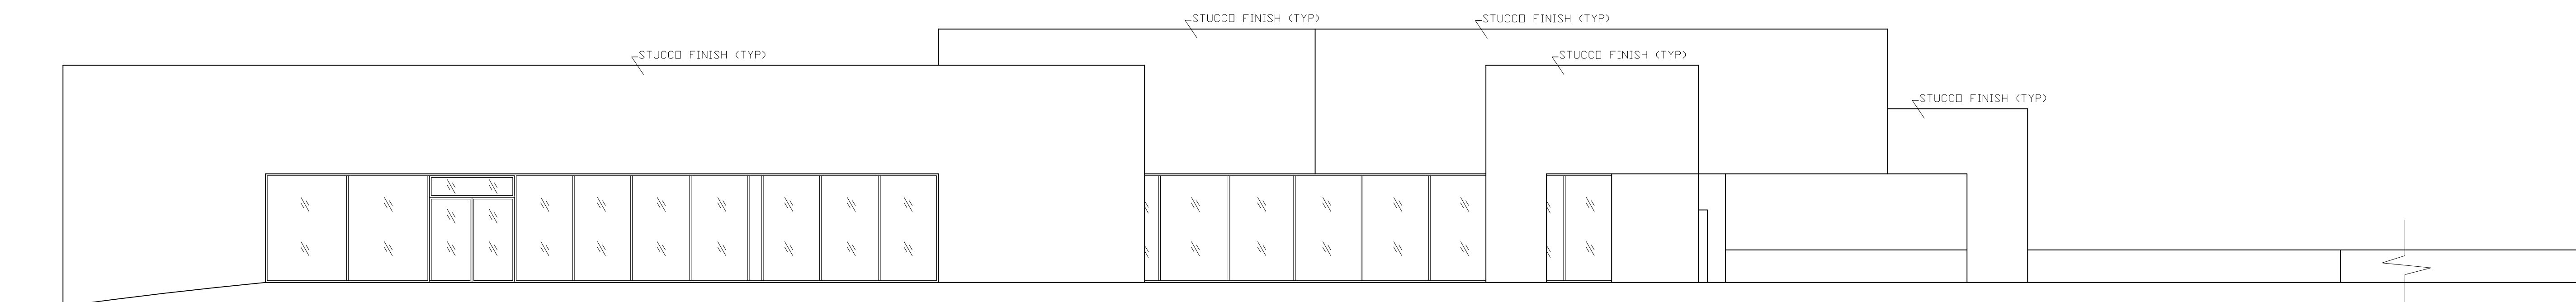

FRONT ELEVATION


REAR ELEVATION

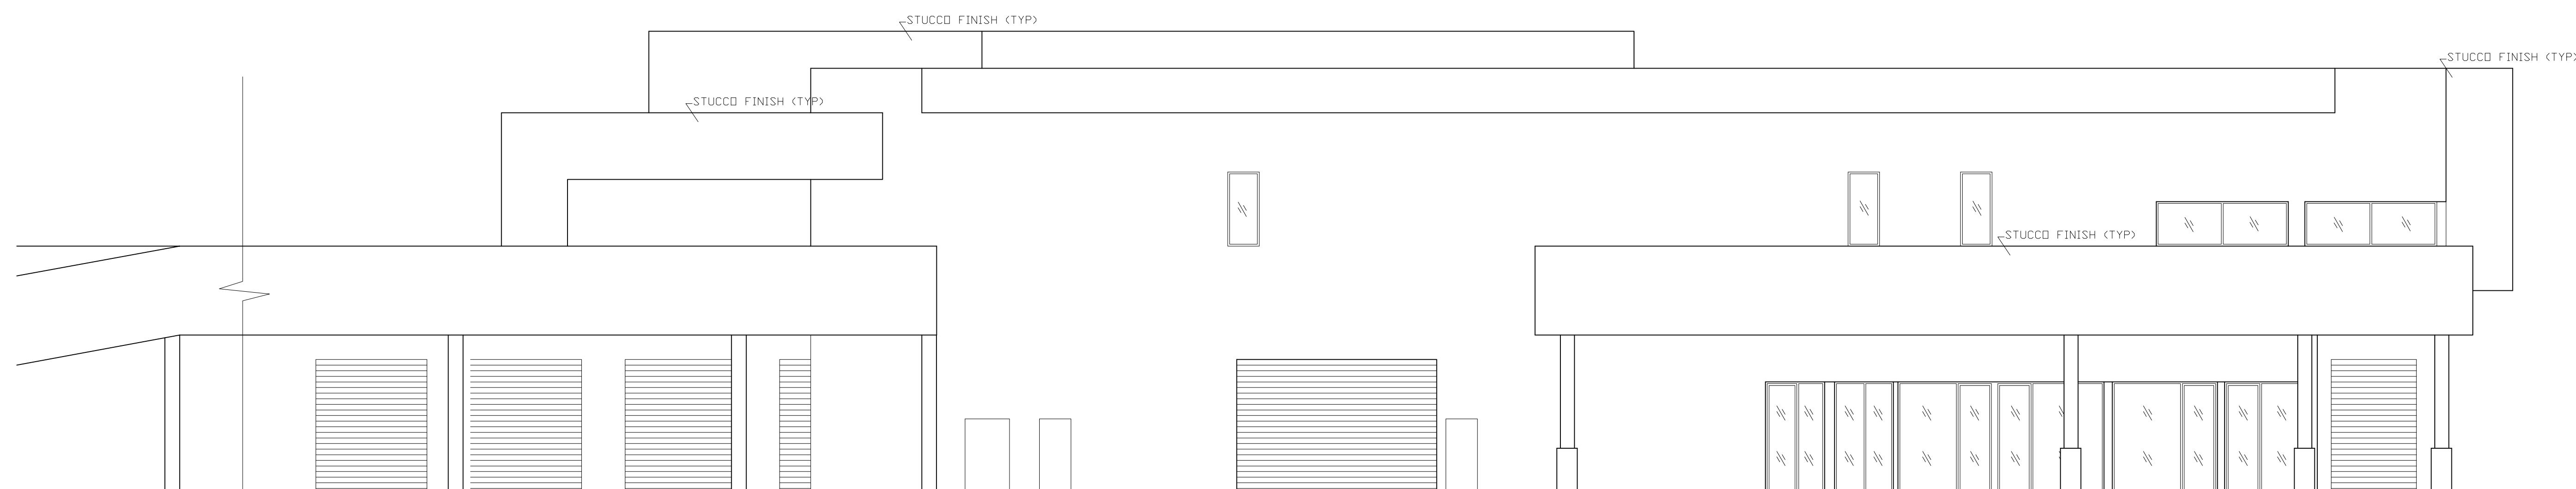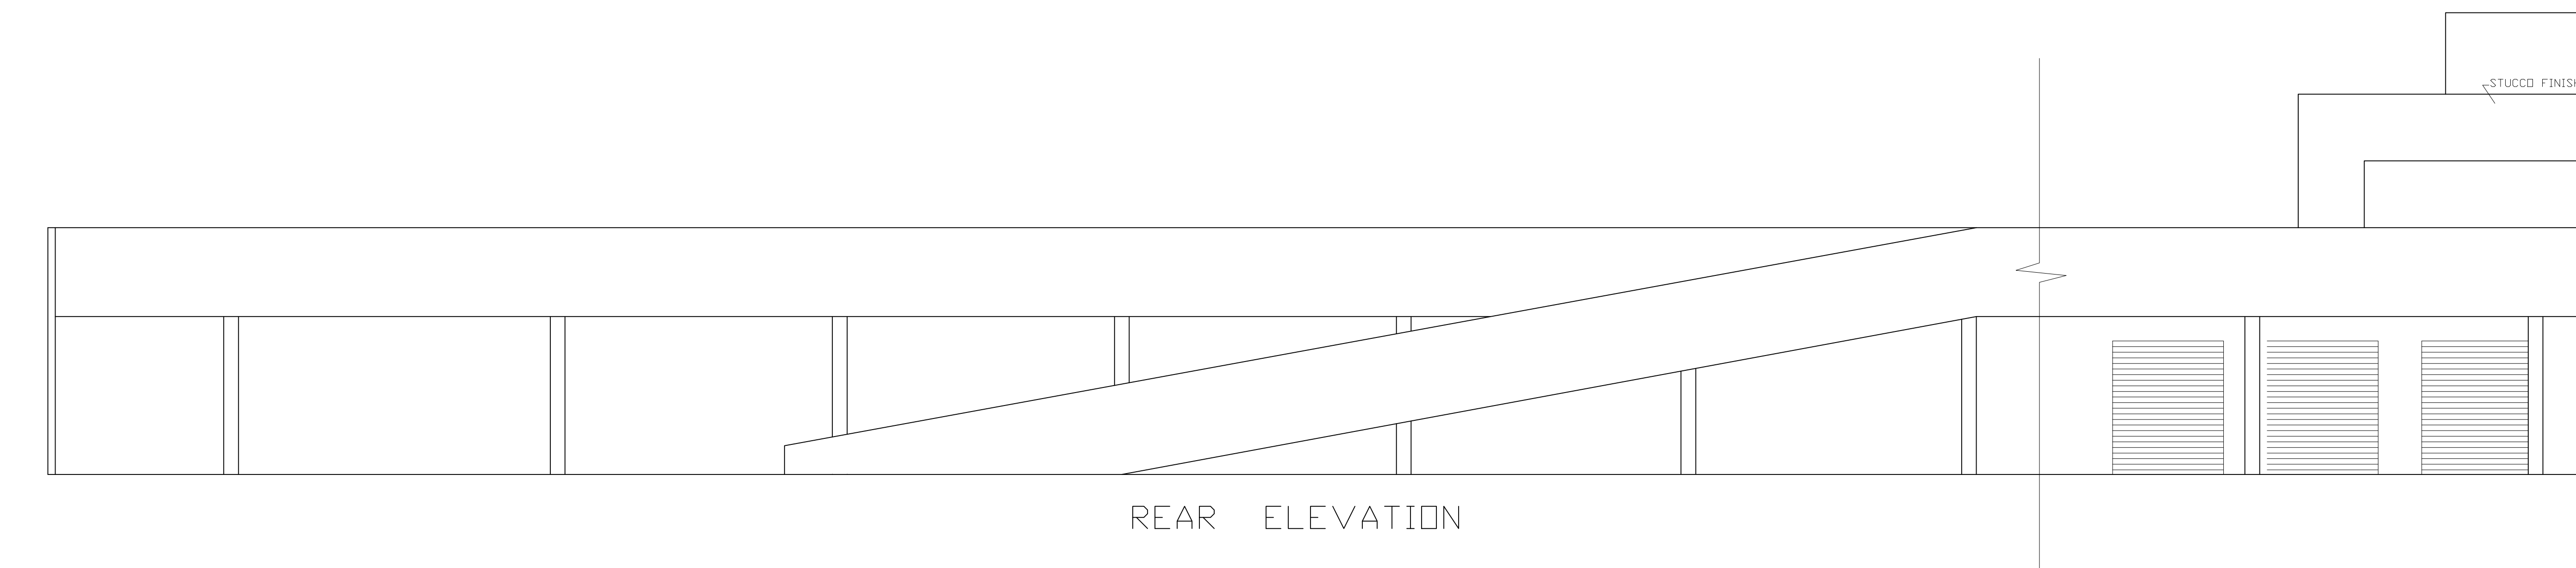


O1	100% SUBMISSION	SEE COVER SHEET
NO.	ISSUES   REVISIONS	DATE
		SHEET TITLE
HL		PROJECT MANAGER
HL		PROJECT DIRECTOR
O12317-1		PROJECT NUMBER
<b>1/8"=1'-0"</b>		SCALE
CL		DRAWN BY
		SHEET NUMBER

# AB-5



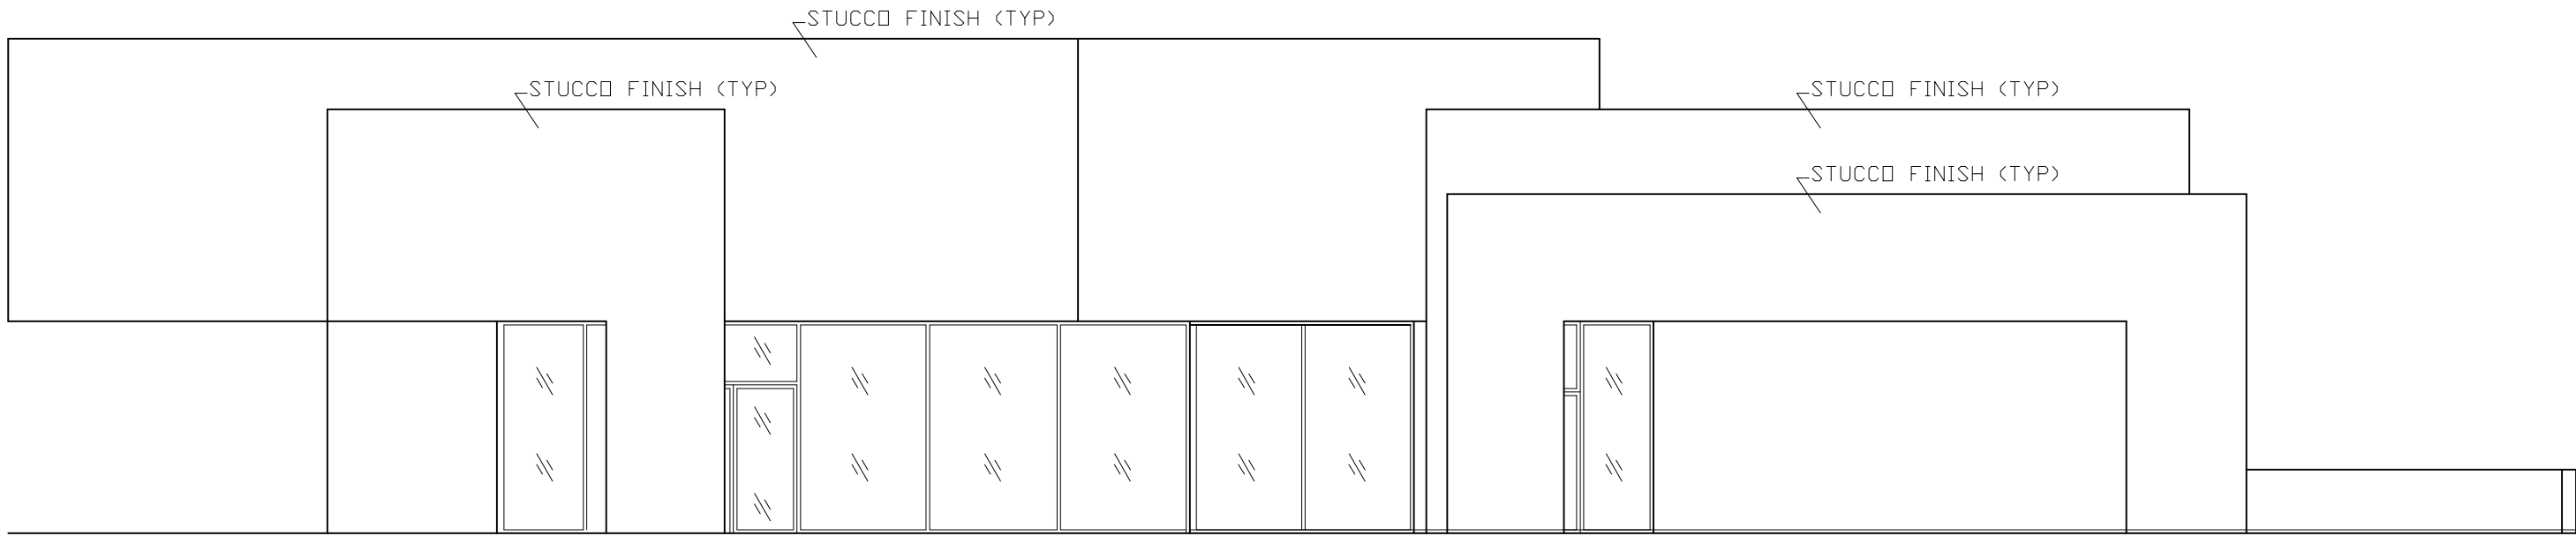

RIGHT ELEVATION

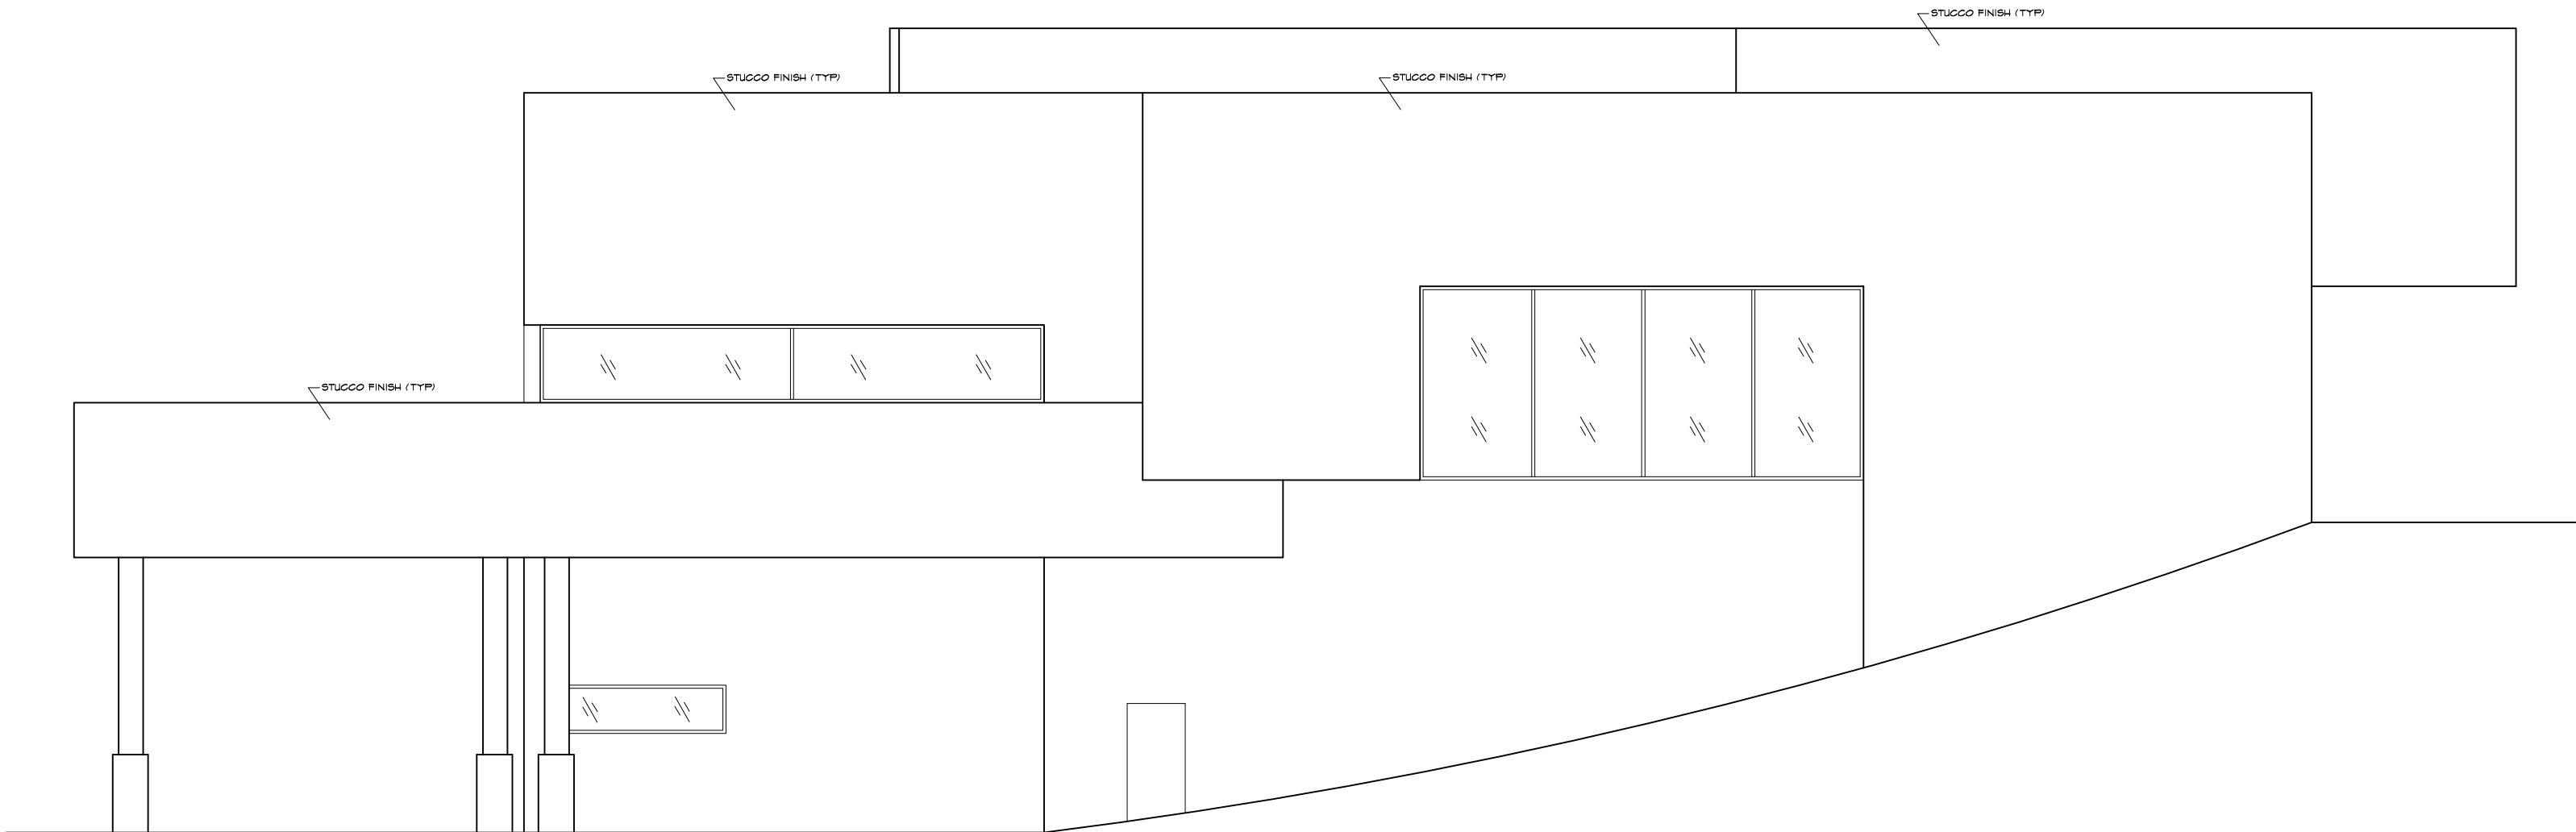

LEFT ELEVATION

As BUILT

PROFESSIONALS

www.asbuiltprofessionals.com

A DIVISION OF:

AEC

CONSULTANTS INC

844.272.8458

844 ASBUILT

© 2019 AEC CONSULTANTS INC

ARCHITECTURAL AS BUILT  
SELECT LUXURY CARS

MARIETTA, GA 30060

01	100% SUBMISSION	SEE COVER SHEET
NO.	ISSUES   REVISIONS	DATE
SHEET TITLE		
HL	PROJECT MANAGER	
HL	PROJECT DIRECTOR	
012317-1	PROJECT NUMBER	
1/8"=1'-0"	SCALE	
CL	DRAWN BY	
SHEET NUMBER		

AB-5a