




ARCHITECTURAL BOMA ANALYSIS
Santa Rosa Professional Pavilion
San Antonio, TX

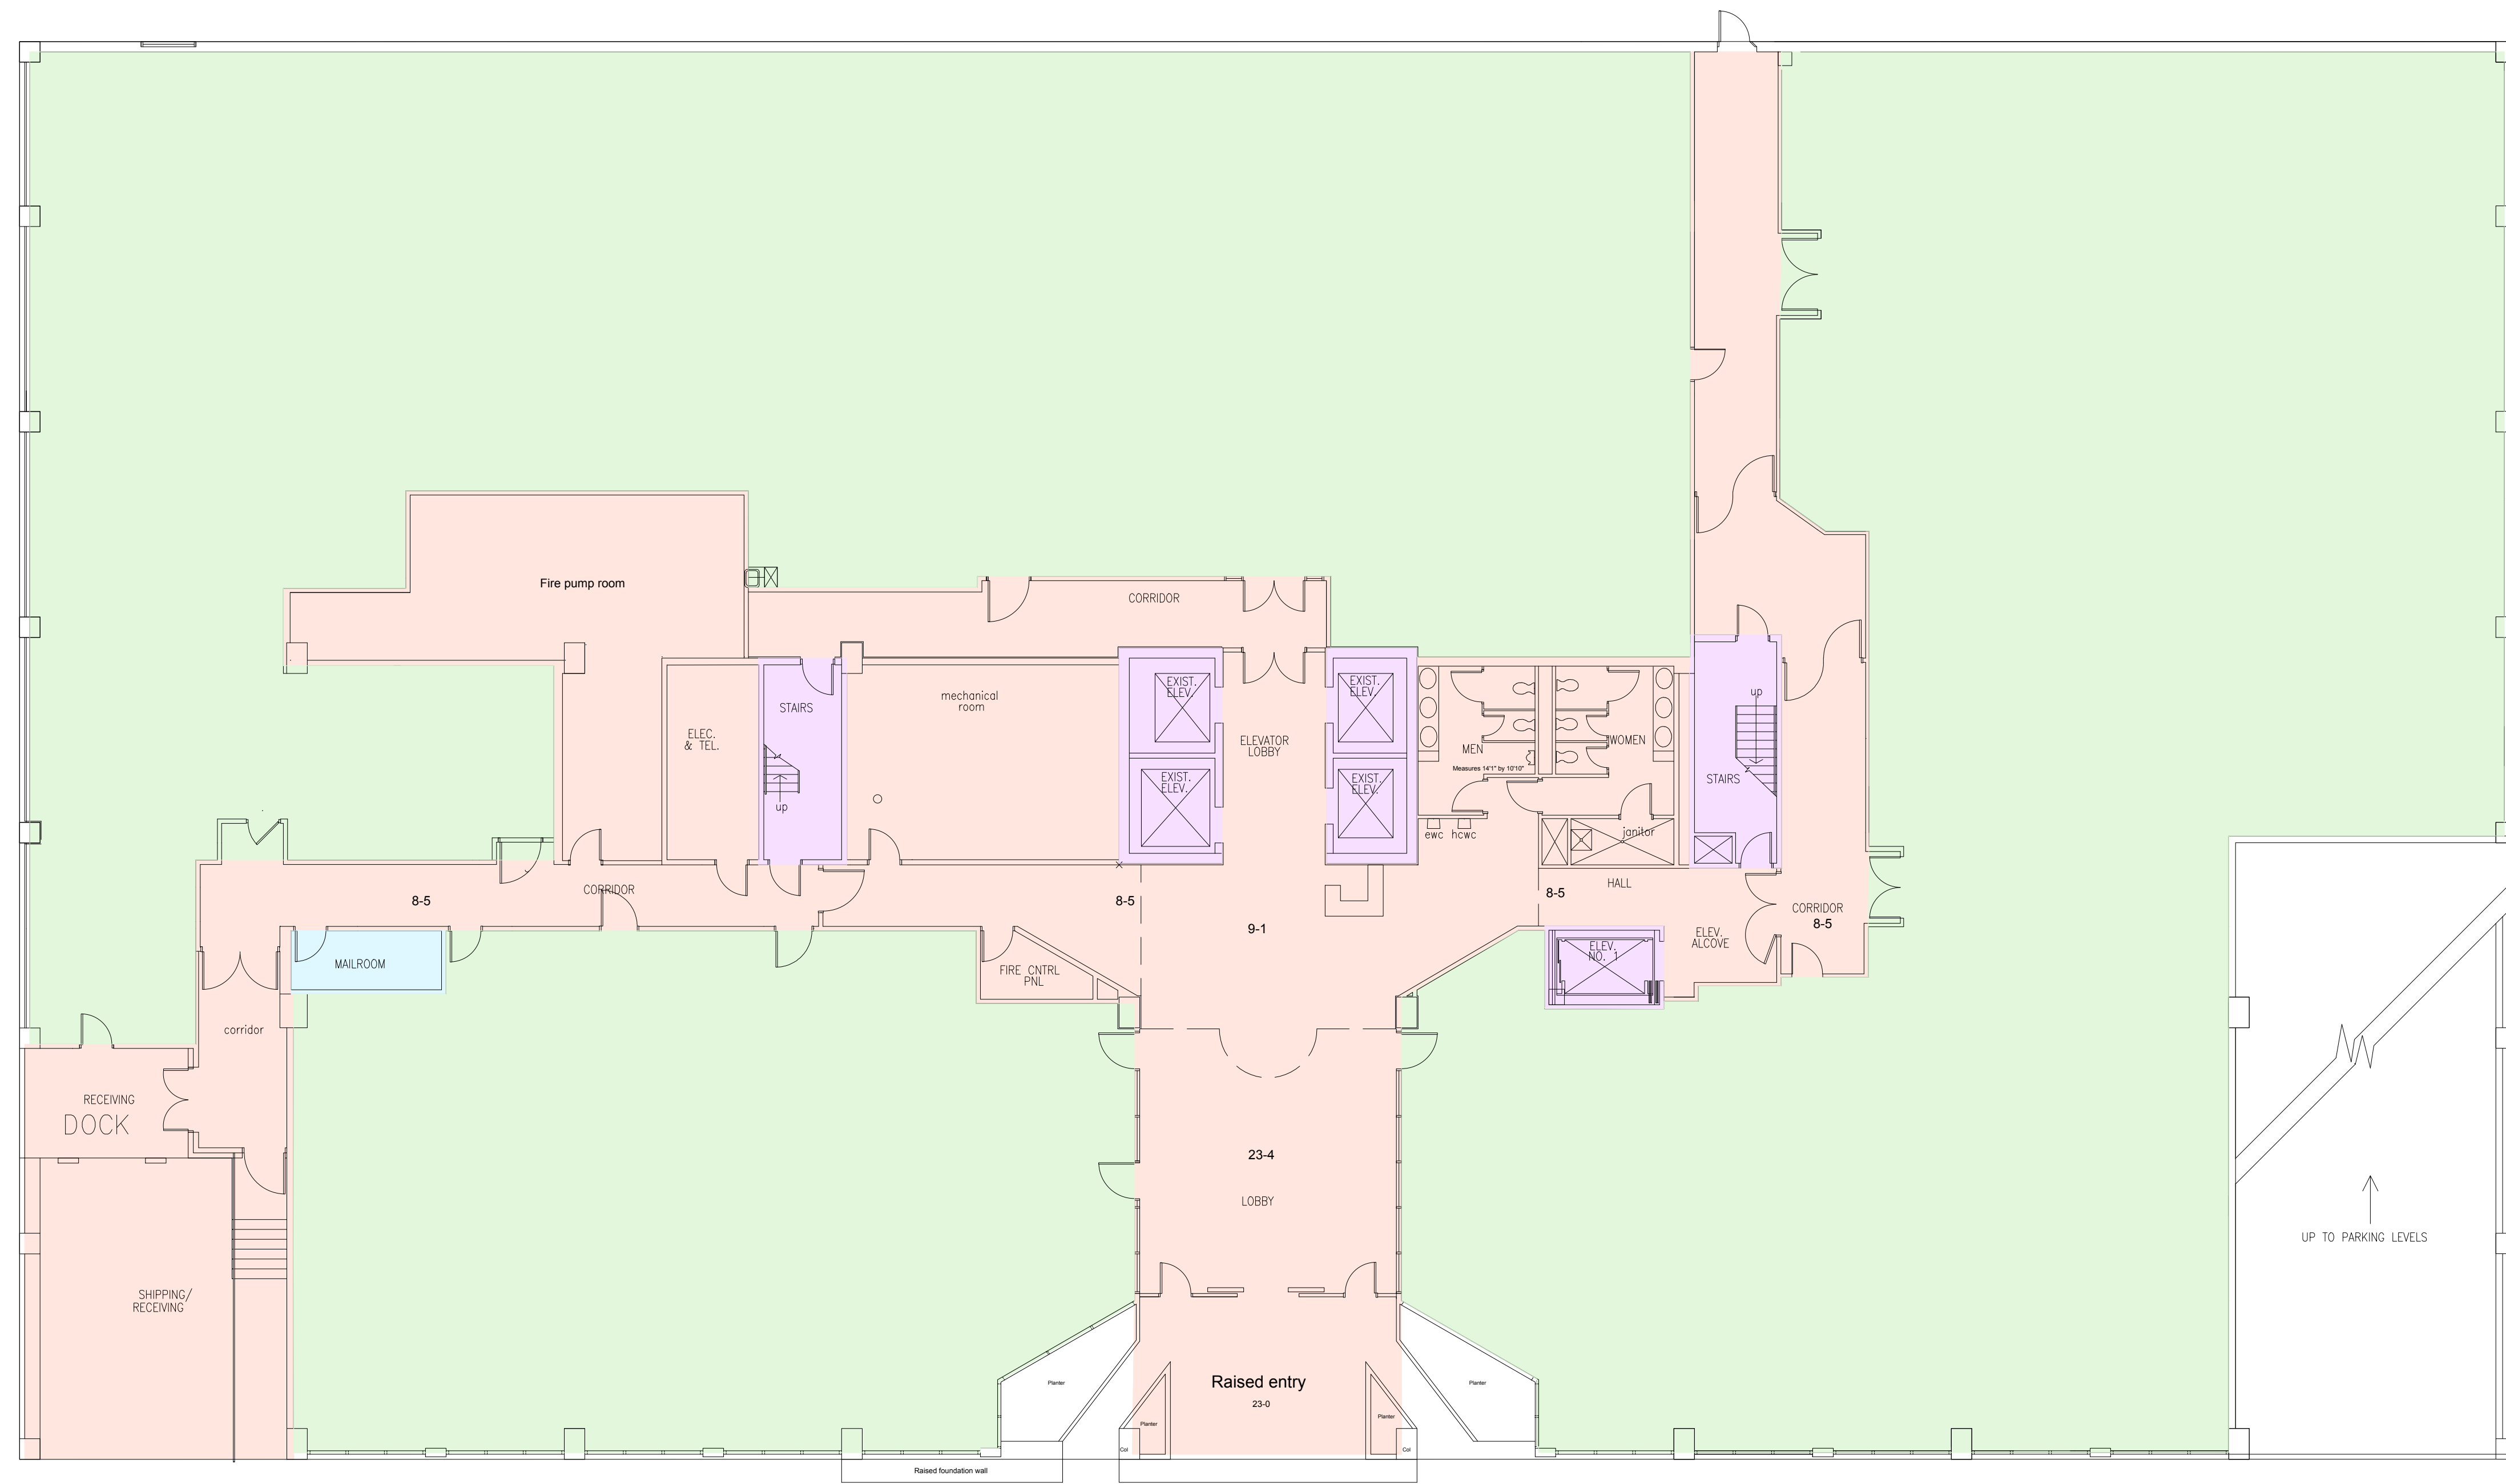

FIRST FLOOR
PAVILLION MEDICAL OFFICE BUILDING

AREA DATA	
INTERIOR GROSS AREA	= 32714
MAJOR VERTICAL PENETRATIONS	= 865
PARKING	= 0
OCCUPANT STORAGE	= 0
OCCUPANT AREA	= 22708
BUILDING AMENITIES	= 93
FLOOR SERVICE AREA	= 7404

KEY

- MAJOR VERTICAL PENETRATIONS
- OCCUPANT AREA
- BUILDING AMENITY
- FLOOR SERVICE AREA

01	100% SUBMISSION	
NO.	ISSUES REVISIONS	DATE
HL		PROJECT MANAGER
HL		PROJECT DIRECTOR
012317-1		PROJECT NUMBER
3/32"=1'-0"		SCALE
CL		DRAWN BY
		SHEET NUMBER