






FRONT ELEVATION
SCALE: 1/4" = 1'-0"

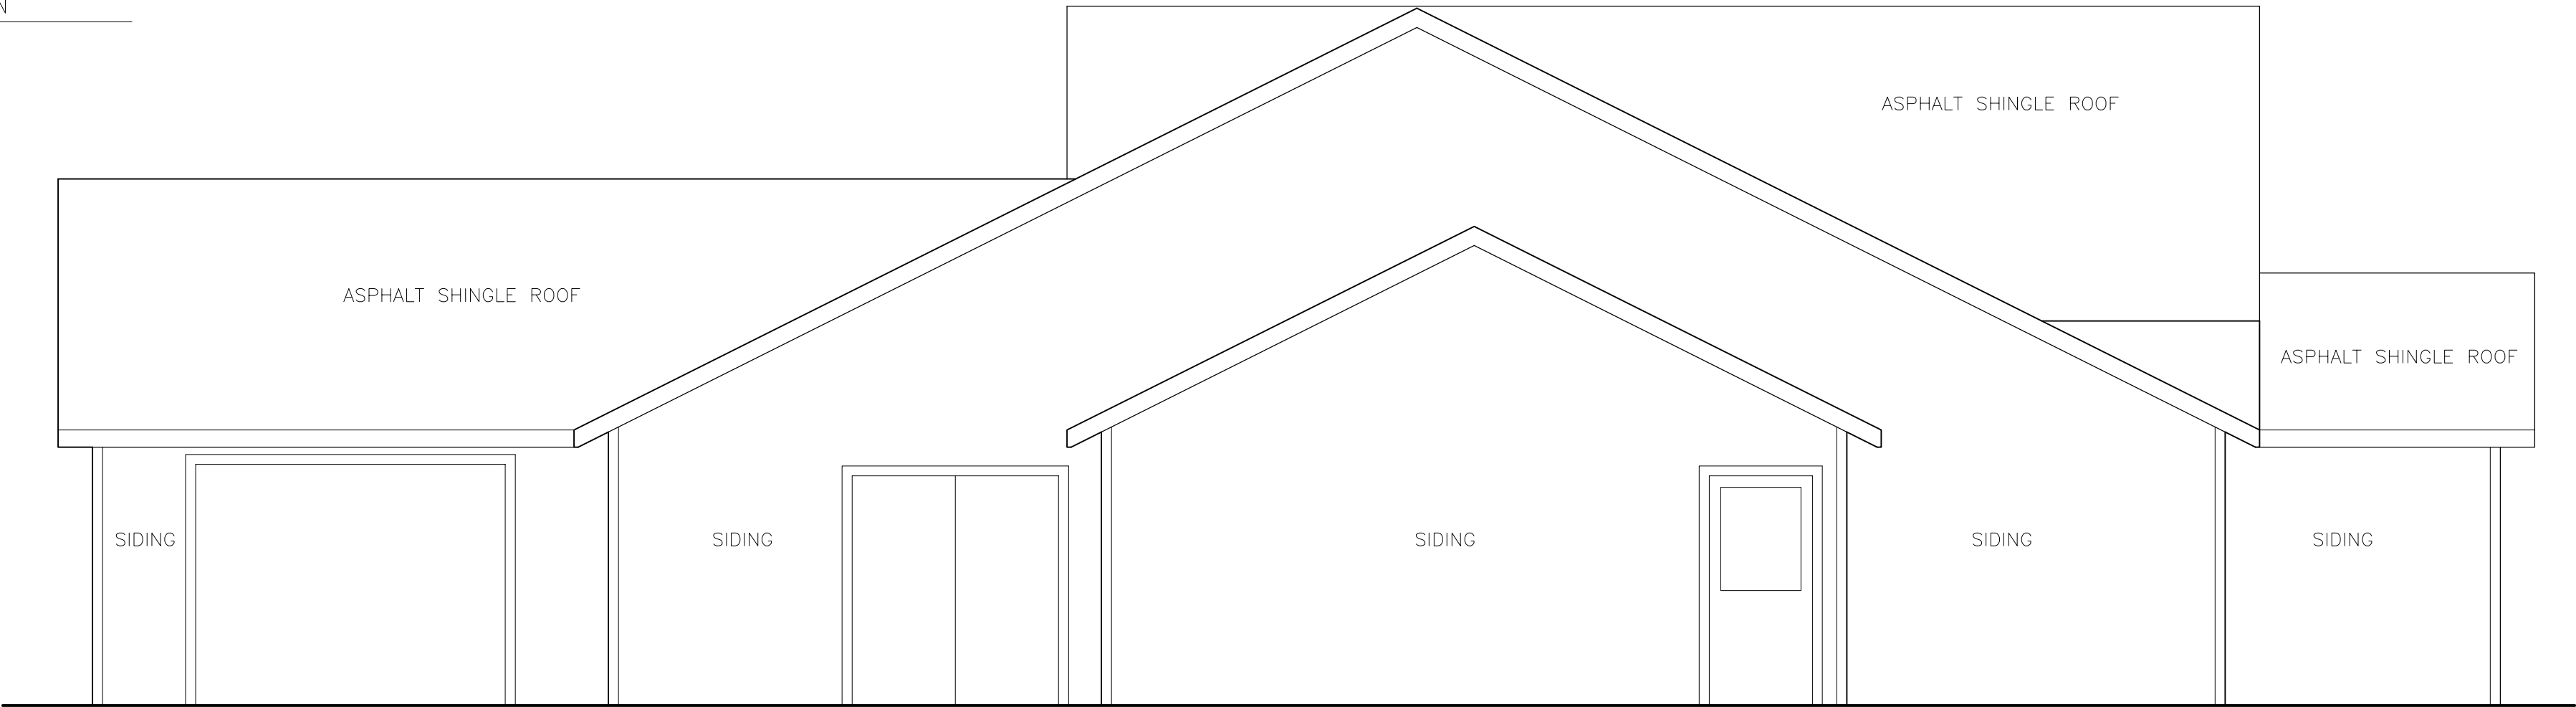

LEFT SIDE ELEVATION
SCALE: 1/4" = 1'-0"

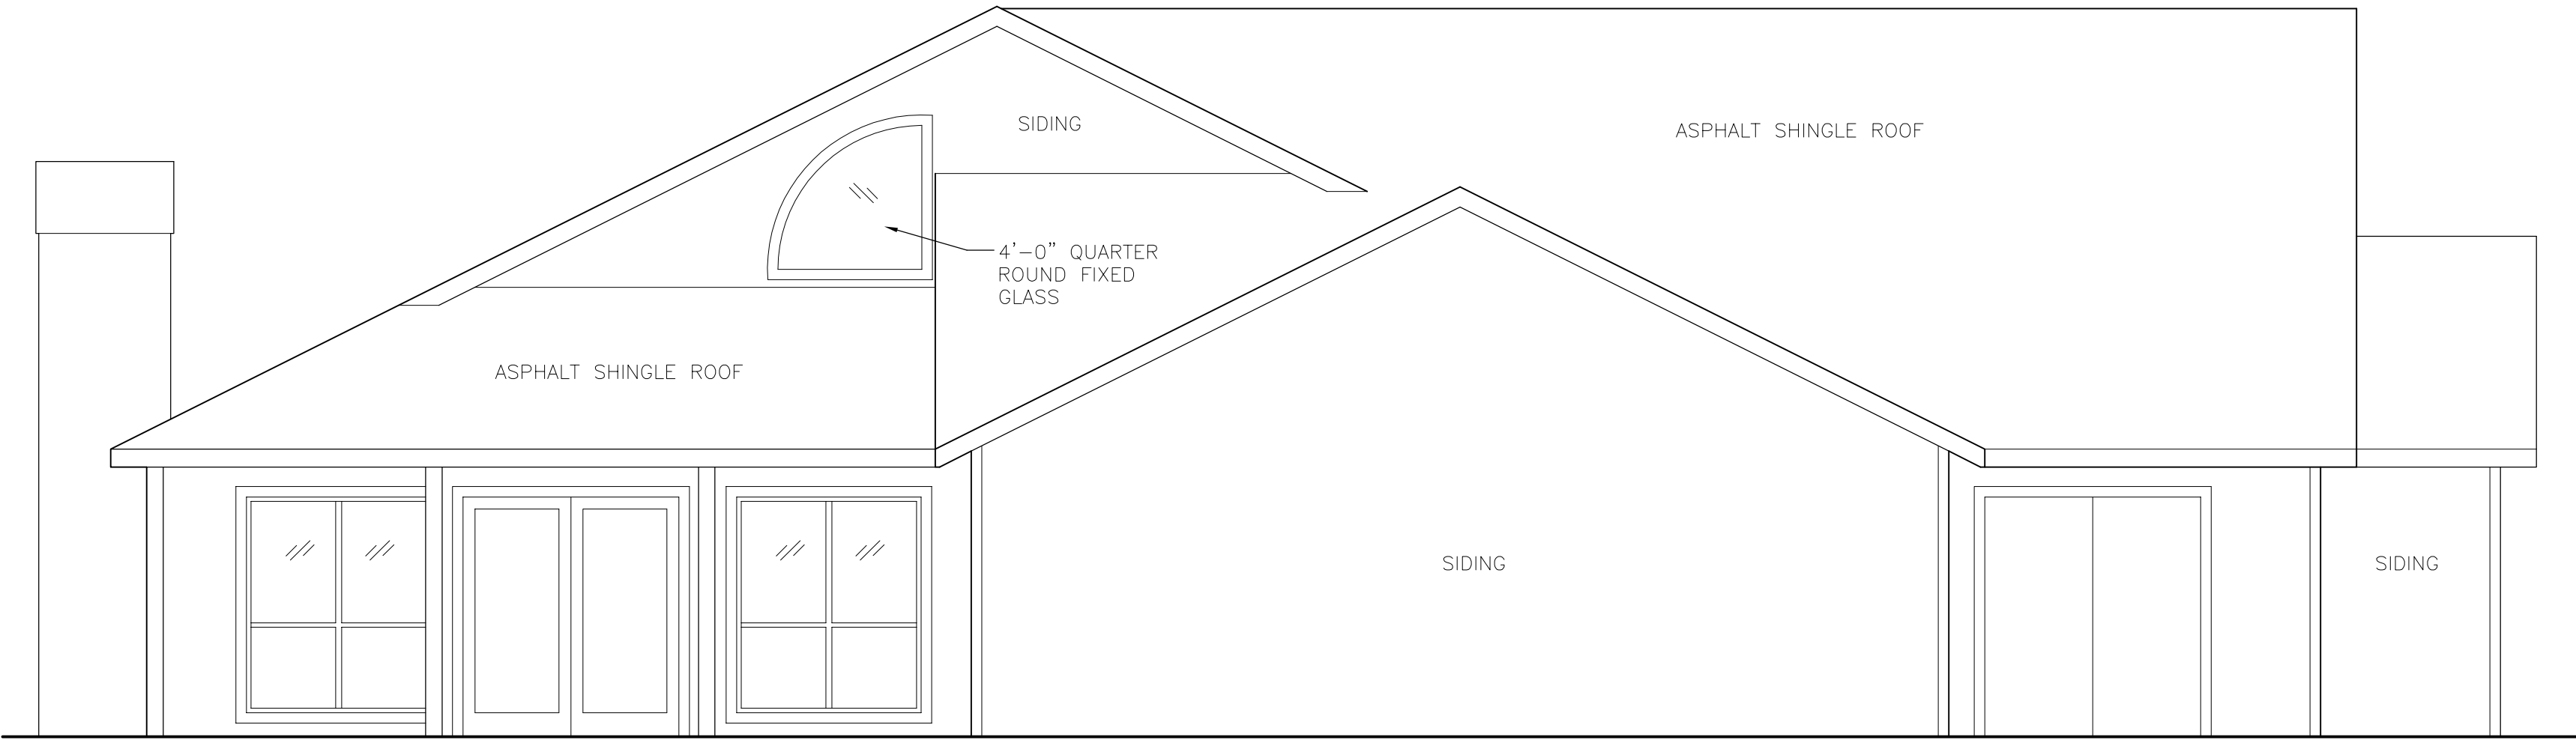

REAR ELEVATION
SCALE: 1/4" = 1'-0"

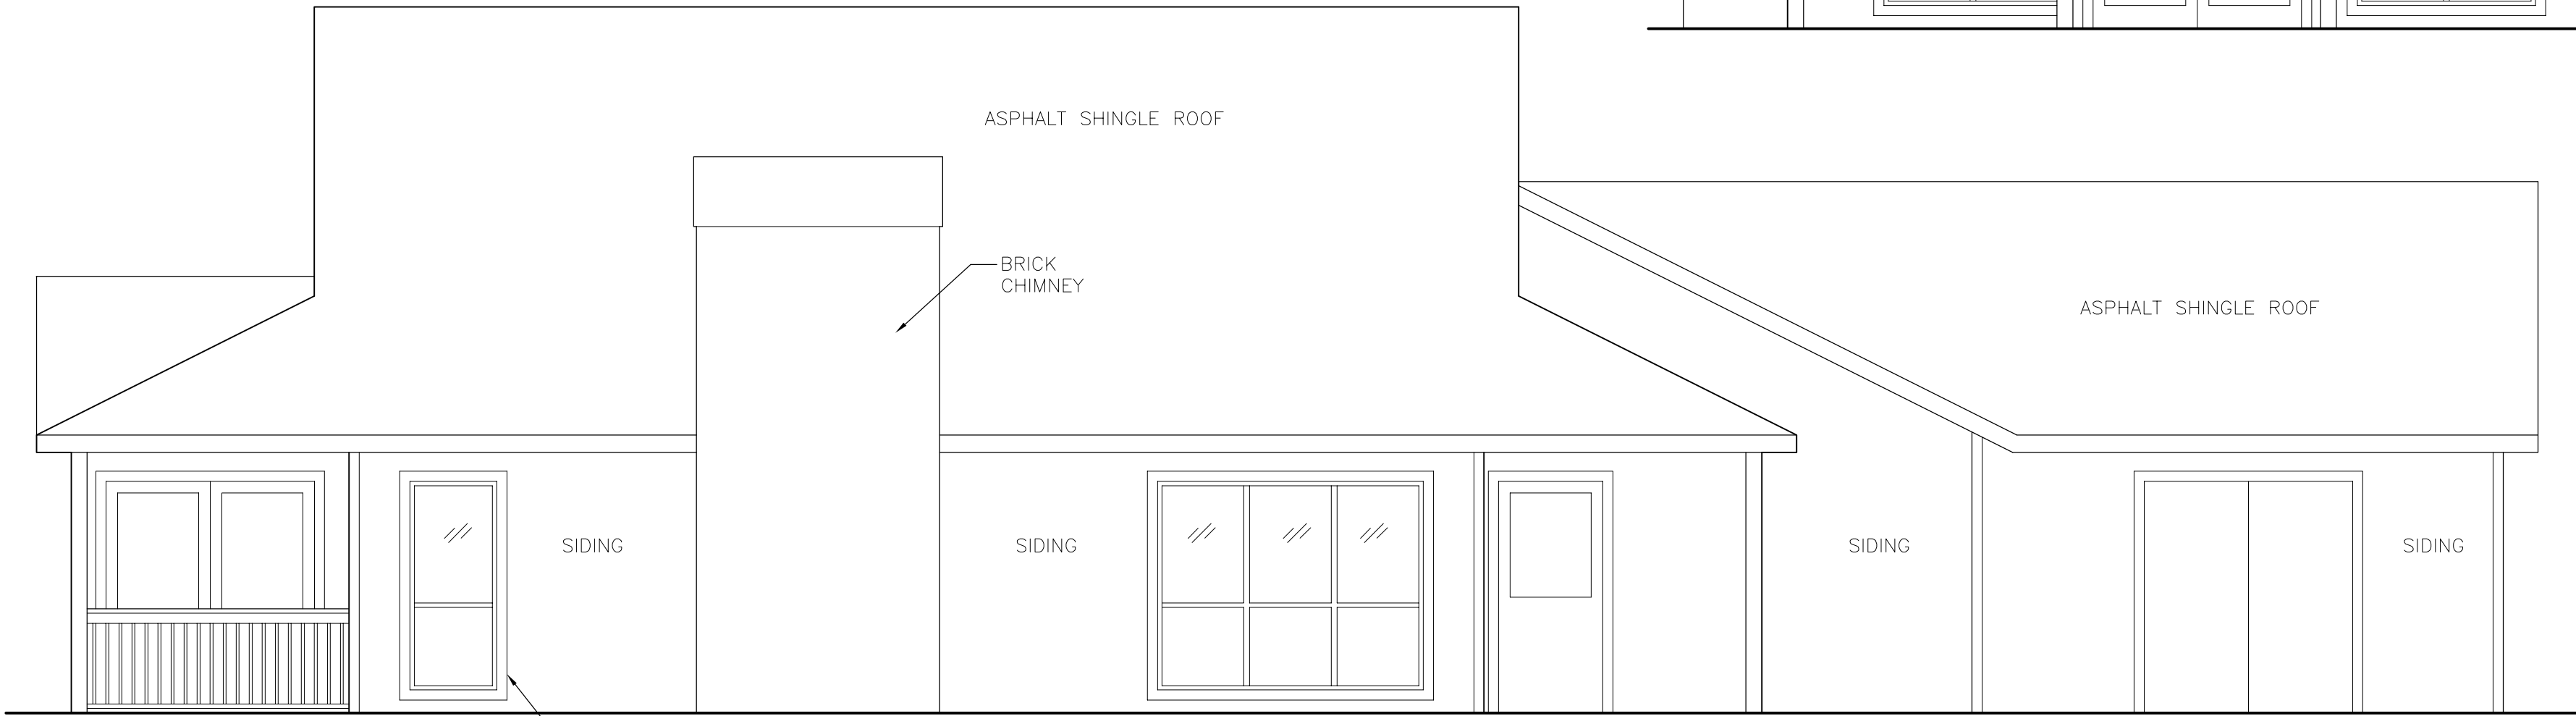

RIGHT SIDE ELEVATION
SCALE: 1/4" = 1'-0"

© 2015 AEC CONSULTANTS INC.







AEC
CONSULTANTS INC
THE AS BUILT PROFESSIONALS
844.272.8458
AS BUILT
www.asbuiltprofessionals.com

FACILITY DOCUMENTATION: COOPER'S POINTE APARTMENTS

North Charleston, SC 29406

NO.		ISSUES REVISIONS	DATE
		SHEET TITLE	
		PROJECT MANAGER	
		PROJECT DIRECTOR	
		PROJECT NUMBER	
AS NOTED		SCALE	
		DRAWN BY	
		SHEET NUMBER	

A-2

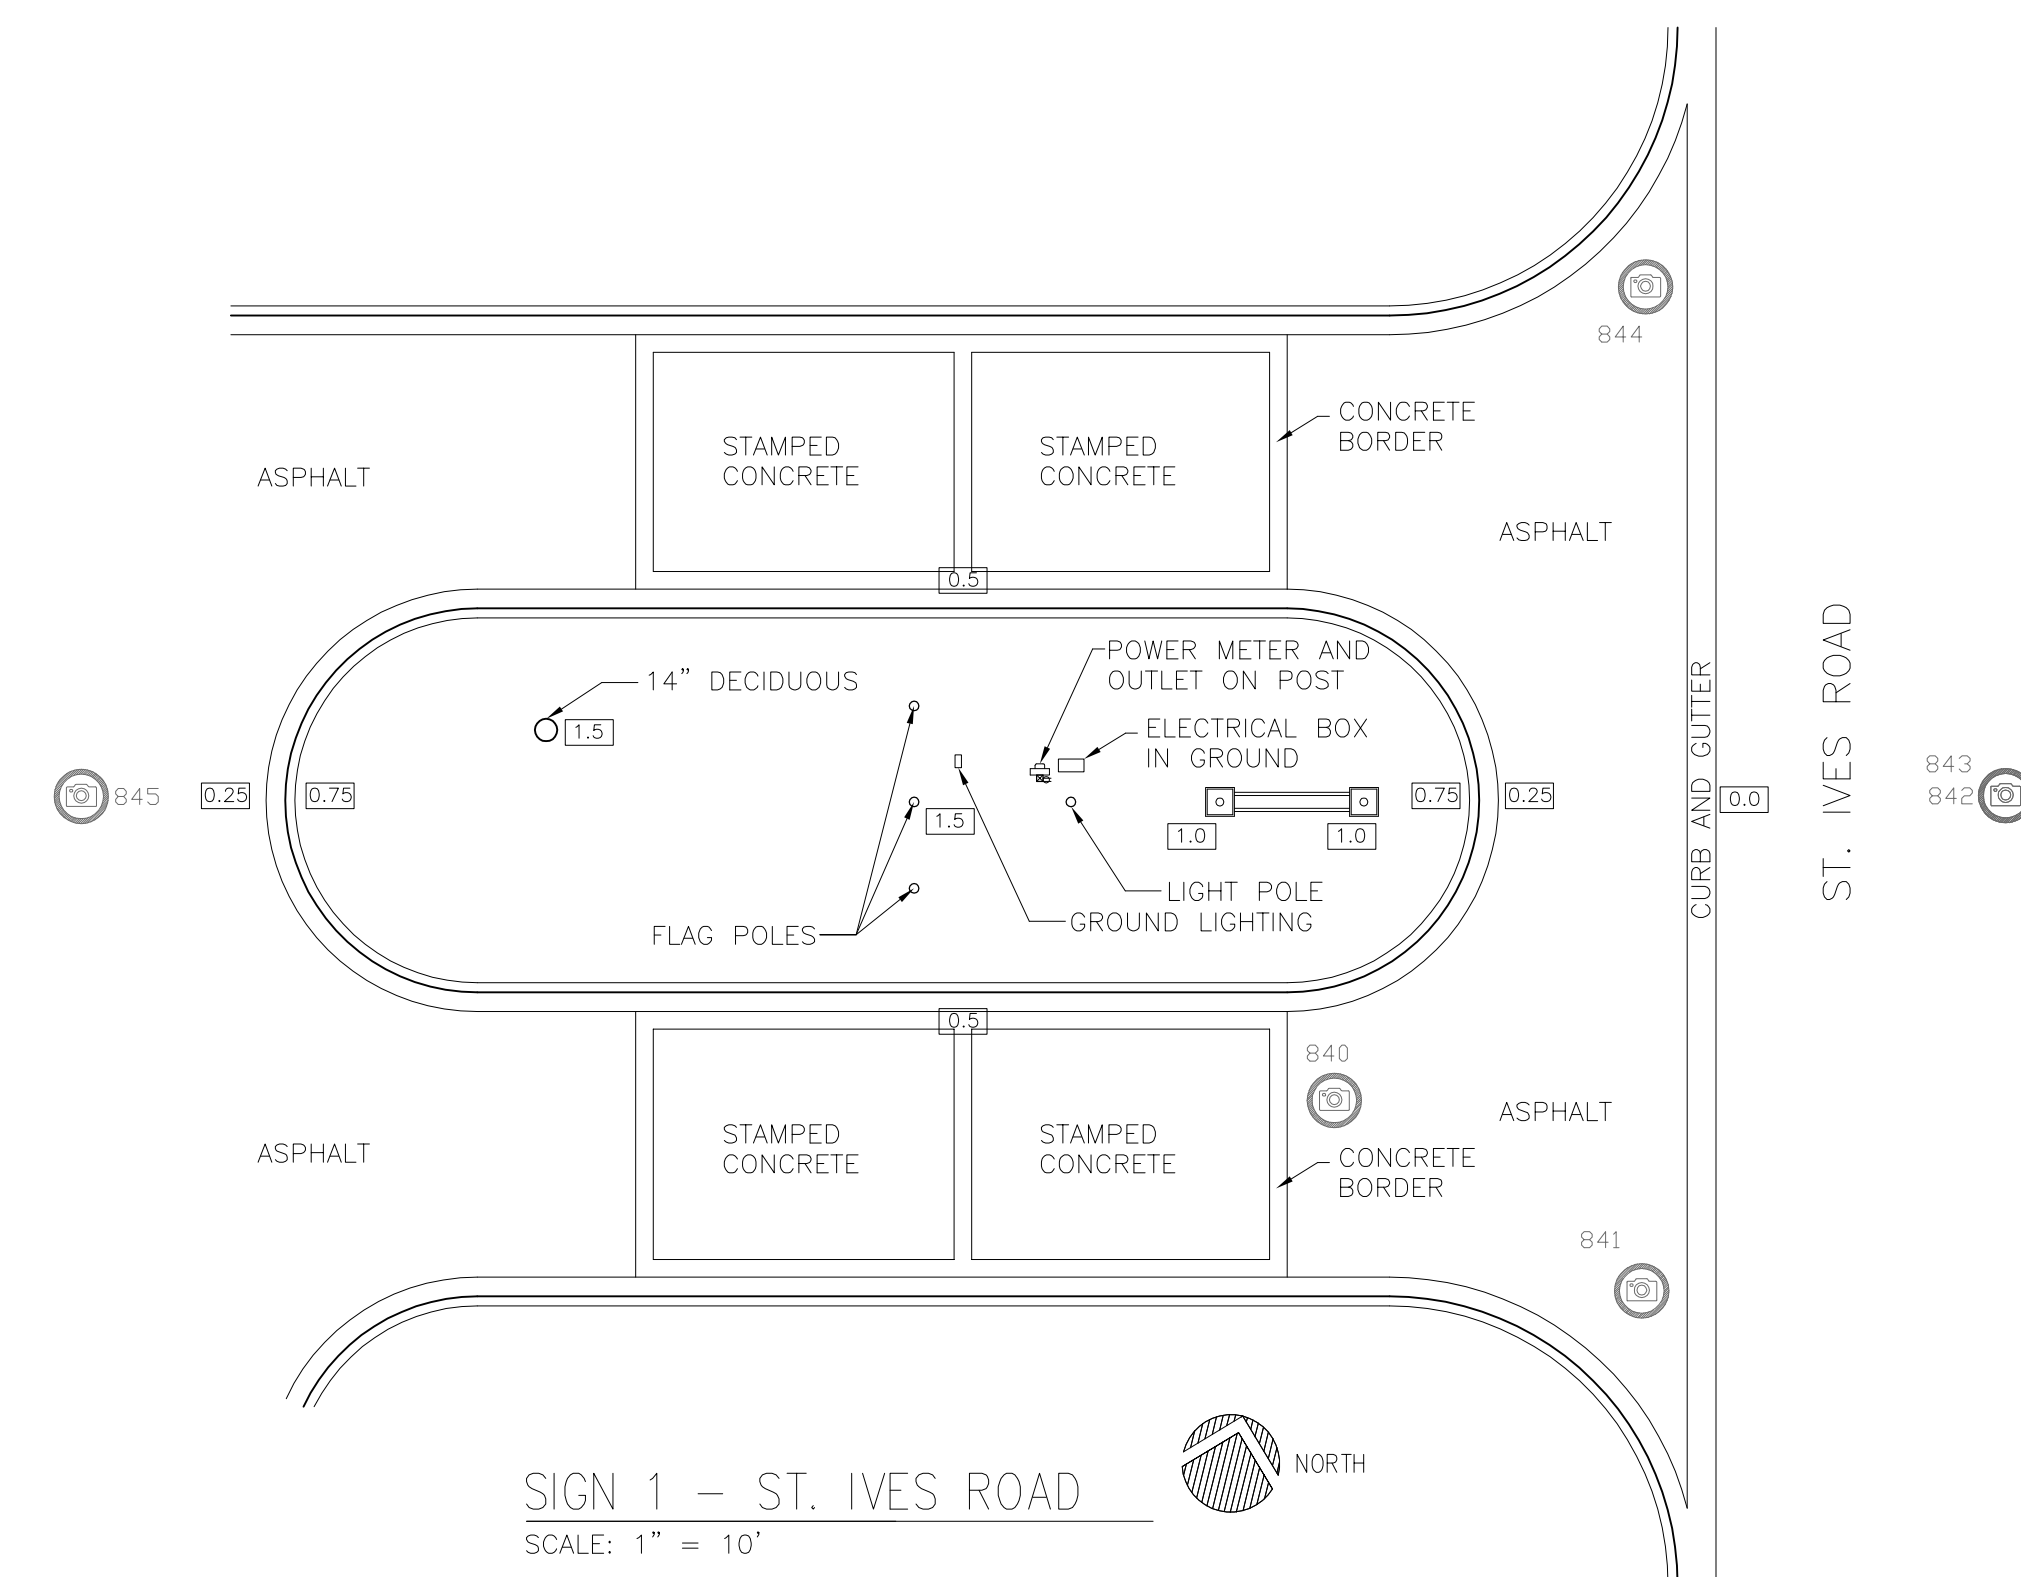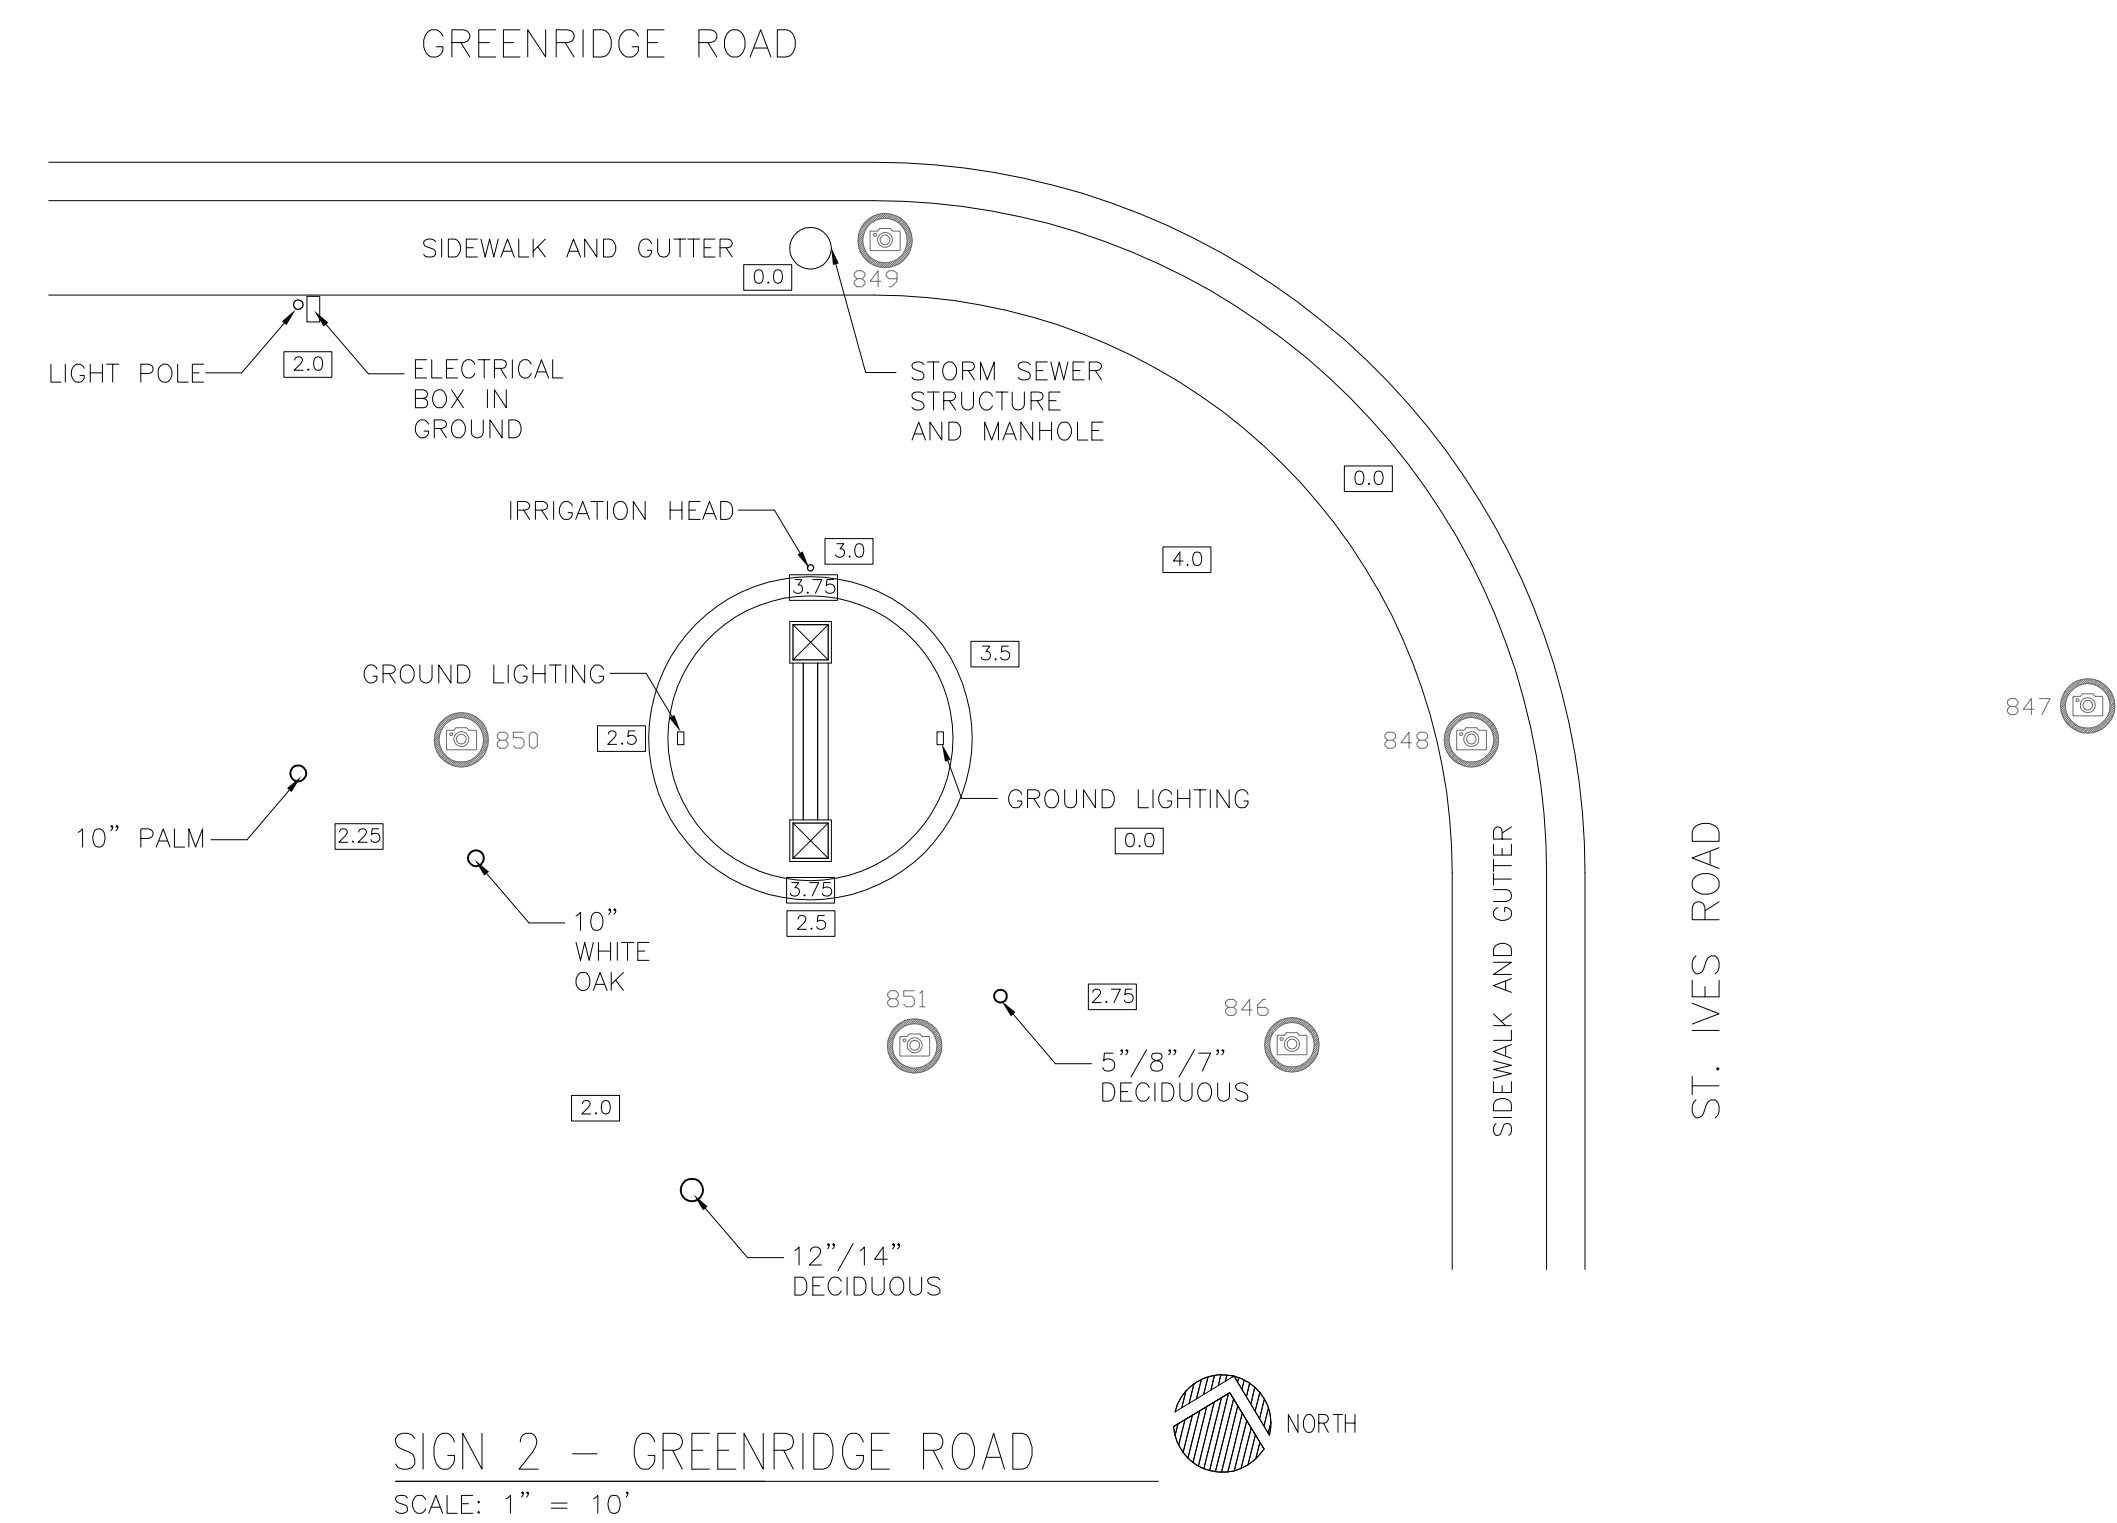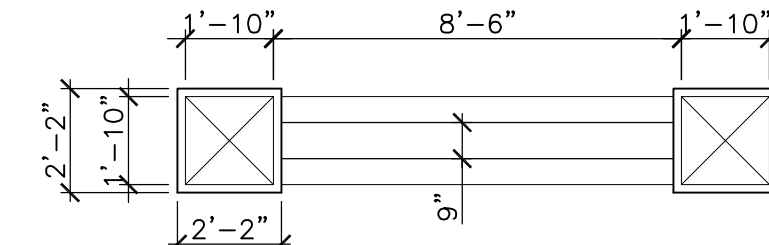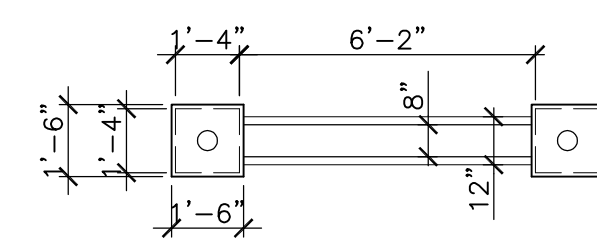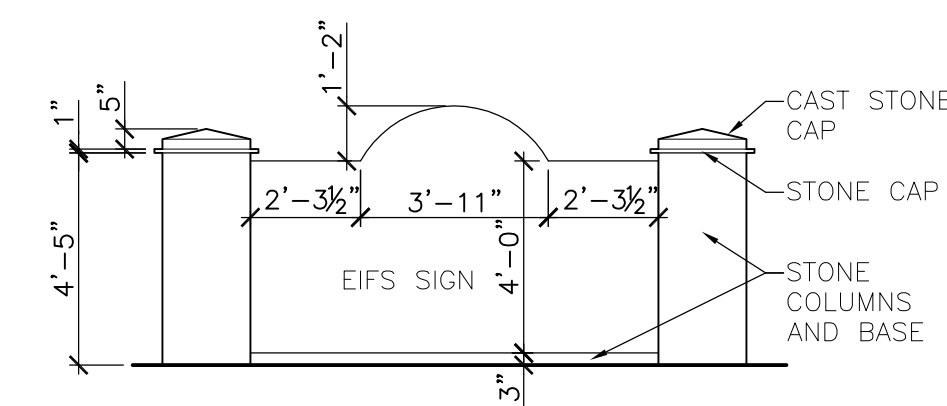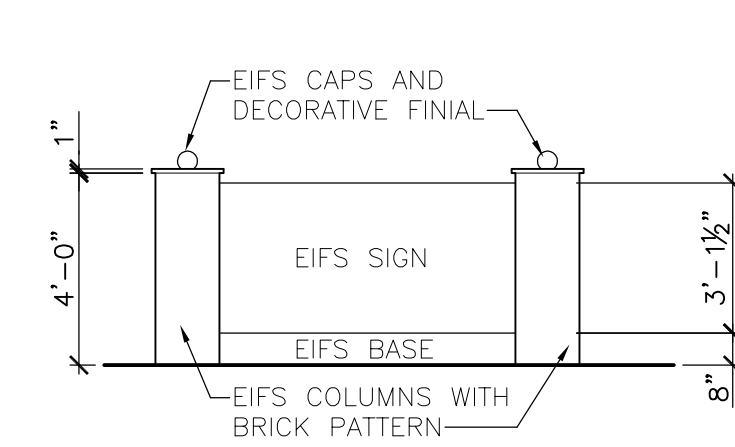

**FACILITY DOCUMENTATION:
COOPER'S POINTE APARTMENTS**

[illegible]

	PROJECT MANAGER
	PROJECT DIRECTOR
	PROJECT NUMBER
AS NOTED	SCALE
	DRAWN BY
	SHEET NUMBER