

AS-BUILT DOCUMENTATION

DWR FURNITURE ANNEX

PORTLAND, OR 97209


DRAWING INDEX

- C-1 COVER SHEET | DRAWING INDEX
- SL SYMBOLS LEGEND
- AB-1 FLOOR PLAN
- AB-2 REFLECTED CEILING PLAN
- AB-3 INTERIOR ELEVATIONS



© 2017 AEC CONSULTANTS INC

**ARCHITECTURAL AS BUILT
DWR FURNITURE ANNEX
PORTLAND, OR**

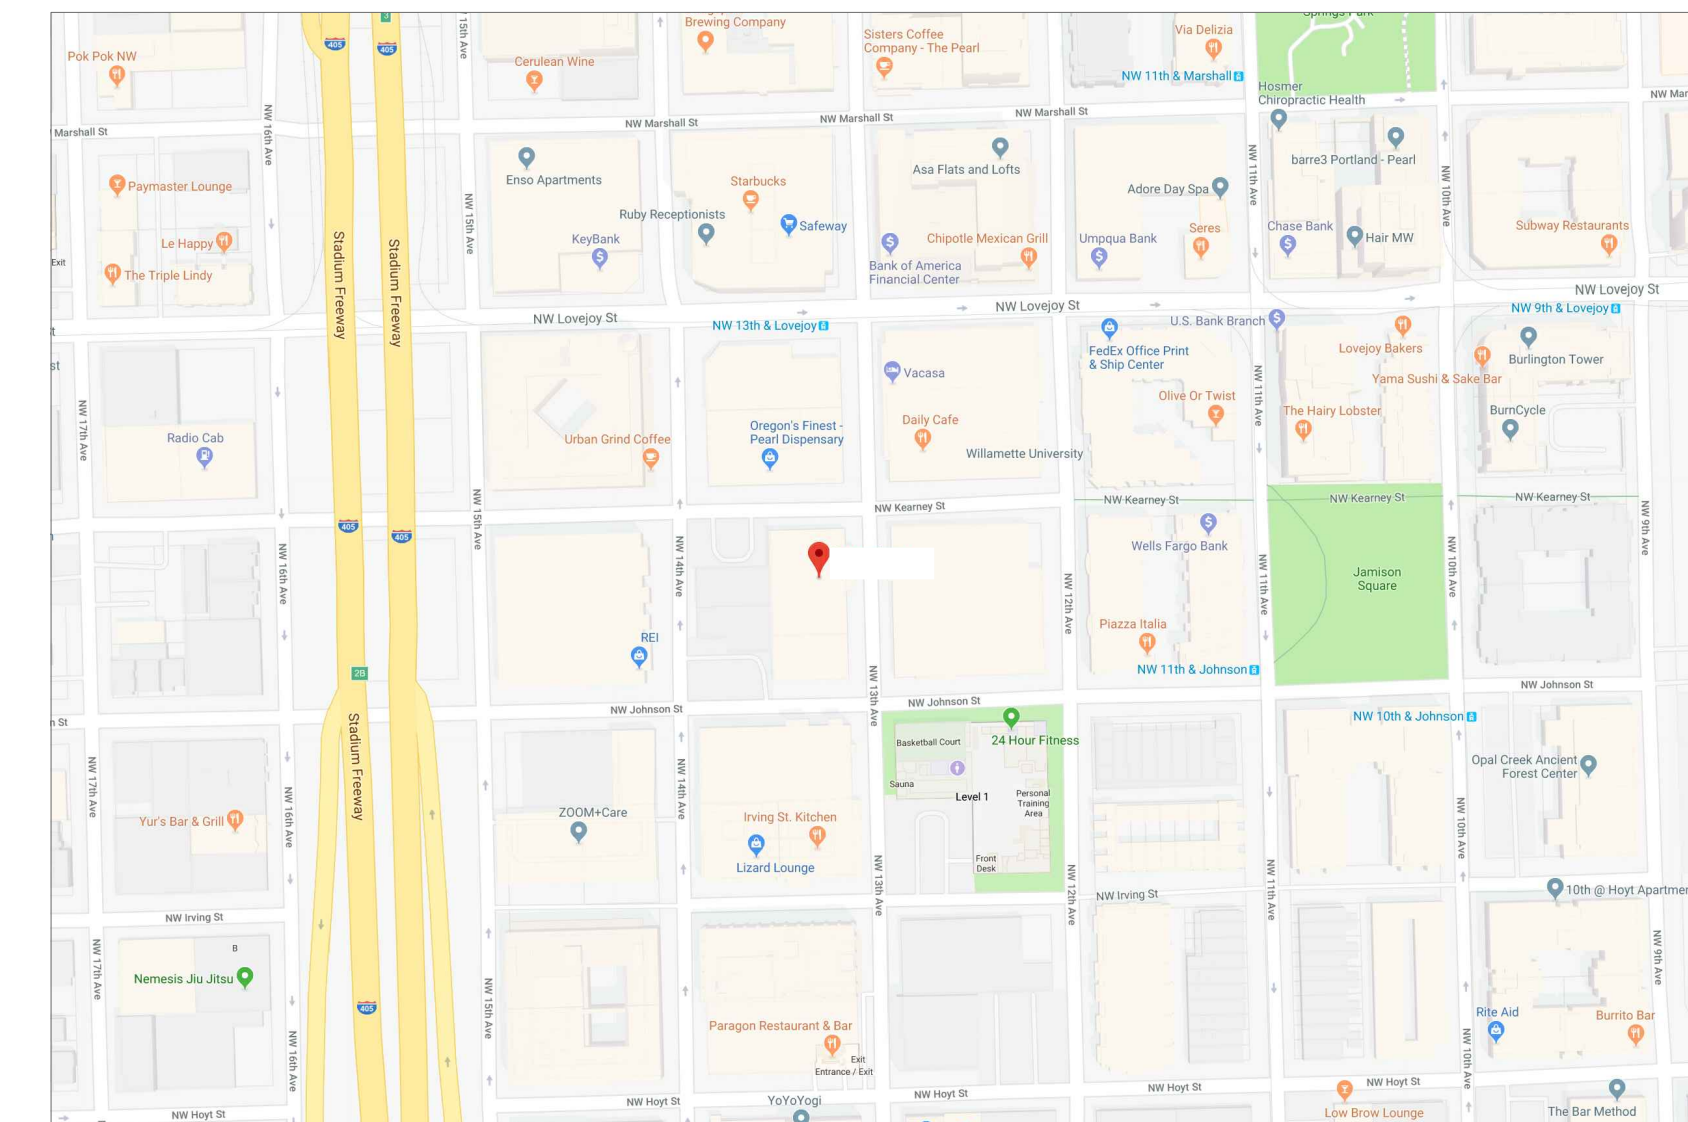

VICINITY MAP
NTS


AREA DATA	
RETAIL SPACE	3,700 S.F. ±

100% SUBMITTAL

01	100% SUBMISSION	SEE COVER SHEET
NO.	ISSUES REVISIONS	DATE
		SHEET TITLE
COVER SHEET		
HL		PROJECT MANAGER
HL		PROJECT DIRECTOR
012317-1		PROJECT NUMBER
		SCALE
CL		DRAWN BY
		SHEET NUMBER

C-1

ARCHITECTURAL AS BUILT
DWR FURNITURE ANNEX
PORTLAND, OR

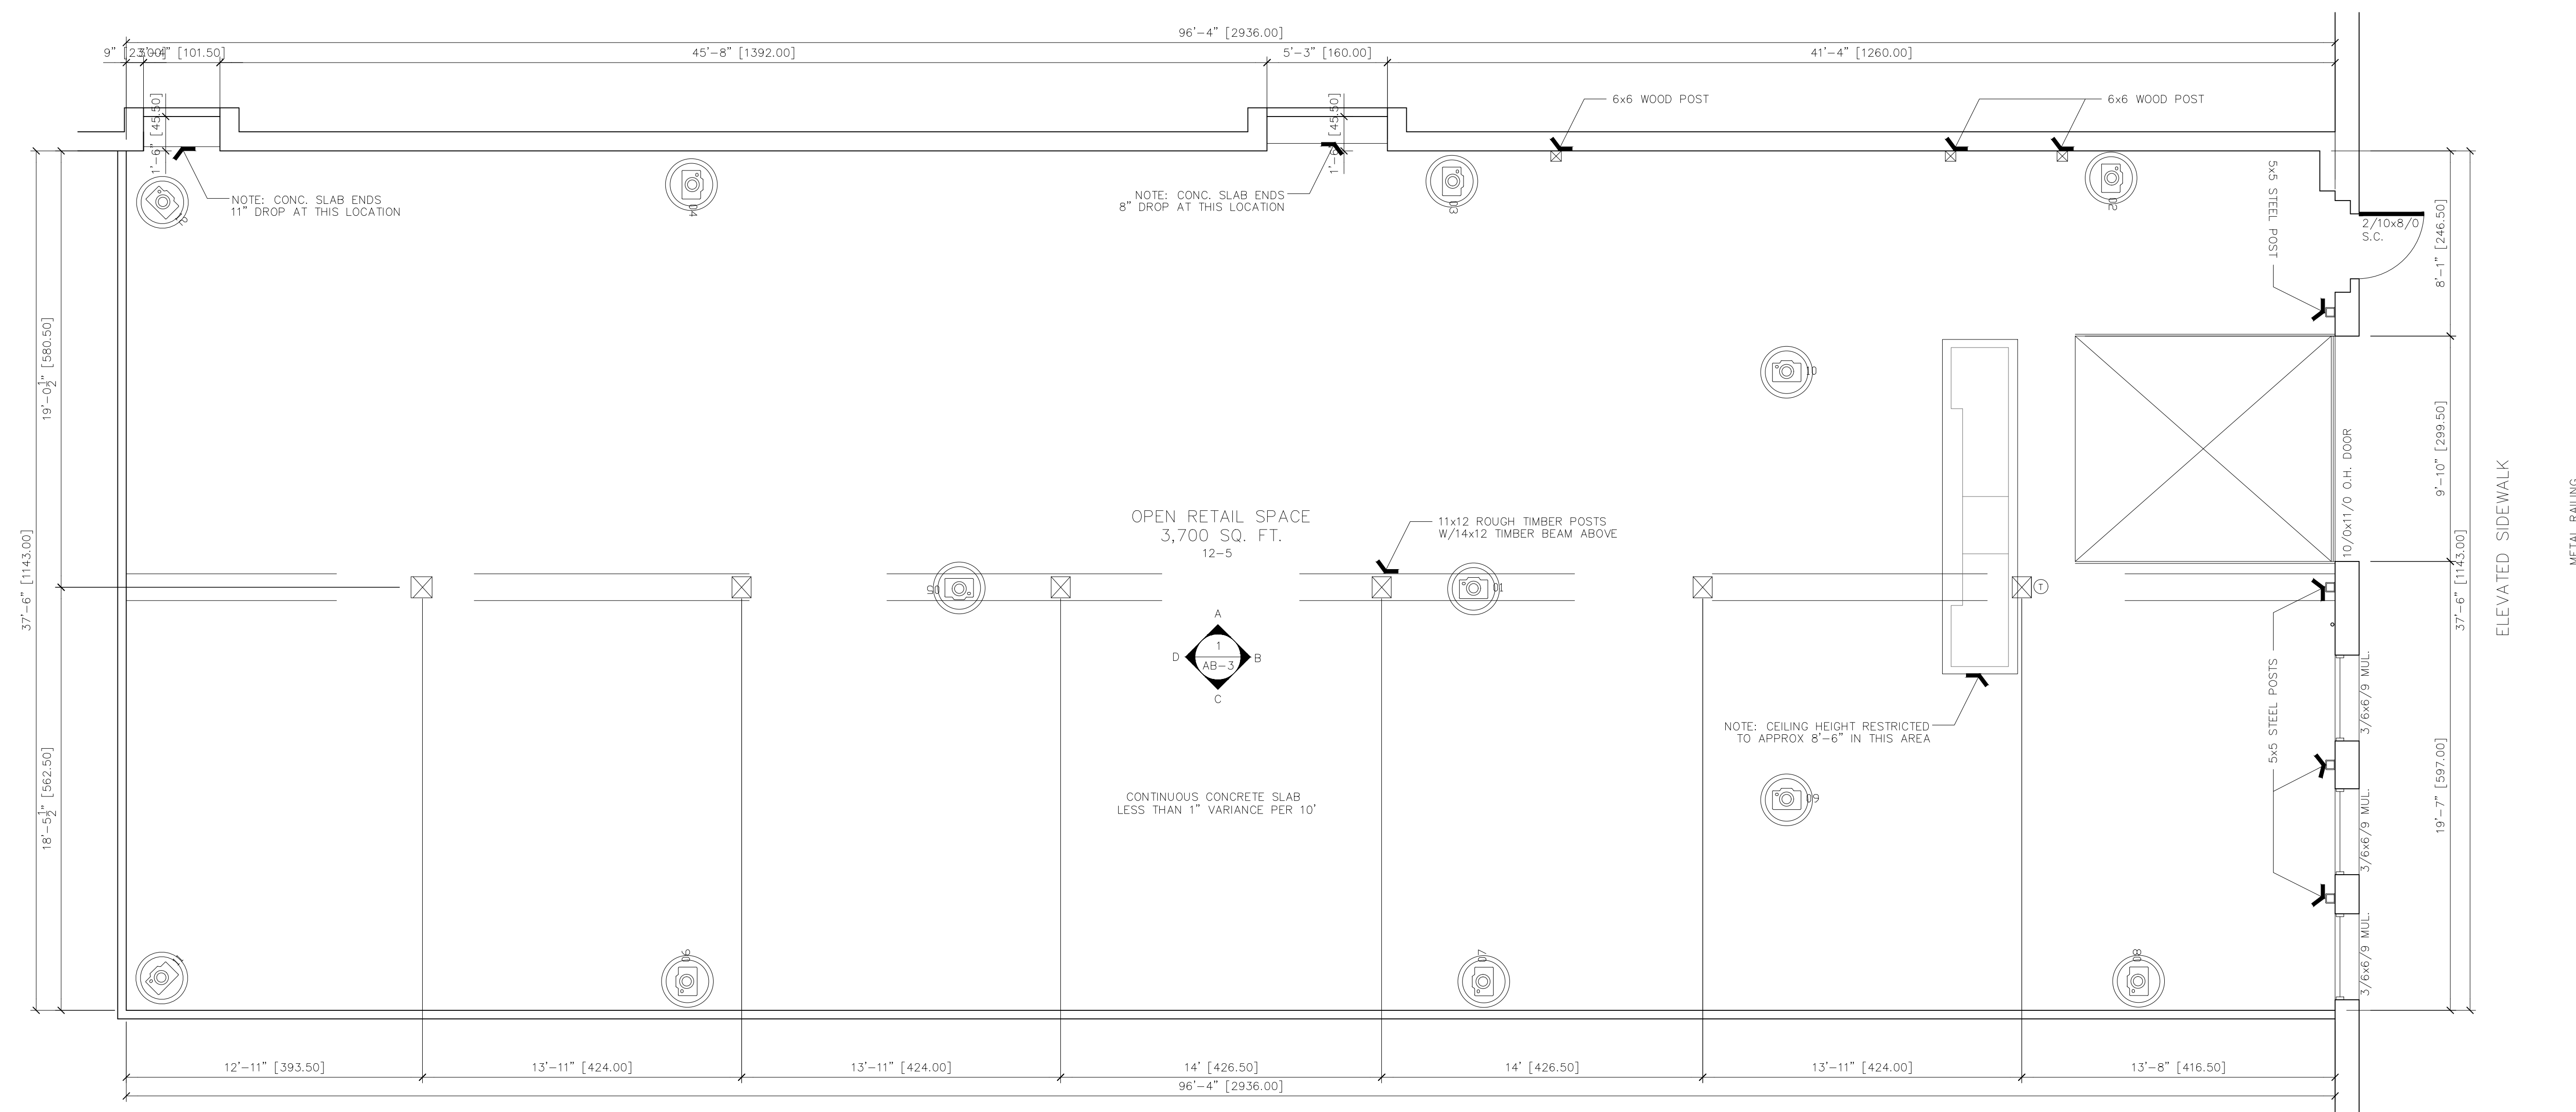

FLOOR PLAN

AREA DATA	
OPEN RETAIL SPACE	3,700 S.F. ±

NW 13th AVE

ELEVATED SIDEWALK

METAL RAILING

01	100% SUBMISSION	SEE COVER SHEET
NO.	ISSUES REVISIONS	DATE
SHEET TITLE		

HL	PROJECT MANAGER
HL	PROJECT DIRECTOR
012317-1	PROJECT NUMBER
1/4"=1'-0"	SCALE
CL	DRAWN BY
	SHEET NUMBER

AB-1

