

SYMBOLS LEGEND

RCP

	EXHAUST VENT		TRACK LIGHT OR VANITY LIGHT
	CEILING MOUNTED LIGHT FIXTURE		WALL-MOUNTED LIGHT FIXTURE
	CEILING MOUNTED DIRECTIONAL LIGHT		EMERGENCY EXIT SIGN
	RECESSED CAN LIGHT		EMERGENCY EXIT LIGHT
	EYEBALL OR SMALL CAN LIGHT		EMERGENCY EXIT LIGHT W/ SIGN
	PENDANT LIGHT		LIGHTED STAIR SIGN
	INDIVIDUAL FLUOR. LAY-IN FIXTURE 4 BULB		FLOOD LIGHT
	INDIVIDUAL FLUOR. HANGING FIXTURE 2 BULB		PHOTO CELL
	INDIVIDUAL FLUOR. FLUSH MOUNT FIXTURE 4 BULB		CEILING FAN
	CAMERA		CEILING FAN W/ LIGHT KIT
	MOTION DET.		7-2-6 CEILING HEIGHT AND TRIM 7'-2" ABOVE FLOOR BELOW WITH 6" CROWN MOULDING. NOTE: ALL CEILINGS NOT LABELED ARE PLASTER. CEILINGS SHOWN WITH A GRID ARE LAY IN ACOUSTICAL TILE..
	SUPPLY VENT		JUNCTION BOX
	SUPPLY VENT		
	RETURN VENT		
	RETURN VENT		
	SPEAKER		

ELECTRIC

	DATA OUTLET
	TELEPHONE JACK

	ELECTRIC PANEL
	ELECTRIC METER
	BUTTON SWITCH
	DISCONNECT SWITCH
	GROUND/FLOOR LIGHT
	KEY PAD

FIRE PROTECTION


	FIRE EXTINGUISHER
	FIRE PULL
	FIRE ALARM (HORN/SRTOBE)
	SMOKE DETECTOR
	SMOKE ALARM SPEAKER
	SPRINKLER HEAD CEILING MOUNT
	SPRINKLER HEAD WALL MOUNT

MEP


	THERMOSTAT
	FLOOR DRAIN
	VALVE
	HOSE BIB
	WATER SUPPLY
	SUSPENDED GAS HEATER

MISC

	BOLLARD
	SPOT ELEVATION

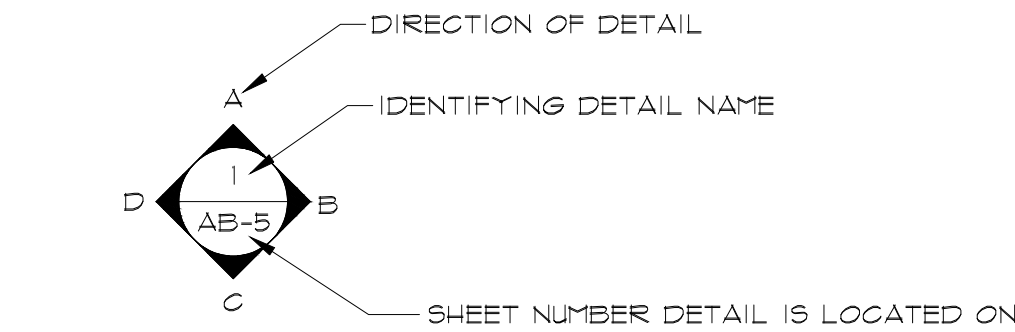

INTERIOR ELEVATIONS

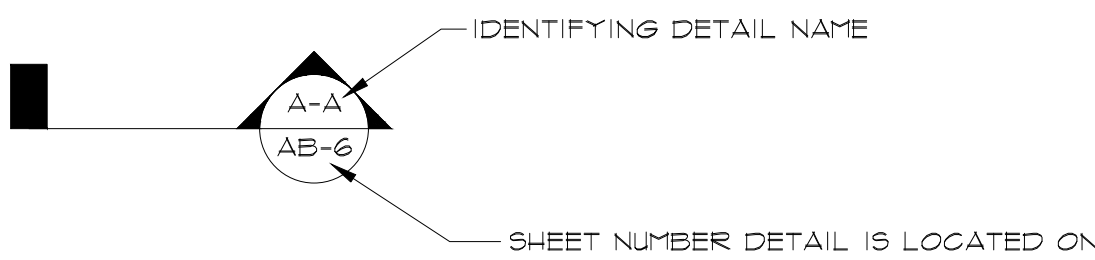

BUILDING SECTION

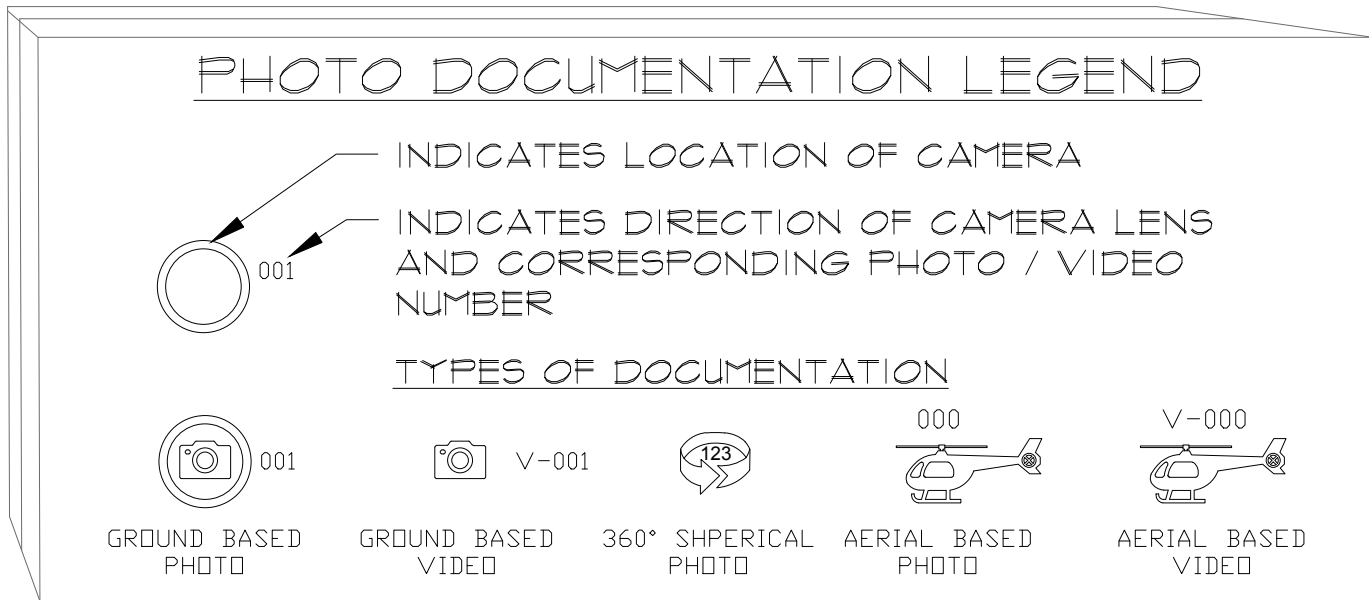


PHOTO DOCUMENTATION LEGEND

INDICATES LOCATION OF CAMERA
INDICATES DIRECTION OF CAMERA LENS AND CORRESPONDING PHOTO / VIDEO NUMBER

TYPES OF DOCUMENTATION

	001		V-001		000		000		V-000
GROUND BASED PHOTO		GROUND BASED VIDEO		360° SPHERICAL PHOTO		AERIAL BASED PHOTO		AERIAL BASED VIDEO	



© 2019 AEC CONSULTANTS INC.

ARCHITECTURAL AS BUILT
HOLIDAY MANOR APARTMENTS
Oxnard, CA 94901

01	100% SUBMISSION	SEE COVER SHEET
NO.	ISSUES / REVISIONS	DATE

SHEET TITLE

HL	PROJECT MANAGER
HL	PROJECT DIRECTOR
012317-1	PROJECT NUMBER
NOT TO SCALE	SCALE
CL	DRAWN BY
	SHEET NUMBER

SL







ARCHITECTURAL AS BUILT

DATE _____DRAWN BY

SL



BUILDING LOCATION MAP NOT TO SCALE

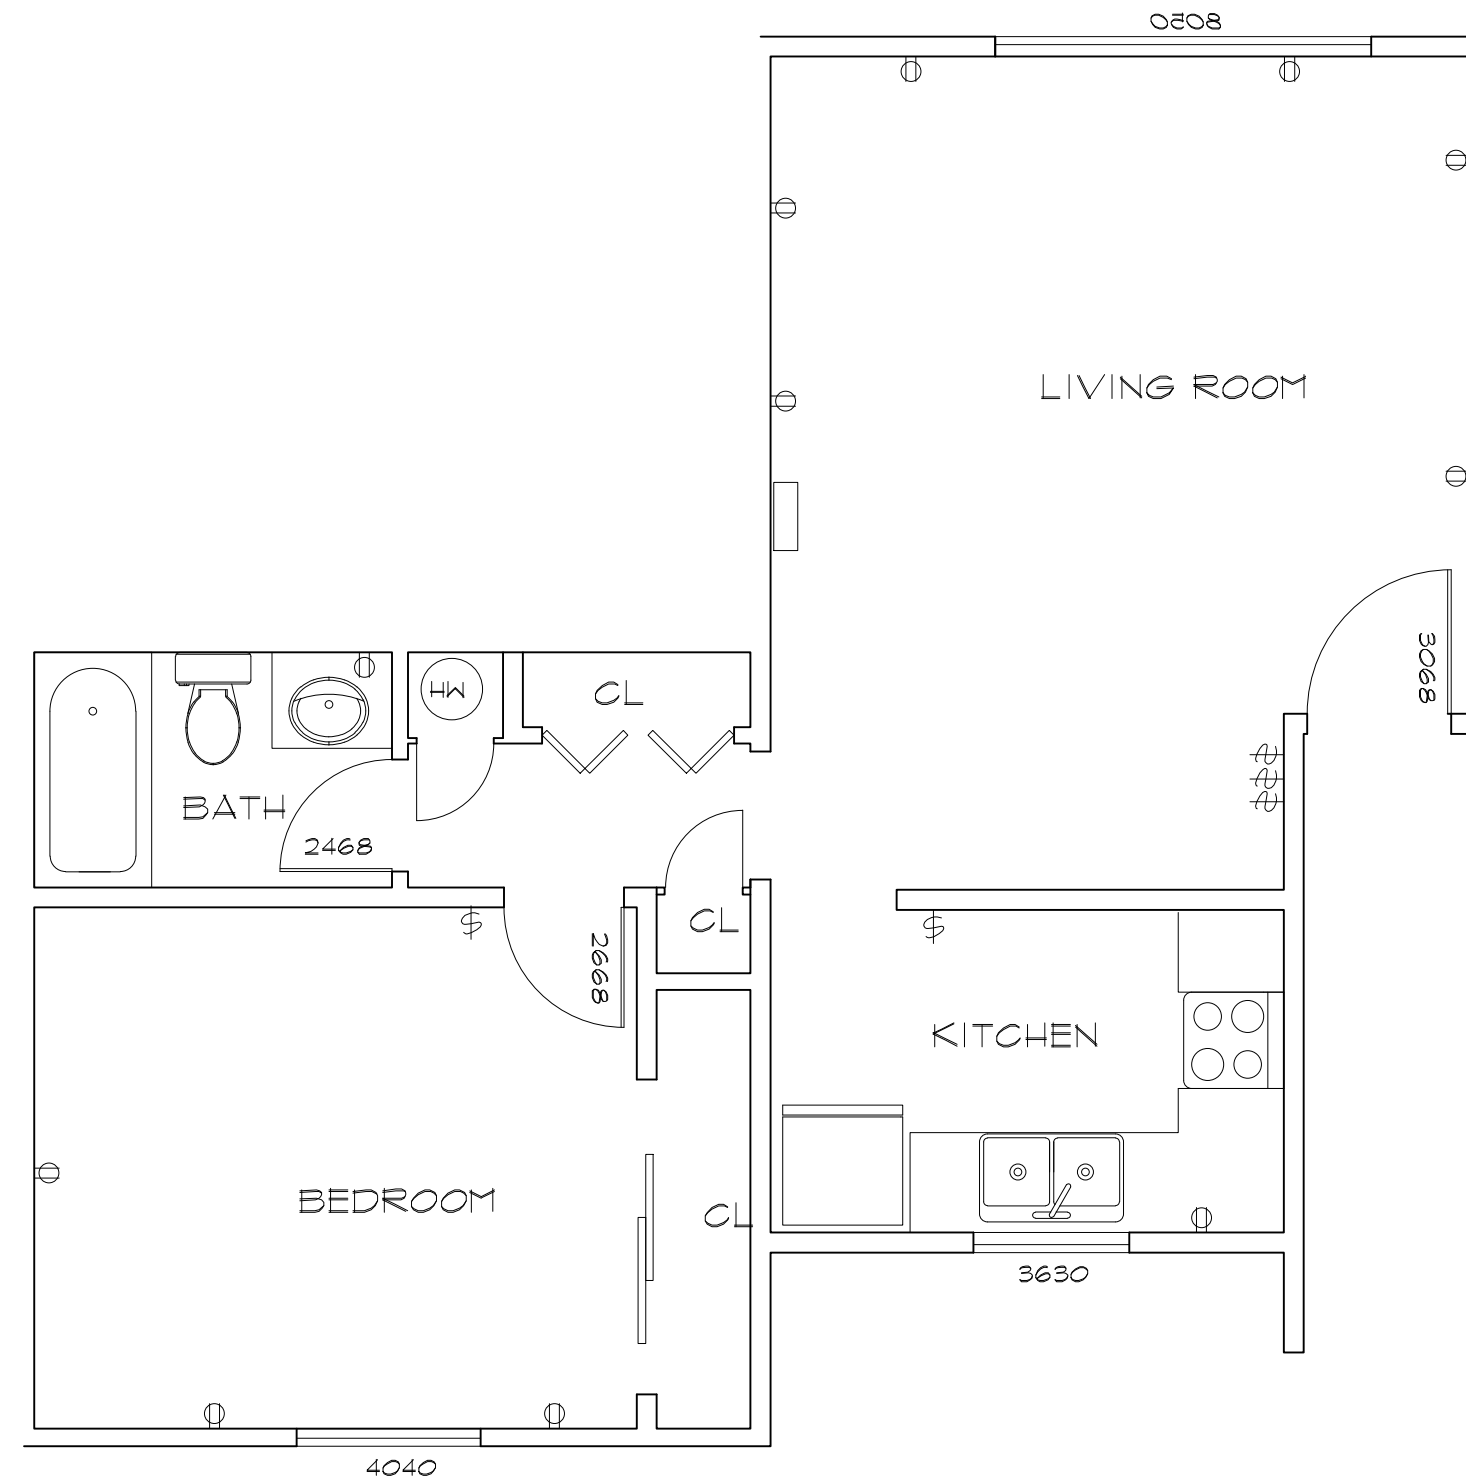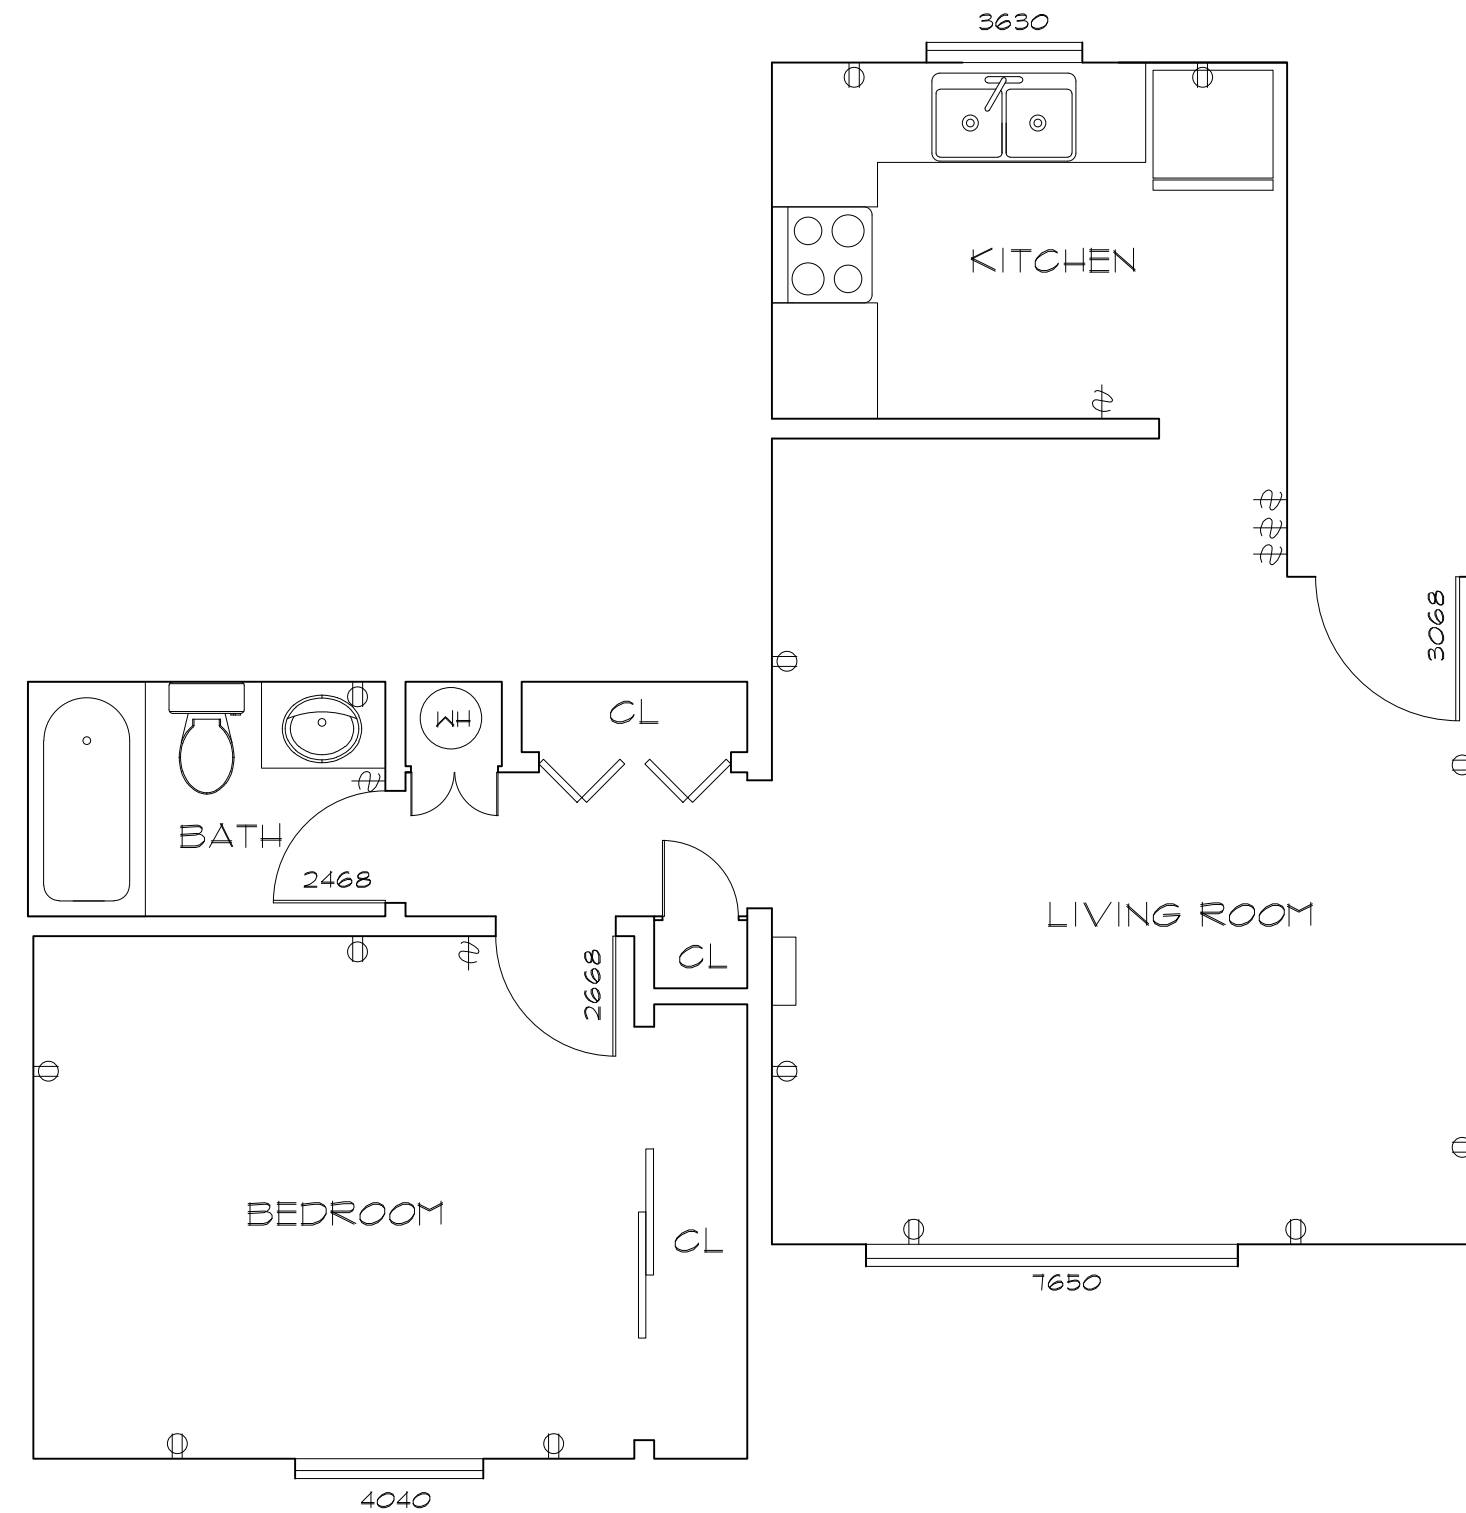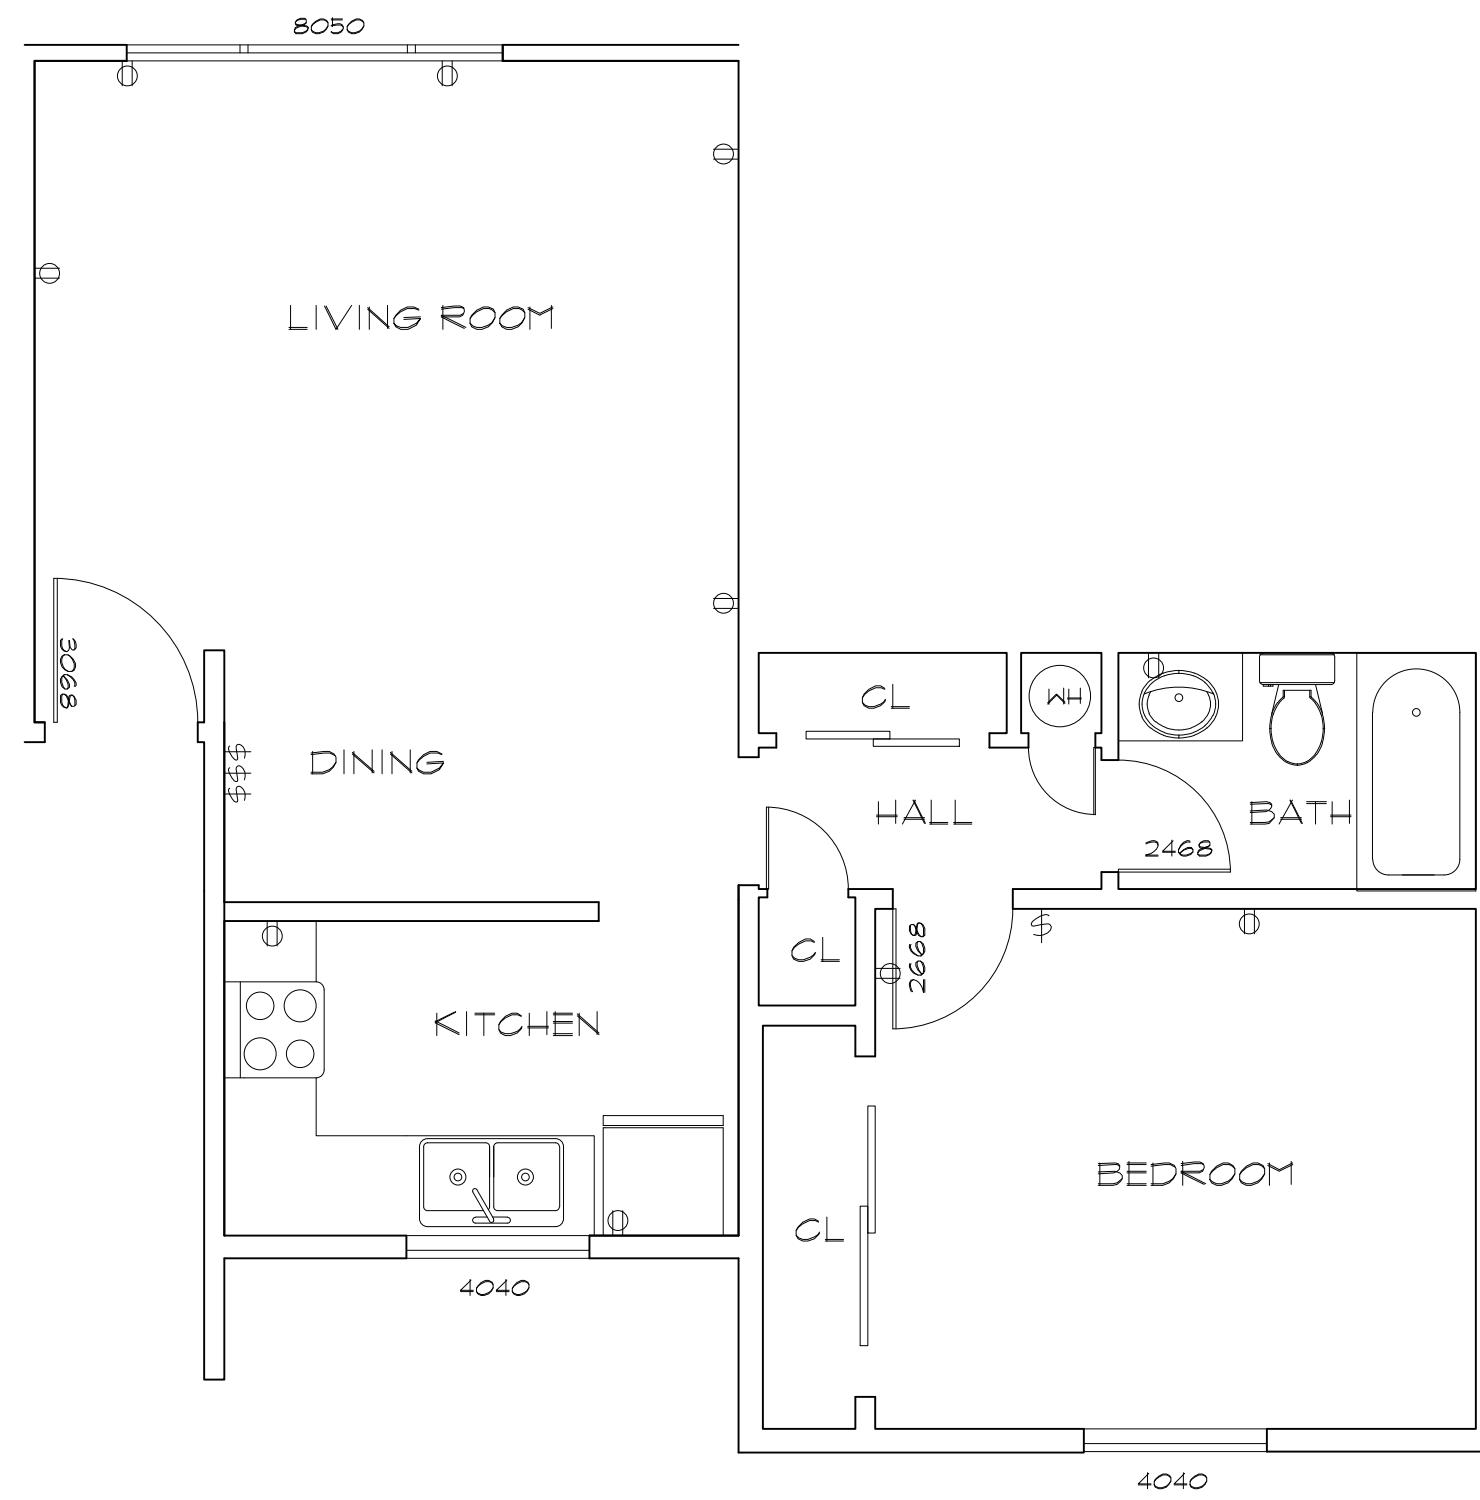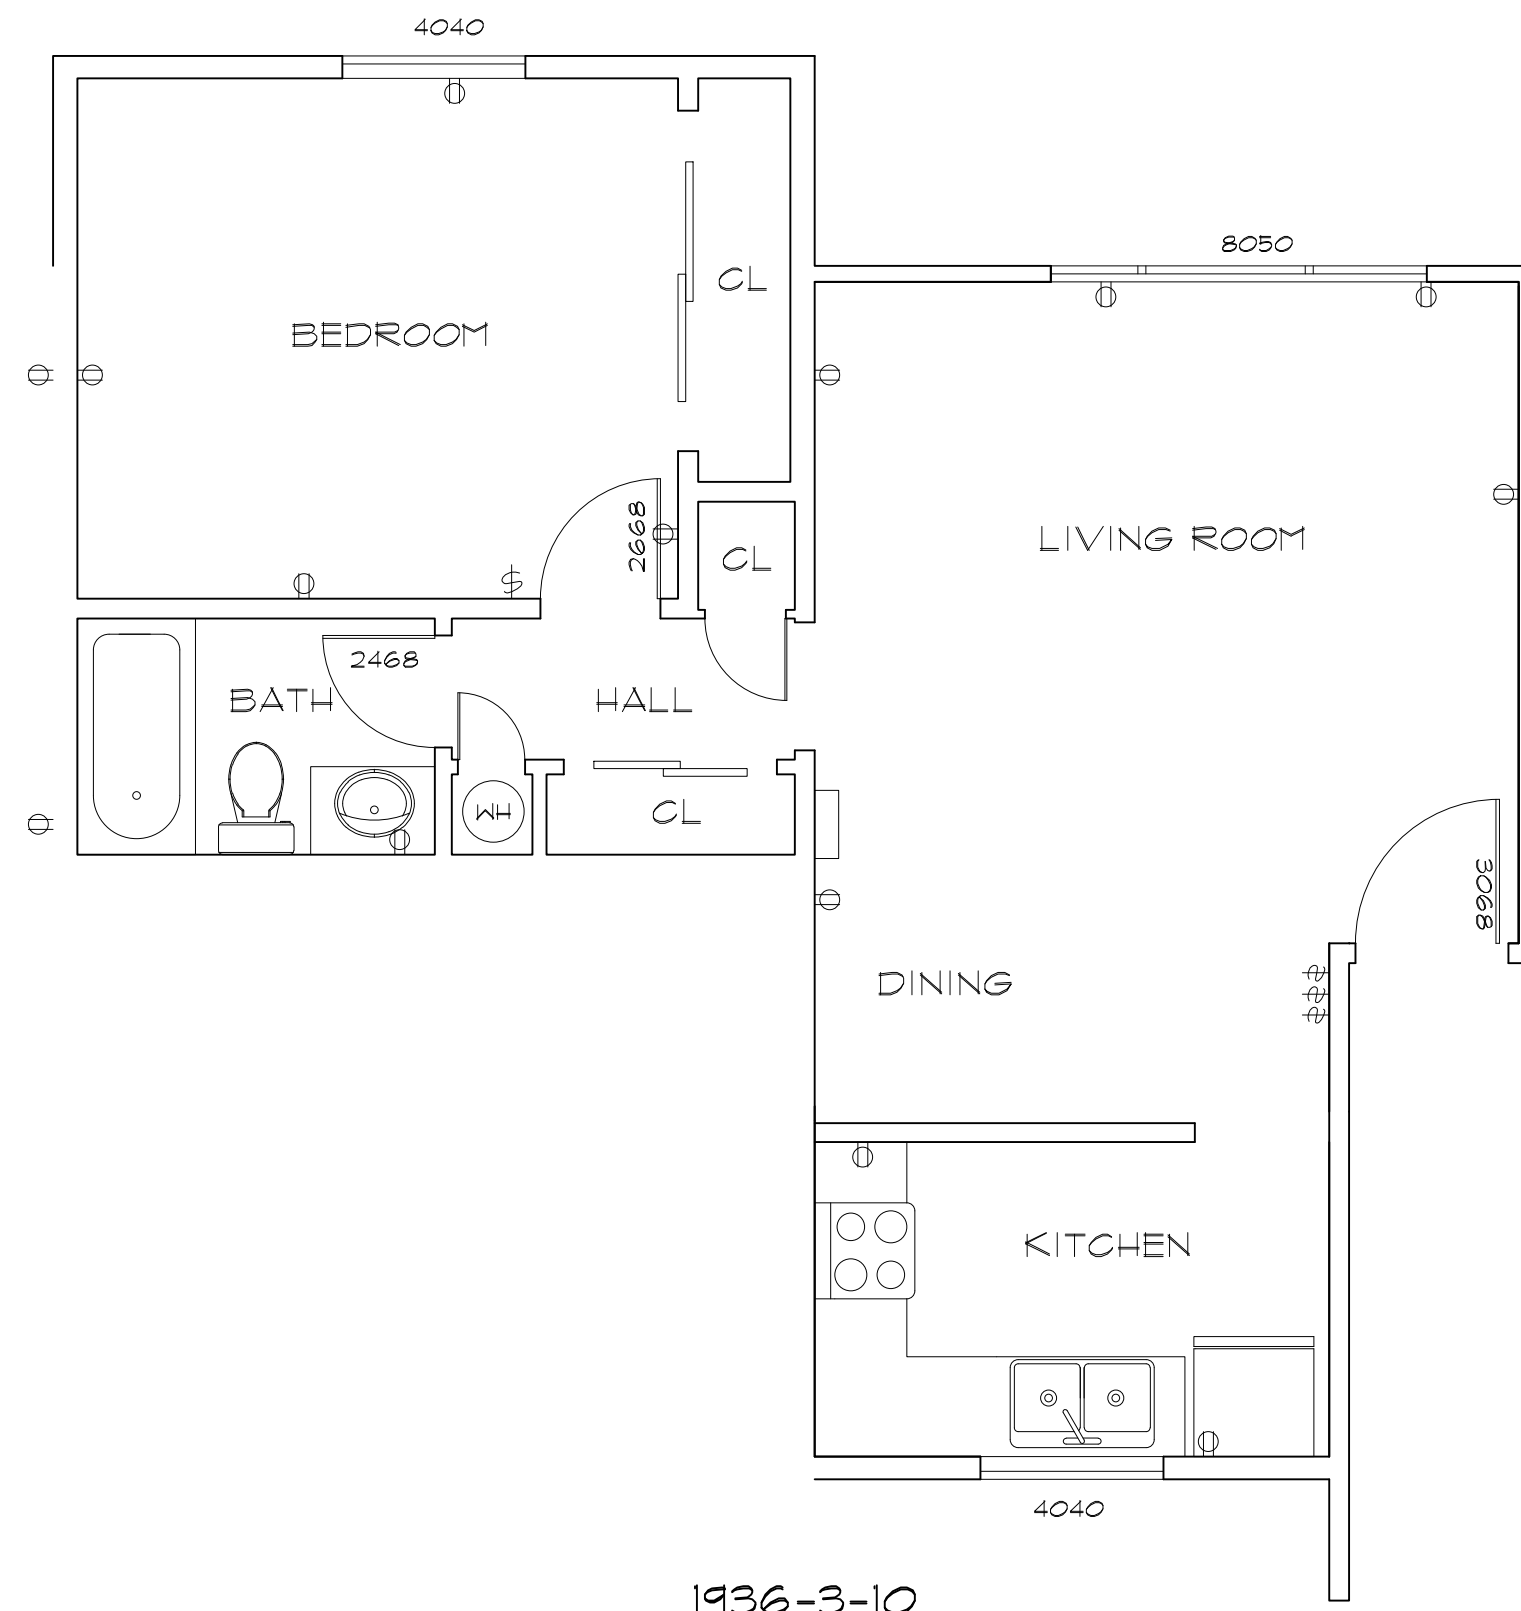

1 BEDROOM LAYOUTS

As BUILT
PROFESSIONALS
www.asbuiltprofessionals.com
A DIVISION OF:

AEC
CONSULTANTS INC
844.272.8458
844 AS BUILT

© 2019 AEC CONSULTANTS INC


ARCHITECTURAL AS BUILT

HOLIDAY MANOR APARTMENTS


Oxnard, CA 94901

01	100% SUBMISSION	SEE COVER SHEET
NO.	ISSUES REVISIONS	DATE
		SHEET TITLE
HL	PROJECT MANAGER	
HL	PROJECT DIRECTOR	
012317-1	PROJECT NUMBER	
1/4"=1'-0"		SCALE
CL	DRAWN BY	
		SHEET NUMBER


UL-1

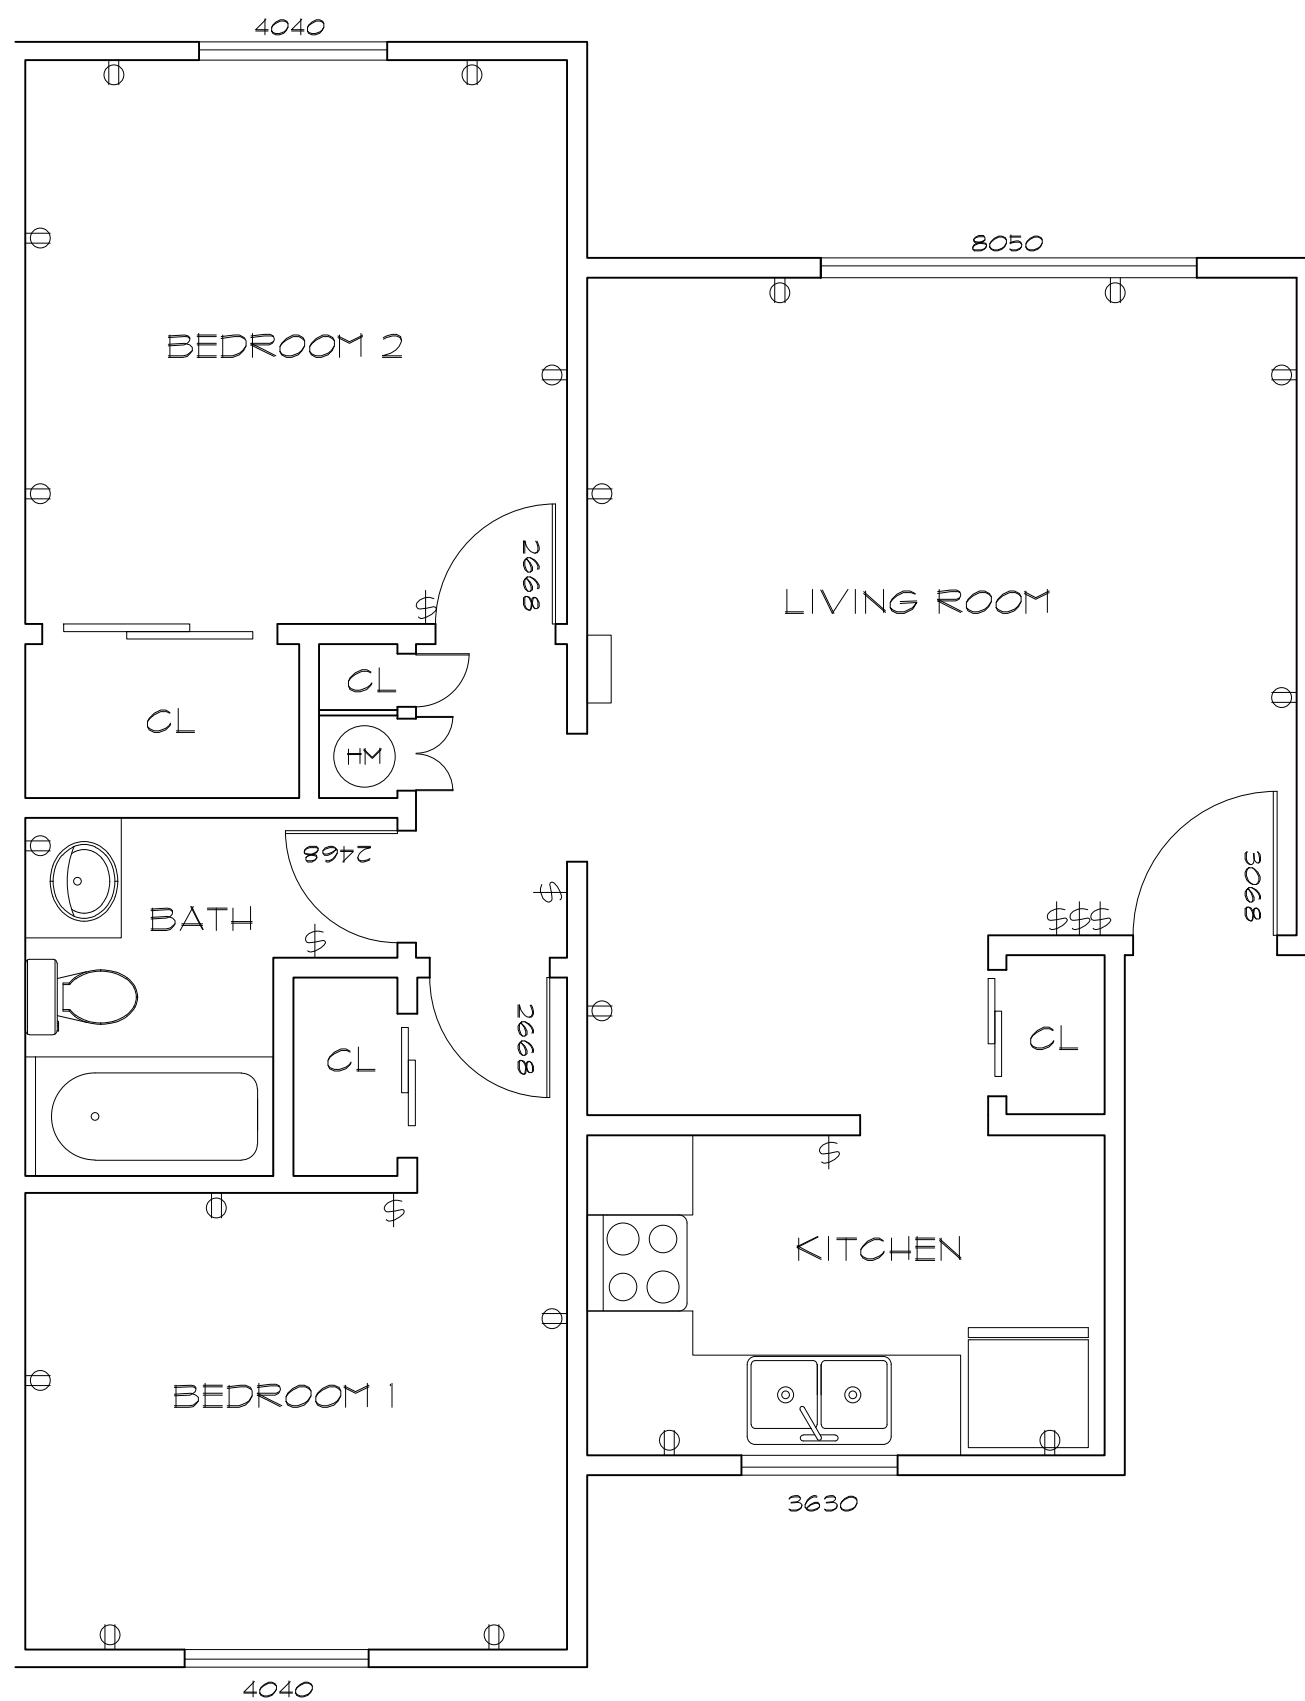


1966-8-3c

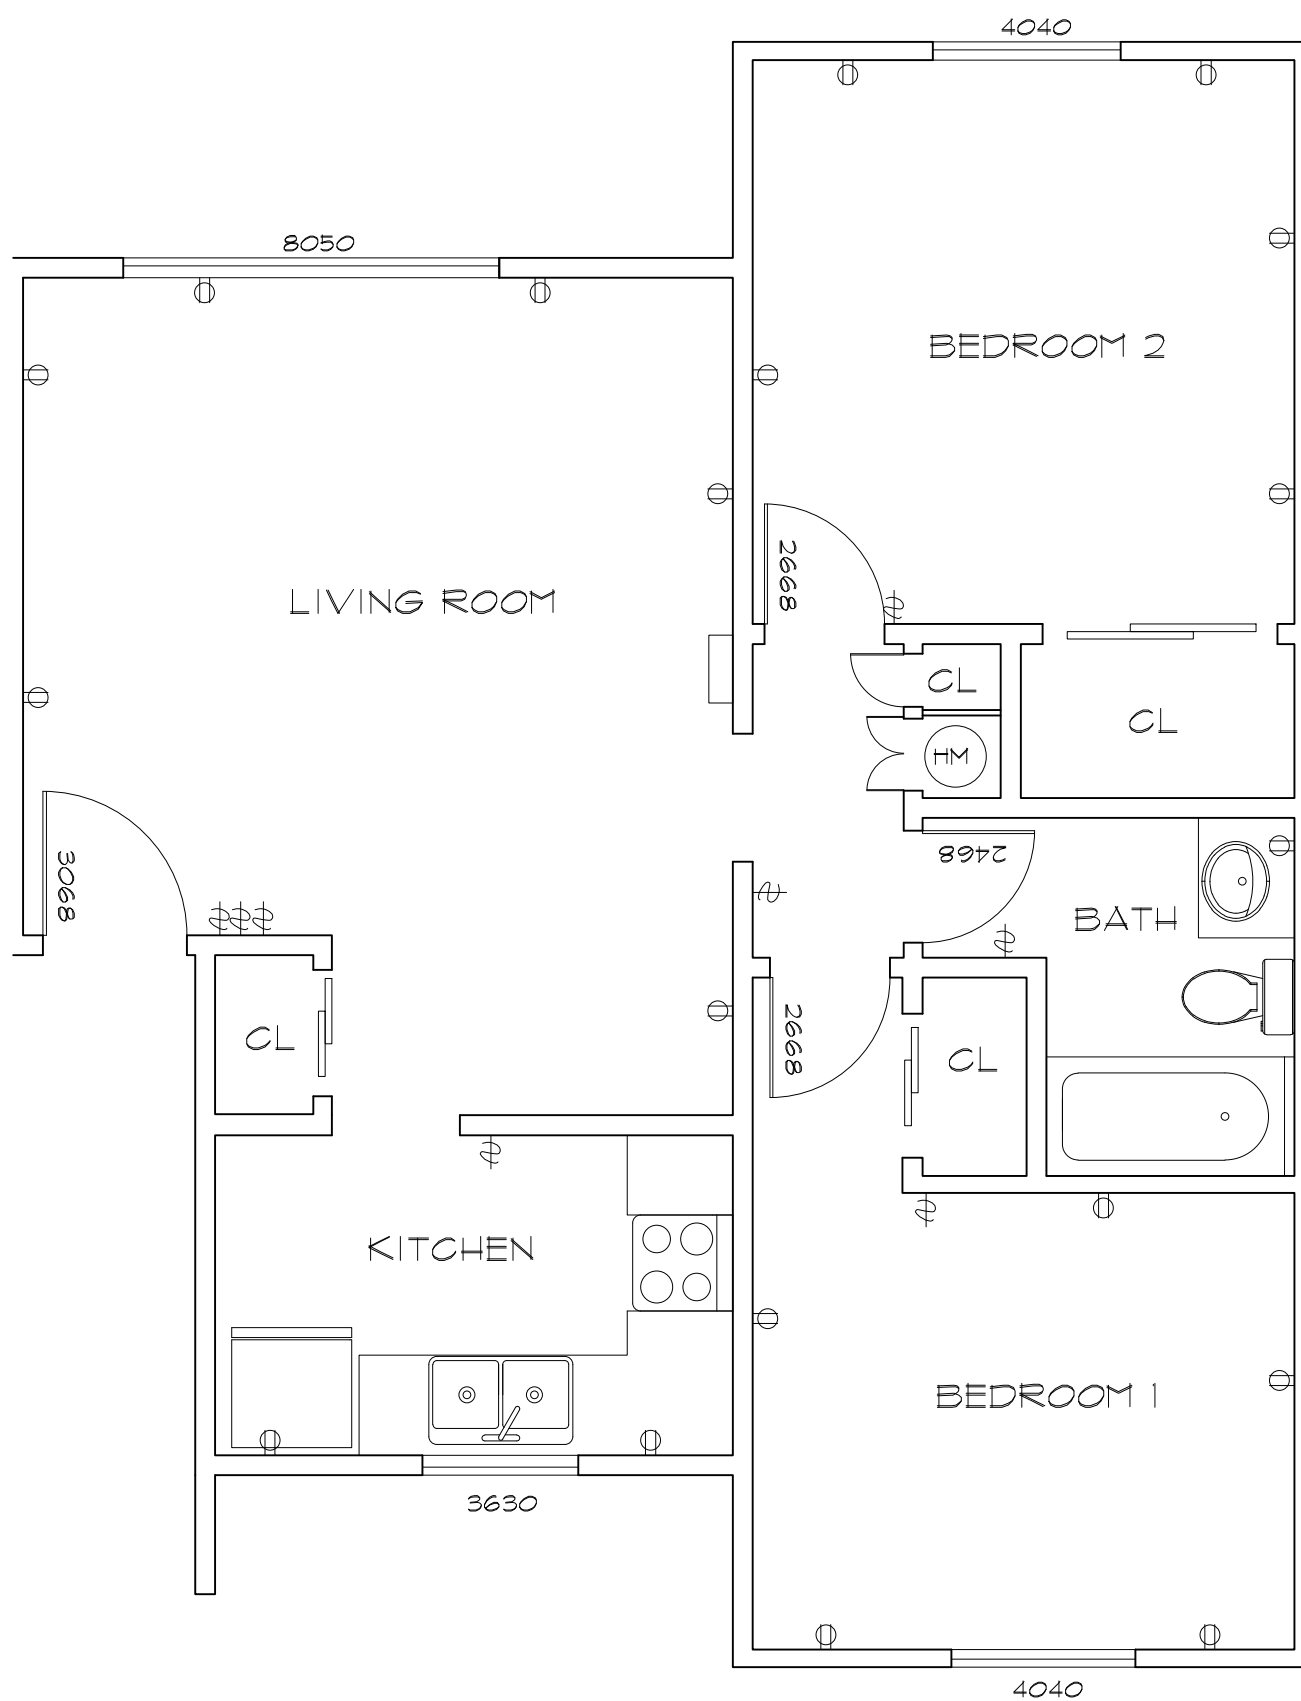

1966-8-3d

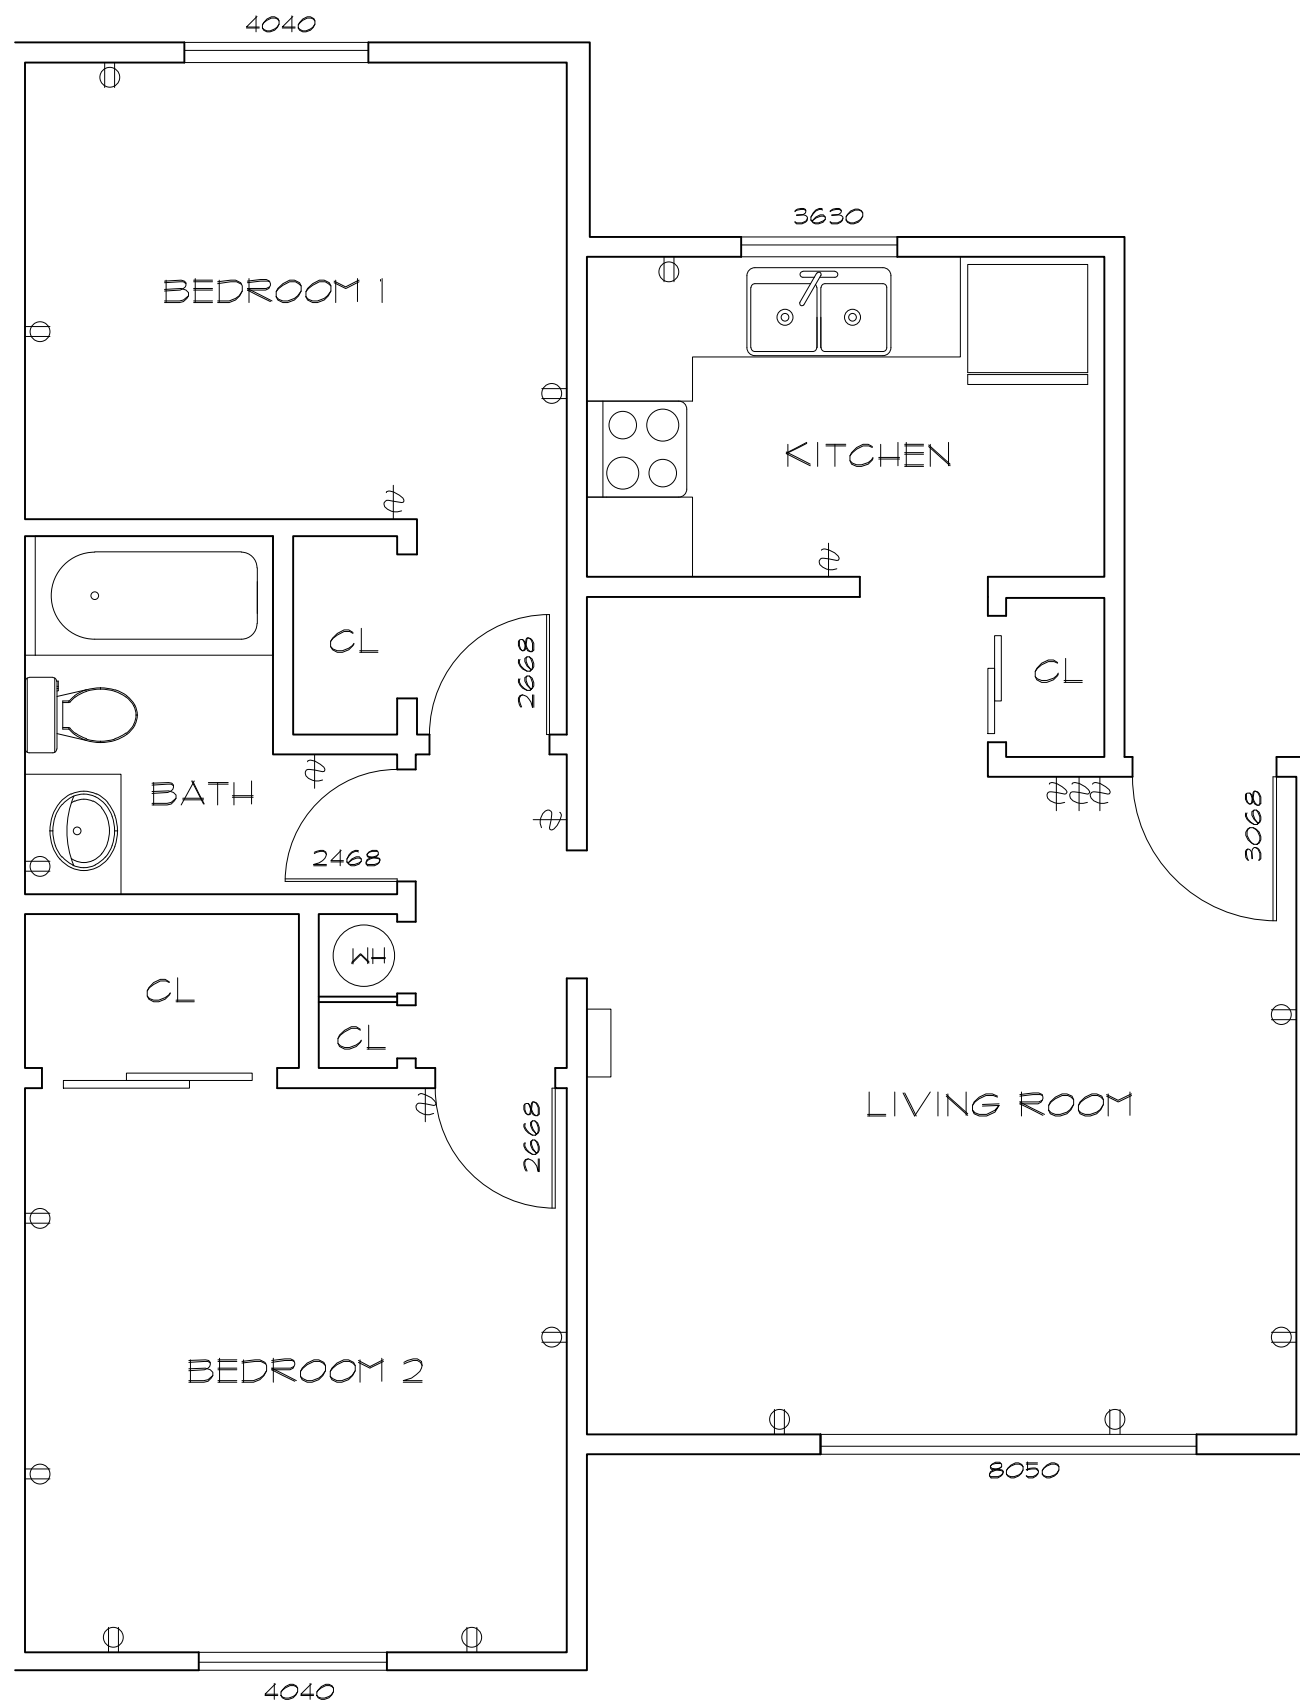

1966-8-3b

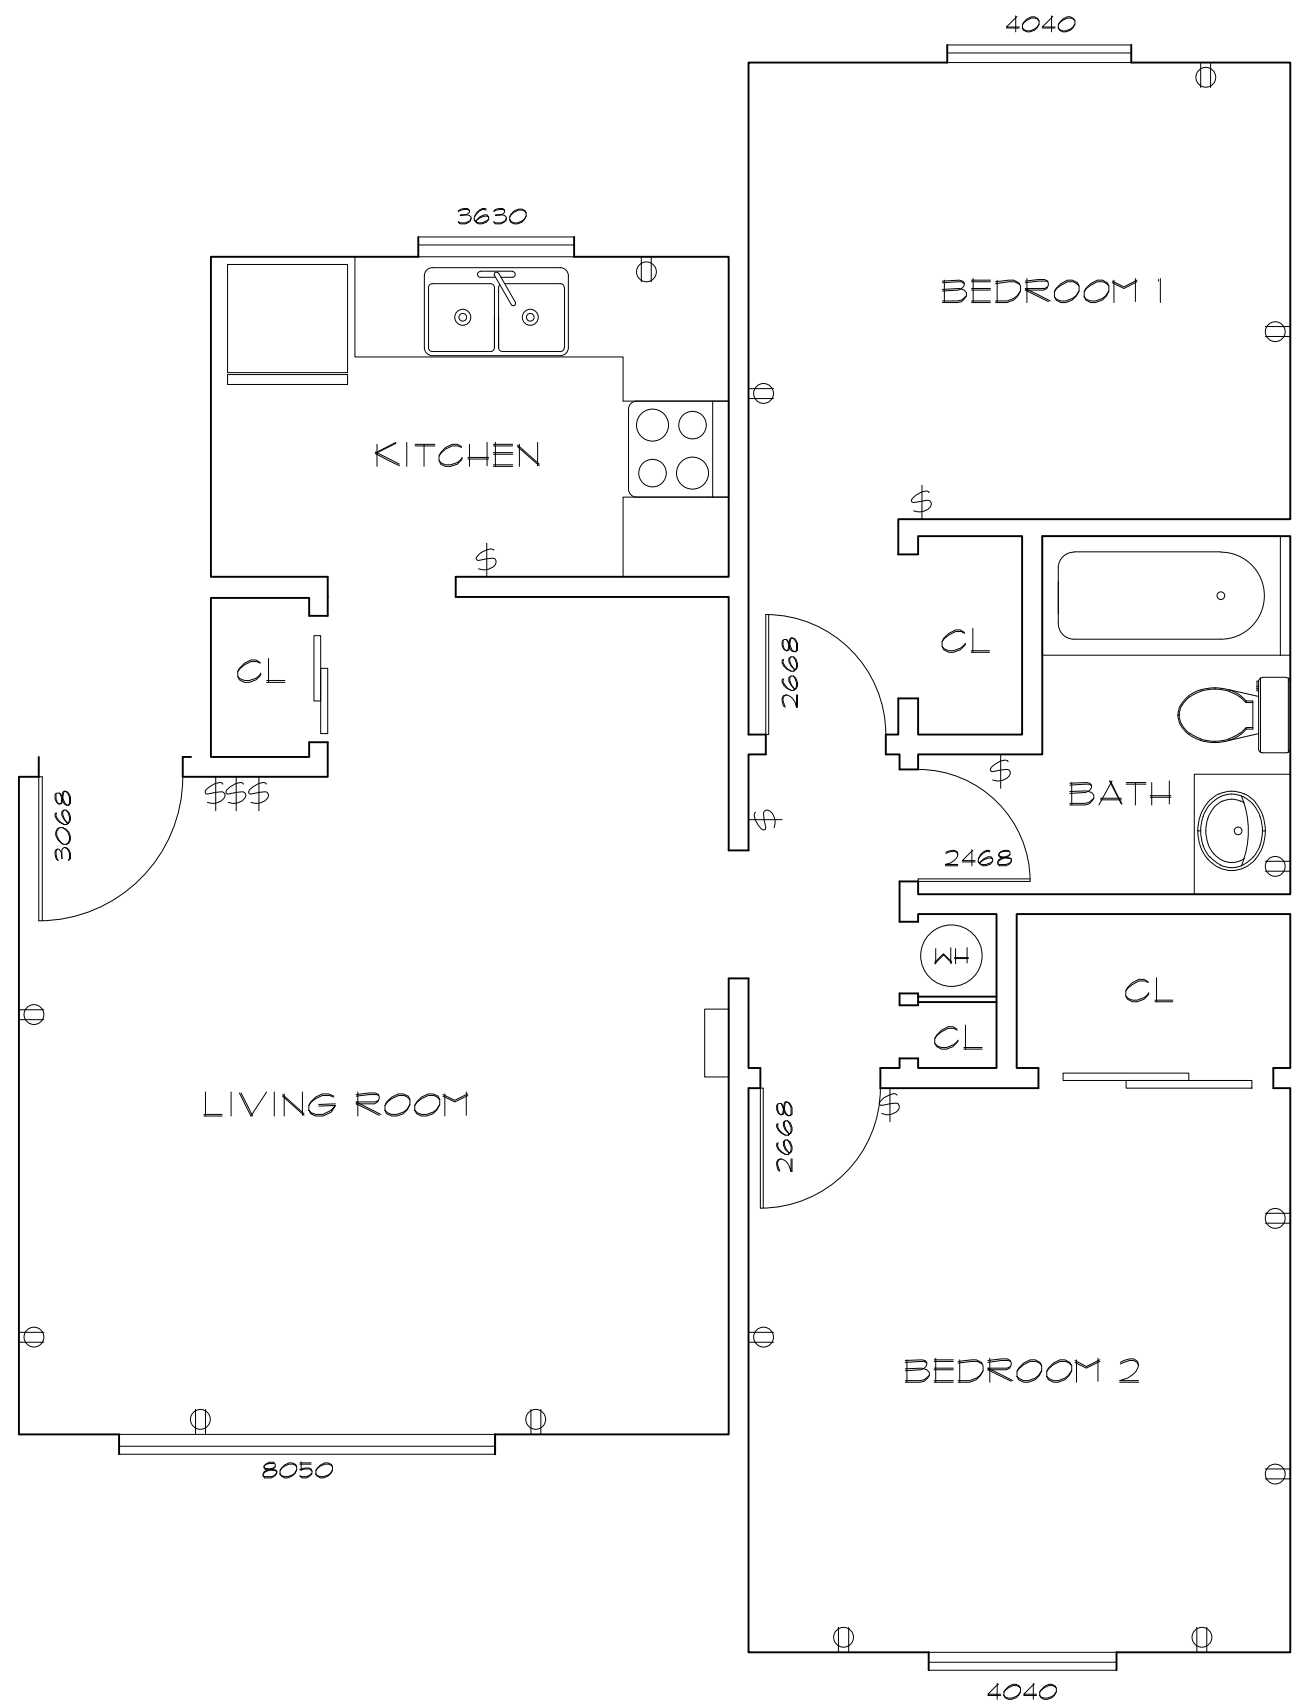

1966-8-3

2 BEDROOM LAYOUTS

As BUILT

PROFESSIONALS

www.asbuiltprofessionals.com

A DIVISION OF:

AEC

CONSULTANTS INC

844.272.8458

844 AS BUILT

© 2019 AEC CONSULTANTS INC





ARCHITECTURAL AS BUILT

HOLIDAY MANOR APARTMENTS


Oxnard, CA 94901

01	100% SUBMISSION	SEE COVER SHEET
NO.	ISSUES REVISIONS	DATE
		SHEET TITLE
HL	PROJECT MANAGER	
HL	PROJECT DIRECTOR	
012317-1	PROJECT NUMBER	
1/4"=1'-0"	SCALE	
CL	DRAWN BY	
		SHEET NUMBER


UL-2

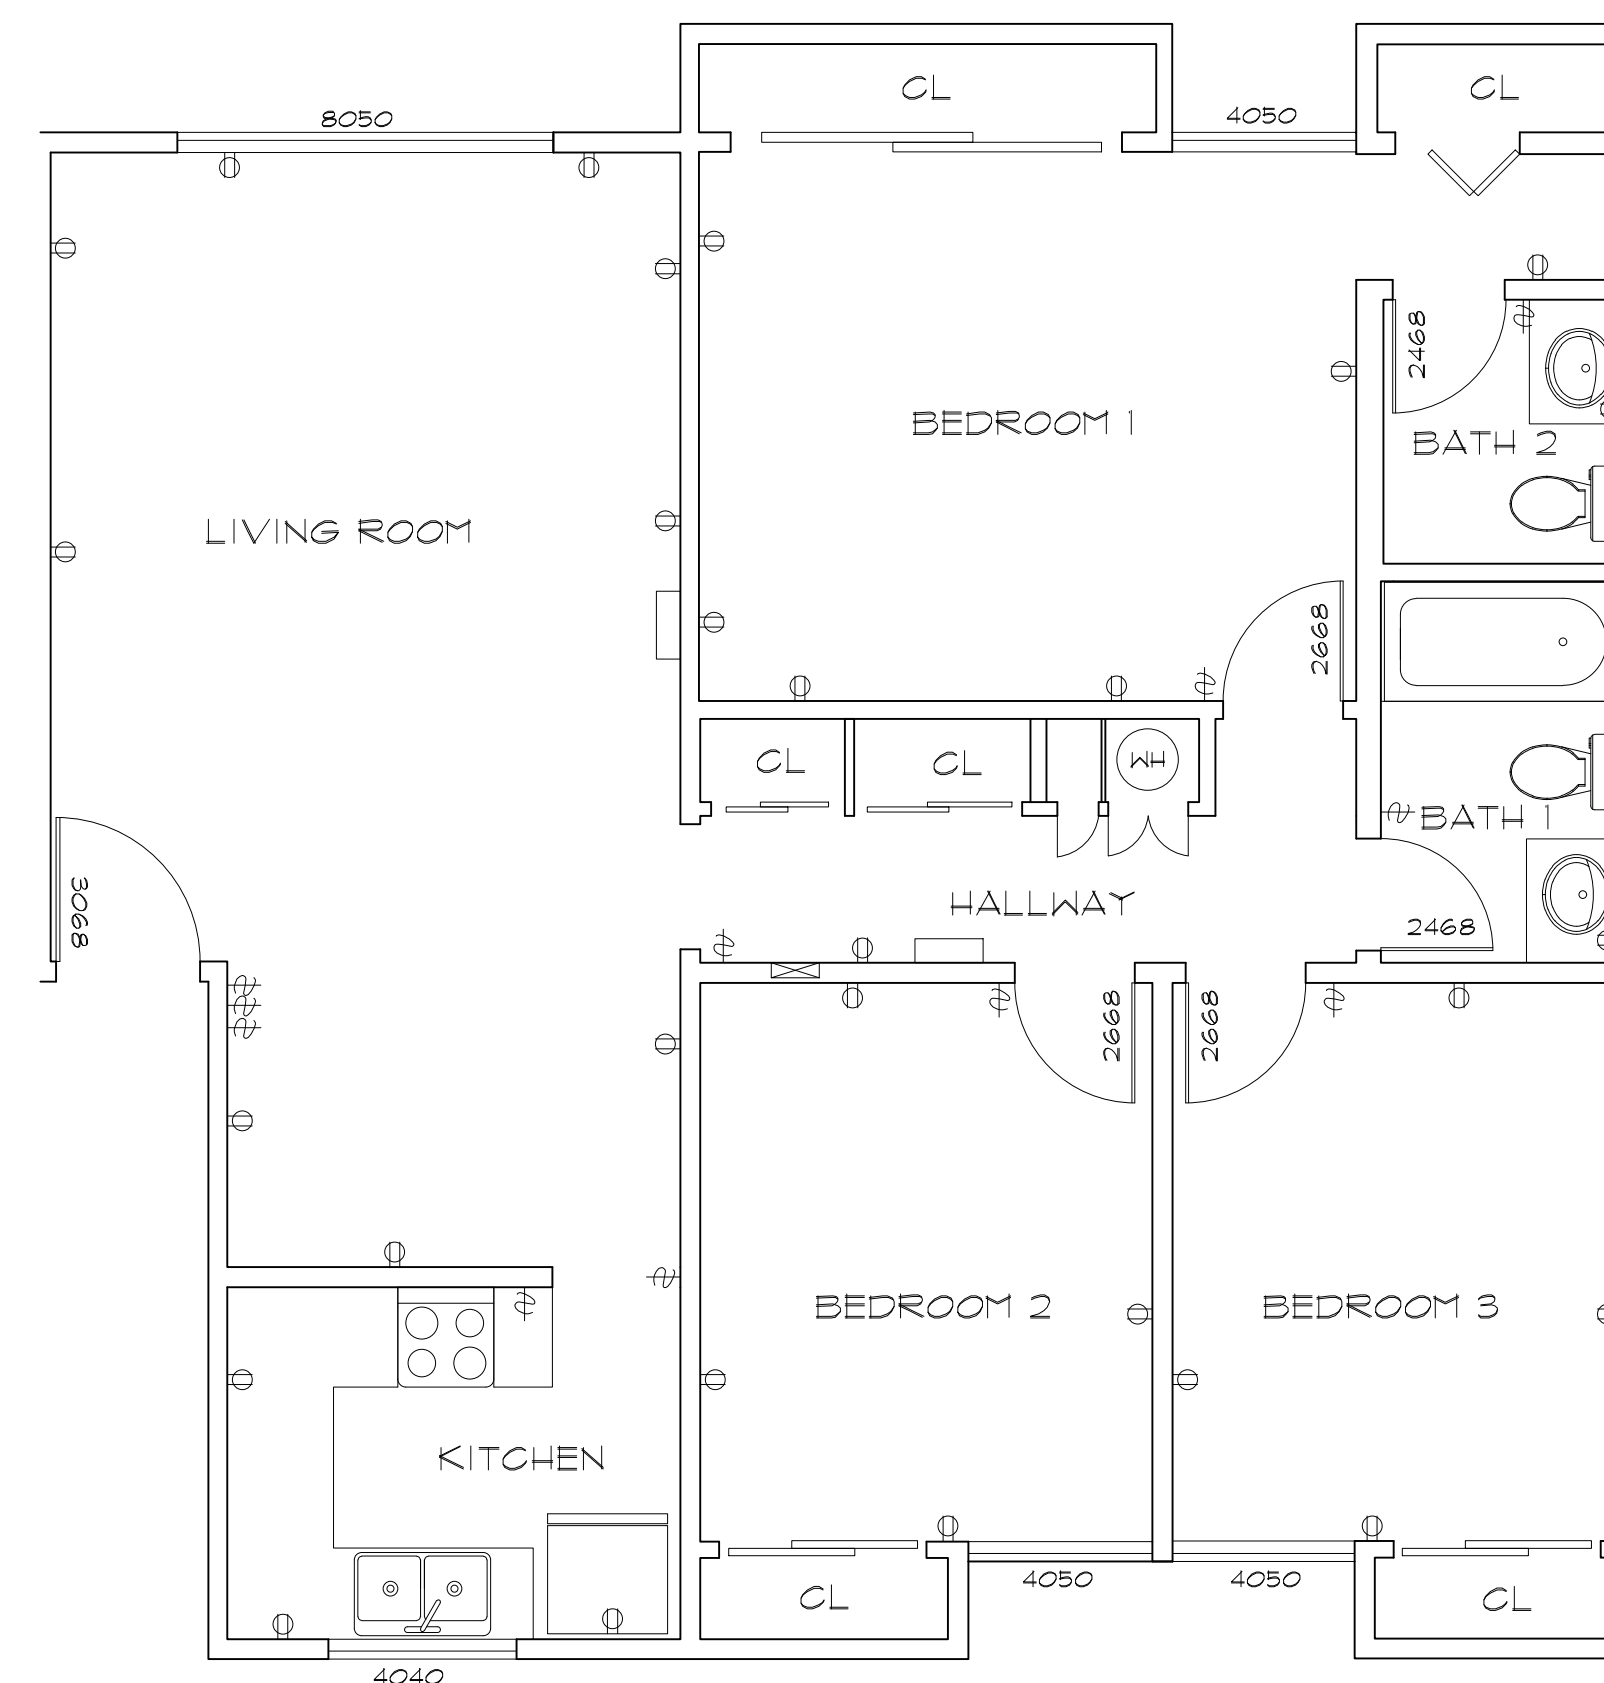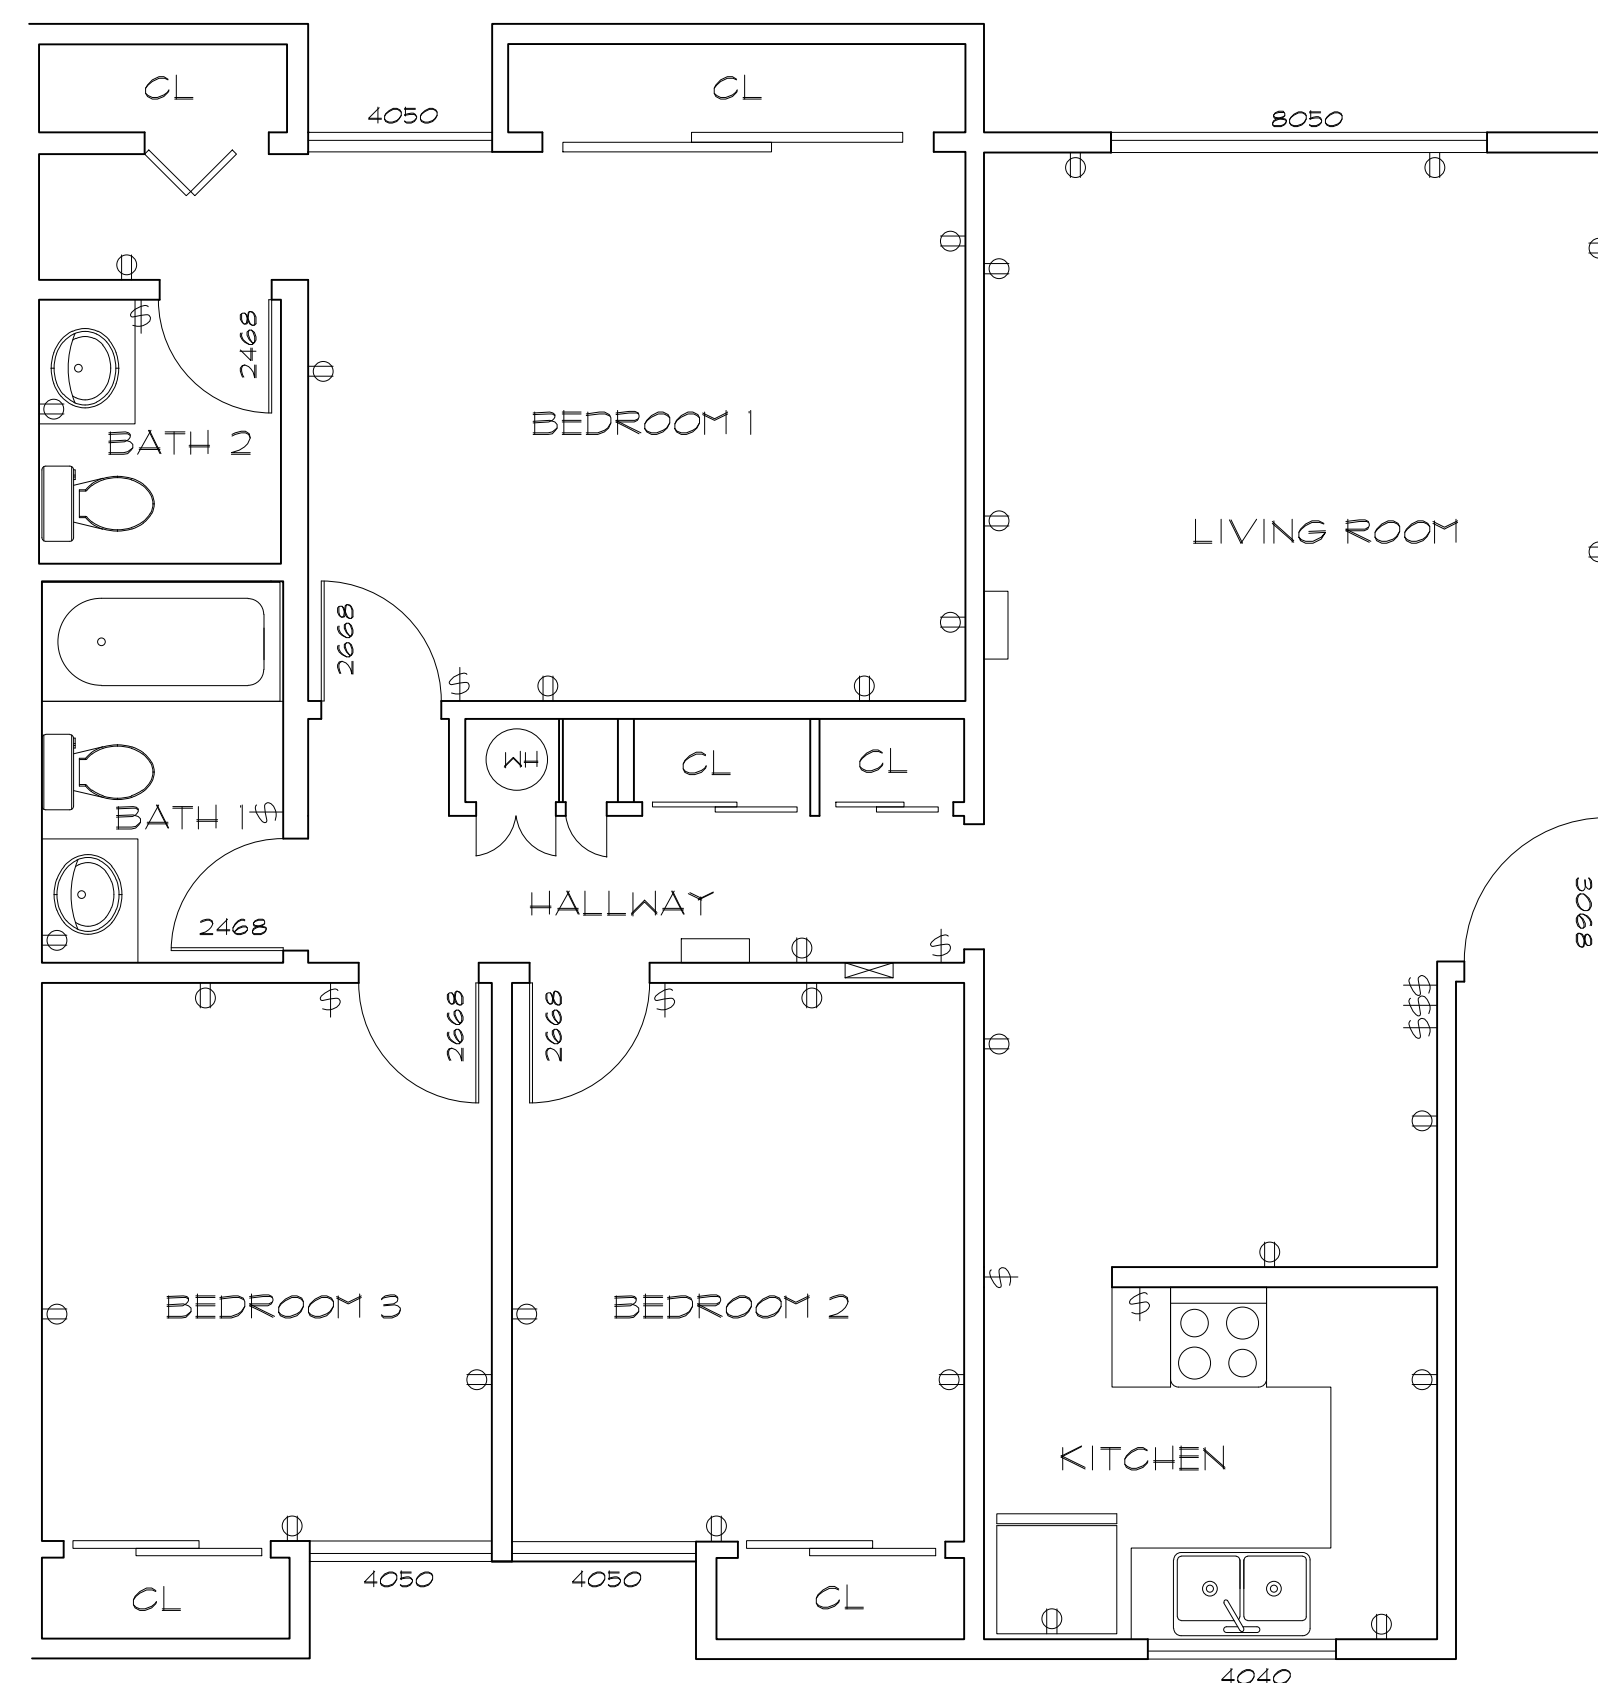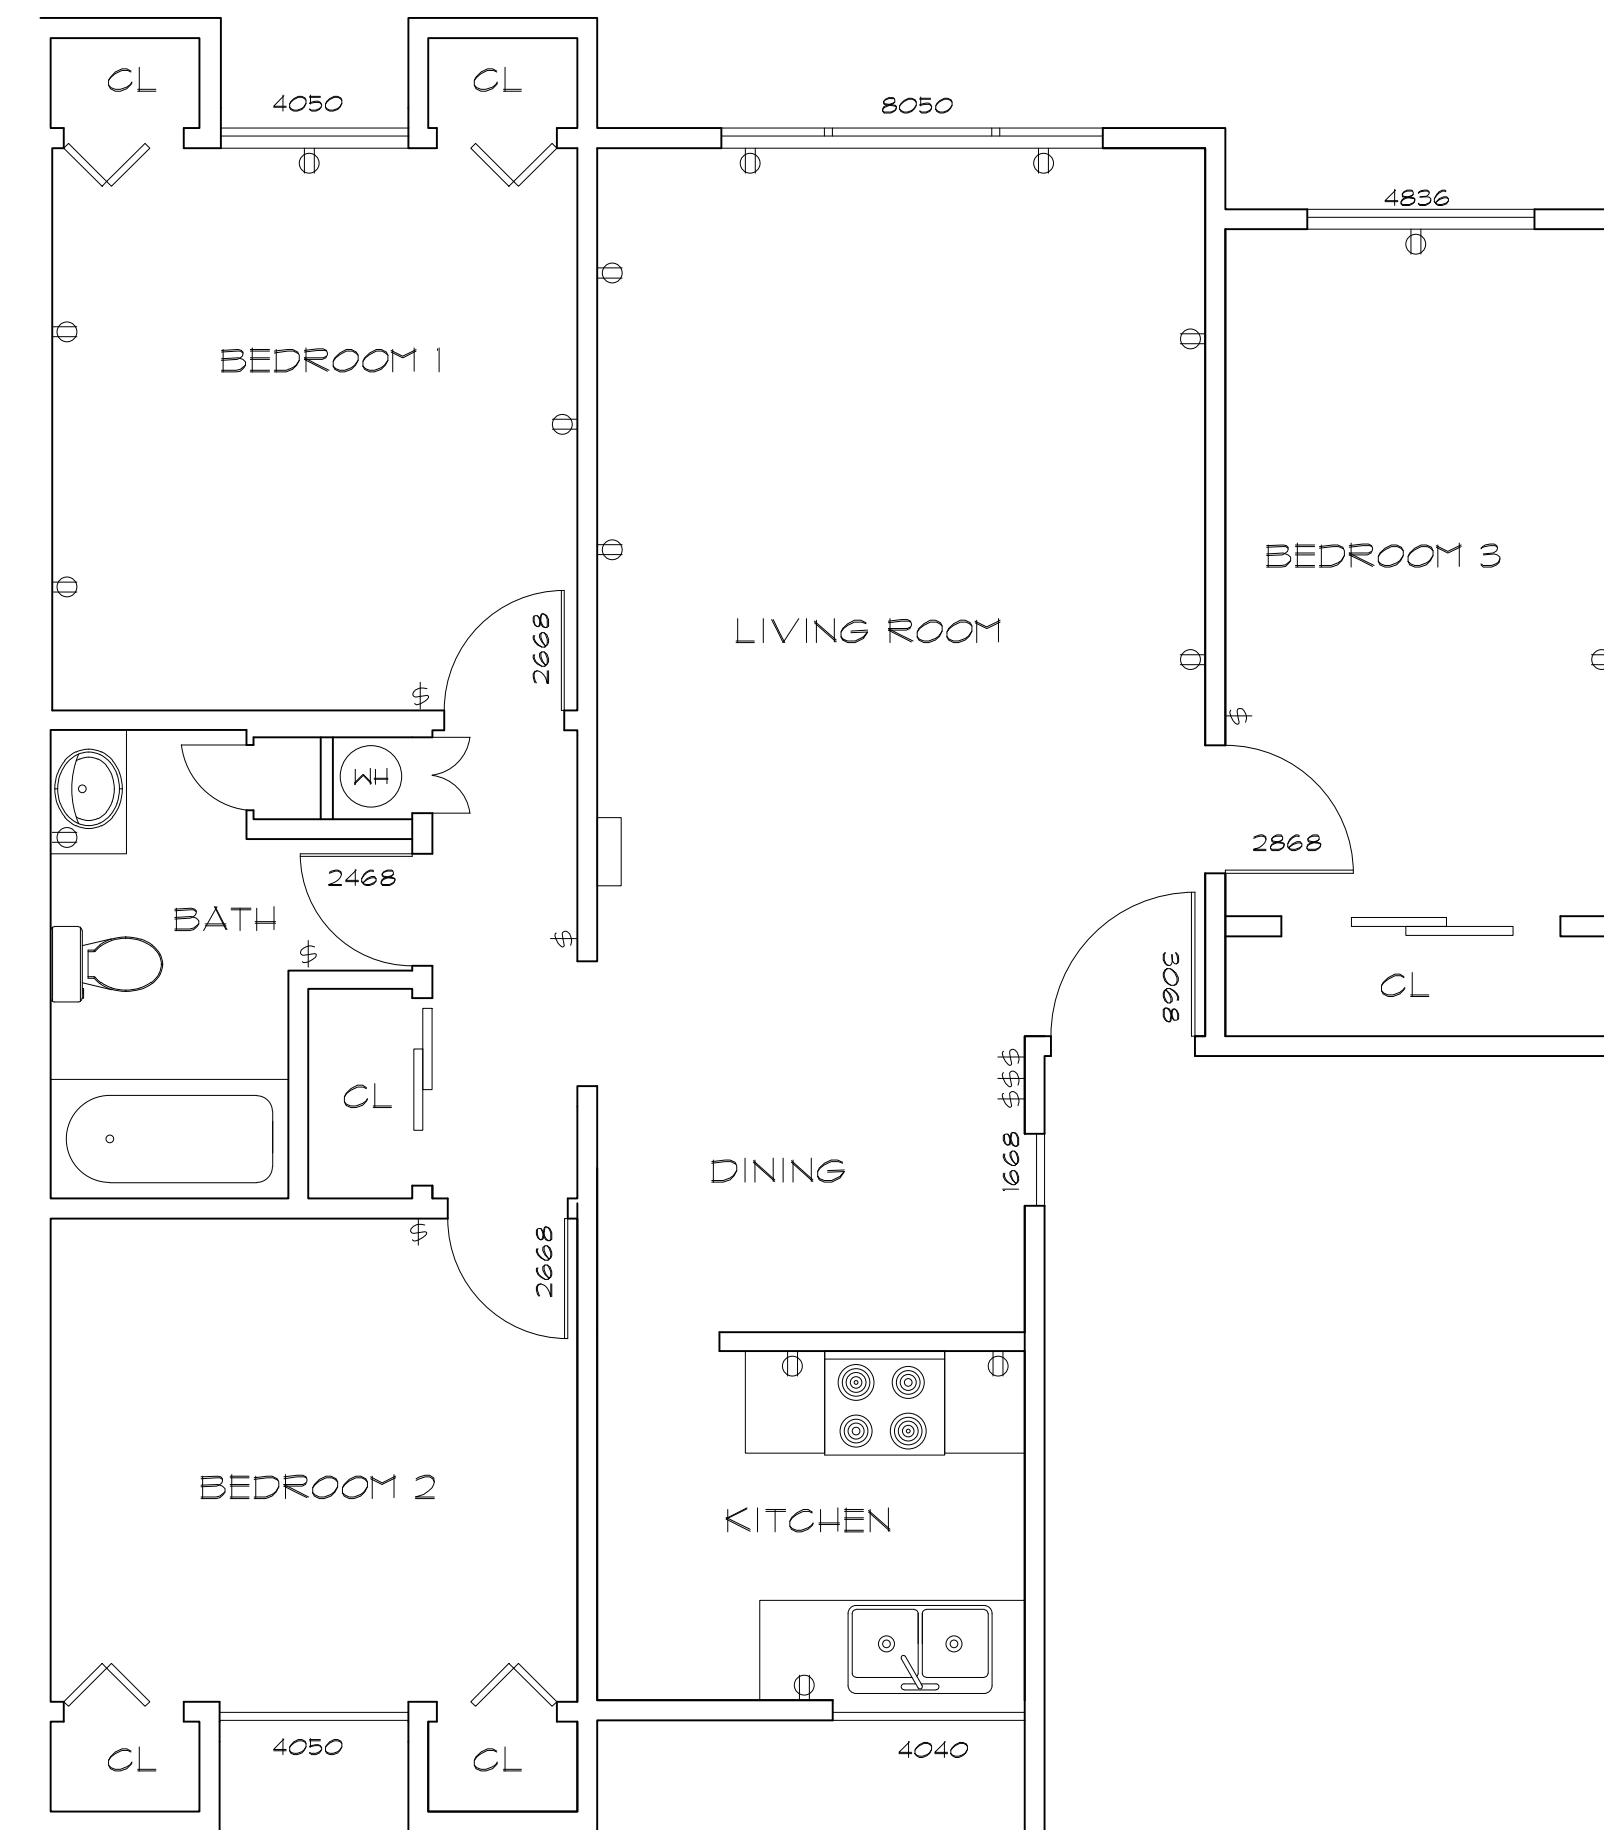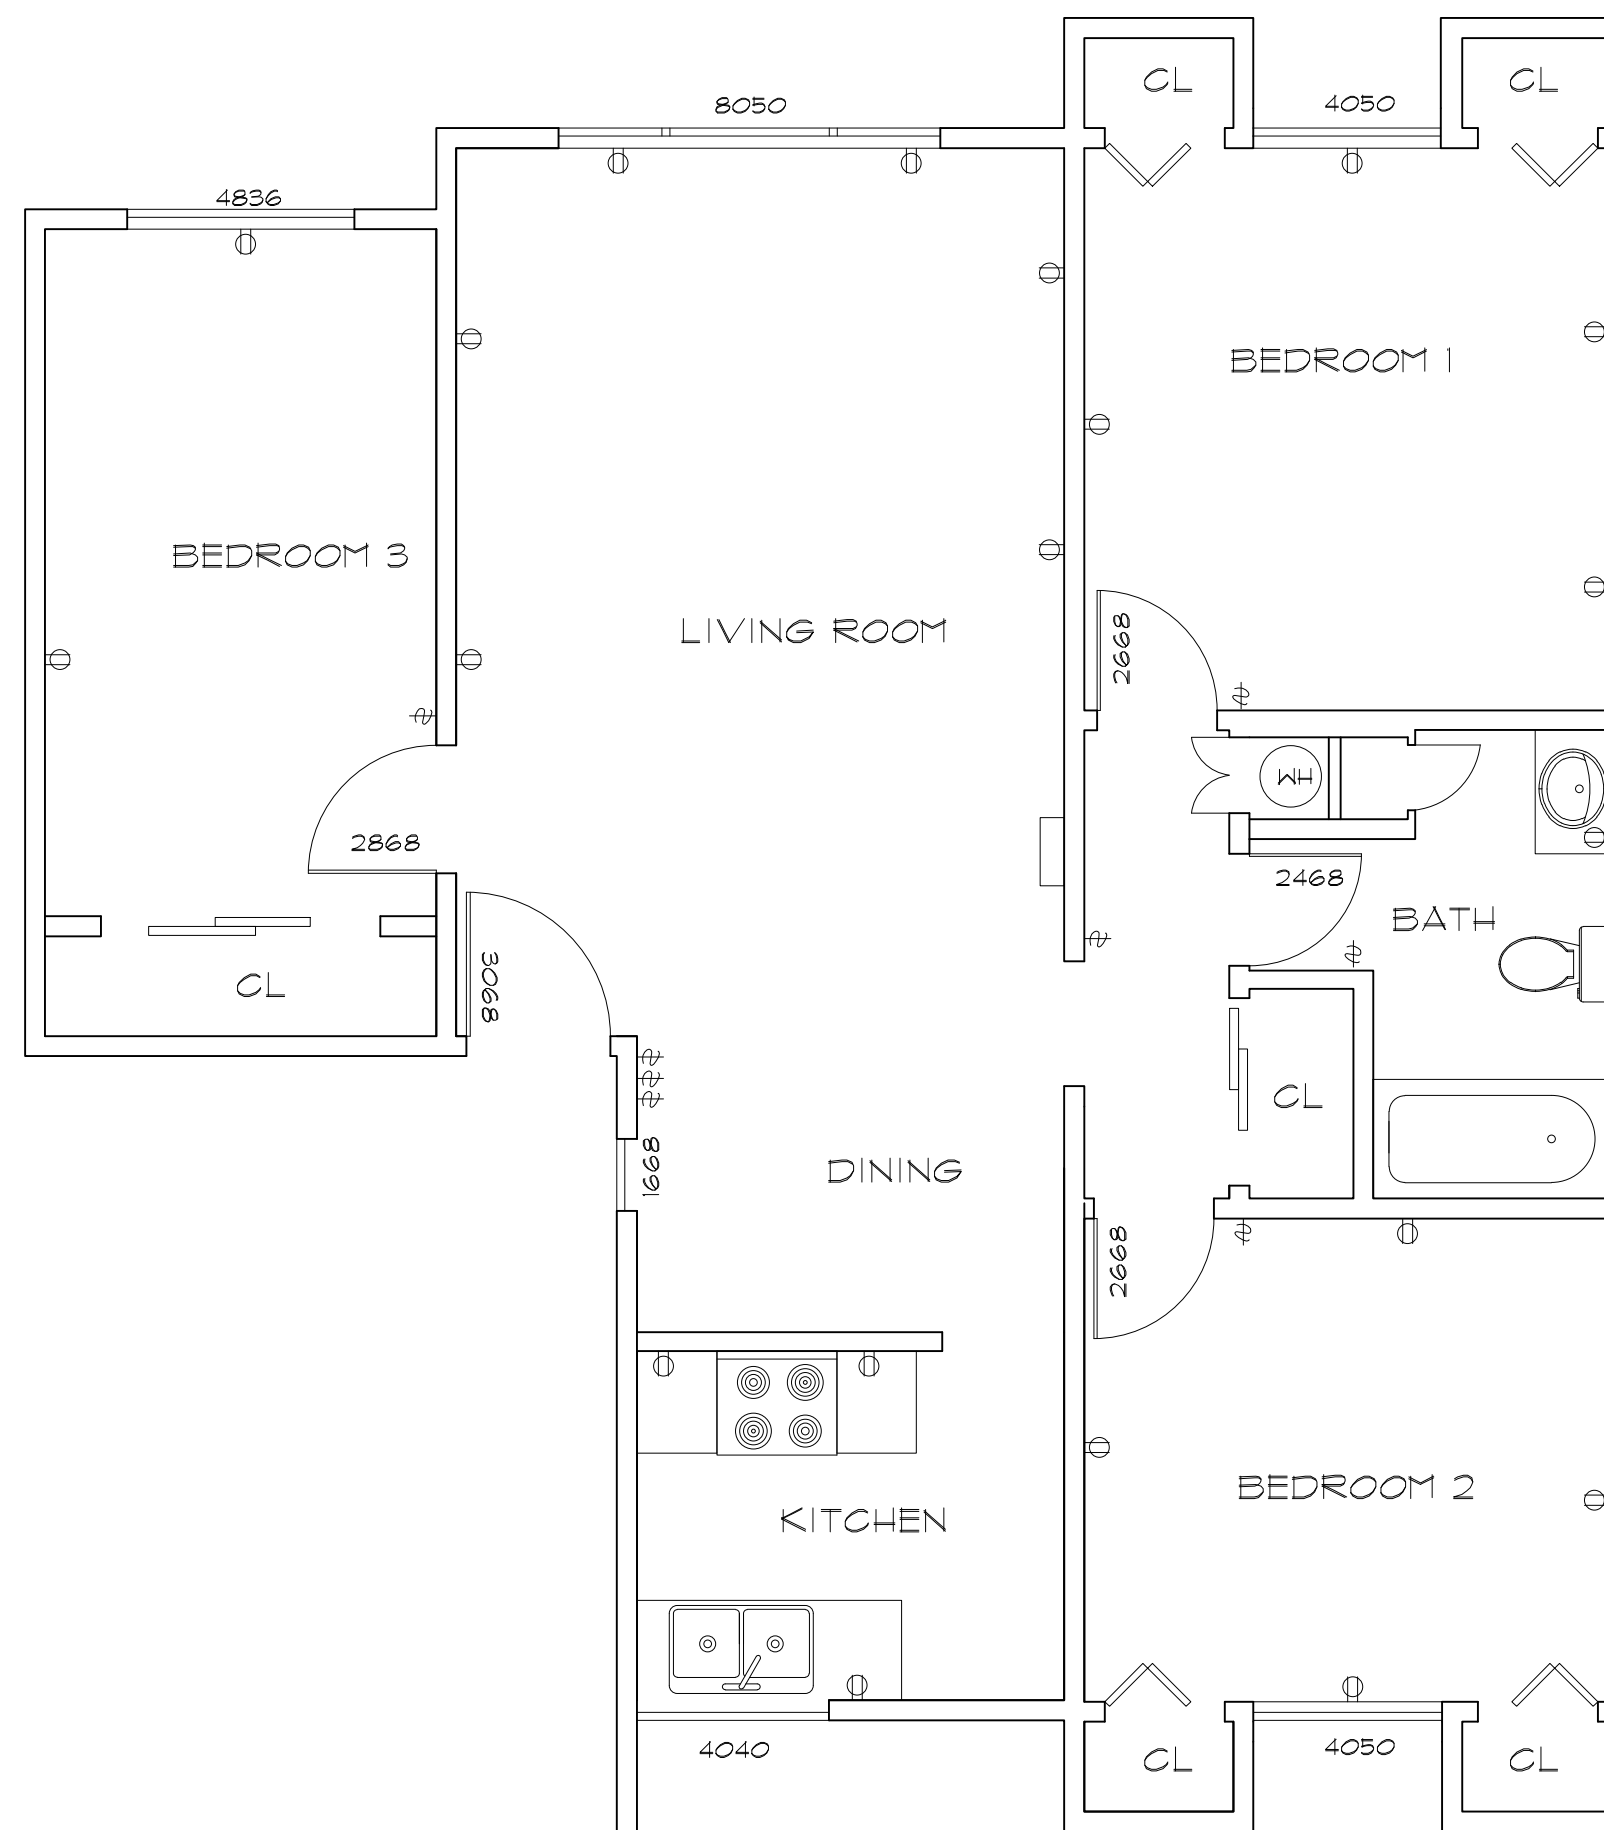


O1	100% SUBMISSION	SEE COVER SHEET
NO.	ISSUES REVISIONS	DATE
		SHEET TITLE
HL		PROJECT MANAGER
HL		PROJECT DIRECTOR
012317-1		PROJECT NUMBER
1/4"=1'-0"		SCALE
CL		DRAWN BY
		SHEET NUMBER

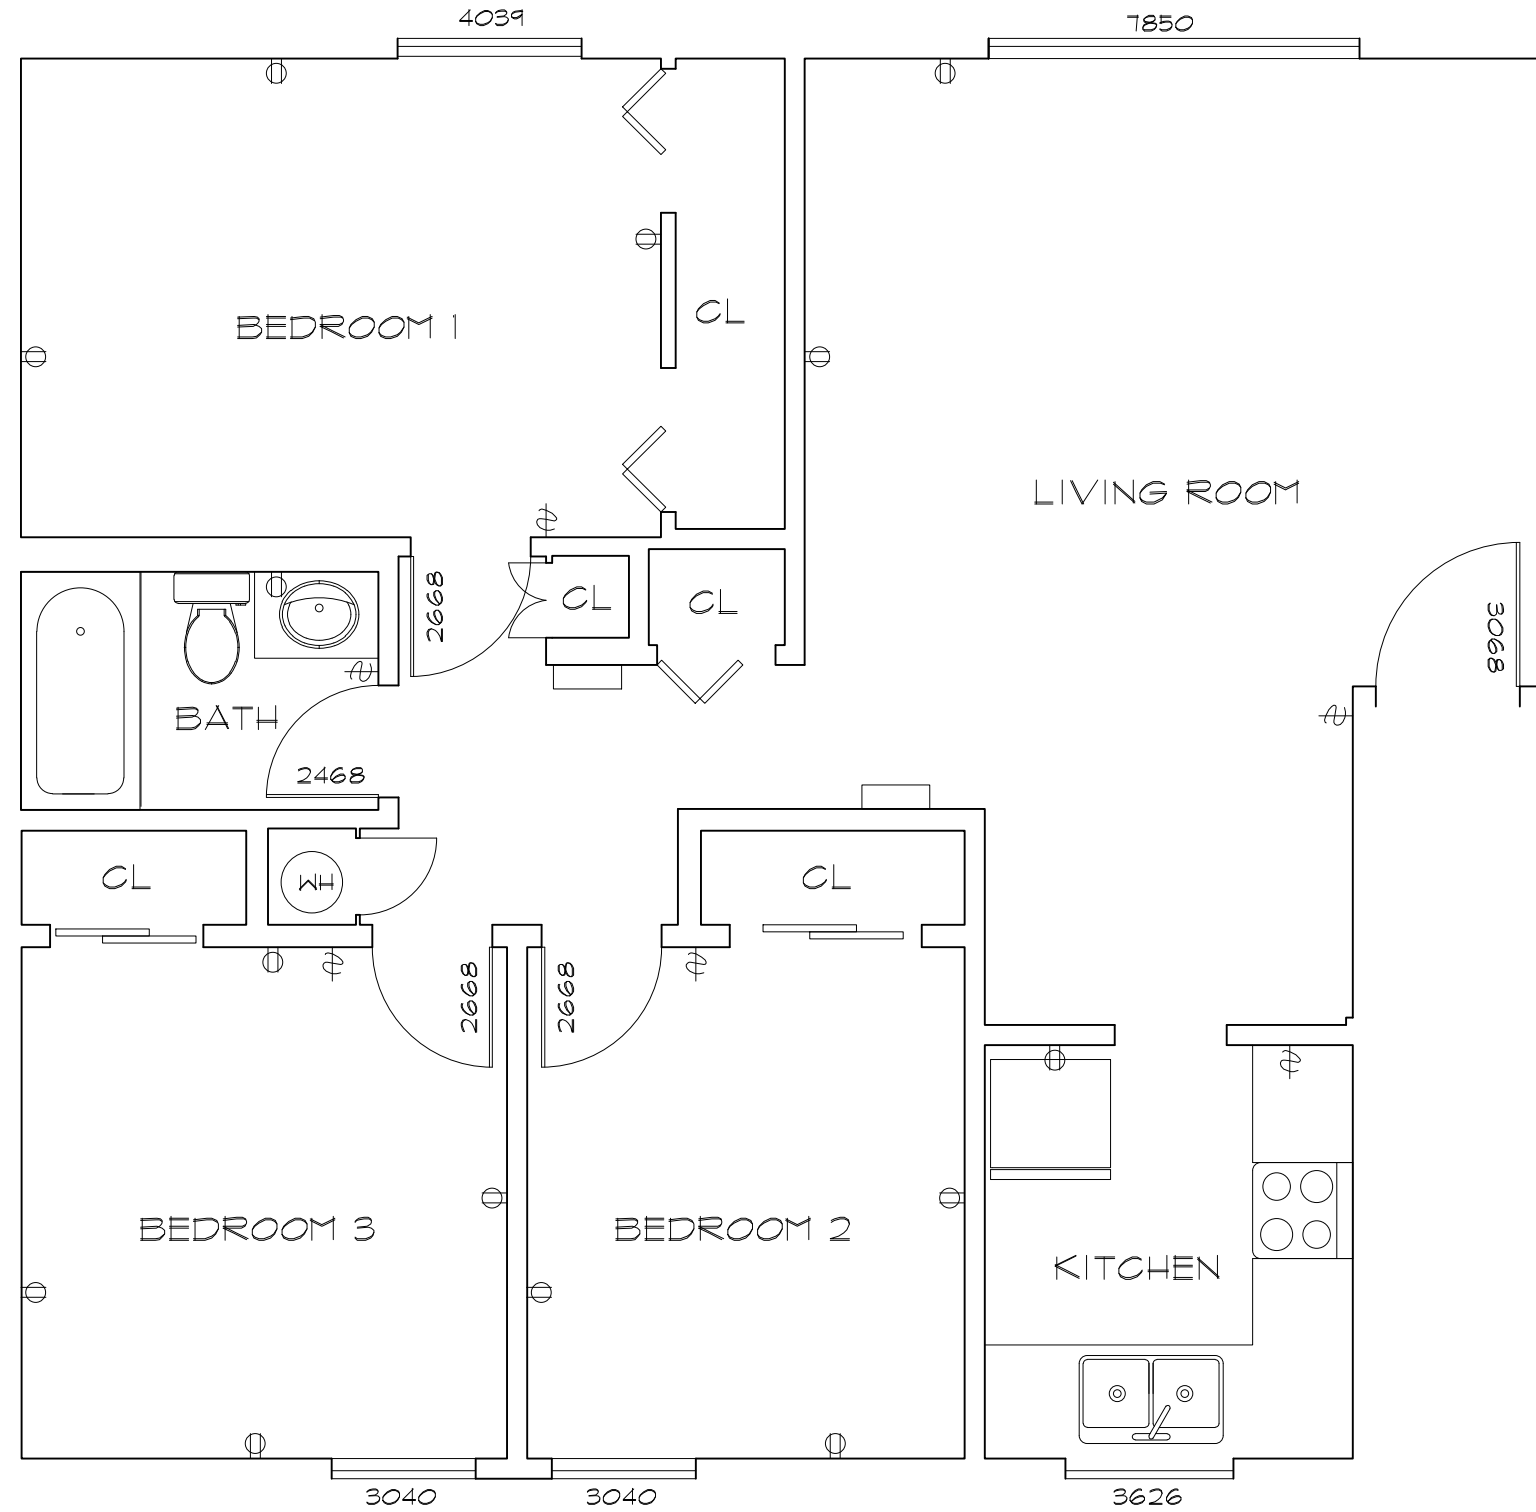


1960-1-1b

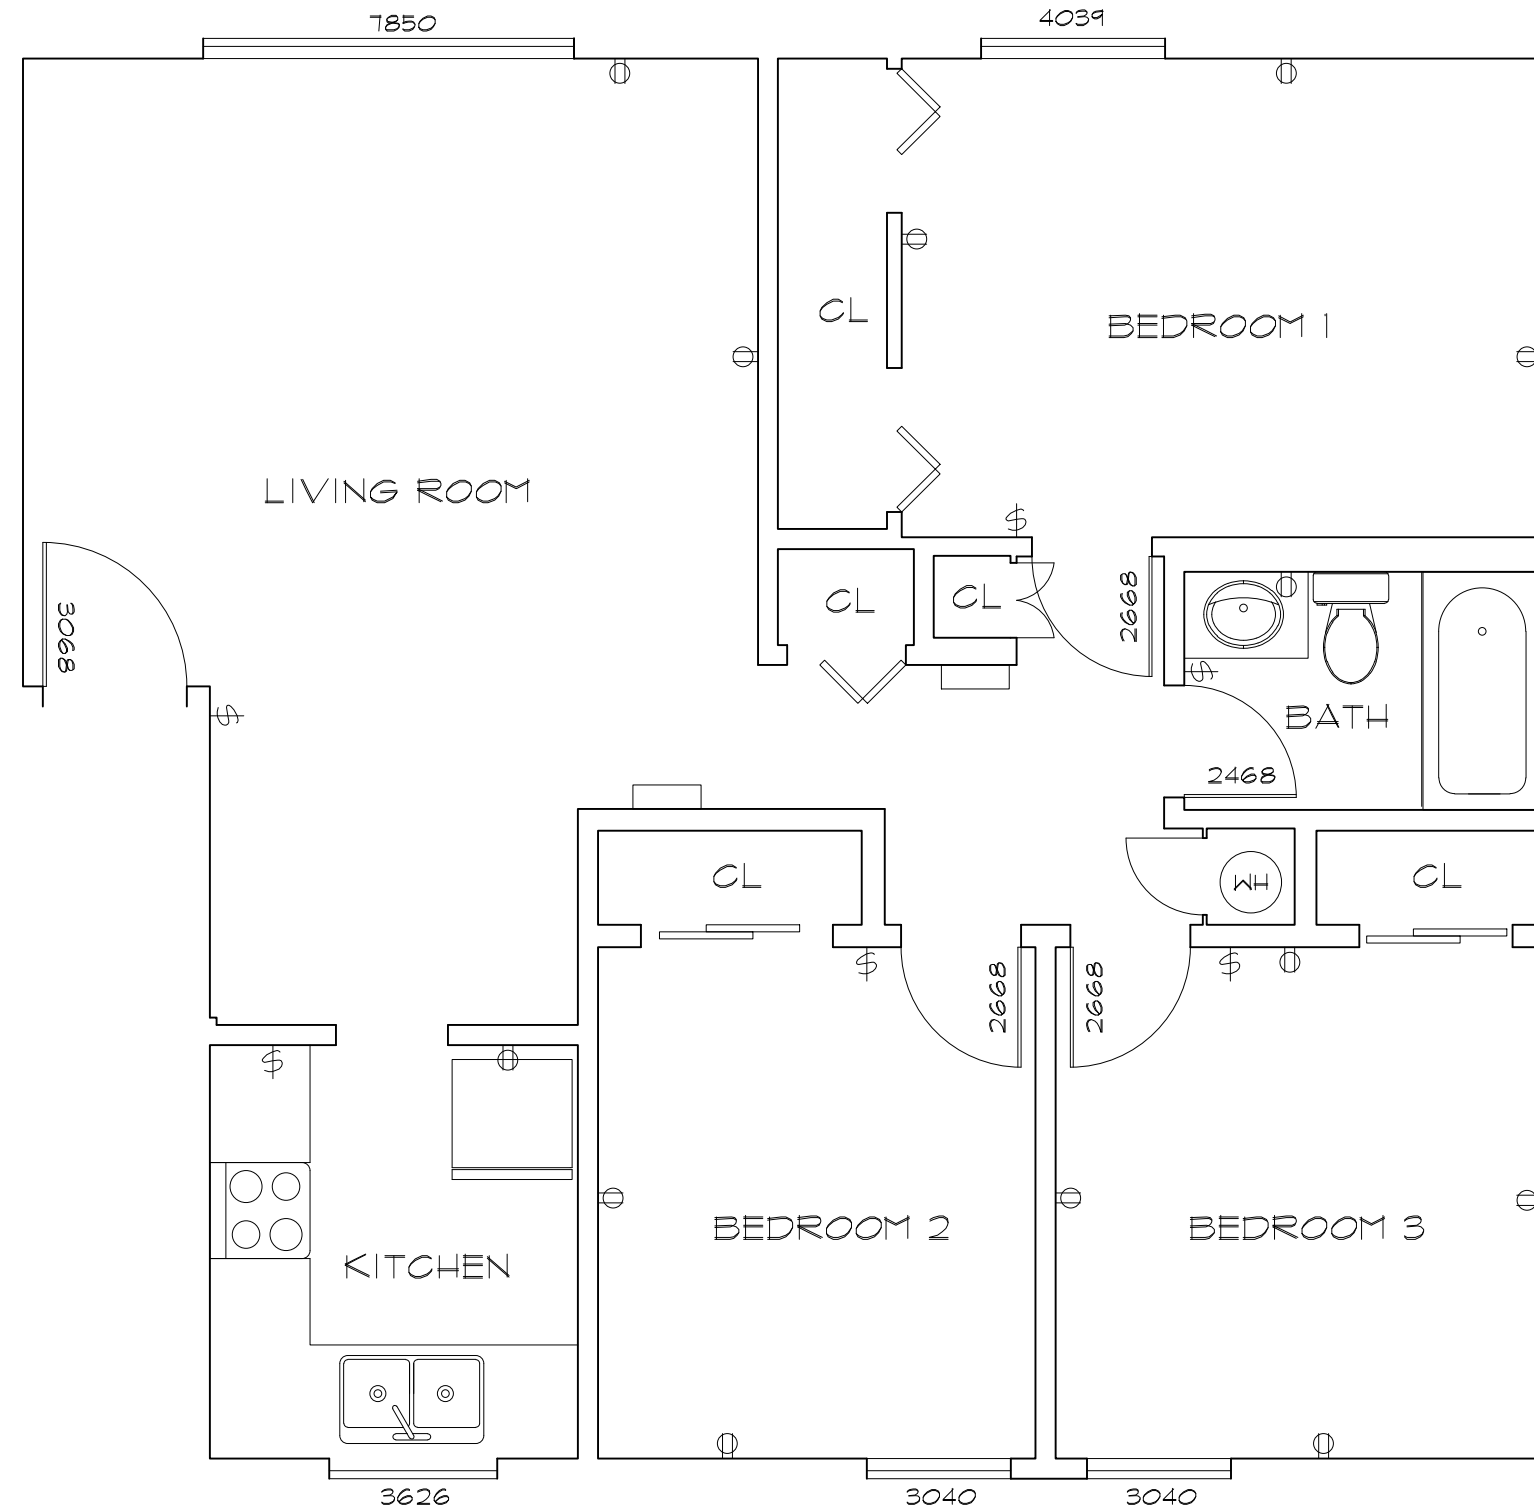

1960-8-1

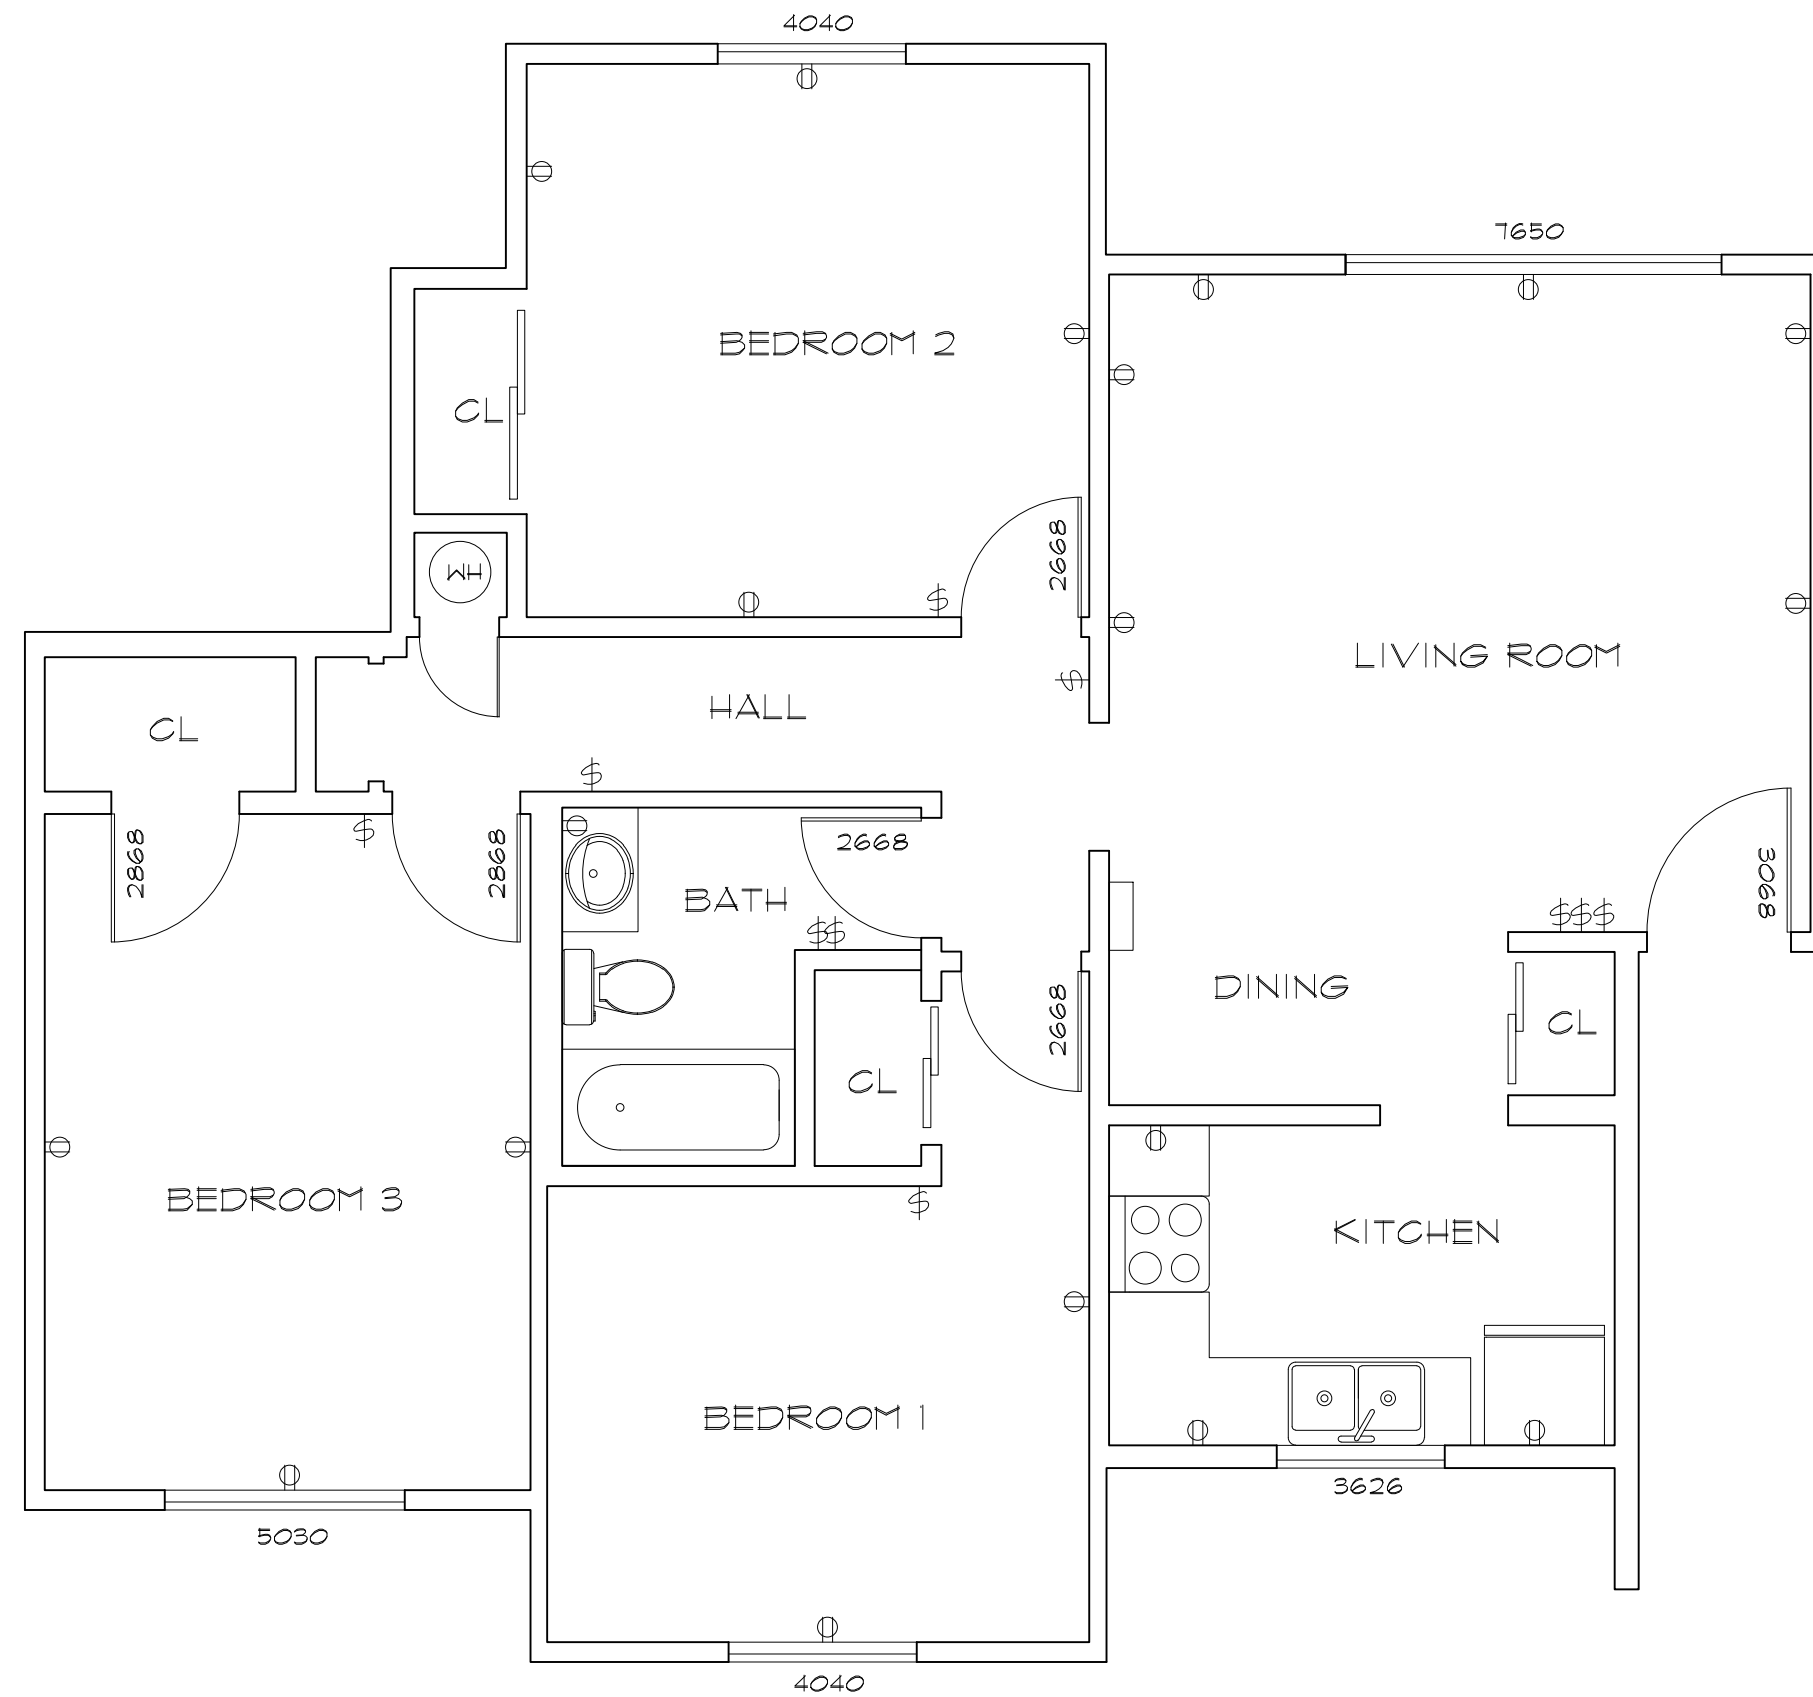

1952-4-4b

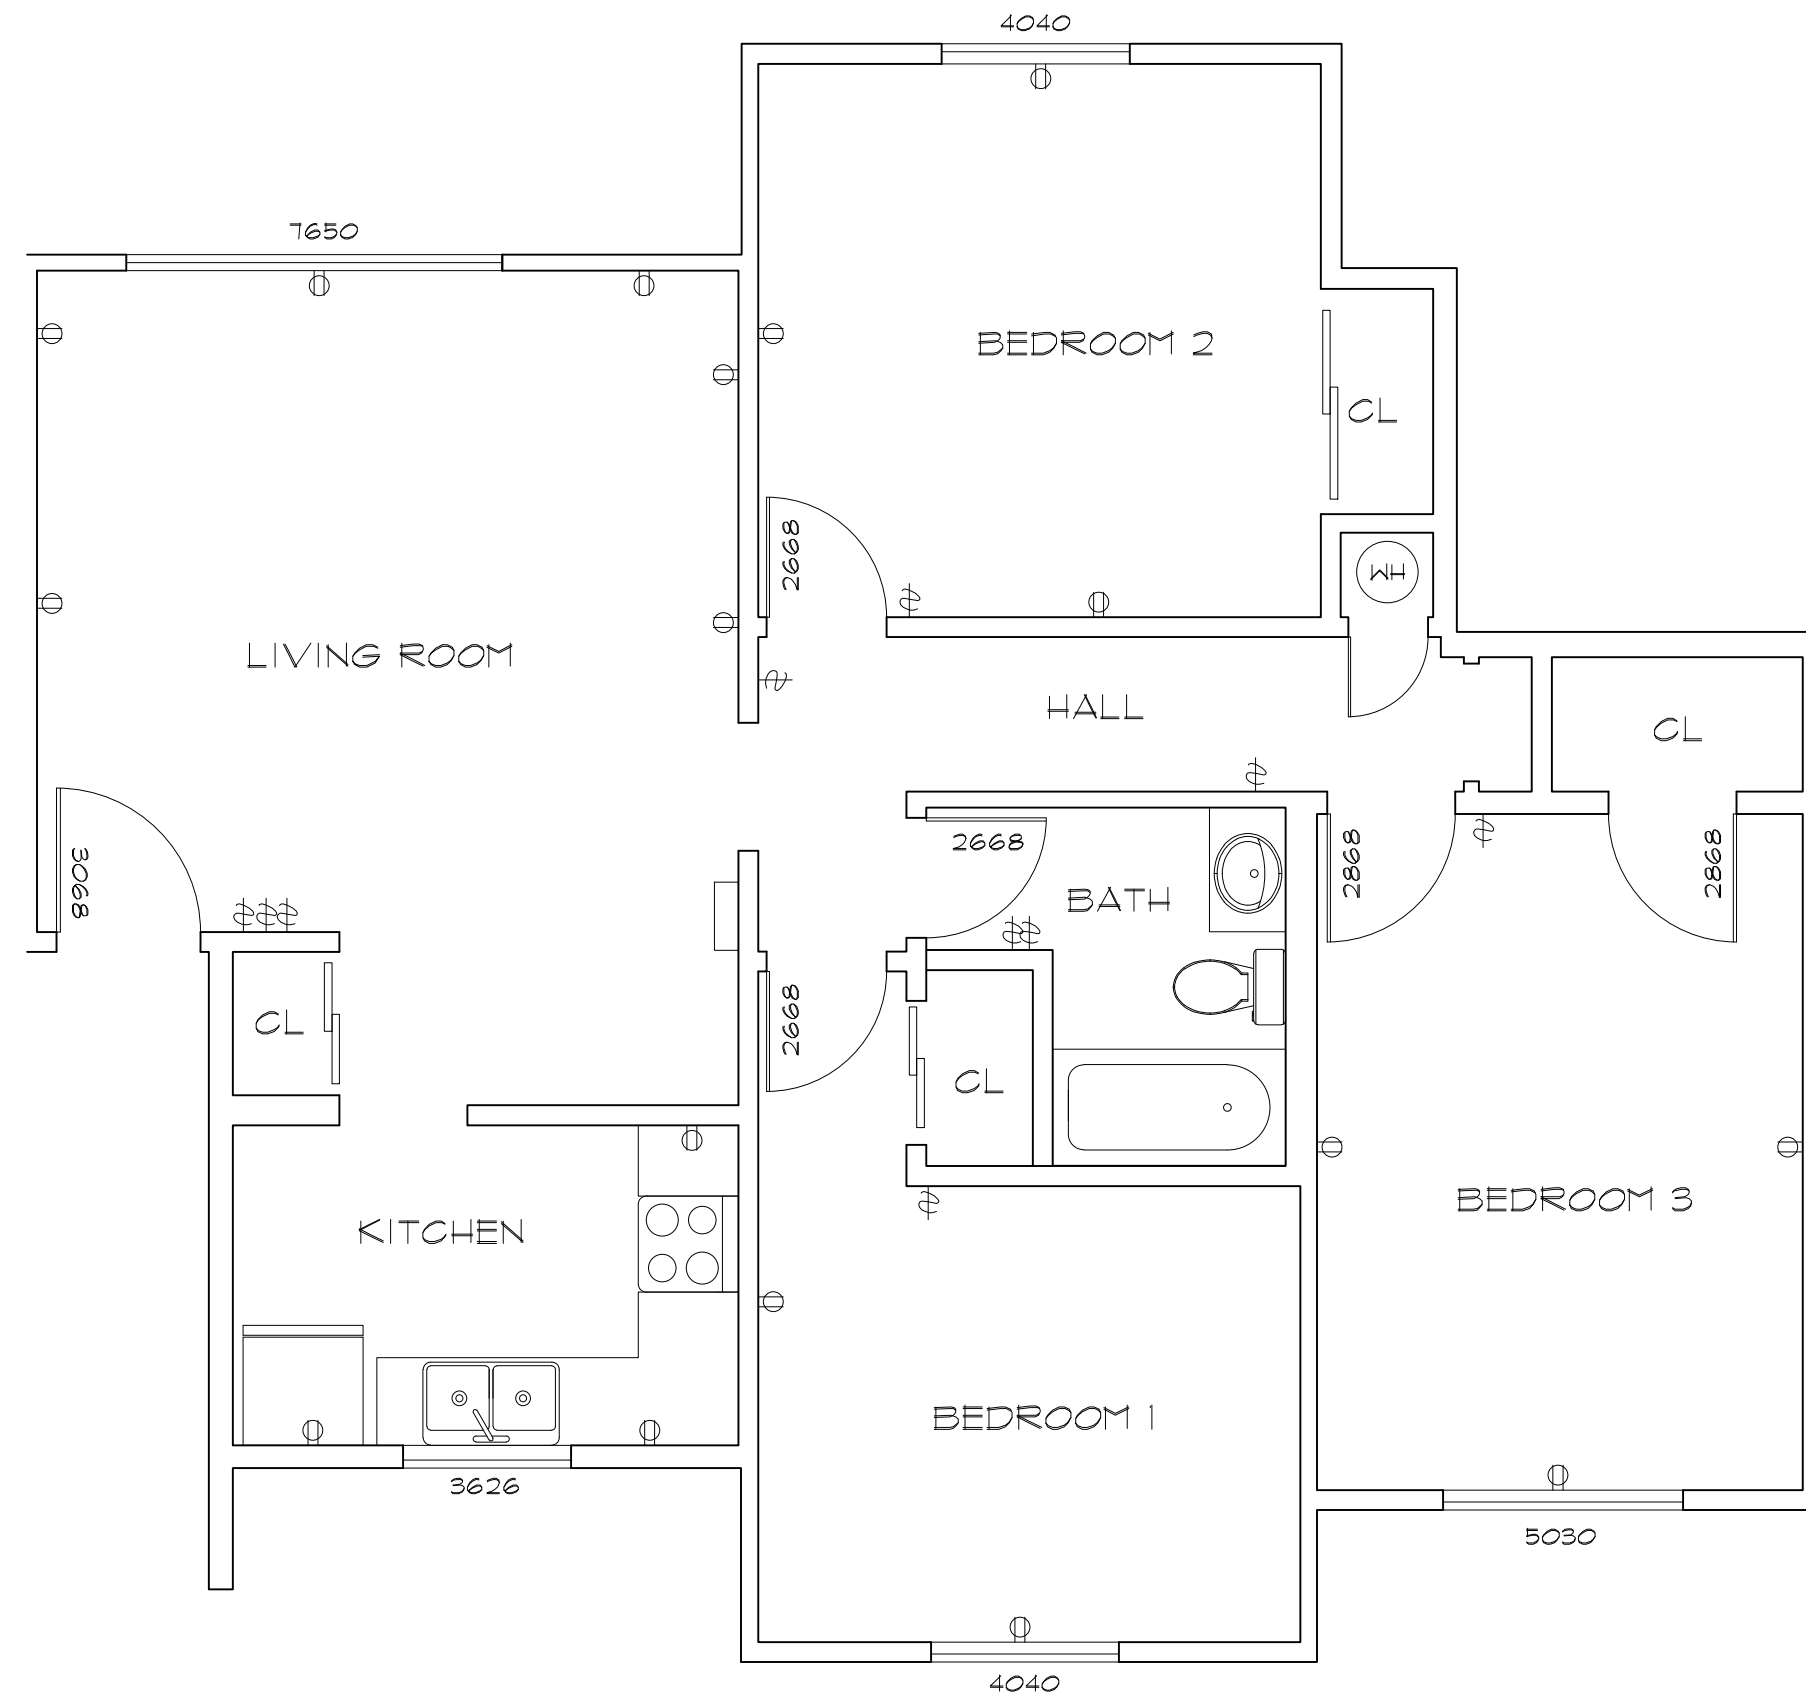


1952-4-4

3 BEDROOM LAYOUTS


As BUILT
PROFESSIONALS
www.asbuiltprofessionals.com
A DIVISION OF:
AEC
CONSULTANTS INC
844.272.8458
844 ASBUILT
© 2019 AEC CONSULTANTS INC

ARCHITECTURAL AS BUILT
HOLIDAY MANOR APARTMENTS
Oxnard, CA 94901

01	100% SUBMISSION	SEE COVER SHEET
NO.	ISSUES REVISIONS	DATE
		SHEET TITLE
HL	PROJECT MANAGER	
HL	PROJECT DIRECTOR	
012317-1	PROJECT NUMBER	
1/4"=1'-0"	SCALE	
CL	DRAWN BY	
		SHEET NUMBER
UL-4		

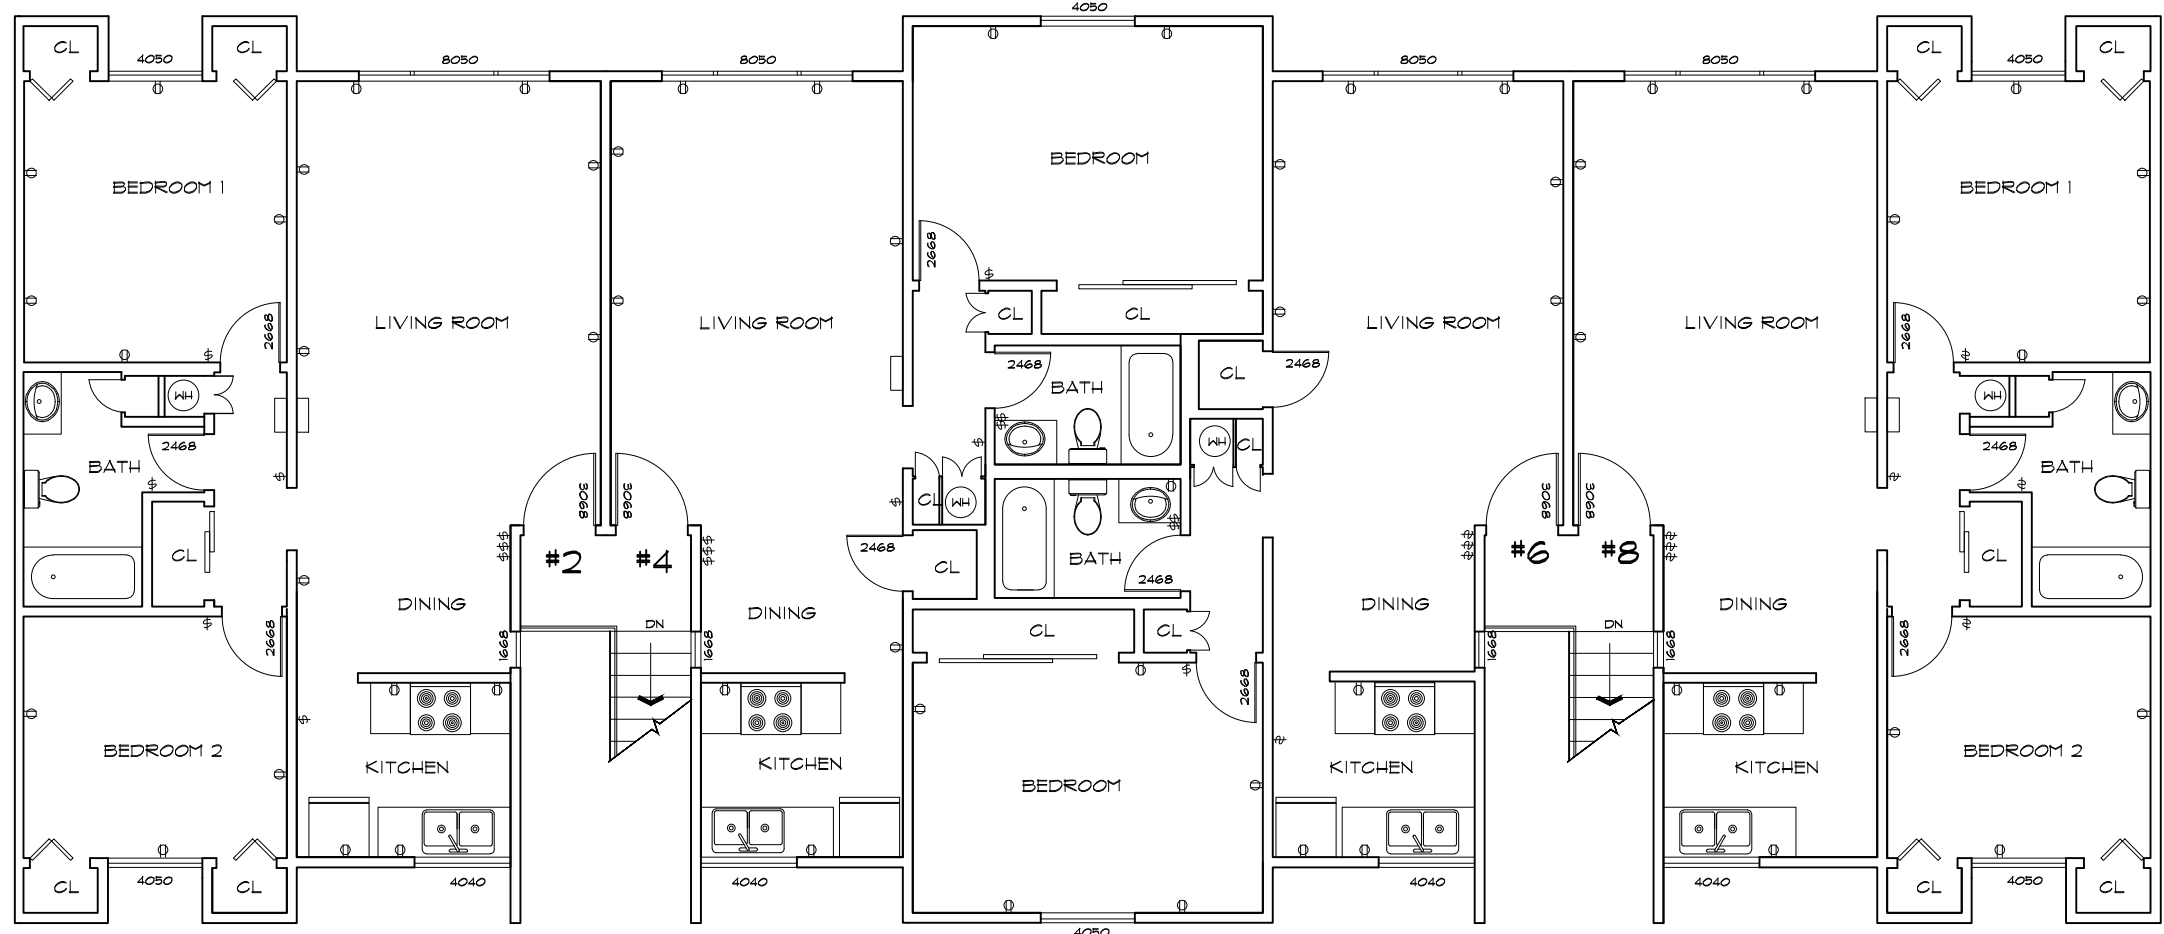

BUILDING 1 SECOND FLOOR PLAN

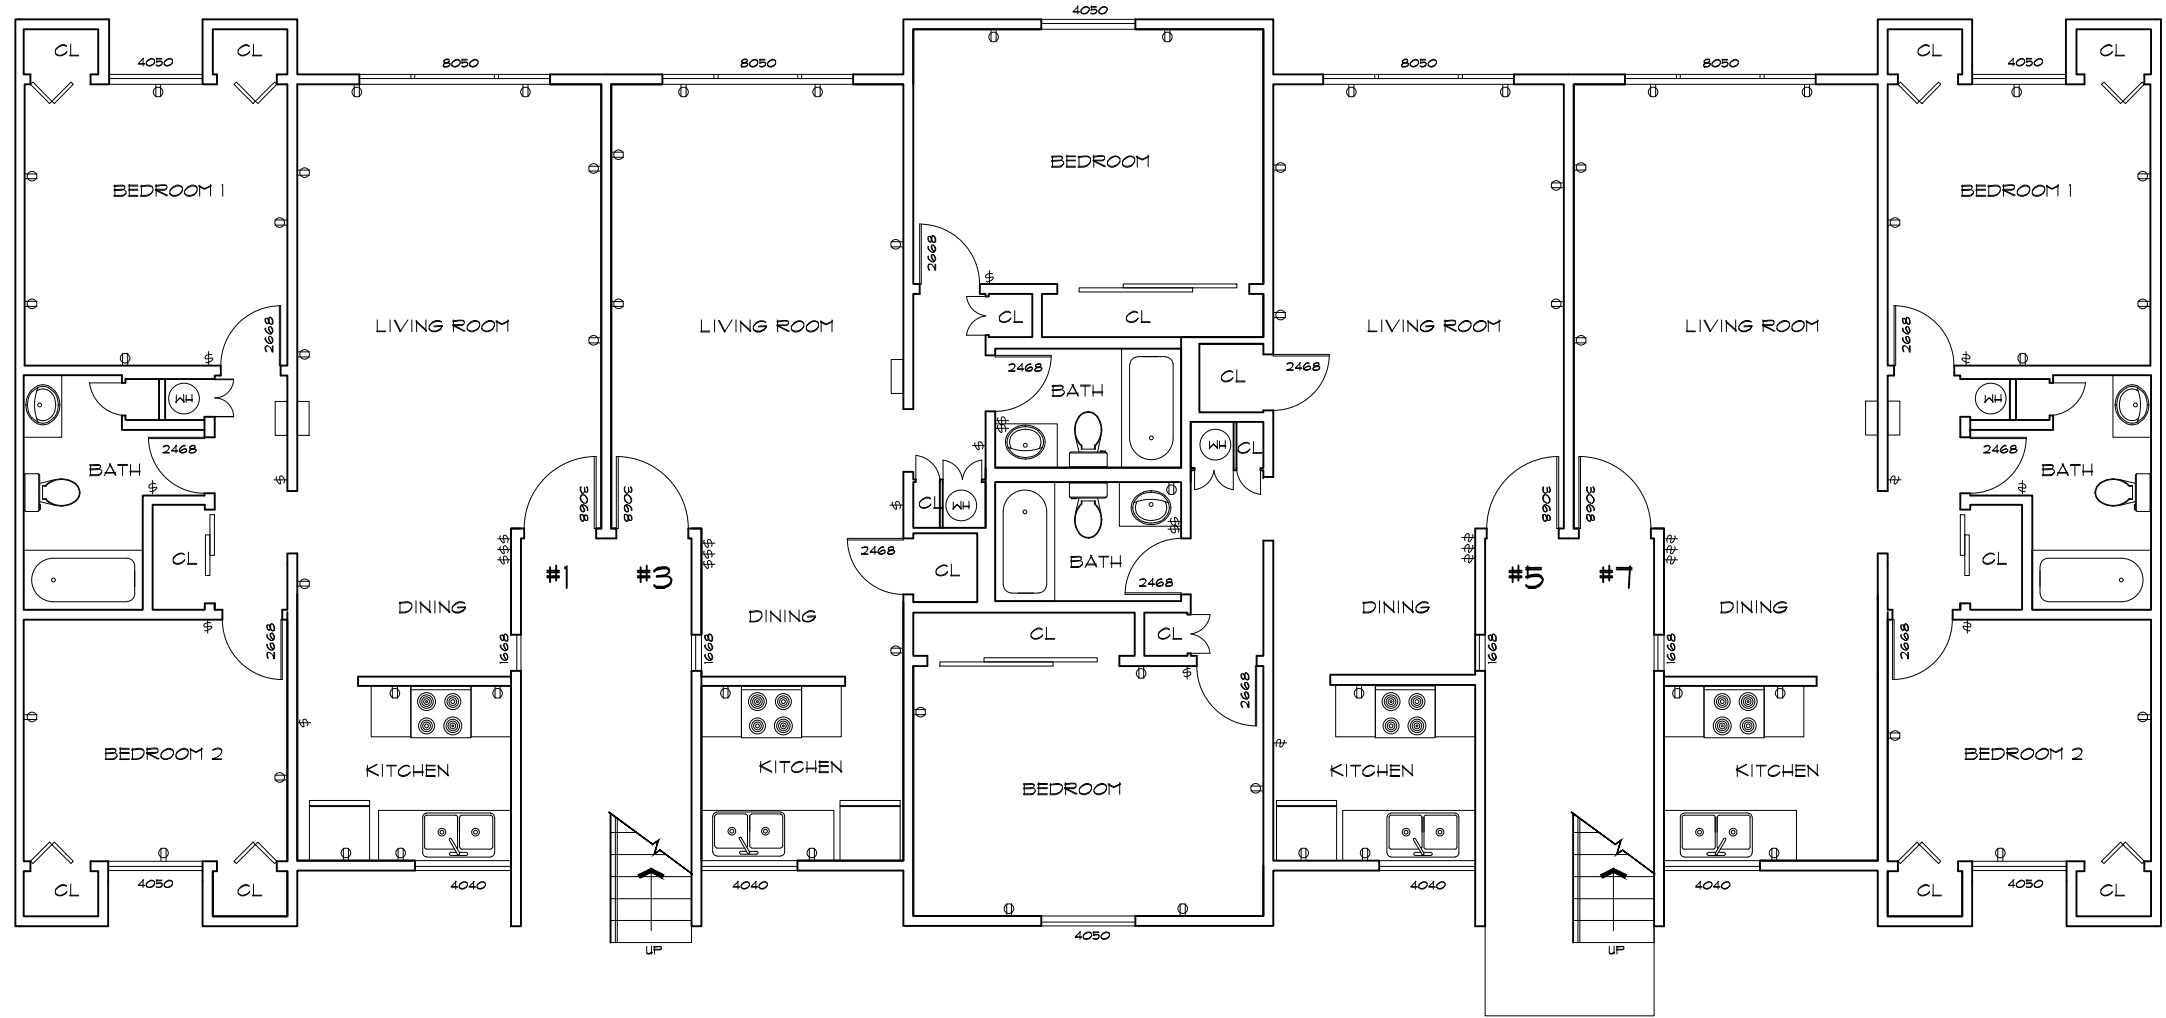

BUILDING 1 FIRST FLOOR PLAN

As BUILT

PROFESSIONALS

www.asbuiltprofessionals.com

A DIVISION OF:

AEC

CONSULTANTS INC

844.272.8458

844 ASBUILT


© 2019 AEC CONSULTANTS INC

ARCHITECTURAL AS BUILT


HOLIDAY MANOR APARTMENTS

Oxnard, CA 94901

01	100% SUBMISSION	SEE COVER SHEET
NO.	ISSUES REVISIONS	DATE
		SHEET TITLE
HL		PROJECT MANAGER
HL		PROJECT DIRECTOR
012317-1		PROJECT NUMBER
1/8"=1'-0"		SCALE
CL		DRAWN BY
		SHEET NUMBER
AB-1		

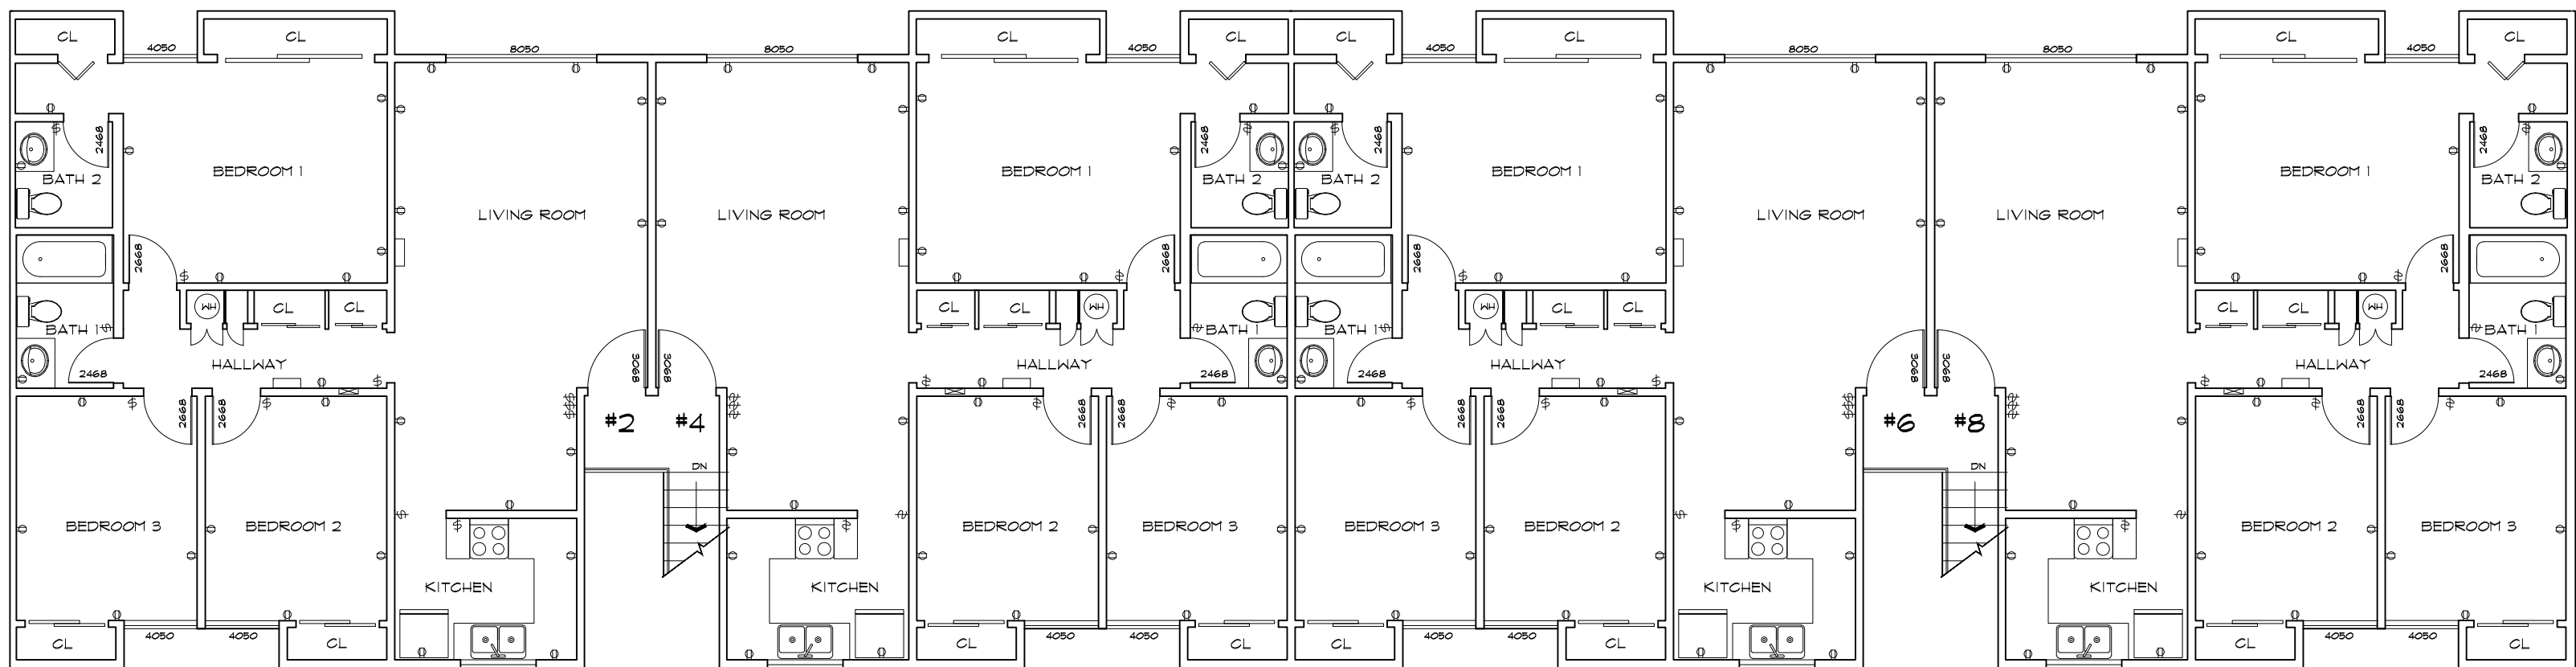

BUILDING 2 SECOND FLOOR PLAN

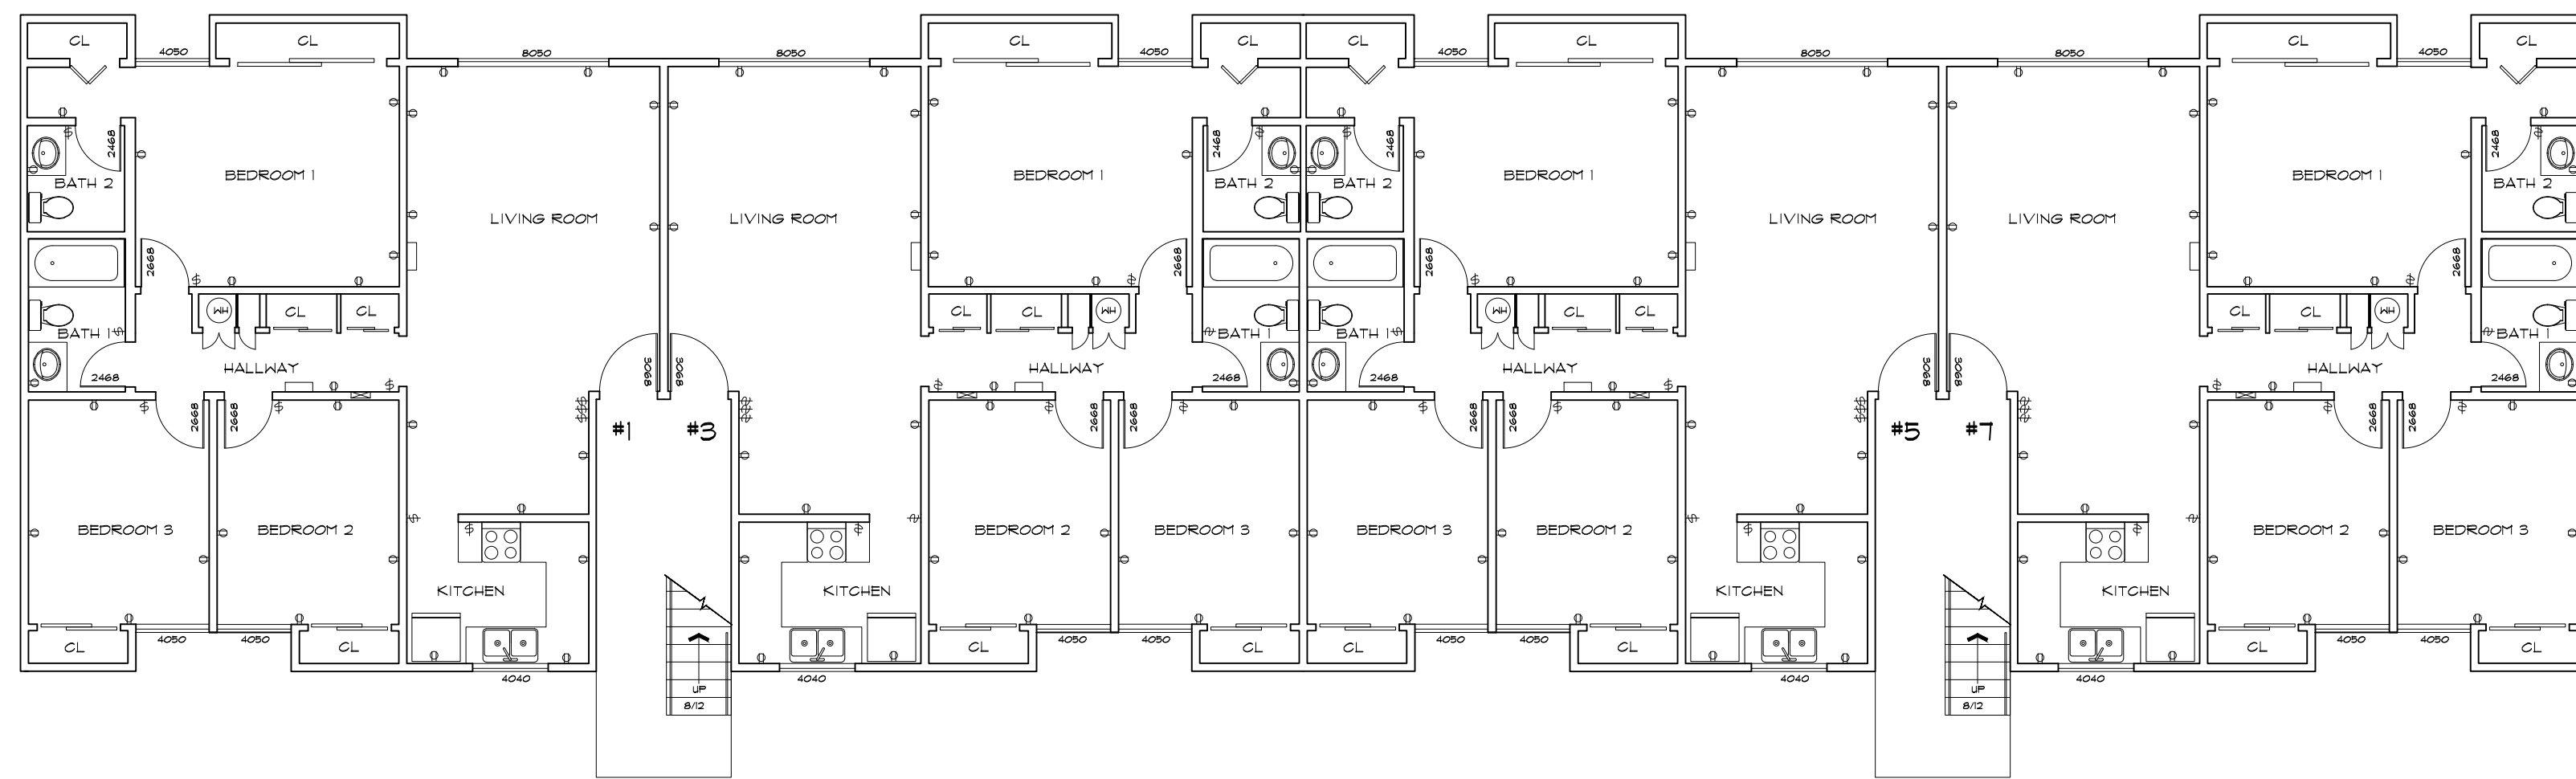

BUILDING 2 FIRST FLOOR PLAN

ARCHITECTURAL AS BUILT

HOLIDAY MANOR APARTMENTS

Oxnard, CA 94901

01	100% SUBMISSION	SEE COVER SHEET
NO.	ISSUES REVISIONS	DATE
		SHEET TITLE
HL	PROJECT MANAGER	
HL	PROJECT DIRECTOR	
012317-1	PROJECT NUMBER	
1/8"=1'-0"	SCALE	
CL	DRAWN BY	
		SHEET NUMBER
AB-2		

As BUILT

PROFESSIONALS

www.asbuiltprofessionals.com

A DIVISION OF:


AEC

CONSULTANTS INC


844.272.8458

844 AS BUILT

@ 2019 AEC CONSULTANTS INC

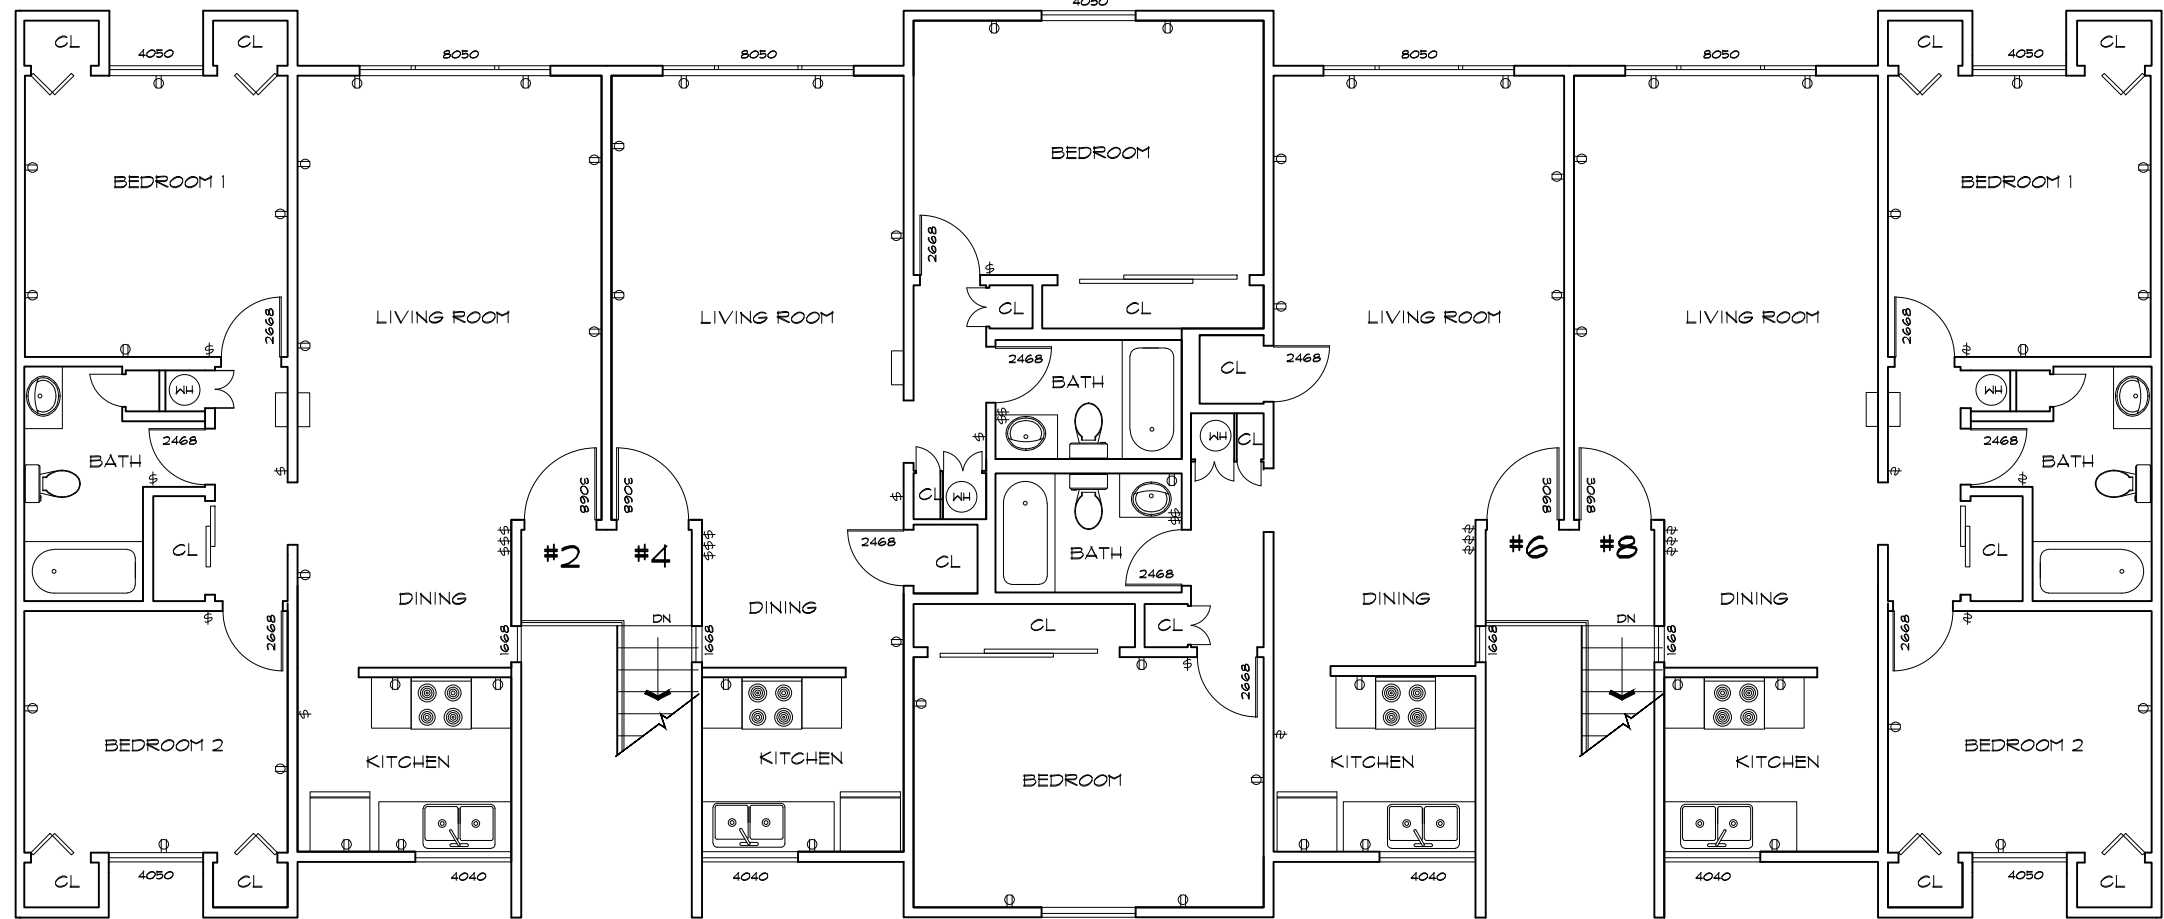

BUILDING 3 SECOND FLOOR PLAN

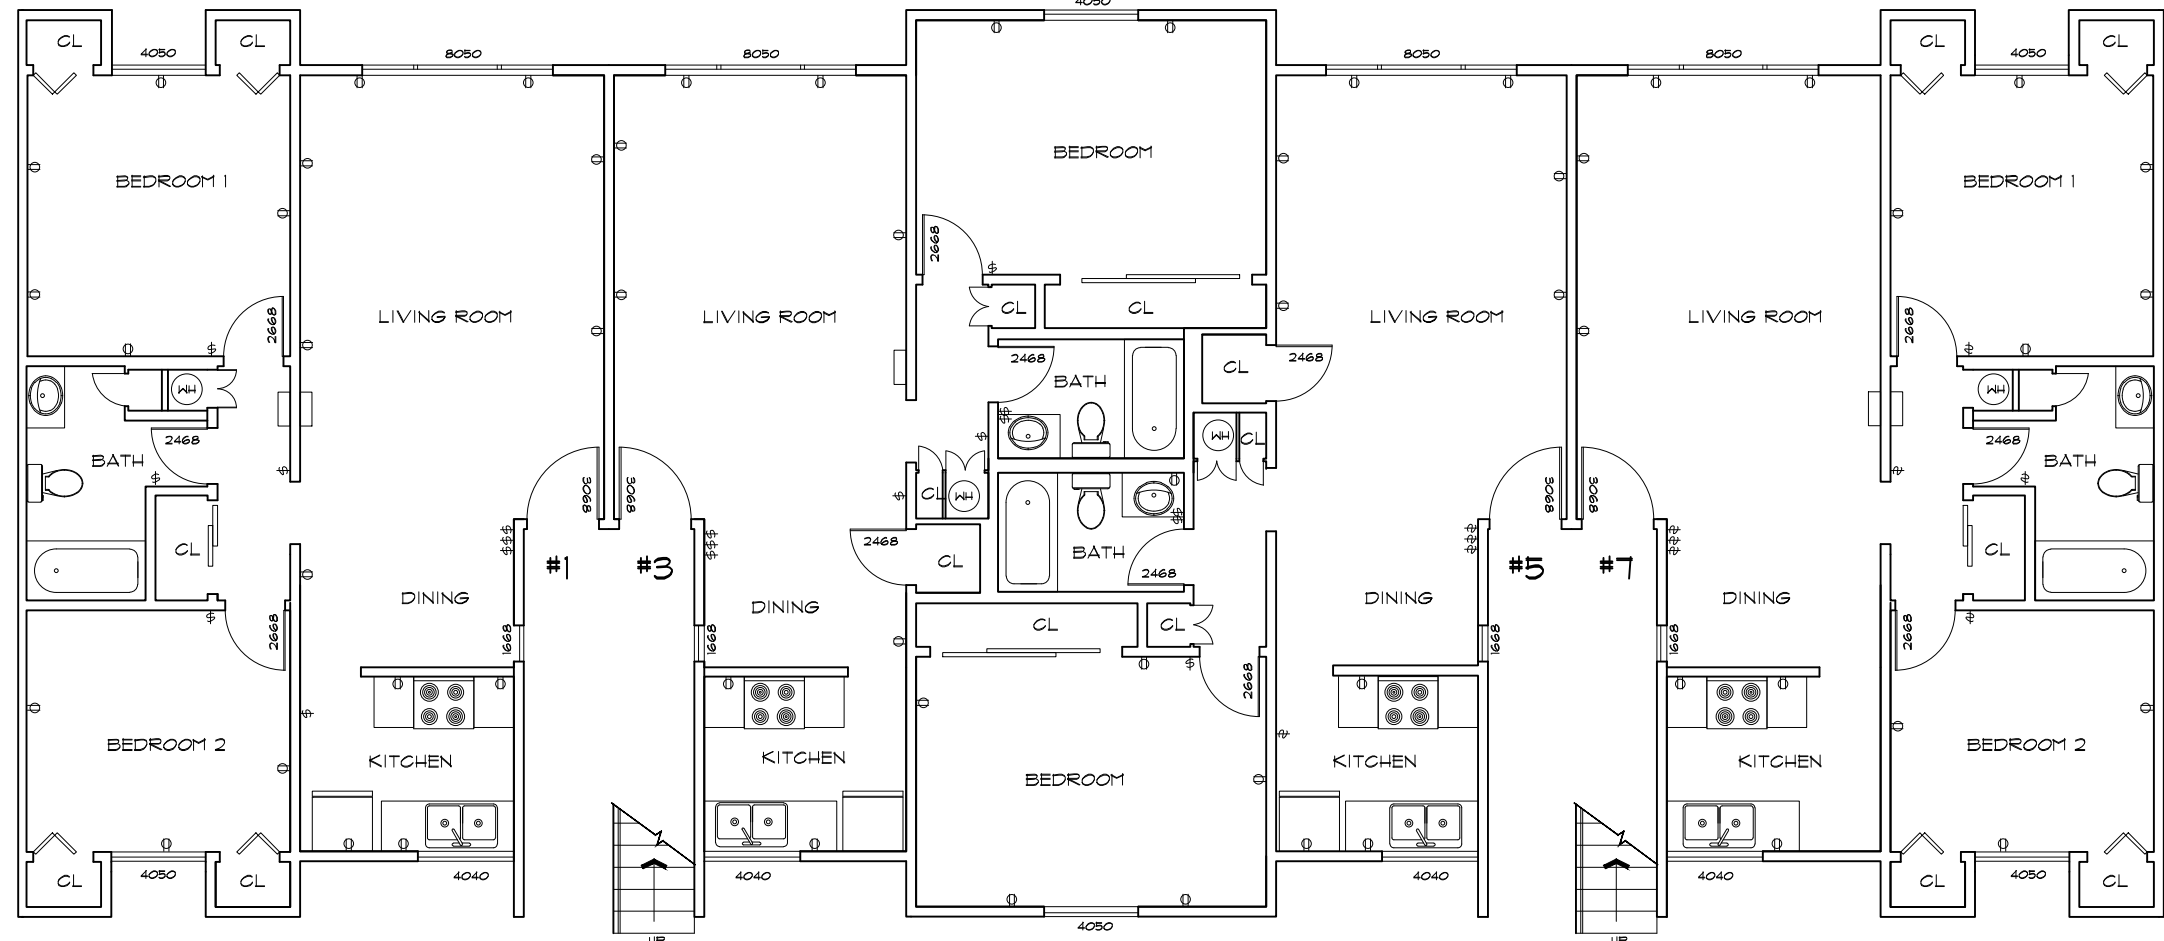

BUILDING 3 FIRST FLOOR PLAN

ARCHITECTURAL AS BUILT

HOLIDAY MANOR APARTMENTS


Oxnard, CA 94901

01	100% SUBMISSION	SEE COVER SHEET
NO.	ISSUES REVISIONS	DATE
		SHEET TITLE
HL		PROJECT MANAGER
HL		PROJECT DIRECTOR
012317-1		PROJECT NUMBER
1/8"=1'-0"		SCALE
CL		DRAWN BY
		SHEET NUMBER
AB-3		


ARCHITECTURAL AS BUILT

HOLIDAY MANOR APARTMENTS

Oxnard, CA 94901

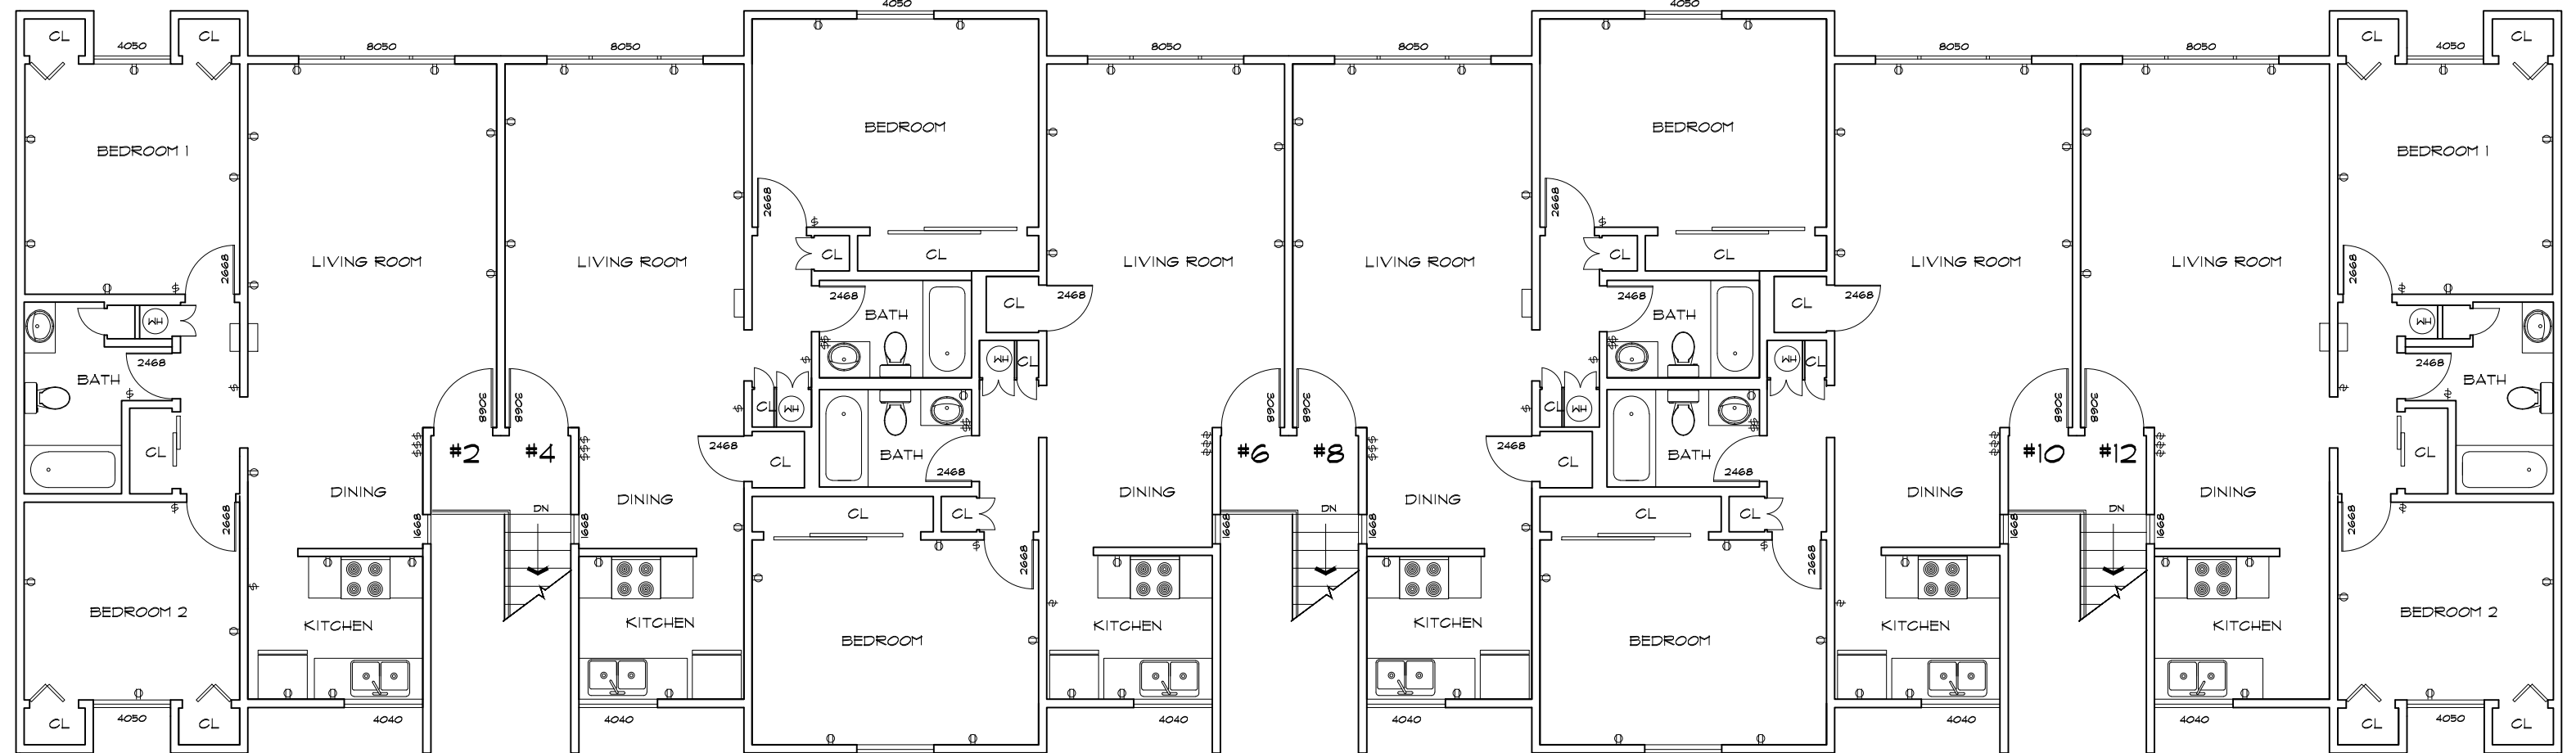


BUILDING 4 SECOND FLOOR PLAN

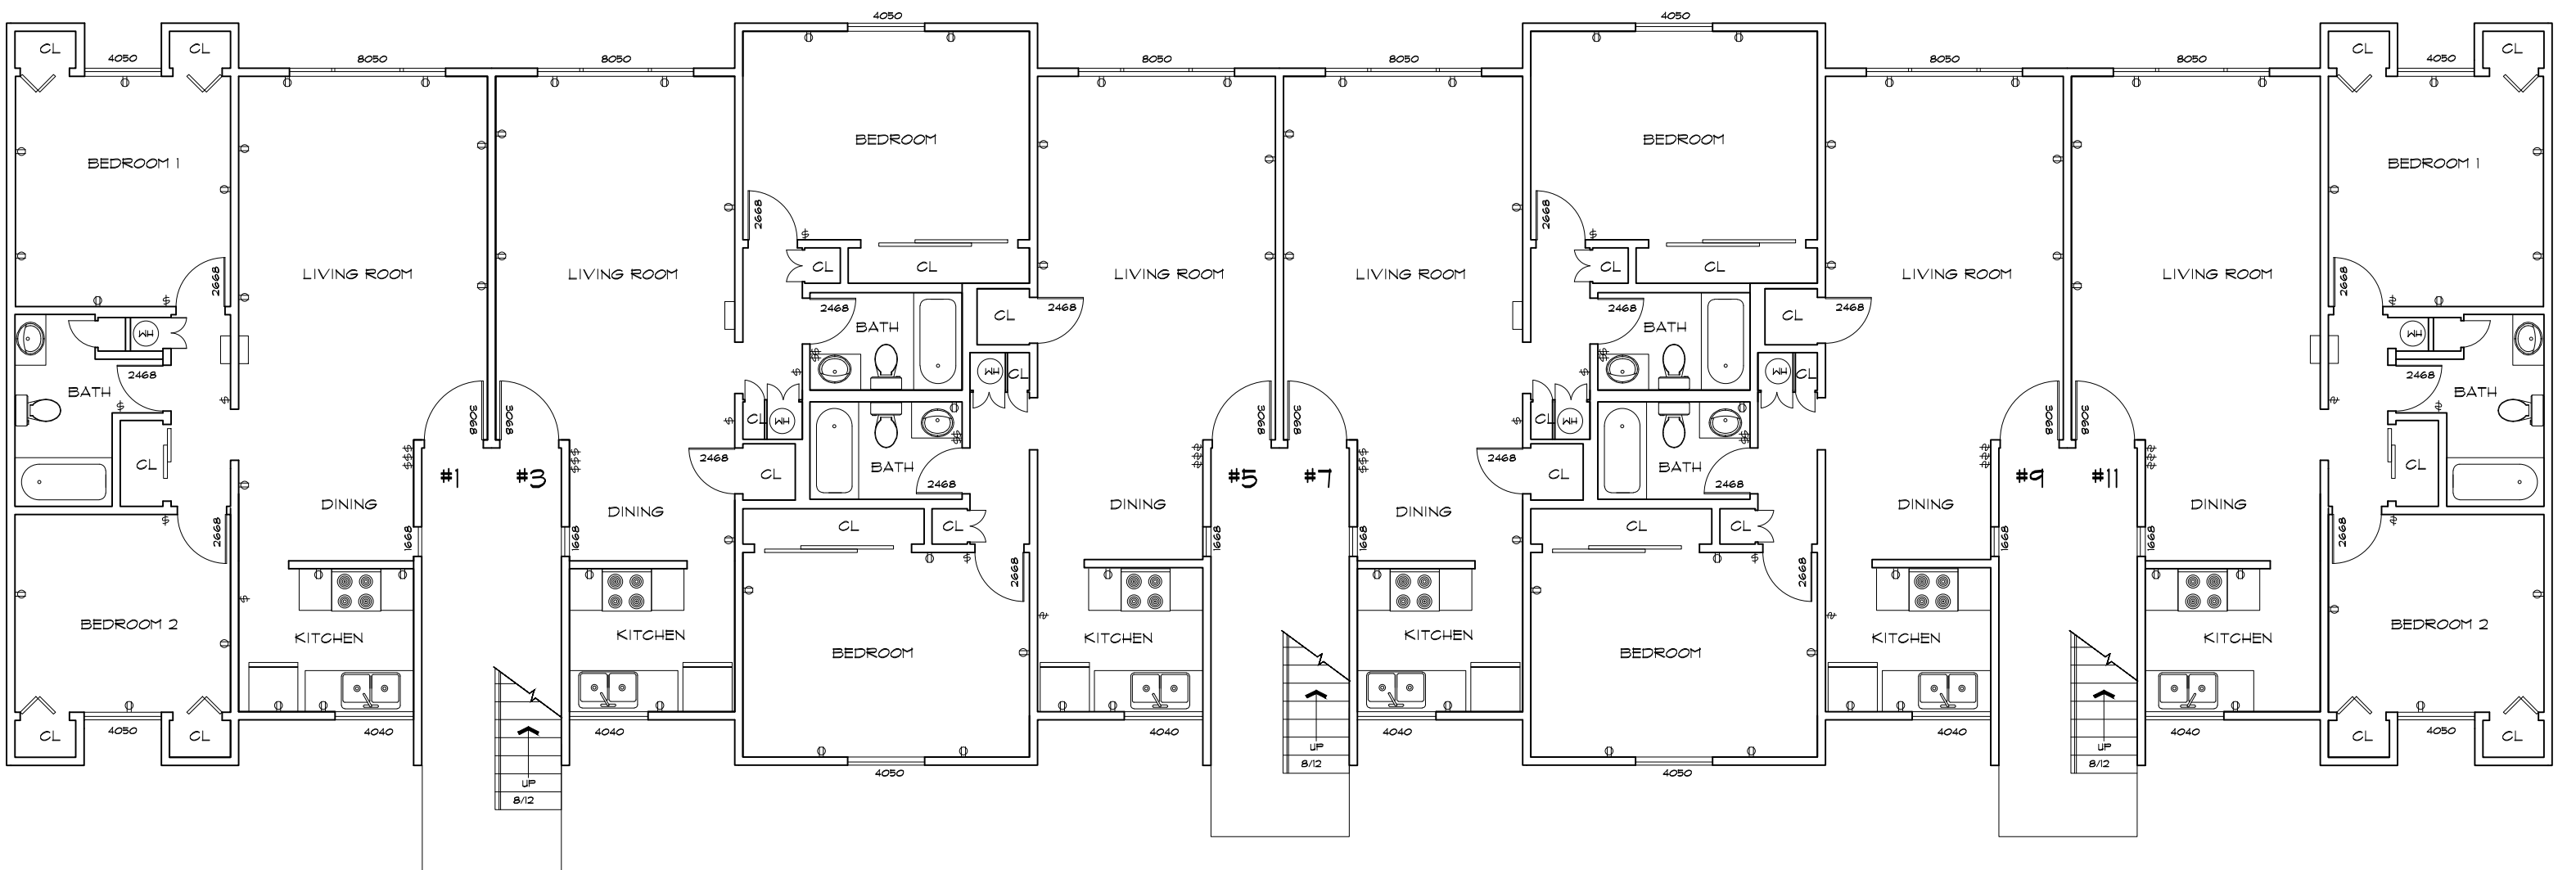


BUILDING 4 FIRST FLOOR PLAN

01	100% SUBMISSION	SEE COVER SHEET
NO.	ISSUES REVISIONS	DATE
		SHEET TITLE
HL	PROJECT MANAGER	
HL	PROJECT DIRECTOR	
012317-1	PROJECT NUMBER	
1/8"=1'-0"	SCALE	
CL	DRAWN BY	
		SHEET NUMBER
AB-4		

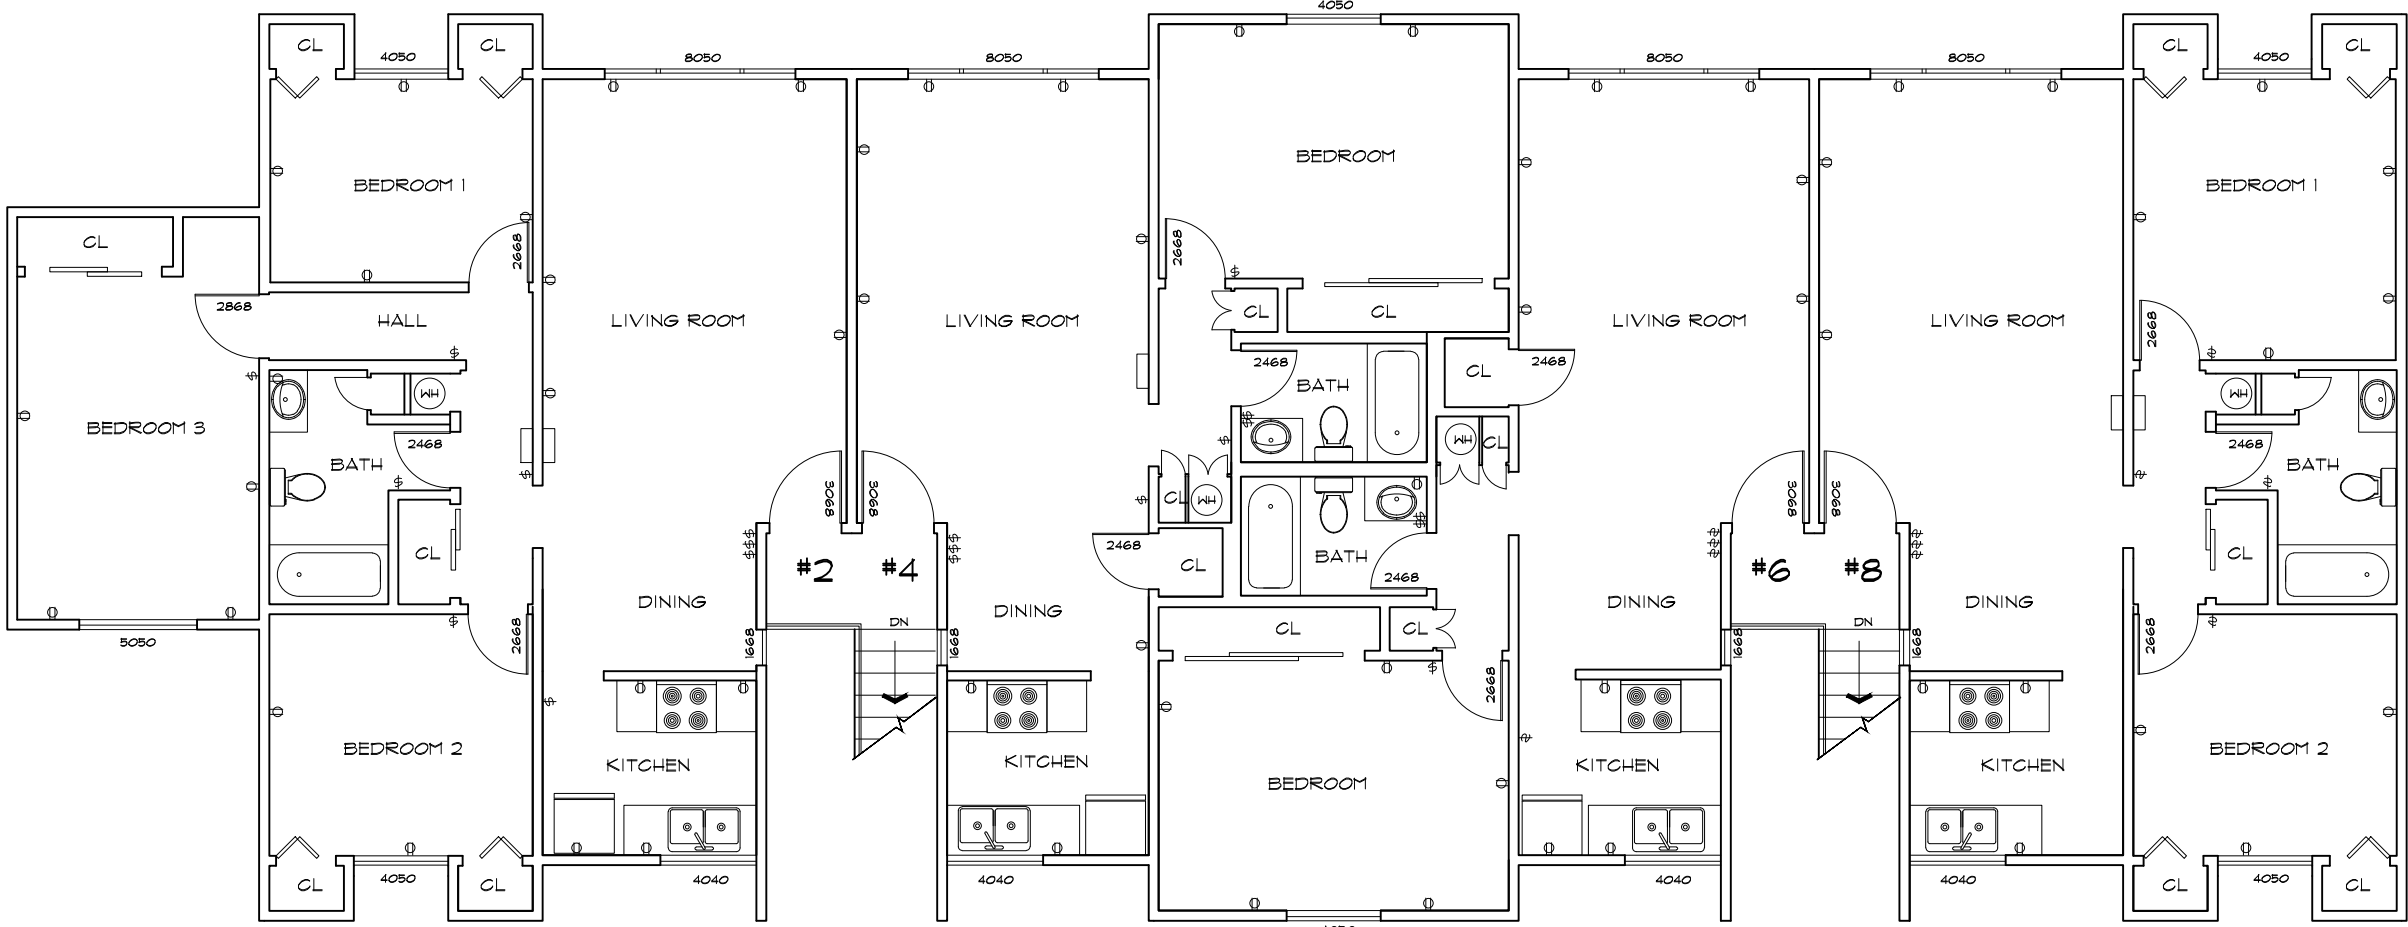

BUILDING 5 SECOND FLOOR PLAN

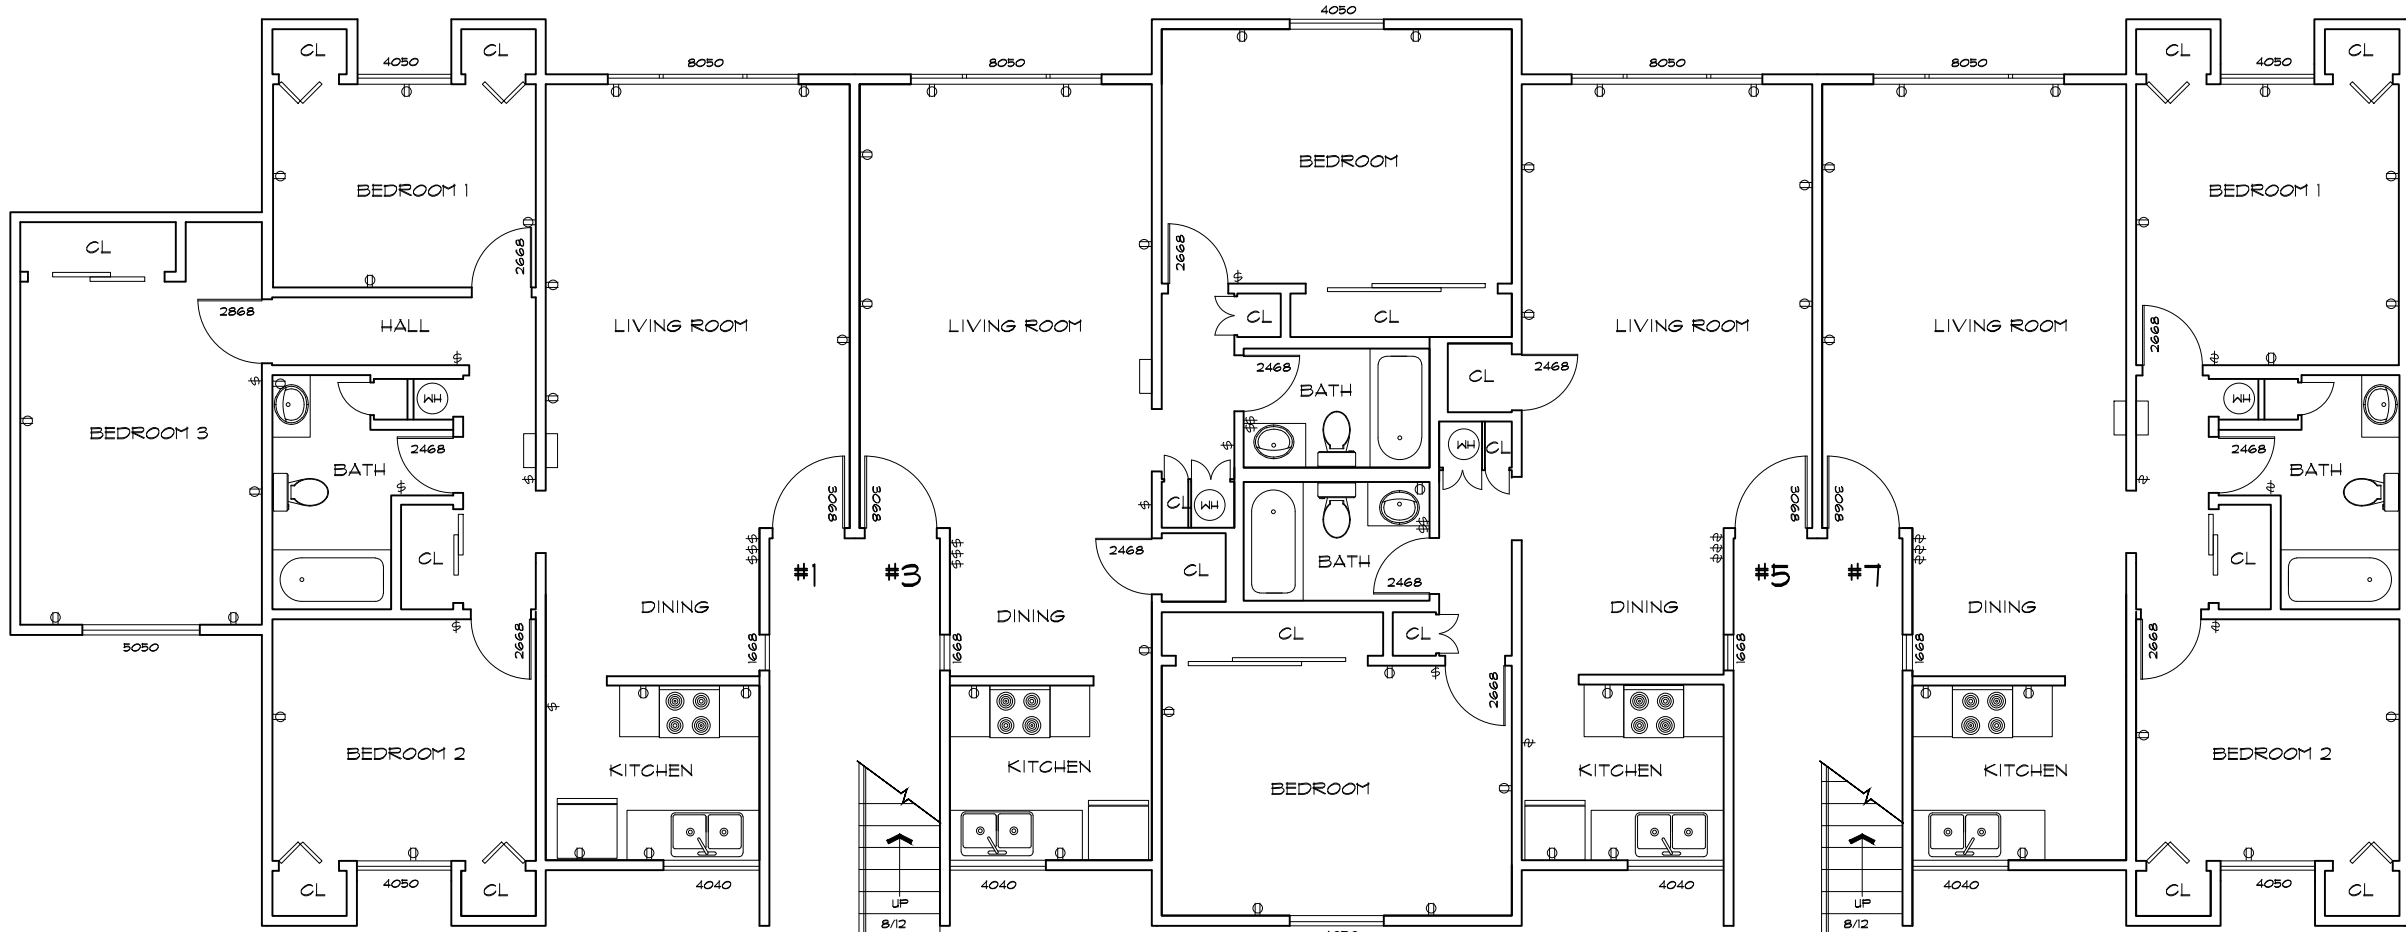

BUILDING 5 FIRST FLOOR PLAN

As BUILT

PROFESSIONALS

www.asbuiltprofessionals.com

A DIVISION OF:

AEC

CONSULTANTS INC

844.272.8458

844 AS BUILT

© 2019 AEC CONSULTANTS INC


ARCHITECTURAL AS BUILT

HOLIDAY MANOR APARTMENTS


Oxnard, CA 94901

01	100% SUBMISSION	SEE COVER SHEET
NO.	ISSUES REVISIONS	DATE
		SHEET TITLE
HL		PROJECT MANAGER
HL		PROJECT DIRECTOR
012317-1		PROJECT NUMBER
1/8"=1'-0"		SCALE
CL		DRAWN BY
		SHEET NUMBER

AB-5

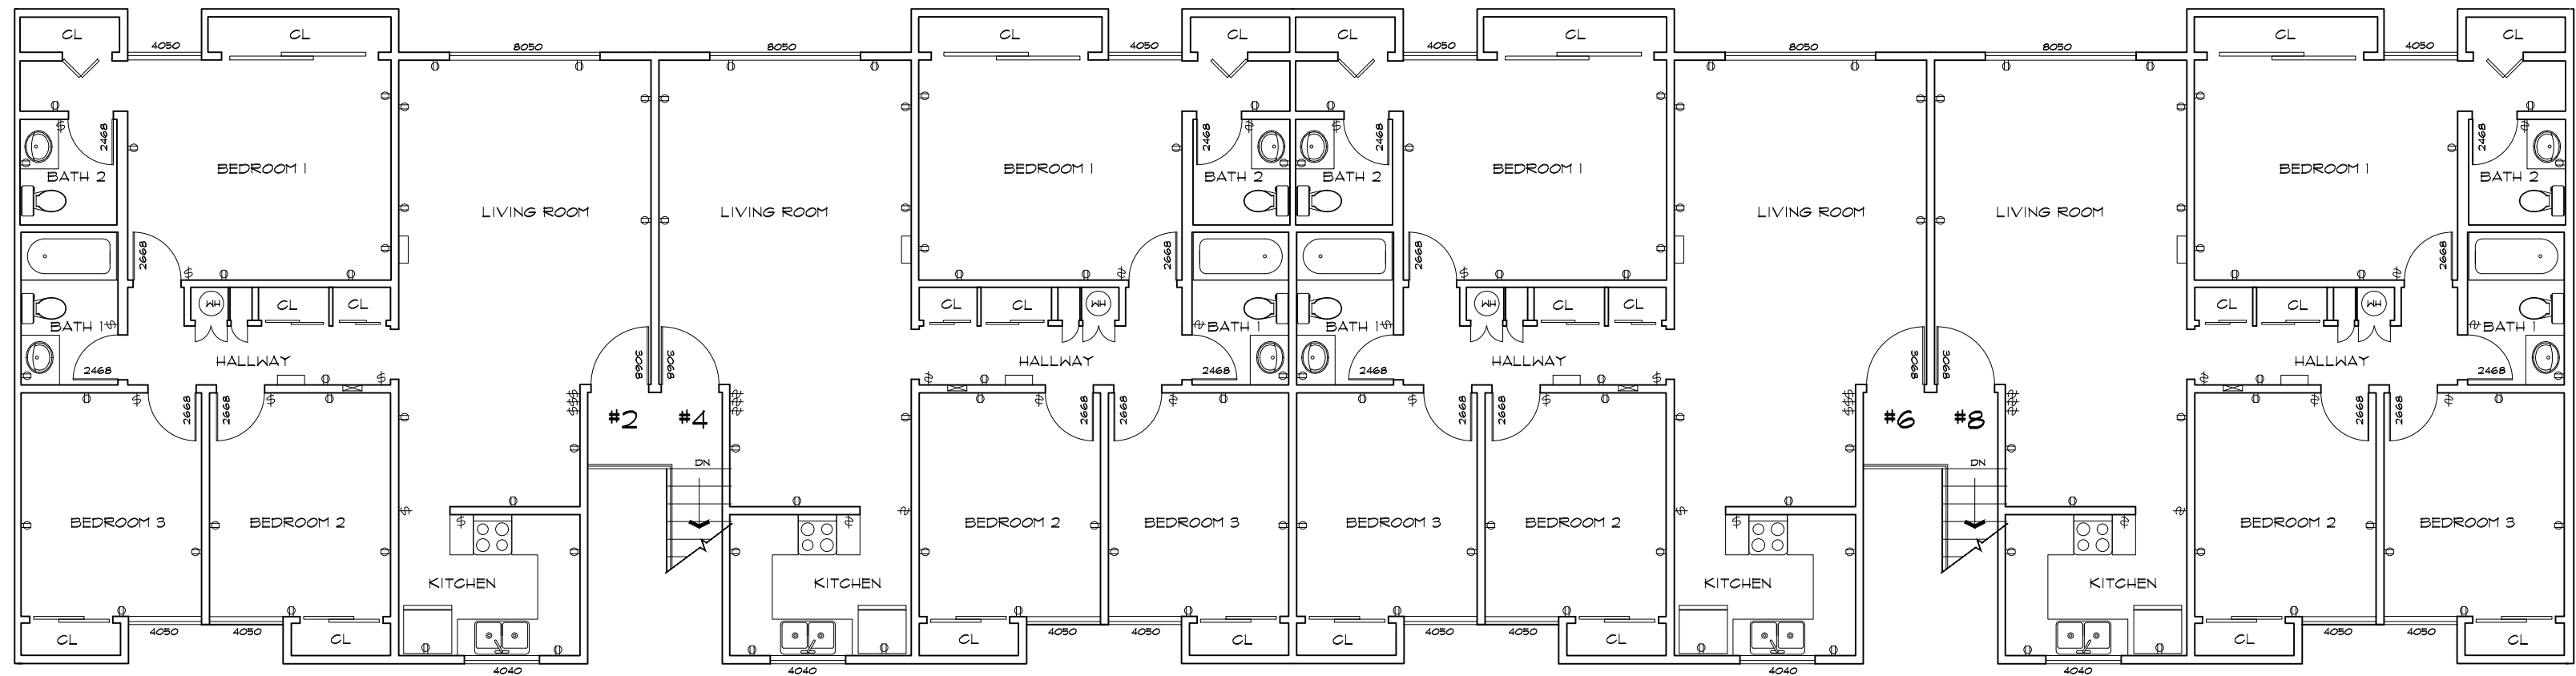

BUILDING 6 SECOND FLOOR PLAN

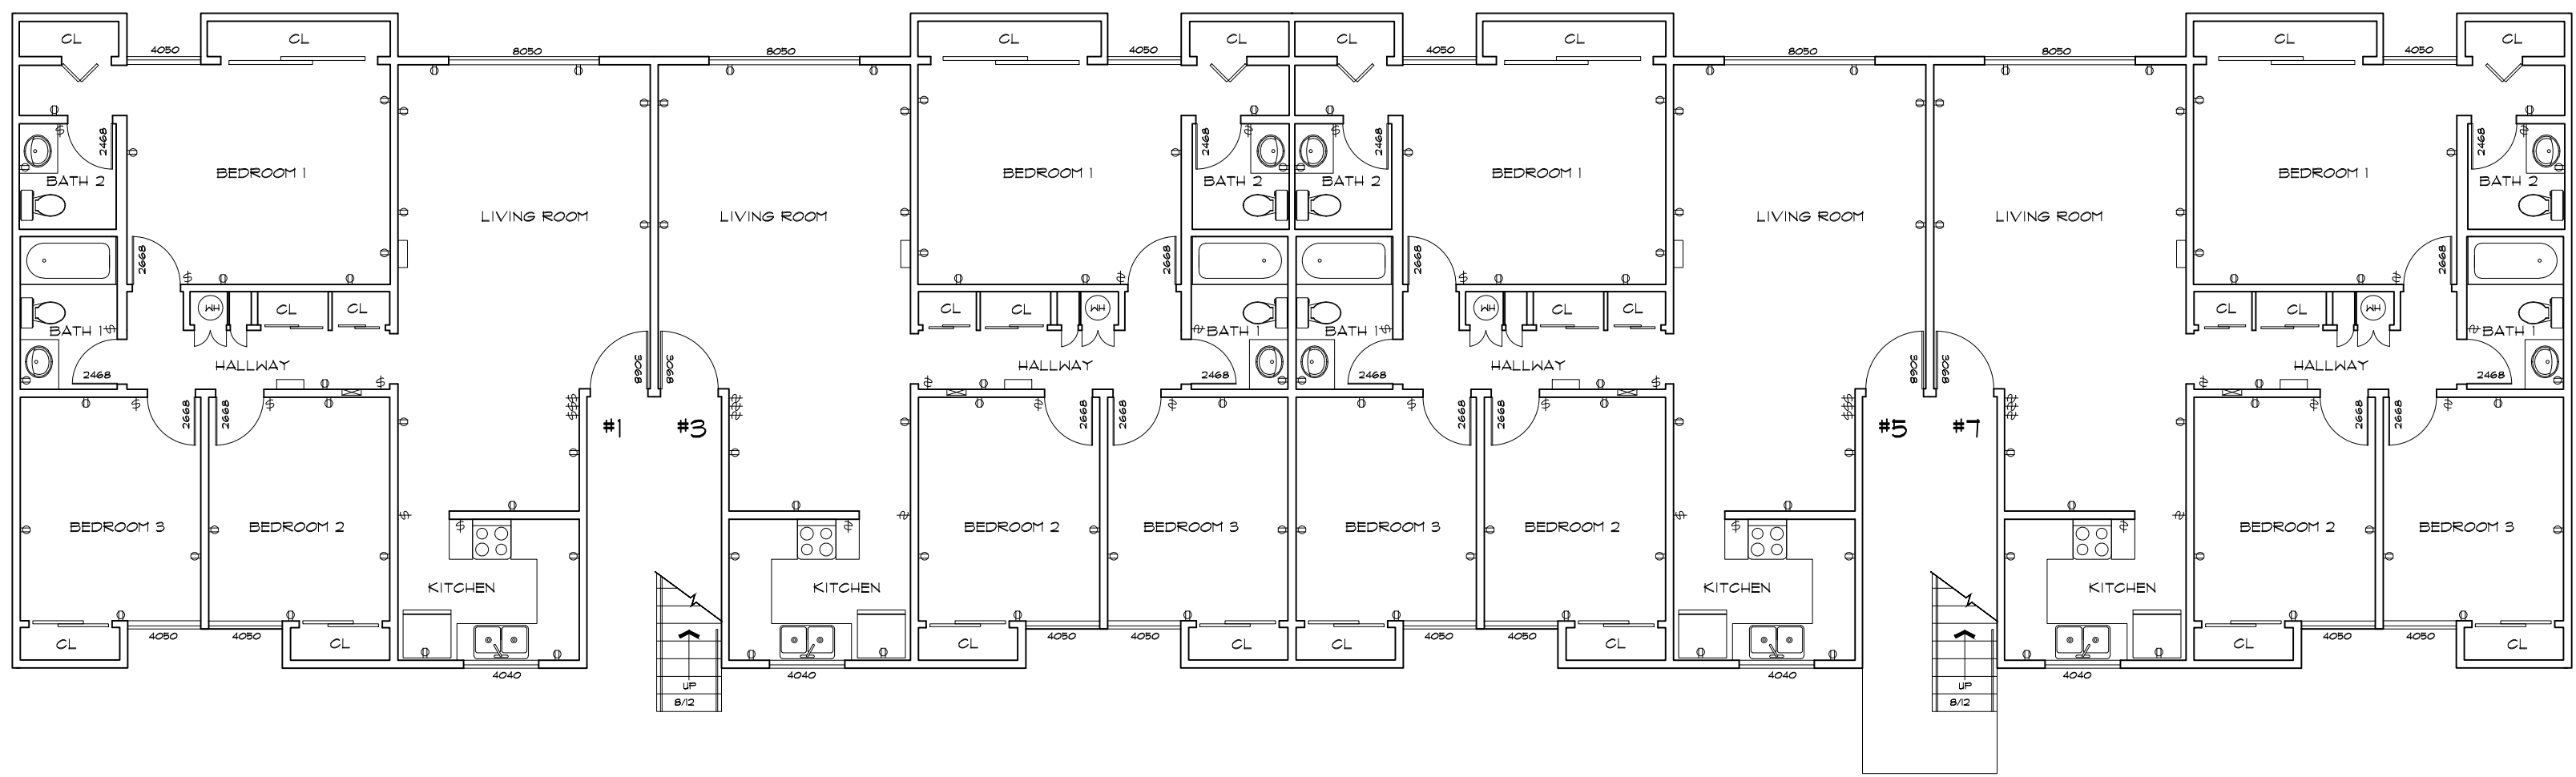

BUILDING 6 FIRST FLOOR PLAN

ARCHITECTURAL AS BUILT

HOLIDAY MANOR APARTMENTS

Oxnard, CA 94901

01	100% SUBMISSION	SEE COVER SHEET
NO.	ISSUES REVISIONS	DATE
		SHEET TITLE
HL	PROJECT MANAGER	
HL	PROJECT DIRECTOR	
012317-1	PROJECT NUMBER	
1/8"=1'-0"	SCALE	
CL	DRAWN BY	
		SHEET NUMBER

AB-6

As BUILT

PROFESSIONALS

www.asbuiltprofessionals.com

A DIVISION OF:

AEC

CONSULTANTS INC

844.272.8458

844 AS BUILT

© 2019 AEC CONSULTANTS INC


ARCHITECTURAL AS BUILT

HOLIDAY MANOR APARTMENTS


Oxnard, CA 94901

01	100% SUBMISSION	SEE COVER SHEET
NO.	ISSUES REVISIONS	DATE
		SHEET TITLE
HL		PROJECT MANAGER
HL		PROJECT DIRECTOR
012317-1		PROJECT NUMBER
1/8"=1'-0"		SCALE
CL		DRAWN BY
		SHEET NUMBER


AB-7

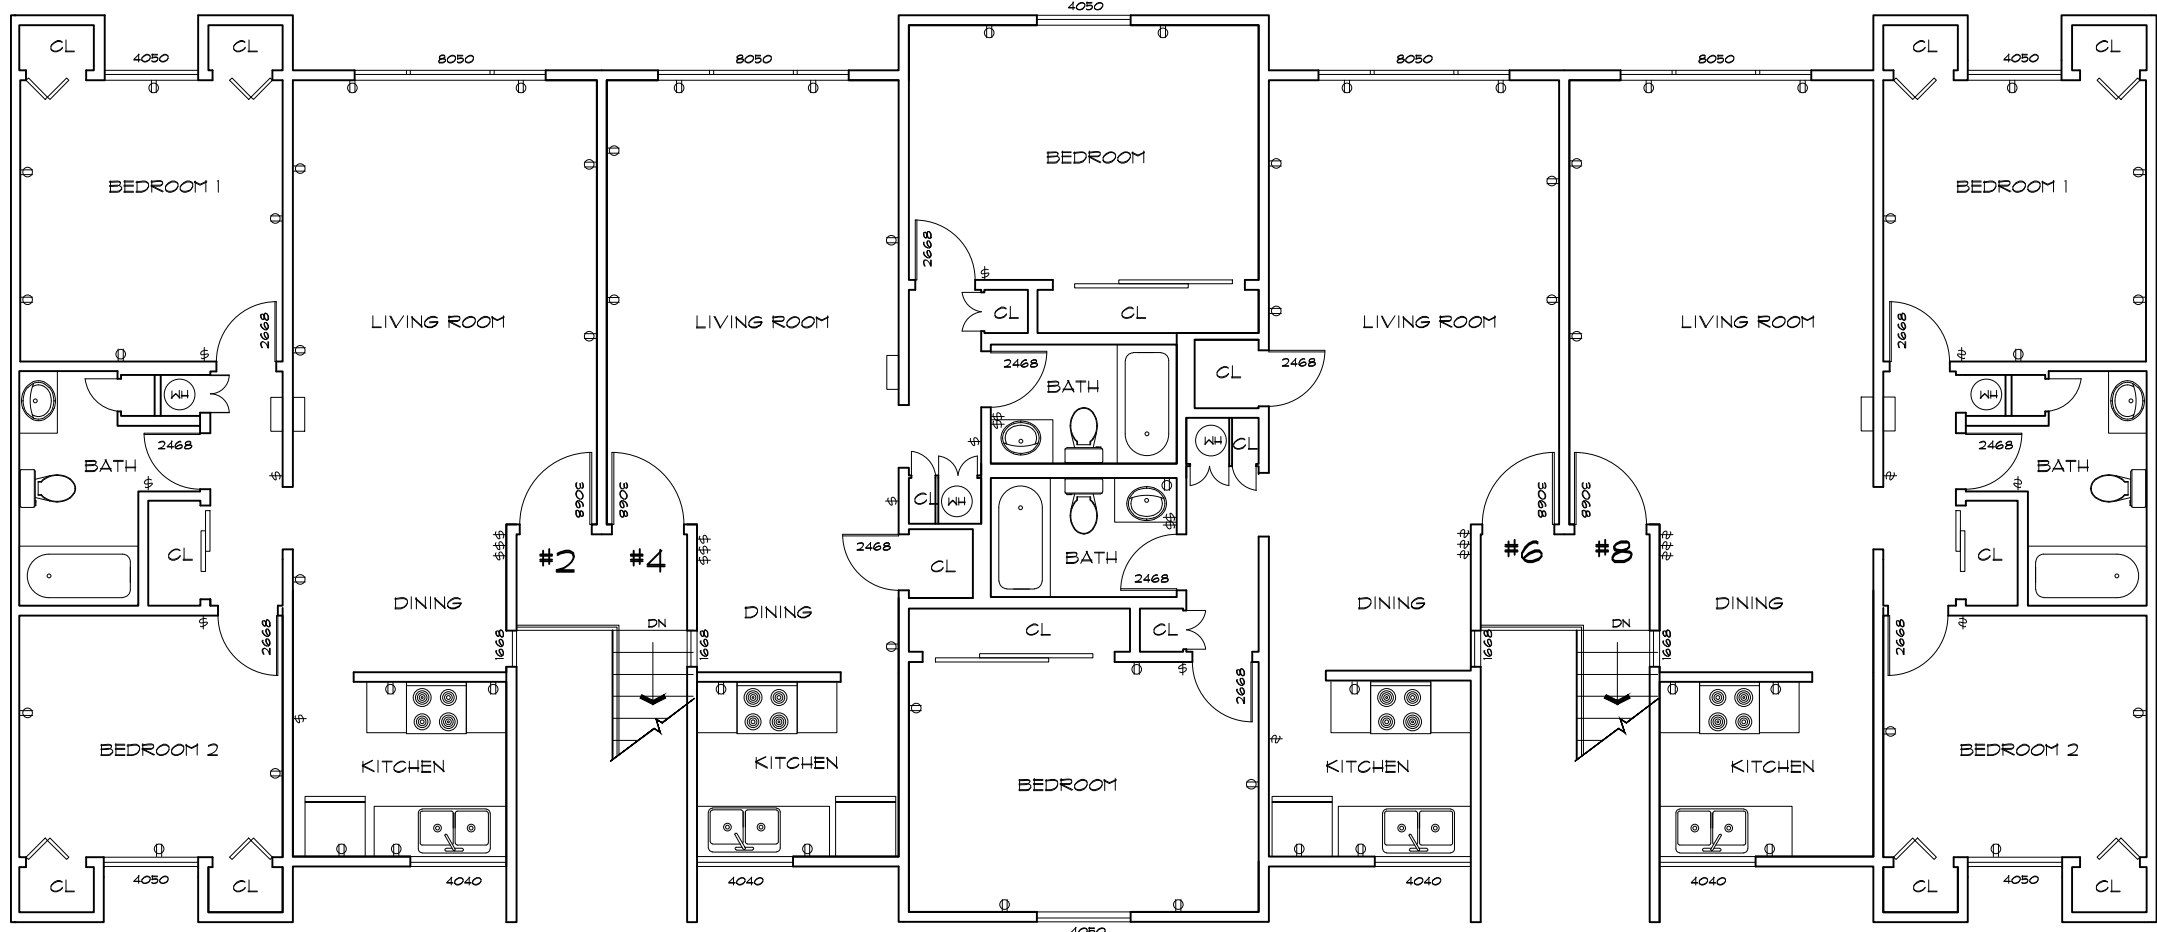


BUILDING 7 SECOND FLOOR PLAN

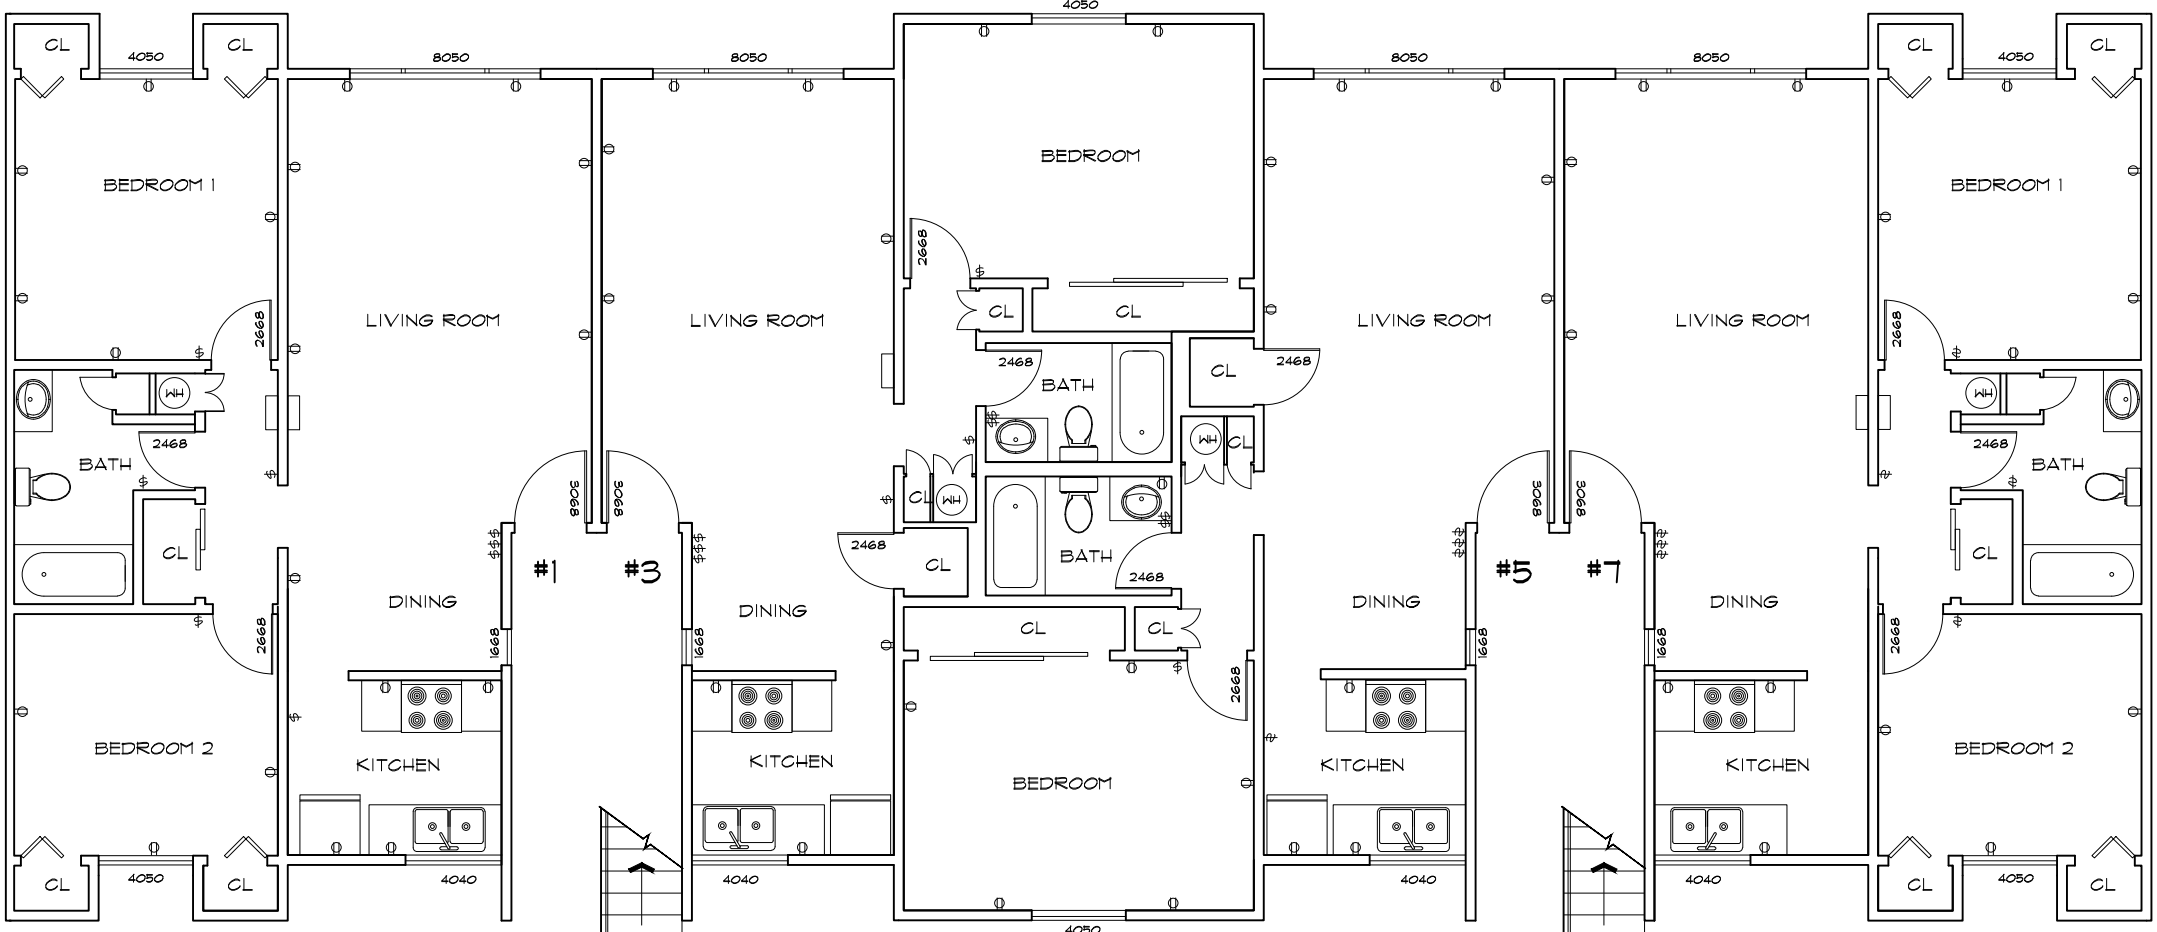

BUILDING 7 FIRST FLOOR PLAN

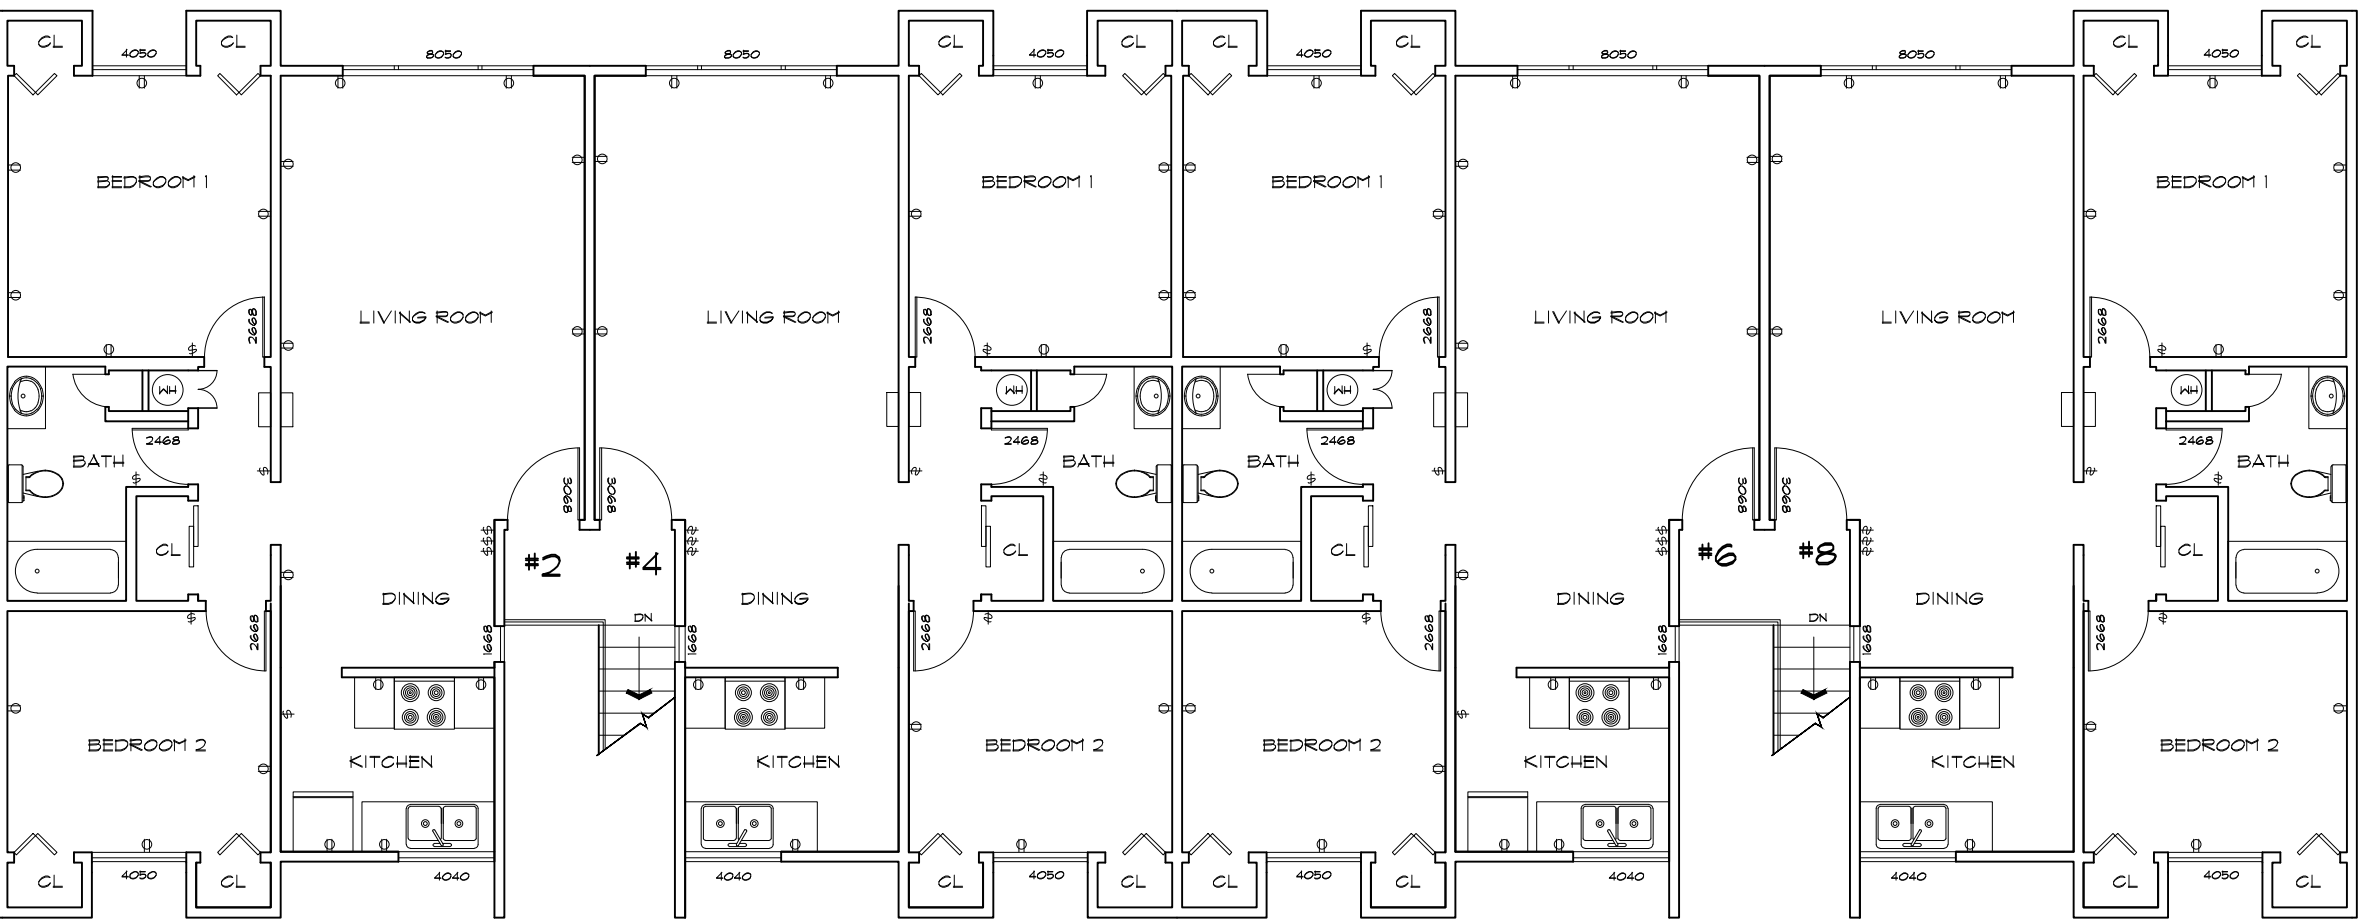

BUILDING 8 SECOND FLOOR PLAN

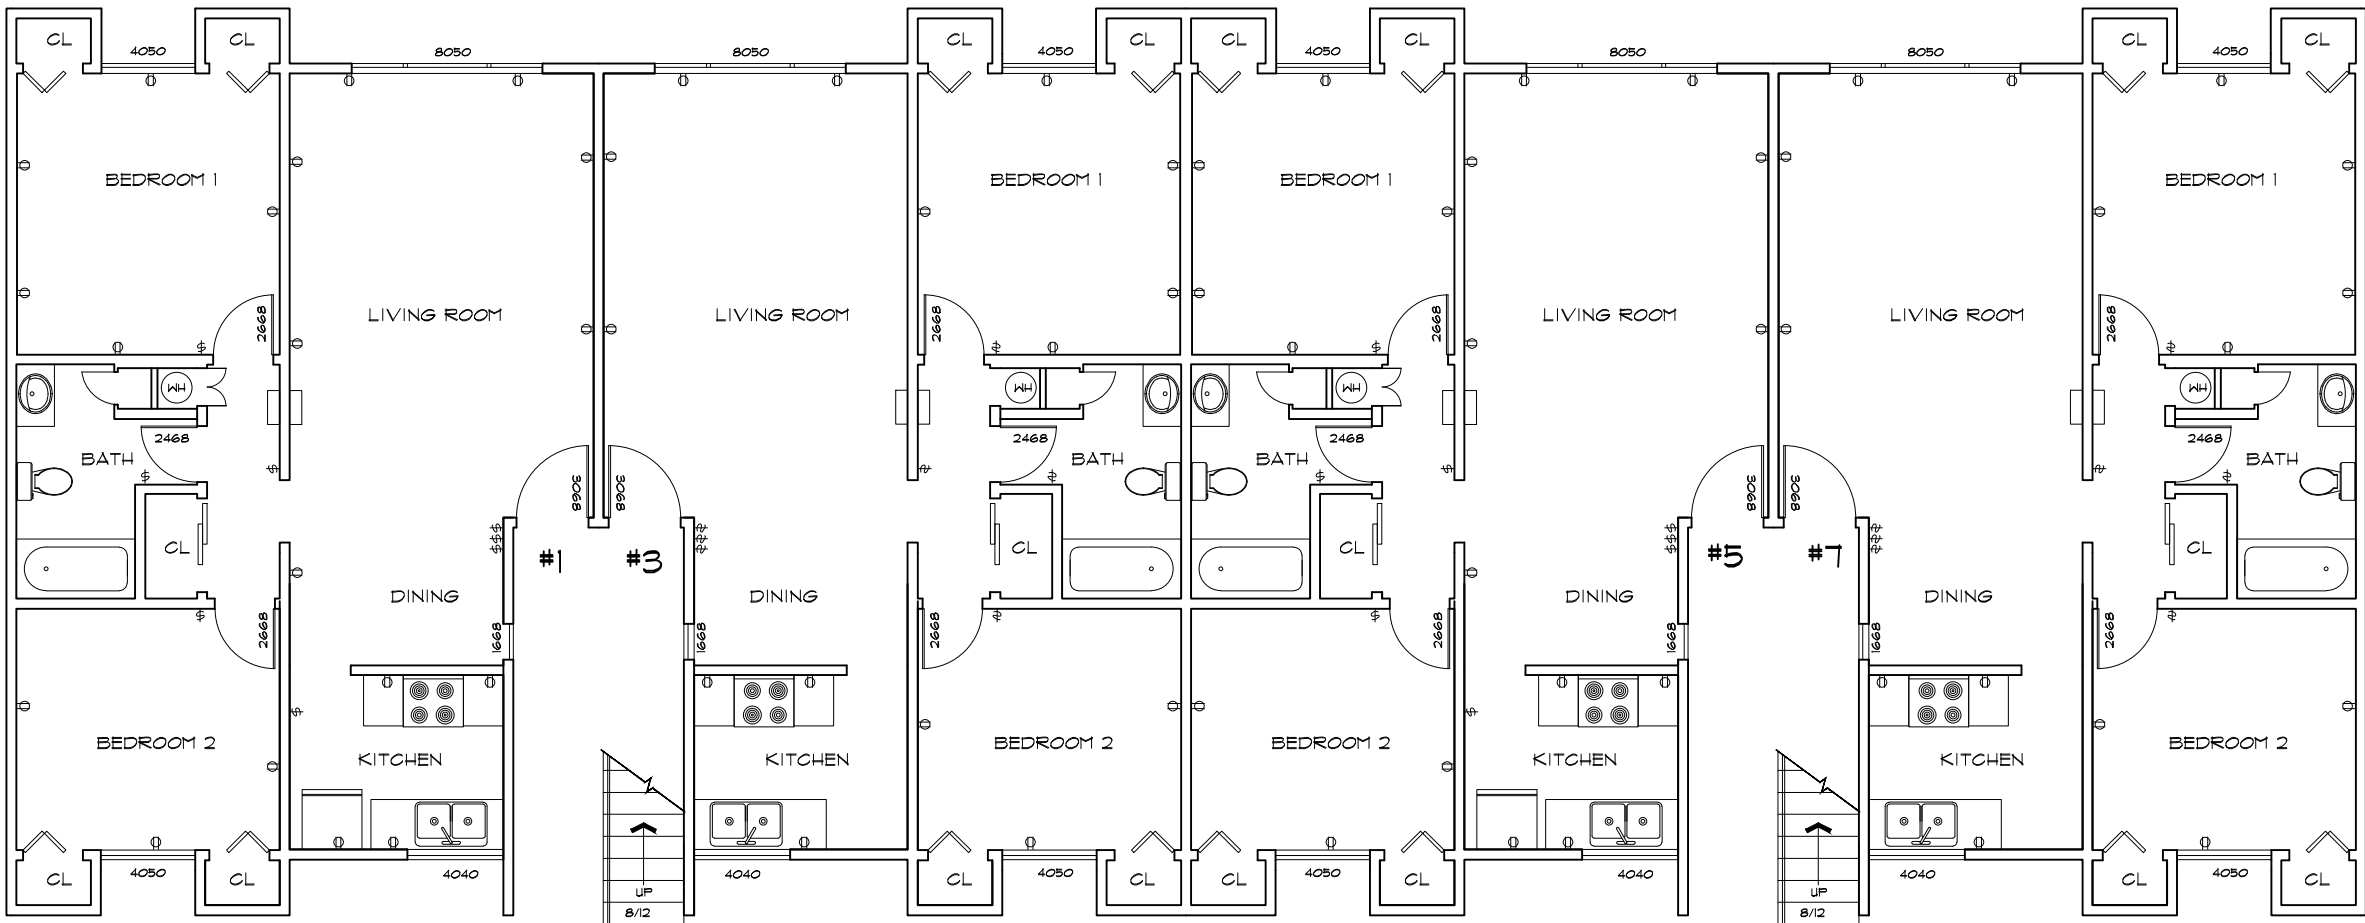

BUILDING 8 FIRST FLOOR PLAN

As BUILT

PROFESSIONALS

www.asbuiltprofessionals.com

A DIVISION OF:

AEC

CONSULTANTS INC

844.272.8458

844 AS BUILT


@ 2019 AEC CONSULTANTS INC

ARCHITECTURAL AS BUILT


HOLIDAY MANOR APARTMENTS

Oxnard, CA 94901

01	100% SUBMISSION	SEE COVER SHEET
NO.	ISSUES REVISIONS	DATE
		SHEET TITLE
HL		PROJECT MANAGER
HL		PROJECT DIRECTOR
012317-1		PROJECT NUMBER
1/8"=1'-0"		SCALE
CL		DRAWN BY
		SHEET NUMBER
AB-8		

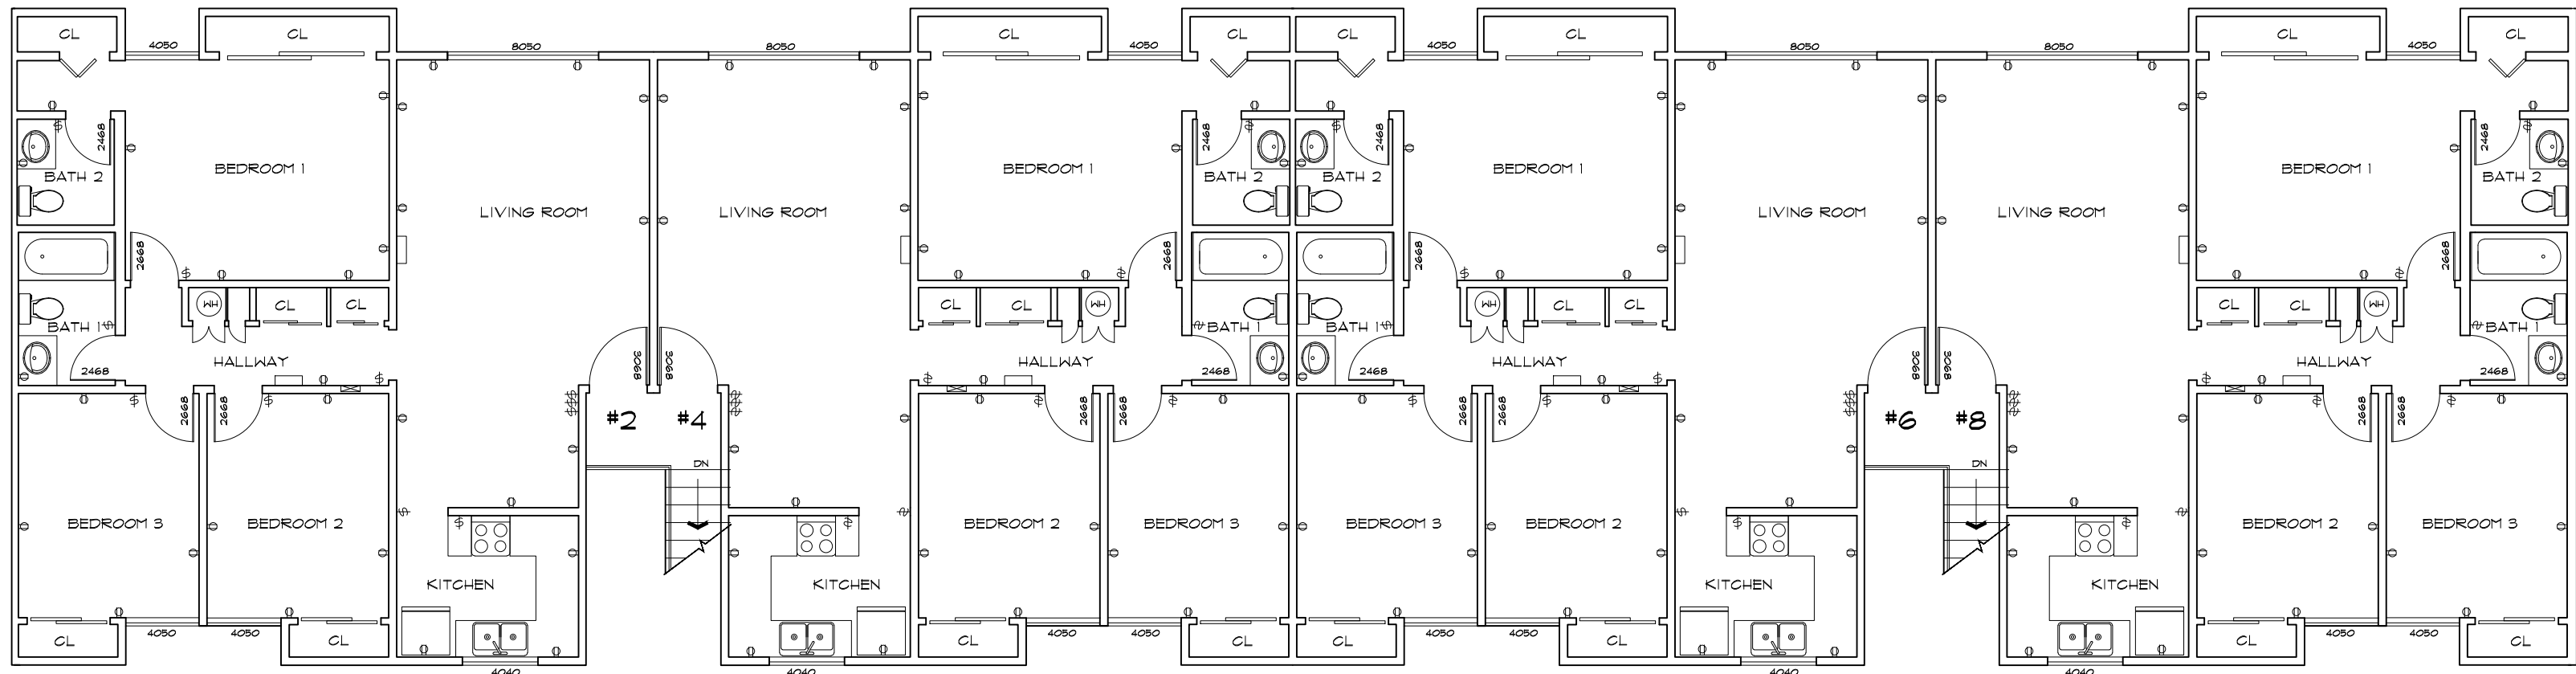

BUILDING 9 SECOND FLOOR PLAN

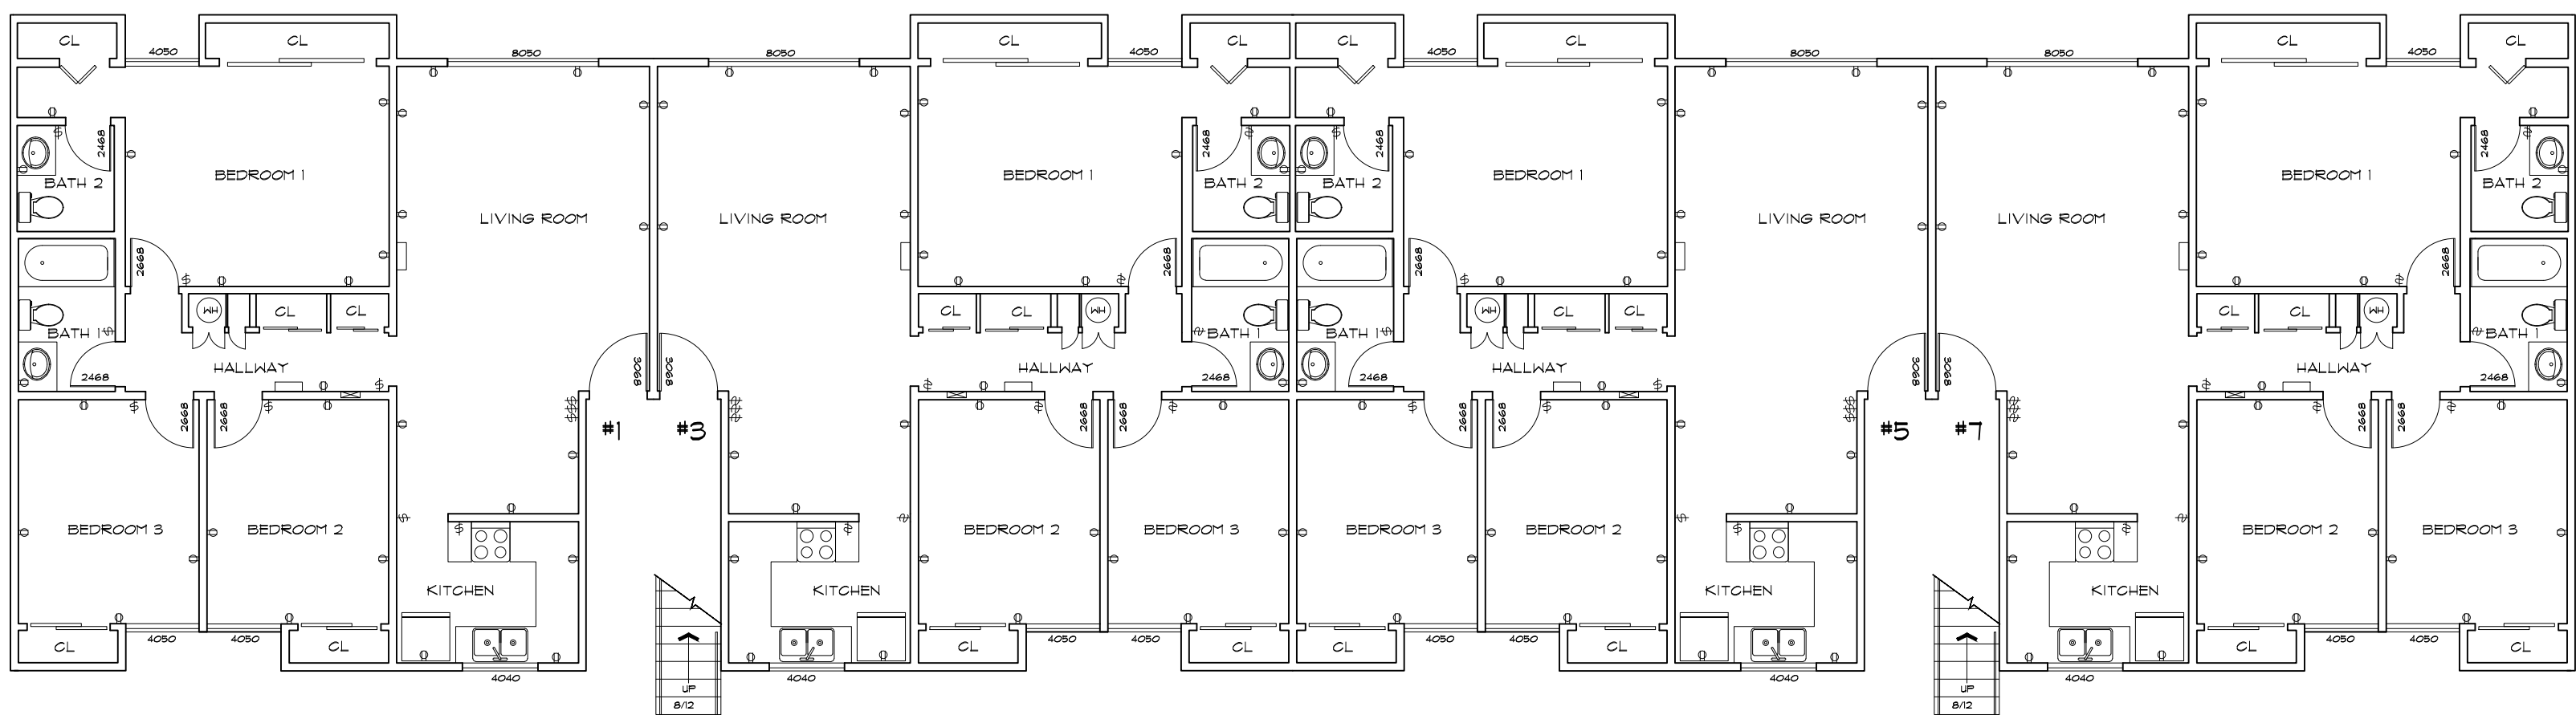

BUILDING 9 FIRST FLOOR PLAN

As BUILT

PROFESSIONALS

www.asbuiltprofessionals.com

A DIVISION OF:

AEC

CONSULTANTS INC

844.272.8458

844 AS BUILT


@ 2019 AEC CONSULTANTS INC

ARCHITECTURAL AS BUILT


HOLIDAY MANOR APARTMENTS

Oxnard, CA 94901

01	100% SUBMISSION	SEE COVER SHEET
NO.	ISSUES REVISIONS	DATE
		SHEET TITLE
HL	PROJECT MANAGER	
HL	PROJECT DIRECTOR	
012317-1	PROJECT NUMBER	
1/8"=1'-0"	SCALE	
CL	DRAWN BY	
	SHEET NUMBER	
AB-9		

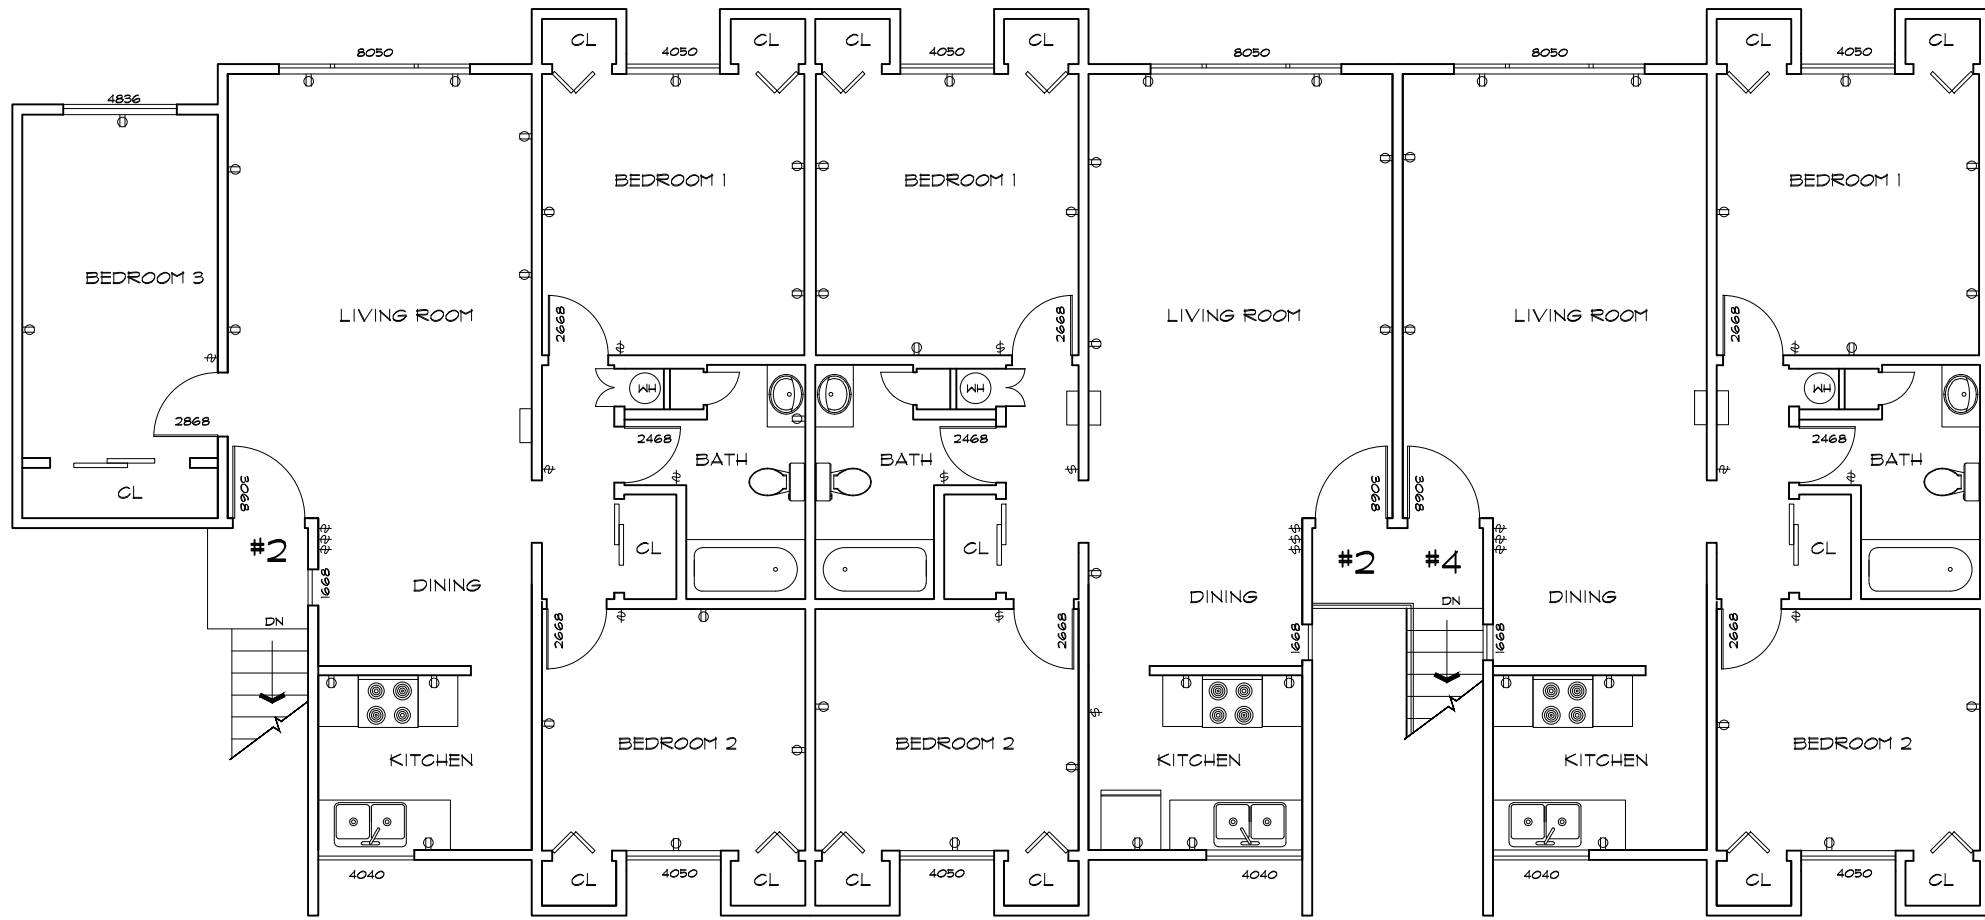

BUILDING 10 SECOND FLOOR PLAN

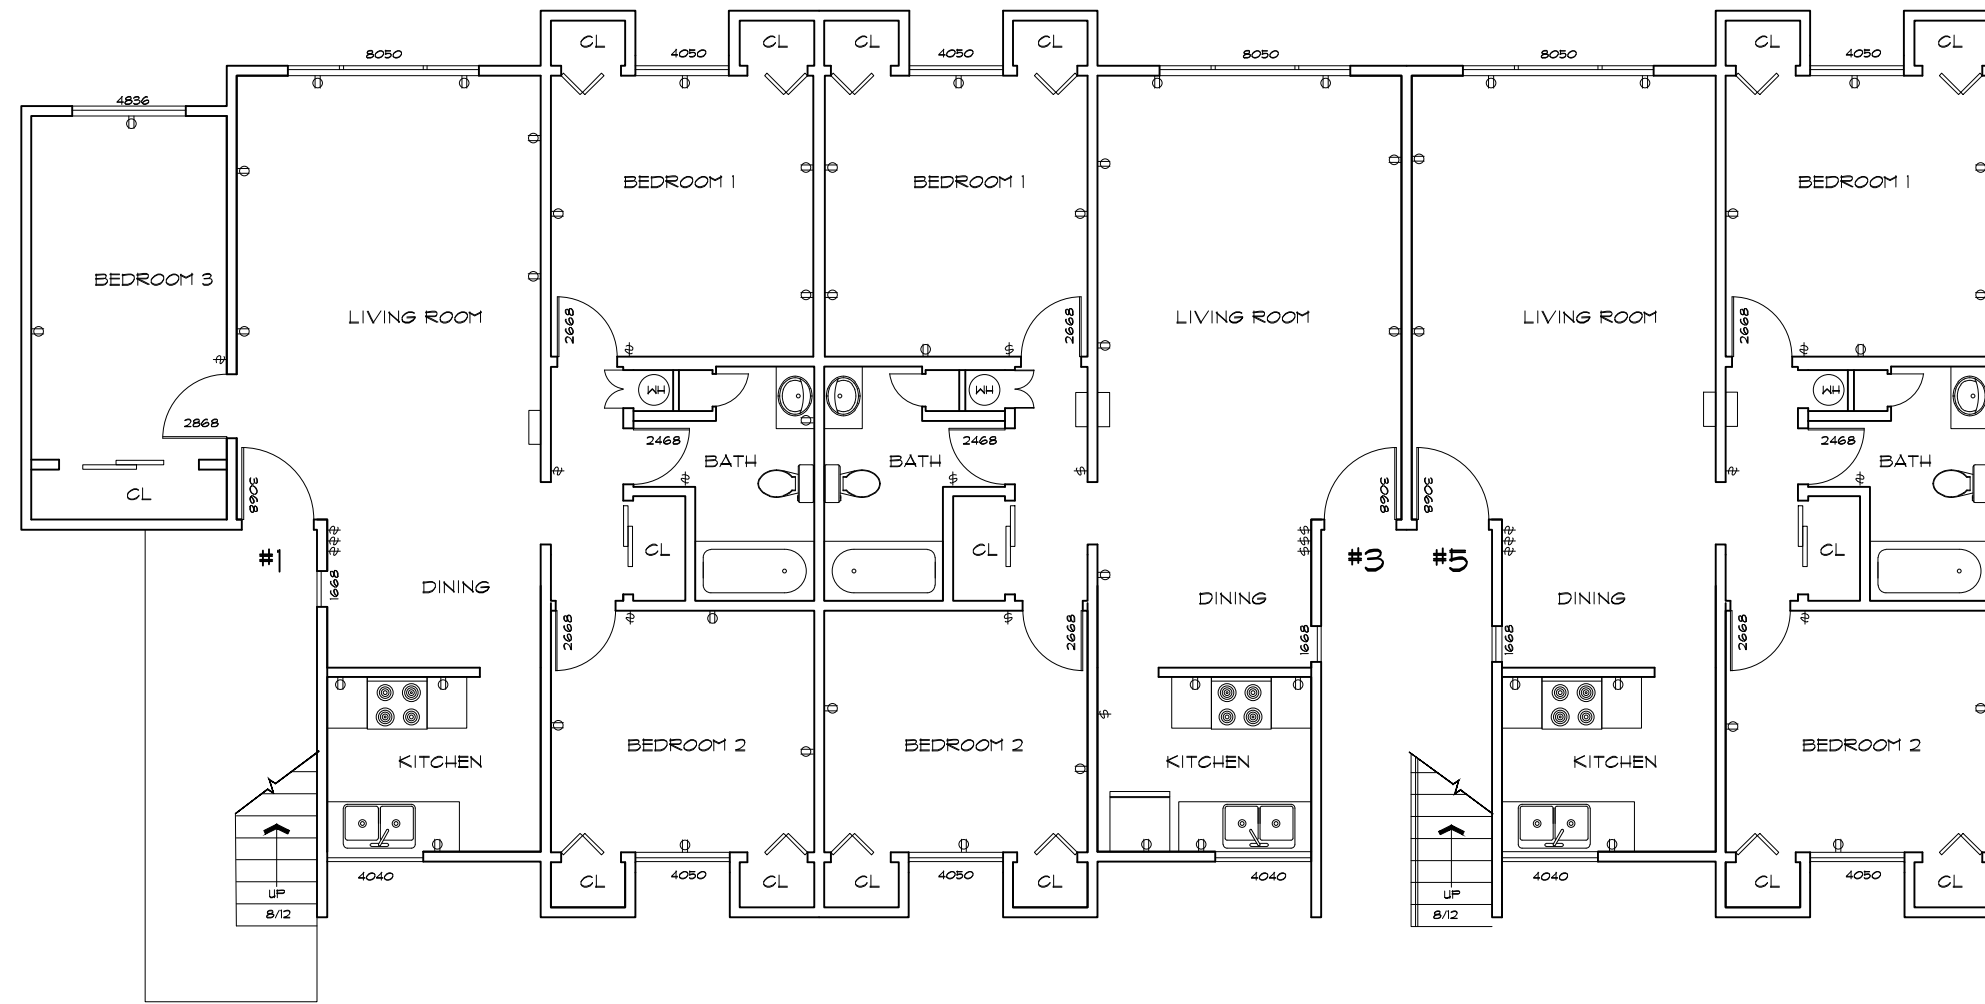

BUILDING 10 FIRST FLOOR PLAN

As BUILT

PROFESSIONALS

www.asbuiltprofessionals.com

A DIVISION OF:

AEC

CONSULTANTS INC

844.272.8458

844 AS BUILT

@ 2019 AEC CONSULTANTS INC

ARCHITECTURAL AS BUILT

HOLIDAY MANOR APARTMENTS

Oxnard, CA 94901


01	100% SUBMISSION	SEE COVER SHEET
NO.	ISSUES REVISIONS	DATE
		SHEET TITLE
HL		PROJECT MANAGER
HL		PROJECT DIRECTOR
012317-1		PROJECT NUMBER
1/8"=1'-0"		SCALE
CL		DRAWN BY
		SHEET NUMBER
AB-10		

ARCHITECTURAL AS BUILT


HOLIDAY MANOR APARTMENTS

Oxnard, CA 94901

01	100% SUBMISSION	SEE COVER SHEET
NO.	ISSUES REVISIONS	DATE
		SHEET TITLE
HL	PROJECT MANAGER	
HL	PROJECT DIRECTOR	
012317-1	PROJECT NUMBER	
1/8"=1'-0"	SCALE	
CL	DRAWN BY	
	SHEET NUMBER	

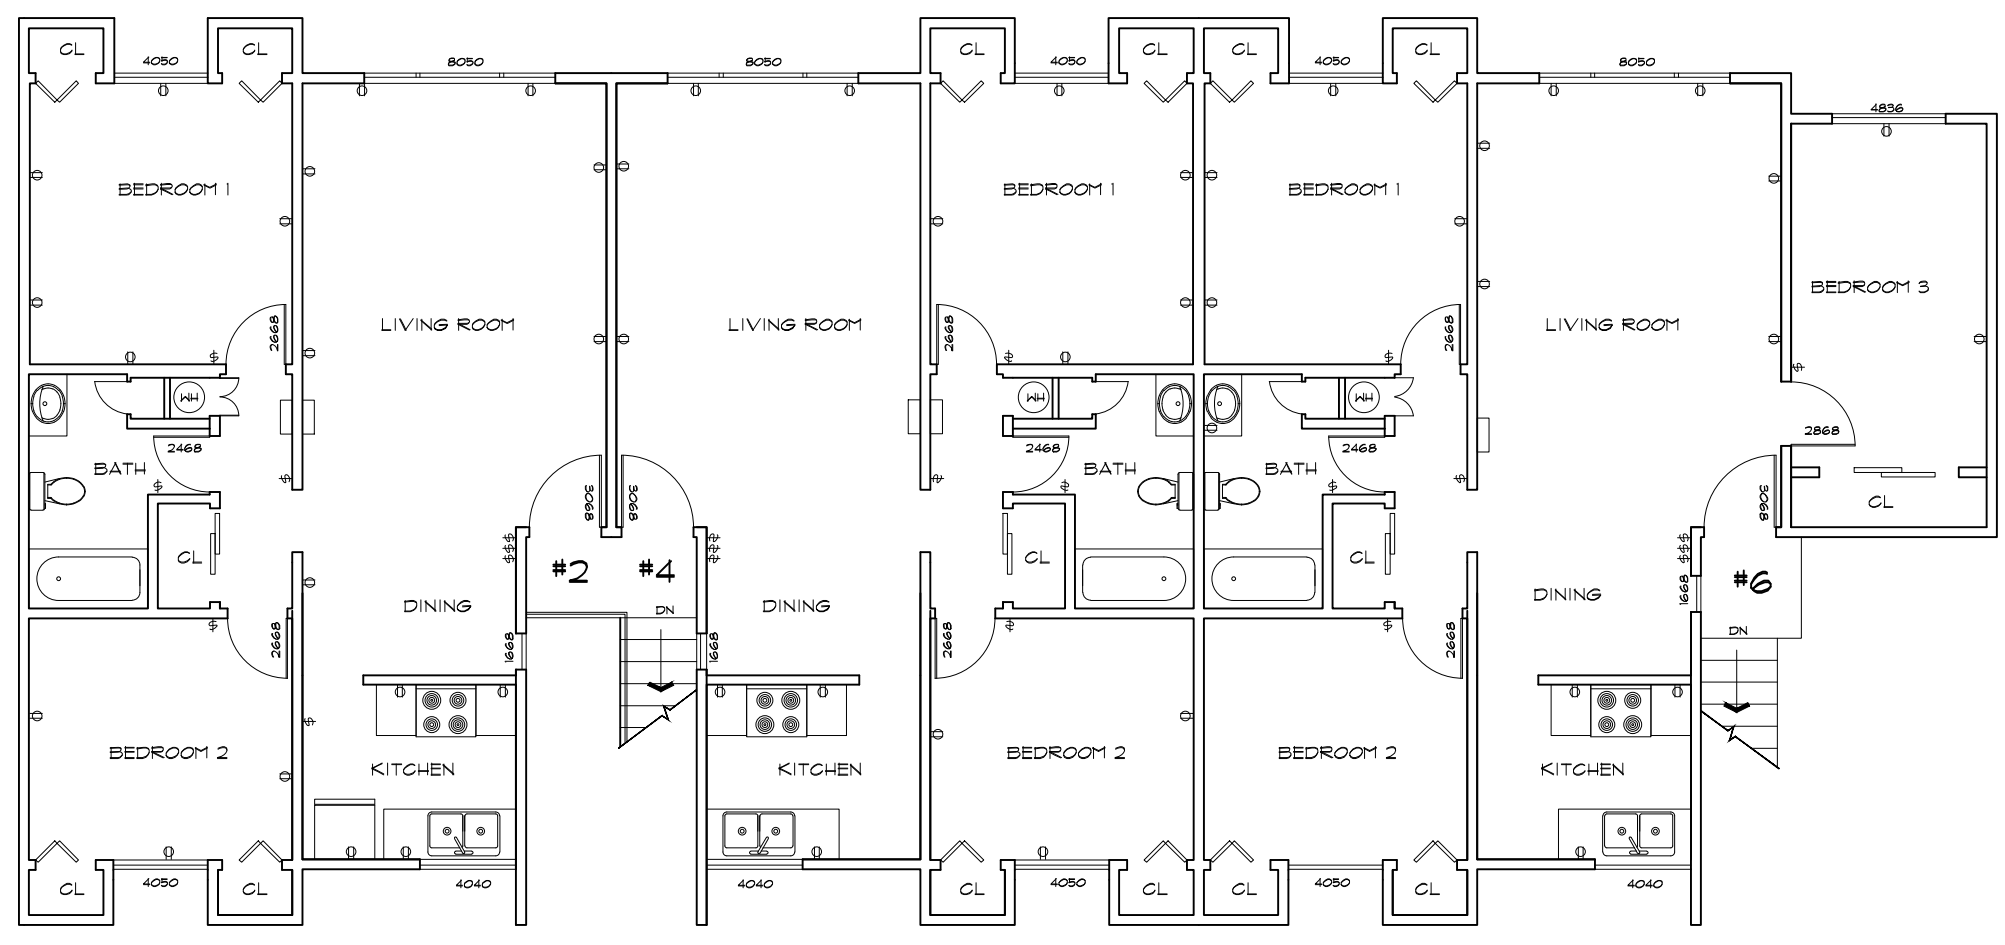

BUILDING 11 SECOND FLOOR PLAN

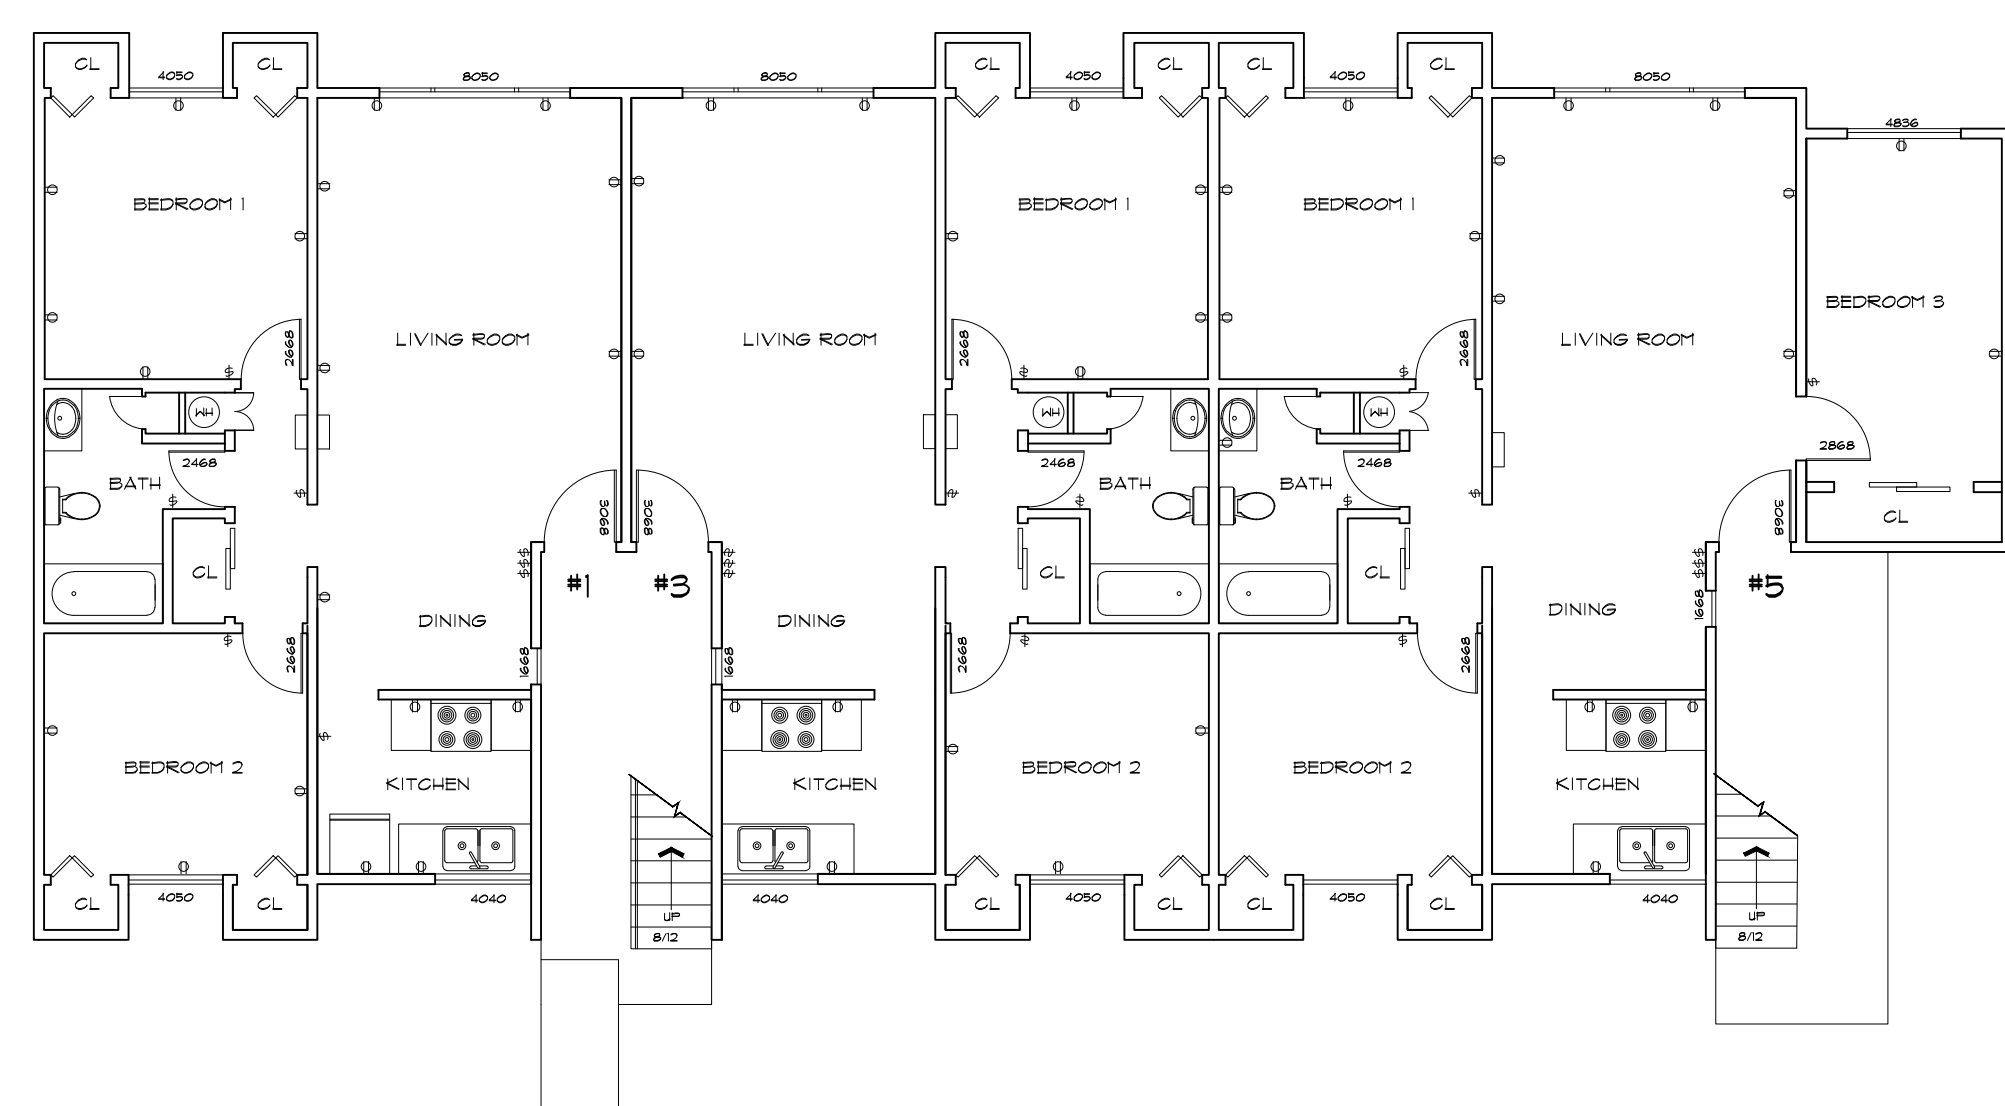

BUILDING 11 FIRST FLOOR PLAN

As BUILT

PROFESSIONALS

www.asbuiltprofessionals.com

A DIVISION OF:


AEC

CONSULTANTS INC


844.272.8458

844 AS BUILT

@ 2019 AEC CONSULTANTS INC

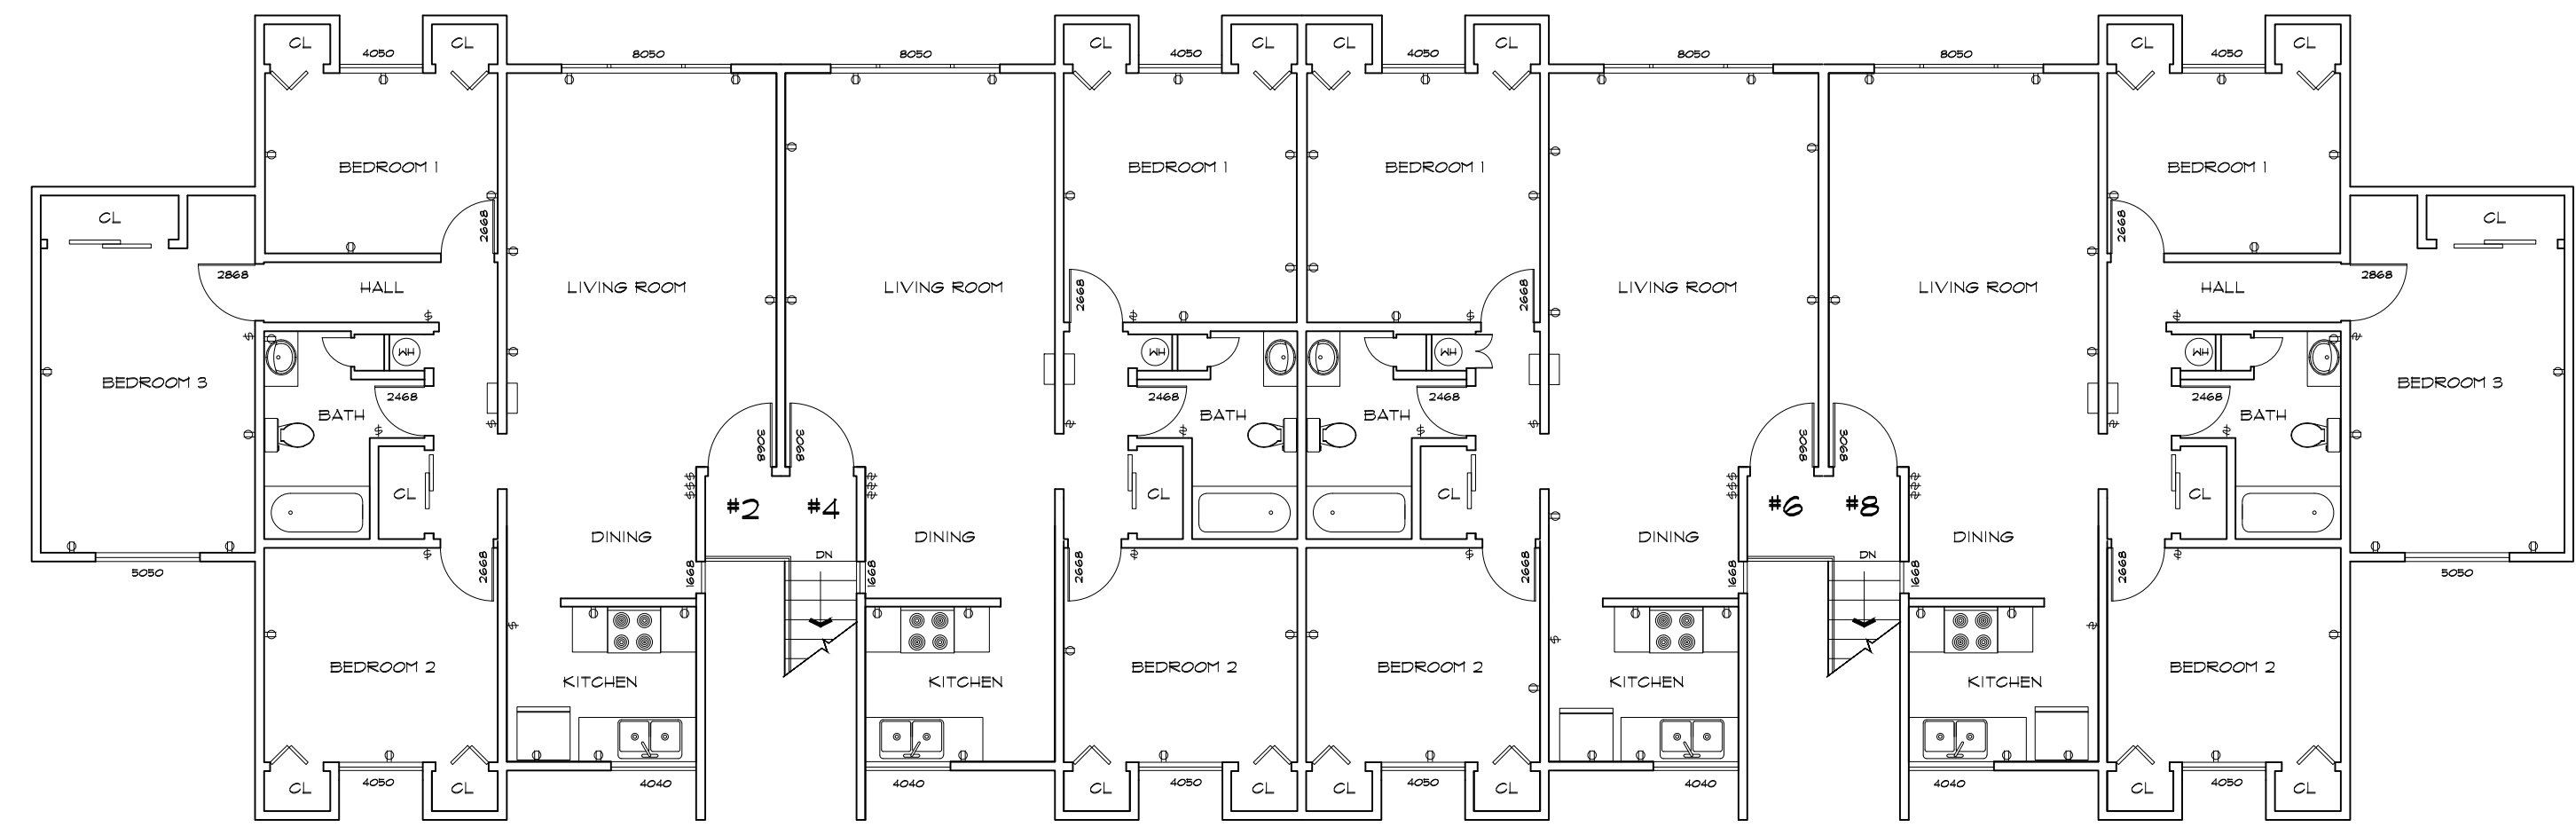

BUILDING 12 SECOND FLOOR PLAN

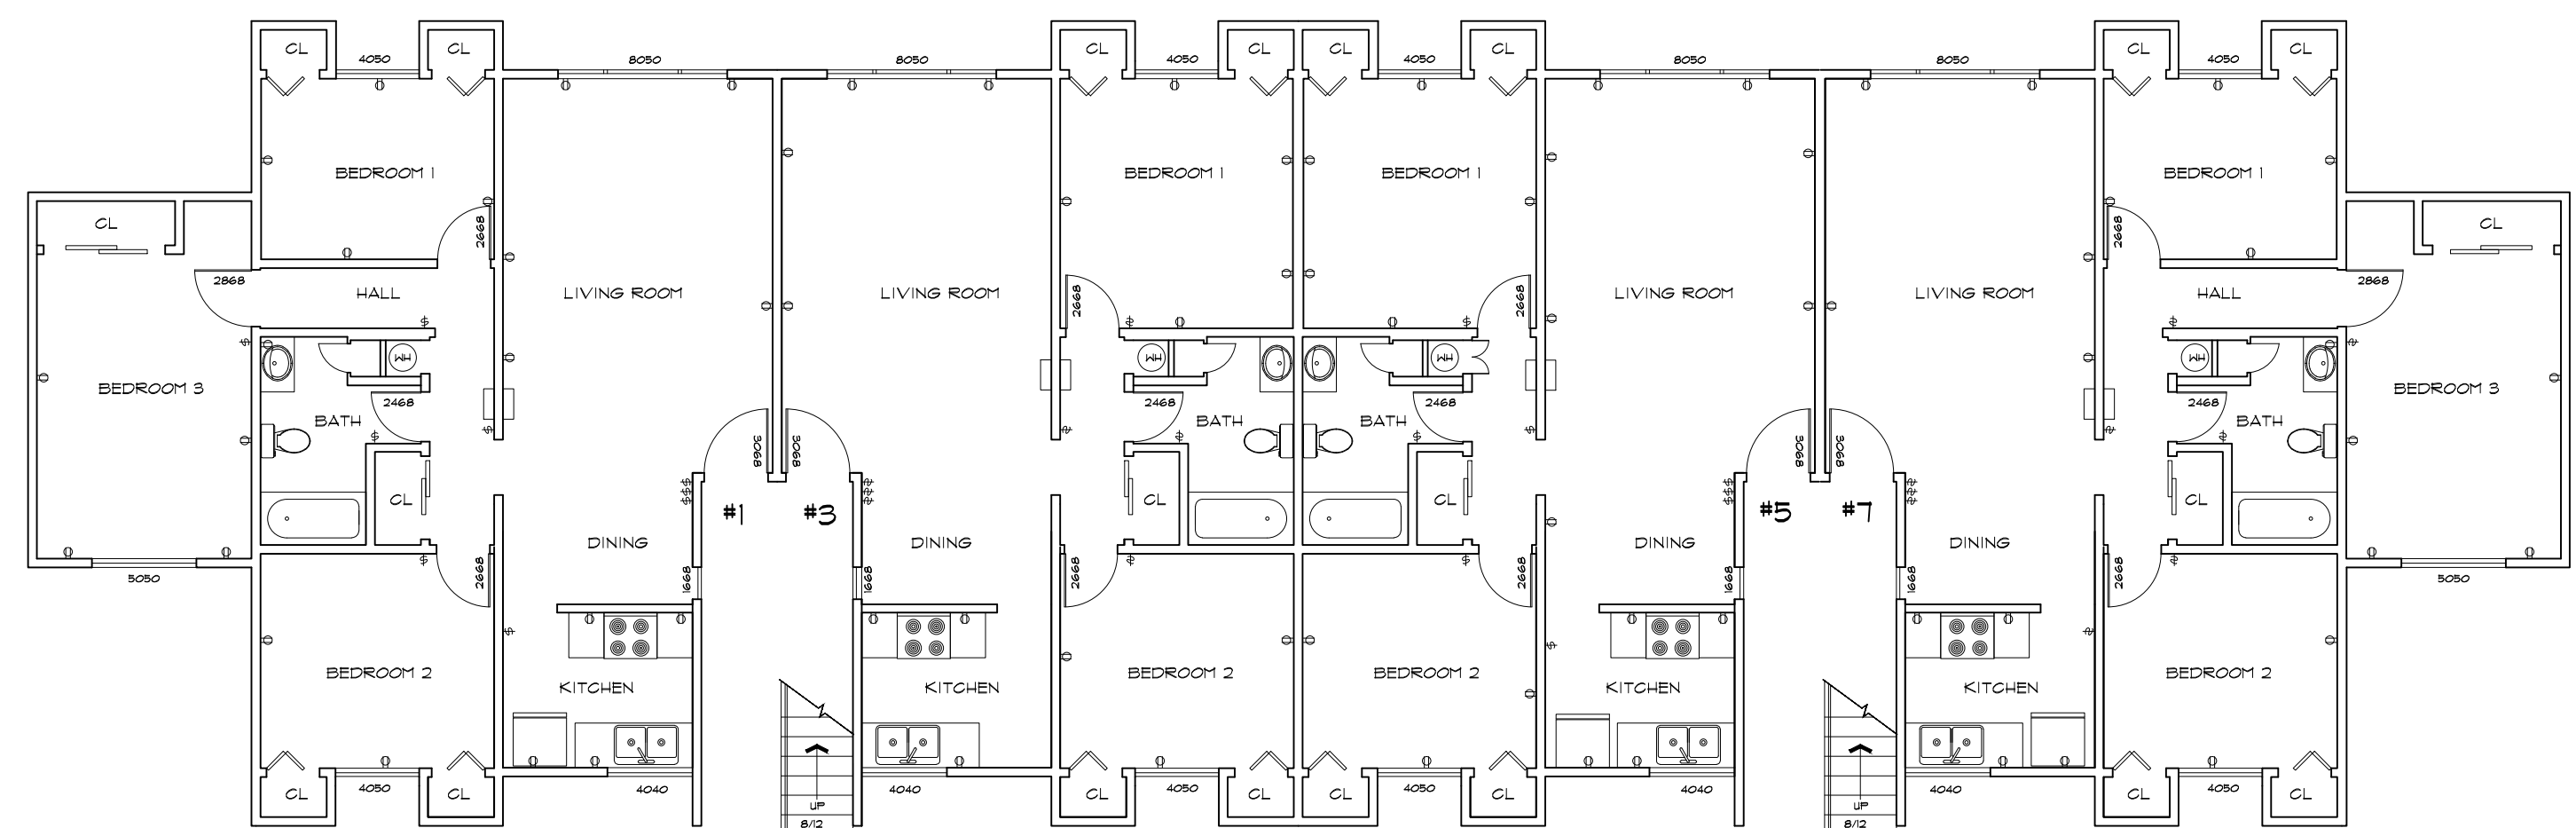


BUILDING 12 FIRST FLOOR PLAN

ARCHITECTURAL AS BUILT


HOLIDAY MANOR APARTMENTS

Oxnard, CA 94901

01	100% SUBMISSION	SEE COVER SHEET
NO.	ISSUES REVISIONS	DATE
		SHEET TITLE
HL	PROJECT MANAGER	
HL	PROJECT DIRECTOR	
012317-1	PROJECT NUMBER	
1/8"=1'-0"	SCALE	
CL	DRAWN BY	
		SHEET NUMBER
AB-12		

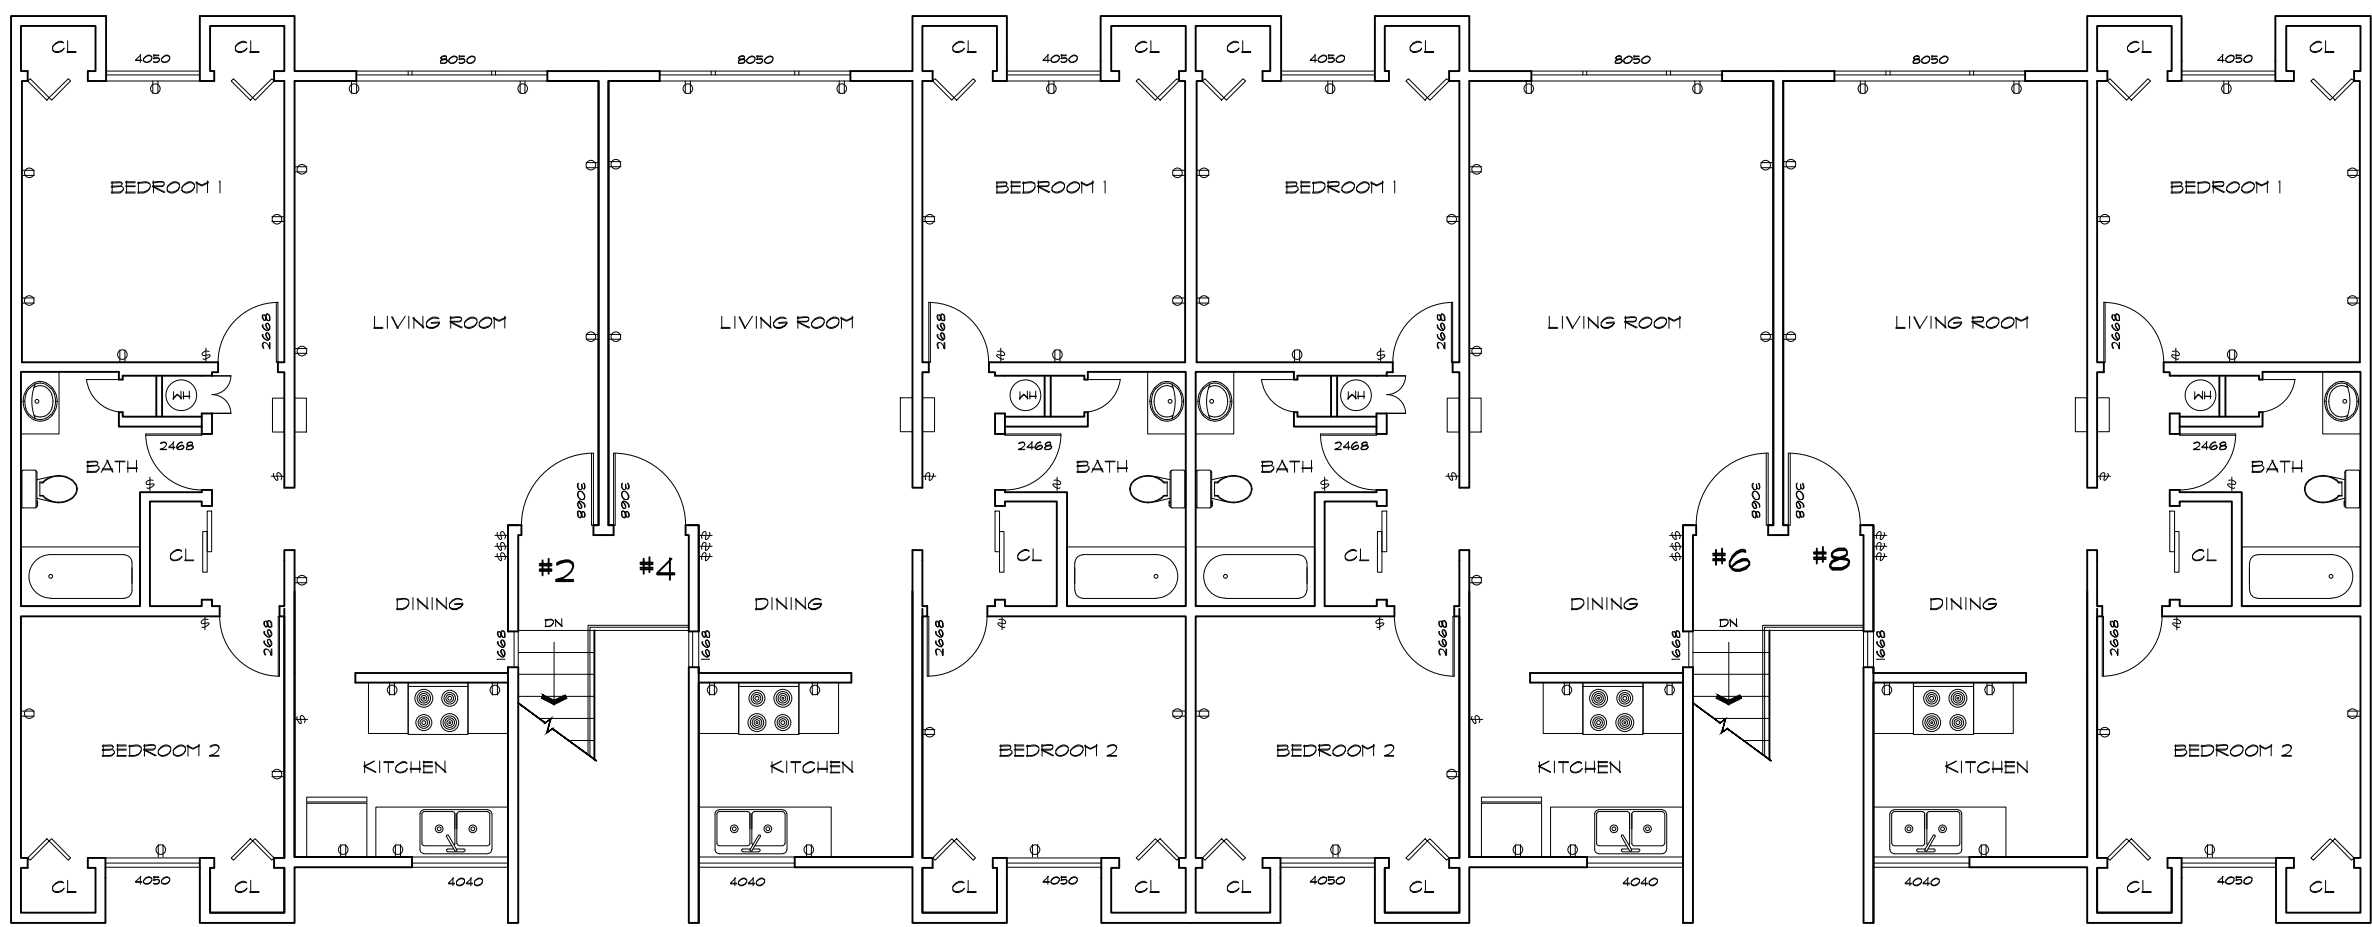

BUILDING 14 SECOND FLOOR PLAN

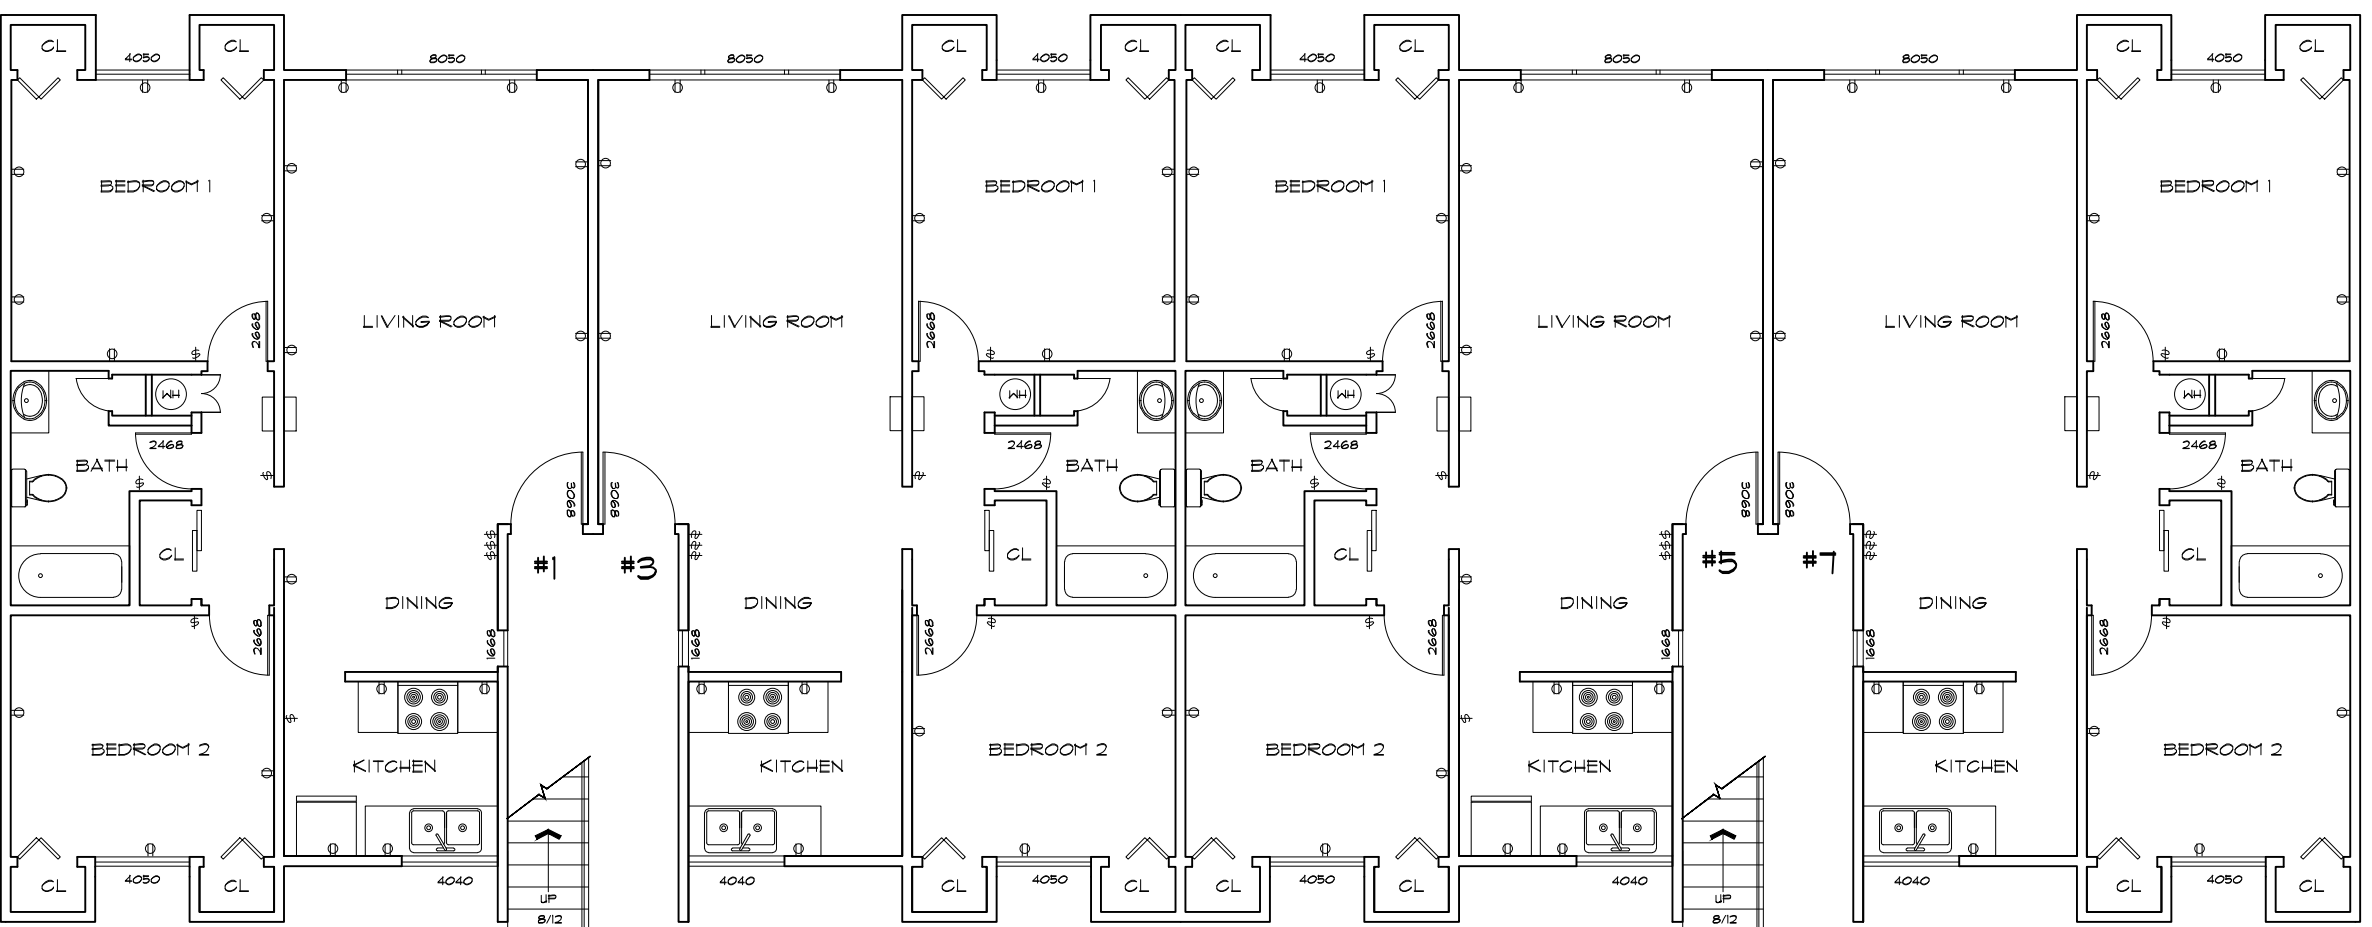

BUILDING 14 FIRST FLOOR PLAN

As BUILT

PROFESSIONALS

www.asbuiltprofessionals.com

A DIVISION OF:

AEC

CONSULTANTS INC

844.272.8458

844 AS BUILT

@ 2019 AEC CONSULTANTS INC

ARCHITECTURAL AS BUILT

HOLIDAY MANOR APARTMENTS

Oxnard, CA 94901

01	100% SUBMISSION	SEE COVER SHEET
NO.	ISSUES REVISIONS	DATE
		SHEET TITLE
HL		PROJECT MANAGER
HL		PROJECT DIRECTOR
012317-1		PROJECT NUMBER
1/8"=1'-0"		SCALE
CL		DRAWN BY
		SHEET NUMBER
AB-14		




ARCHITECTURAL AS BUILT


HOLIDAY MANOR APARTMENTS

Oxnard, CA 94901

AB-15

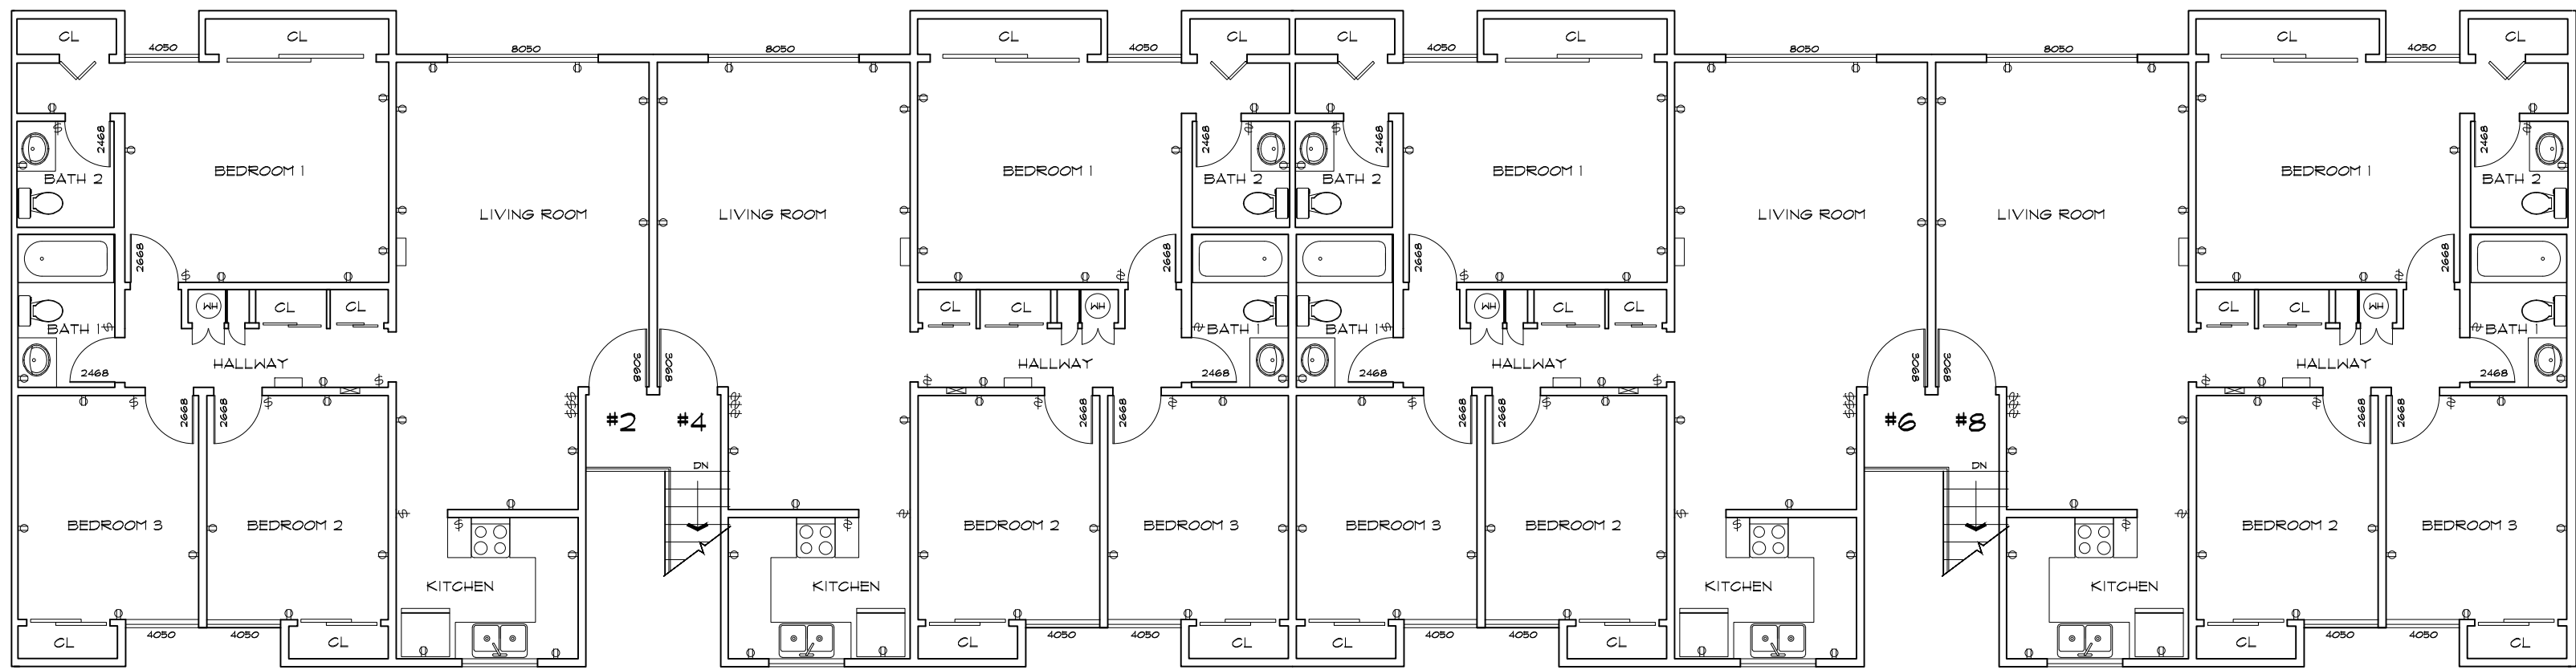

BUILDING 16 SECOND FLOOR PLAN

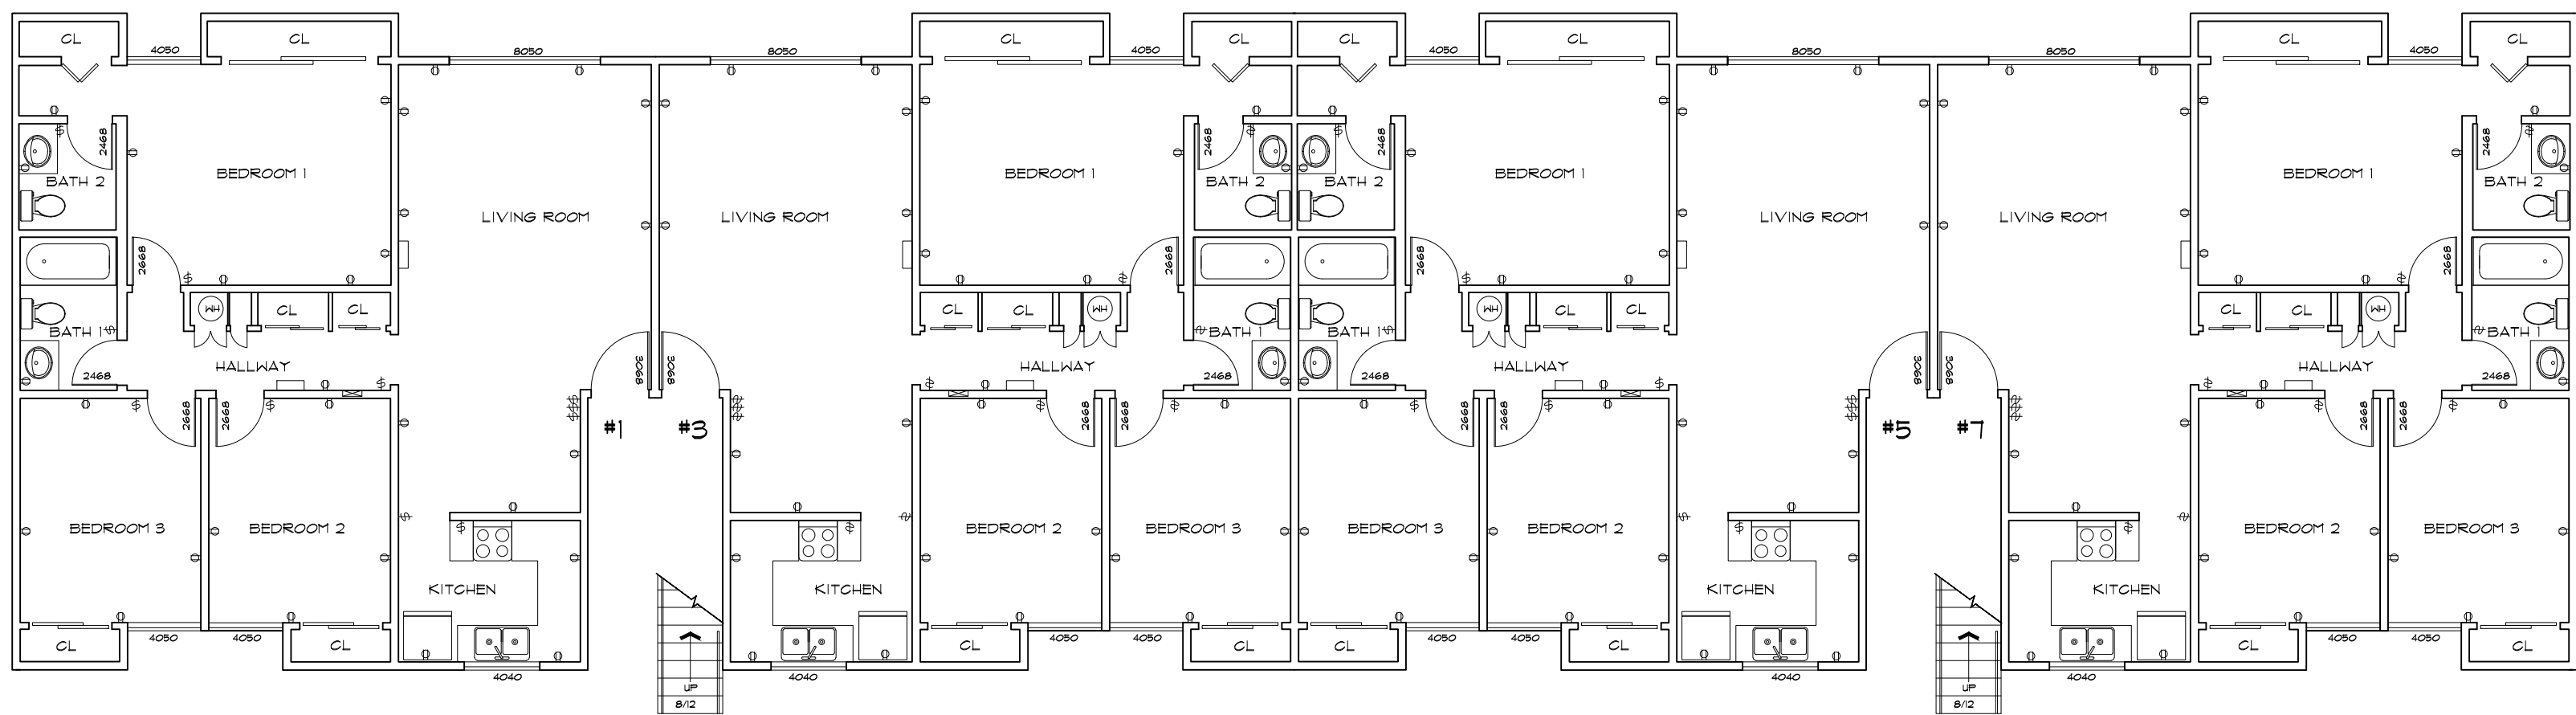

BUILDING 16 FIRST FLOOR PLAN

ARCHITECTURAL AS BUILT

HOLIDAY MANOR APARTMENTS

Oxnard, CA 94901

01	100% SUBMISSION	SEE COVER SHEET
NO.	ISSUES REVISIONS	DATE
		SHEET TITLE
HL	PROJECT MANAGER	
HL	PROJECT DIRECTOR	
012317-1	PROJECT NUMBER	
1/8"=1'-0"	SCALE	
CL	DRAWN BY	
		SHEET NUMBER

[illegible]

01	100% SUBMISSION	SEE COVER SHEET
NO.	ISSUES REVISIONS	DATE
		SHEET TITLE
HL		PROJECT MANAGER
HL		PROJECT DIRECTOR
012317-1		PROJECT NUMBER
1/8"=1'-0"		SCALE
CL		DRAWN BY
		SHEET NUMBER

As BUILT

PROFESSIONALS

www.asbuiltprofessionals.com

A DIVISION OF:

AEC

CONSULTANTS INC

844.272.8458

844 AS BUILT


© 2019 AEC CONSULTANTS INC

ARCHITECTURAL AS BUILT


HOLIDAY MANOR APARTMENTS

Oxnard, CA 94901

01	100% SUBMISSION	SEE COVER SHEET
NO.	ISSUES REVISIONS	DATE
		SHEET TITLE
HL		PROJECT MANAGER
HL		PROJECT DIRECTOR
012317-1		PROJECT NUMBER
1/8"=1'-0"		SCALE
CL		DRAWN BY
		SHEET NUMBER
AB-18		

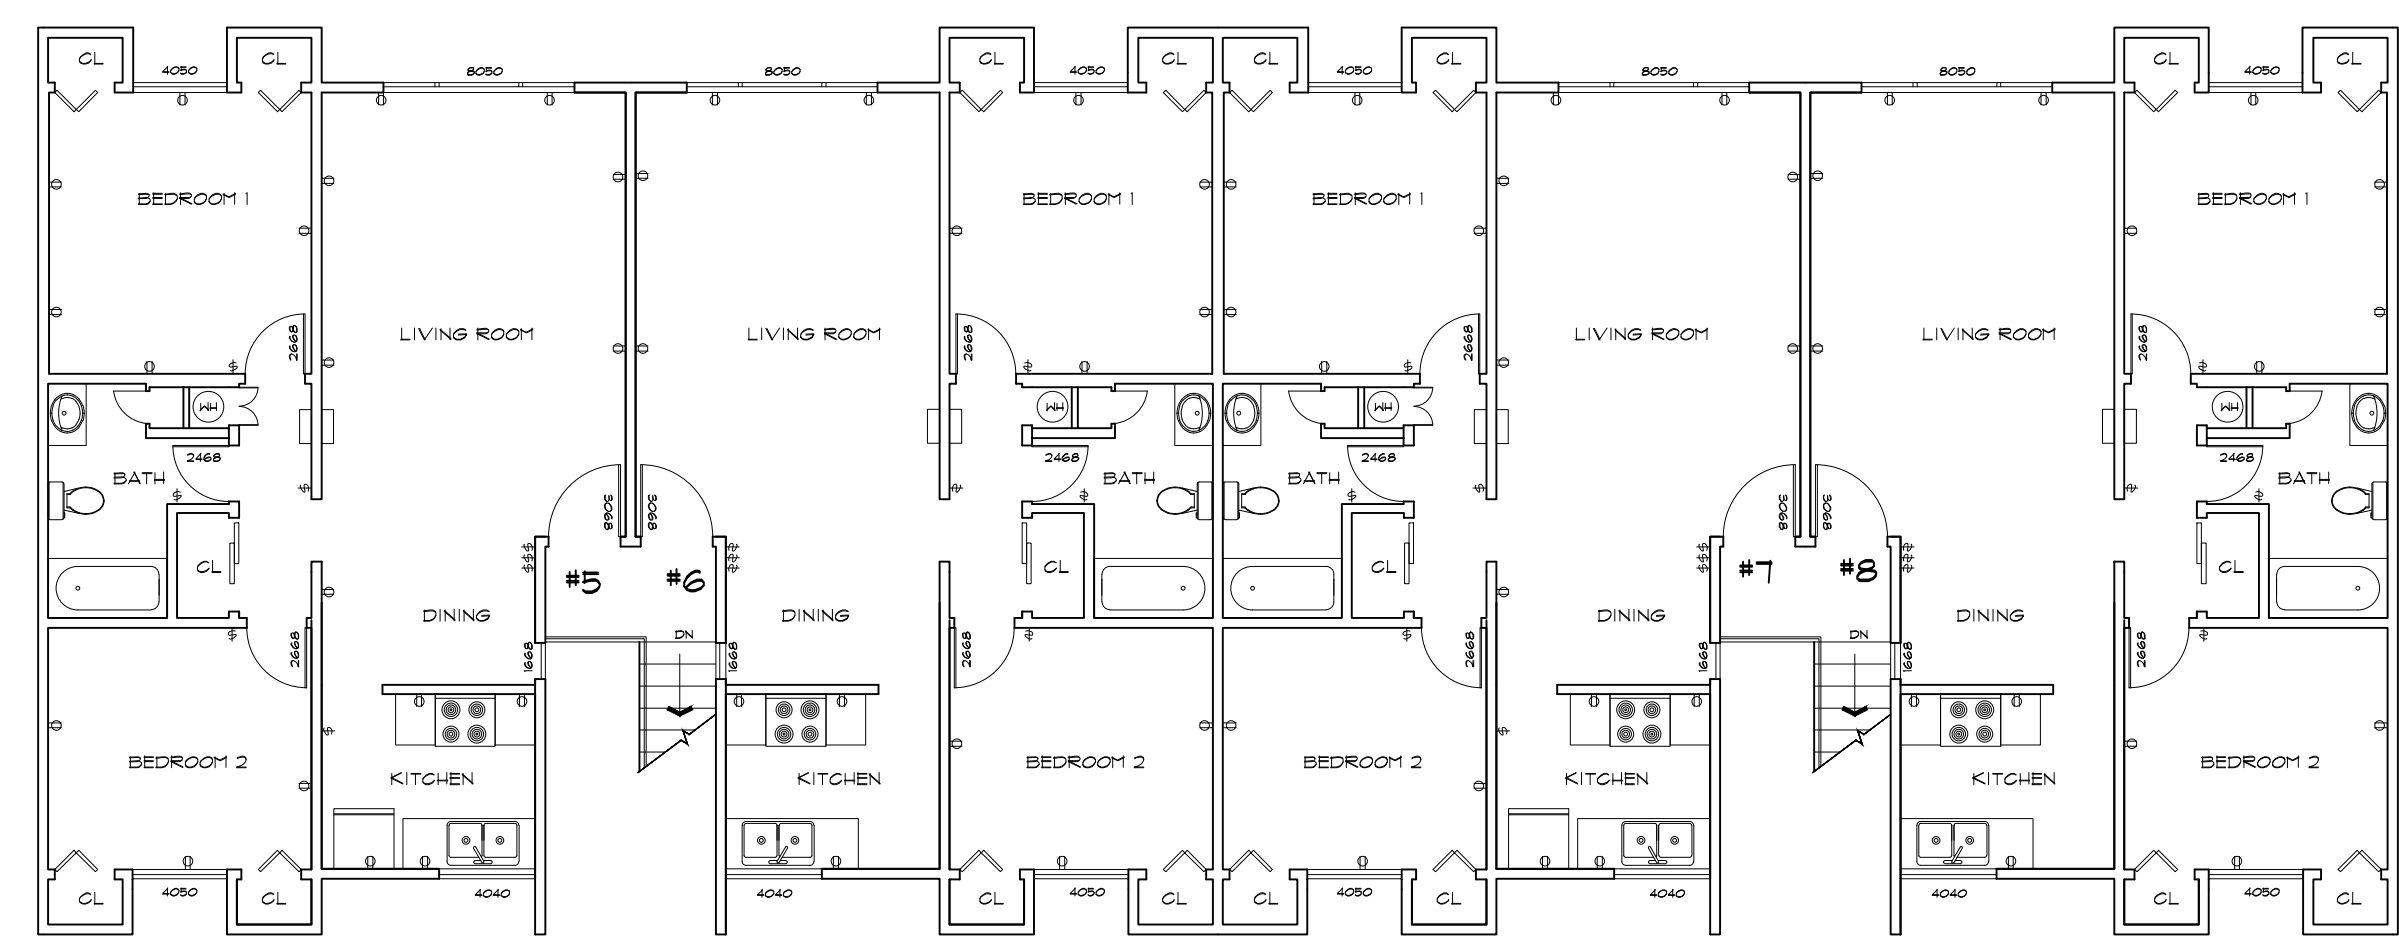

BUILDING 20 SECOND FLOOR PLAN

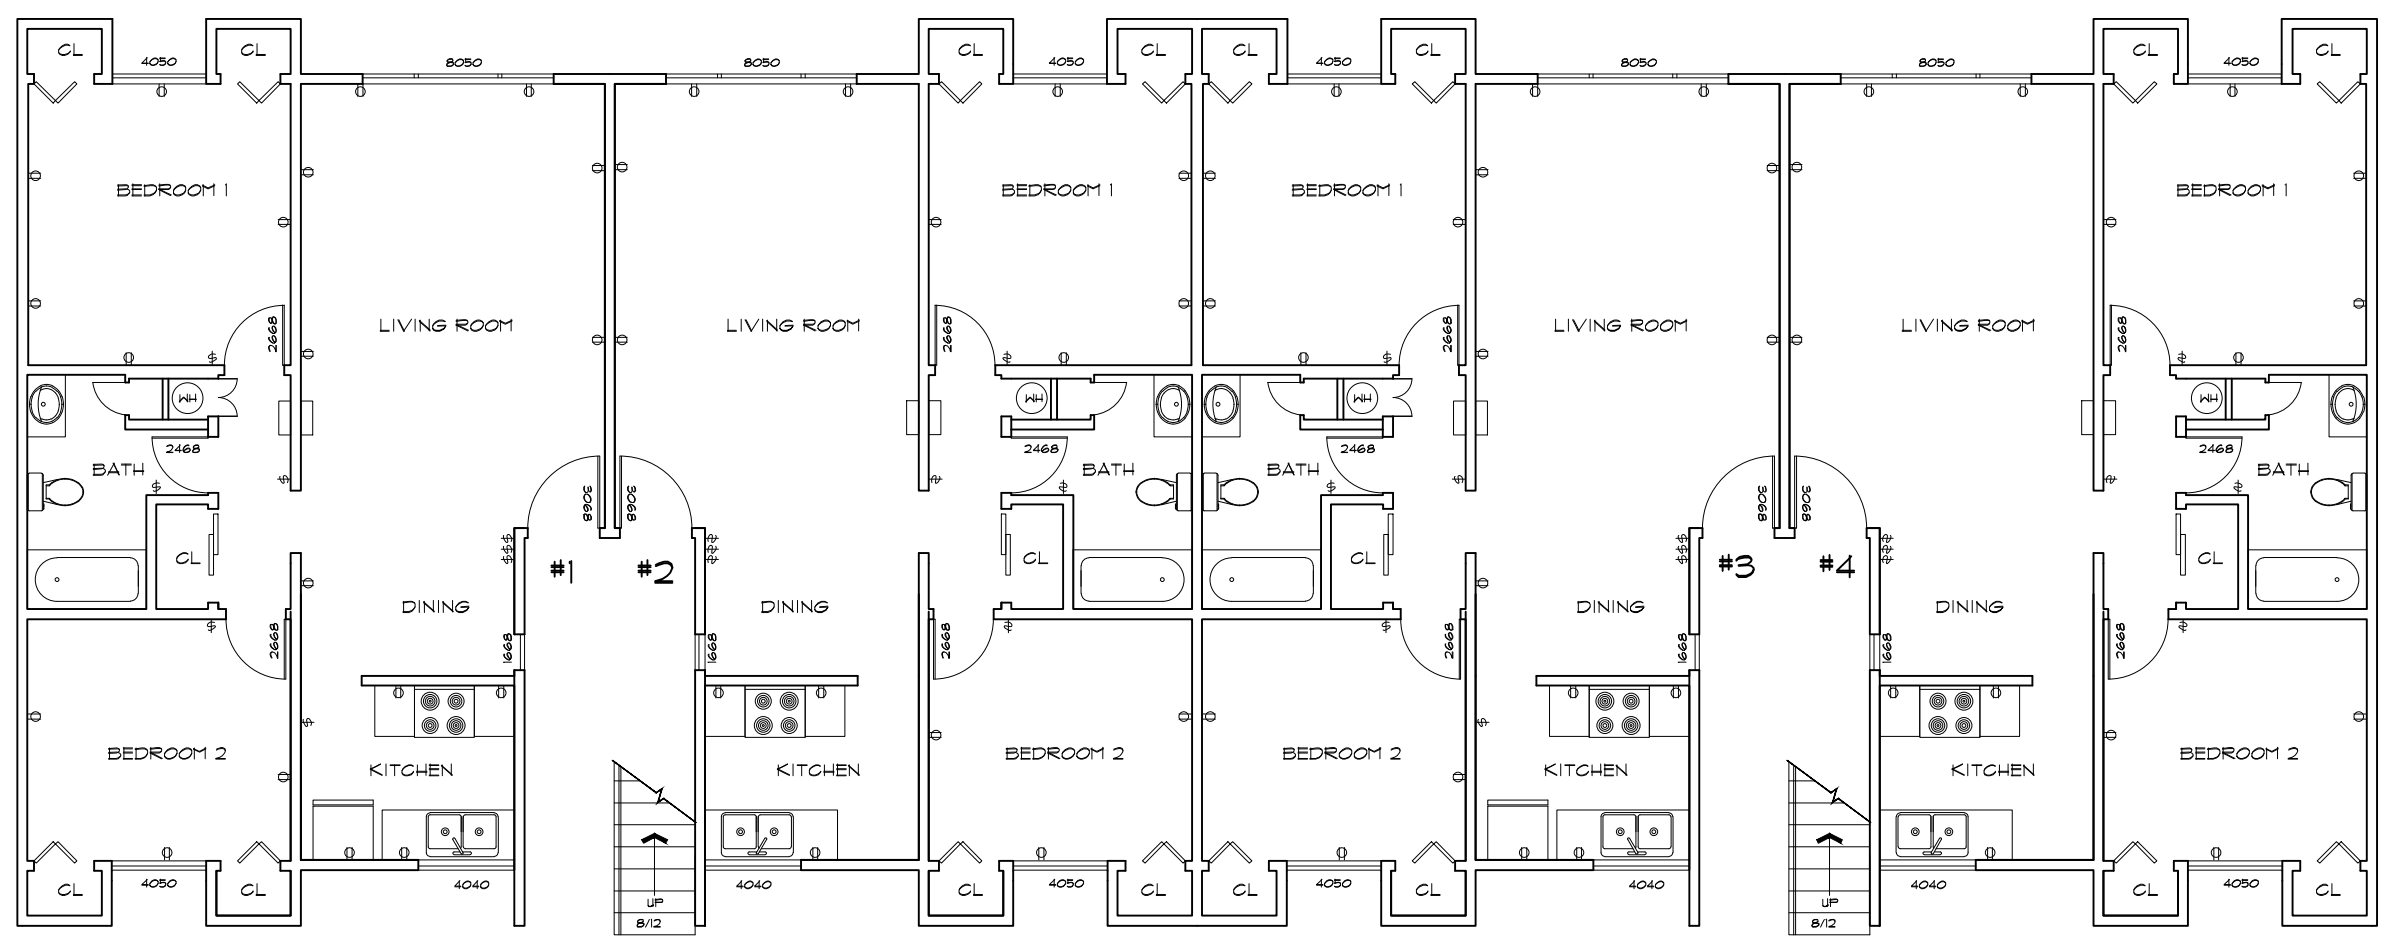


BUILDING 20 FIRST FLOOR PLAN

ARCHITECTURAL AS BUILT

HOLIDAY MANOR APARTMENTS

Oxnard, CA 94901

01	100% SUBMISSION	SEE COVER SHEET
NO.	ISSUES REVISIONS	DATE
		SHEET TITLE
HL		PROJECT MANAGER
HL		PROJECT DIRECTOR
012317-1		PROJECT NUMBER
1/8"=1'-0"		SCALE
CL		DRAWN BY
		SHEET NUMBER
AB-20		

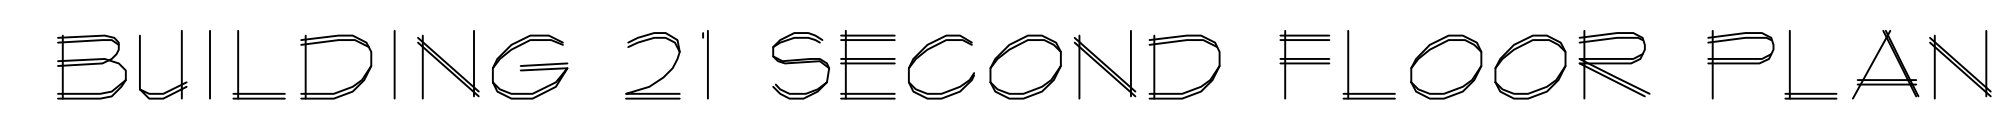


ARCHITECTURAL AS BUILT


HOLIDAY MANOR APARTMENTS

Oxnard, CA 94901

01	100% SUBMISSION	SEE COVER SHEET
NO.	ISSUES REVISIONS	DATE
		SHEET TITLE
HL	PROJECT MANAGER	
HL	PROJECT DIRECTOR	
012317-1	PROJECT NUMBER	
1/8"=1'-0"		SCALE
CL	DRAWN BY	
		SHEET NUMBER
AB-21		

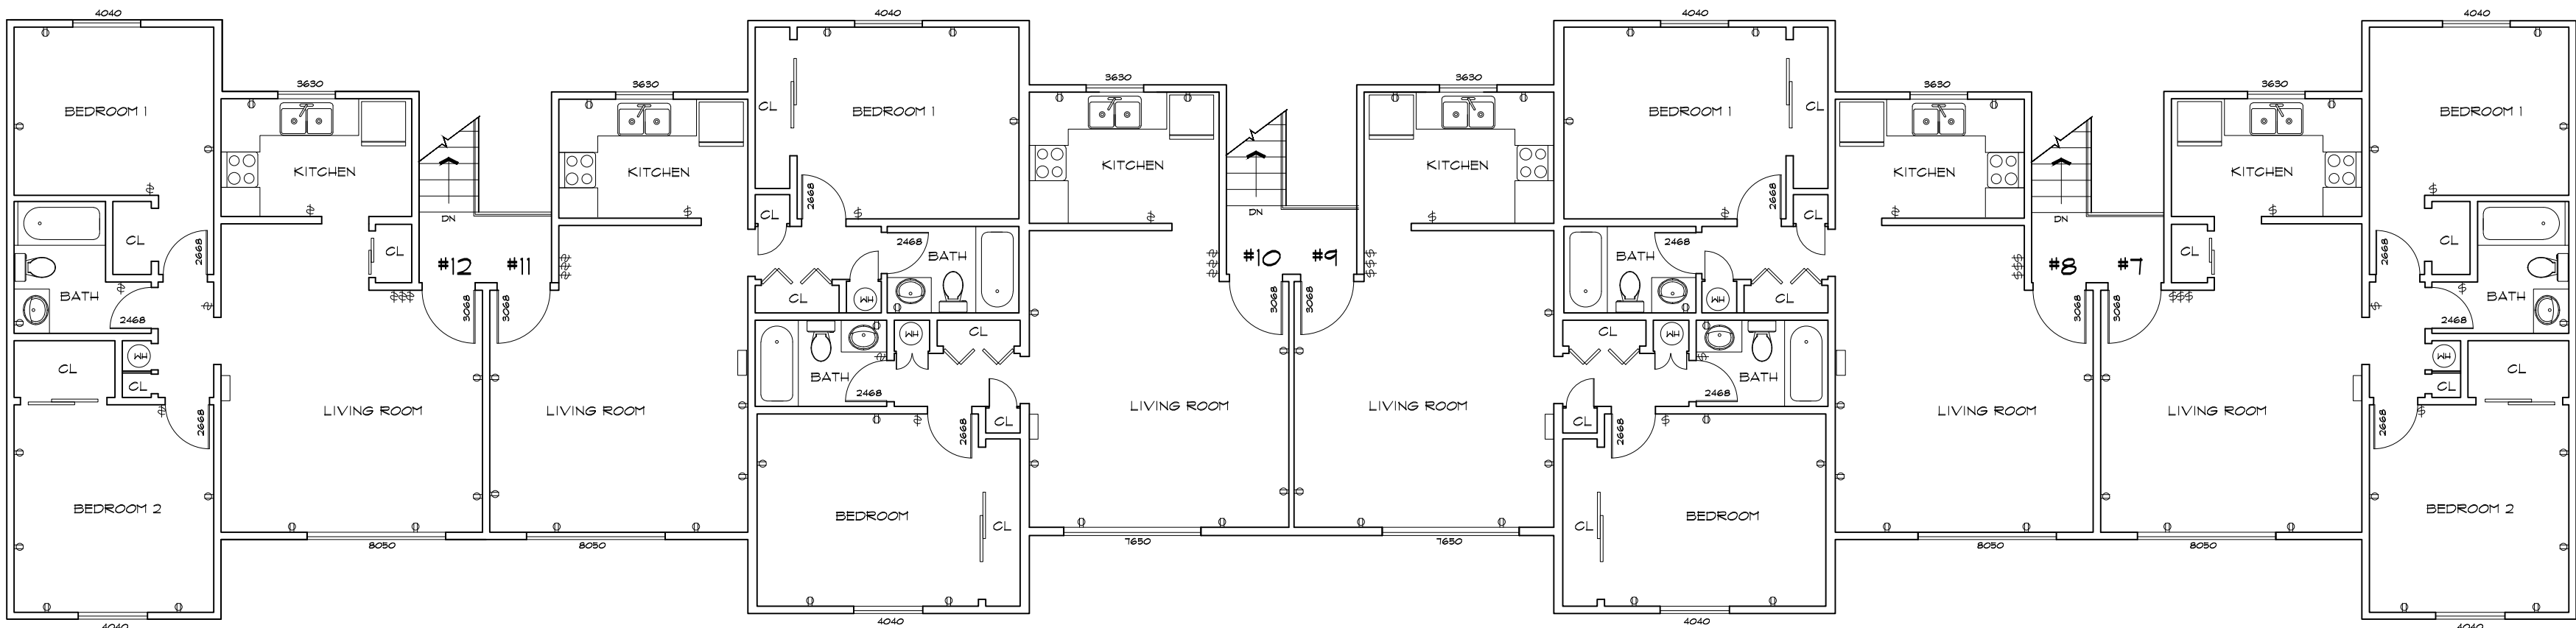

BUILDING 22 SECOND FLOOR PLAN

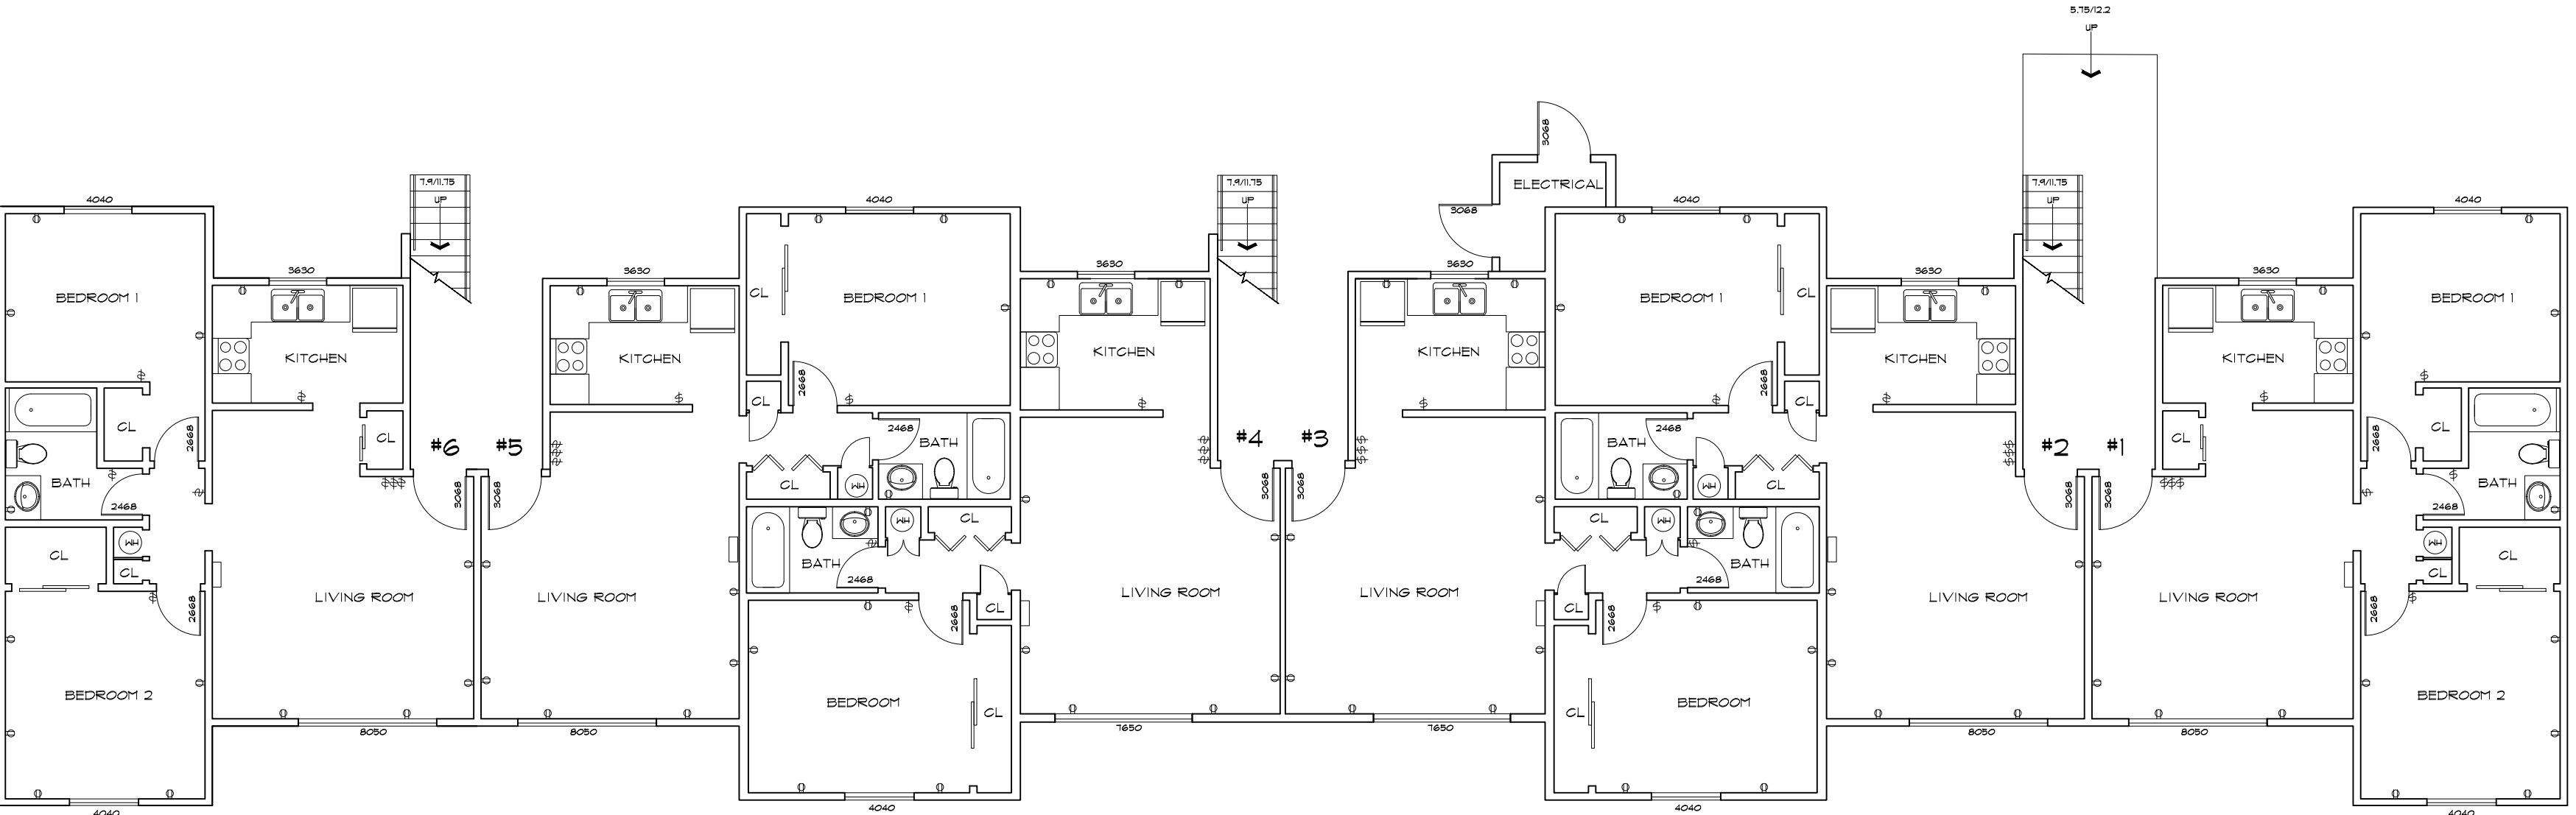


BUILDING 22 FIRST FLOOR PLAN

ARCHITECTURAL AS BUILT


HOLIDAY MANOR APARTMENTS

Oxnard, CA 94901

01	100% SUBMISSION	SEE COVER SHEET
NO.	ISSUES REVISIONS	DATE
		SHEET TITLE
HL	PROJECT MANAGER	
HL	PROJECT DIRECTOR	
012317-1	PROJECT NUMBER	
1/8"=1'-0"	SCALE	
CL	DRAWN BY	
		SHEET NUMBER
AB-22		

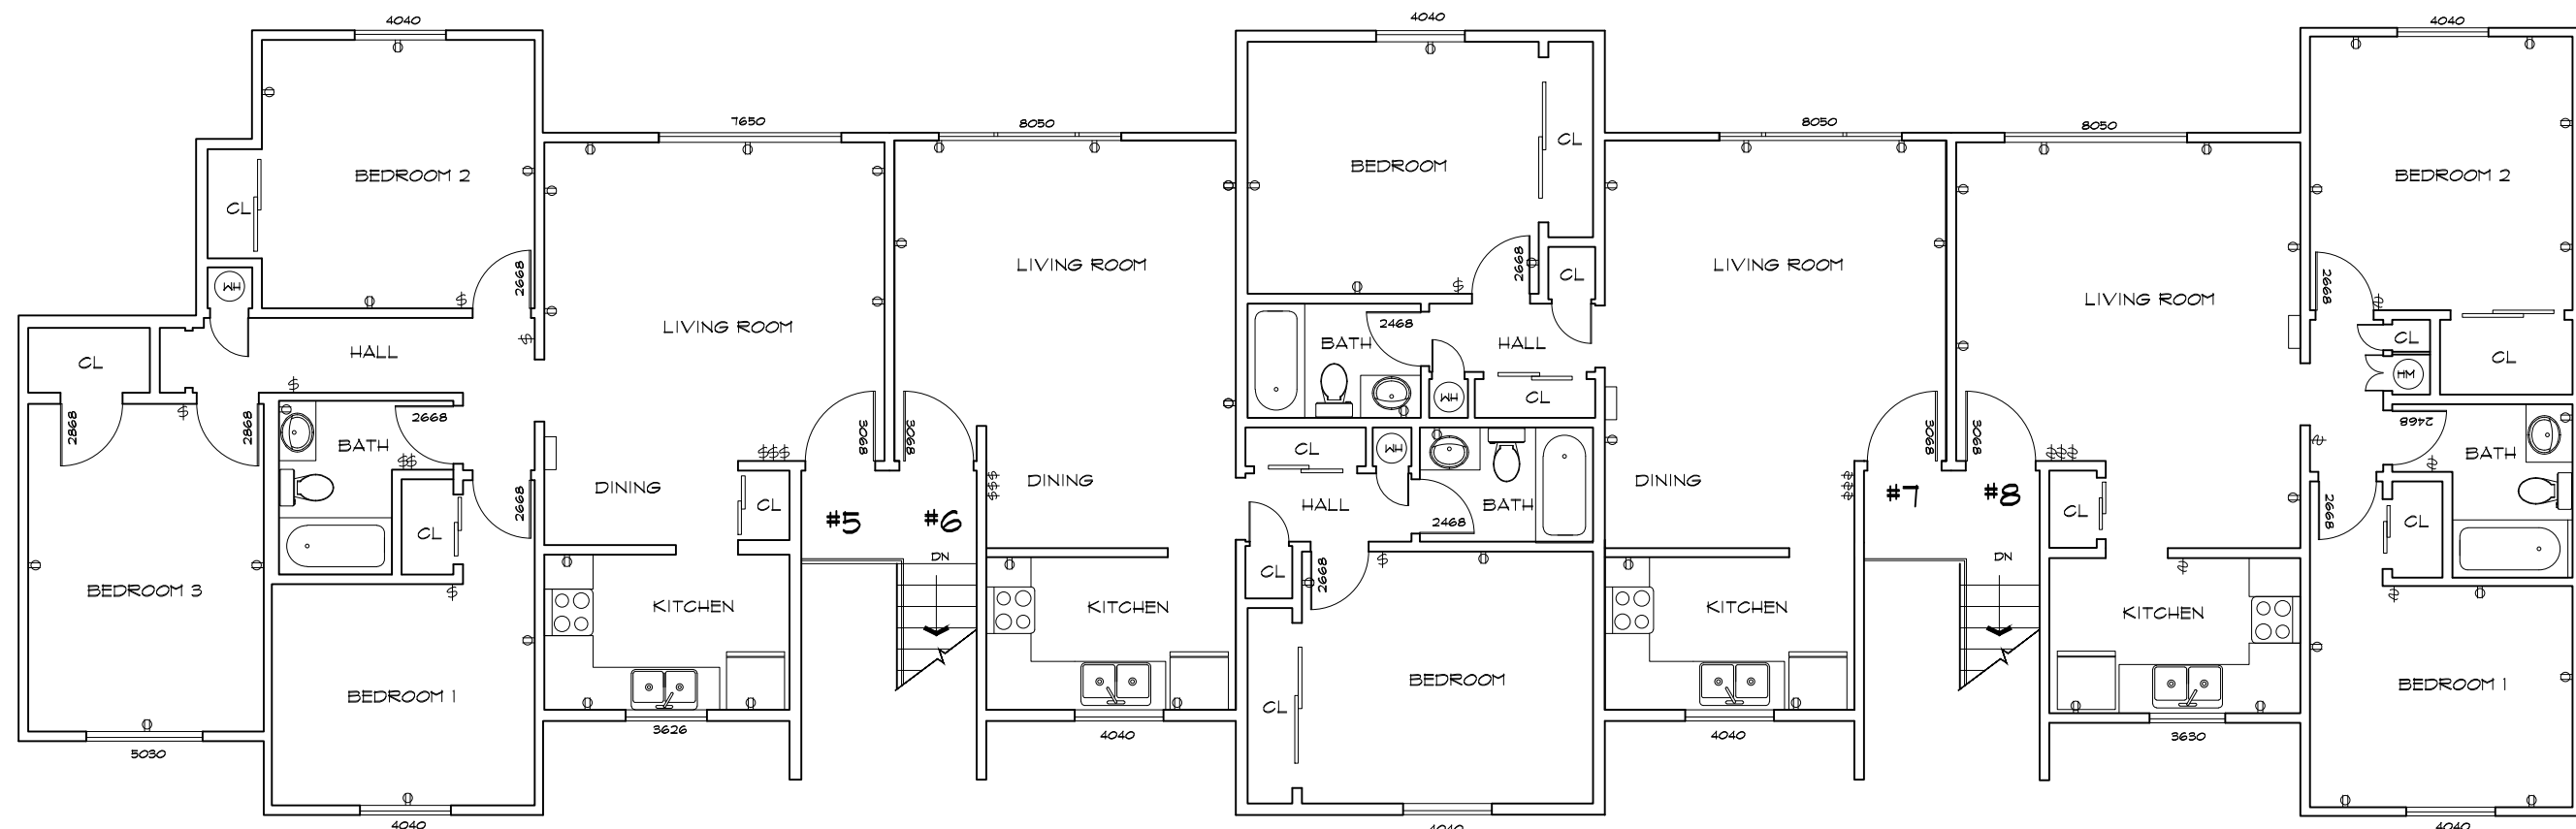

BUILDING 23 SECOND FLOOR PLAN

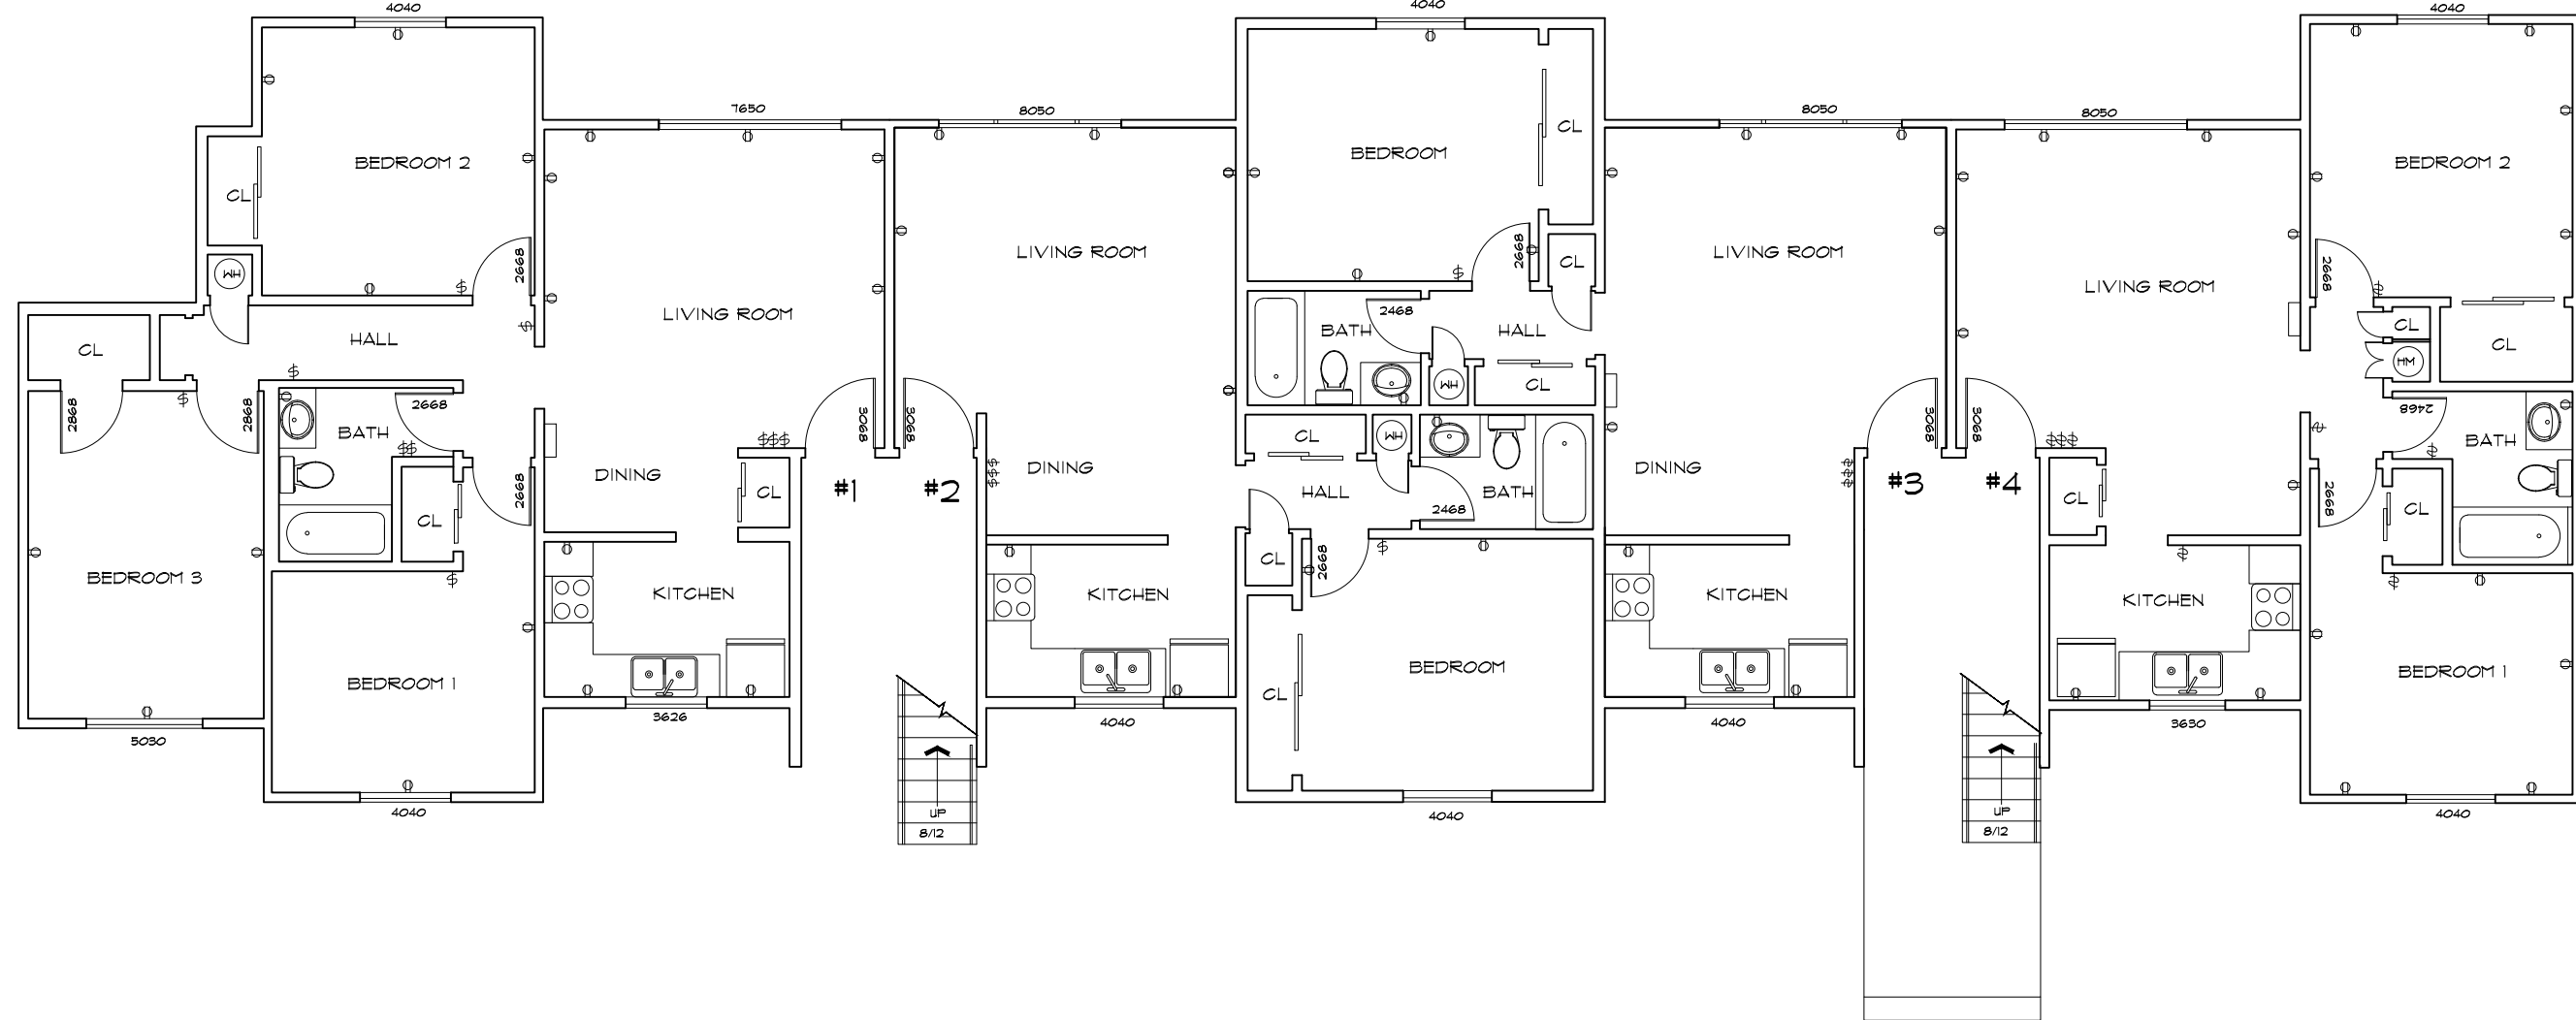

BUILDING 23 FIRST FLOOR PLAN

As BUILT

PROFESSIONALS

www.asbuiltprofessionals.com

A DIVISION OF:

AEC

CONSULTANTS INC

844.272.8458

844 AS BUILT


© 2019 AEC CONSULTANTS INC

ARCHITECTURAL AS BUILT


HOLIDAY MANOR APARTMENTS

Oxnard, CA 94901

01	100% SUBMISSION	SEE COVER SHEET
NO.	ISSUES REVISIONS	DATE
		SHEET TITLE
HL		PROJECT MANAGER
HL		PROJECT DIRECTOR
012317-1		PROJECT NUMBER
1/8"=1'-0"		SCALE
CL		DRAWN BY
		SHEET NUMBER
AB-23		

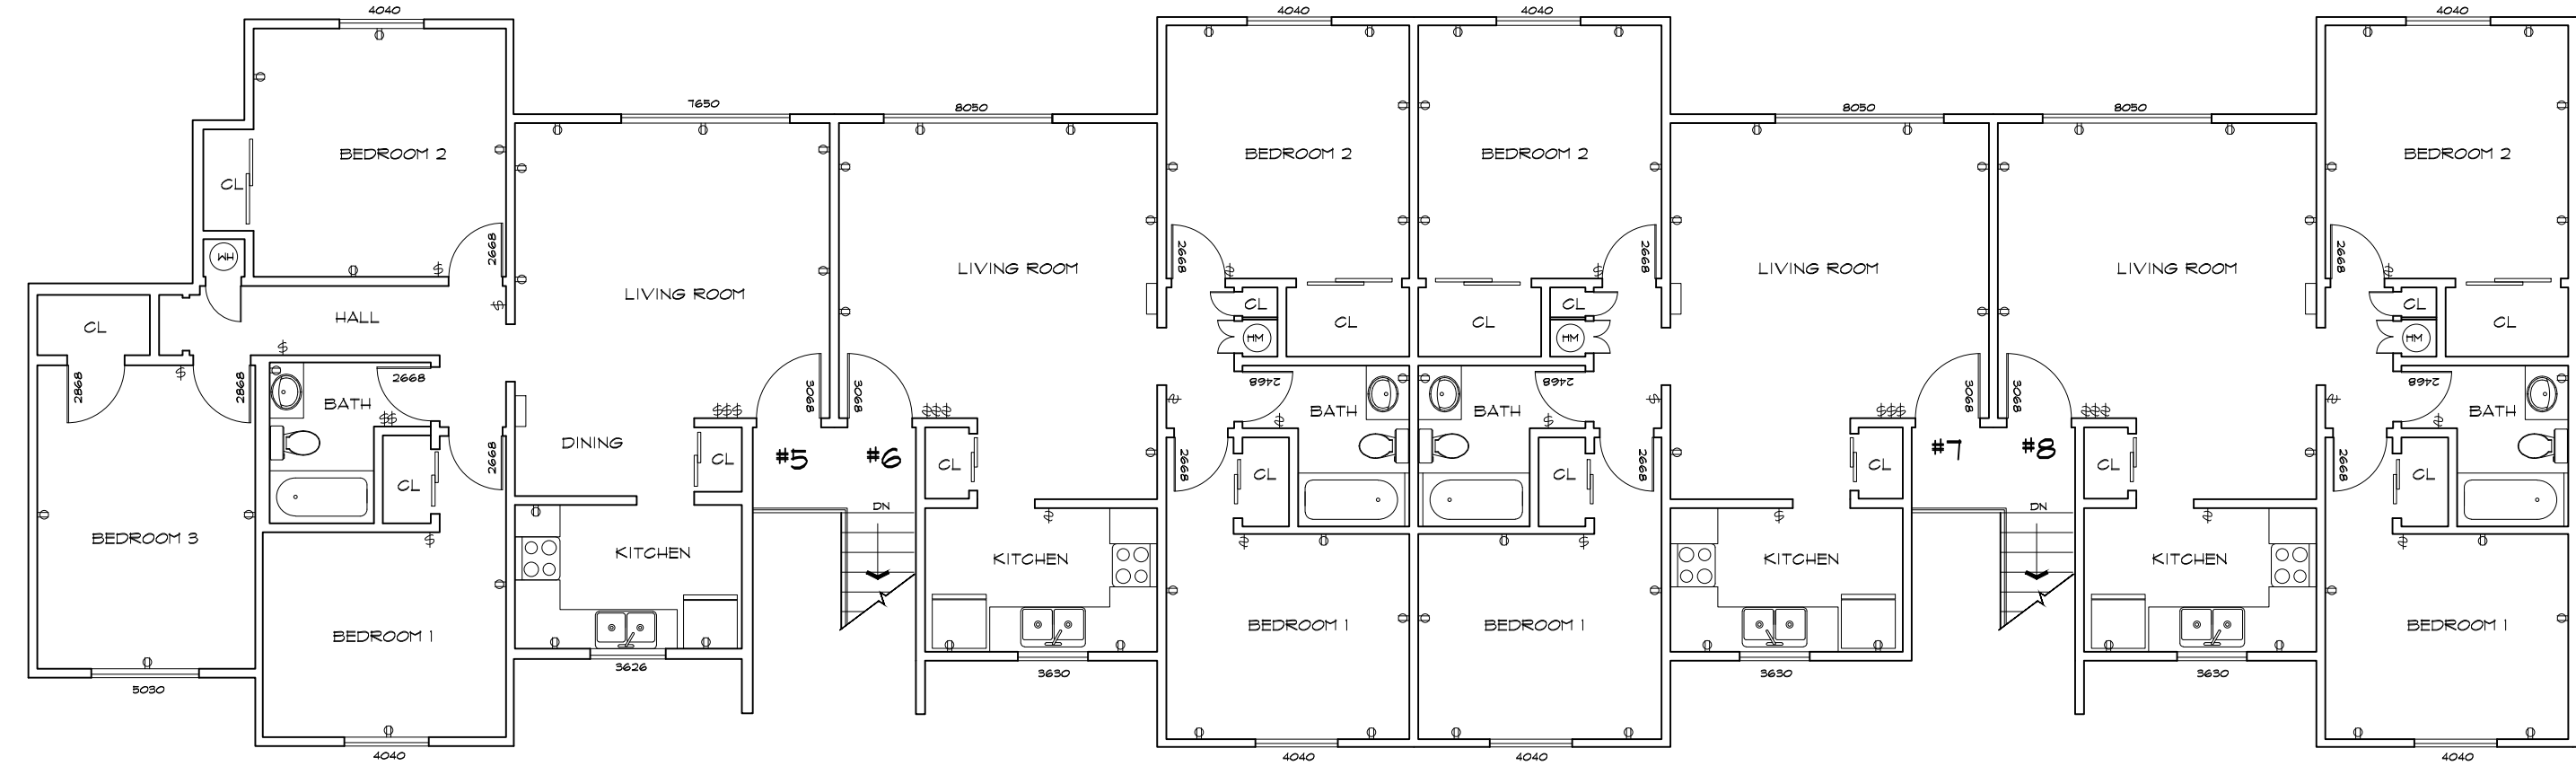

BUILDING 24 SECOND FLOOR PLAN

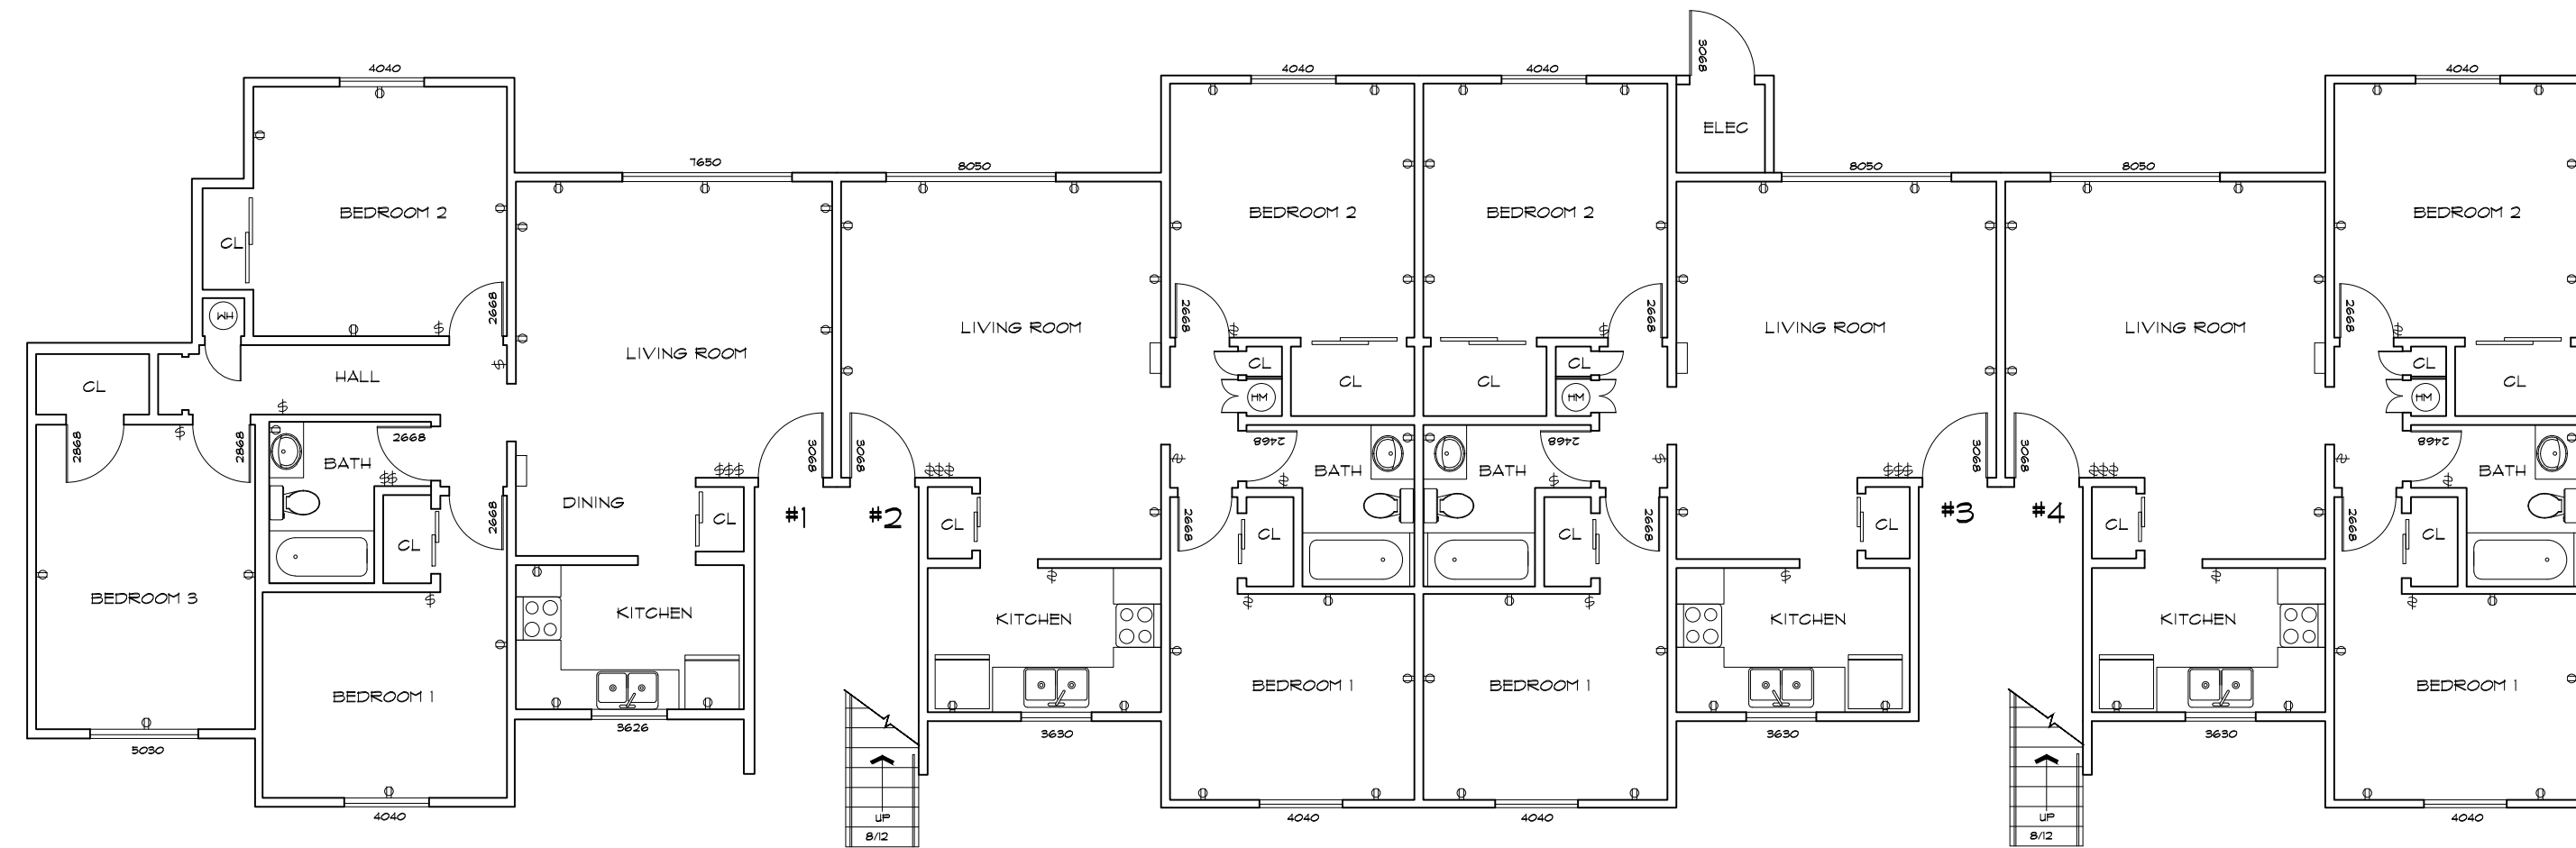

BUILDING 24 FIRST FLOOR PLAN

As BUILT

PROFESSIONALS

www.asbuiltprofessionals.com

A DIVISION OF:

AEC

CONSULTANTS INC

844.272.8458

844 AS BUILT


© 2019 AEC CONSULTANTS INC

ARCHITECTURAL AS BUILT


HOLIDAY MANOR APARTMENTS

Oxnard, CA 94901

01	100% SUBMISSION	SEE COVER SHEET
NO.	ISSUES REVISIONS	DATE
		SHEET TITLE
HL		PROJECT MANAGER
HL		PROJECT DIRECTOR
012317-1		PROJECT NUMBER
1/8"=1'-0"		SCALE
CL		DRAWN BY
		SHEET NUMBER
AB-24		

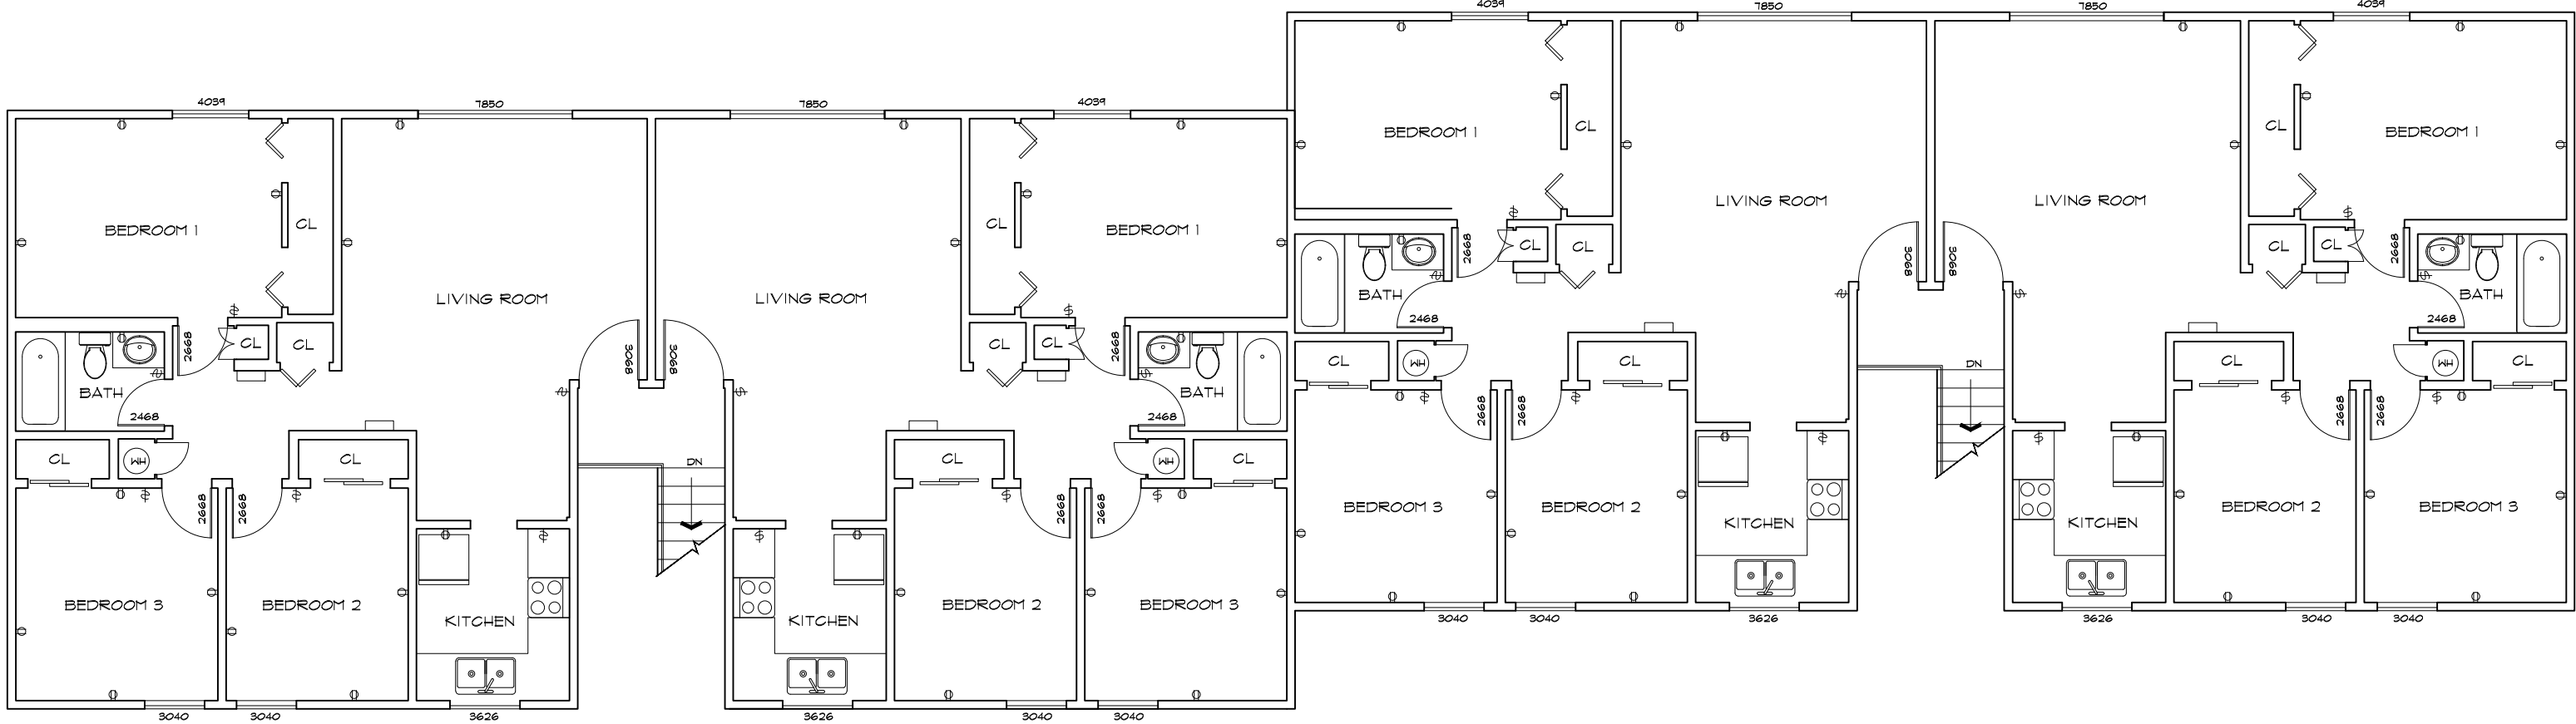

BUILDING 25 SECOND FLOOR PLAN

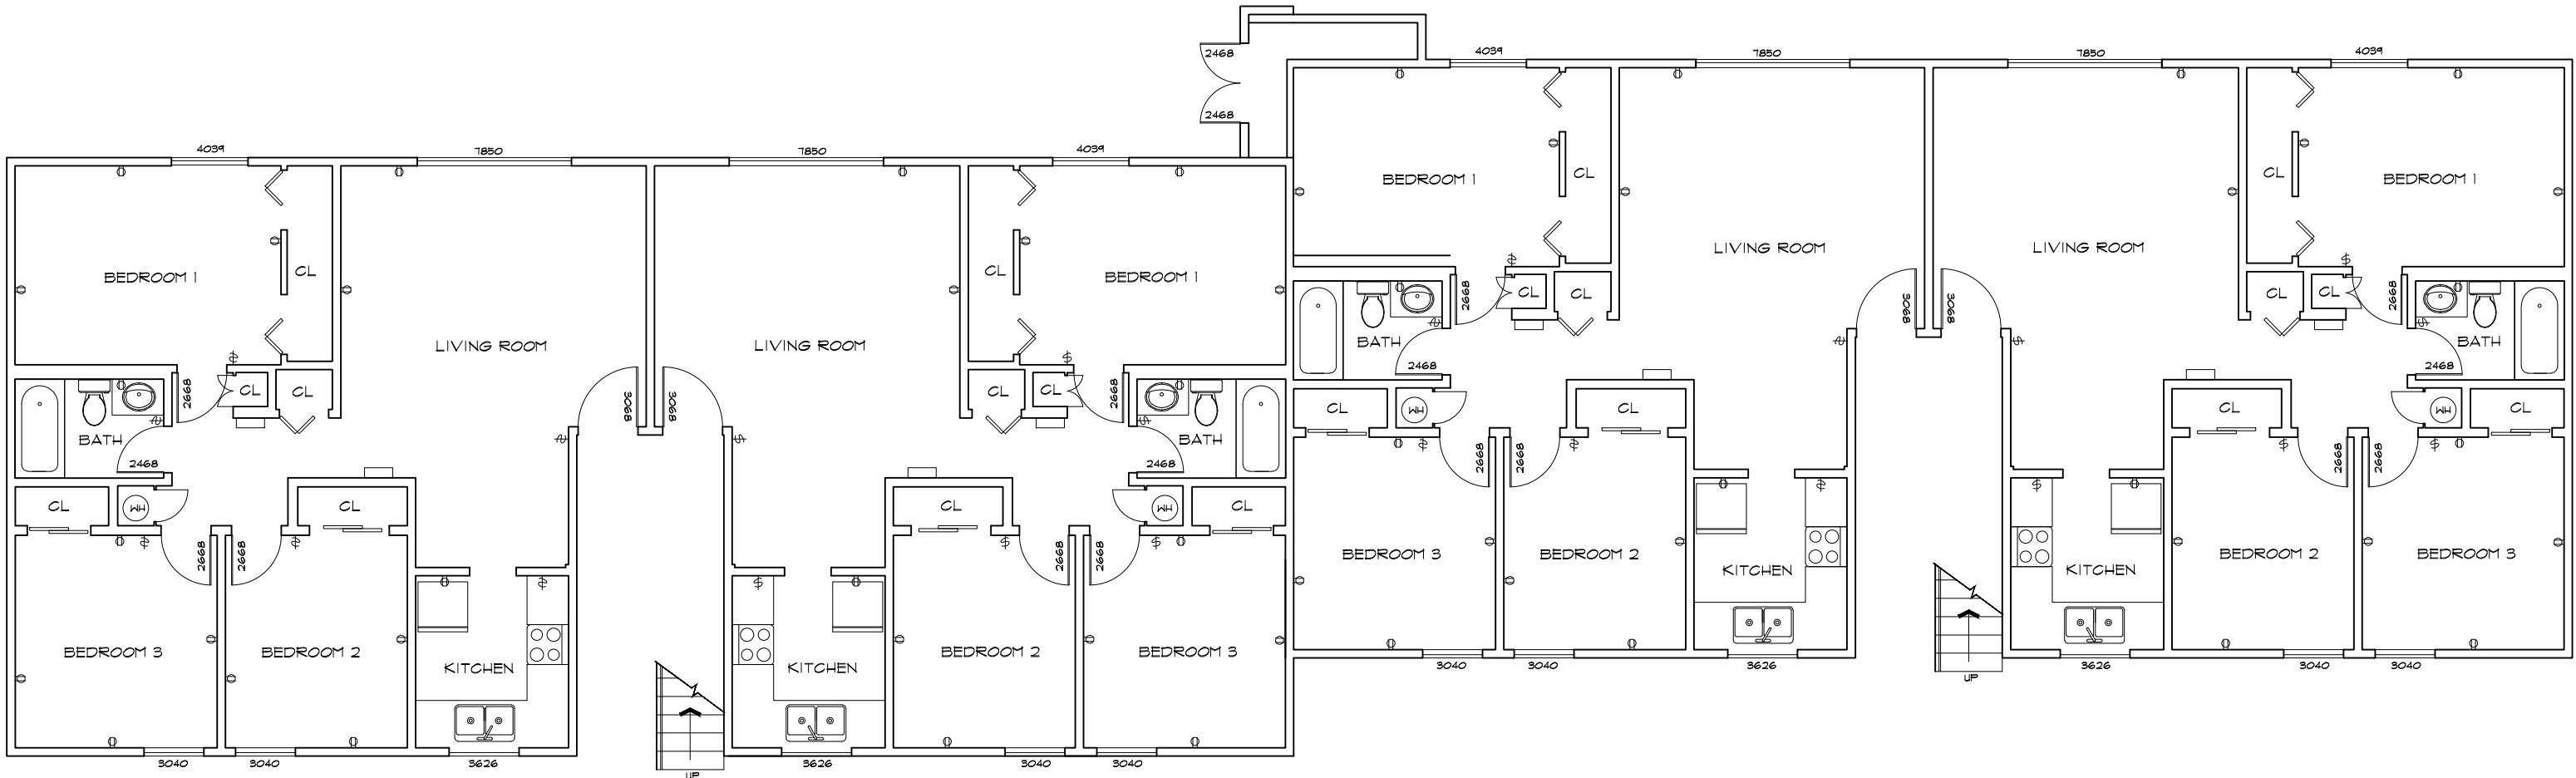

BUILDING 25 FIRST FLOOR PLAN

As BUILT

PROFESSIONALS

www.asbuiltprofessionals.com

A DIVISION OF:

AEC

CONSULTANTS INC

844.272.8458

844 ASBUILT


© 2019 AEC CONSULTANTS INC

ARCHITECTURAL AS BUILT


HOLIDAY MANOR APARTMENTS

Oxnard, CA 94901

01	100% SUBMISSION	SEE COVER SHEET
NO.	ISSUES REVISIONS	DATE
		SHEET TITLE
HL		PROJECT MANAGER
HL		PROJECT DIRECTOR
012317-1		PROJECT NUMBER
1/8"=1'-0"		SCALE
CL		DRAWN BY
		SHEET NUMBER
AB-25		

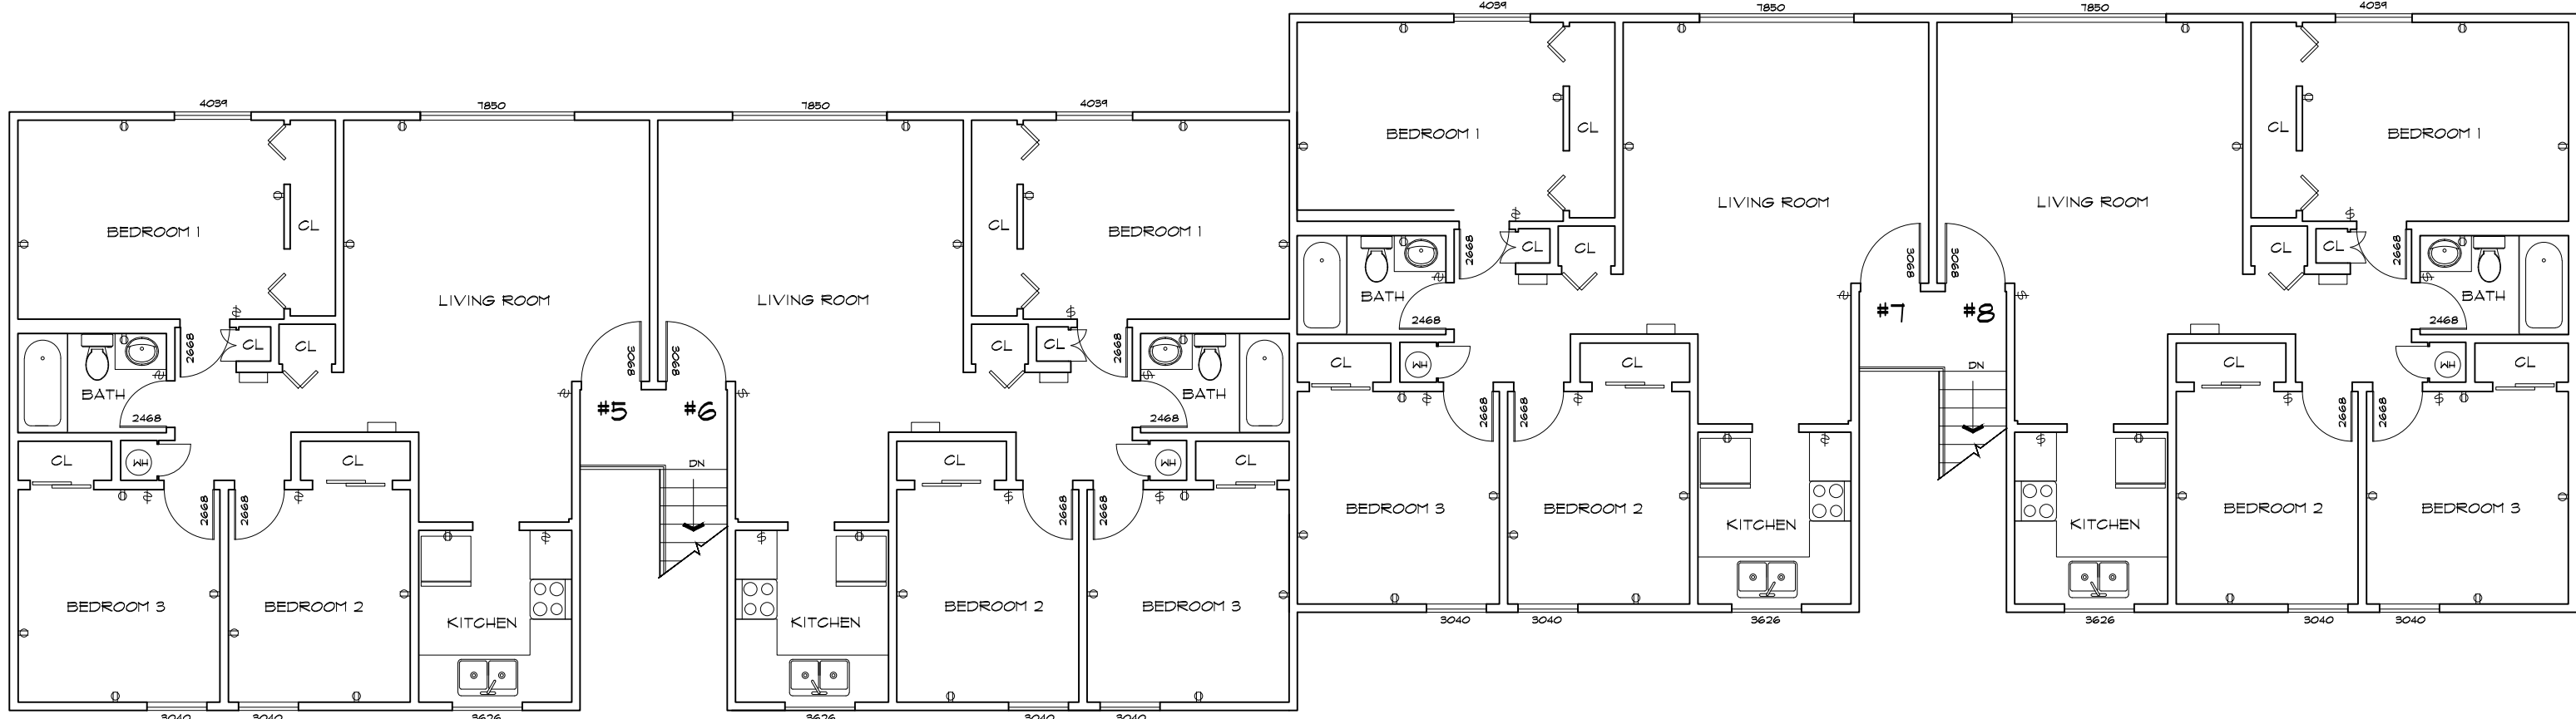

BUILDING 26 SECOND FLOOR PLAN

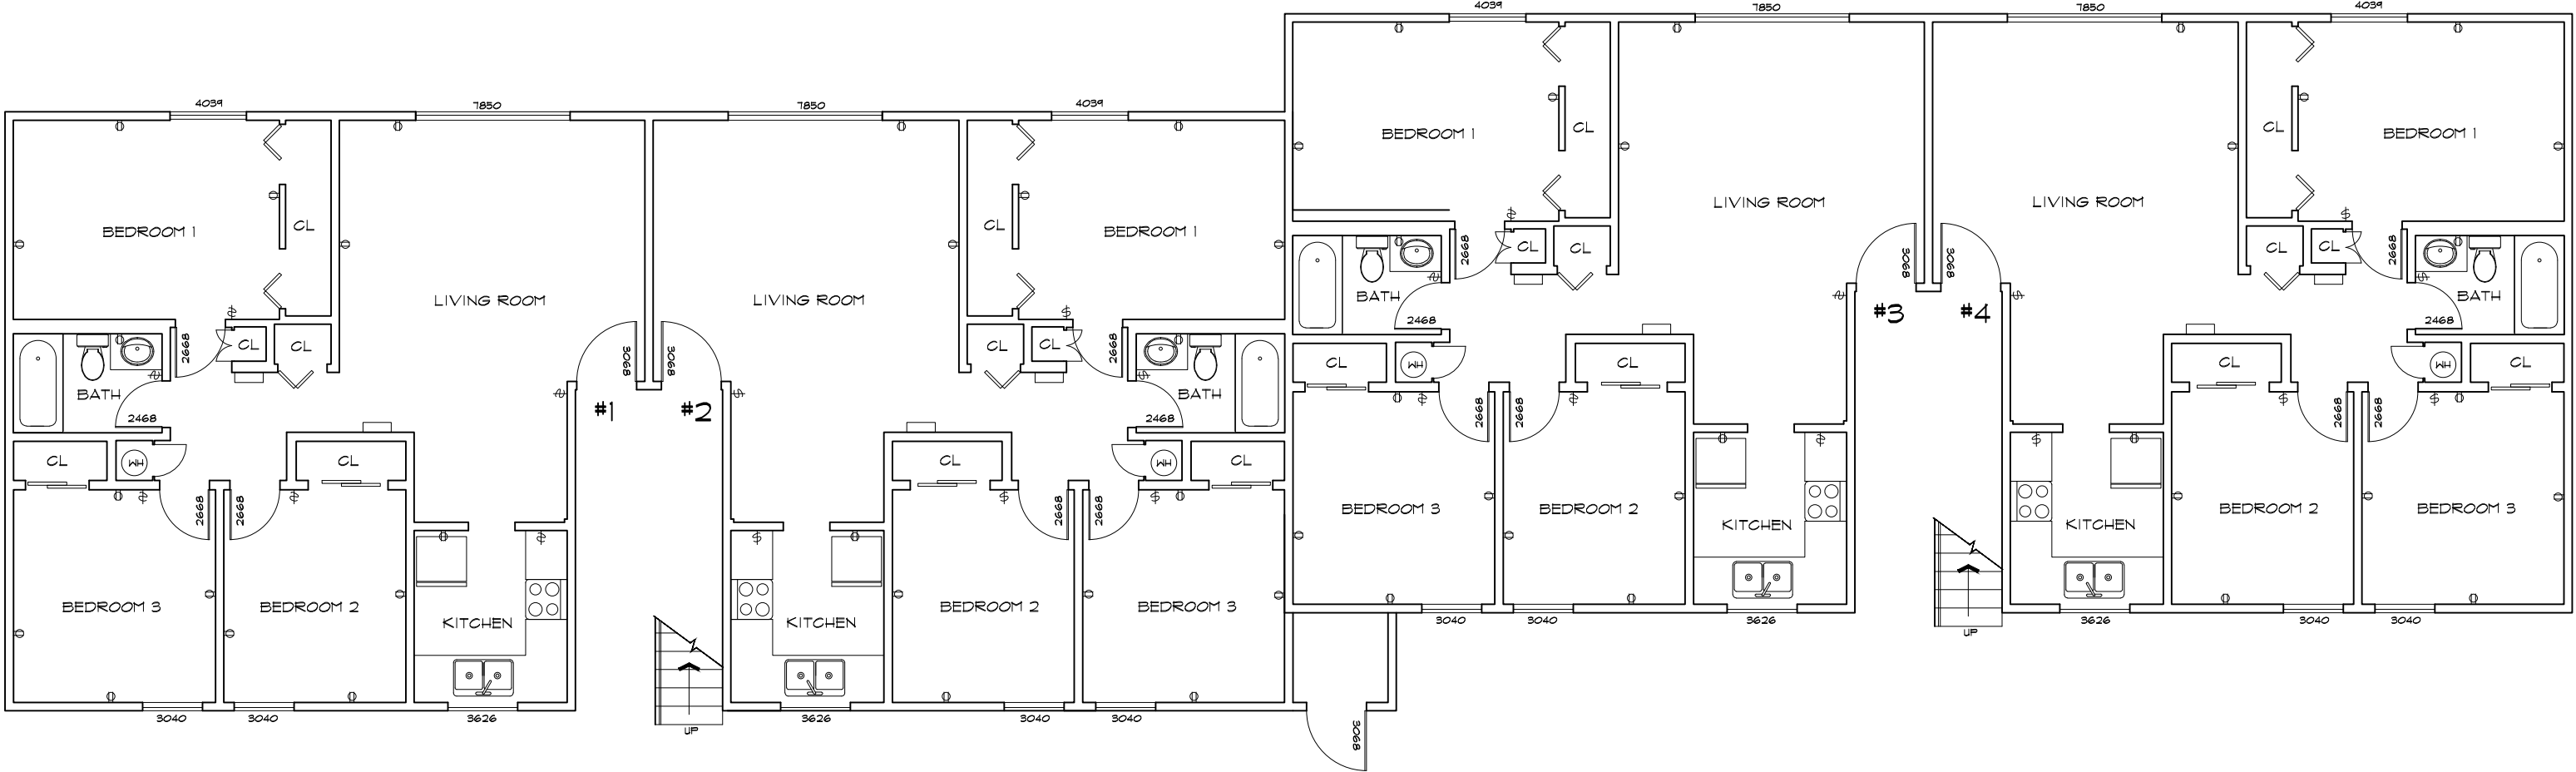

BUILDING 26 FIRST FLOOR PLAN

As BUILT

PROFESSIONALS

www.asbuiltprofessionals.com

A DIVISION OF:

AEC

CONSULTANTS INC

844.272.8458

844 AS BUILT


@ 2019 AEC CONSULTANTS INC

ARCHITECTURAL AS BUILT


HOLIDAY MANOR APARTMENTS

Oxnard, CA 94901

01	100% SUBMISSION	SEE COVER SHEET
NO.	ISSUES REVISIONS	DATE
		SHEET TITLE
HL		PROJECT MANAGER
HL		PROJECT DIRECTOR
012317-1		PROJECT NUMBER
1/8"=1'-0"		SCALE
CL		DRAWN BY
		SHEET NUMBER
AB-26		

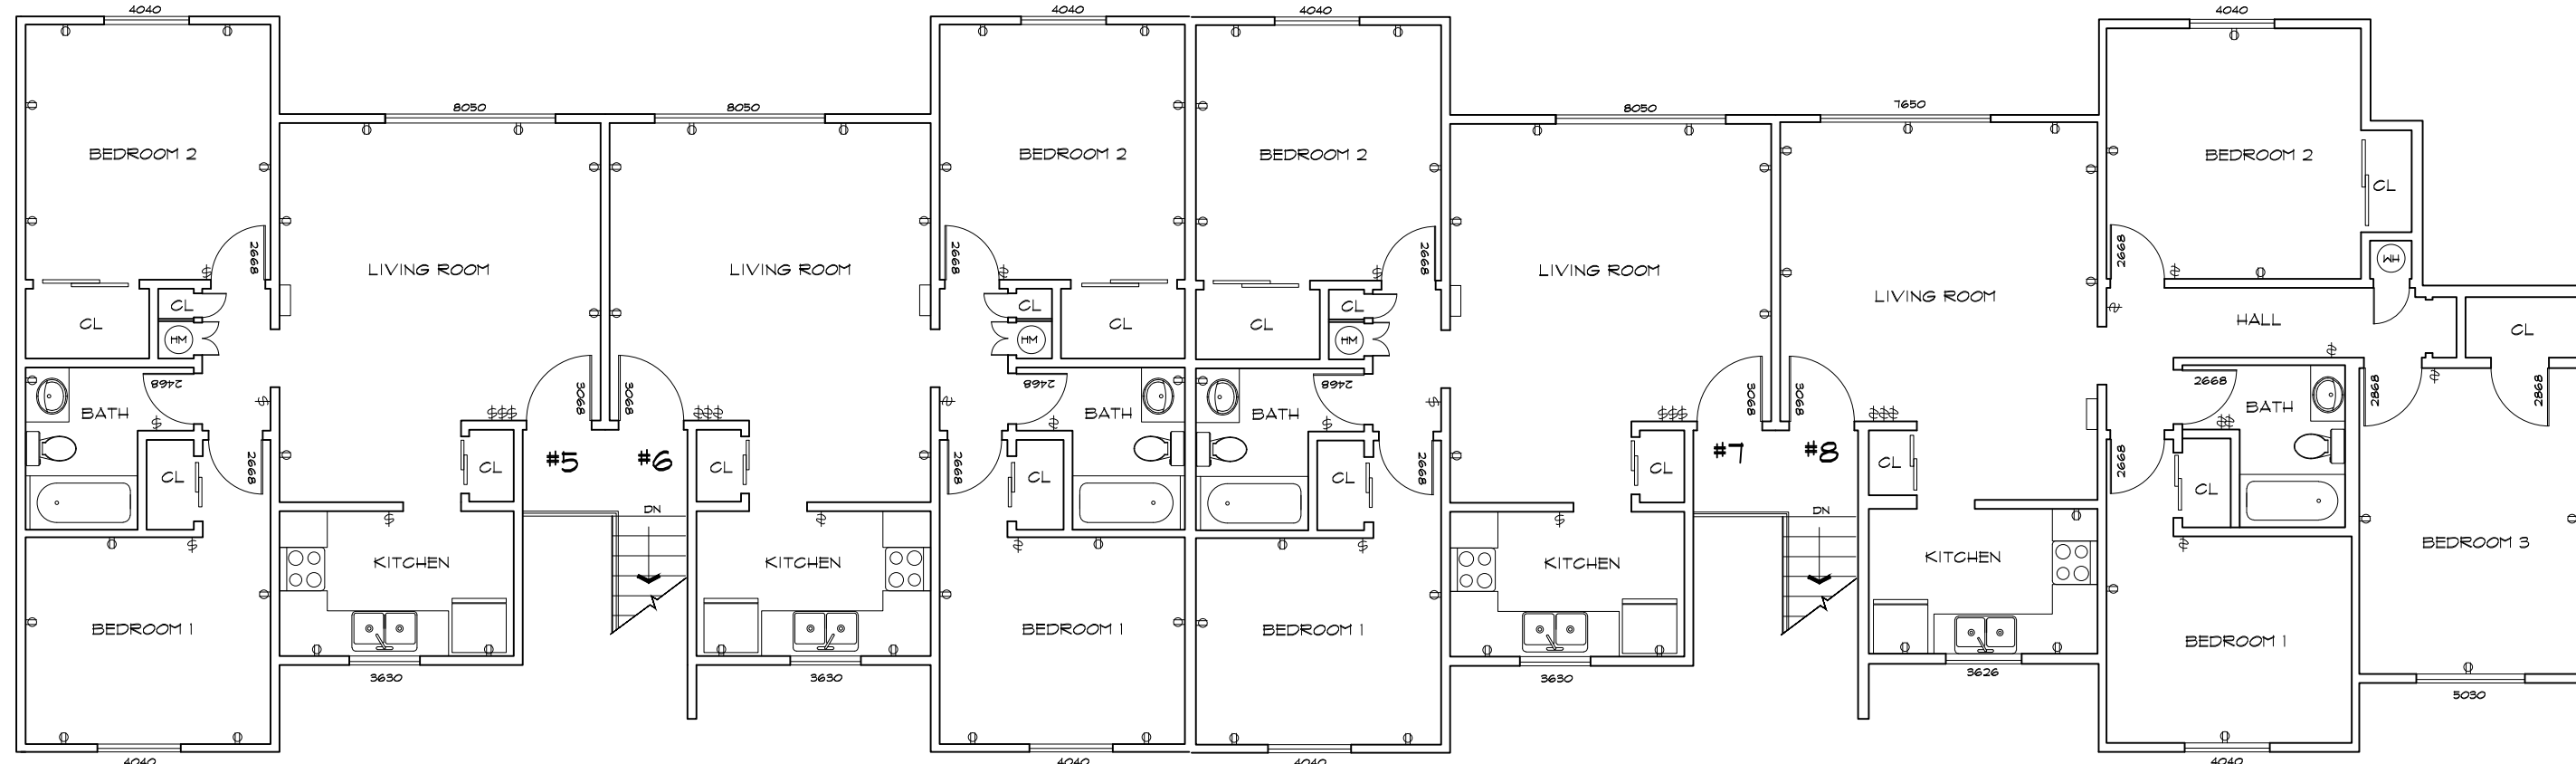

BUILDING 27 SECOND FLOOR PLAN

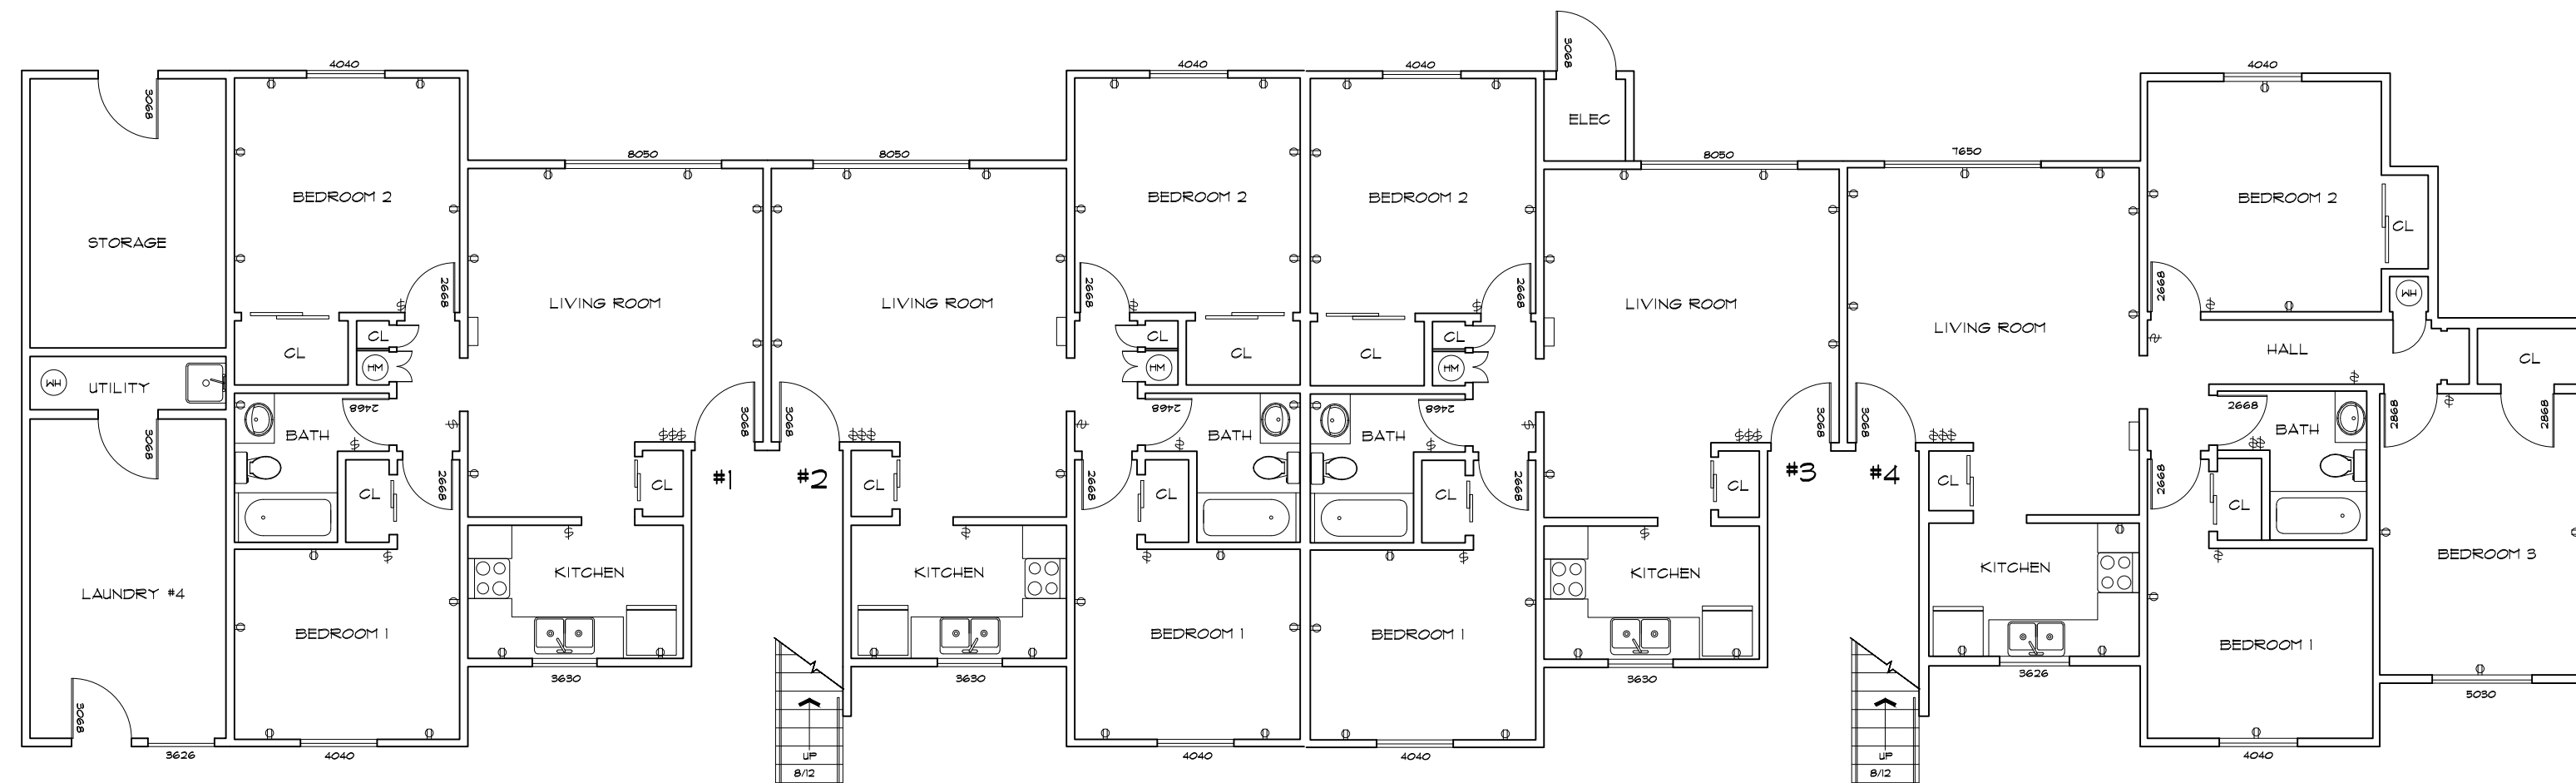

BUILDING 27 FIRST FLOOR PLAN

As BUILT

PROFESSIONALS

www.asbuiltprofessionals.com

A DIVISION OF:

AEC

CONSULTANTS INC

844.272.8458

844 ASBUILT

© 2019 AEC CONSULTANTS INC


ARCHITECTURAL AS BUILT

HOLIDAY MANOR APARTMENTS


Oxnard, CA 94901

01	100% SUBMISSION	SEE COVER SHEET
NO.	ISSUES REVISIONS	DATE
		SHEET TITLE
HL		PROJECT MANAGER
HL		PROJECT DIRECTOR
012317-1		PROJECT NUMBER
1/8"=1'-0"		SCALE
CL		DRAWN BY
		SHEET NUMBER

AB-27

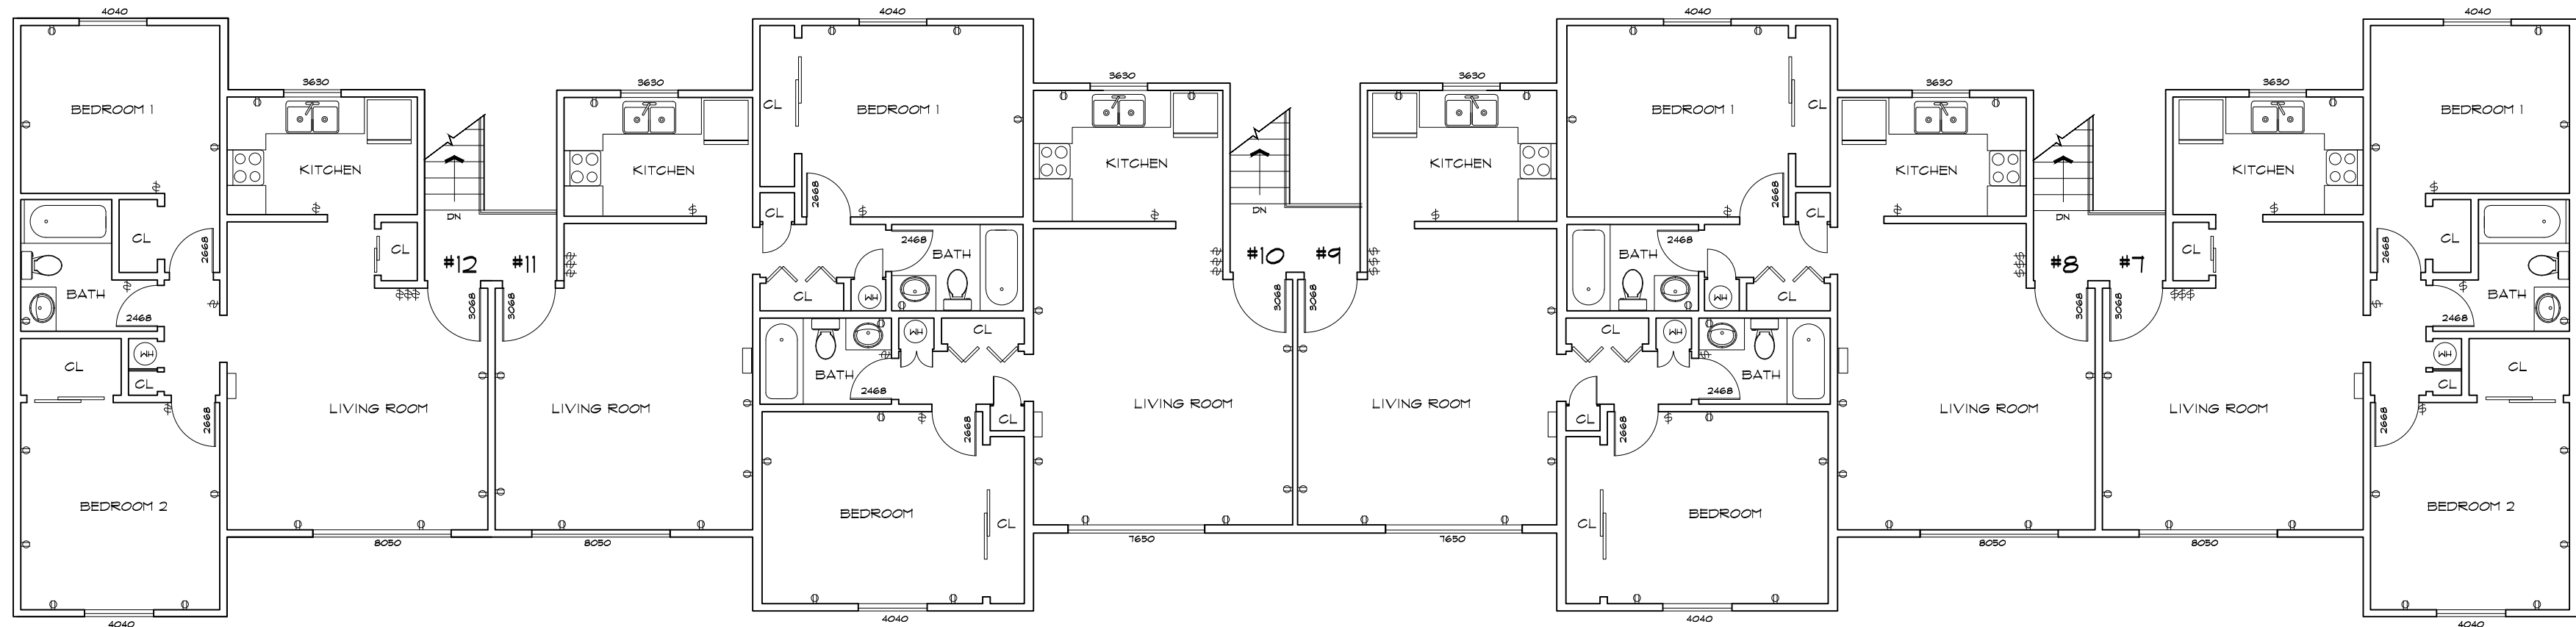

BUILDING 28 SECOND FLOOR PLAN

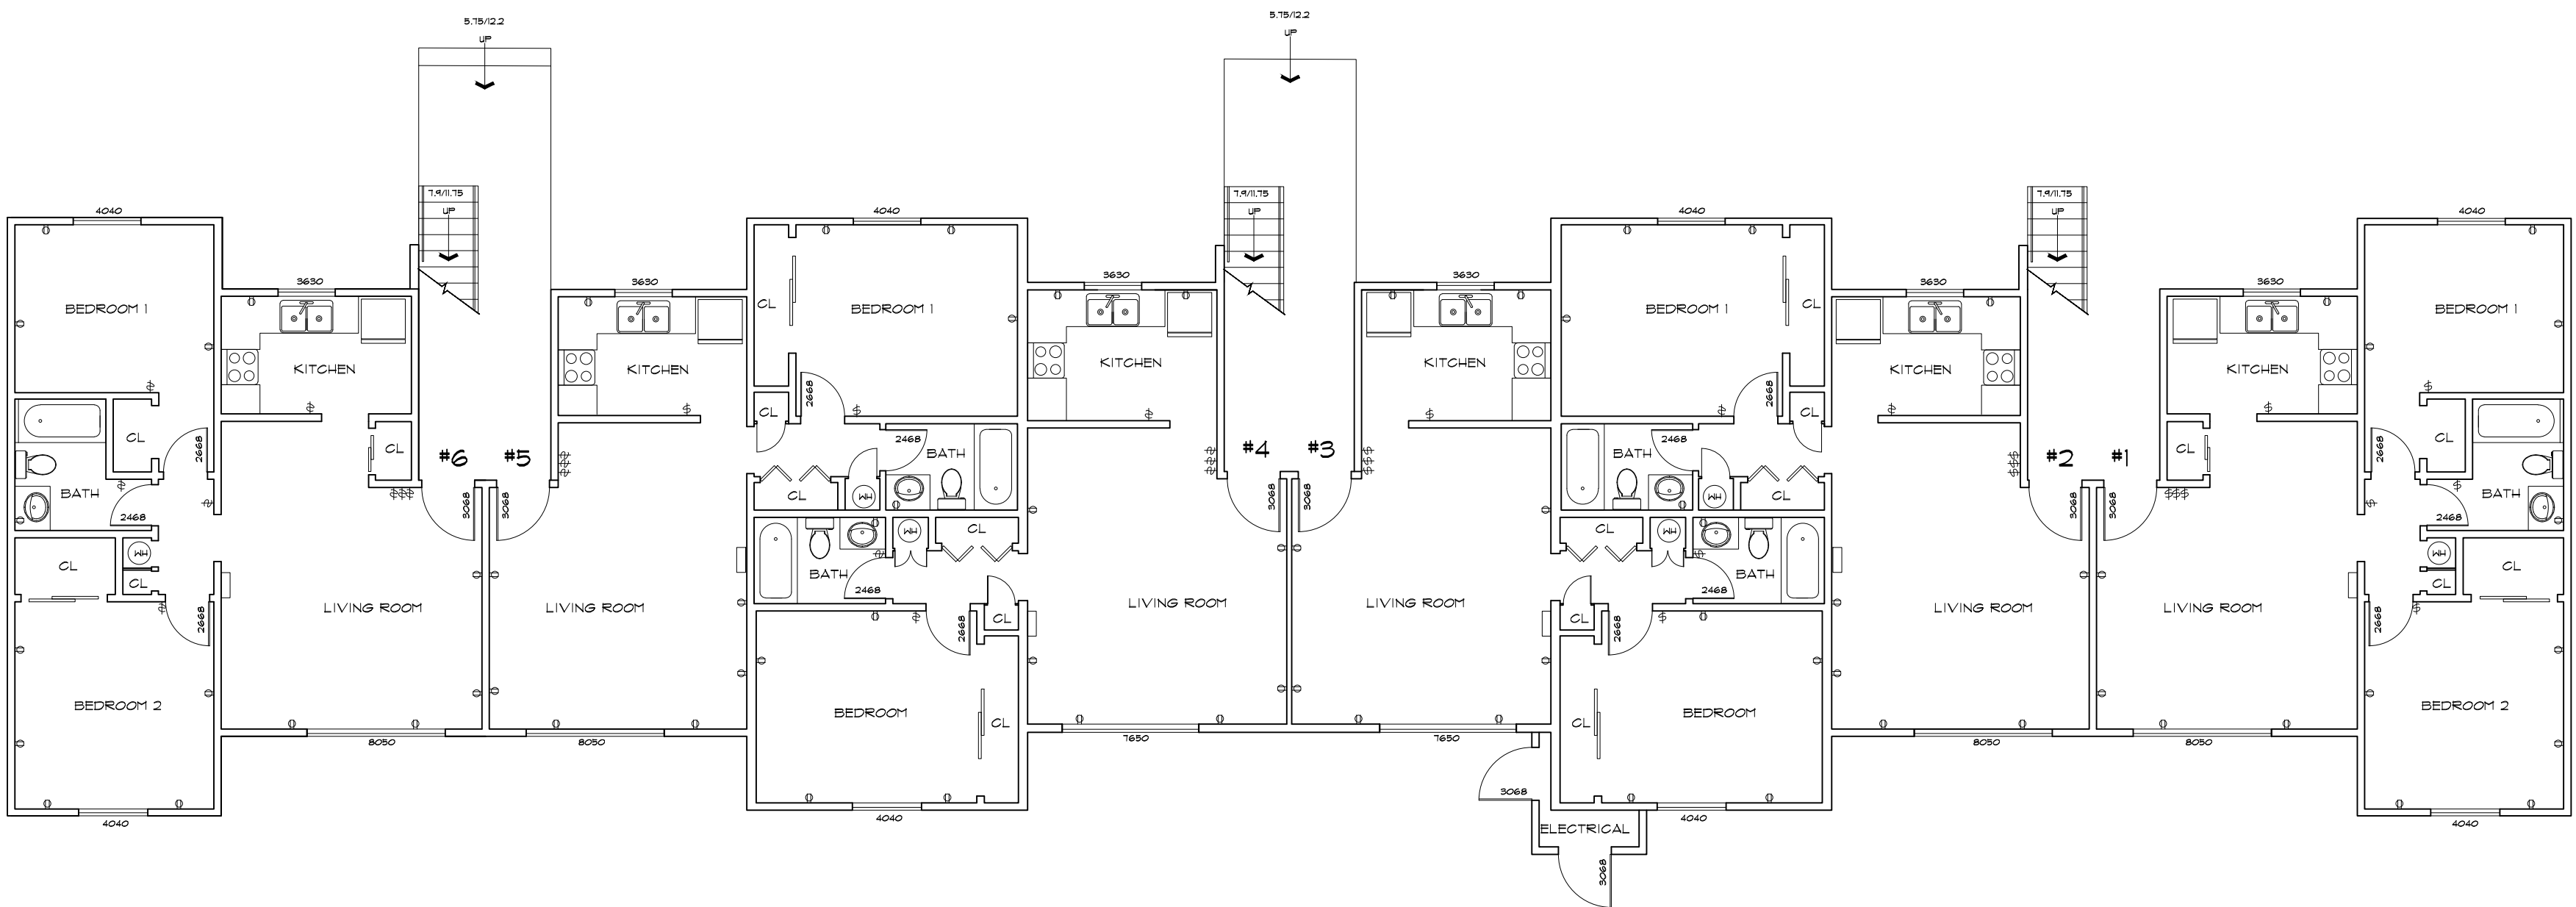


BUILDING 28 FIRST FLOOR PLAN

ARCHITECTURAL AS BUILT


HOLIDAY MANOR APARTMENTS

Oxnard, CA 94901

01	100% SUBMISSION	SEE COVER SHEET
NO.	ISSUES REVISIONS	DATE
		SHEET TITLE
HL	PROJECT MANAGER	
HL	PROJECT DIRECTOR	
012317-1	PROJECT NUMBER	
1/8"=1'-0"	SCALE	
CL	DRAWN BY	
		SHEET NUMBER
AB-28		

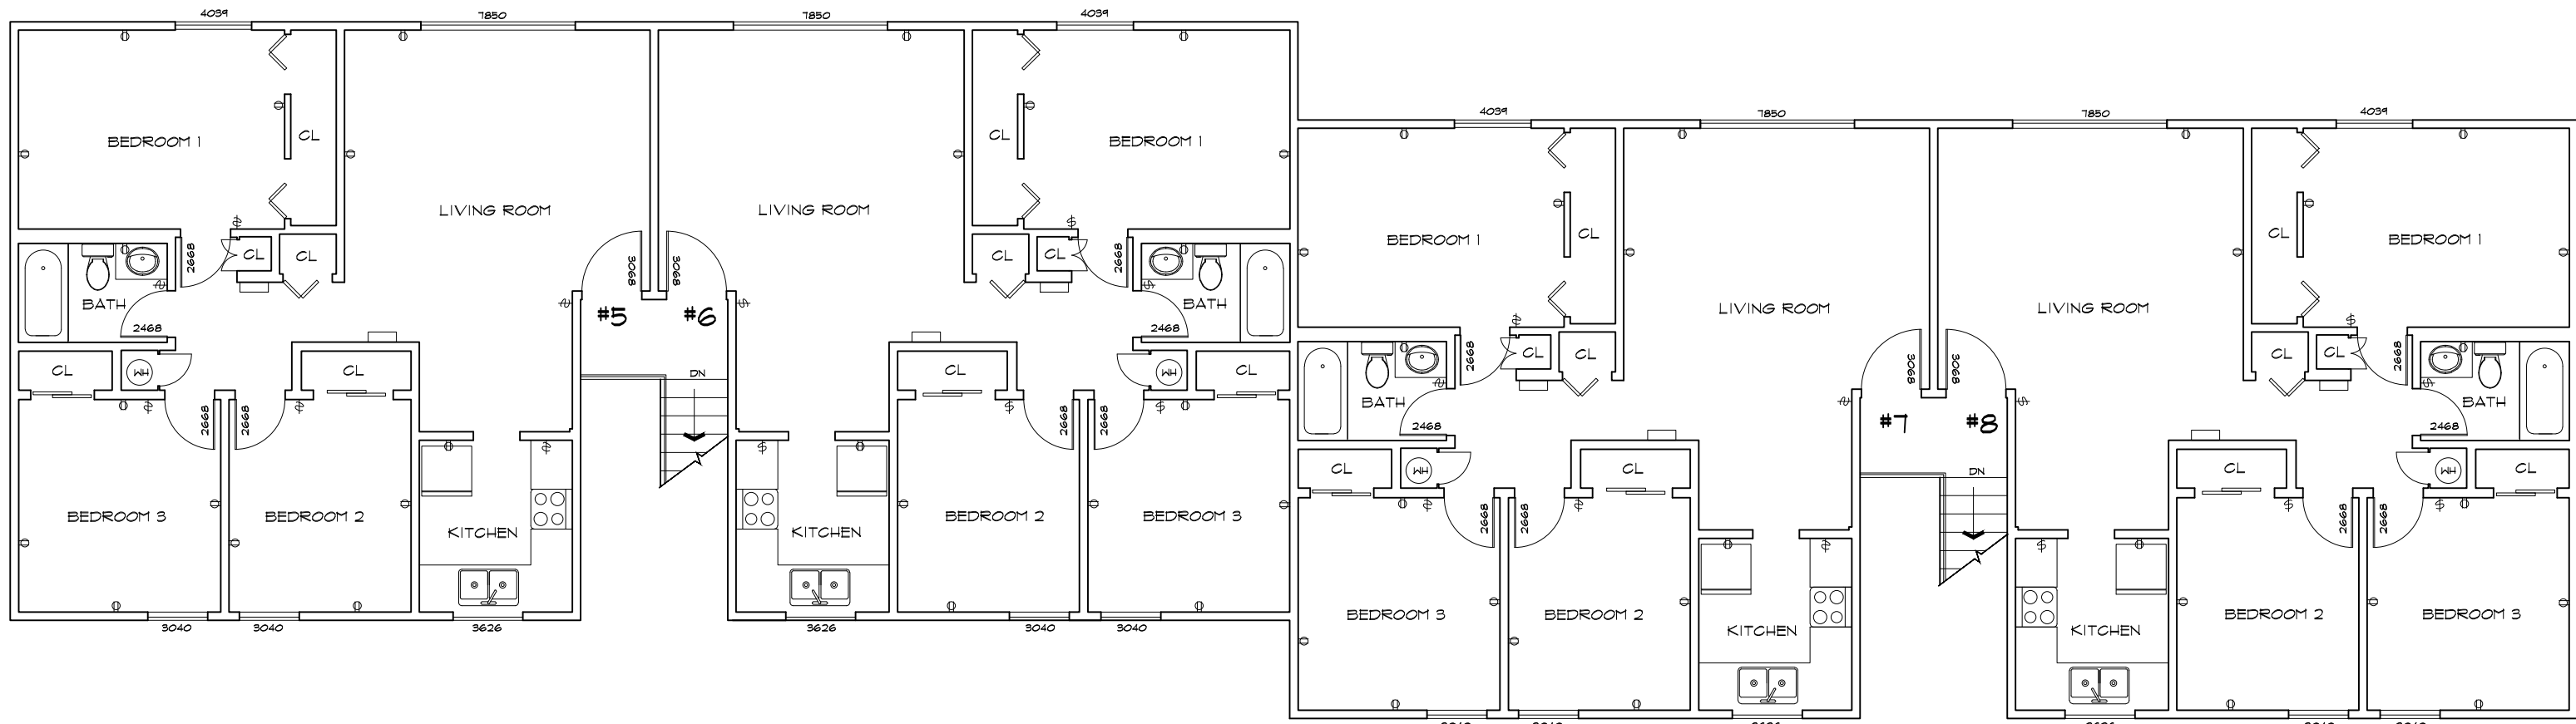

BUILDING 29 SECOND FLOOR PLAN

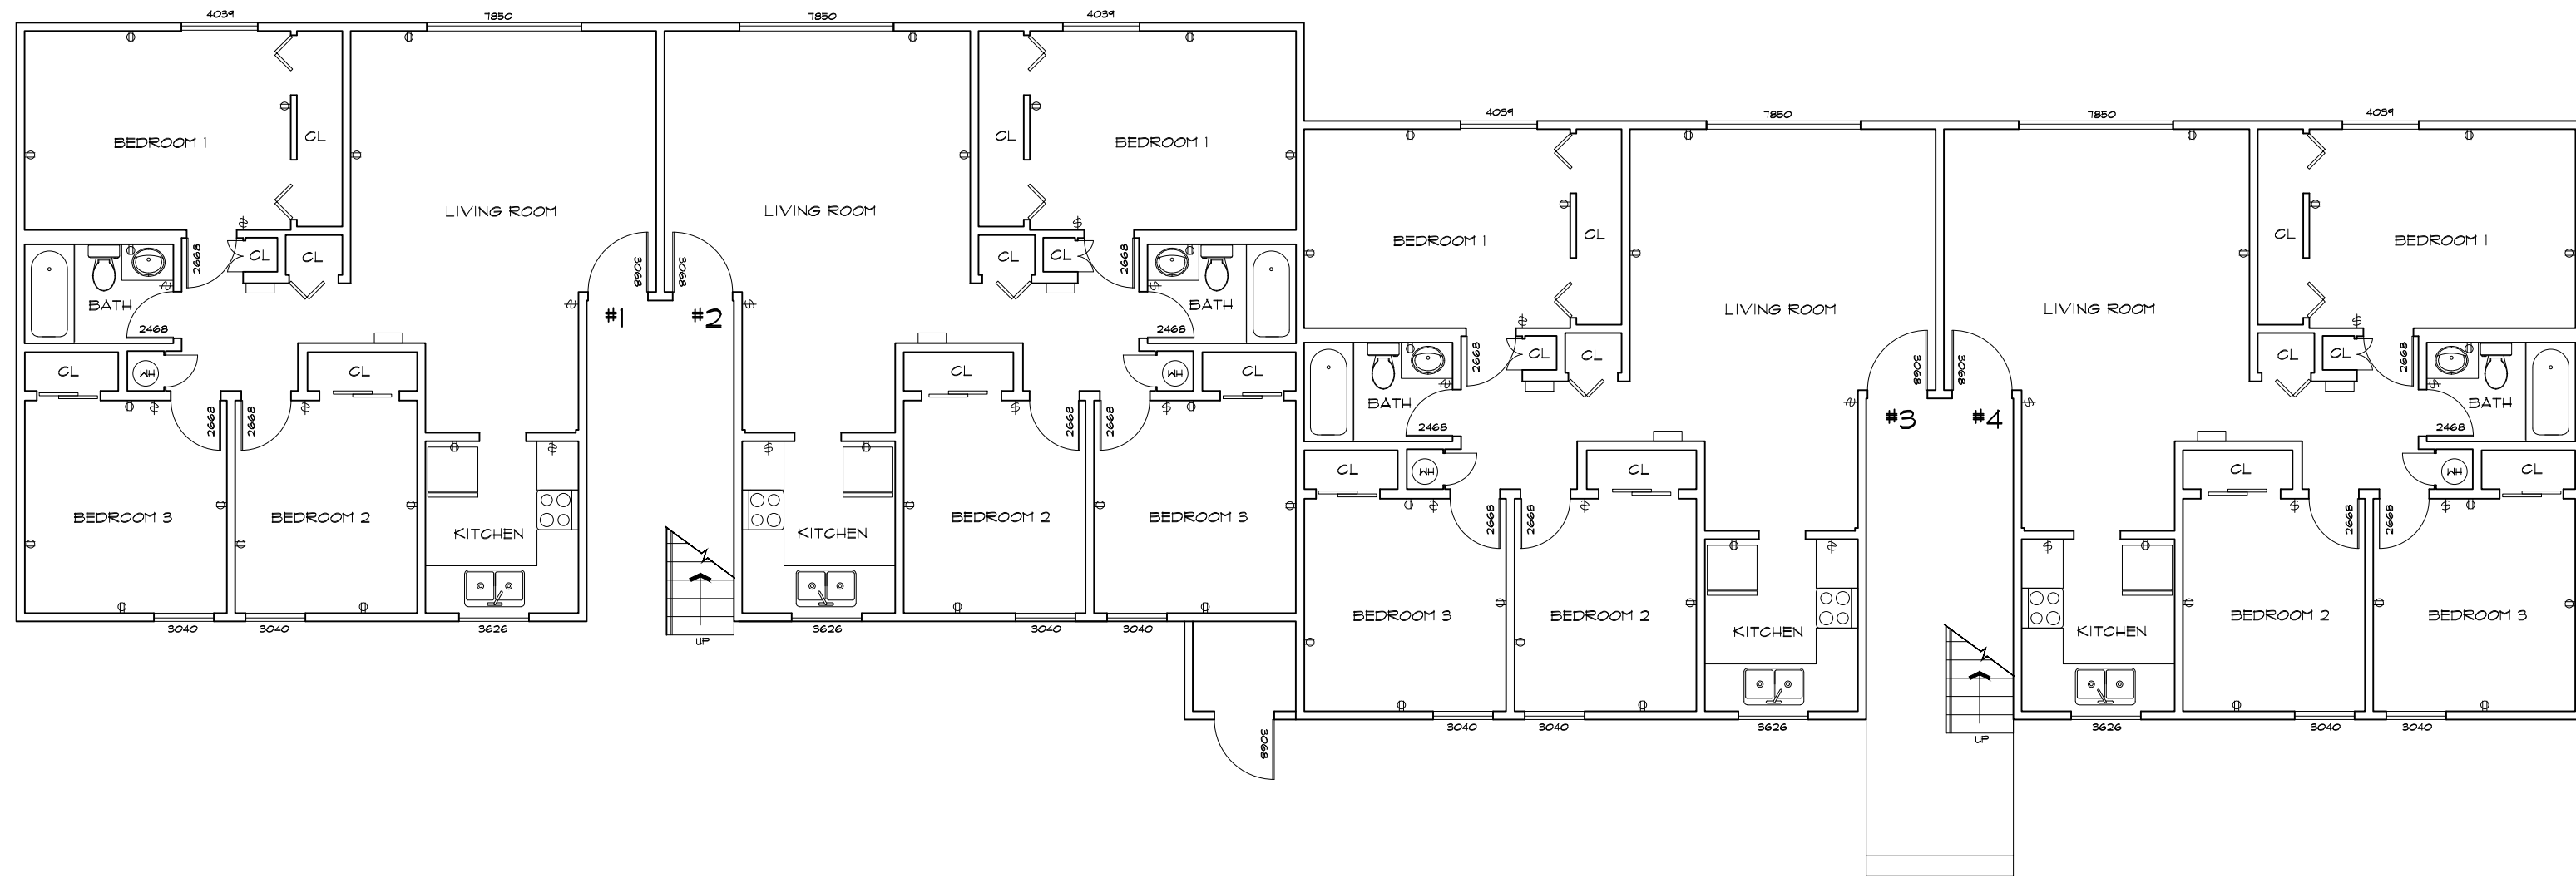

BUILDING 29 FIRST FLOOR PLAN

As BUILT

PROFESSIONALS

www.asbuiltprofessionals.com

A DIVISION OF:

AEC

CONSULTANTS INC

844.272.8458

844 AS BUILT


© 2019 AEC CONSULTANTS INC

ARCHITECTURAL AS BUILT


HOLIDAY MANOR APARTMENTS

Oxnard, CA 94901

01	100% SUBMISSION	SEE COVER SHEET
NO.	ISSUES REVISIONS	DATE
		SHEET TITLE
HL	PROJECT MANAGER	
HL	PROJECT DIRECTOR	
012317-1	PROJECT NUMBER	
1/8"=1'-0"	SCALE	
CL	DRAWN BY	
		SHEET NUMBER
AB-29		

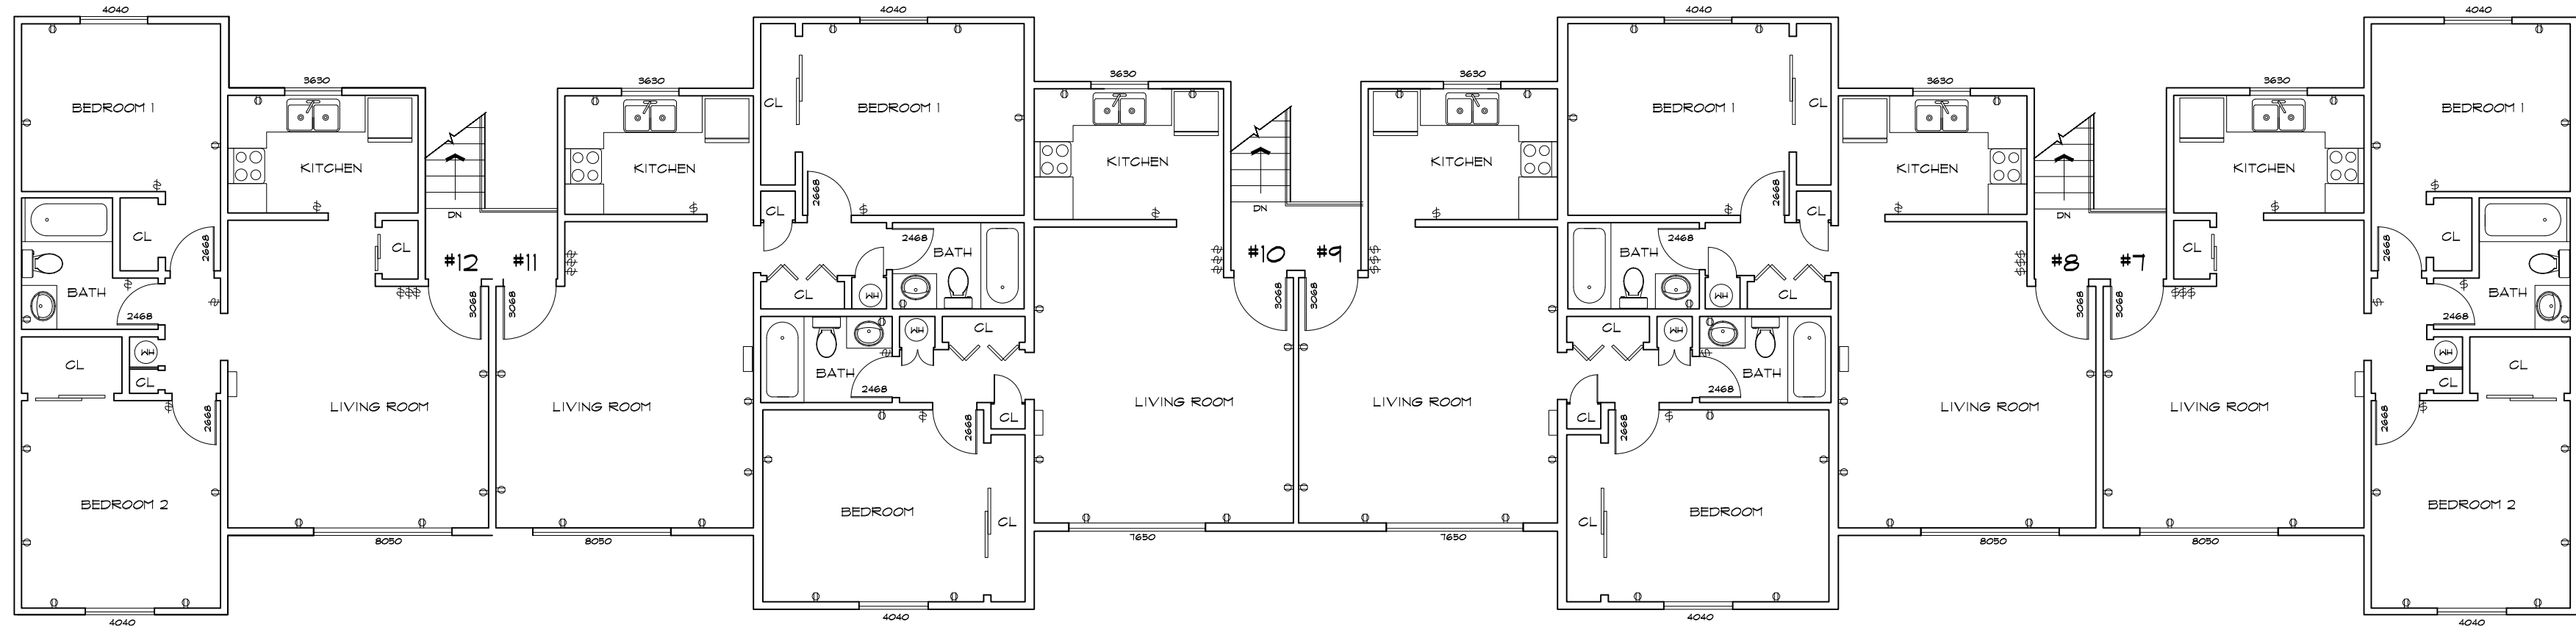

BUILDING 30 SECOND FLOOR PLAN

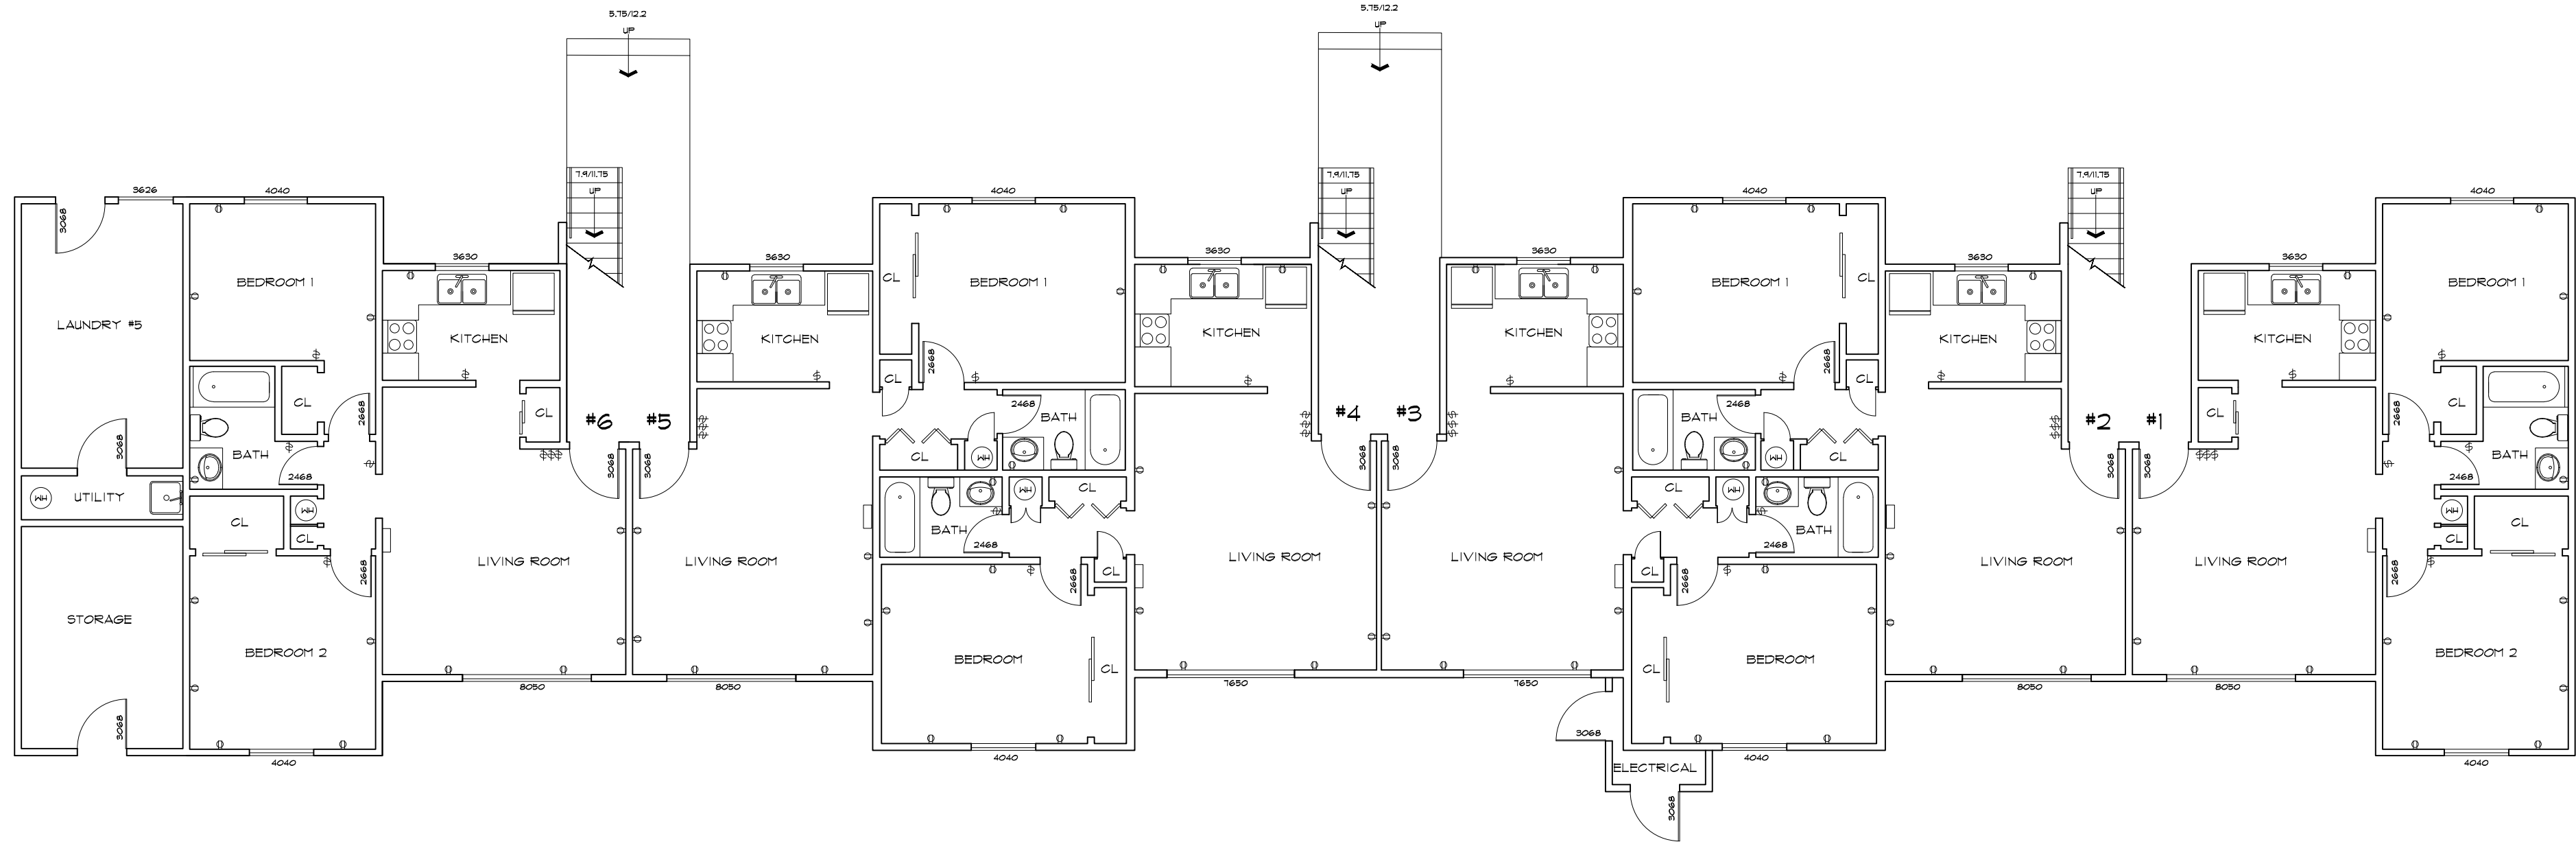


BUILDING 30 FIRST FLOOR PLAN

ARCHITECTURAL AS BUILT

HOLIDAY MANOR APARTMENTS

Oxnard, CA 94901

01	100% SUBMISSION	SEE COVER SHEET
NO.	ISSUES REVISIONS	DATE
		SHEET TITLE
HL	PROJECT MANAGER	
HL	PROJECT DIRECTOR	
012317-1	PROJECT NUMBER	
1/8"=1'-0"	SCALE	
CL	DRAWN BY	
		SHEET NUMBER
AB-30		

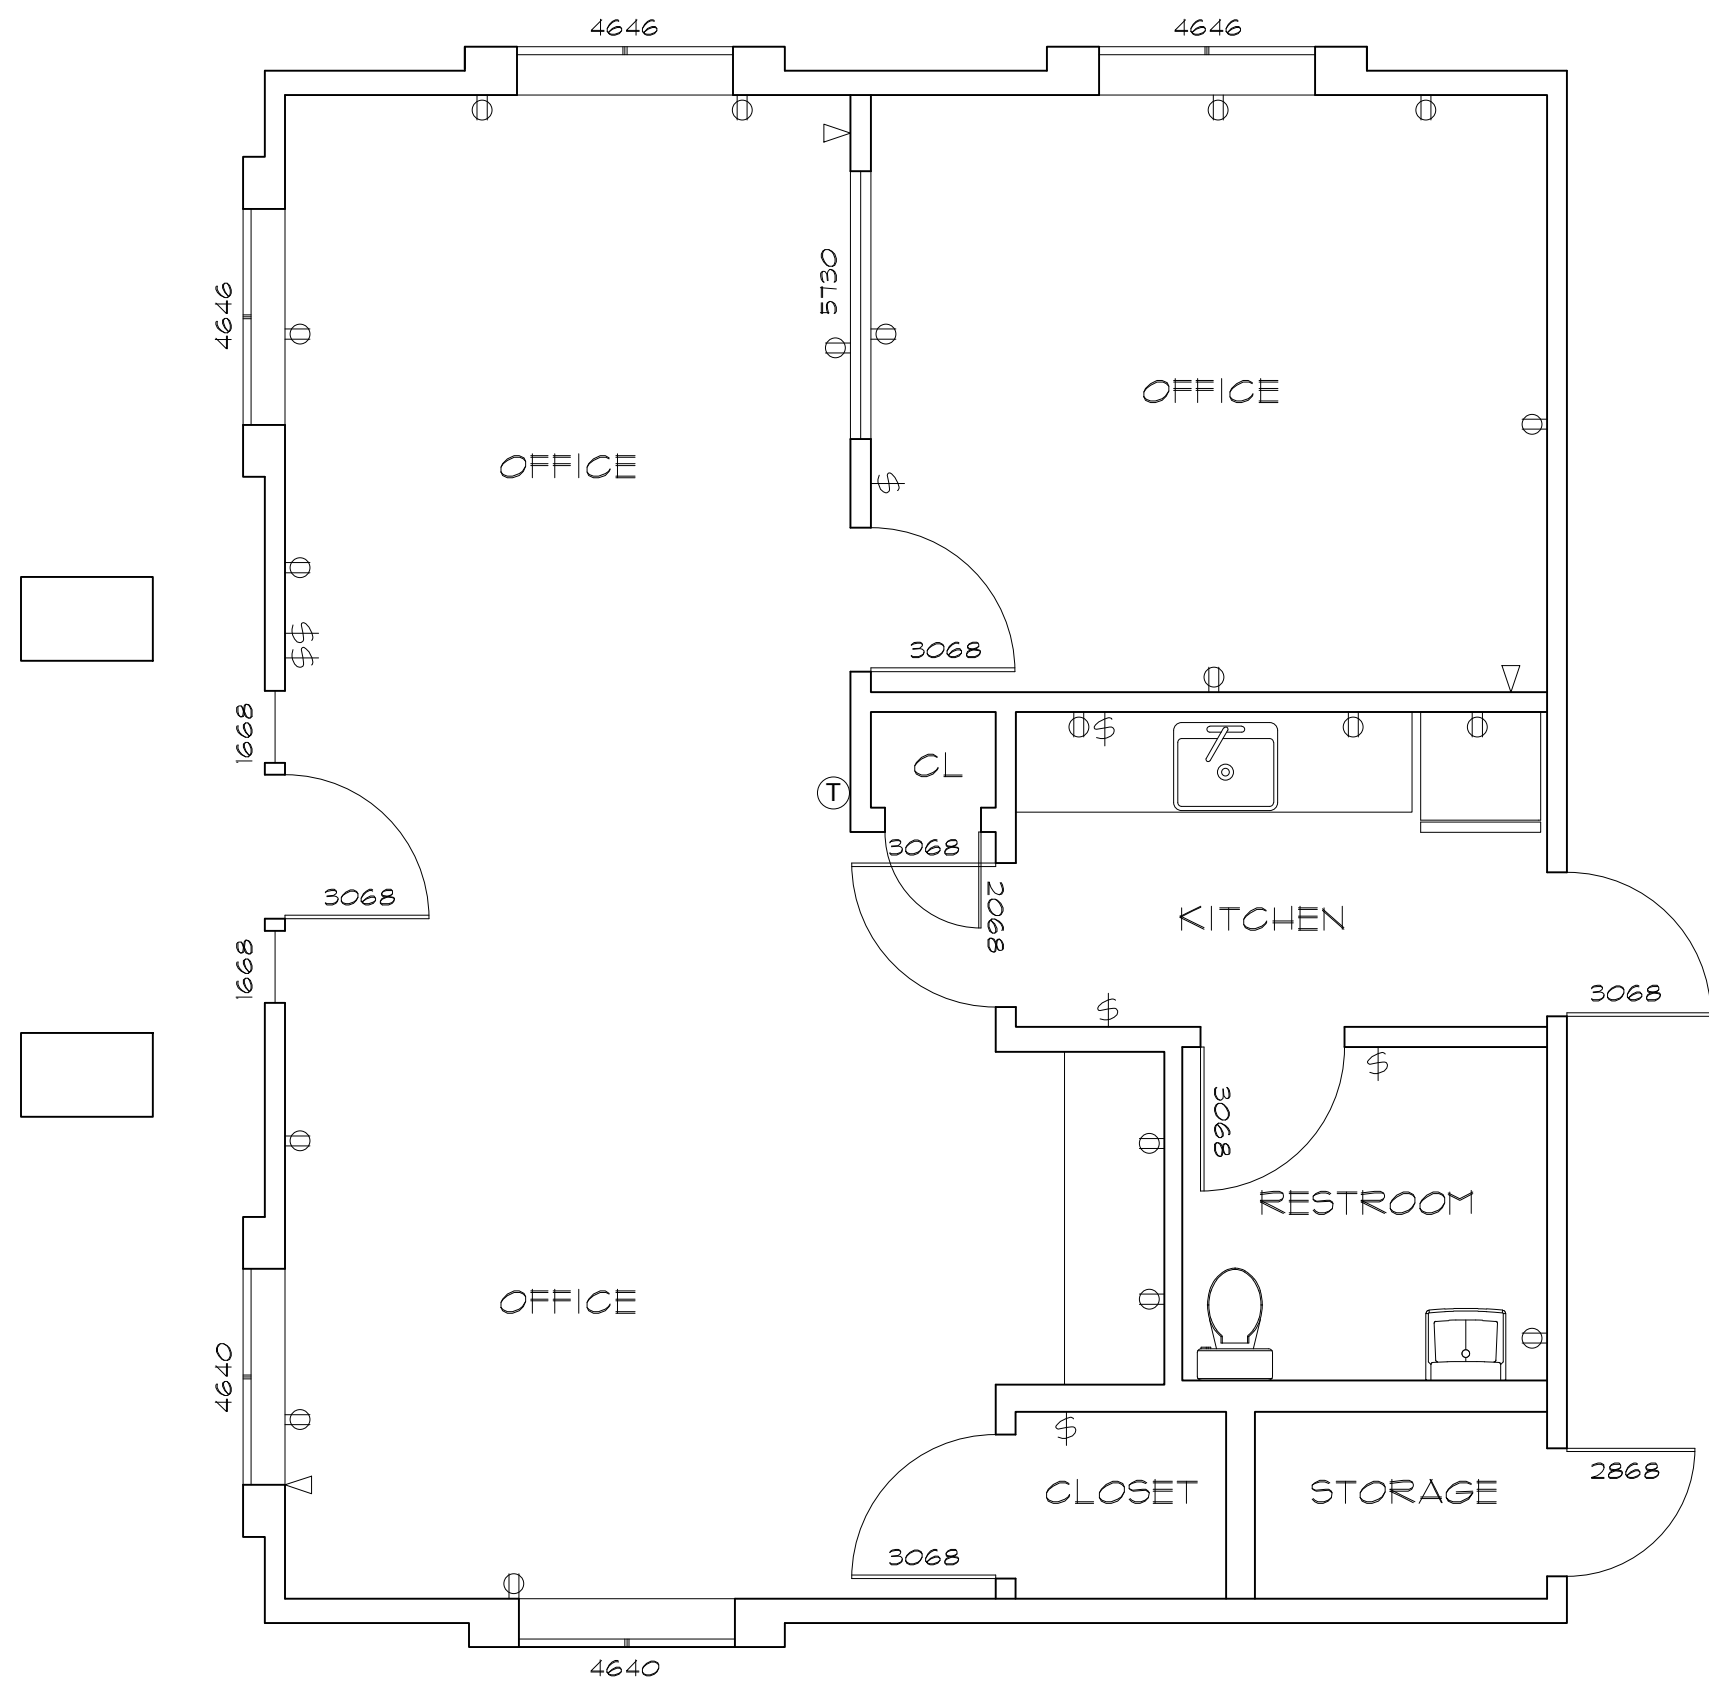

BUILDING 31 FLOOR PLAN

As BUILT

PROFESSIONALS

www.asbuiltprofessionals.com

A DIVISION OF:

AEC

CONSULTANTS INC

844.272.8458

844 AS BUILT

© 2019 AEC CONSULTANTS INC


ARCHITECTURAL AS BUILT

HOLIDAY MANOR APARTMENTS

Oxnard, CA 94901

01	100% SUBMISSION	SEE COVER SHEET
NO.	ISSUES REVISIONS	DATE
SHEET TITLE		
HL	PROJECT MANAGER	
HL	PROJECT DIRECTOR	
012317-1	PROJECT NUMBER	
1/4"=1'-0"	SCALE	
CL	DRAWN BY	
SHEET NUMBER		

AB-31

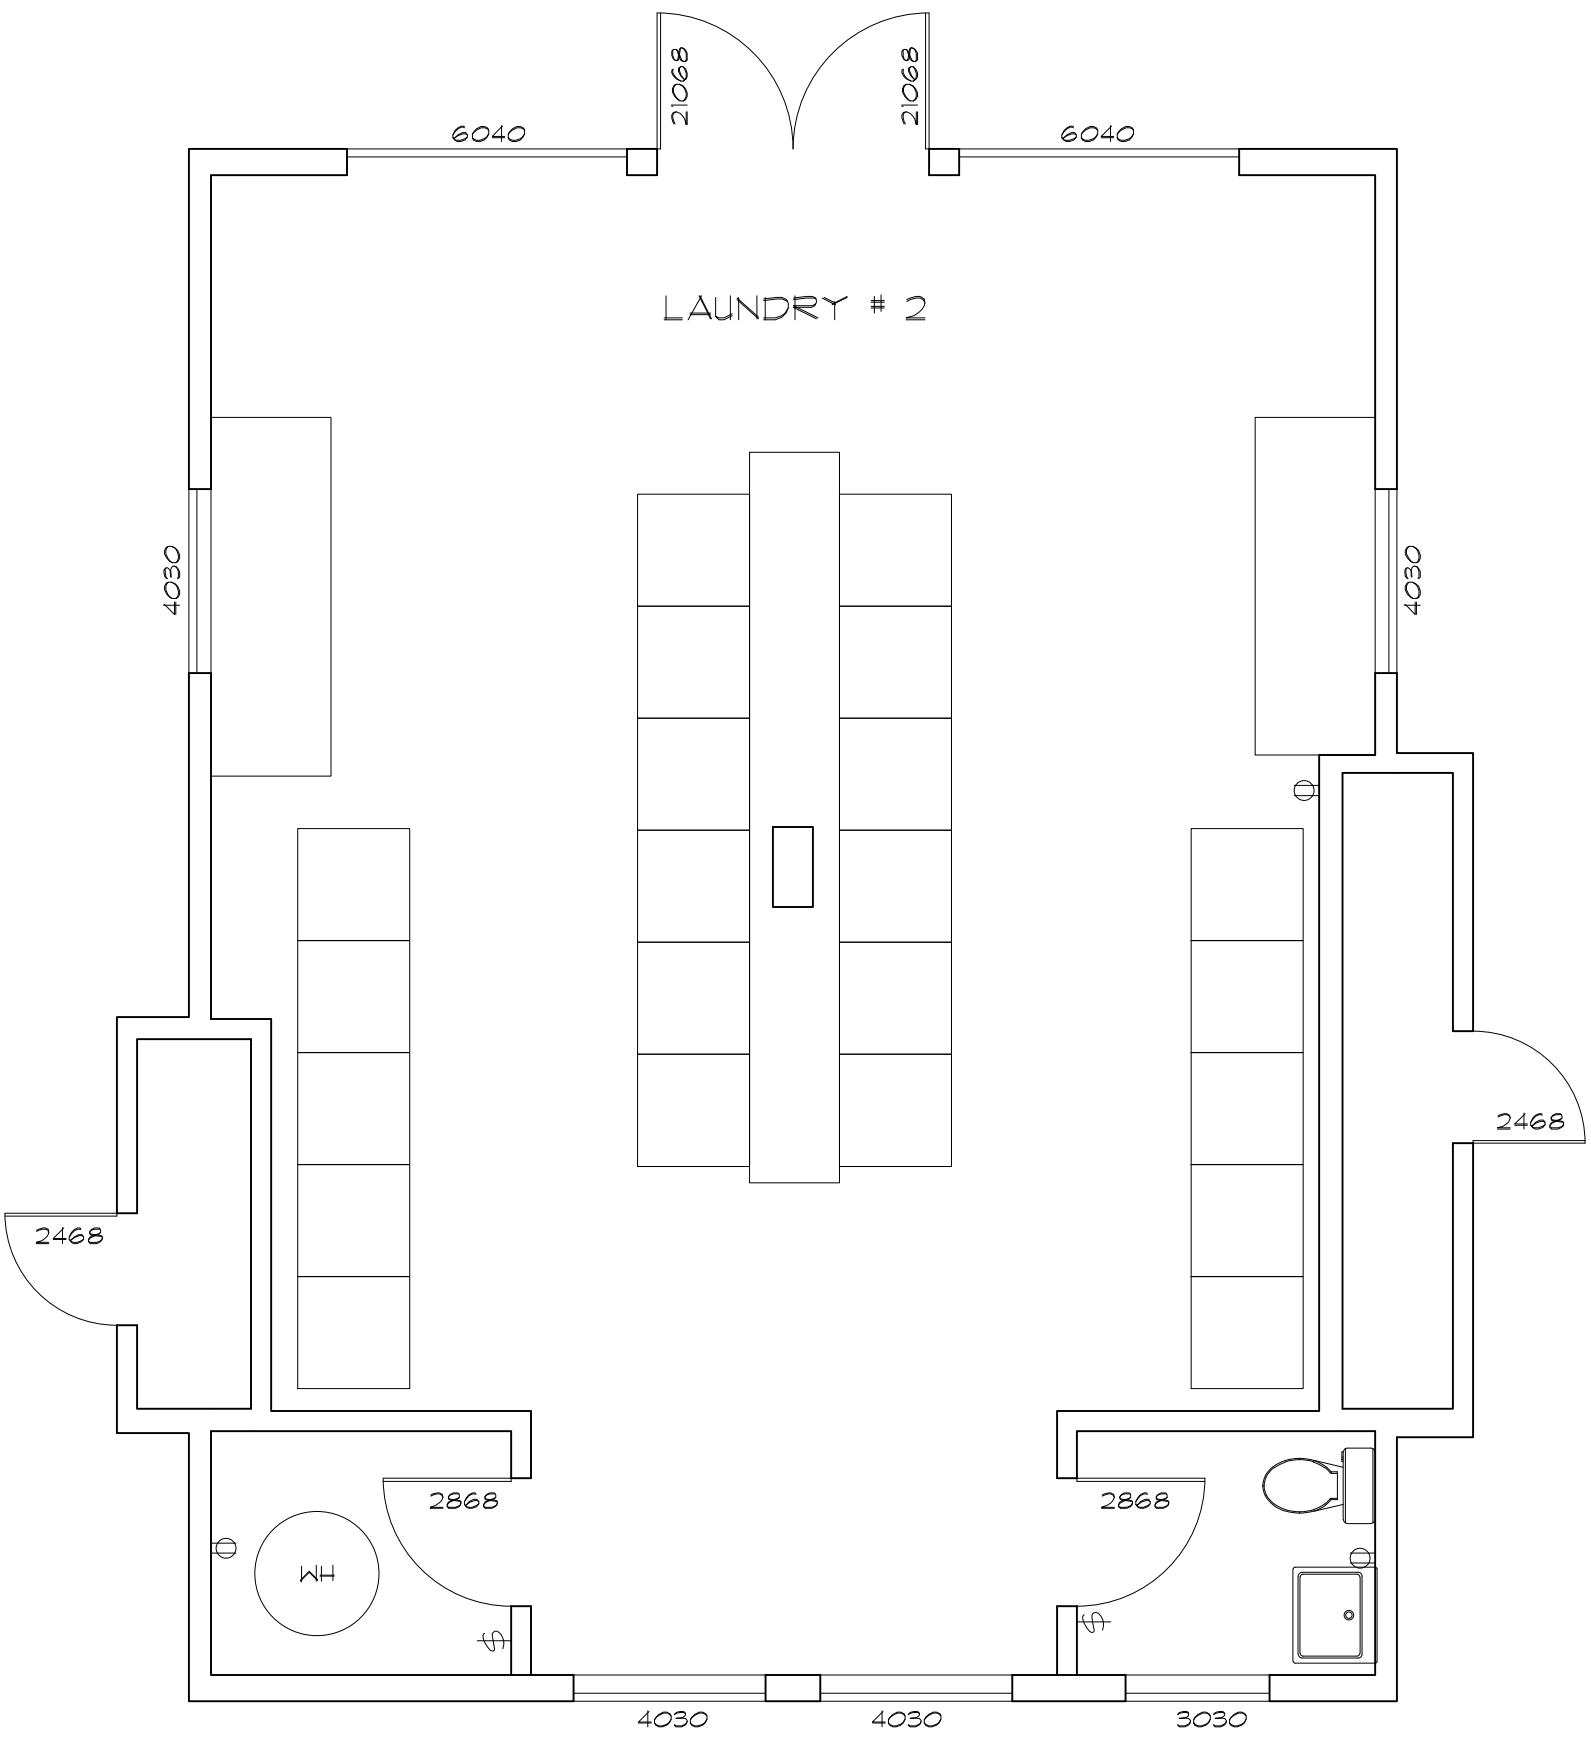

BUILDING 32 FLOOR PLAN

As BUILT

PROFESSIONALS

www.asbuiltprofessionals.com

A DIVISION OF:

AEC

CONSULTANTS INC

844.272.8458

844 ASBUILT

© 2018 AEC CONSULTANTS INC

ARCHITECTURAL AS BUILT

HOLIDAY MANOR APARTMENTS


Oxnard, CA 94901

01	100% SUBMISSION	SEE COVER SHEET
NO.	ISSUES REVISIONS	DATE
		SHEET TITLE
HL		PROJECT MANAGER
HL		PROJECT DIRECTOR
012317-1		PROJECT NUMBER
1/4"=1'-0"		SCALE
CL		DRAWN BY
		SHEET NUMBER
AB-32		



O1	100% SUBMISSION	SEE COVER SHEET
NO.	ISSUES REVISIONS	DATE
		SHEET TITLE
H/L		PROJECT MANAGER
H/L		PROJECT DIRECTOR
O12317-1		PROJECT NUMBER
1/4"=1'-0"		SCALE
CL		DRAWN BY
		SHEET NUMBER

AB-33

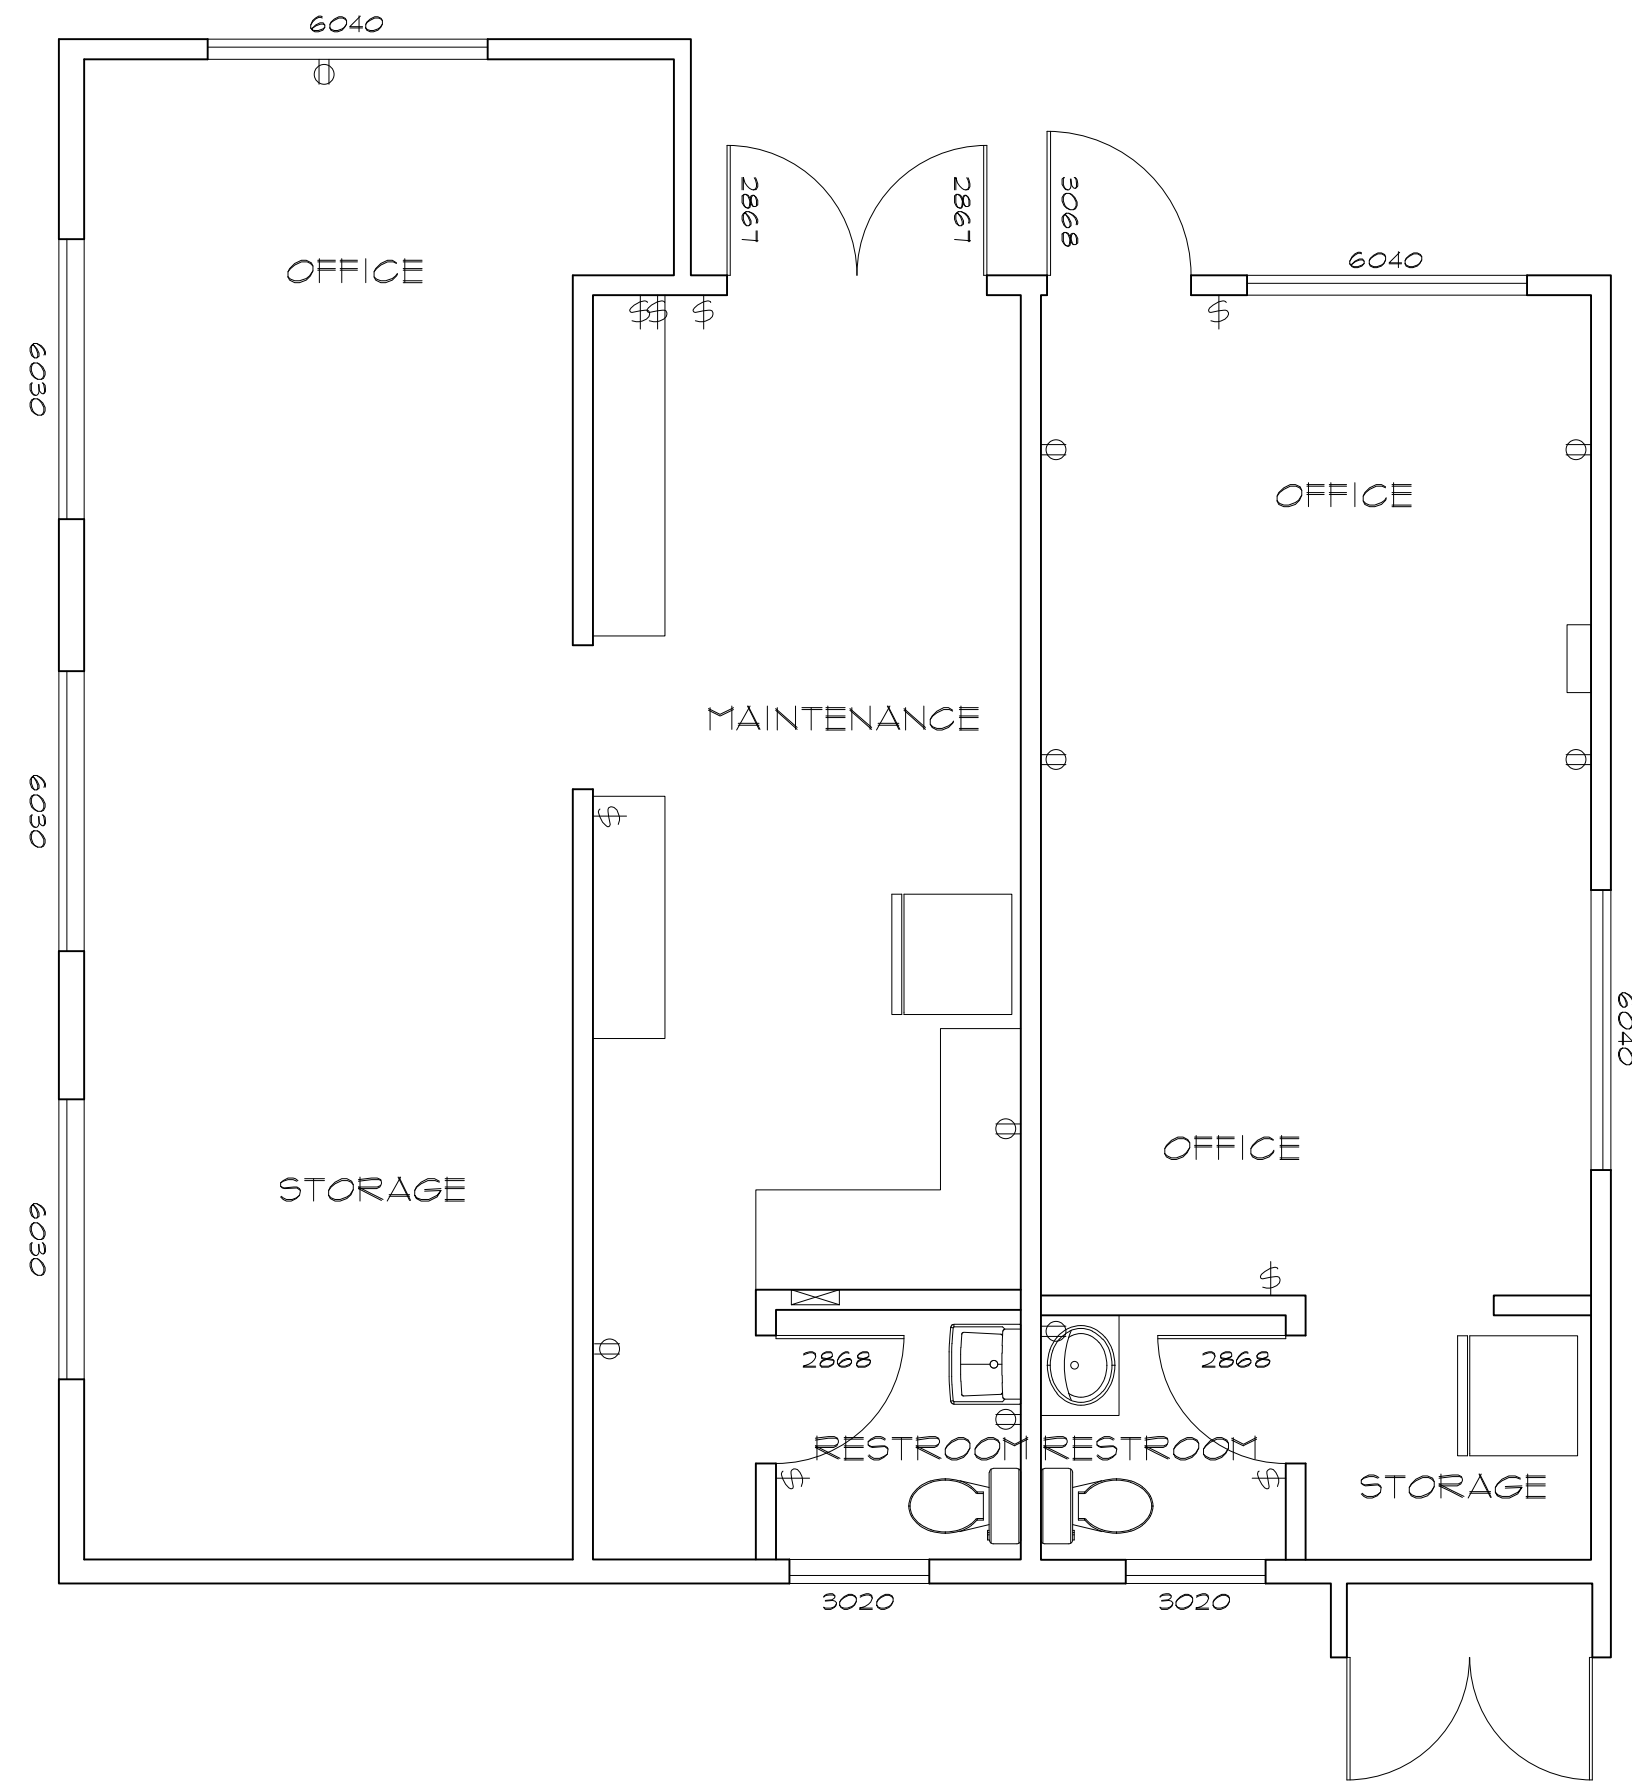

BUILDING 34 FLOOR PLAN

As BUILT

PROFESSIONALS

www.asbuiltprofessionals.com

A DIVISION OF:

AEC

CONSULTANTS INC

844.272.8458

844 AS BUILT

© 2019 AEC CONSULTANTS INC

ARCHITECTURAL AS BUILT


HOLIDAY MANOR APARTMENTS

Oxnard, CA 94901

01	100% SUBMISSION	SEE COVER SHEET
NO.	ISSUES REVISIONS	DATE
		SHEET TITLE
HL	PROJECT MANAGER	
HL	PROJECT DIRECTOR	
012317-1	PROJECT NUMBER	
1/4"=1'-0"	SCALE	
CL	DRAWN BY	
		SHEET NUMBER
AB-34		



© 2019 AEC CONSULTANTS INC.

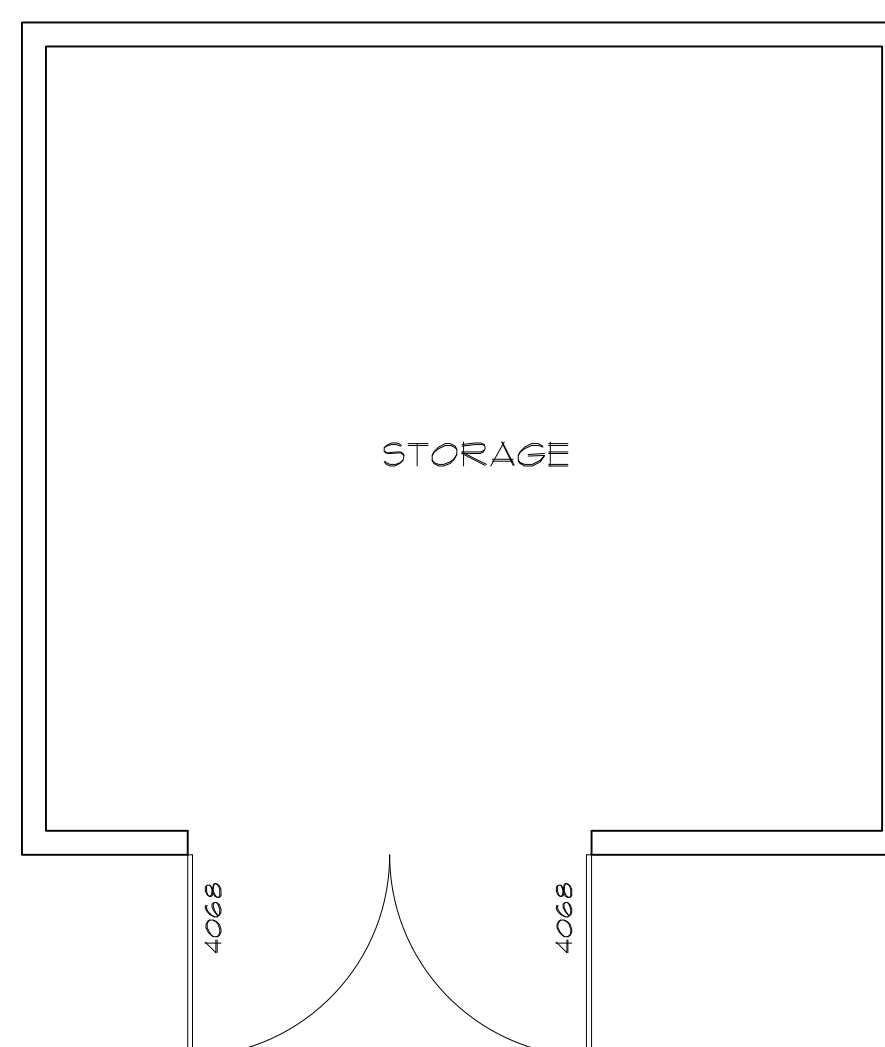


BUILDING 35 FLOOR PLAN

ARCHITECTURAL AS BUILT

HOLIDAY MANOR APARTMENTS

Oxnard, CA 94901

01	100% SUBMISSION	SEE COVER SHEET
NO.	ISSUES REVISIONS	DATE
		SHEET TITLE
HL	PROJECT MANAGER	
HL	PROJECT DIRECTOR	
012317-1	PROJECT NUMBER	
1/4"=1'-0"	SCALE	
CL	DRAWN BY	
		SHEET NUMBER
AB-35		

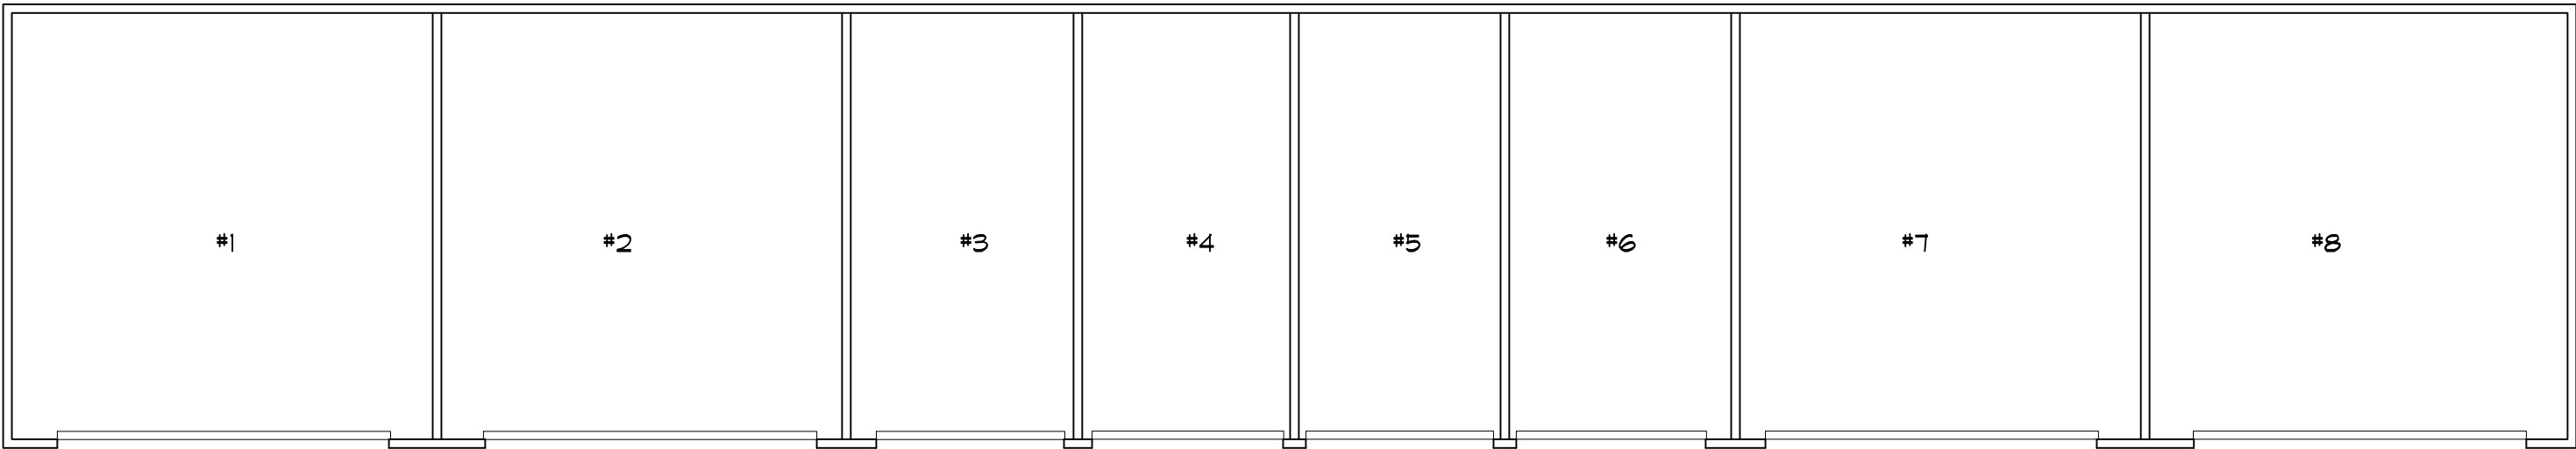

BUILDING 36 FLOOR PLAN

As BUILT

PROFESSIONALS

www.asbuiltprofessionals.com

A DIVISION OF:

AEC

CONSULTANTS INC

844.272.8458

844 A S B U I L T

© 2019 AEC CONSULTANTS INC


ARCHITECTURAL AS BUILT

HOLIDAY MANOR APARTMENTS

Oxnard, CA 94901

01	100% SUBMISSION	SEE COVER SHEET
NO.	ISSUES REVISIONS	DATE
		SHEET TITLE
HL		PROJECT MANAGER
HL		PROJECT DIRECTOR
012317-1		PROJECT NUMBER
1/8"=1'-0"		SCALE
CL		DRAWN BY
		SHEET NUMBER

AB-36

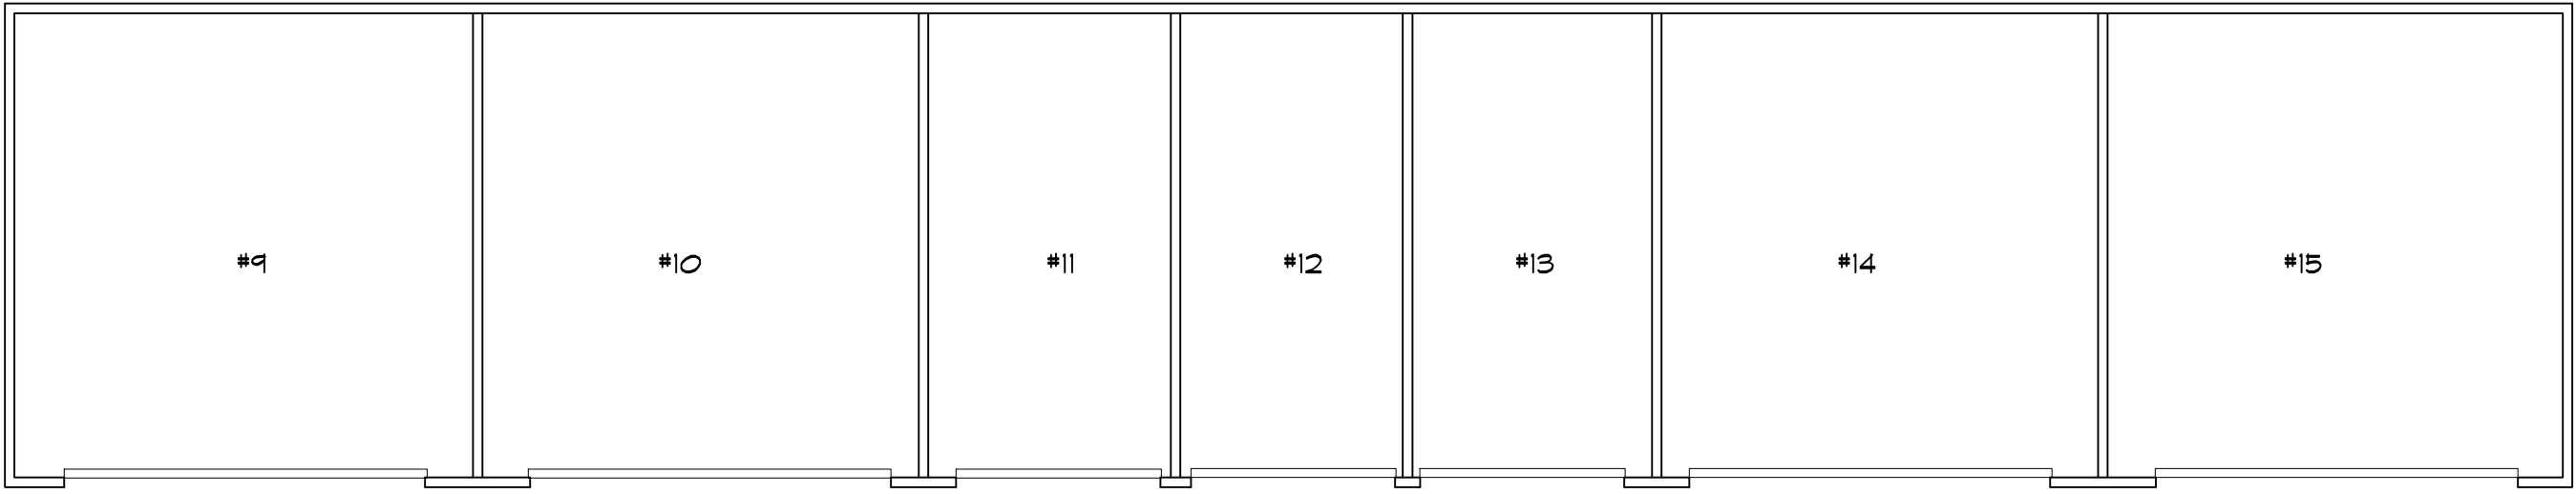

BUILDING 37 FLOOR PLAN

As BUILT

PROFESSIONALS

www.asbuiltprofessionals.com

A DIVISION OF:

AEC

CONSULTANTS INC

844.272.8458

844 A S B U I L T


© 2019 AEC CONSULTANTS INC

ARCHITECTURAL AS BUILT

HOLIDAY MANOR APARTMENTS

Oxnard, CA 94901

01	100% SUBMISSION	SEE COVER SHEET
NO.	ISSUES REVISIONS	DATE
		SHEET TITLE
HL		PROJECT MANAGER
HL		PROJECT DIRECTOR
012317-1		PROJECT NUMBER
1/8"=1'-0"		SCALE
CL		DRAWN BY
		SHEET NUMBER
AB-37		

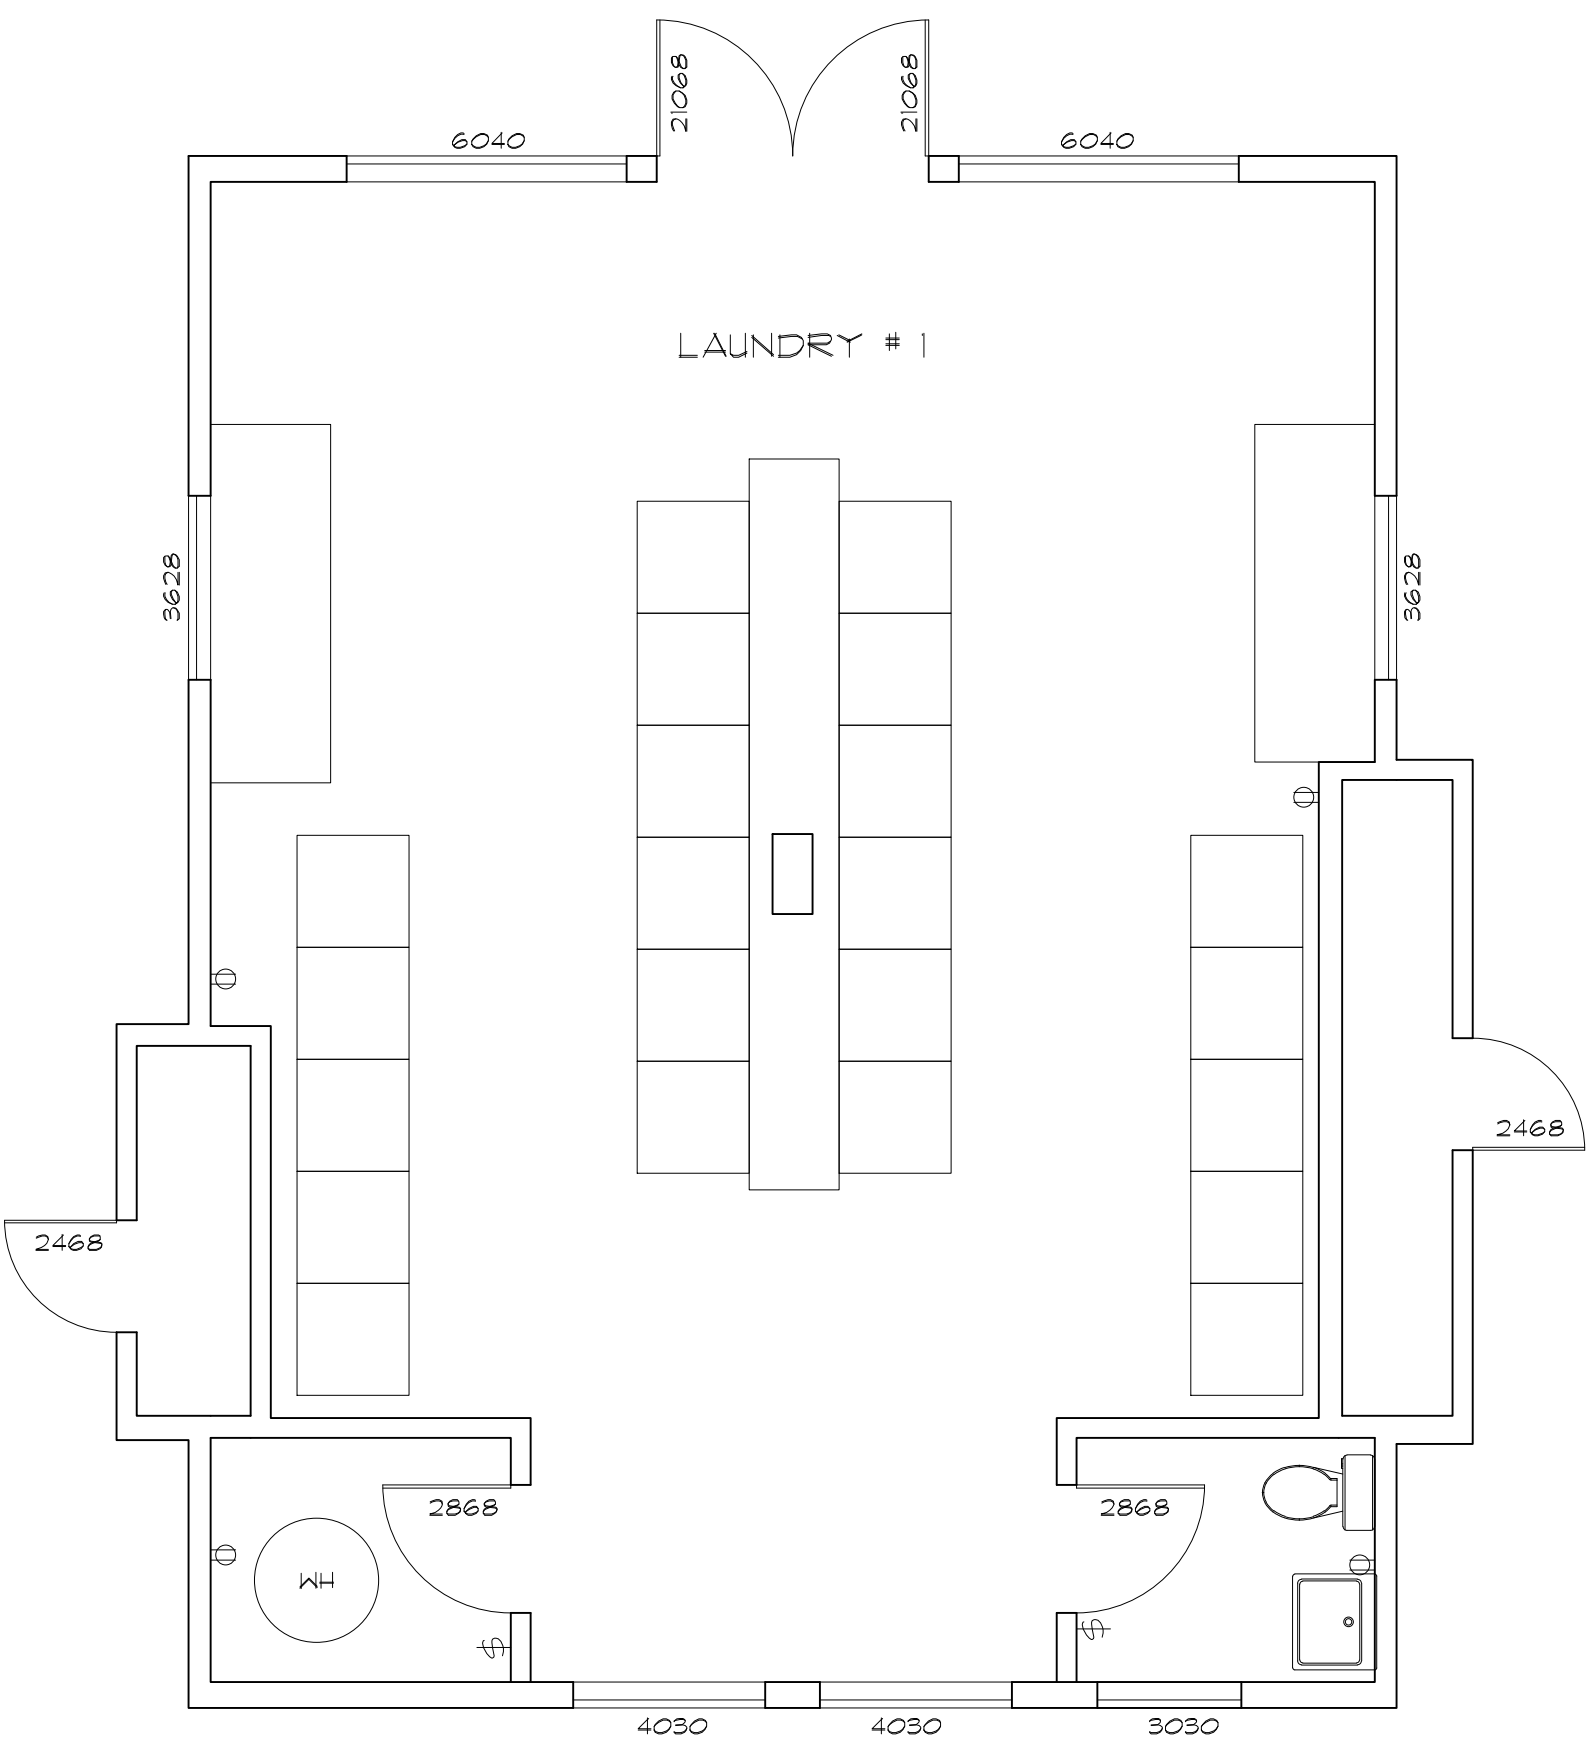

BUILDING 38 FLOOR PLAN

As BUILT

PROFESSIONALS

www.asbuiltprofessionals.com

A DIVISION OF:

AEC

CONSULTANTS INC

844.272.8458

844 AS BUILT

© 2019 AEC CONSULTANTS INC


ARCHITECTURAL AS BUILT

HOLIDAY MANOR APARTMENTS

Oxnard, CA 94901

01	100% SUBMISSION	SEE COVER SHEET
NO.	ISSUES REVISIONS	DATE
		SHEET TITLE
HL		PROJECT MANAGER
HL		PROJECT DIRECTOR
012317-1		PROJECT NUMBER
1/4"=1'-0"		SCALE
CL		DRAWN BY
		SHEET NUMBER

 AB-38



BUILDING 39 FLOOR PLAN

As BUILT

PROFESSIONALS

www.asbuiltprofessionals.com

A DIVISION OF:

AEC

CONSULTANTS INC

844.272.8458

844 A S B U I L T

@ 2019 AEC CONSULTANTS INC

ARCHITECTURAL AS BUILT

HOLIDAY MANOR APARTMENTS

Oxnard, CA 94901

01	100% SUBMISSION	SEE COVER SHEET
NO.	ISSUES REVISIONS	DATE
		SHEET TITLE
HL		PROJECT MANAGER
HL		PROJECT DIRECTOR
012317-1		PROJECT NUMBER
1/4"=1'-0"		SCALE
CL		DRAWN BY
		SHEET NUMBER
AB-39		