


AS-BUILT DOCUMENTATION

Milledgeville, GA 31061

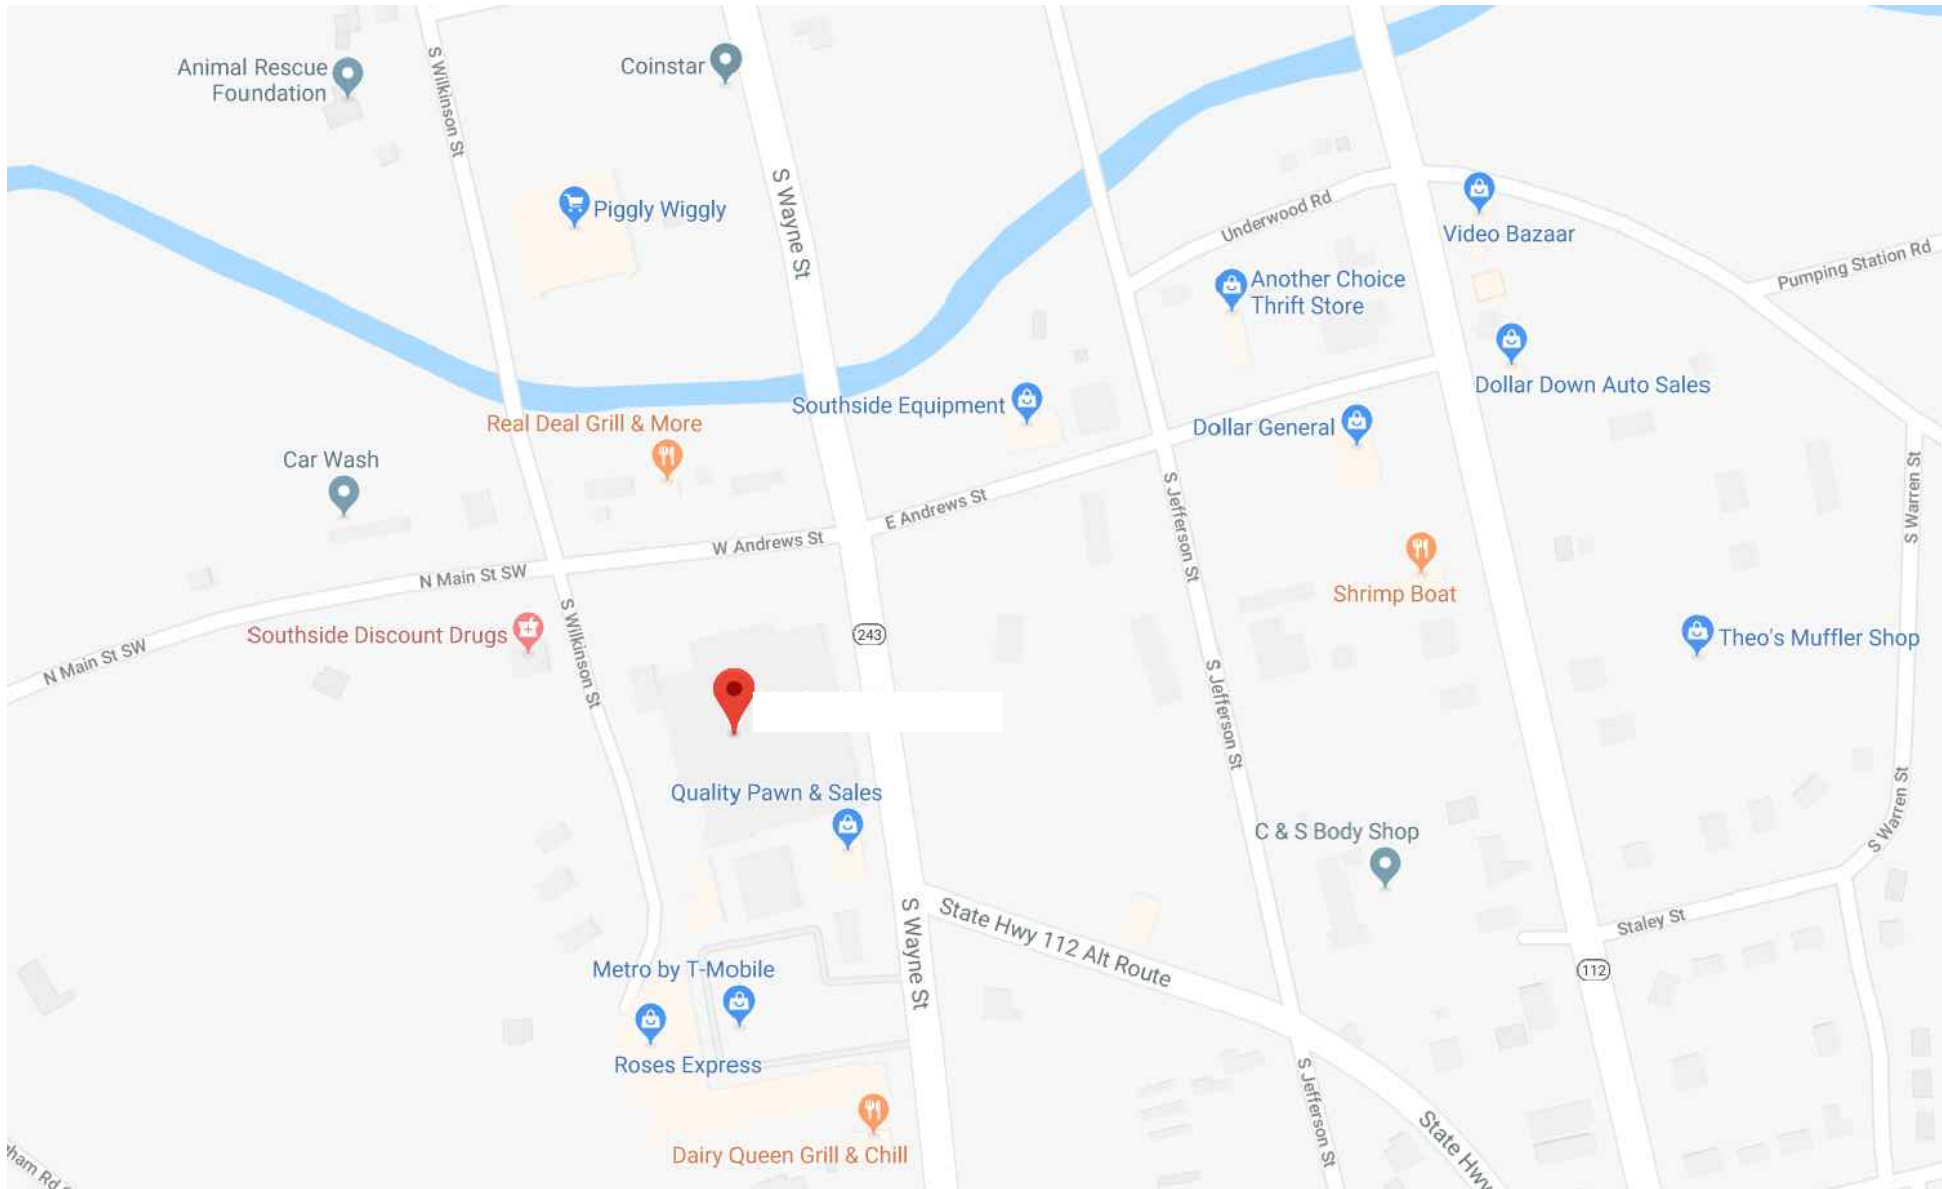

VICINITY MAP
NTS

AREA DATA	
BASEMENT FLOOR	2,765 S.F. ±
FIRST FLOOR	96,535 S.F. ±
SECOND FLOOR	2,722 S.F. ±
GRAND TOTAL	102,022 S.F. ±

DRAWING INDEX

- C-1COVER SHEET | DRAWING INDEX
- SLSYMBOLS LEGEND
- AB-1FIRST FLOOR PLAN
- AB-2REFLECTED CEILING PLAN
- AB-3ROOF PLAN
- AB-4EXTERIOR ELEVATIONS
- AB-5BUILDING SECTIONS

AS BUILT

PROFESSIONALS

www.asbuiltprofessionals.com

A DIVISION OF:

AEC

CONSULTANTS INC

844.272.8458

844 AS BUILT

© 2018 AEC CONSULTANTS INC

ARCHITECTURAL AS BUILT

Milledgeville, GA 31061

100% SUBMITTAL

01	100% SUBMISSION	SEE COVER SHEET
NO.	ISSUES REVISIONS	DATE
		SHEET TITLE
COVER SHEET		
HL	PROJECT MANAGER	
HL	PROJECT DIRECTOR	
012317-1	PROJECT NUMBER	
	SCALE	
CL	DRAWN BY	
	SHEET NUMBER	
C-1		

ARCHITECTURAL AS BUILT
Milledgeville, GA 31061


01	100% SUBMISSION	SEE COVER SHEET
NO.	ISSUES REVISIONS	DATE

SHEET TITLE

FIRST FLOOR PLAN

HL	PROJECT MANAGER
HL	PROJECT DIRECTOR
012317-1	PROJECT NUMBER
1/16"=1'-0"	SCALE
CL	DRAWN BY
	SHEET NUMBER

AB-1

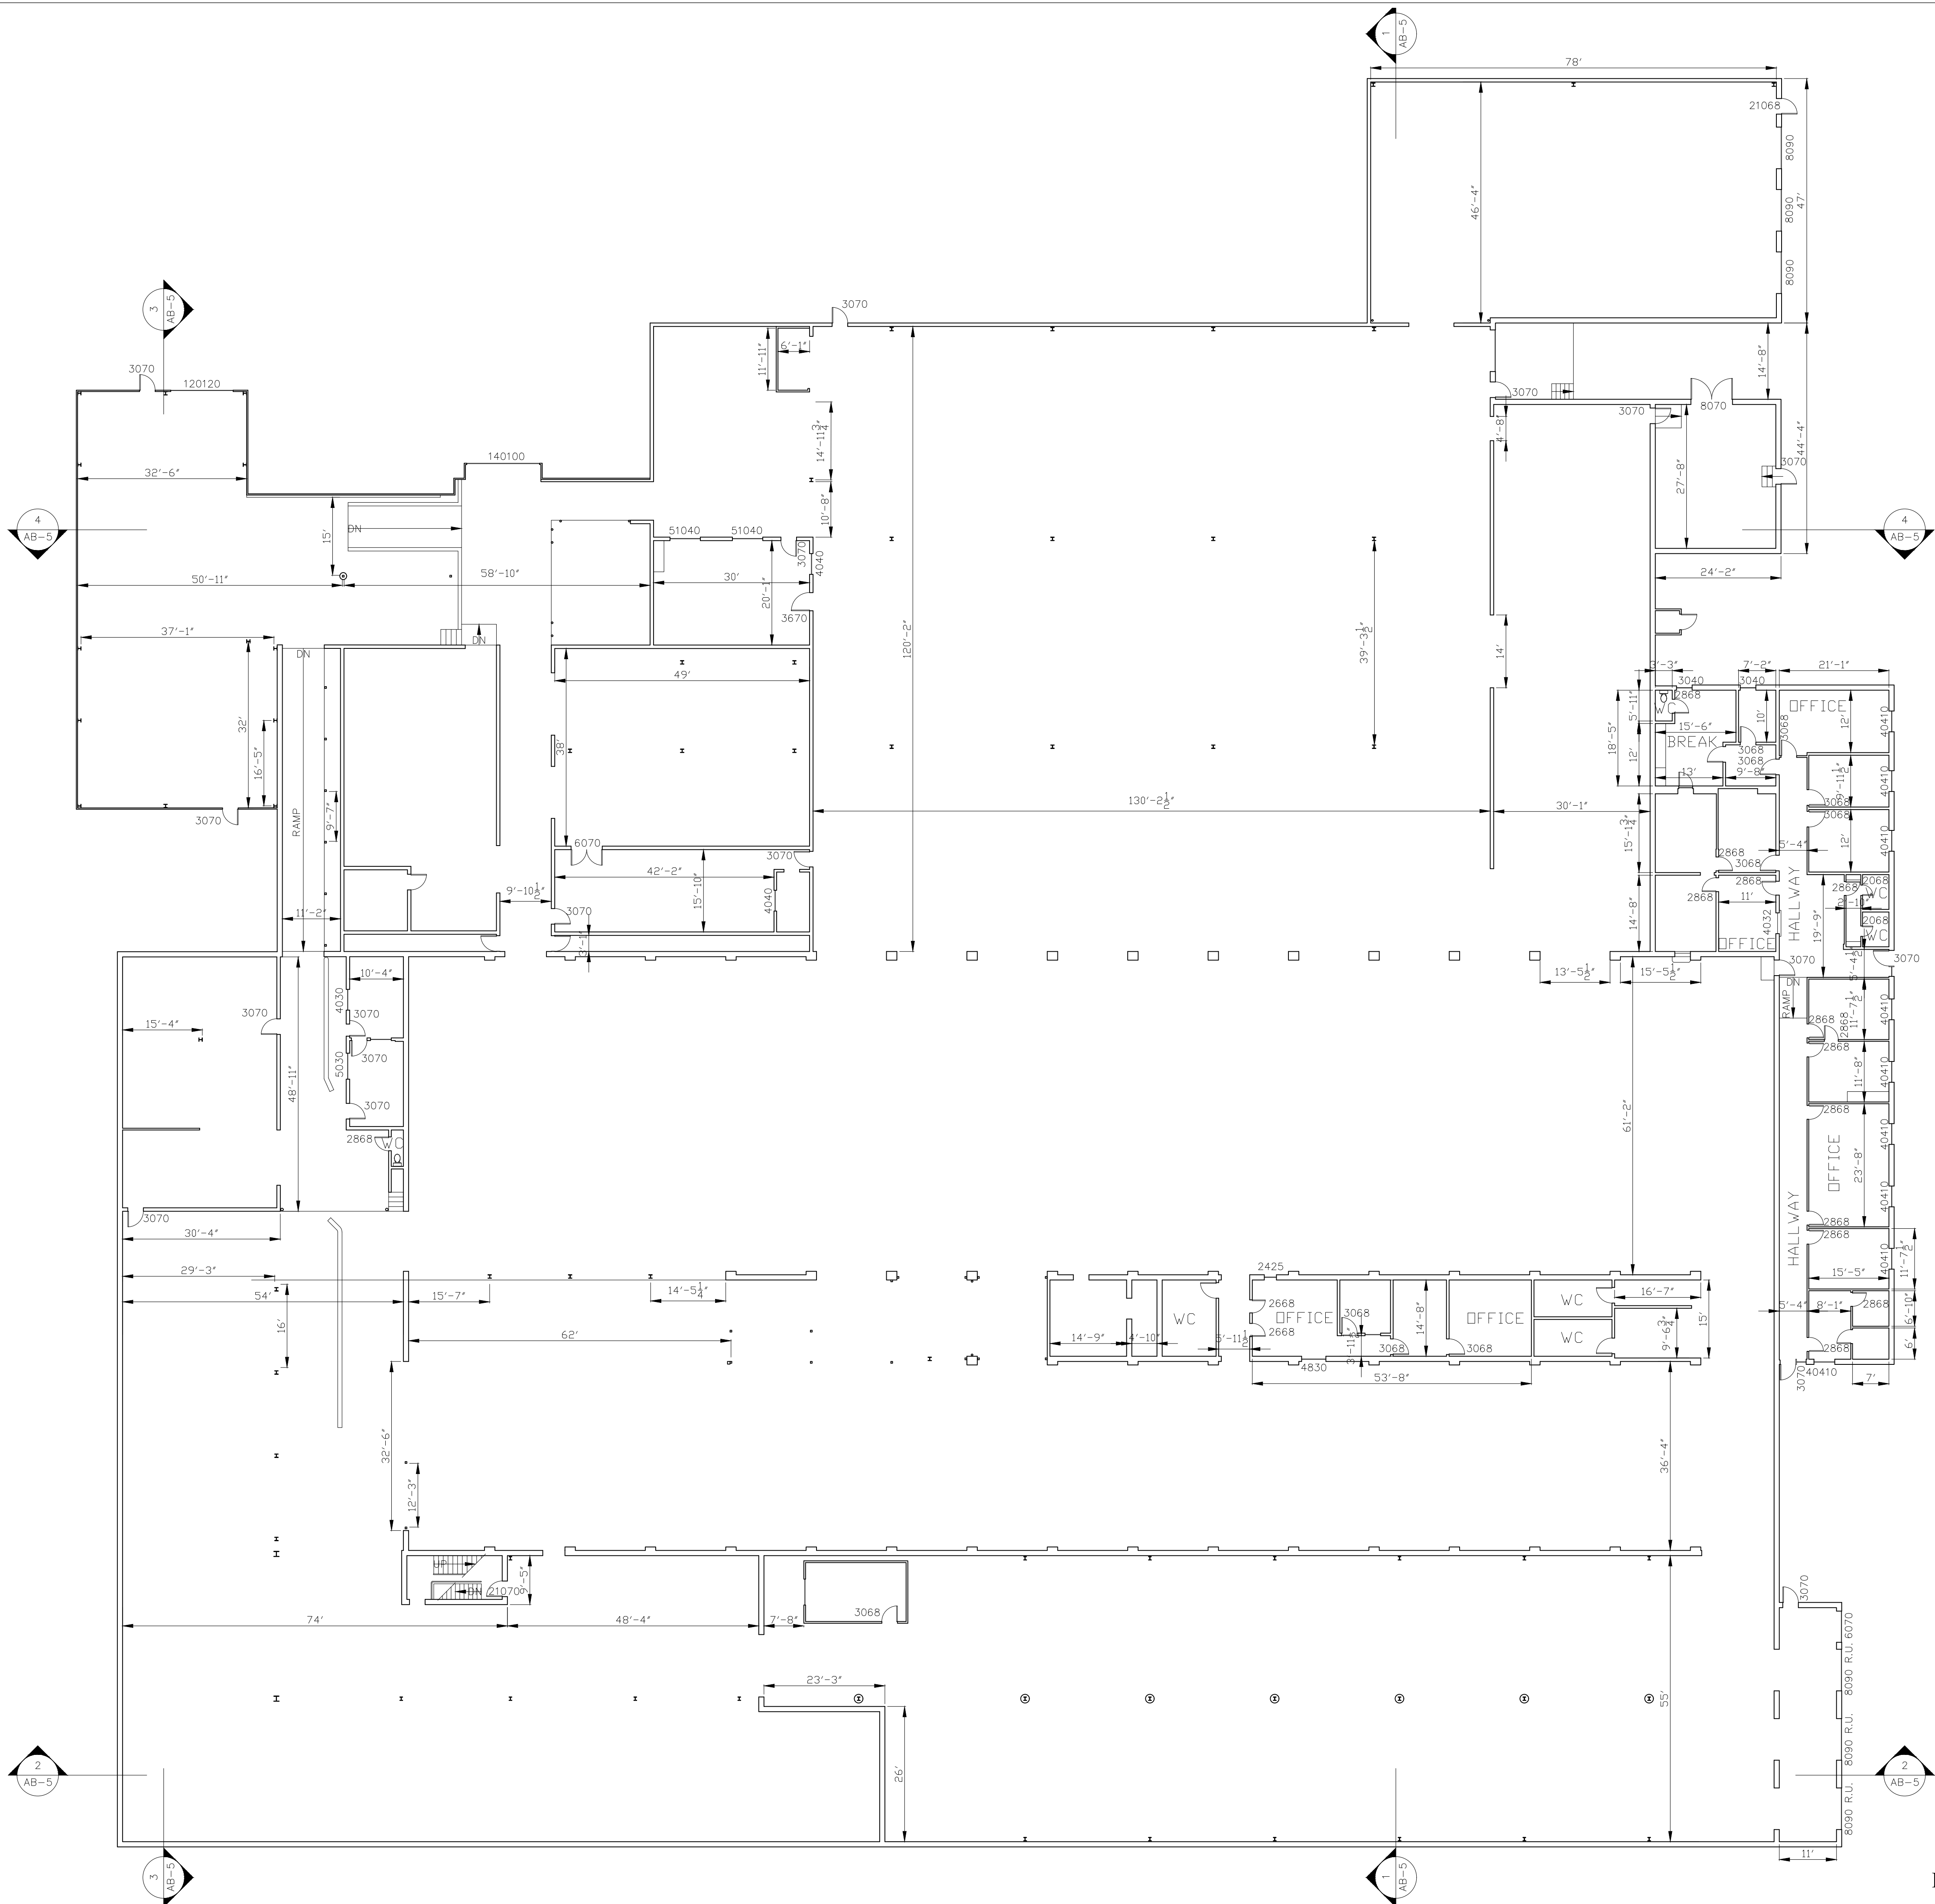

FIRST FLOOR



AB-2

AB-2




ARCHITECTURAL AS BUILT

Milledgeville, GA 31061


01	100% SUBMISSION	SEE COVER SHEET
NO.	ISSUES REVISIONS	DATE
		SHEET TITLE
ROOF PLAN		
HL		PROJECT MANAGER
HL		PROJECT DIRECTOR
012317-1		PROJECT NUMBER
1/16"=1'-0"		SCALE
CL		DRAWN BY
		SHEET NUMBER
AB-3		




ROOF PLAN 

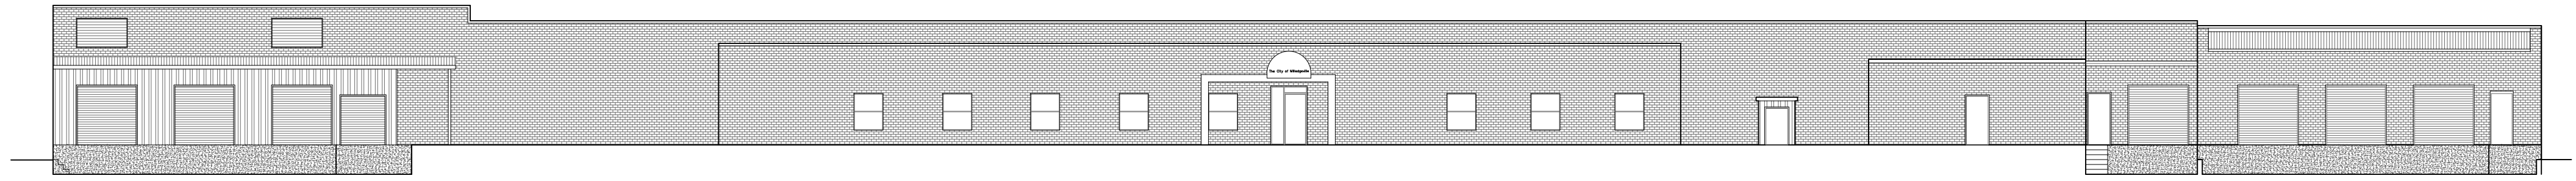


NORTH

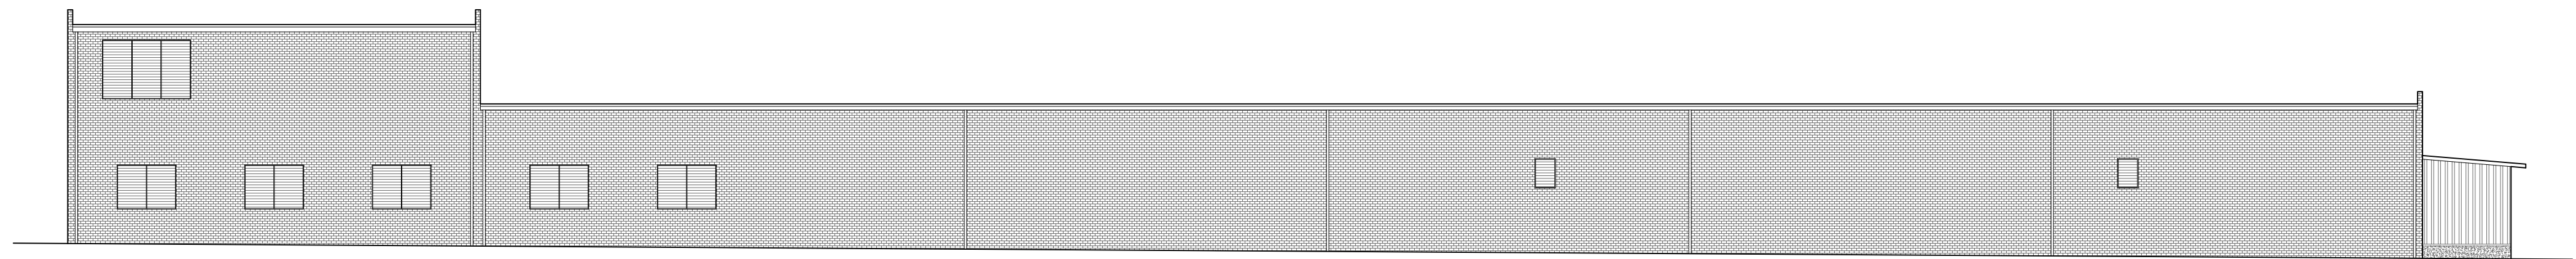

EAST

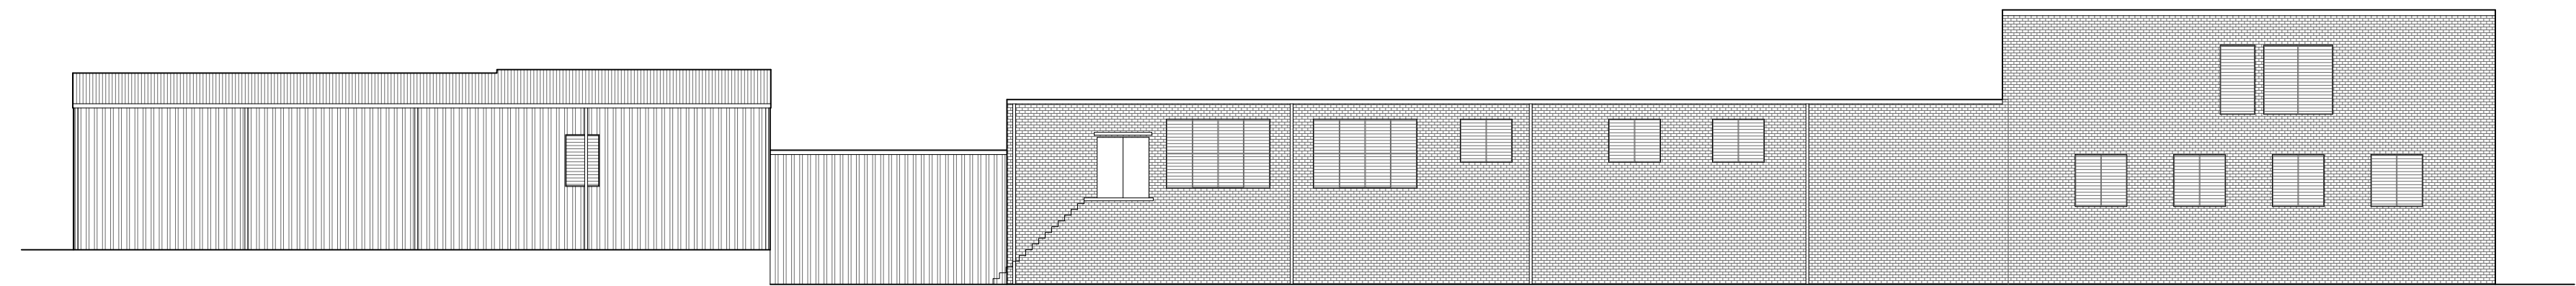

SOUTH

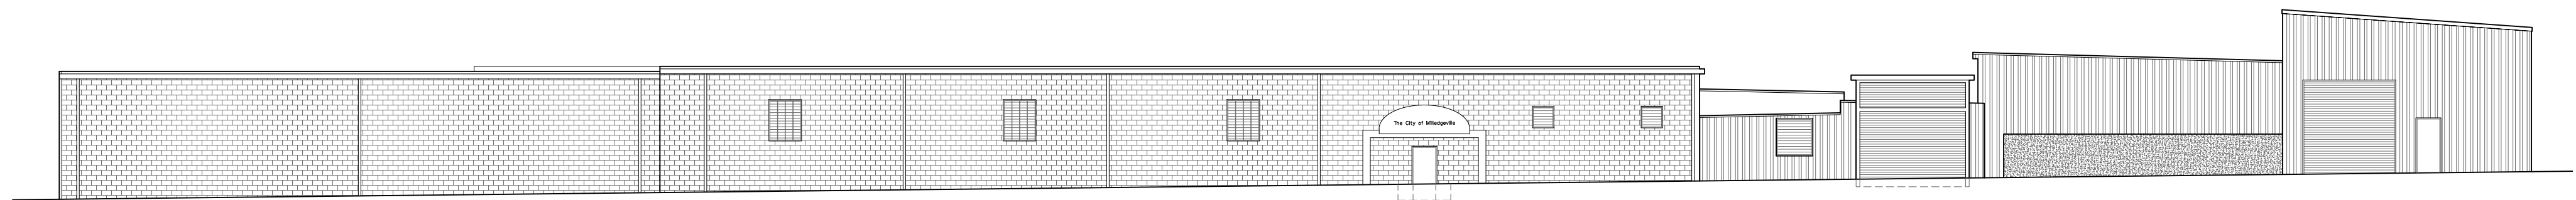


WEST


ARCHITECTURAL AS BUILT

Milledgeville, GA 31061


01	100% SUBMISSION	SEE COVER SHEET
NO.	ISSUES REVISIONS	DATE
		SHEET TITLE
ELEVATIONS		
HL		PROJECT MANAGER
HL		PROJECT DIRECTOR
012317-1		PROJECT NUMBER
1/16"=1'-0"		SCALE
CL		DRAWN BY
		SHEET NUMBER
AB-4		

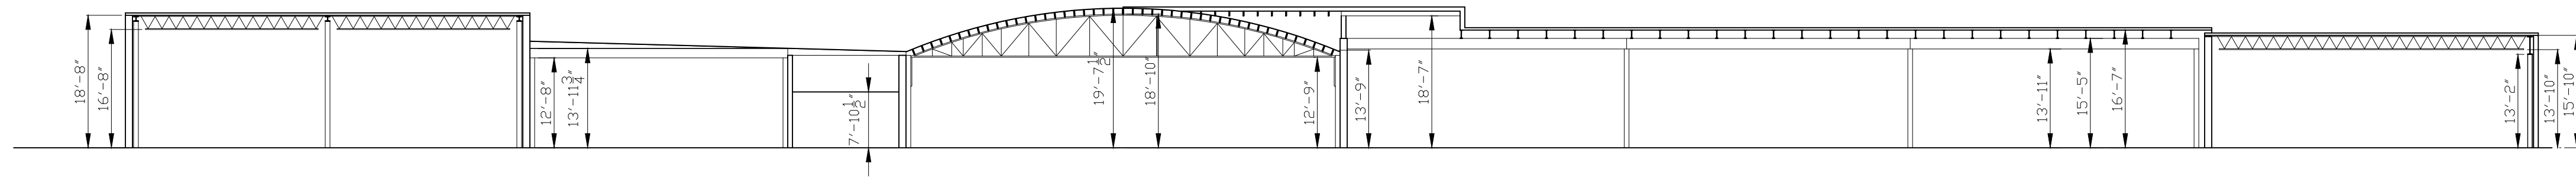


SECTION 1

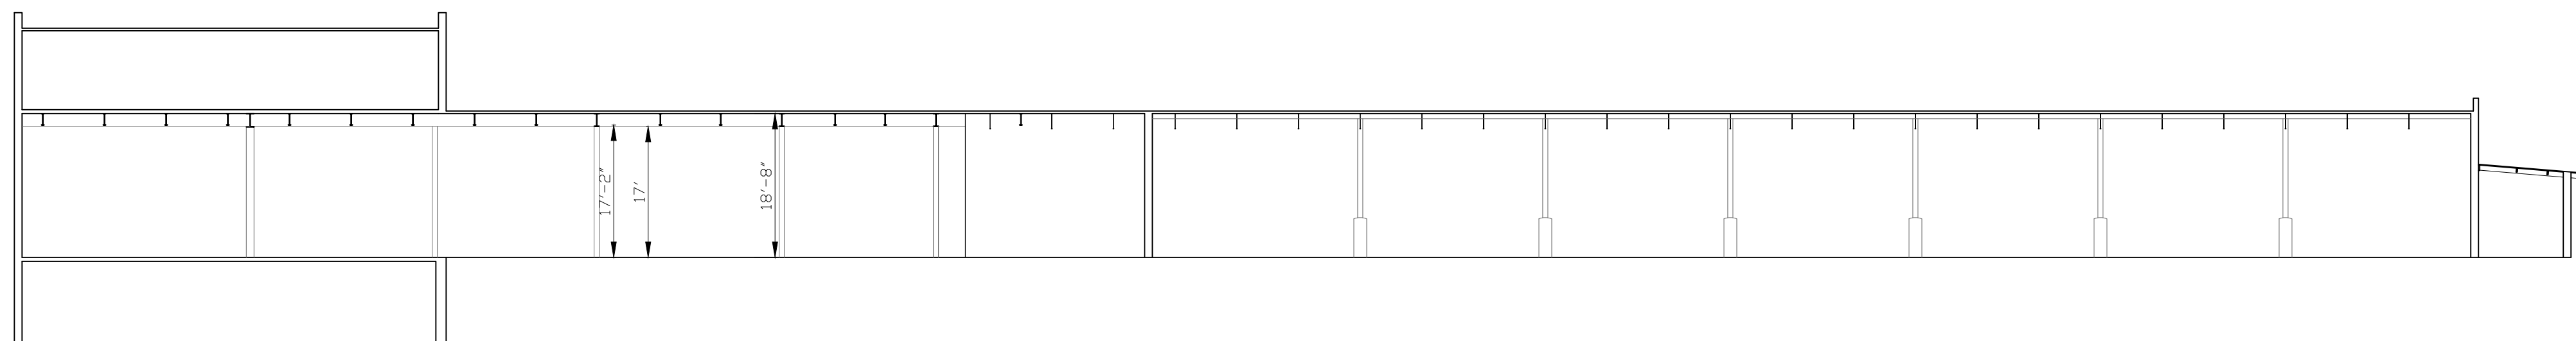

SECTION 2

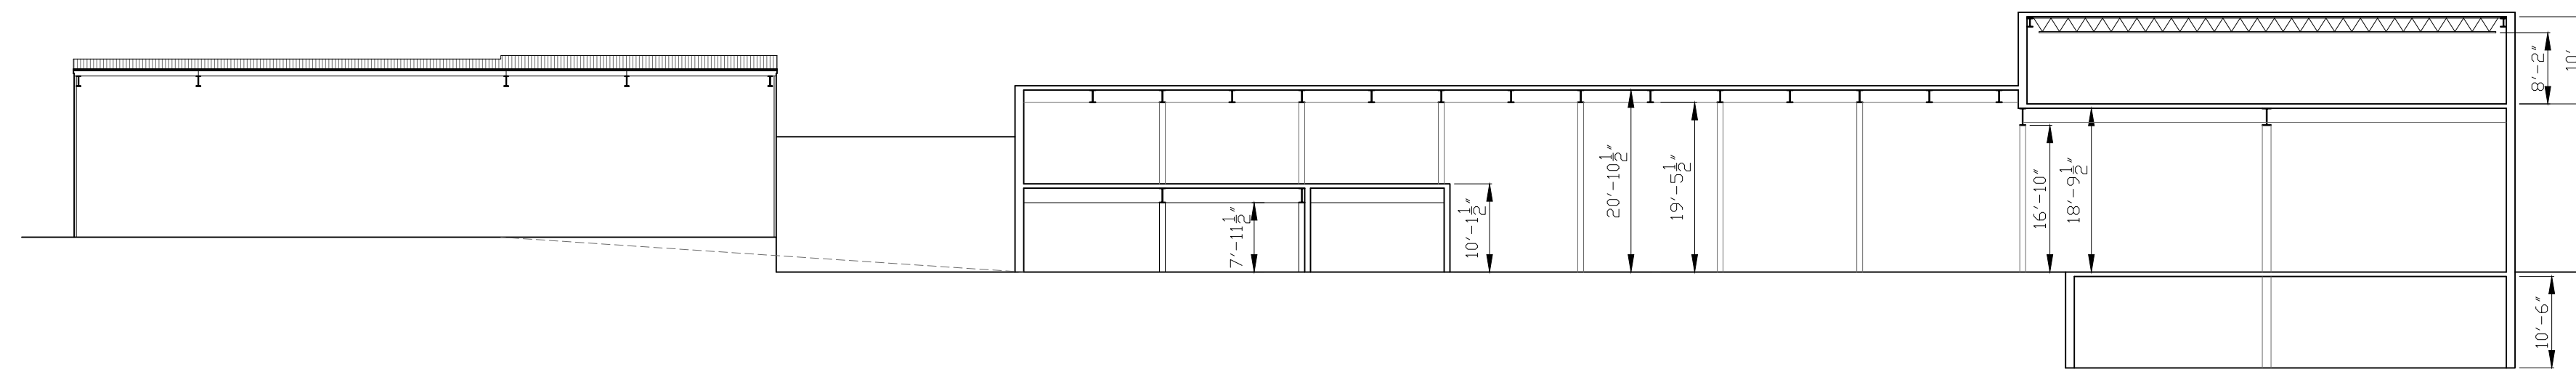

SECTION 3

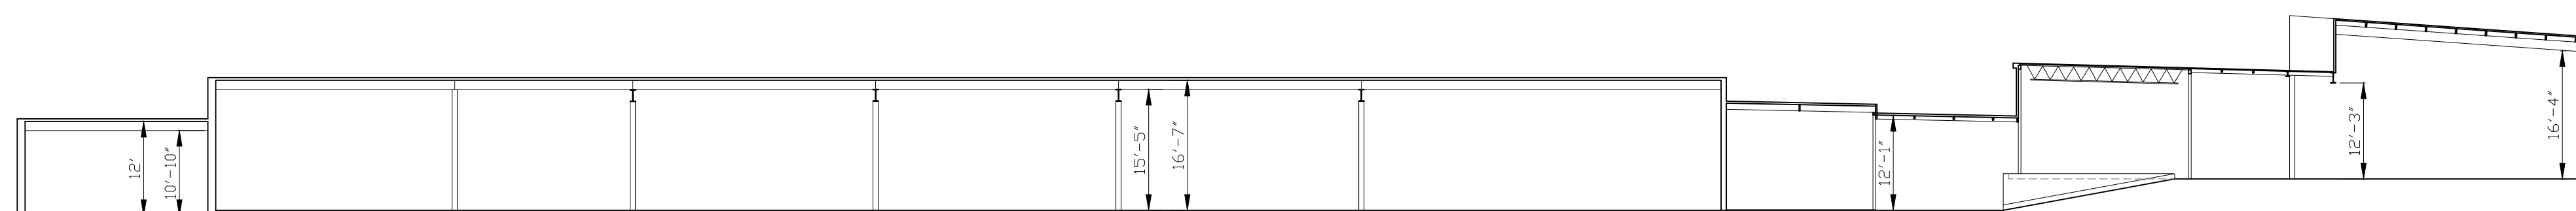

SECTION 4

ARCHITECTURAL AS BUILT

Milledgeville, GA 31061

01	100% SUBMISSION	SEE COVER SHEET
NO.	ISSUES REVISIONS	DATE
		SHEET TITLE
BUILDING SECTIONS		
HL		PROJECT MANAGER
HL		PROJECT DIRECTOR
012317-1		PROJECT NUMBER
1/16"=1'-0"		SCALE
CL		DRAWN BY
		SHEET NUMBER
AB-5		