

# AS-BUILT DOCUMENTATION

## KENSINGTON APARTMENTS


## SACRAMENTO, CA 95821



100% SUBMITTAL

### DRAWING INDEX

- C-1 COVER SHEET | DRAWING INDEX
- SL SYMBOLS LEGEND
- AB-1 CLUBHOUSE FLOOR PLAN
- AB-2 CLUBHOUSE RCP
- AB-3 CLUBHOUSE ROOF PLAN
- AB-4 CLUBHOUSE ELEVATIONS
- AB-5 CLUBHOUSE ELEVATIONS
- AB-6 LAUNDRY ROOMS

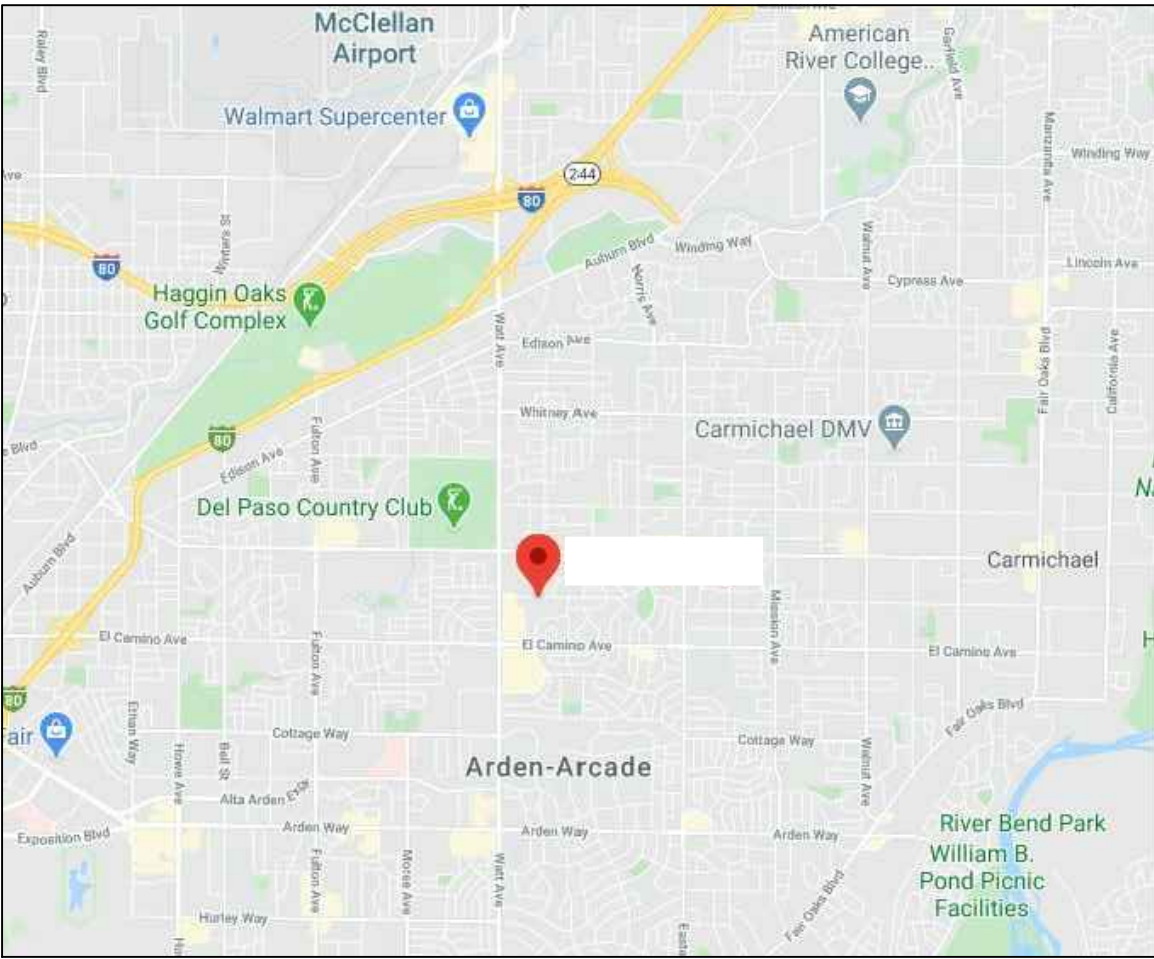

VICINITY MAP  
NTS

AREA DATA	
CLUB HOUSE	3,371 S.F. ±
LAUNDRY #1	299 S.F. ±
LAUNDRY #2	137 S.F. ±
LAUNDRY #4	299 S.F. ±
LAUNDRY #5	299 S.F. ±
TOTAL	4,405 S.F. ±

AS BUILT

PROFESSIONALS

www.asbuiltprofessionals.com

A DIVISION OF:

AEC

CONSULTANTS INC

844.272.8458

844 AS BUILT

© 2020 AEC CONSULTANTS, INC.

ARCHITECTURAL AS BUILT  
KENSINGTON APARTMENTS  
SACRAMENTO, CA 95821

01100% SUBMISSION

NO. ISSUES | REVISIONS

DATE

SHEET TITLE

COVER SHEET

HLPROJECT MANAGER

HLPROJECT DIRECTOR

?PROJECT NUMBER

SCALE

MMDRAWN BY

SHEET NUMBER

C-1



SYMBOLS LEGEND

RCP

	EXHAUST VENT		TRACK LIGHT OR VANITY LIGHT
	CEILING MOUNTED LIGHT FIXTURE		WALL-MOUNTED LIGHT FIXTURE
	CEILING MOUNTED DIRECTIONAL LIGHT		EMERGENCY EXIT SIGN
	RECESSED CAN LIGHT		EMERGENCY EXIT LIGHT
	EYEBALL OR SMALL CAN LIGHT		EMERGENCY EXIT LIGHT W/ SIGN
	PENDANT LIGHT		LIGHTED STAIR SIGN
	INDIVIDUAL FLUOR. LAY-IN FIXTURE 4 BULB		FLOOD LIGHT
	INDIVIDUAL FLUOR. HANGING FIXTURE 2 BULB		PHOTO CELL
	INDIVIDUAL FLUOR. FLUSH MOUNT FIXTURE 4 BULB		CEILING FAN
	CAMERA		CEILING FAN W/ LIGHT KIT
	MOTION DET.		CEILING HEIGHT AND TRIM 7'-2" ABOVE FLOOR BELOW WITH 6" CROWN MOULDING. NOTE: ALL CEILINGS NOT LABELED ARE PLASTER. CEILINGS SHOWN WITH A GRID ARE LAY IN ACOUSTICAL TILE..
	SUPPLY VENT		JUNCTION BOX
	SUPPLY VENT		
	RETURN VENT		
	RETURN VENT		
	SPEAKER		

ELECTRIC

	DATA OUTLET
	TELEPHONE JACK
	ELECTRIC SWITCH
	CABLE TELEVISION OUTLET
	DUPLEX RECEPTACLE OUTLET
	SPECIAL PURPOSE CONNECTION OR OUTLET
	QUADRUPLIX RECEPTACLE OUTLET
	FLOOR DUPLEX RECEPTACLE OUTLET
	ELECTRIC PANEL
	ELECTRIC METER
	BUTTON SWITCH
	DISCONNECT SWITCH
	GROUND/FLOOR LIGHT
	KEY PAD

FIRE PROTECTION


	FIRE EXTINGUISHER
	FIRE PULL
	FIRE ALARM (HORN/SRTOBE)
	SMOKE DETECTOR
	SMOKE ALARM SPEAKER
	SPRINKLER HEAD CEILING MOUNT
	SPRINKLER HEAD WALL MOUNT

MEP


	THERMOSTAT
	FLOOR DRAIN
	VALVE
	HOSE BIB
	WATER SUPPLY
	SUSPENDED GAS HEATER

MISC

	BOLLARD
	SPOT ELEVATION

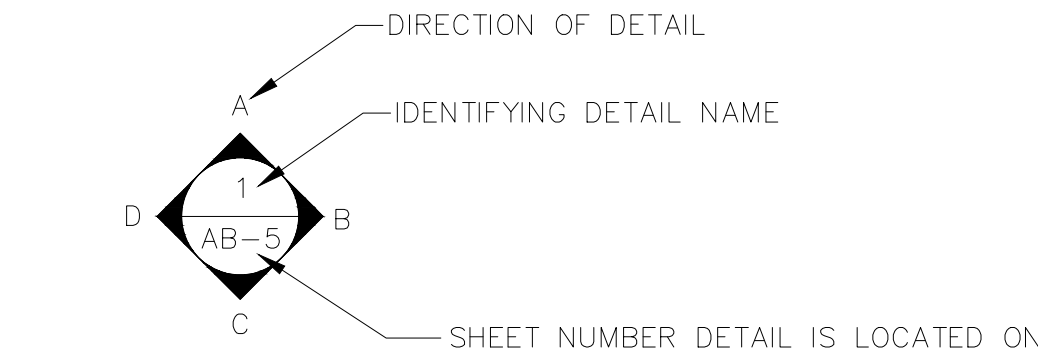

INTERIOR ELEVATIONS

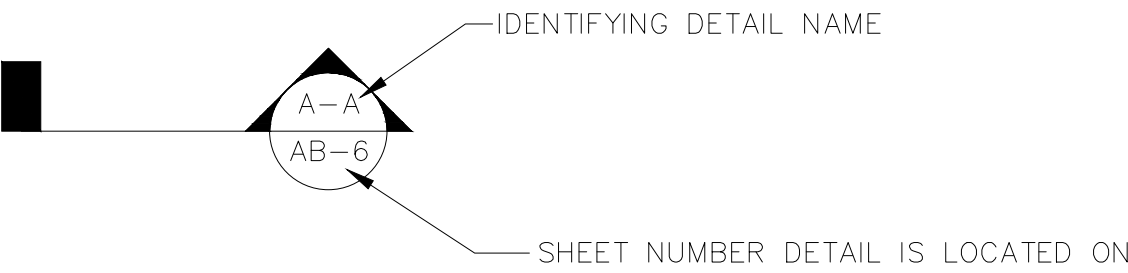

BUILDING SECTION

PHOTO DOCUMENTATION LEGEND

INDICATES LOCATION OF CAMERA

INDICATES DIRECTION OF CAMERA LENS AND CORRESPONDING PHOTO / VIDEO NUMBER

TYPES OF DOCUMENTATION

GROUND BASED PHOTO 001

GROUND BASED VIDEO V-001

360° SPHERICAL PHOTO 123



AERIAL BASED PHOTO 000

AERIAL BASED VIDEO V-000

ARCHITECTURAL AS BUILT  
KENSINGTON APARTMENTS  
SACRAMENTO, CA 95821


01	100% SUBMISSION	
NO.	ISSUES   REVISIONS	DATE

	SHEET TITLE
HL	PROJECT MANAGER
HL	PROJECT DIRECTOR
?	PROJECT NUMBER
NOT TO SCALE	SCALE
MM	DRAWN BY
	SHEET NUMBER

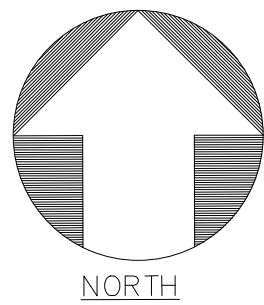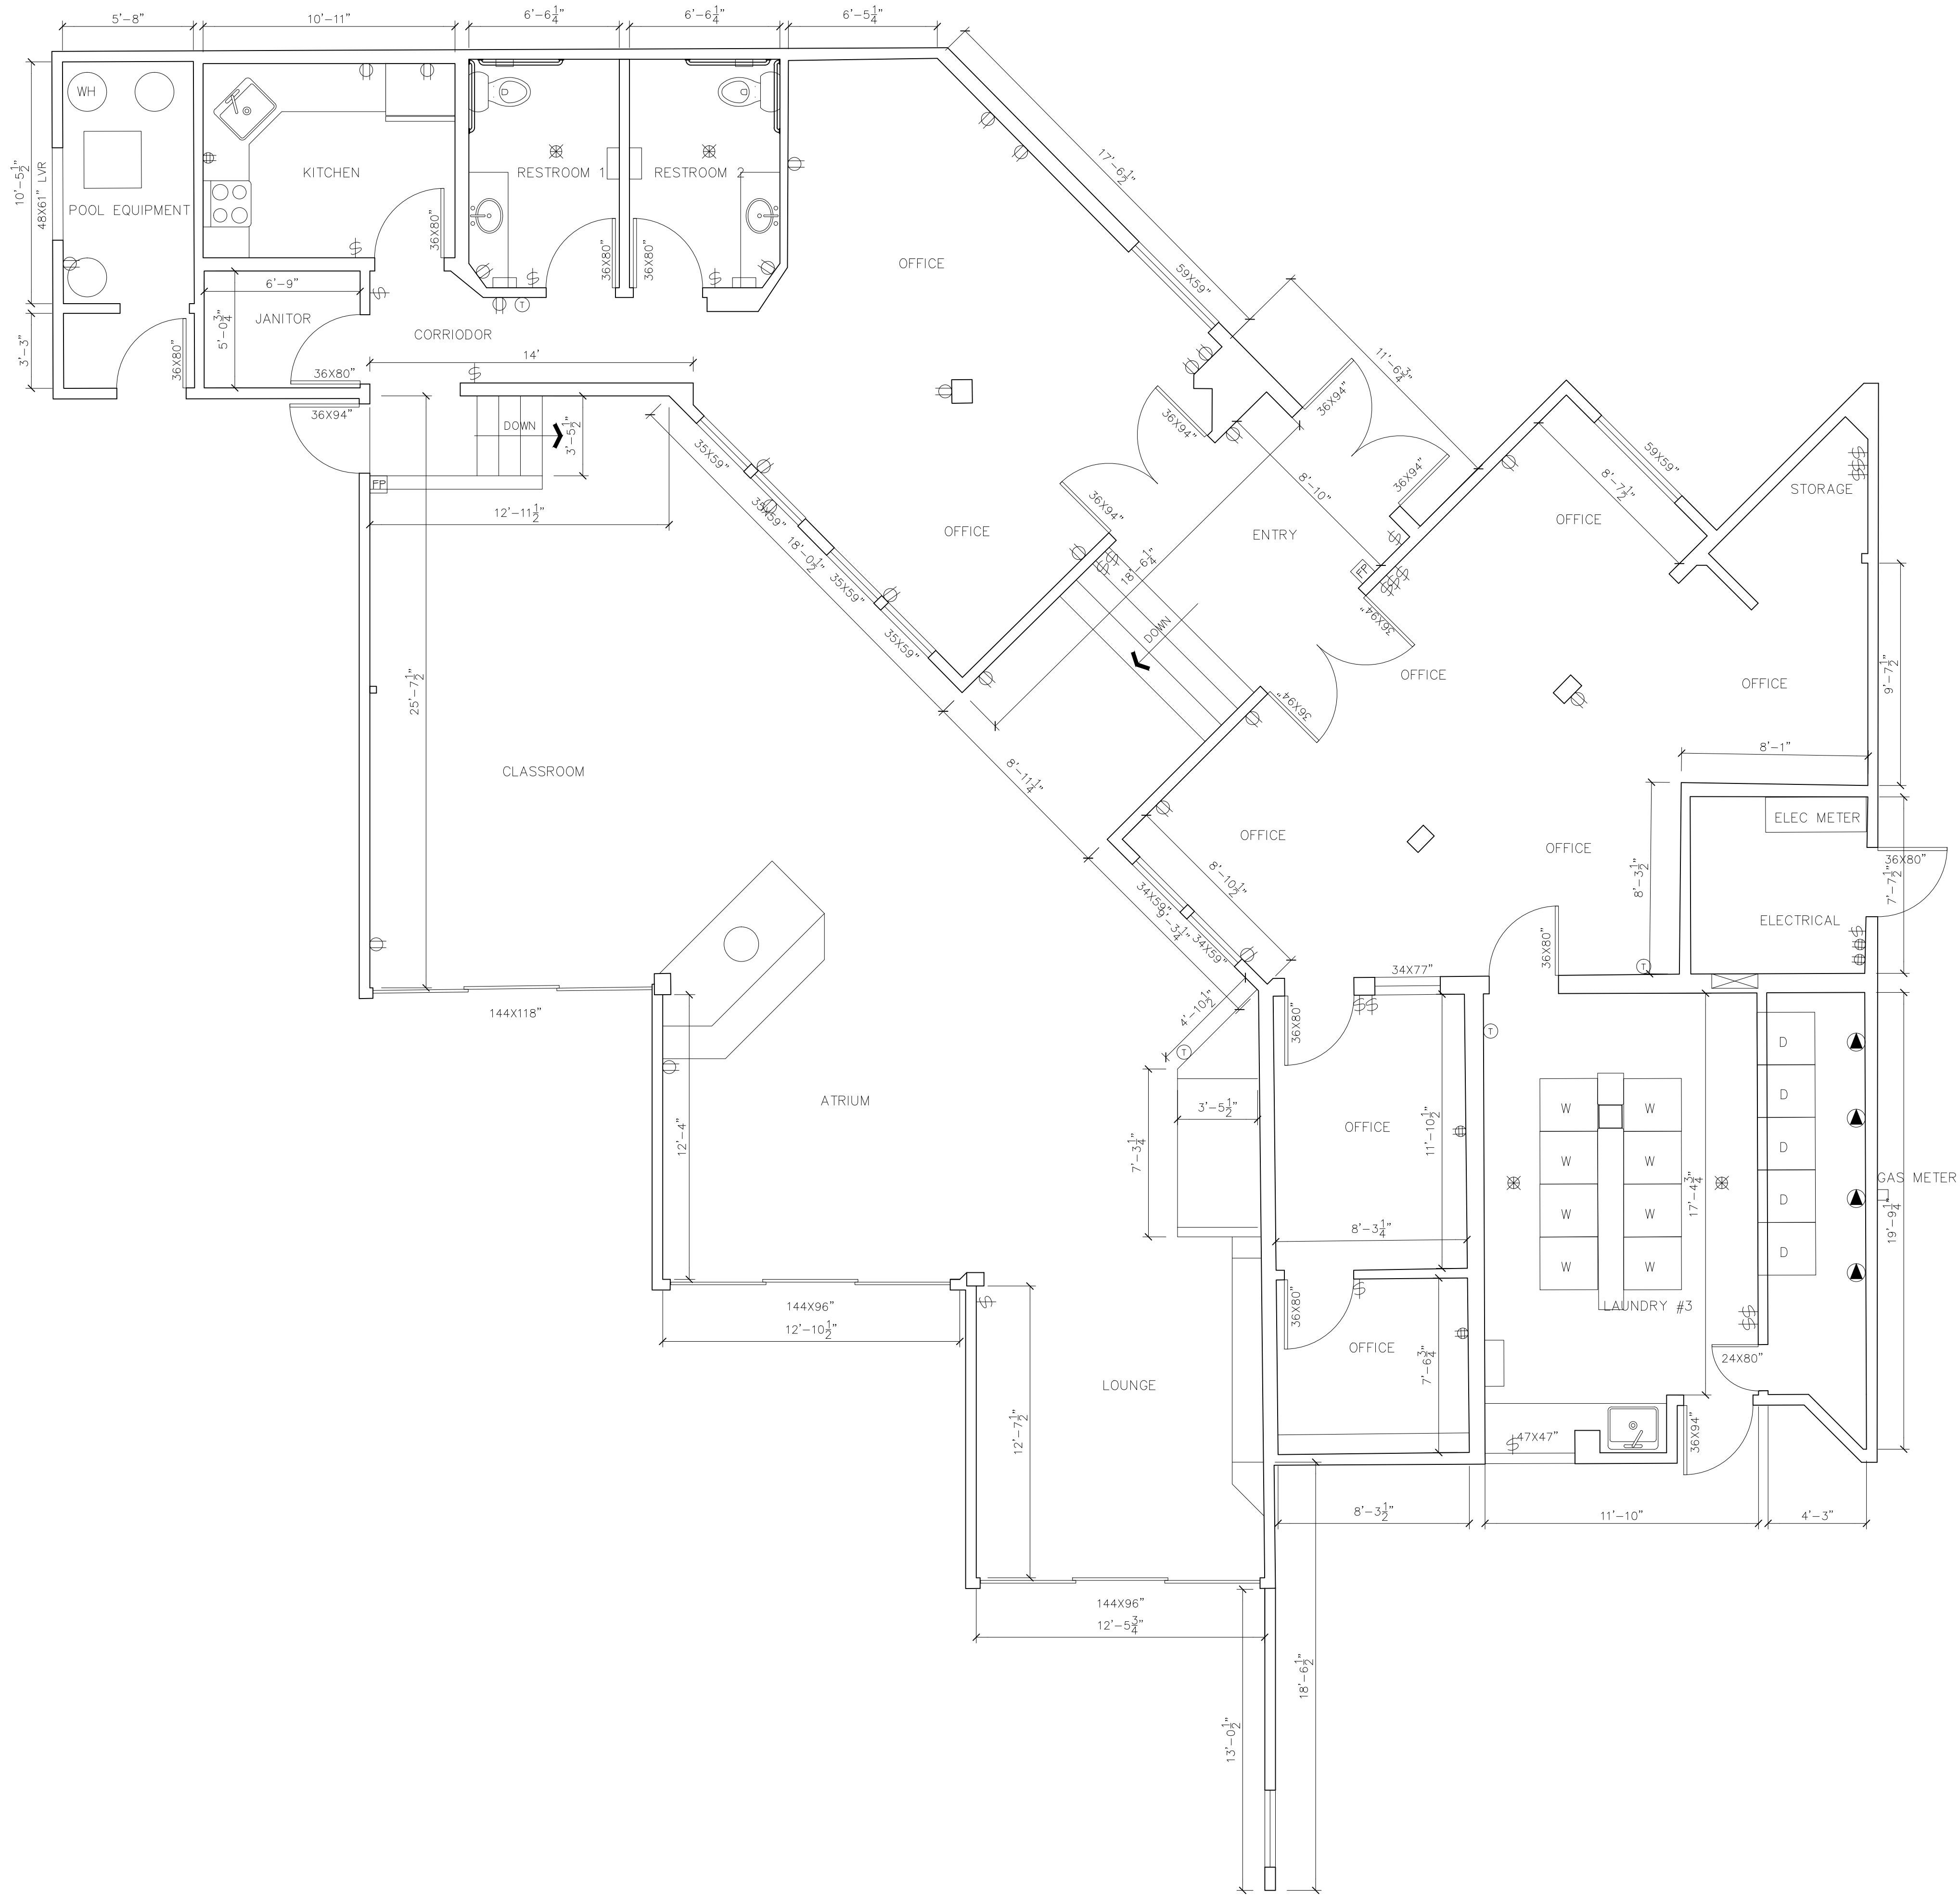

**ARCHITECTURAL AS BUILT**  
**KENSINGTON APARTMENTS**  
**SACRAMENTO, CA 95821**

01	100% SUBMISSION	
NO.	ISSUES   REVISIONS	DATE
SHEET TITLE		
CLUBHOUSE PLAN		
HL	PROJECT MANAGER	
HL	PROJECT DIRECTOR	
?	PROJECT NUMBER	
1/4"=1'-0"		SCALE
MM	DRAWN BY	
SHEET NUMBER		

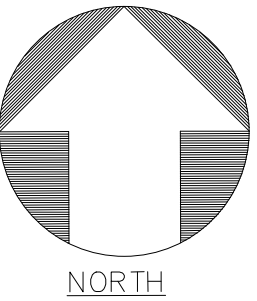

DIVISION OF:



© 2020 AEC CONSULTANTS INC

# ARCHITECTURAL AS BUILT

# KENSINGTON APARTMENTS

**SACRAMENTO, CA 95821**

[illegible]

01	100% SUBMISSION	
NO.	ISSUES   REVISIONS	DATE



PROJECT TITLE

# CLUBHOUSE

## RCP

HL	PROJECT MANAGER
HL	PROJECT DIRECTOR
?	PROJECT NUMBER
<b>1/4"=1'-0"</b>	SCALE
MM	DRAWN BY
	SHEET NUMBER

**AB-2**

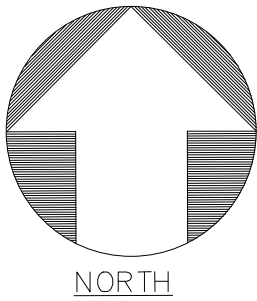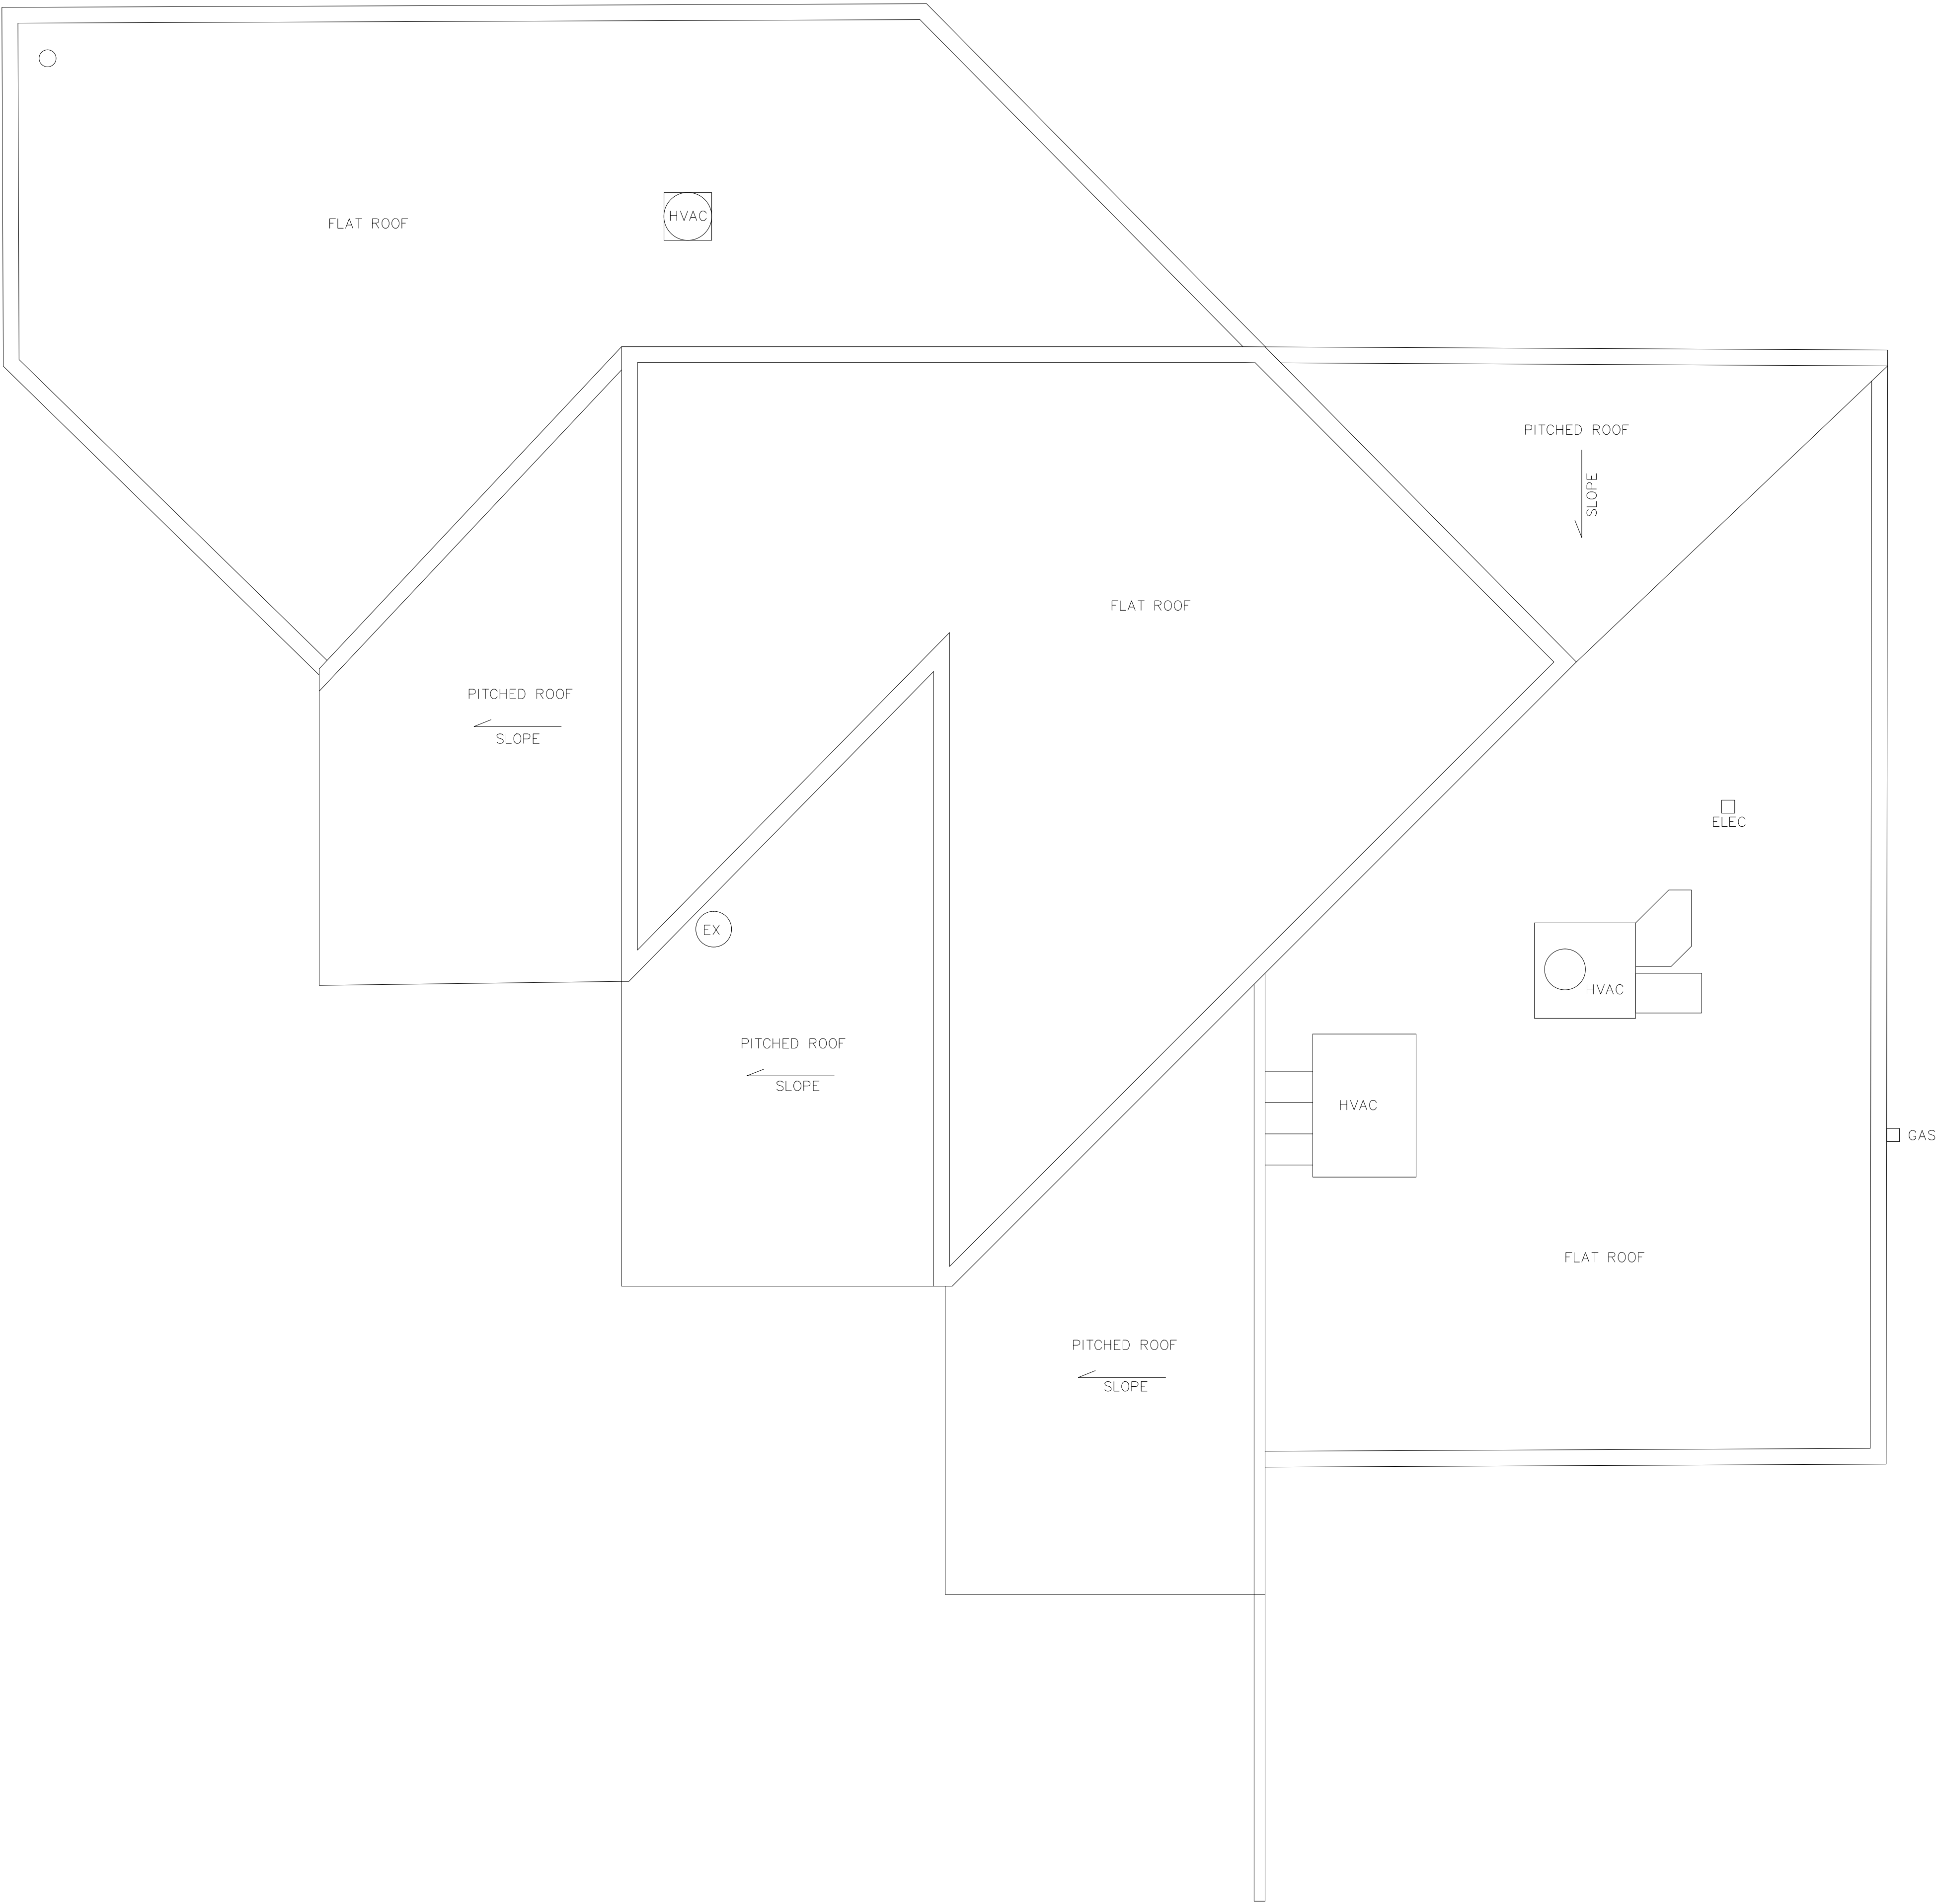


**ARCHITECTURAL AS BUILT**  
**KENSINGTON APARTMENTS**  
**SACRAMENTO, CA 95821**



01	100% SUBMISSION	
NO.	ISSUES   REVISIONS	DATE

SHEET TITLE		
CLUBHOUSE ROOF PLAN		
HL	PROJECT MANAGER	
HL	PROJECT DIRECTOR	
?	PROJECT NUMBER	
1/4"=1'-0"	SCALE	
MM	DRAWN BY	
	SHEET NUMBER	



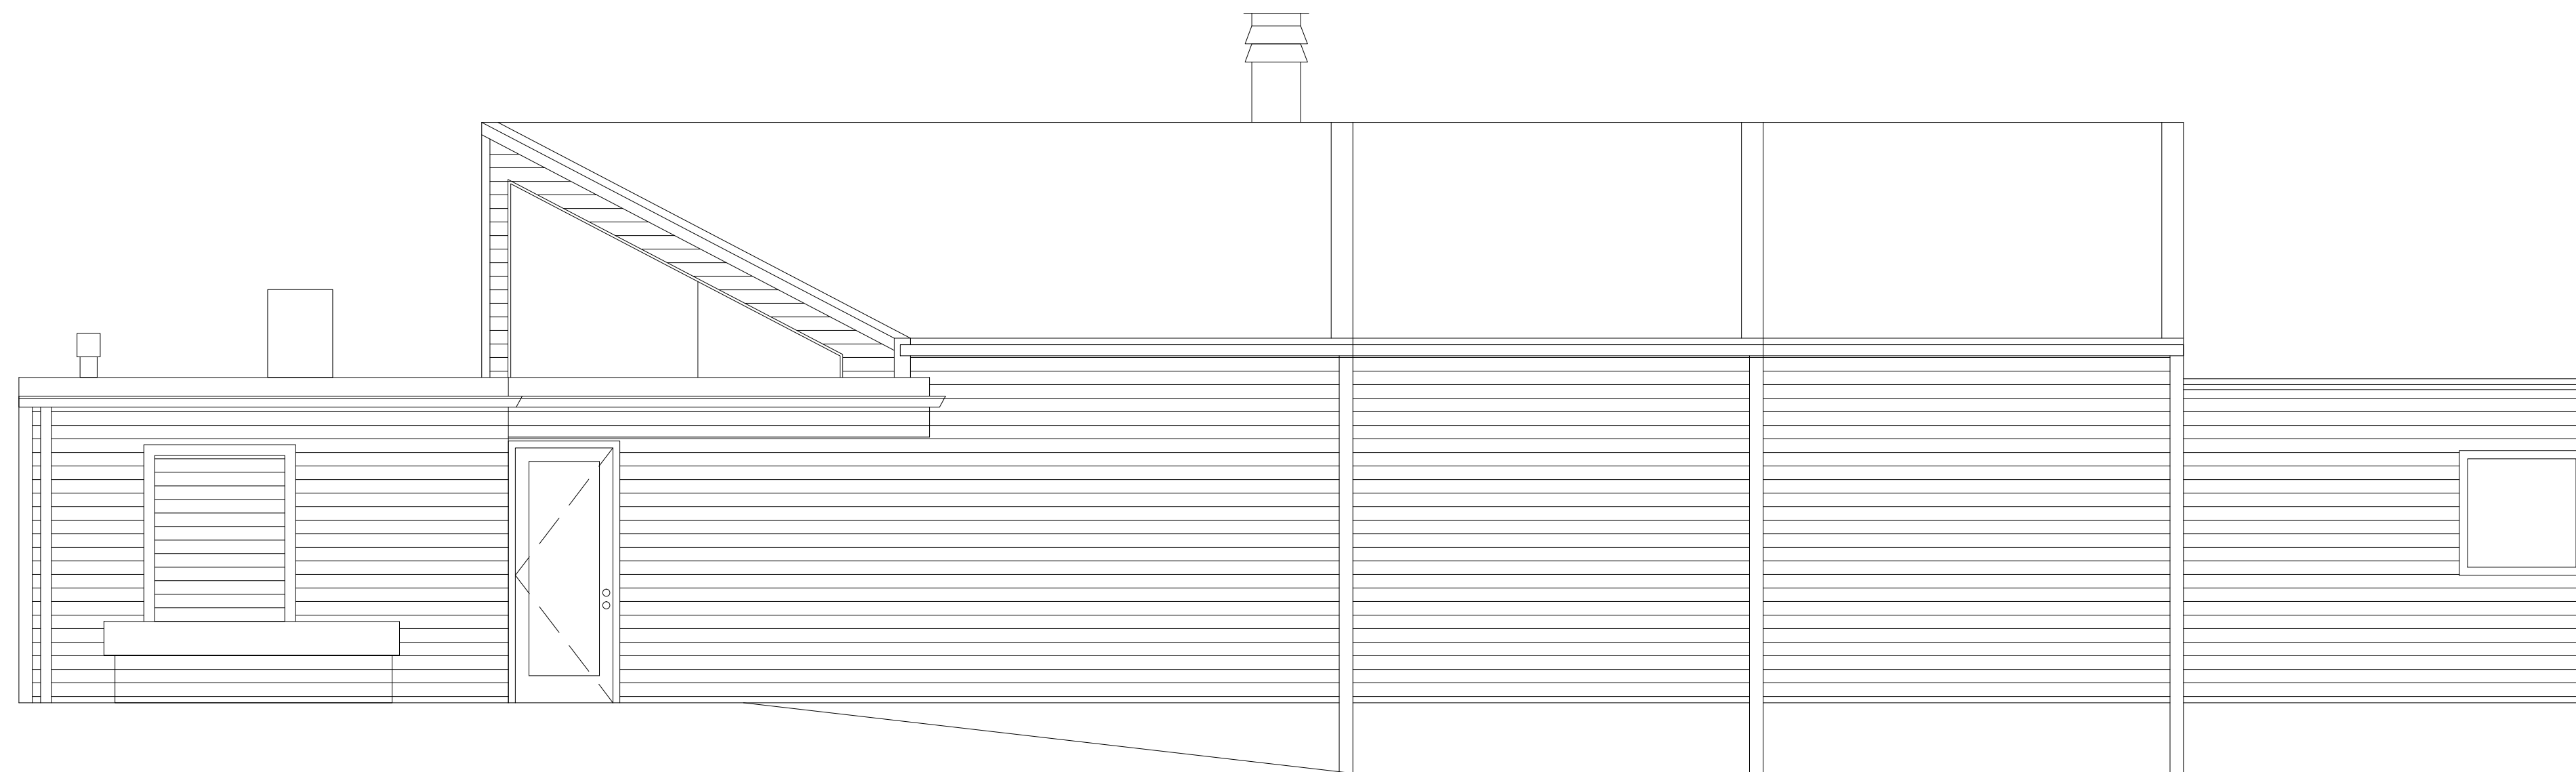

WEST ELEVATION

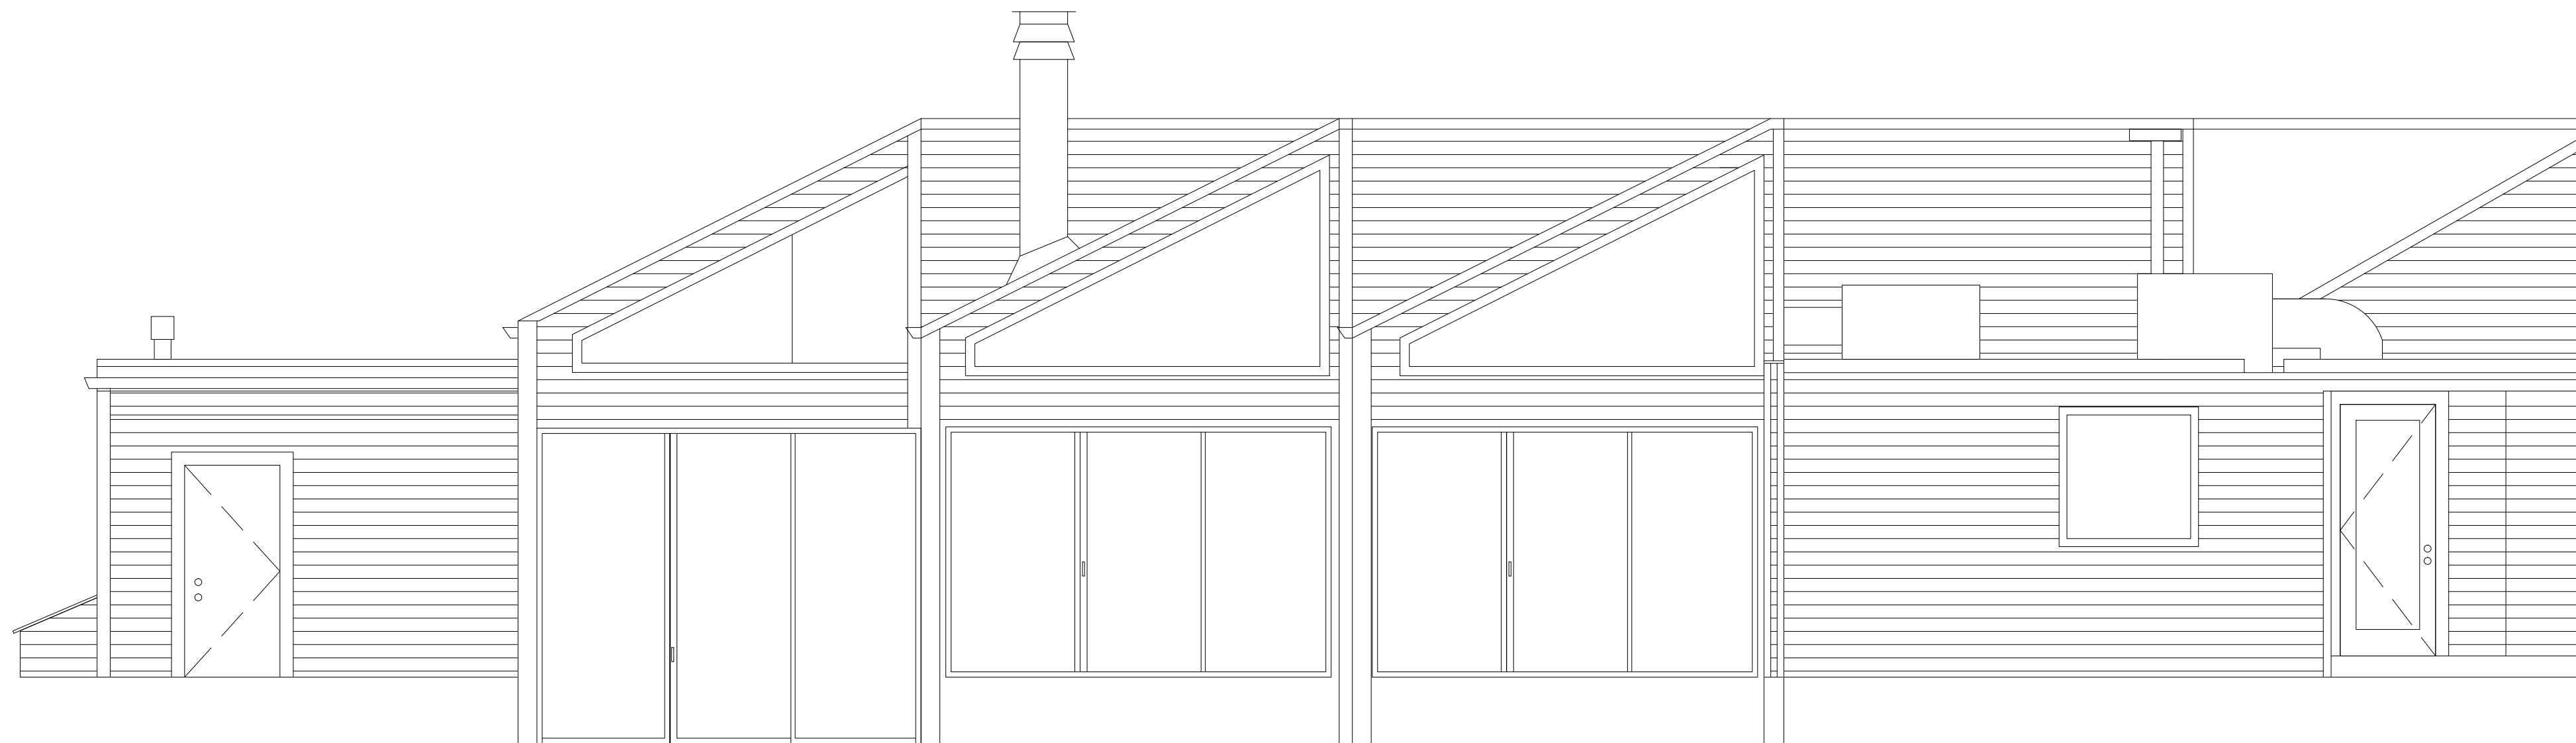

SOUTH ELEVATION



© 2020 AEC CONSULTANTS INC

# ARCHITECTURAL AS BUILT

## KENSINGTON APARTMENTS

**SACRAMENTO, CA 95821**






01	100% SUBMISSION	
NO.	ISSUES   REVISIONS	DATE
		SHEET TITLE
CLUBHOUSE ELEVATIONS		
HL	PROJECT MANAGER	
HL	PROJECT DIRECTOR	
?	PROJECT NUMBER	
1/4"=1'-0"	SCALE	
MM	DRAWN BY	
	SHEET NUMBER	

## CLUBHOUSE ELEVATIONS

HL	PROJECT MANAGER
HL	PROJECT DIRECTOR
?	PROJECT NUMBER
<b>1/4"=1'-0"</b>	SCALE
MM	DRAWN BY
	SHEET NUMBER

**AB-4**



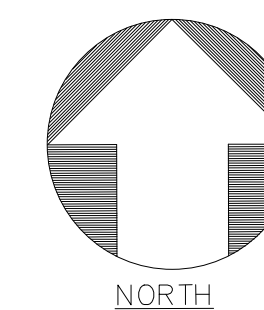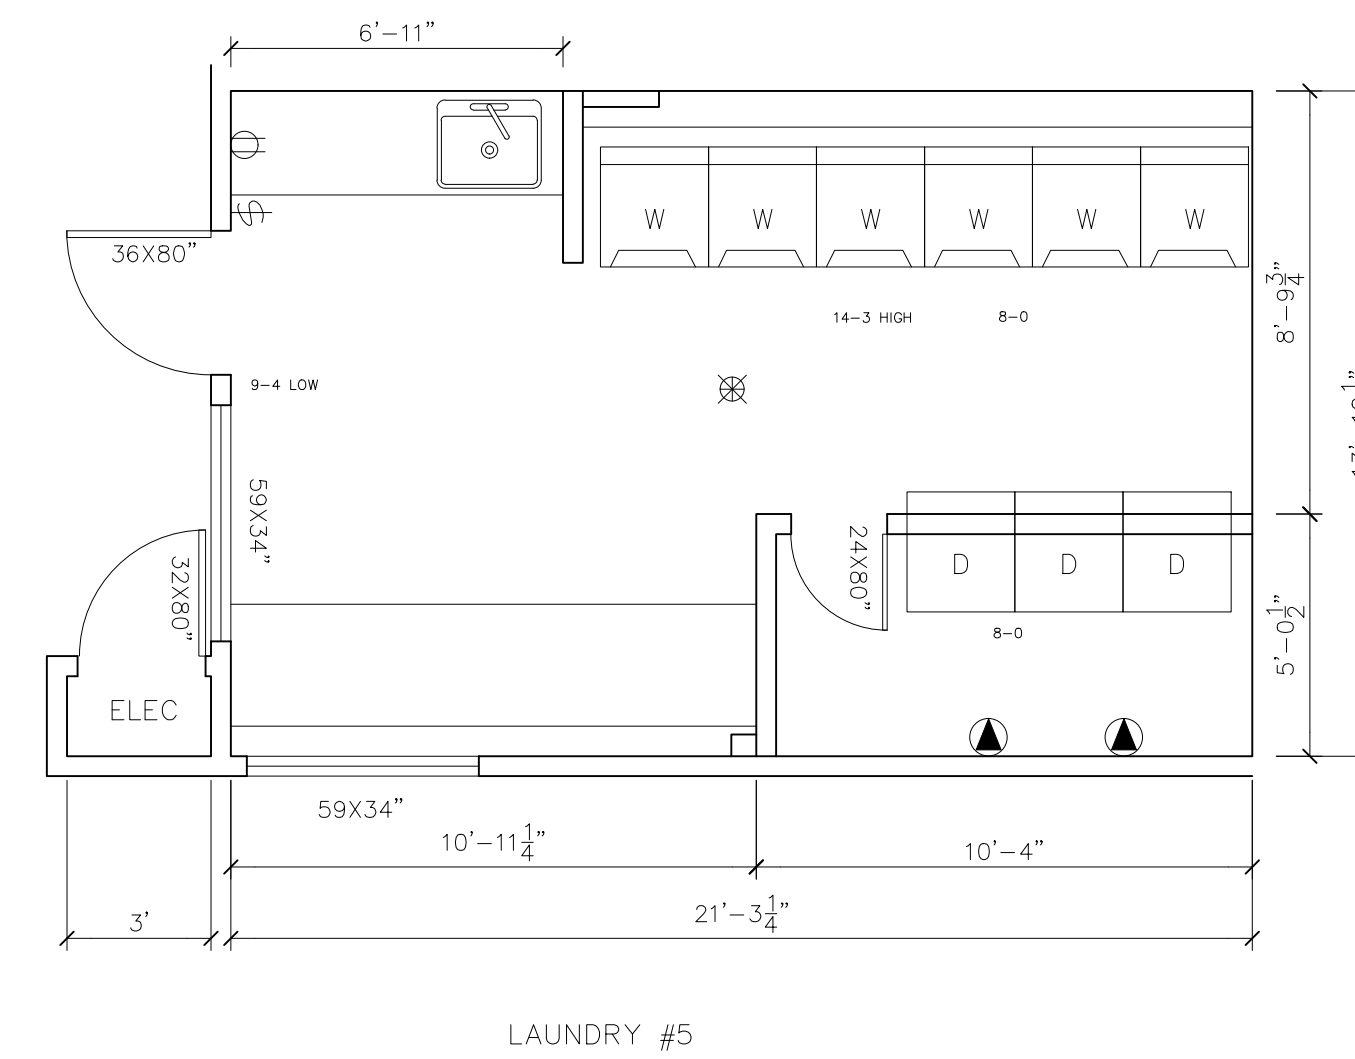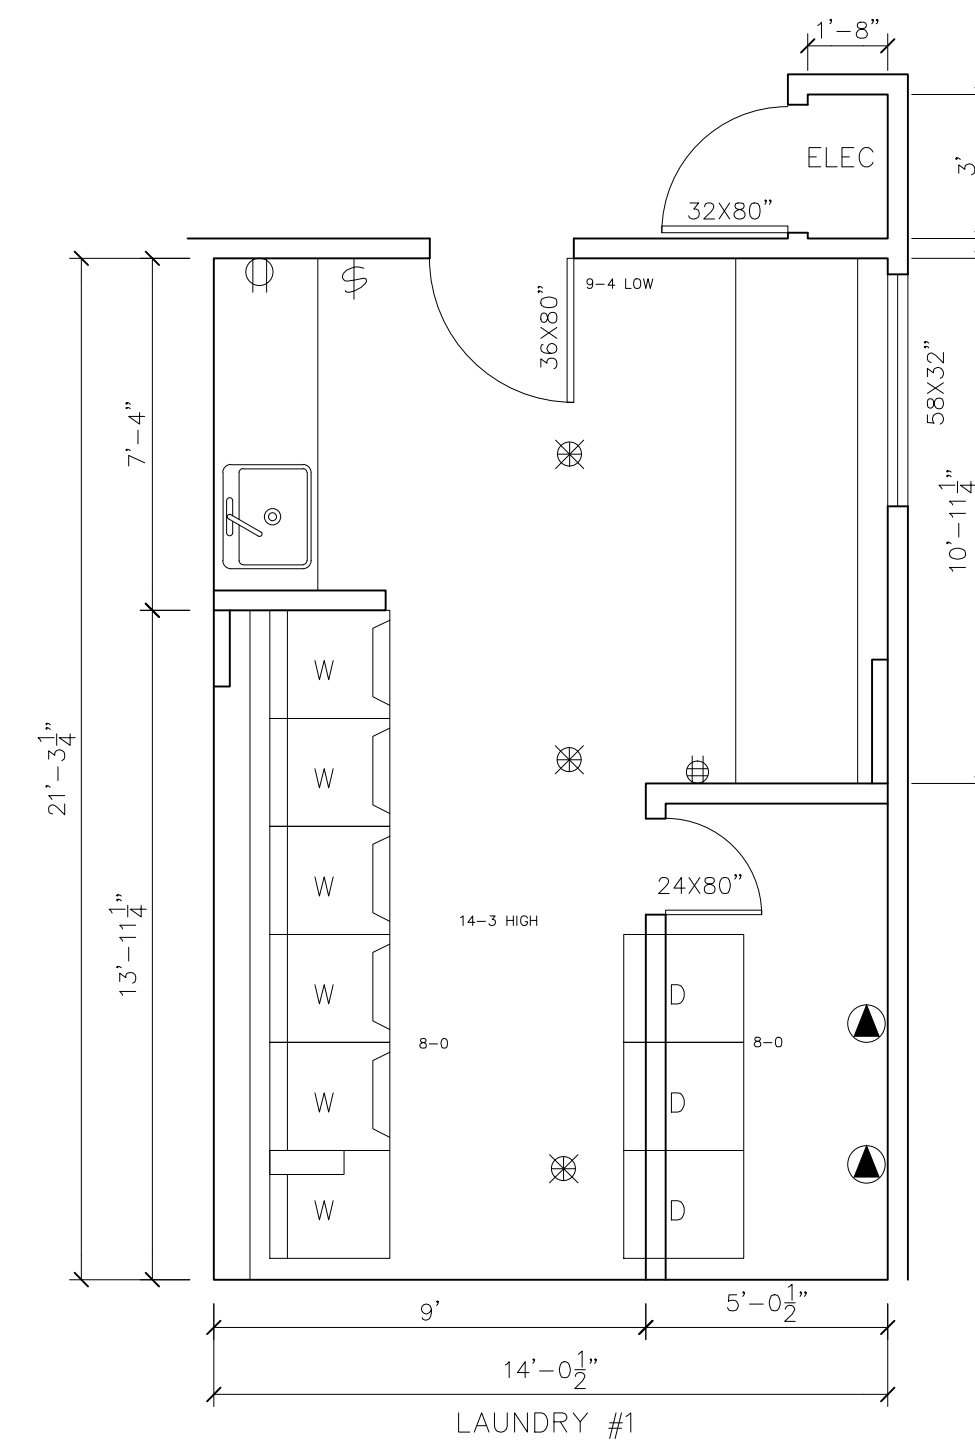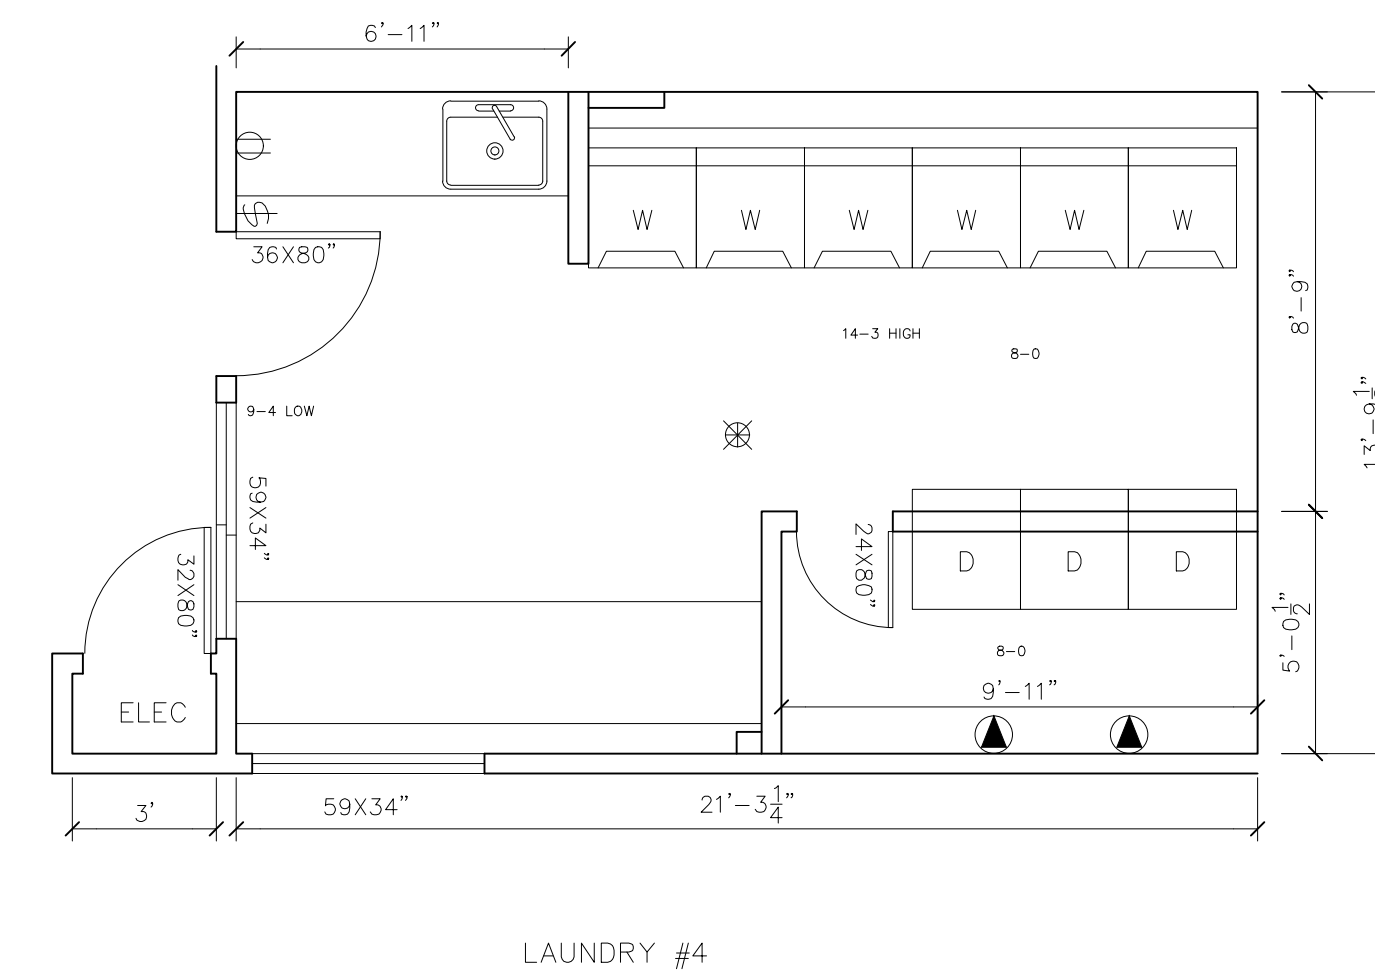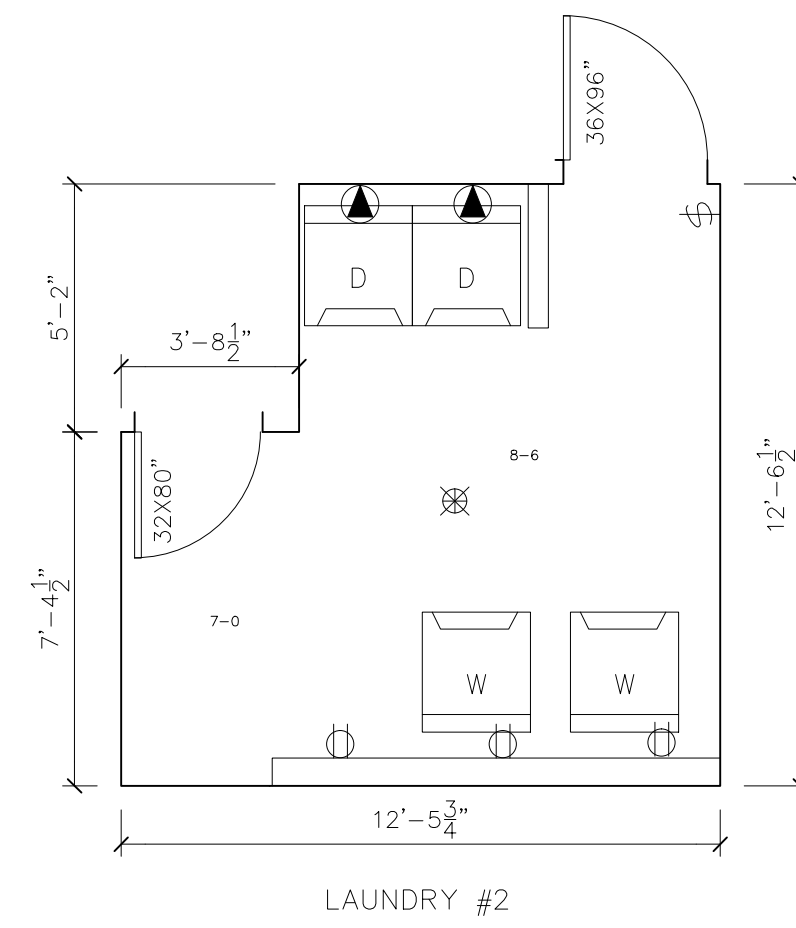

**ARCHITECTURAL AS BUILT**

**KENSINGTON APARTMENTS**

**SACRAMENTO, CA 95821**

01	100% SUBMISSION	
NO.	ISSUES   REVISIONS	DATE
		SHEET TITLE
LAUNDRY ROOMS		
HL	PROJECT MANAGER	
HL	PROJECT DIRECTOR	
?	PROJECT NUMBER	
1/4"=1'-0"		SCALE
MM	DRAWN BY	
		SHEET NUMBER