
AS-BUILT DOCUMENTATION

KENSINGTON PARK APARTMENTS

SACRAMENTO, CA 95821

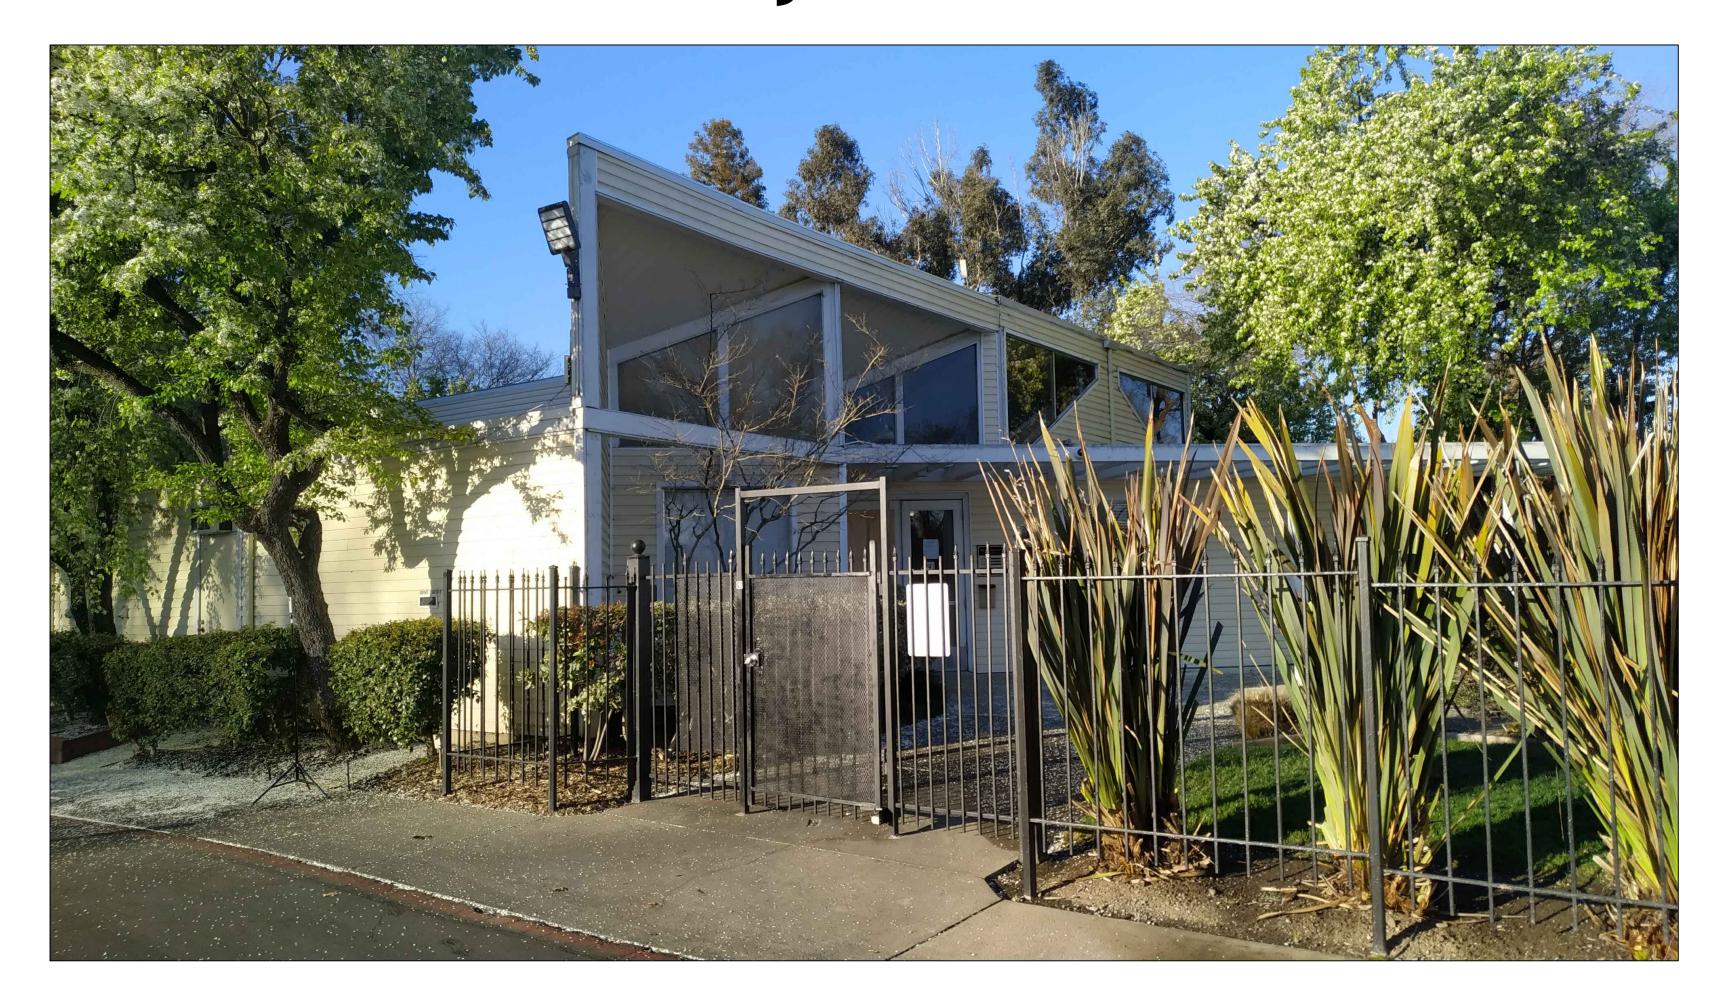


100% SUBMITTAL

DRAWING INDEX

C-1 COVER SHEET | DRAWING INDEX
SL SYMBOLS LEGEND
AB-1 3612-2 FLOORPLAN & RCP
AB-2 3634-1 FLOORPLAN & RCP
AB-3 3638-1 FLOORPLAN & RCP
AB-4 3584-4 FLOORPLAN & RCP
AB-5 3658-13 FLOORPLAN & RCP
AB-6 3658-14 FLOORPLAN & RCP
AB-7 3584-2 FLOORPLAN & RCP
AB-8 3648-2 FLOORPLAN & RCP
AB-9 3704-1 FLOORPLAN & RCP

3698-2 FLOORPLAN & RCP

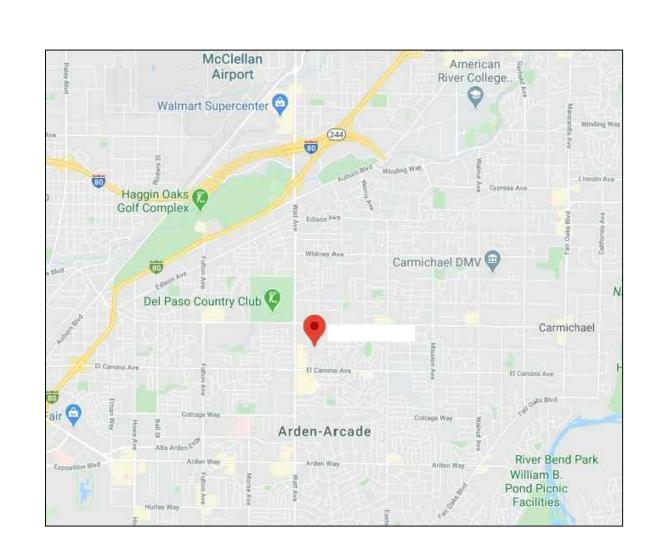

VICINITY MAP NTS

	<u>AREA DATA</u>
3612-2	1,193 ±
3634-1	1,026 ±
3638-1	466 ±
3584-4	1,021 ±
3658-13	1,027 ±
3658-14	1,201 ±
3584-2	1,026 ±
3648-2	773 ±
3704-1	1,023 ±
3698-2	1,026 ±
TOTAL	9,782 1, ±



AS BUILT

NSINGTON APARTMENTS

NO. ISSUES | REVISIONS DATE

COVER
SHEET TITLE

PROJECT MANAGER

C-1

SYMBOLS LEGEND

EXHAUST VENT



CEILING MOUNTED LIGHT FIXTURE



CEILING MOUNTED DIRECTIONAL LIGHT




RECESSED CAN LIGHT




EYEBALL OR SMALL CAN LIGHT



INDIVIDUAL FLUOR.

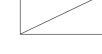

LAY-IN FIXTURE 4 BULB

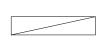

INDIVIDUAL FLUOR. HANGING FIXTURE 2 BULB



INDIVIDUAL FLUOR. FLUSH MOUNT FIXTURE



CAMERA



MOTION DET.



SUPPLY VENT

SUPPLY VENT











SPEAKER

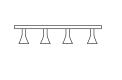

TRACK LIGHT OR VANITY LIGHT



WALL-MOUNTED LIGHT FIXTURE EMERGENCY

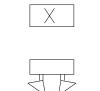

EXIT SIGN EMERGENCY EXIT LIGHT



EMERGENCY EXIT LIGHT W/ SIGN



STAIR


LIGHTED STAIR SIGN




FLOOD LIGHT



PHOTO CELL

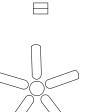


CEILING FAN

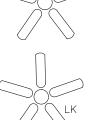

CEILING FAN W/ LIGHT KIT

JUNCTION BOX

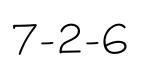

CEILING HEIGHT AND TRIM 7'-2"ABOVE FLOOR BELOW WITH 6" CROWN MOULDING. NOTE: ALL CEILINGS NOT LABELED ARE PLASTER. CEILINGS SHOWN WITH A GRID ARE LAY IN ACOUSTICAL

DATA OUTLET



ELECTRIC SWITCH

TELEPHONE JACK



CABLE TELEVISION OUTLET

DUPLEX RECEPTACLE OUTLET



SPECIAL PURPOSE CONNECTION OR OUTLET



QUADRUPLEX RECEPTACLE OUTLET



FLOOR DUPLEX RECEPTACLE OUTLET



ELECTRIC PANEL



ELECTRIC METER



BUTTON SWITCH



DISCONNECT SWITCH



GROUND/FLOOR LIGHT



KEY PAD

FIRE PROTECTION

FIRE EXTINGUISHER

FP FIRE PULL

FIRE ALARM (HORN/SRTOBE)

SMOKE DETECTOR

SMOKE ALARM SPEAKER

SPRINKLER HEAD CEILING MOUNT

SPRINKLER HEAD WALL MOUNT



HW, CW, AND WW LINES WERE NOT VISIBLE UNLESS OTHERWISE NOTED, THESE LINES WERE DESIGNATED AND LOCATED BY BULLSEYE LEAK DETECTION

₩ FLOOR DRAIN

THERMOSTAT

VALVE HOSE BIB

WATER SUPPLY

SUSPENDED GAS HEATER




BOLLARD


11-4-11/16 SPOT ELEVATION


DIRECTION OF DETAIL IDENTIFYING DETAIL NAME — SHEET NUMBER DETAIL IS LOCATED ON

INTERIOR ELEVATIONS

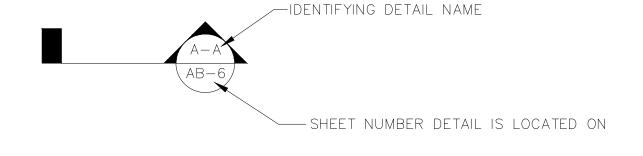

BUILDING SECTION

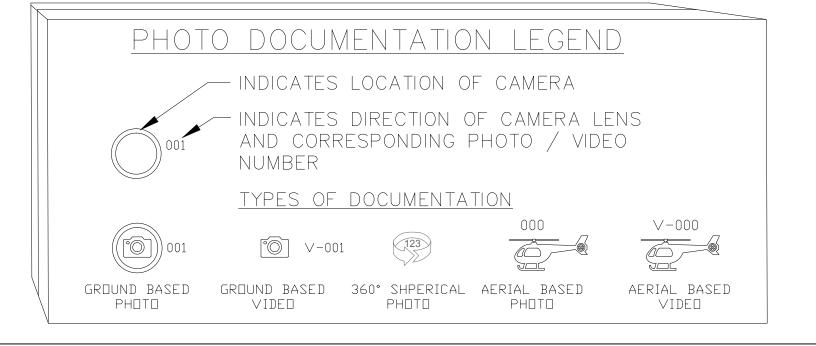

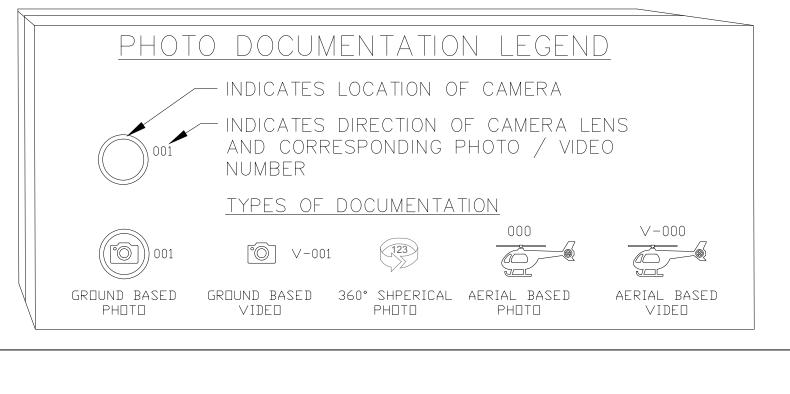

PROFESSIONALS AEC CONSULTANTS INC 844.272.8458 844 A S B U I L T © 2020 AEC CONSULTANTS INC

 ∞

CA SACRAMENTO, **ENSINGTON** ARC


NO. ISSUES | REVISIONS

SYMBOLS LEGEND

PROJECT MANAGER PROJECT DIRECTOR PROJECT NUMBER


NOT TO SCALE

SL

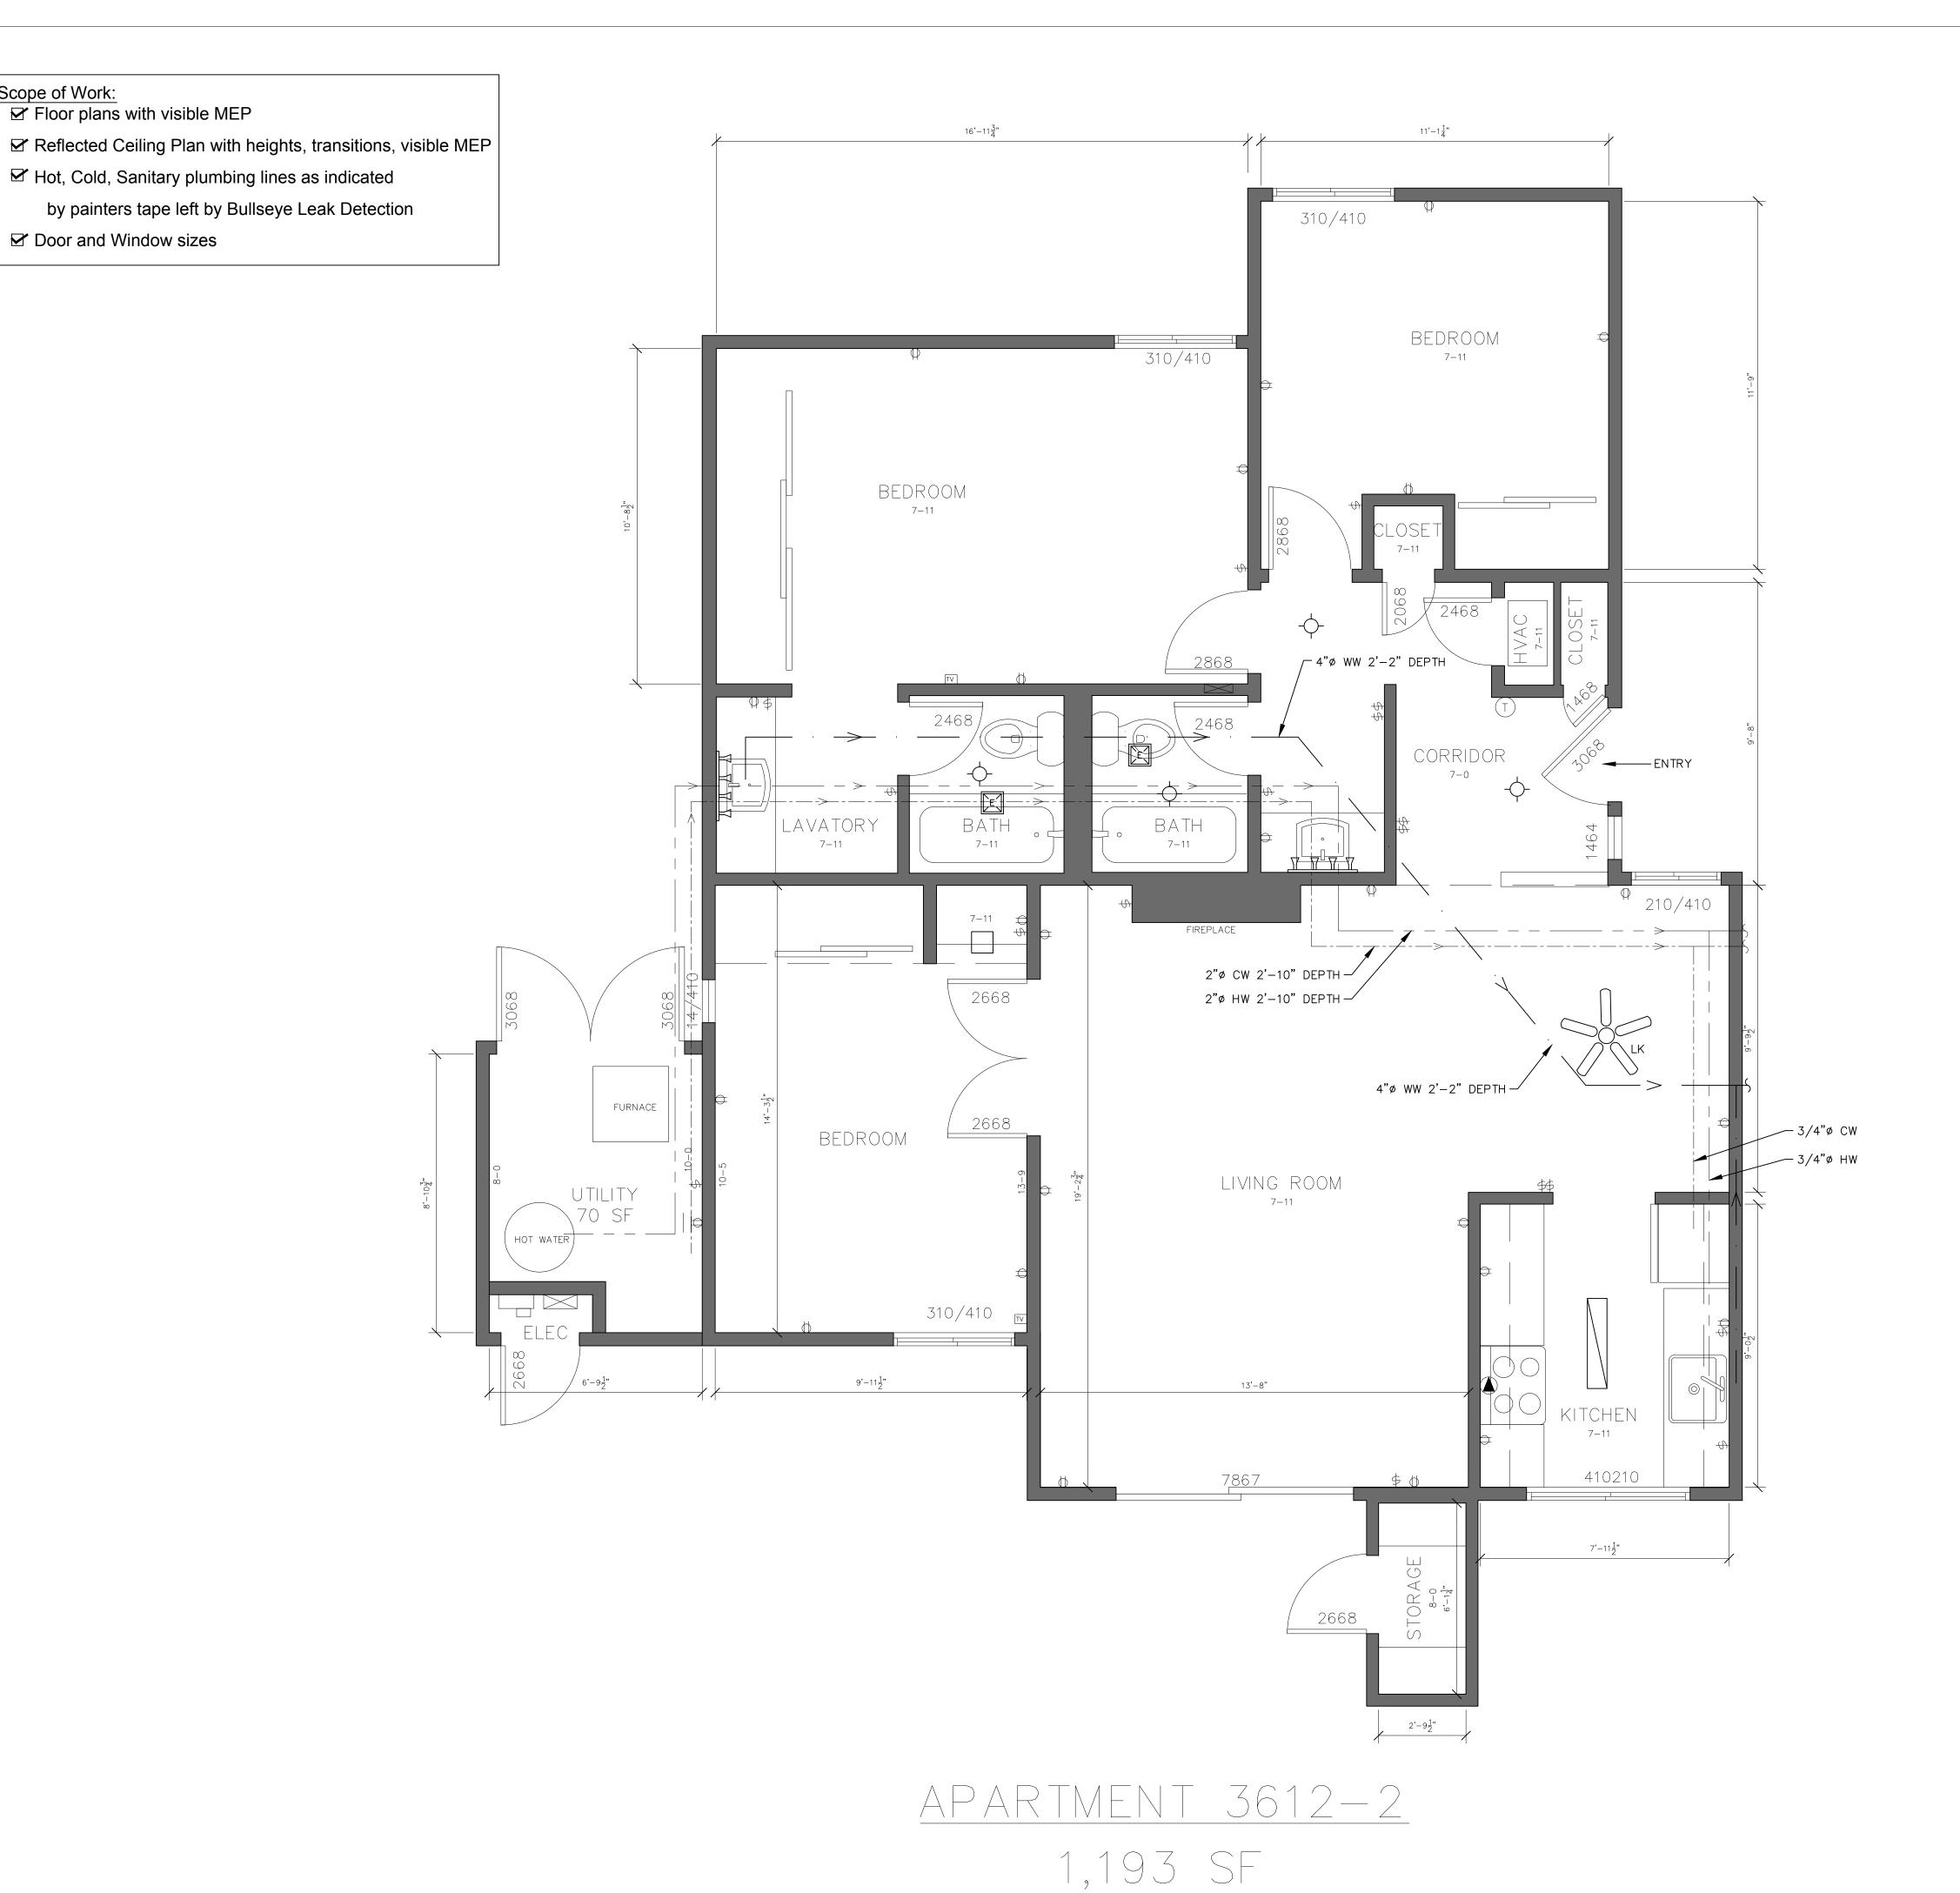

Floor plans with visible MEP

✓ Door and Window sizes

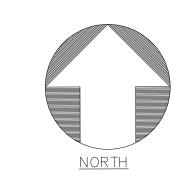



ENSINGTON

95821

CA

SACRAMENTO,

NO. ISSUES | REVISIONS

3612-2 FLOORPLAN & **RCP**

I L	PROJECT MANAGER
HL	PROJECT DIRECTOR
)	PROJECT NUMBER

3/8"=1'-0"


✓ Floor plans with visible MEP

☑ Reflected Ceiling Plan with heights, transitions, visible MEP

✓ Hot, Cold, Sanitary plumbing lines as indicated

by painters tape left by Bullseye Leak Detection

✓ Door and Window sizes

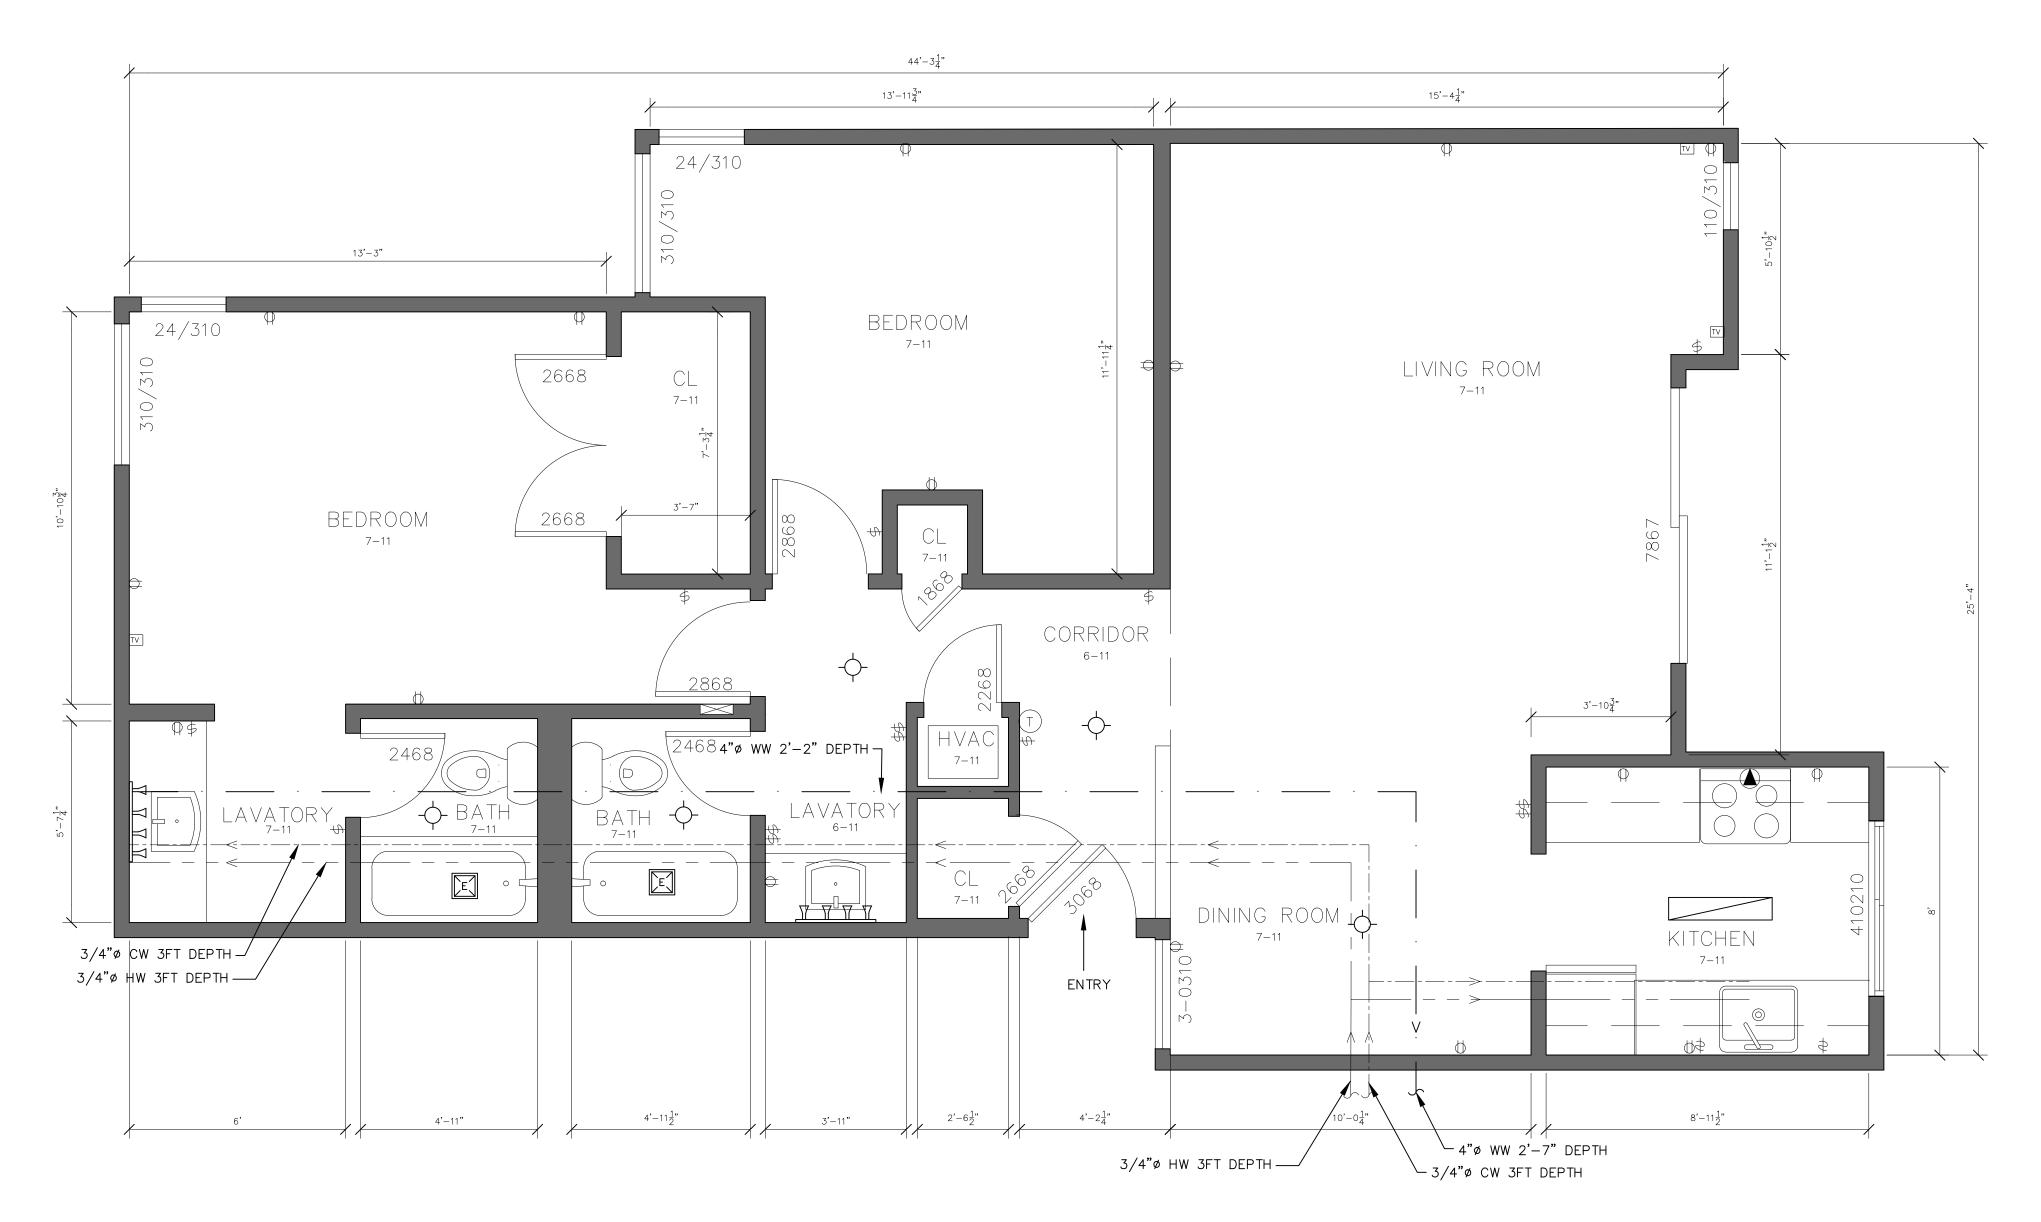

<u>APARTMENT 3634-1</u>
1,026 SF



3634-1 FLOORPLAN & RCP

NO. ISSUES | REVISIONS

HL	PROJECT
HL	PROJECT
?	PROJECT

3/8"=1'-0"

SHEET NU

AB-2



S BUILT

IECIUKAL AS E

ARCHI

95821

CA

SACRAMENTO,


✓ Floor plans with visible MEP

☑ Reflected Ceiling Plan with heights, transitions, visible MEP

✓ Hot, Cold, Sanitary plumbing lines as indicated

by painters tape left by Bullseye Leak Detection

☑ Door and Window sizes

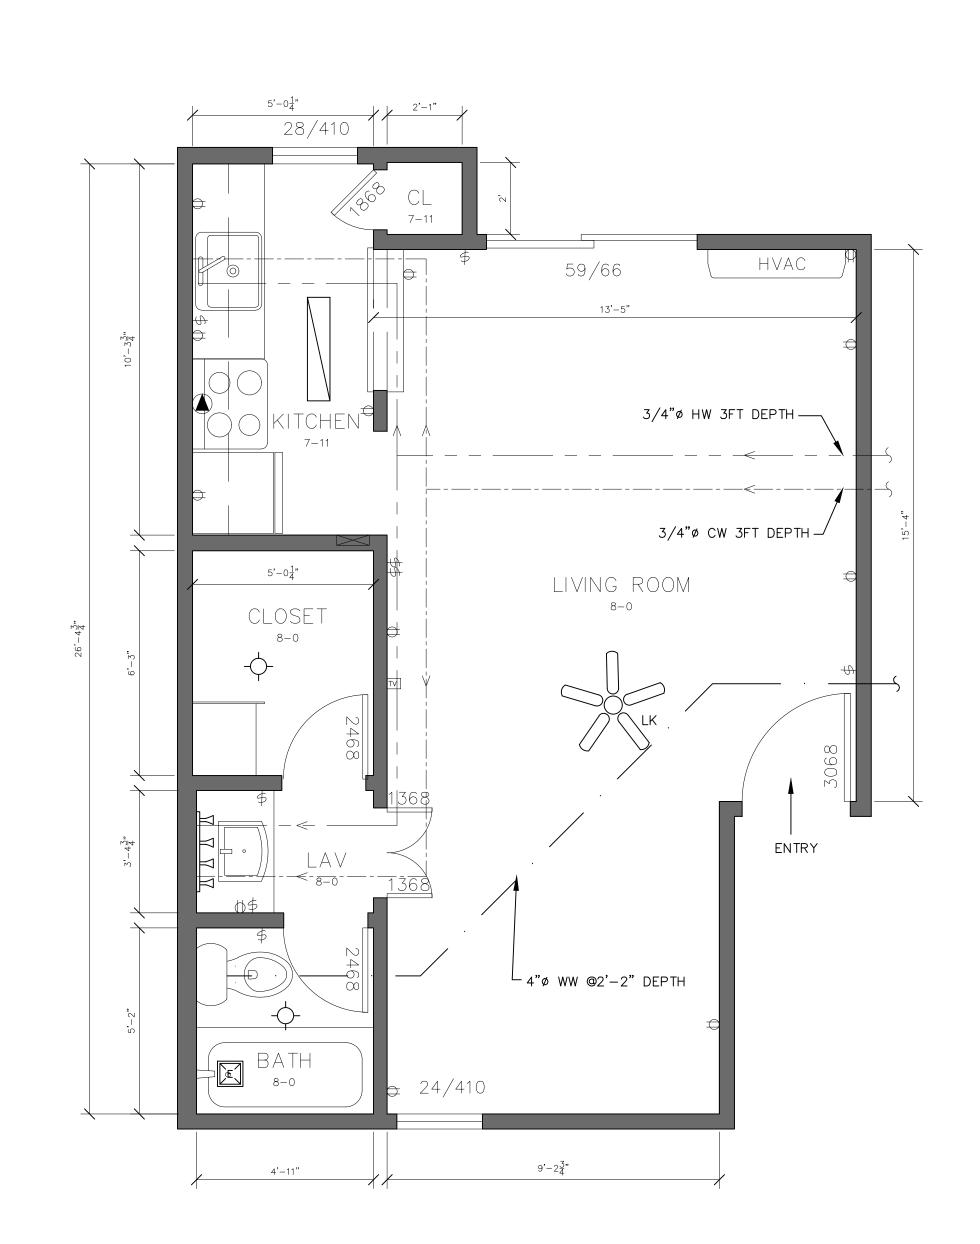

<u>APARTMENT 3638-1</u> 466 SF



S BUILT

SINGTON APARTMENTS

95821

CA

SACRAMENTO,


NO. ISSUES | REVISIONS DATE

3638-1 FLOORPLAN & RCP

IL	PROJECT	MANAGER
IL	PROJECT	DIRECTOR
	PROJECT	NUMBER

3/8"=1'-0"


SHEET NUMB

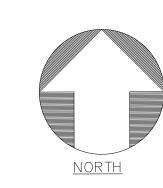


- ✓ Floor plans with visible MEP
- ☑ Reflected Ceiling Plan with heights, transitions, visible MEP
- - by painters tape left by Bullseye Leak Detection
- ✓ Door and Window sizes

NOTE:

LOCATIONS FOR CW, HW, AND WW ON THIS SHEET PER MAINTENANCE SUPERVISOR LUPE AND NOT BULLS EYE LEAK DETECTION

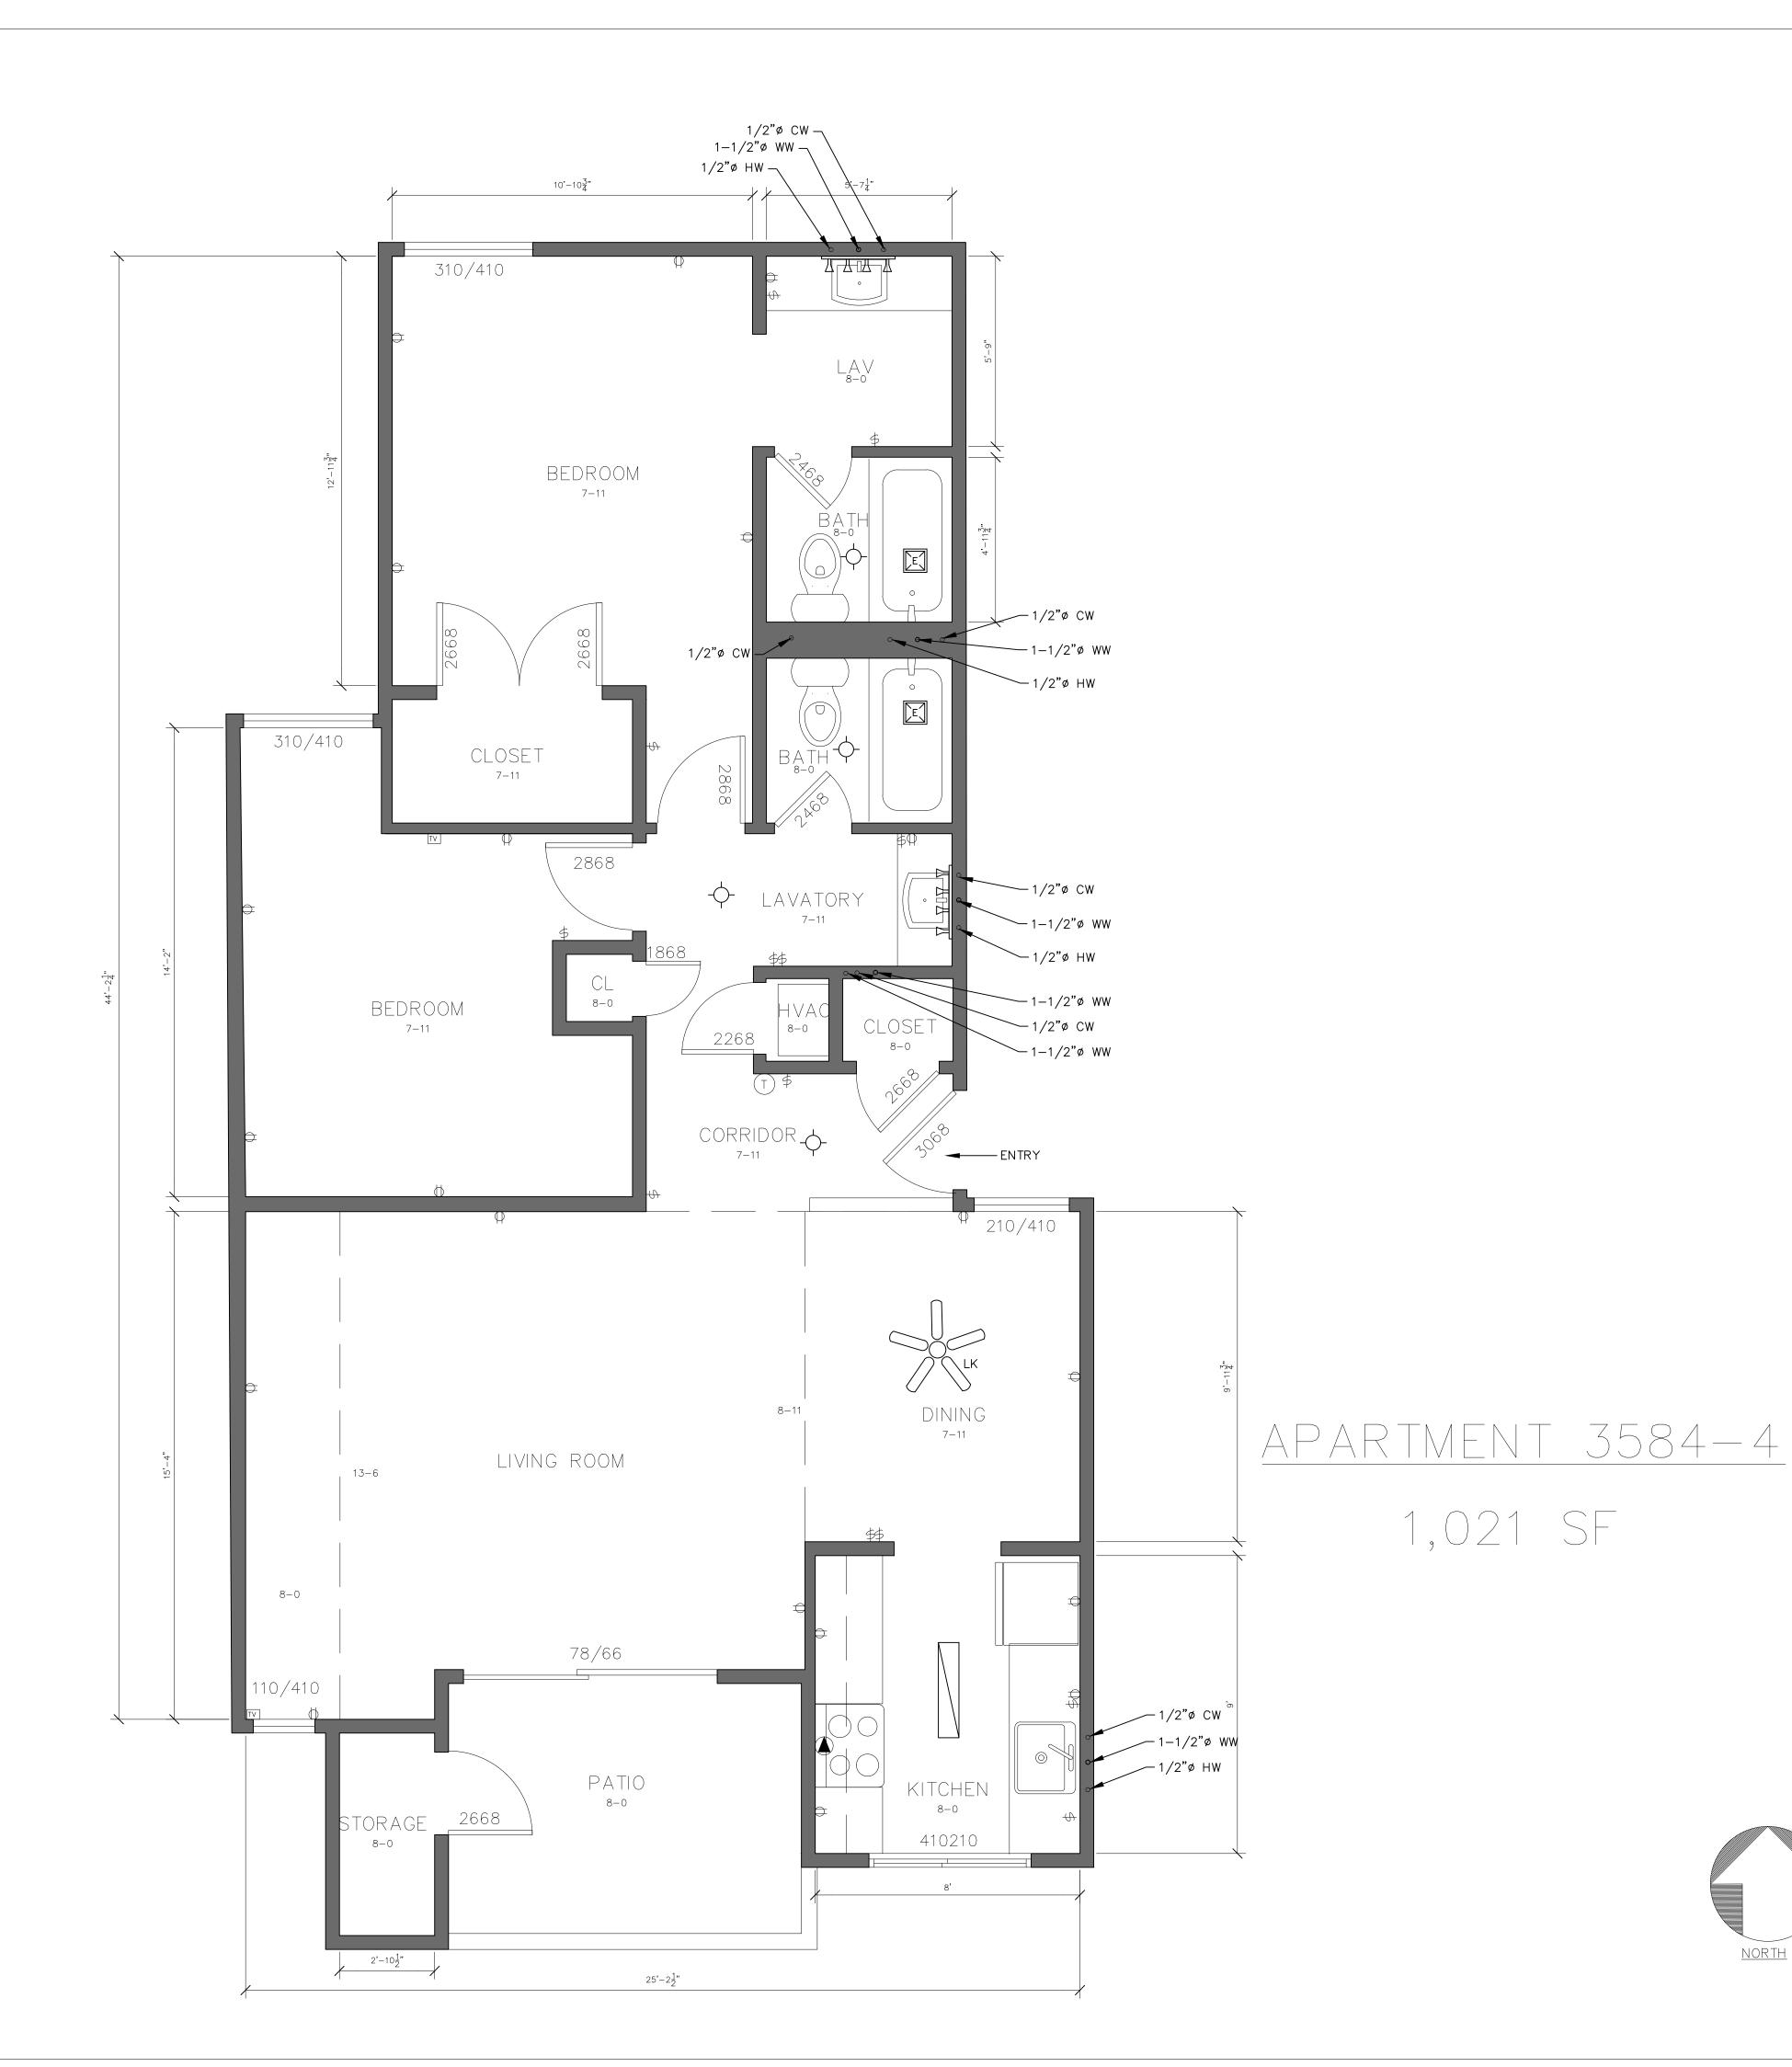

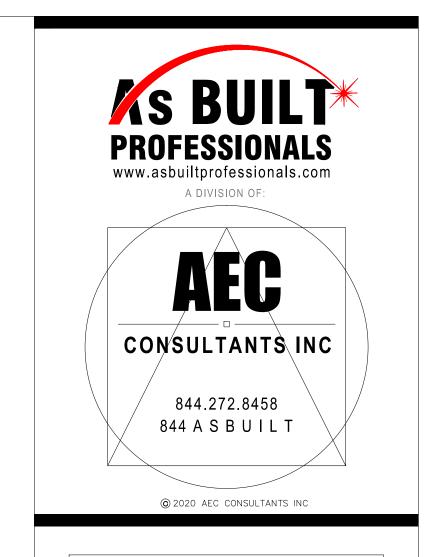

BU

ARCH

95821

CA

SACRAMENTO,

٧٥.	 ISSUES REVISIONS	DATE

3584-4
FLOORPLAN &
RCP


	PROJECT	MANAGER
L	PROJECT	DIRECTOR
	PROJECT	NUMBER
/8''=1' -0 ''	SCALE	
M	DRAWN E	3Y

✓ Floor plans with visible MEP

☑ Reflected Ceiling Plan with heights, transitions, visible MEP

by painters tape left by Bullseye Leak Detection

☑ Door and Window sizes

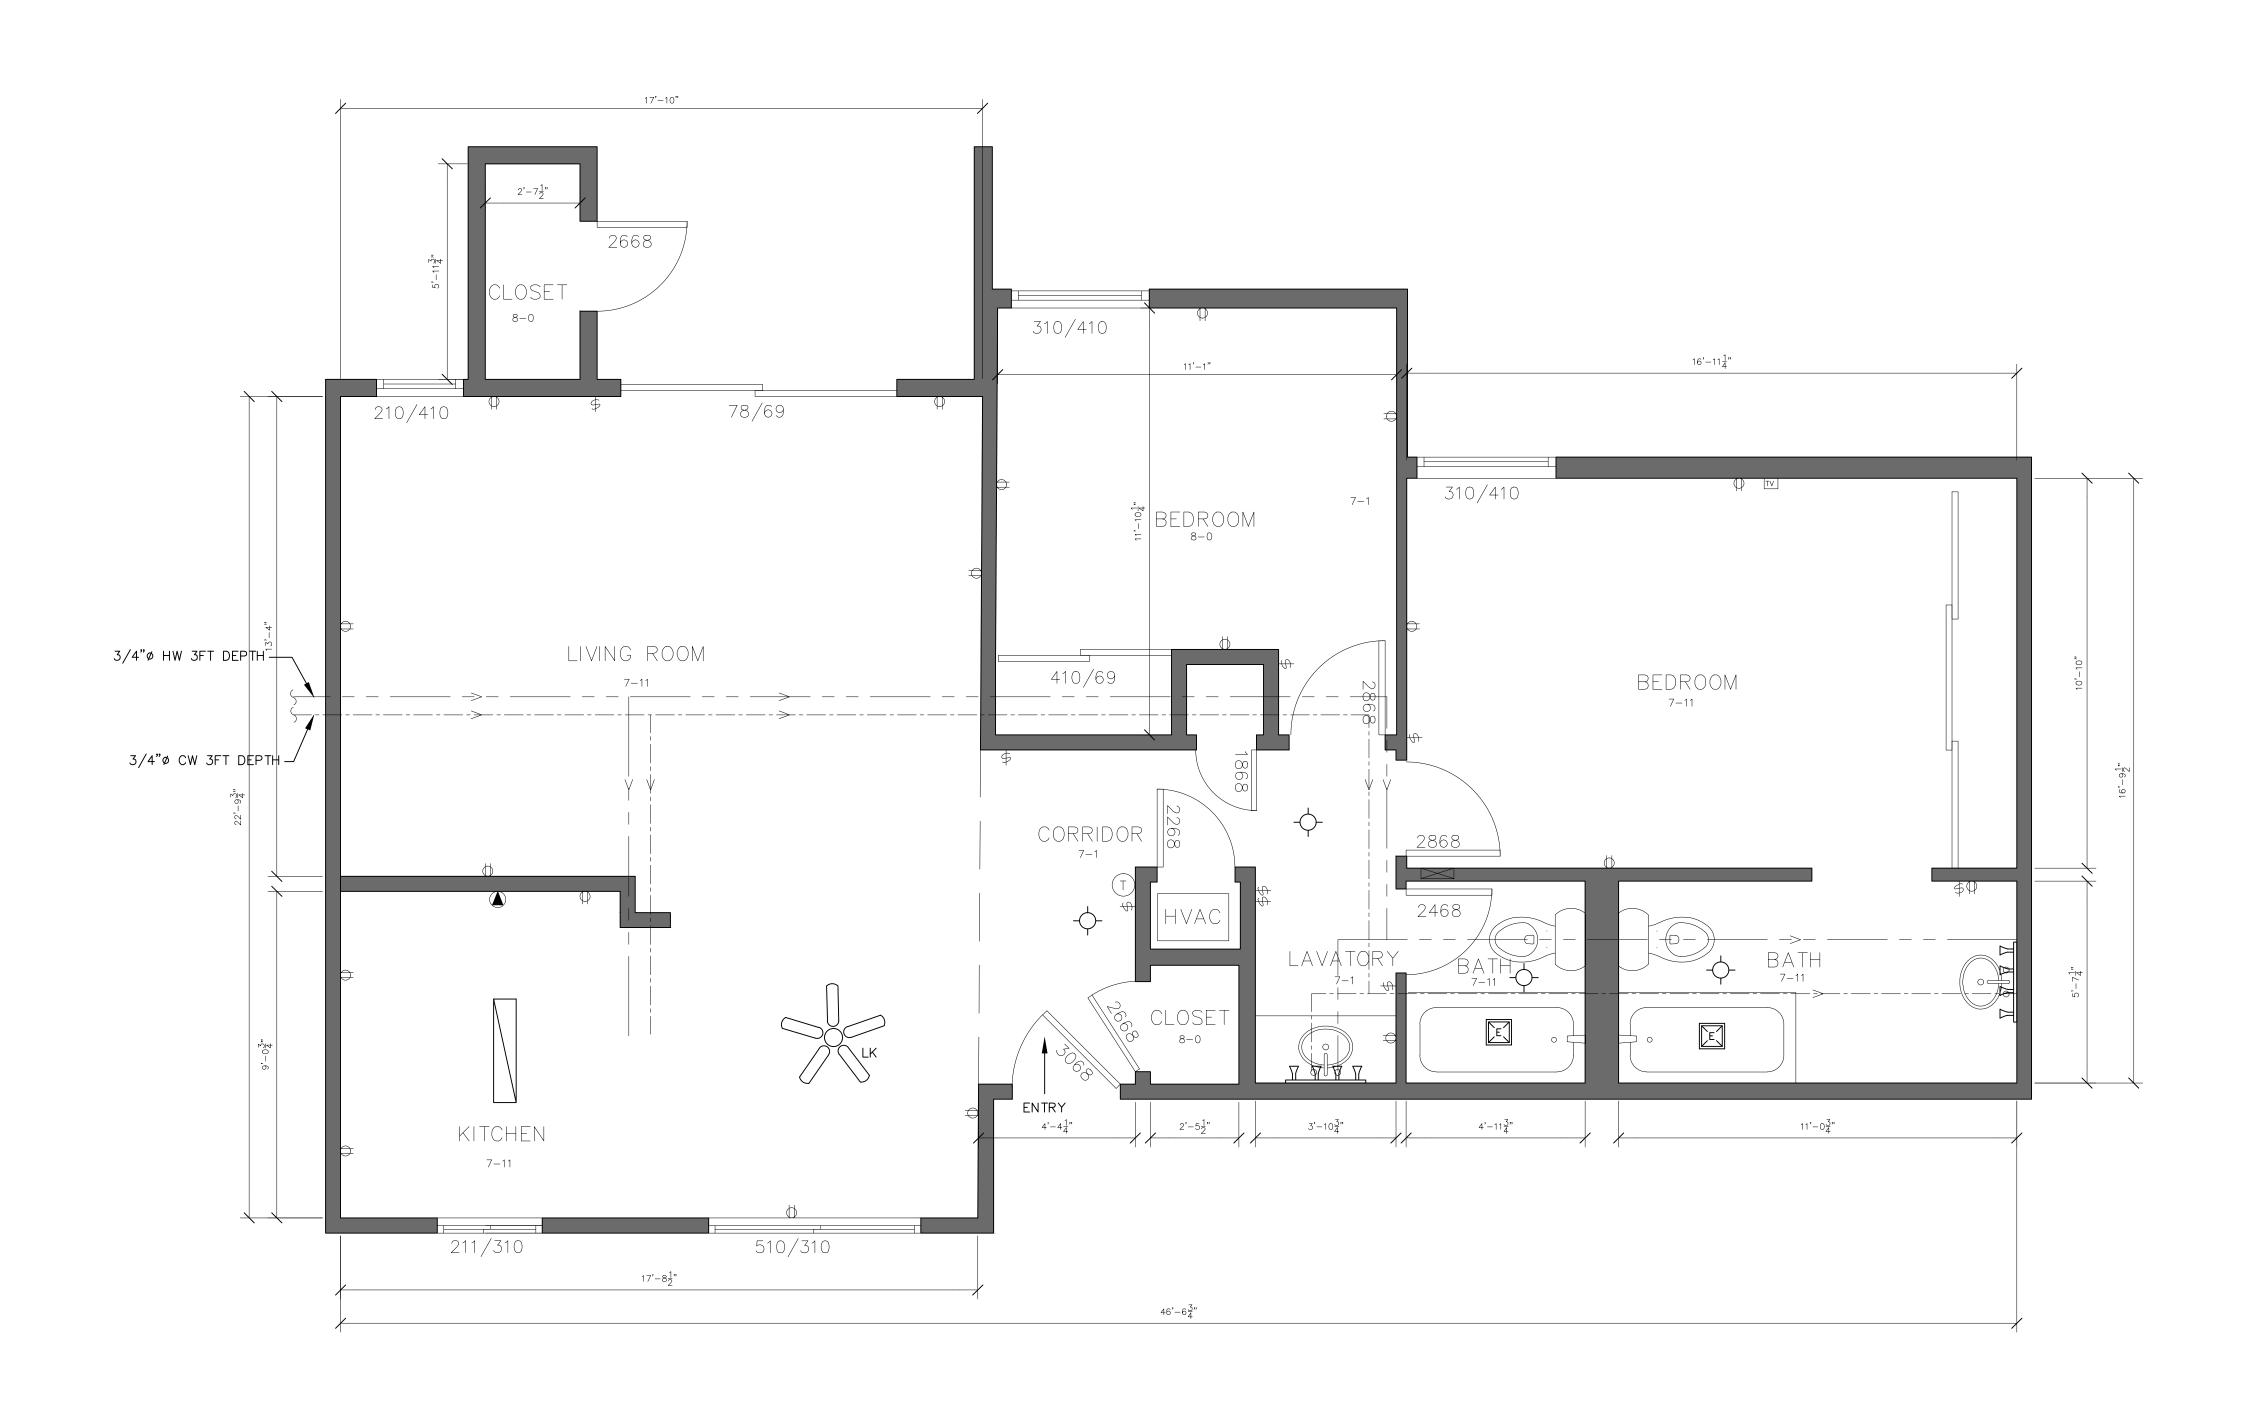

APARTMENT 3658-13 (UNDER CONSTRUCTION) 1,027 SF



95821

CA

SACRAMENTO,

ARCH

NO. ISSUES | REVISIONS

3658-13 FLOORPLAN & **RCP**

3/8"=1'-0"	
? PROJEC	CT NUMBER
HL PROJEC	CT DIRECTOR
HL PROJEC	CT MANAGER




✓ Floor plans with visible MEP

☑ Reflected Ceiling Plan with heights, transitions, visible MEP

by painters tape left by Bullseye Leak Detection

✓ Door and Window sizes

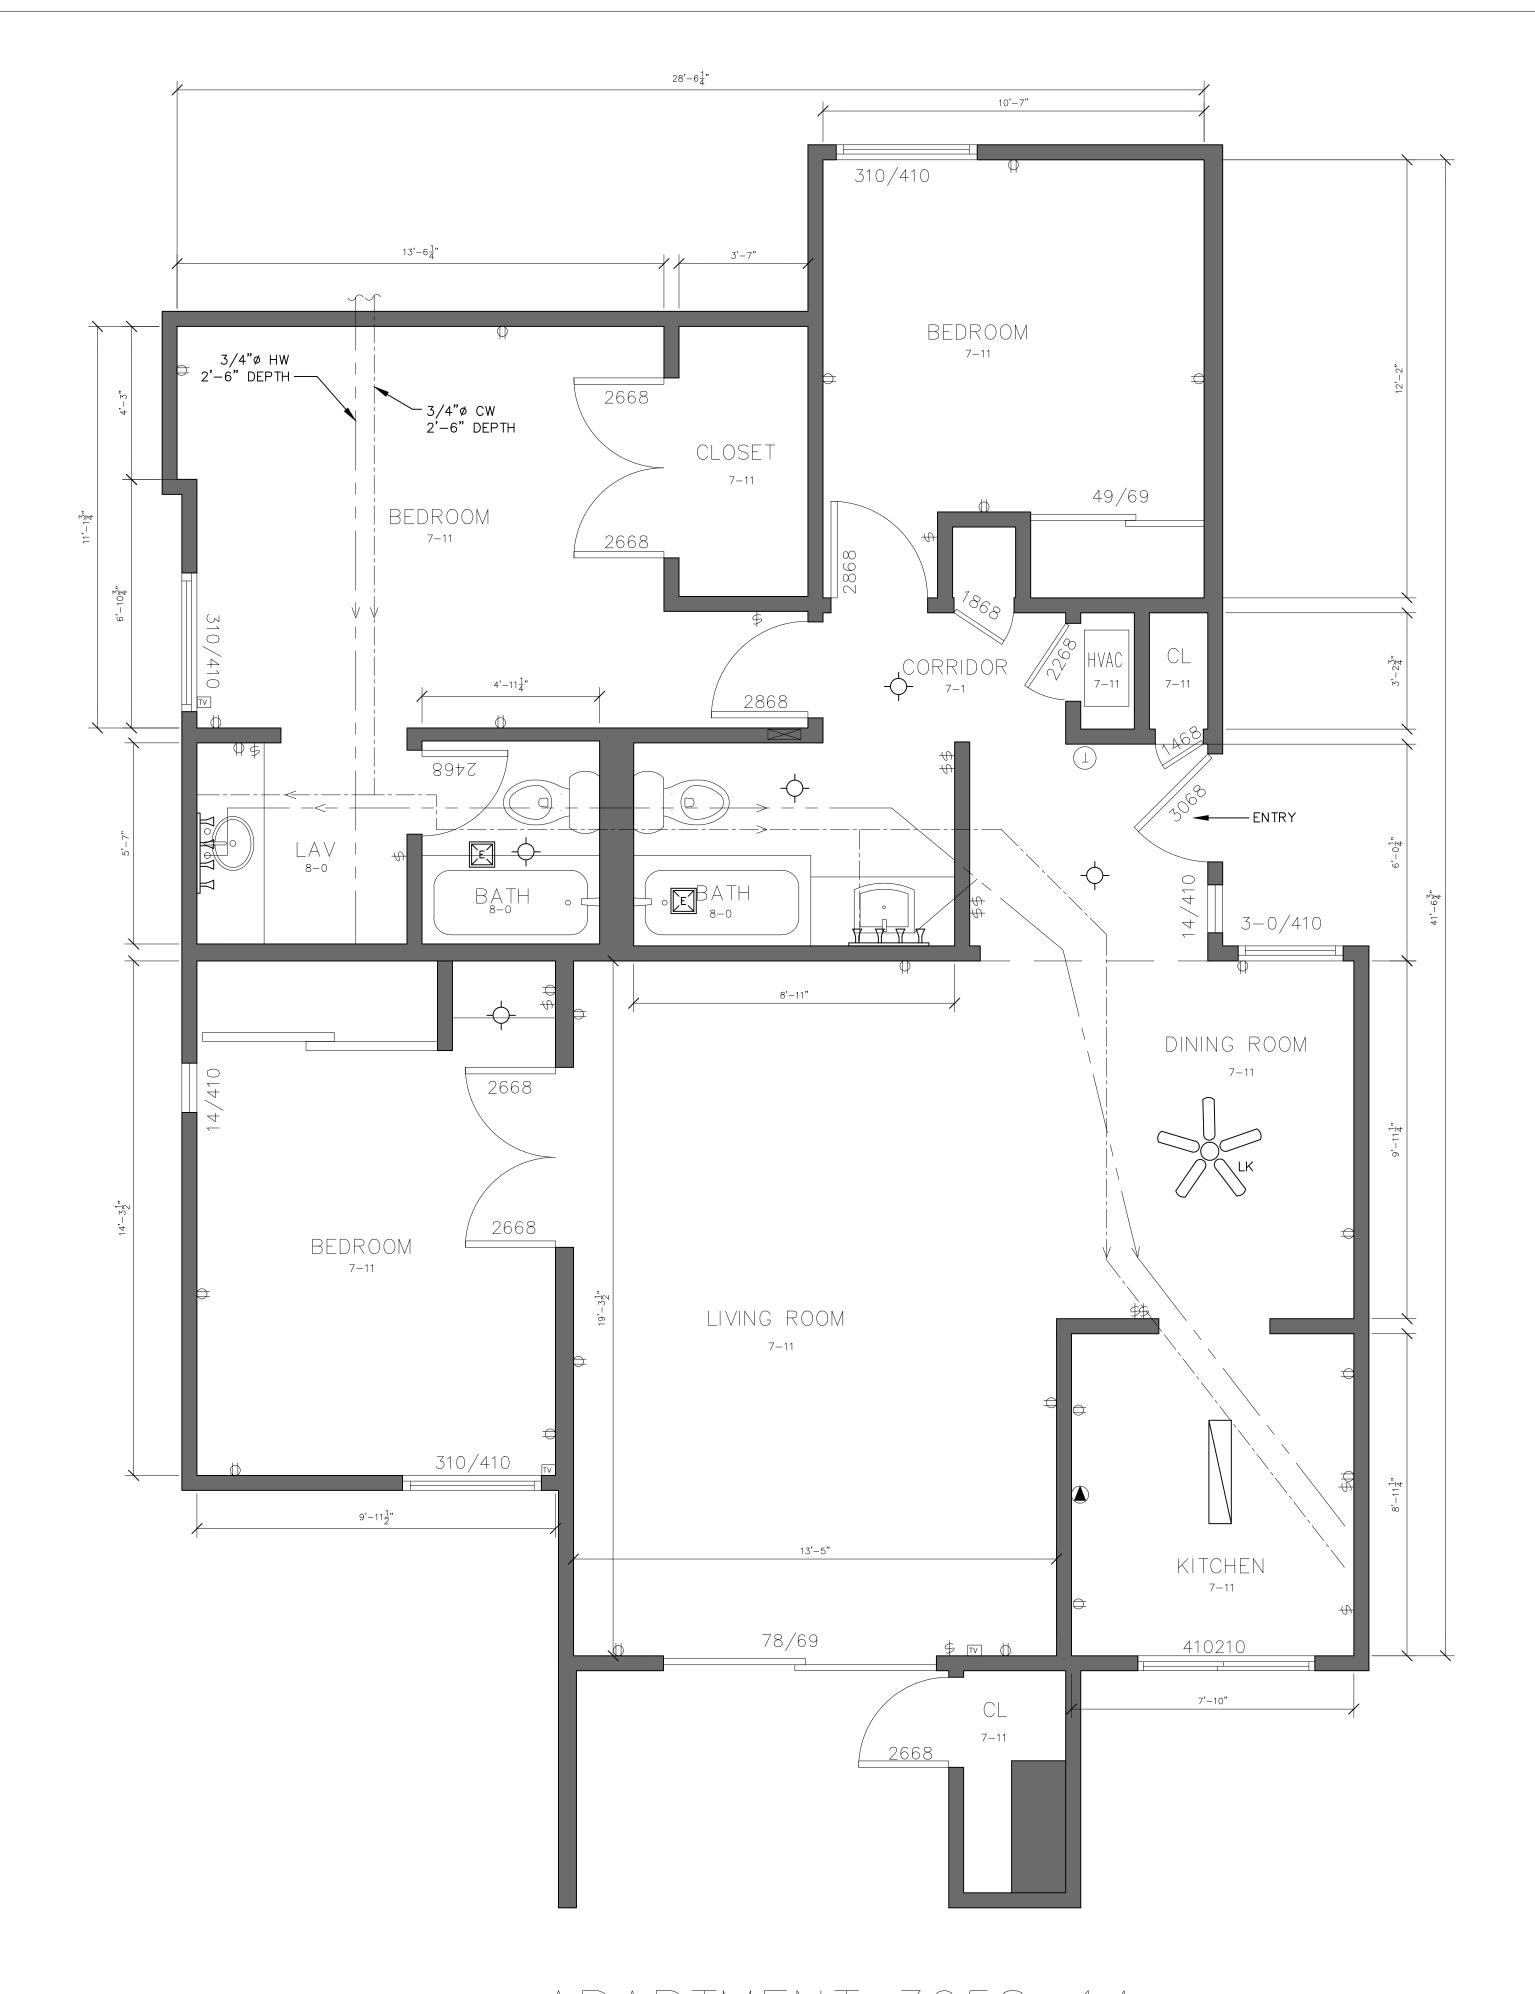

APARTMENT 3658-14

(UNDER CONSTRUCTION)

1,201 SF



BUILT

FECTURAL AS EXENSINGTON APARTMENTS

95821

CA

SACRAMENTO,

NO. ISSUES | REVISIONS

DATE

SHEET TITLE

3658-14
FLOORPLAN & RCP

MM	DRAWN BY
3/8"=1'-0"	SCALE
?	PROJECT NUMBER
HL	PROJECT DIRECTOR
HL	PROJECT MANAGER





✓ Floor plans with visible MEP

☑ Reflected Ceiling Plan with heights, transitions, visible MEP

by painters tape left by Bullseye Leak Detection

✓ Door and Window sizes

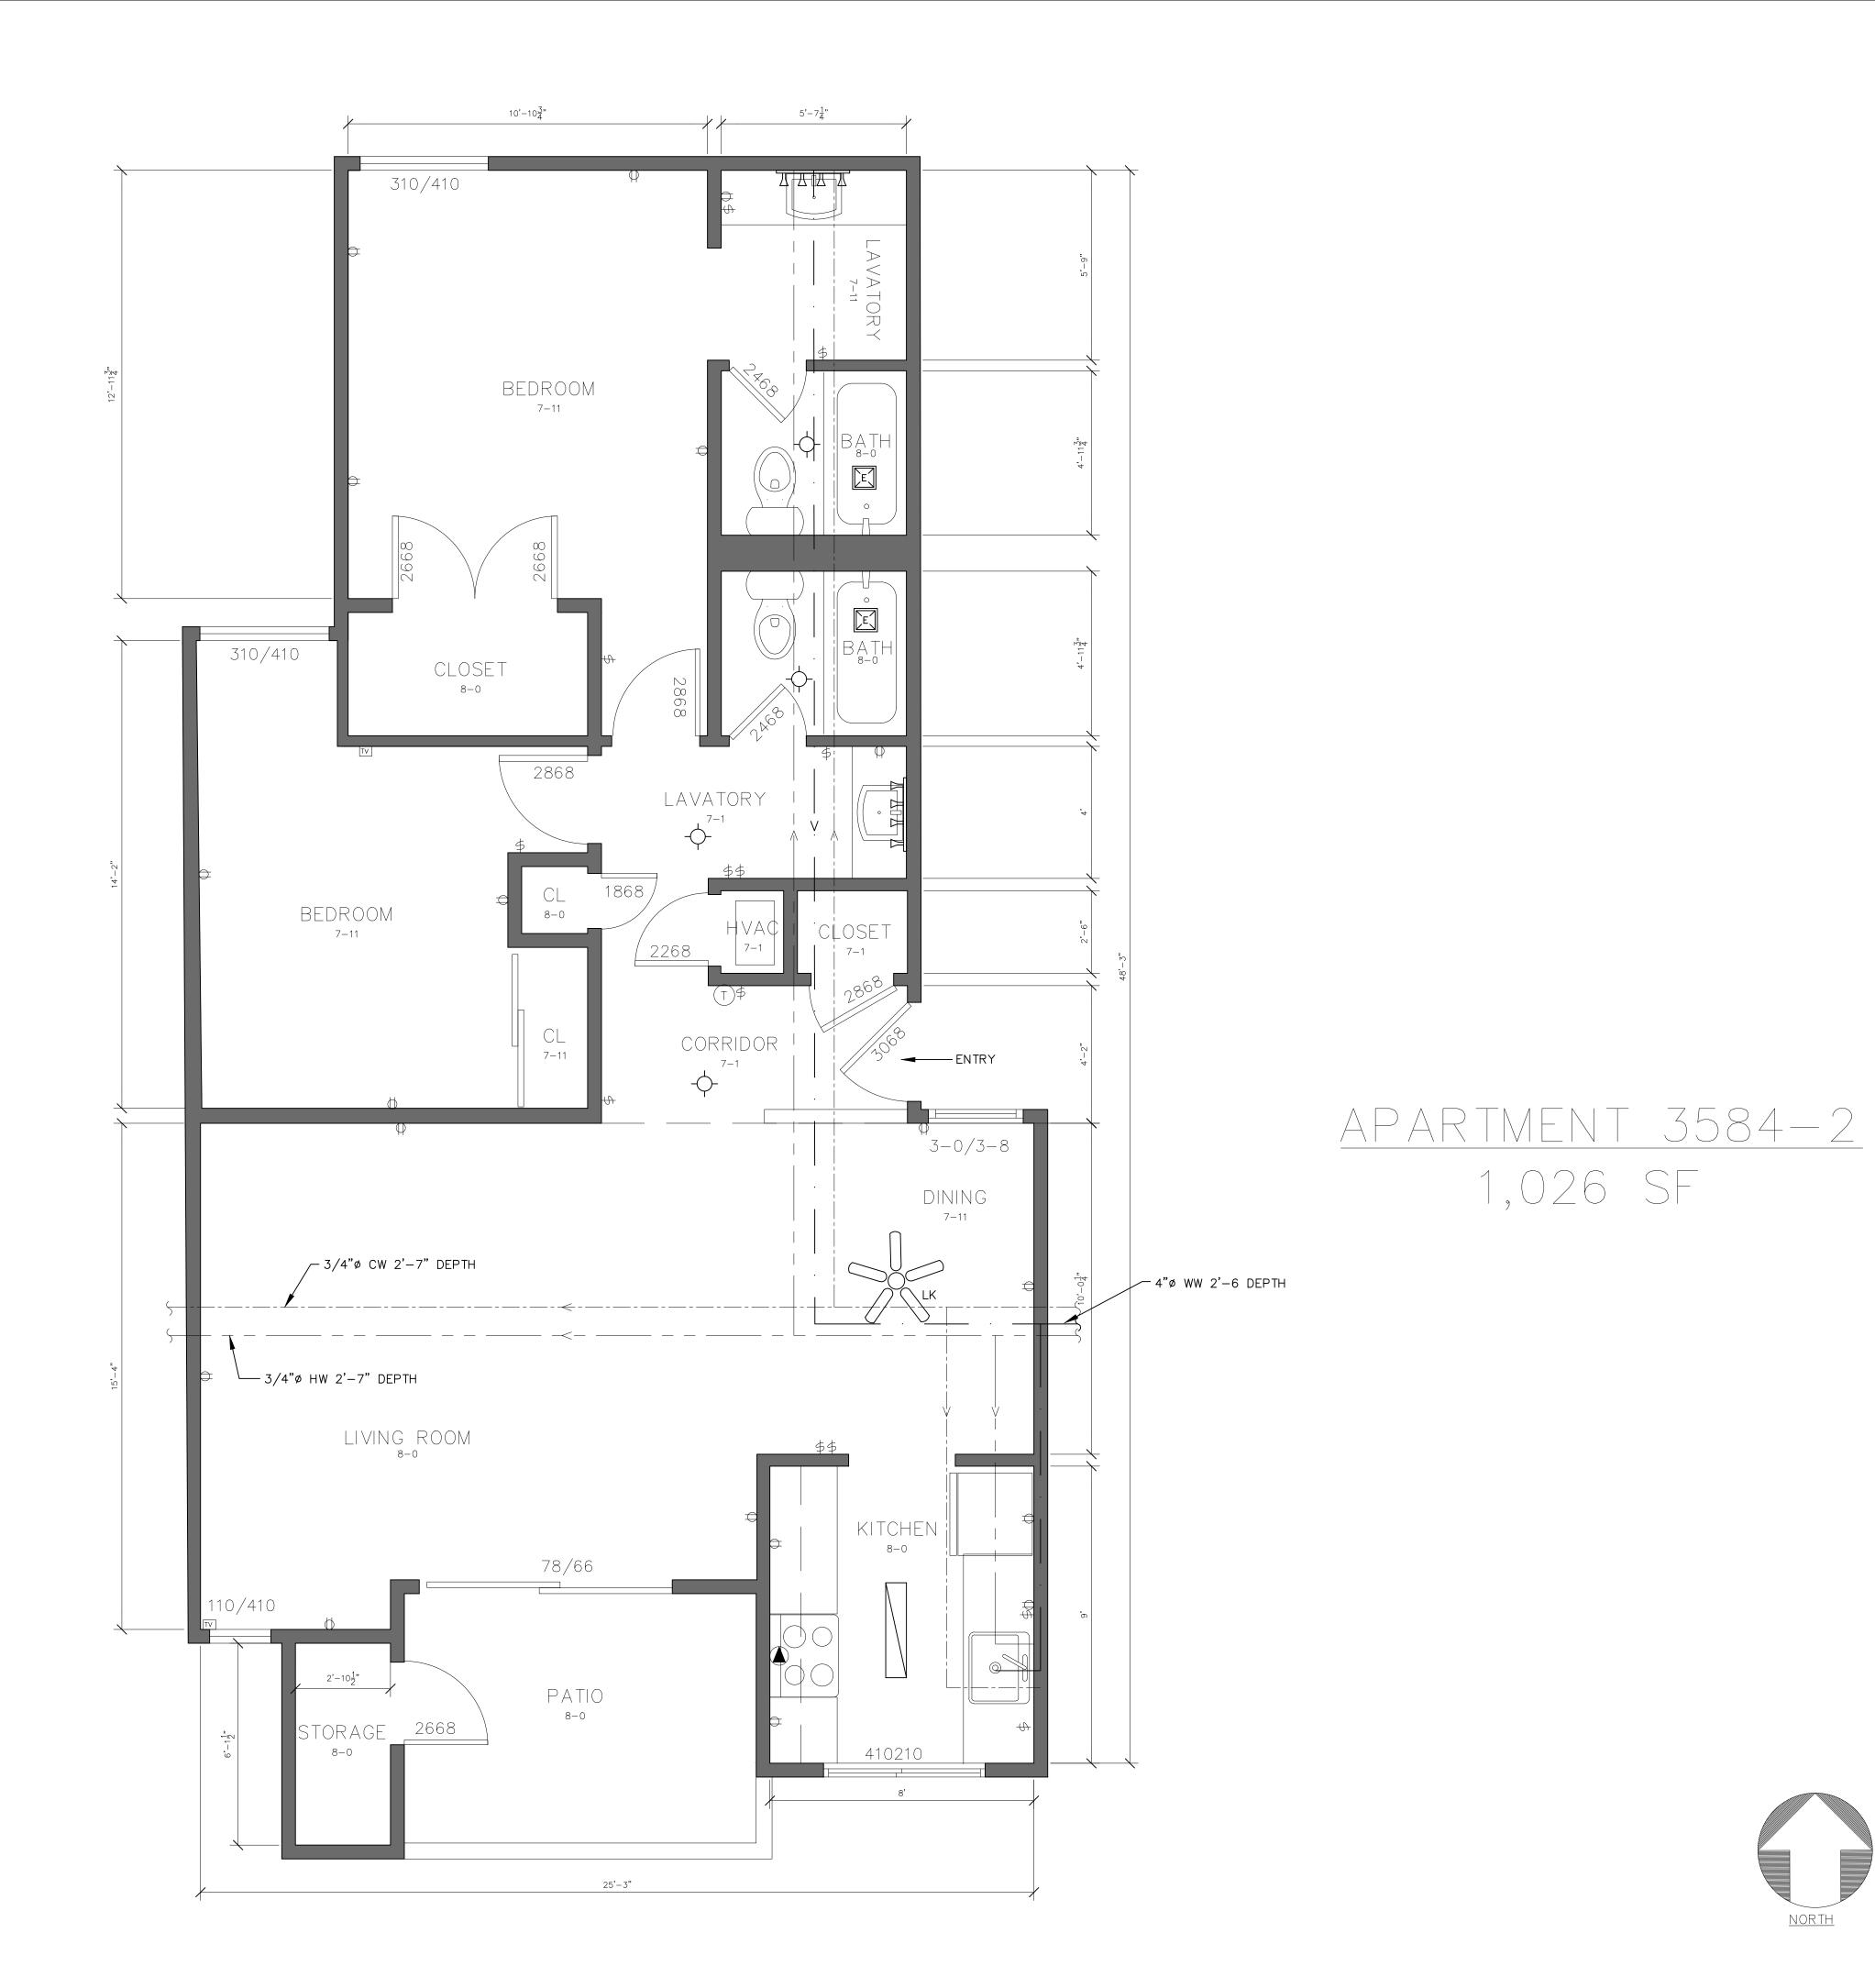

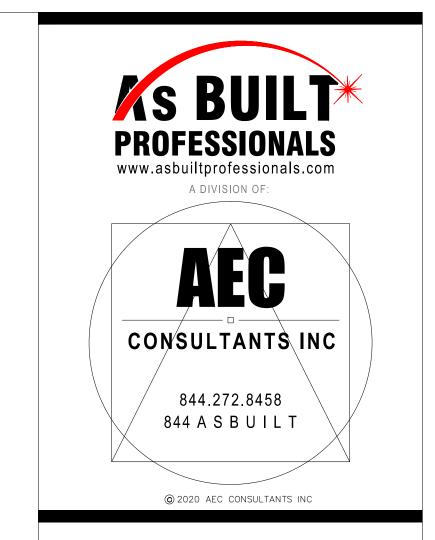

BU

95821

CA

SACRAMENTO,

ARCHI

NO. ISSUES | REVISIONS 3584-2

FLOORPLAN & **RCP**

3/8"=1'-0"


✓ Floor plans with visible MEP

☑ Reflected Ceiling Plan with heights, transitions, visible MEP


✓ Hot, Cold, Sanitary plumbing lines as indicated

by painters tape left by Bullseye Leak Detection

✓ Door and Window sizes

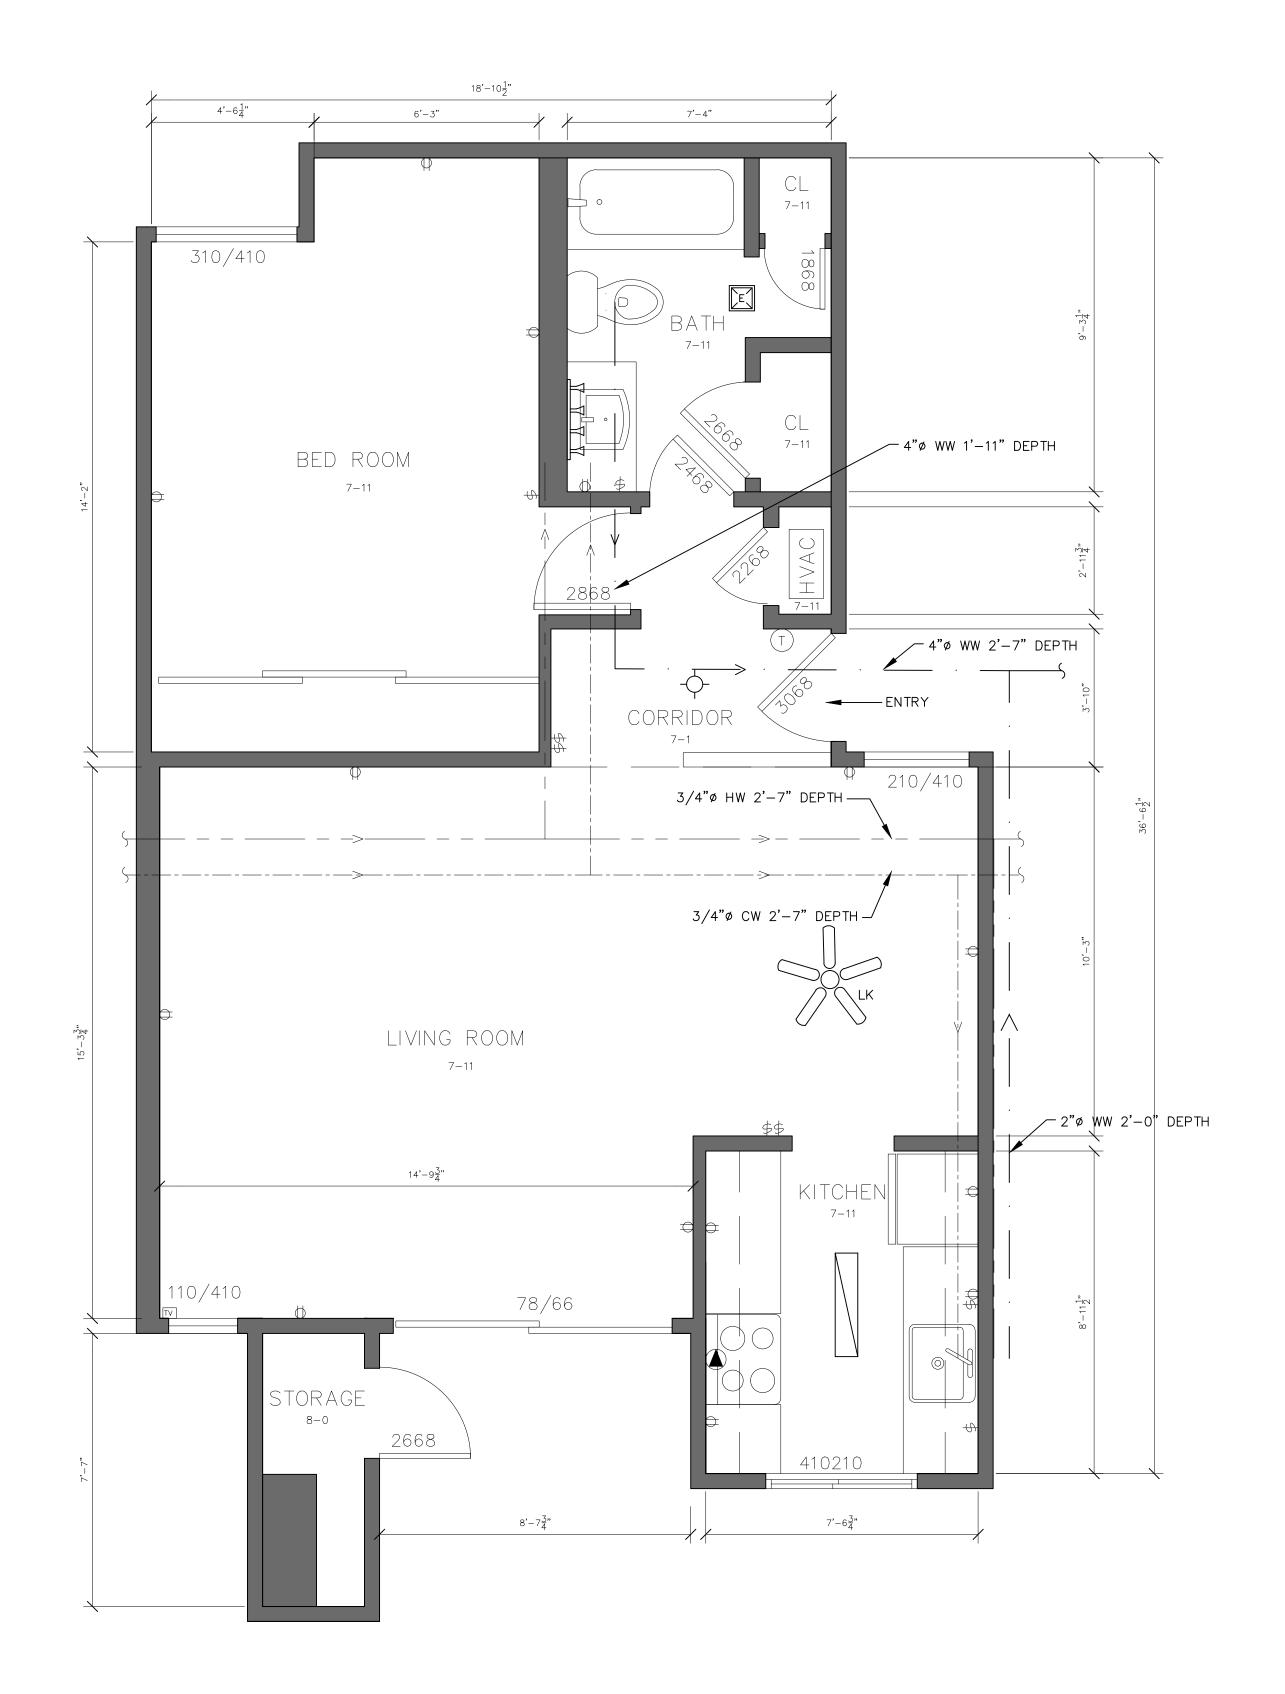

APARTMENT 3648-2 773 SF

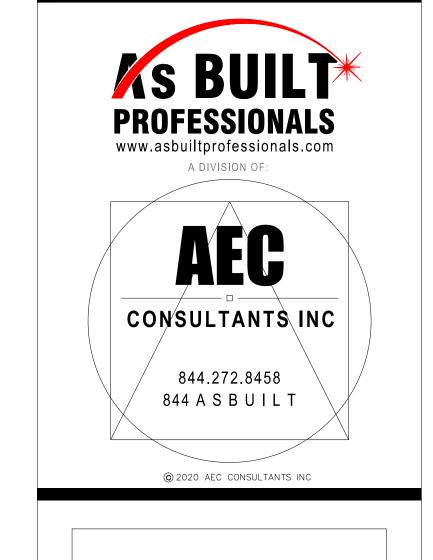

ARCH


95821

CA

	 -		
	 -		
	 1		
	 -		
0.	 ISSUES REVISIONS	DATE	

3648-2 FLOORPLAN & **RCP**

3/8"=1'-0"	SCALE
?	PROJECT NUMBER
HL	PROJECT DIRECTOR
HL	PROJECT MANAGER

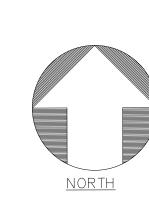


Floor plans with visible MEP


☑ Reflected Ceiling Plan with heights, transitions, visible MEP

by painters tape left by Bullseye Leak Detection

✓ Door and Window sizes

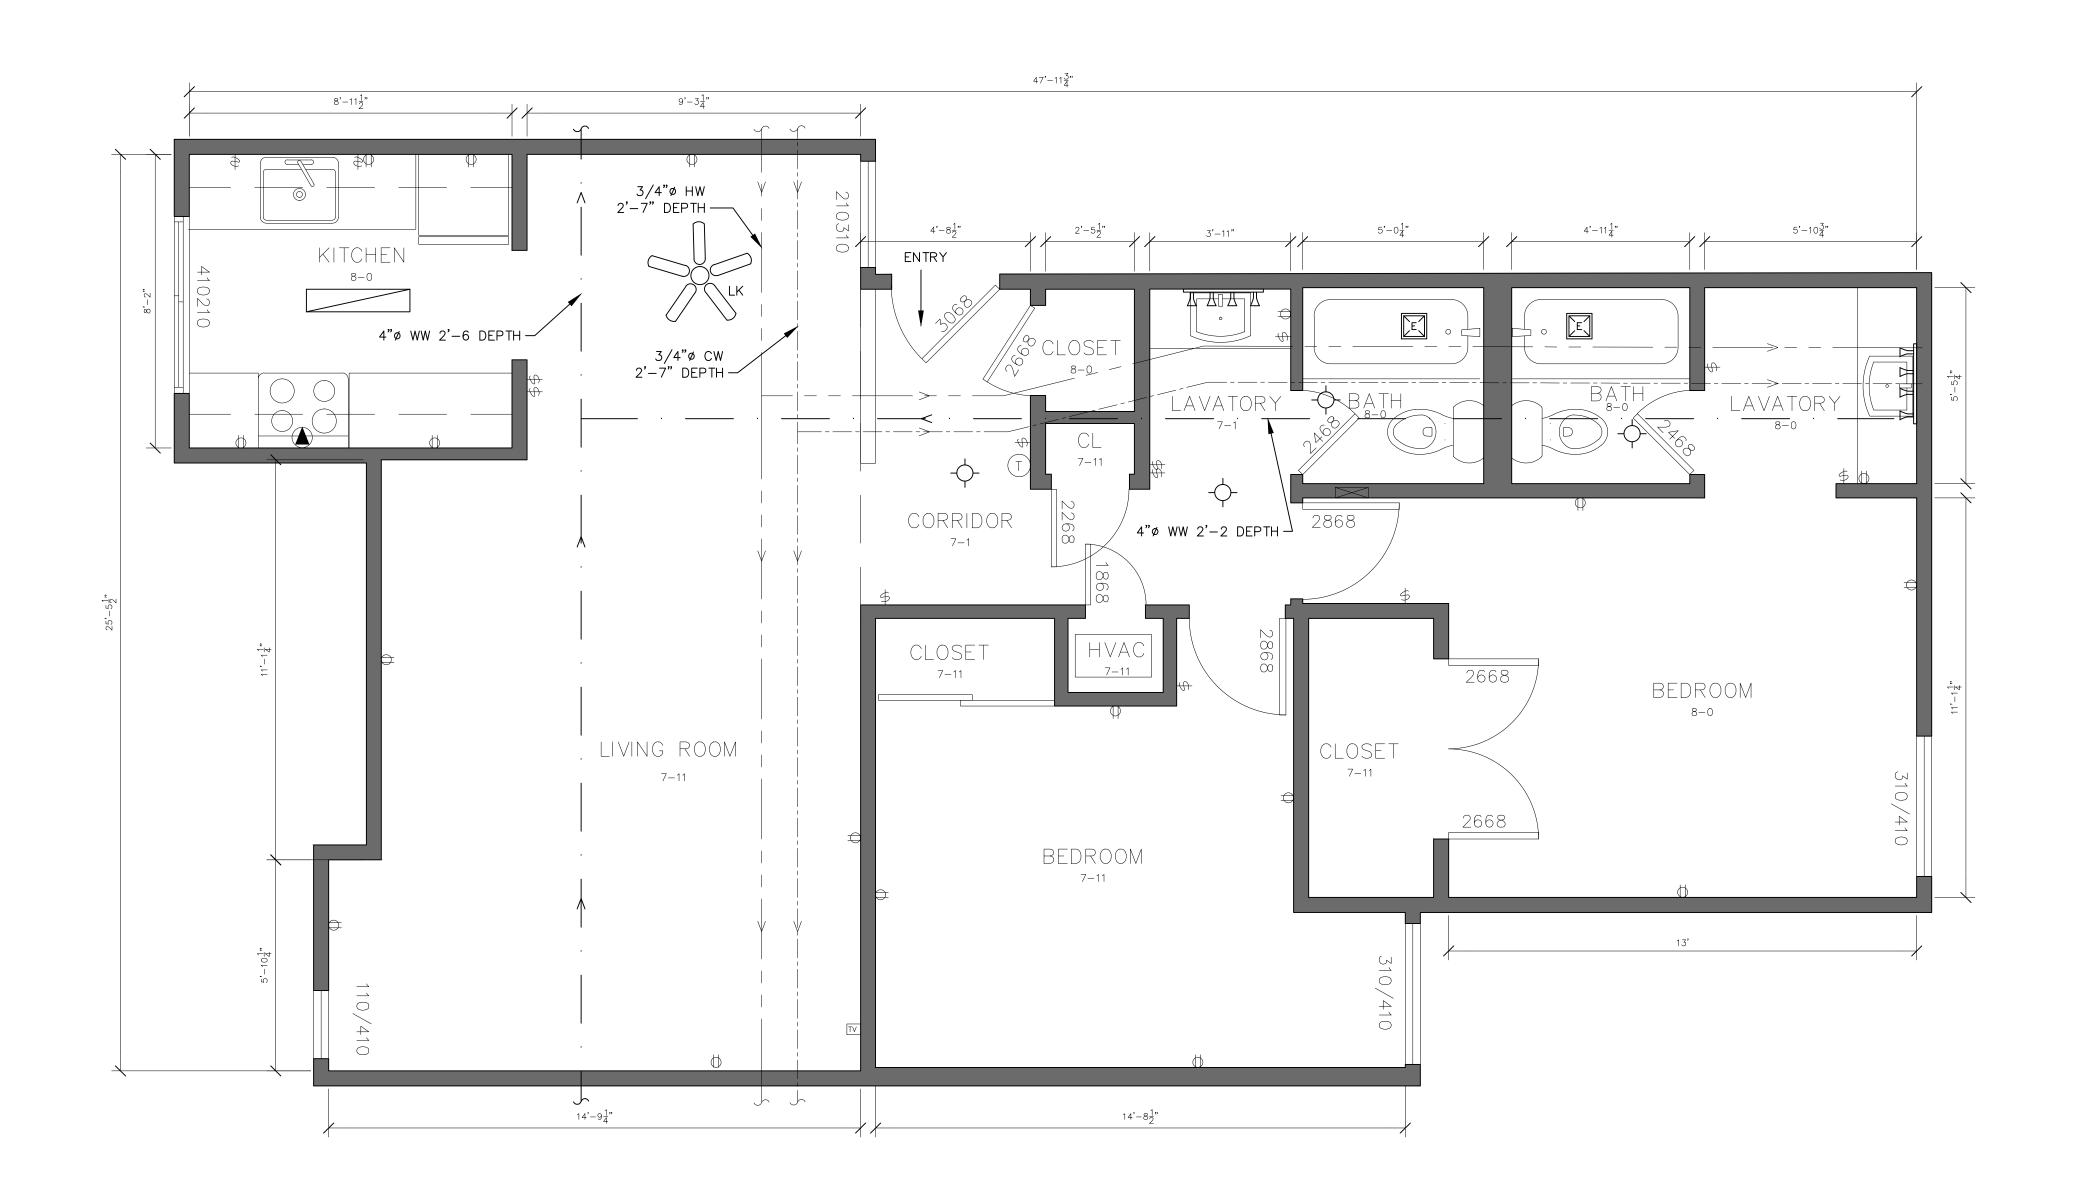

<u>APARTMENT 3704-1</u>
1,023 SF

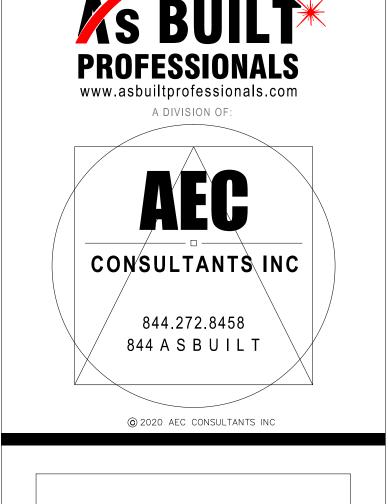

BUILT

JRAL AS BU

ARCI

KENSINGTON APARTME

95821

CA

SACRAMENTO,


3704-1 FLOORPLAN & RCP

NO. ISSUES | REVISIONS

IL F	PROJECT	MANAGER
IL F	PROJECT	DIRECTO
F	PROJECT	NUMBER

3/8"=1'-0"

SHEET NUMBE

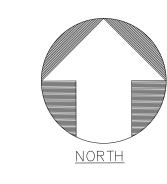


✓ Floor plans with visible MEP

☑ Reflected Ceiling Plan with heights, transitions, visible MEP

by painters tape left by Bullseye Leak Detection

✓ Door and Window sizes

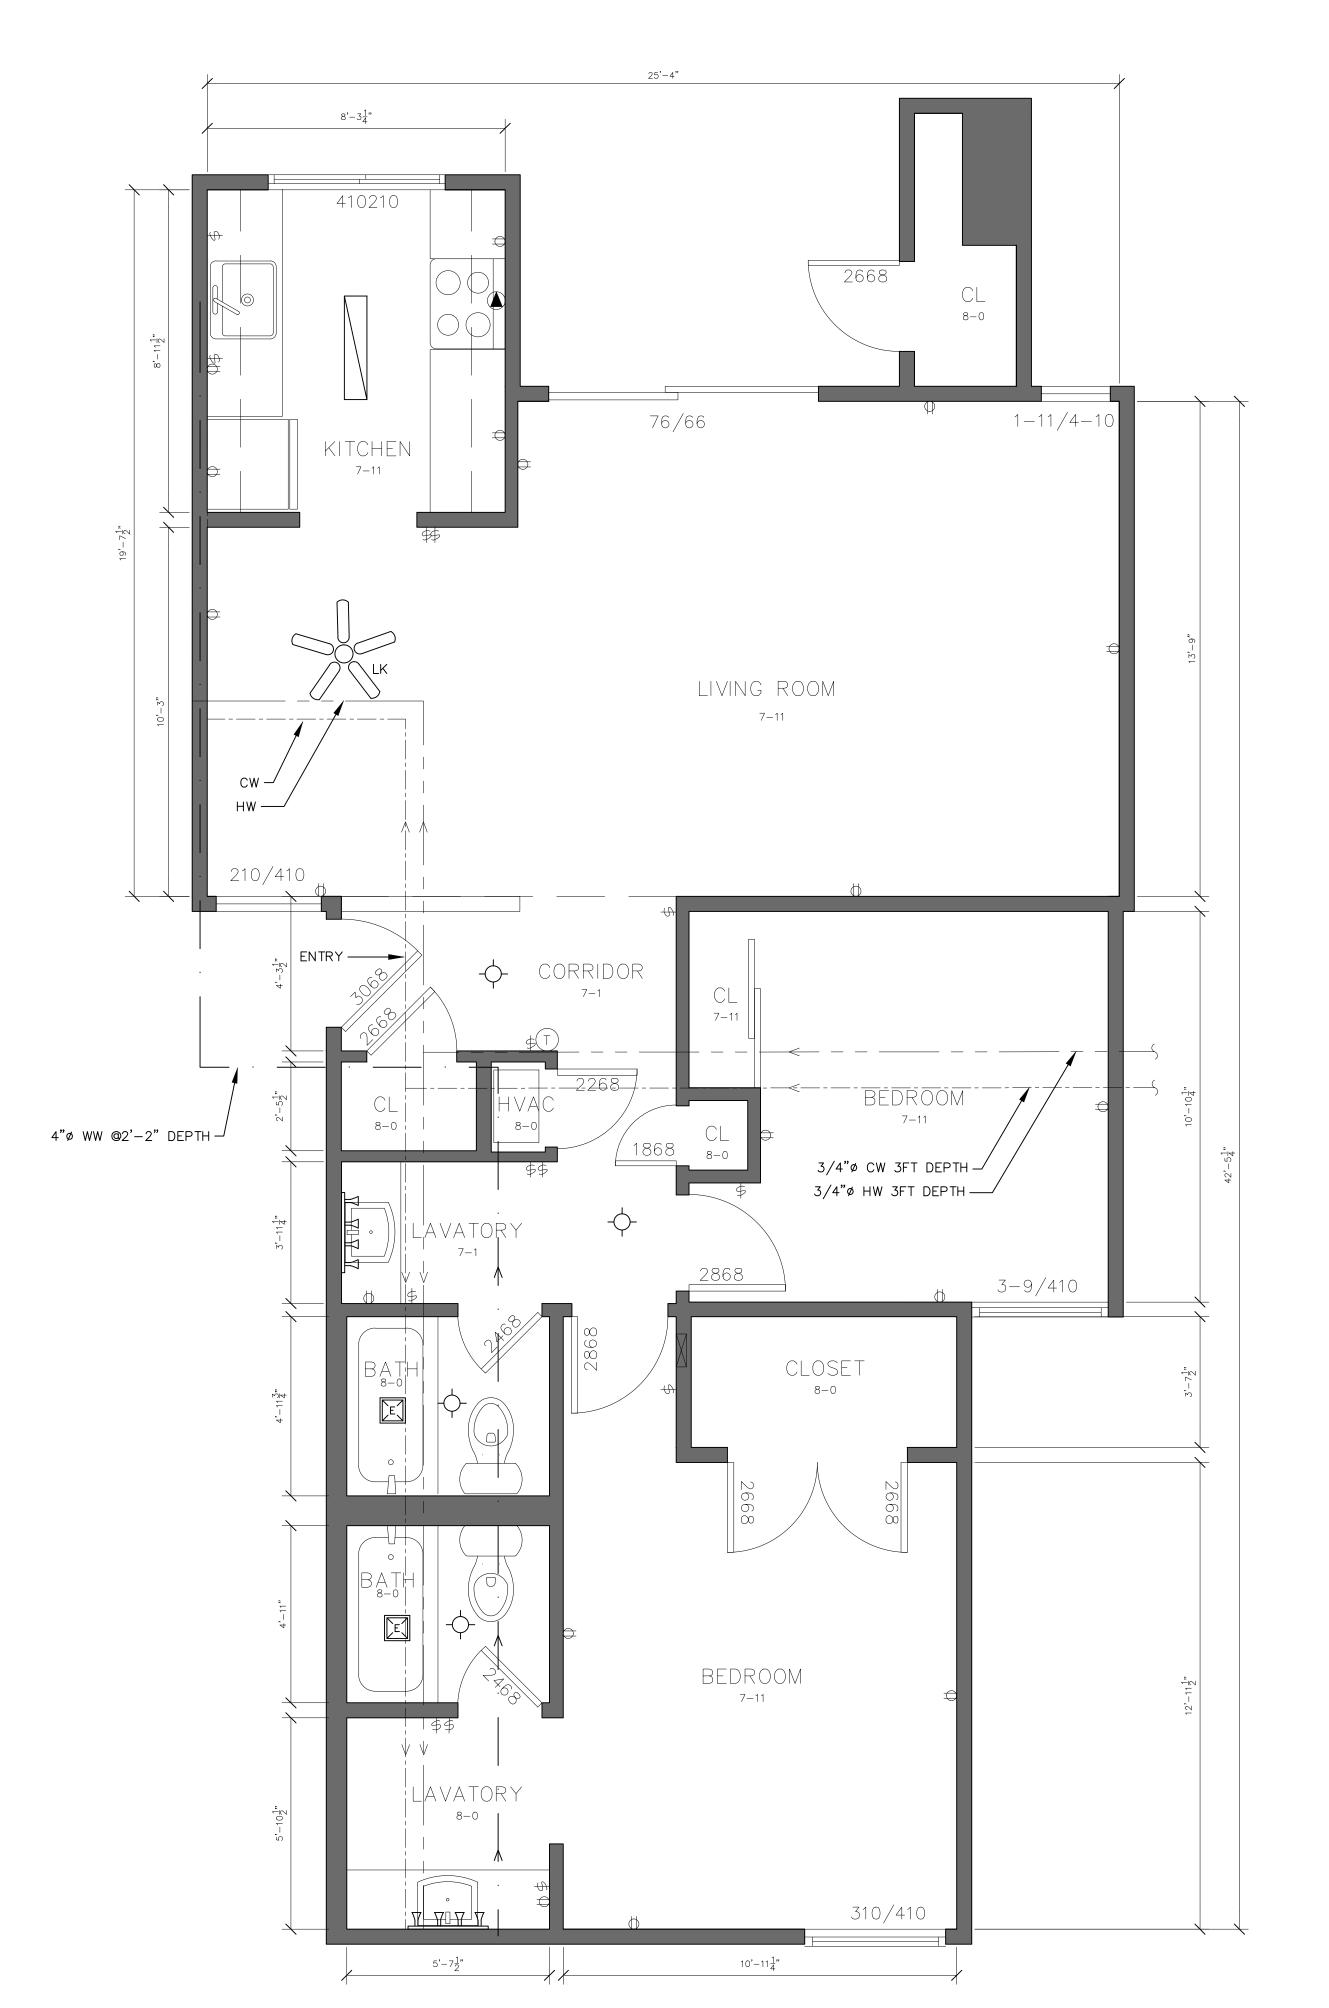

APARTMENT 3698-2 1,026 SF



95821 CA

ARCHI

NO.	ISSUES REVISIONS	DATE
		SHEET TITLE

3698-2 FLOORPLAN & **RCP**

L	PROJECT	MANAGER	
L	PROJECT	DIRECTOR	
	PROJECT	NUMBER	

3/8"=1'-0"

