


AS-BUILT DOCUMENTATION


NEW YORK, NY 10036

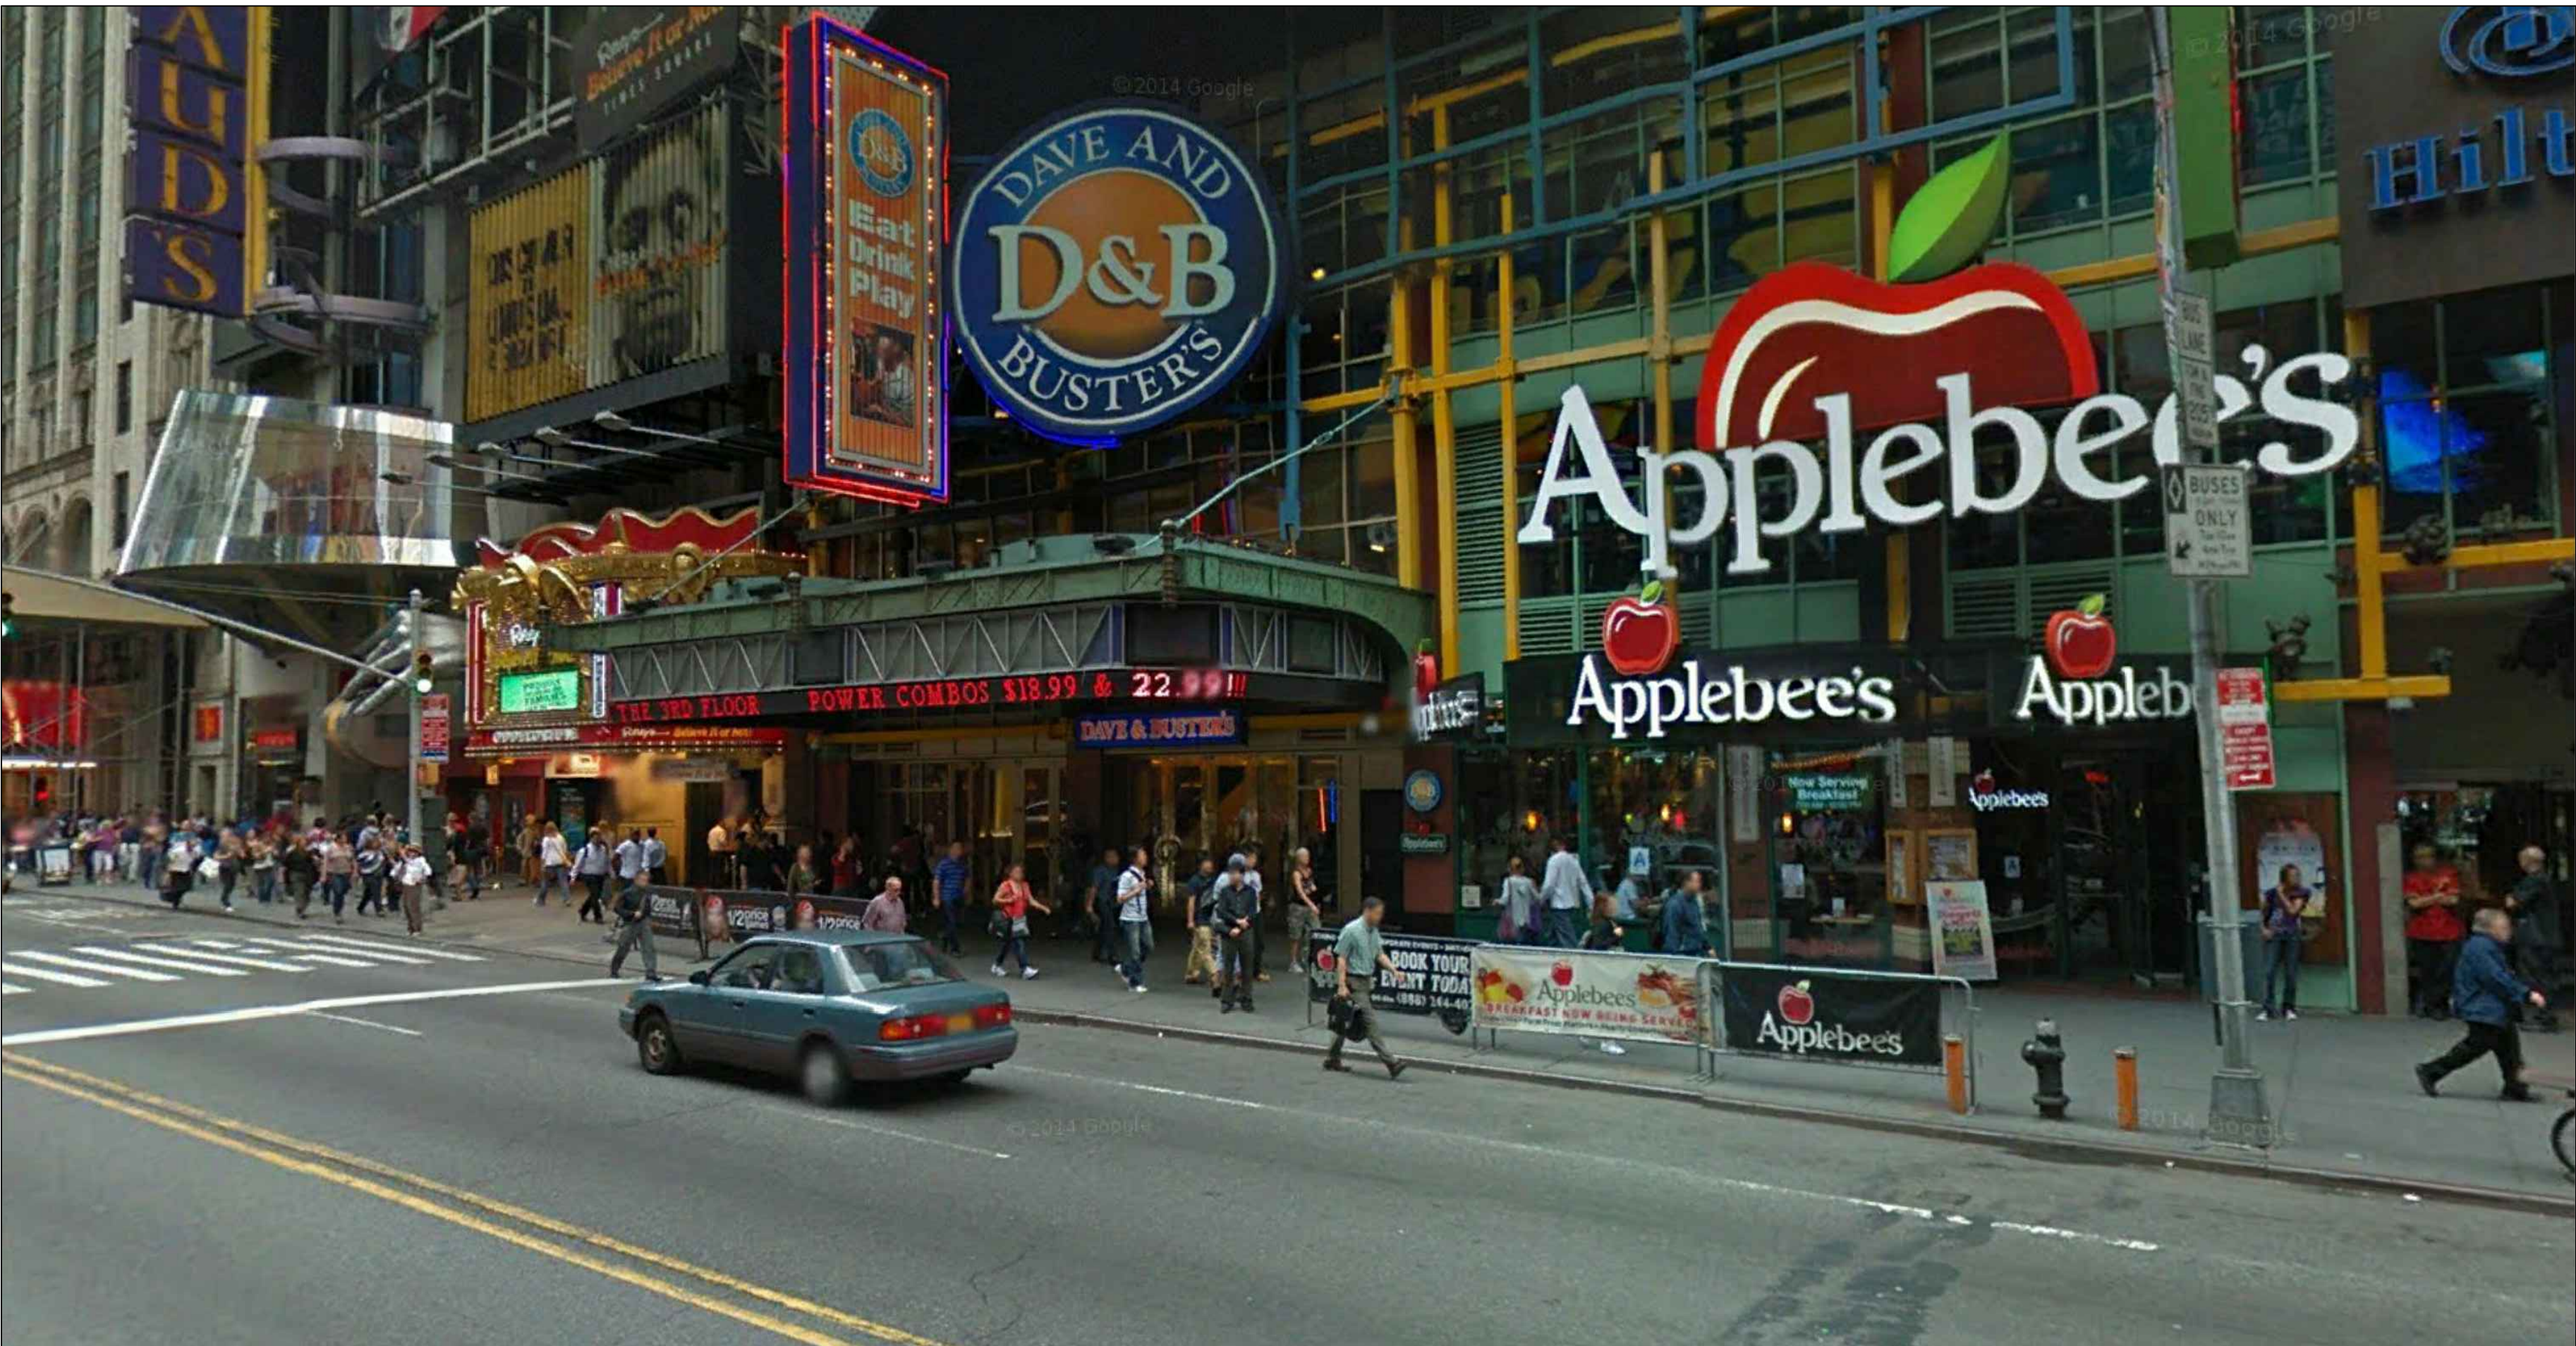

100% SUBMITTAL

DRAWING INDEX

C-1	COVER SHEET DRAWING INDEX
SL	SYMBOLS LEGEND
AB-0	BASEMENT PLAN
AB-1	FIRST FLOOR PLAN
AB-2	SECOND FLOOR PLAN
AB-3	THIRD FLOOR PLAN

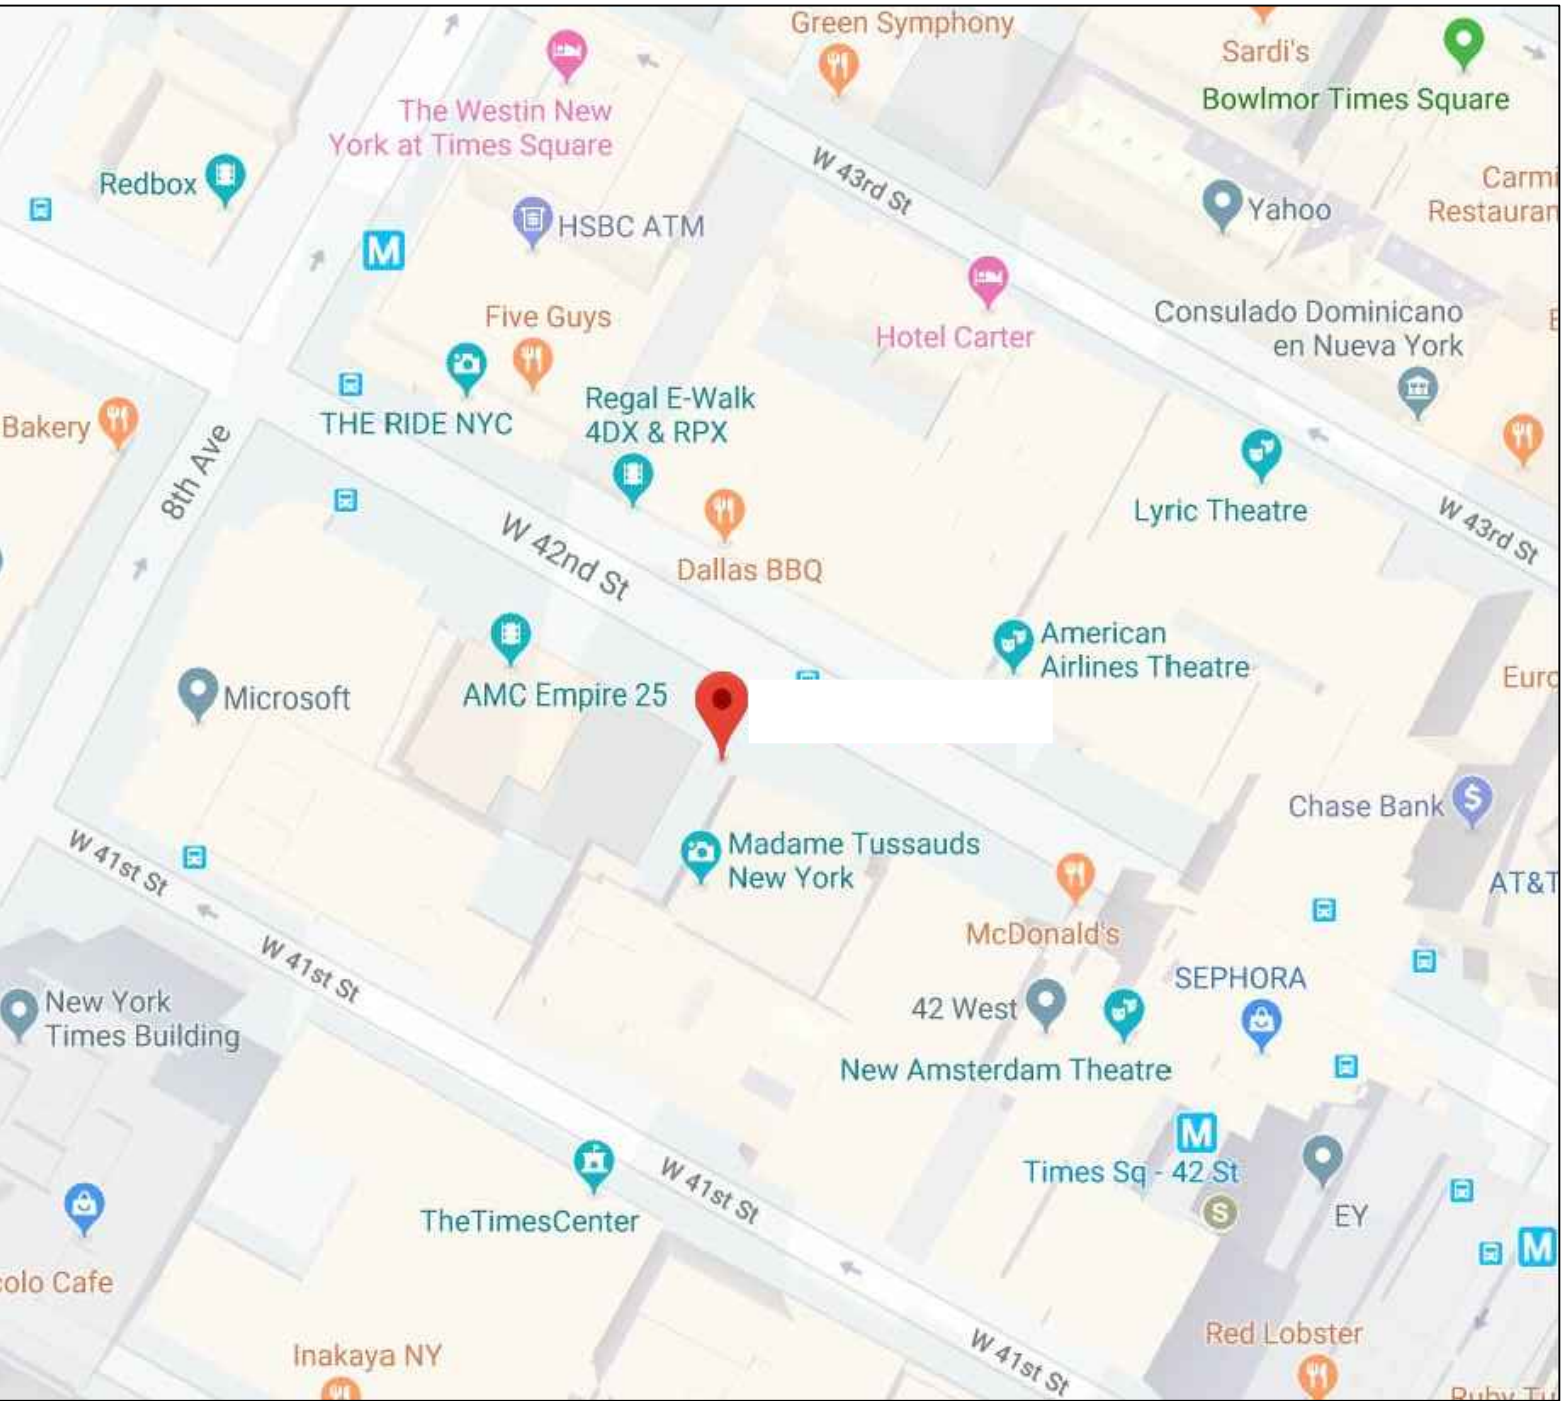

VICINITY MAP NTS

AREA DATA	
BASEMENT FLOOR	2068 SQ. FT. ±
FIRST FLOOR	10137 SQ. FT. ±
SECOND FLOOR	8264 SQ. FT. ±
THIRD FLOOR	3326 SQ. FT. ±
GRAND TOTAL	23759 SQ. FT. ±

AS BUILT

PROFESSIONALS

www.asbuiltprofessionals.com

A DIVISION OF:

AEC

CONSULTANTS INC

844.272.8458

844 AS BUILT

© 2019 AEC CONSULTANTS, INC.

ARCHITECTURAL AS BUILT



NEW YORK, NY 10036

01	100% SUBMISSION	SEE COVER SHEET
NO.	ISSUES REVISIONS	DATE
SHEET TITLE		
COVER SHEET		
HL	PROJECT MANAGER	
HL	PROJECT DIRECTOR	
012317-1	PROJECT NUMBER	
	SCALE	
CL	DRAWN BY	
	SHEET NUMBER	

C1

SYMBOLS LEGEND


RCP

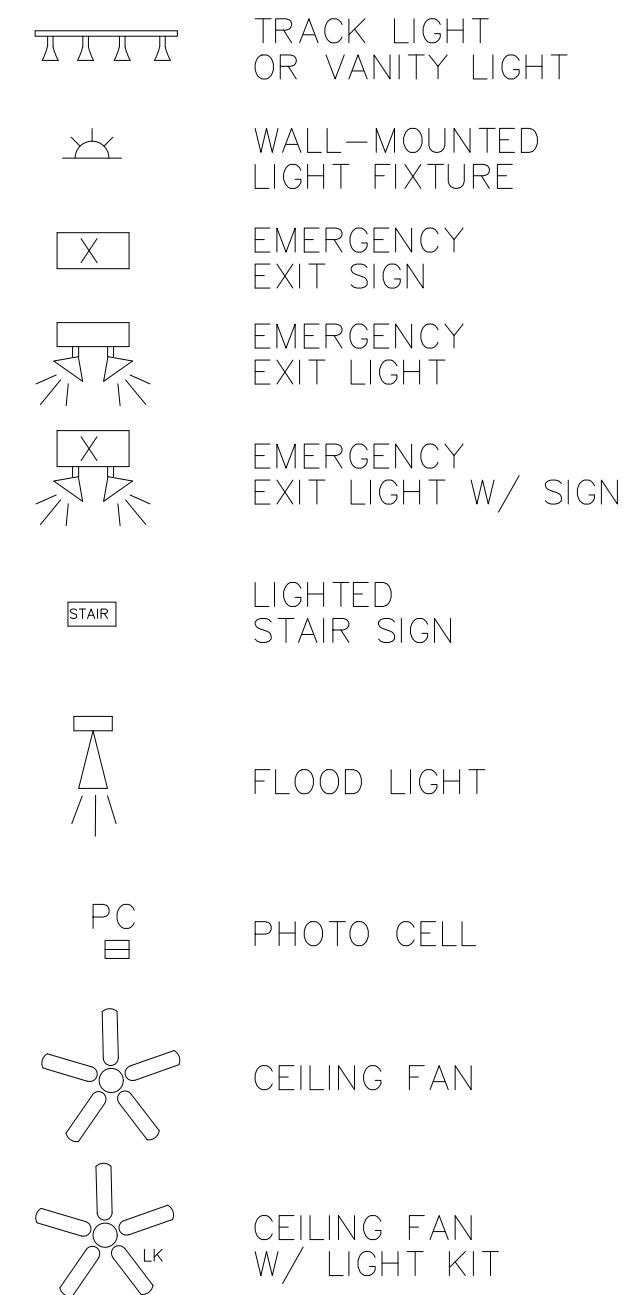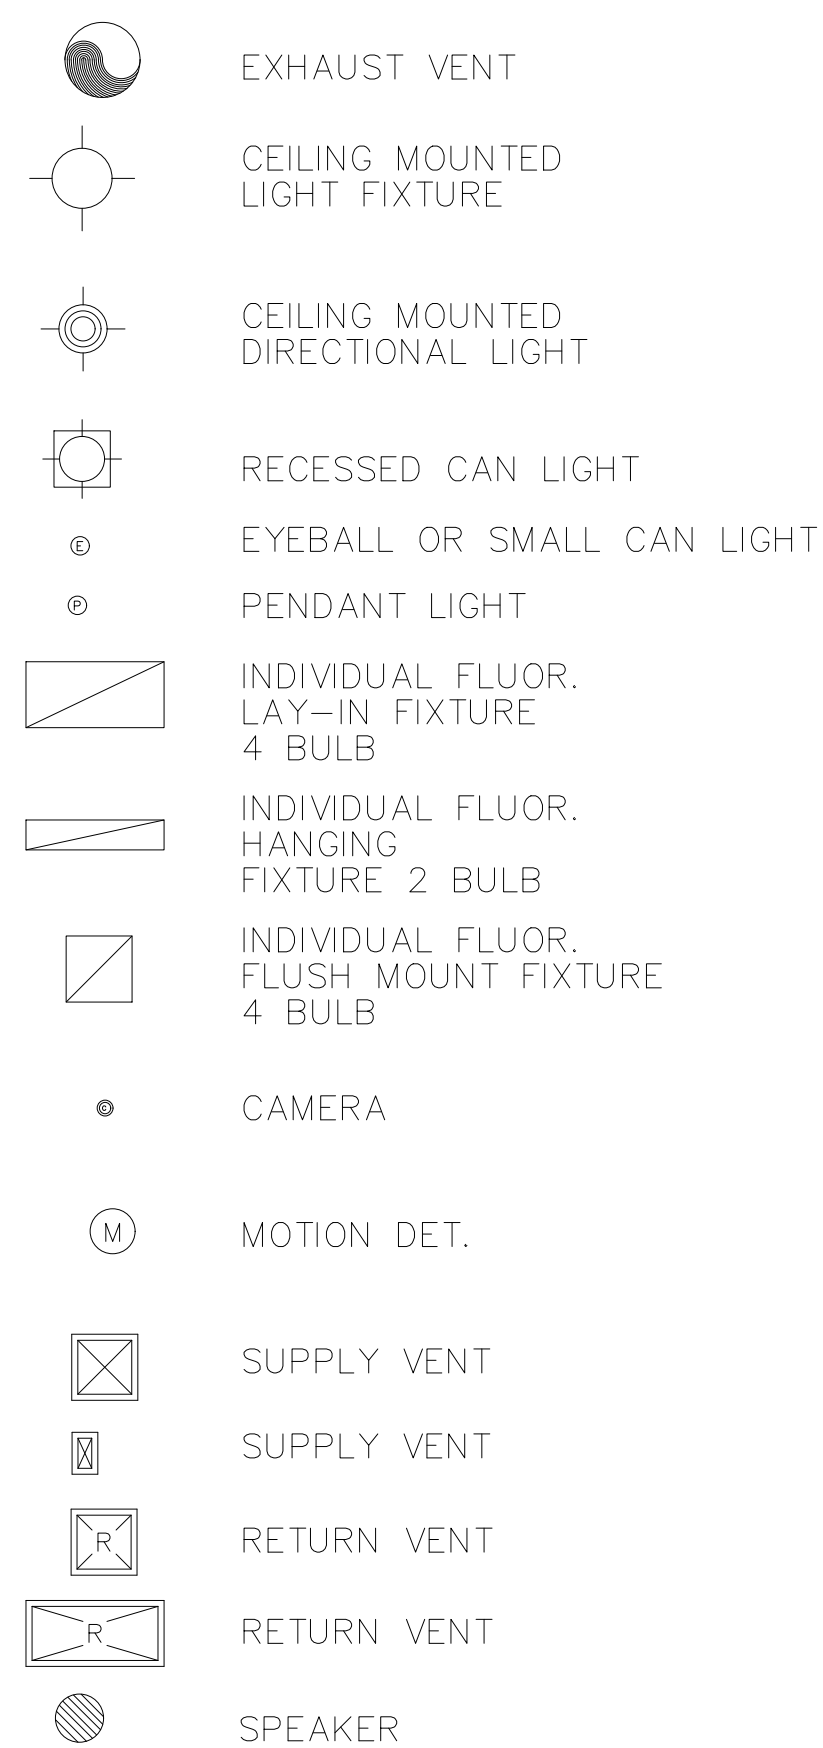


7-2-6 CEILING HEIGHT AND TRIM 7'-2"
ABOVE FLOOR BELOW WITH 6"
CROWN MOULDING. NOTE: ALL
CEILINGS NOT LABELED ARE
PLASTER. CEILINGS SHOWN WITH
A GRID ARE LAY IN ACOUSTICAL
TILE.




ELECTRIC

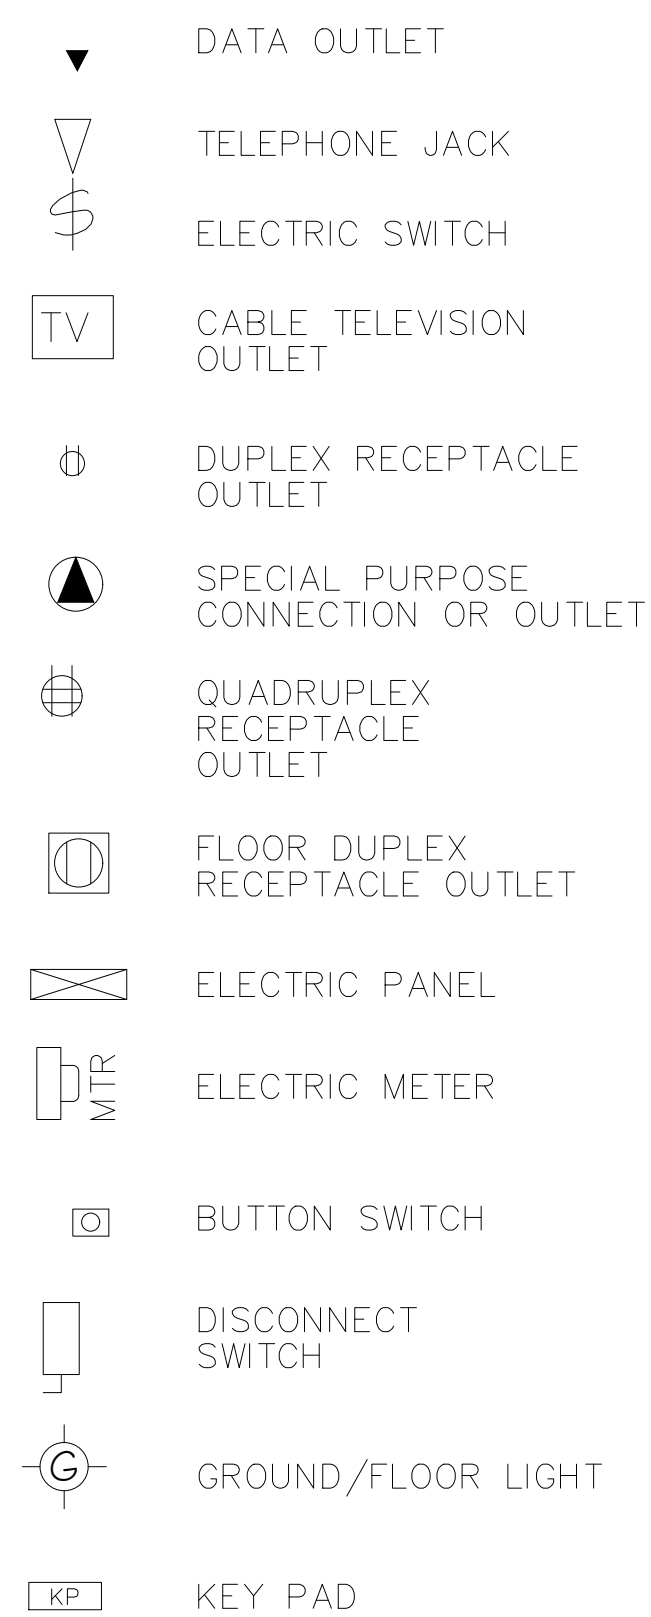



FIRE PROTECTION

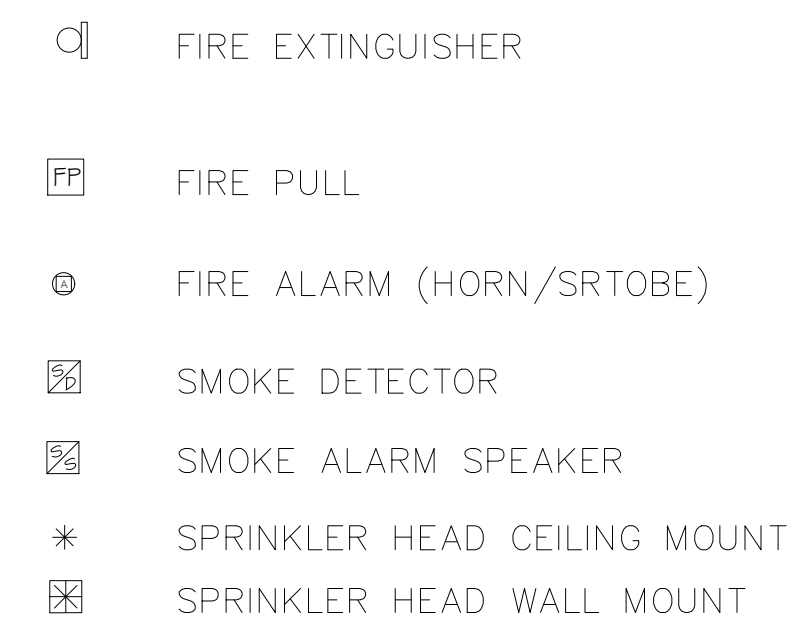


MEP

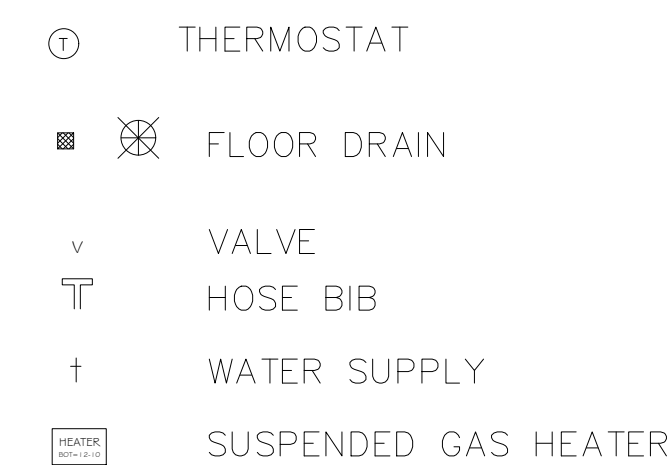


MISC

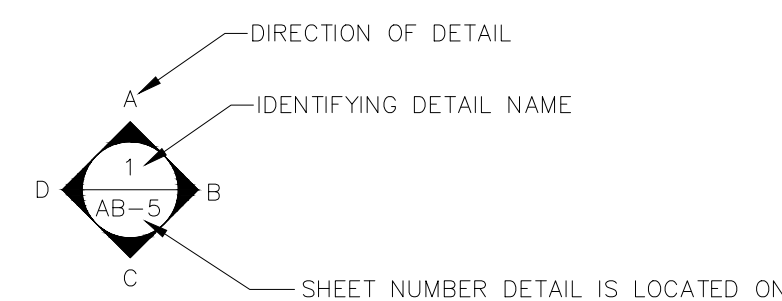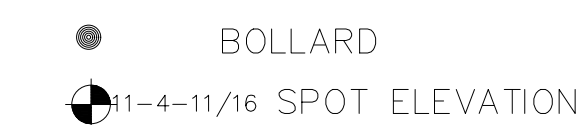

INTERIOR ELEVATIONS

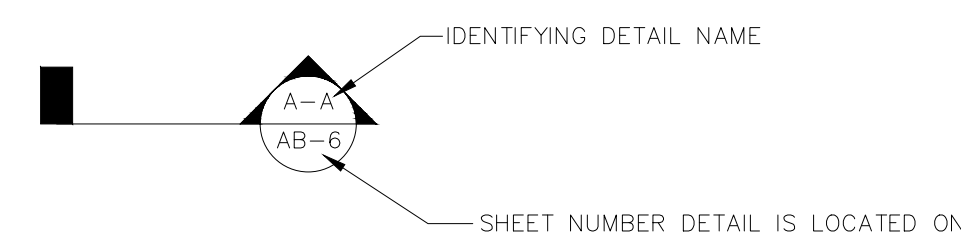

BUILDING SECTION

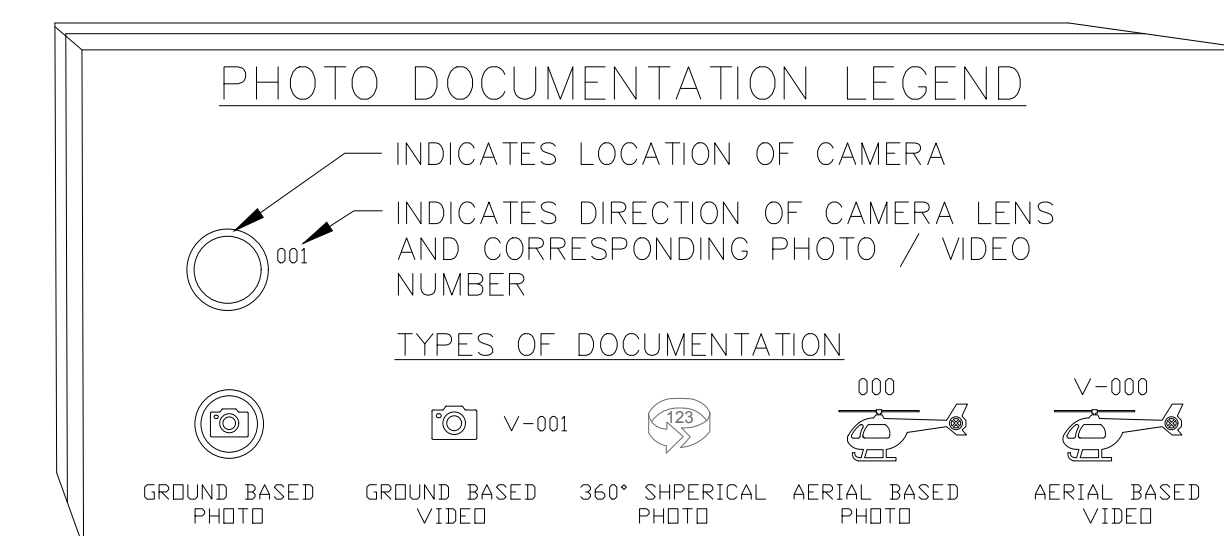


01	100% SUBMISSION	SEE COVER SHEET
IND.	ISSUES REVISIONS	DATE

SYMBOL LEGEND


HL	PROJECT MANAGER
HL	PROJECT DIRECTOR
012317-1	PROJECT NUMBER
	SCALE
CL	DRAWN BY
	SHEET NUMBER

SL

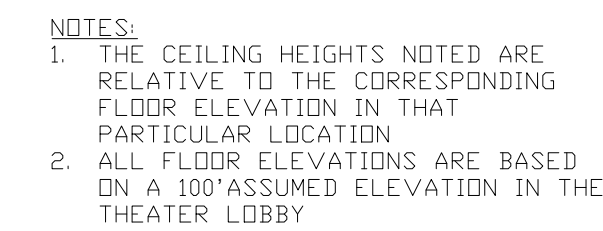

As BUILT
PROFESSIONALS

A DIVISION OF:

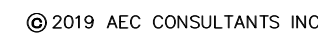


ARCHITECTURAL AS BUILT

NEW YORK, NY 10036

BASEMENT PLAN

AB-0



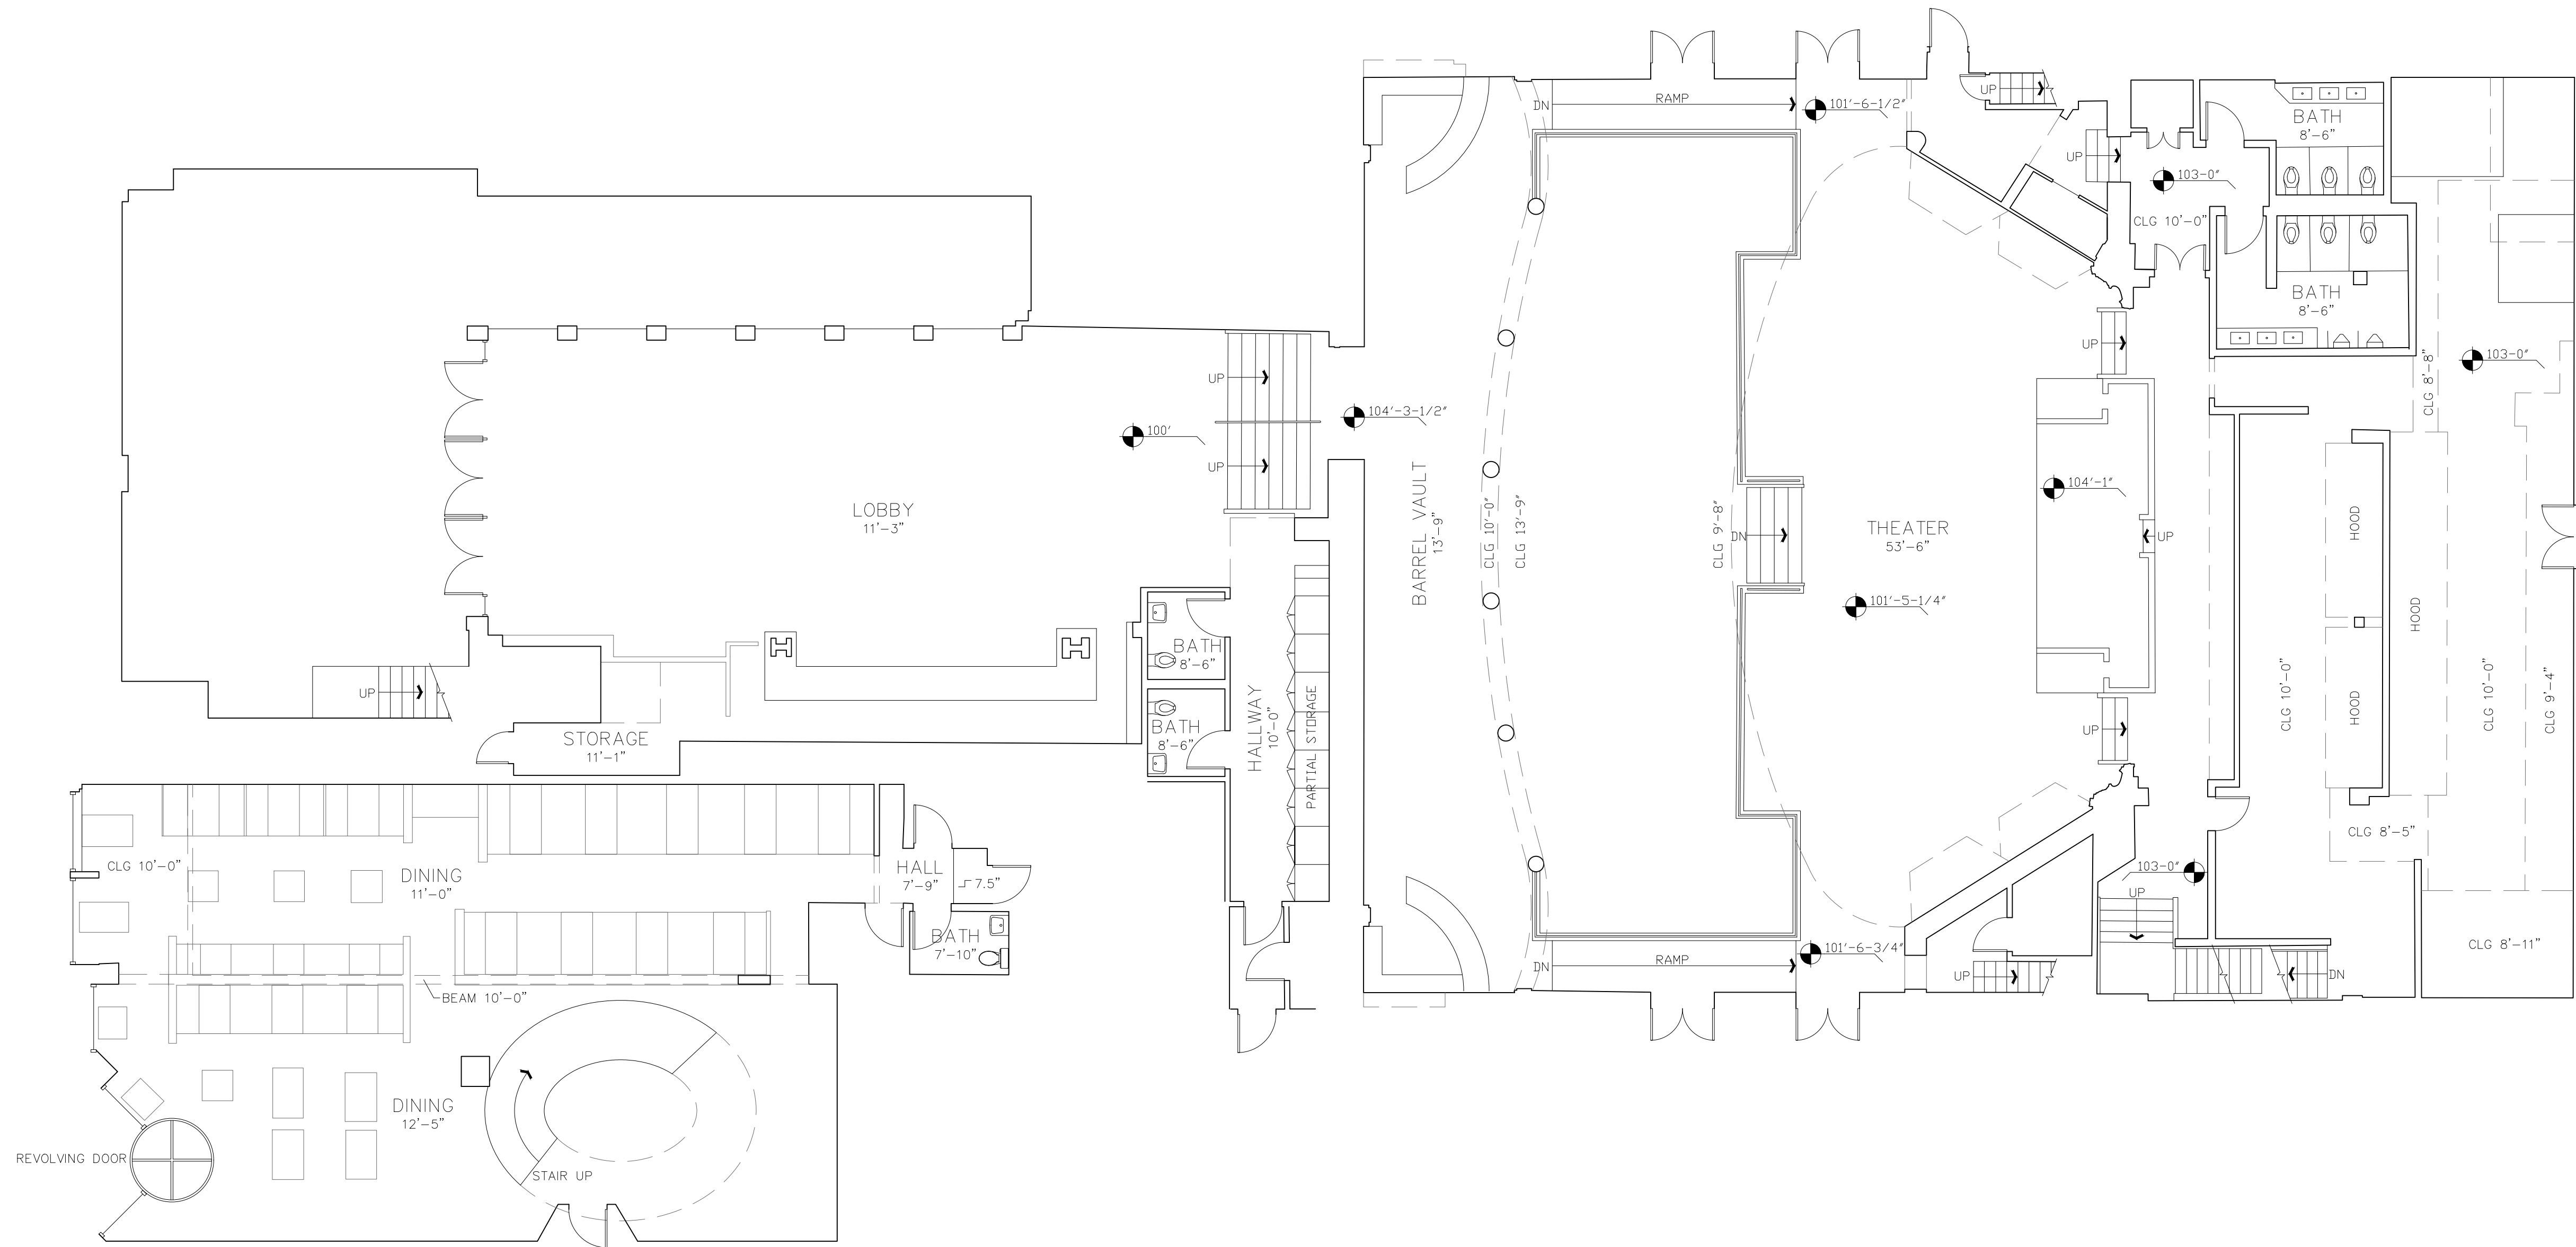

NOTES:
1. THE CEILING HEIGHTS NOTED ARE
RELATIVE TO THE CORRESPONDING
FLOOR ELEVATION IN THAT
PARTICULAR LOCATION.
2. ALL FLOOR ELEVATIONS ARE BASED
ON A 100' ASSUMED ELEVATION IN THE
THEATER LOBBY.

As BUILT

PROFESSIONALS

www.asbuiltprofessionals.com

A DIVISION OF:

AEC

CONSULTANTS INC

844.272.8458

844 A S B U I L T

© 2019 AEC CONSULTANTS INC

ARCHITECTURAL AS BUILT

NEW YORK, NY 10036

01

100% SUBMISSION

SEE COVER SHEET

NO.

ISSUES | REVISIONS

DATE

SHEET TITLE

FIRST FLOOR PLAN

HL

PROJECT MANAGER

HL

PROJECT DIRECTOR

012317-1

PROJECT NUMBER

1/8"=1'-0"

SCALE

CL

DRAWN BY

SHEET NUMBER

AB-1

NOTES:
1. THE CEILING HEIGHTS NOTED ARE
RELATIVE TO THE CORRESPONDING
FLOOR ELEVATION IN THAT
PARTICULAR LOCATION.
2. ALL FLOOR ELEVATIONS ARE BASED
ON A 100' ASSUMED ELEVATION IN THE
THEATER LOBBY.

As BUILT

PROFESSIONALS

www.asbuiltprofessionals.com

A DIVISION OF:

AEC

CONSULTANTS INC


844.272.8458

844 A S B U I L T

© 2019 AEC CONSULTANTS INC

ARCHITECTURAL AS BUILT


NEW YORK, NY 10036

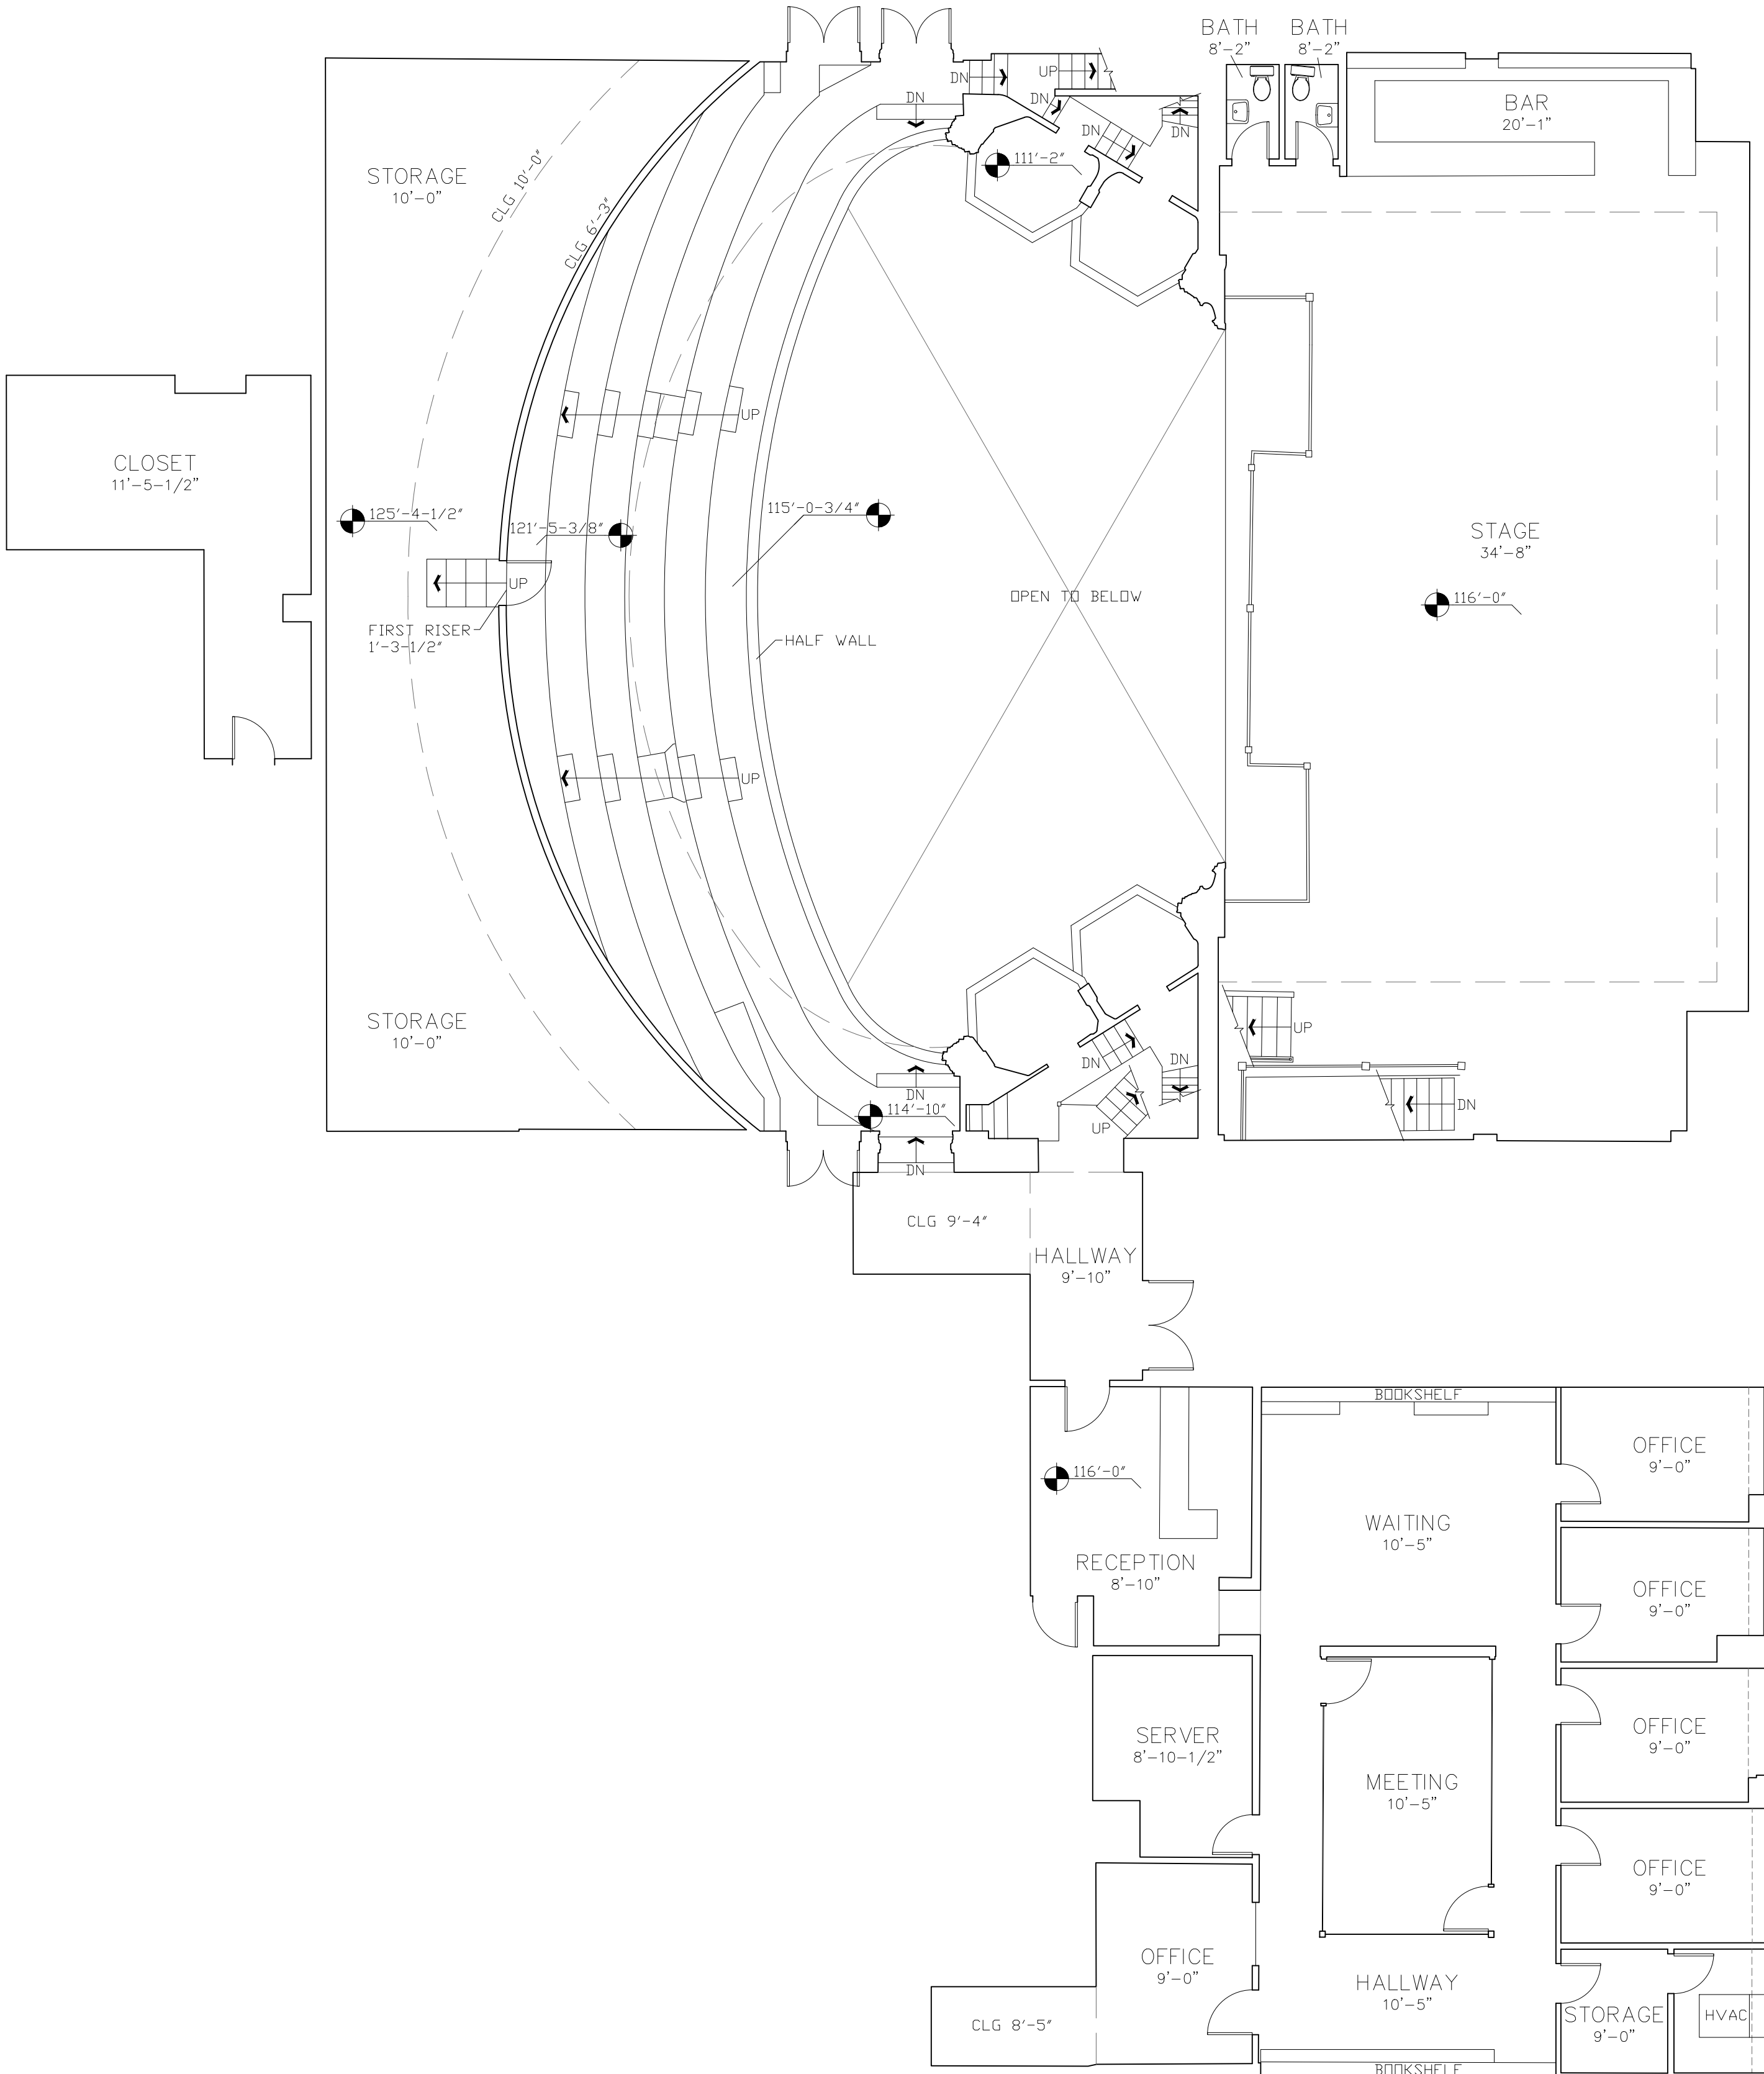

SECOND FLOOR

01	100% SUBMISSION	SEE COVER SHEET
NO.	ISSUES REVISIONS	DATE
		SHEET TITLE
SECOND FLOOR PLAN		
HL	PROJECT MANAGER	
HL	PROJECT DIRECTOR	
012317-1	PROJECT NUMBER	
1/8"=1'-0"	SCALE	
CL	DRAWN BY	
		SHEET NUMBER
AB-2		


- NOTES:
1. THE CEILING HEIGHTS NOTED ARE RELATIVE TO THE CORRESPONDING FLOOR ELEVATION IN THAT PARTICULAR LOCATION
 2. ALL FLOOR ELEVATIONS ARE BASED ON A 100' ASSUMED ELEVATION IN THE THEATER LOBBY

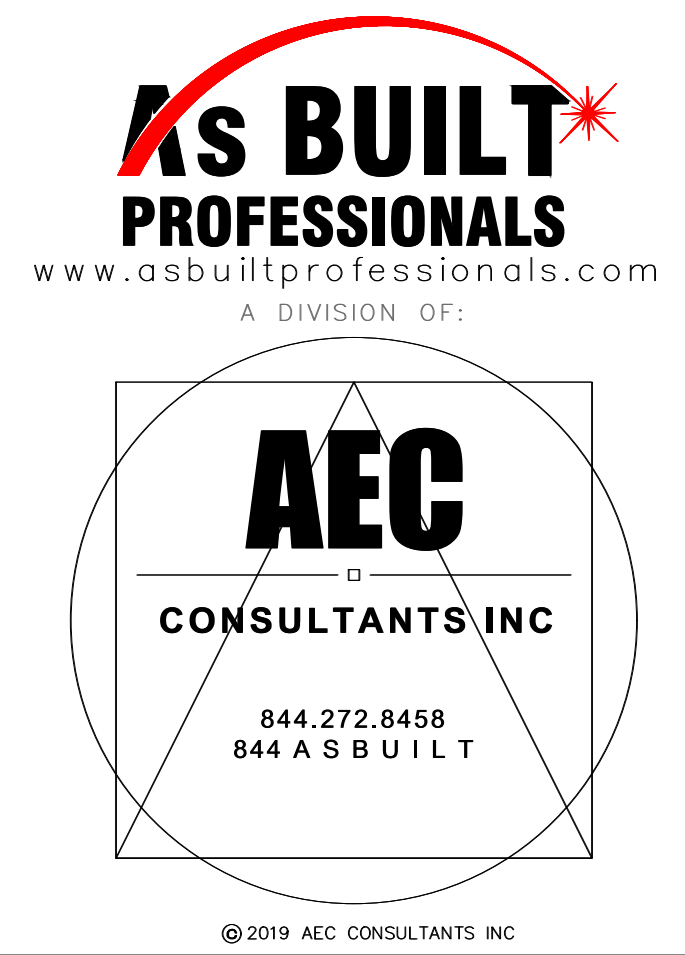

© 2019 AEC CONSULTANTS INC

ARCHITECTURAL AS BUILT

NEW YORK, NY 10036

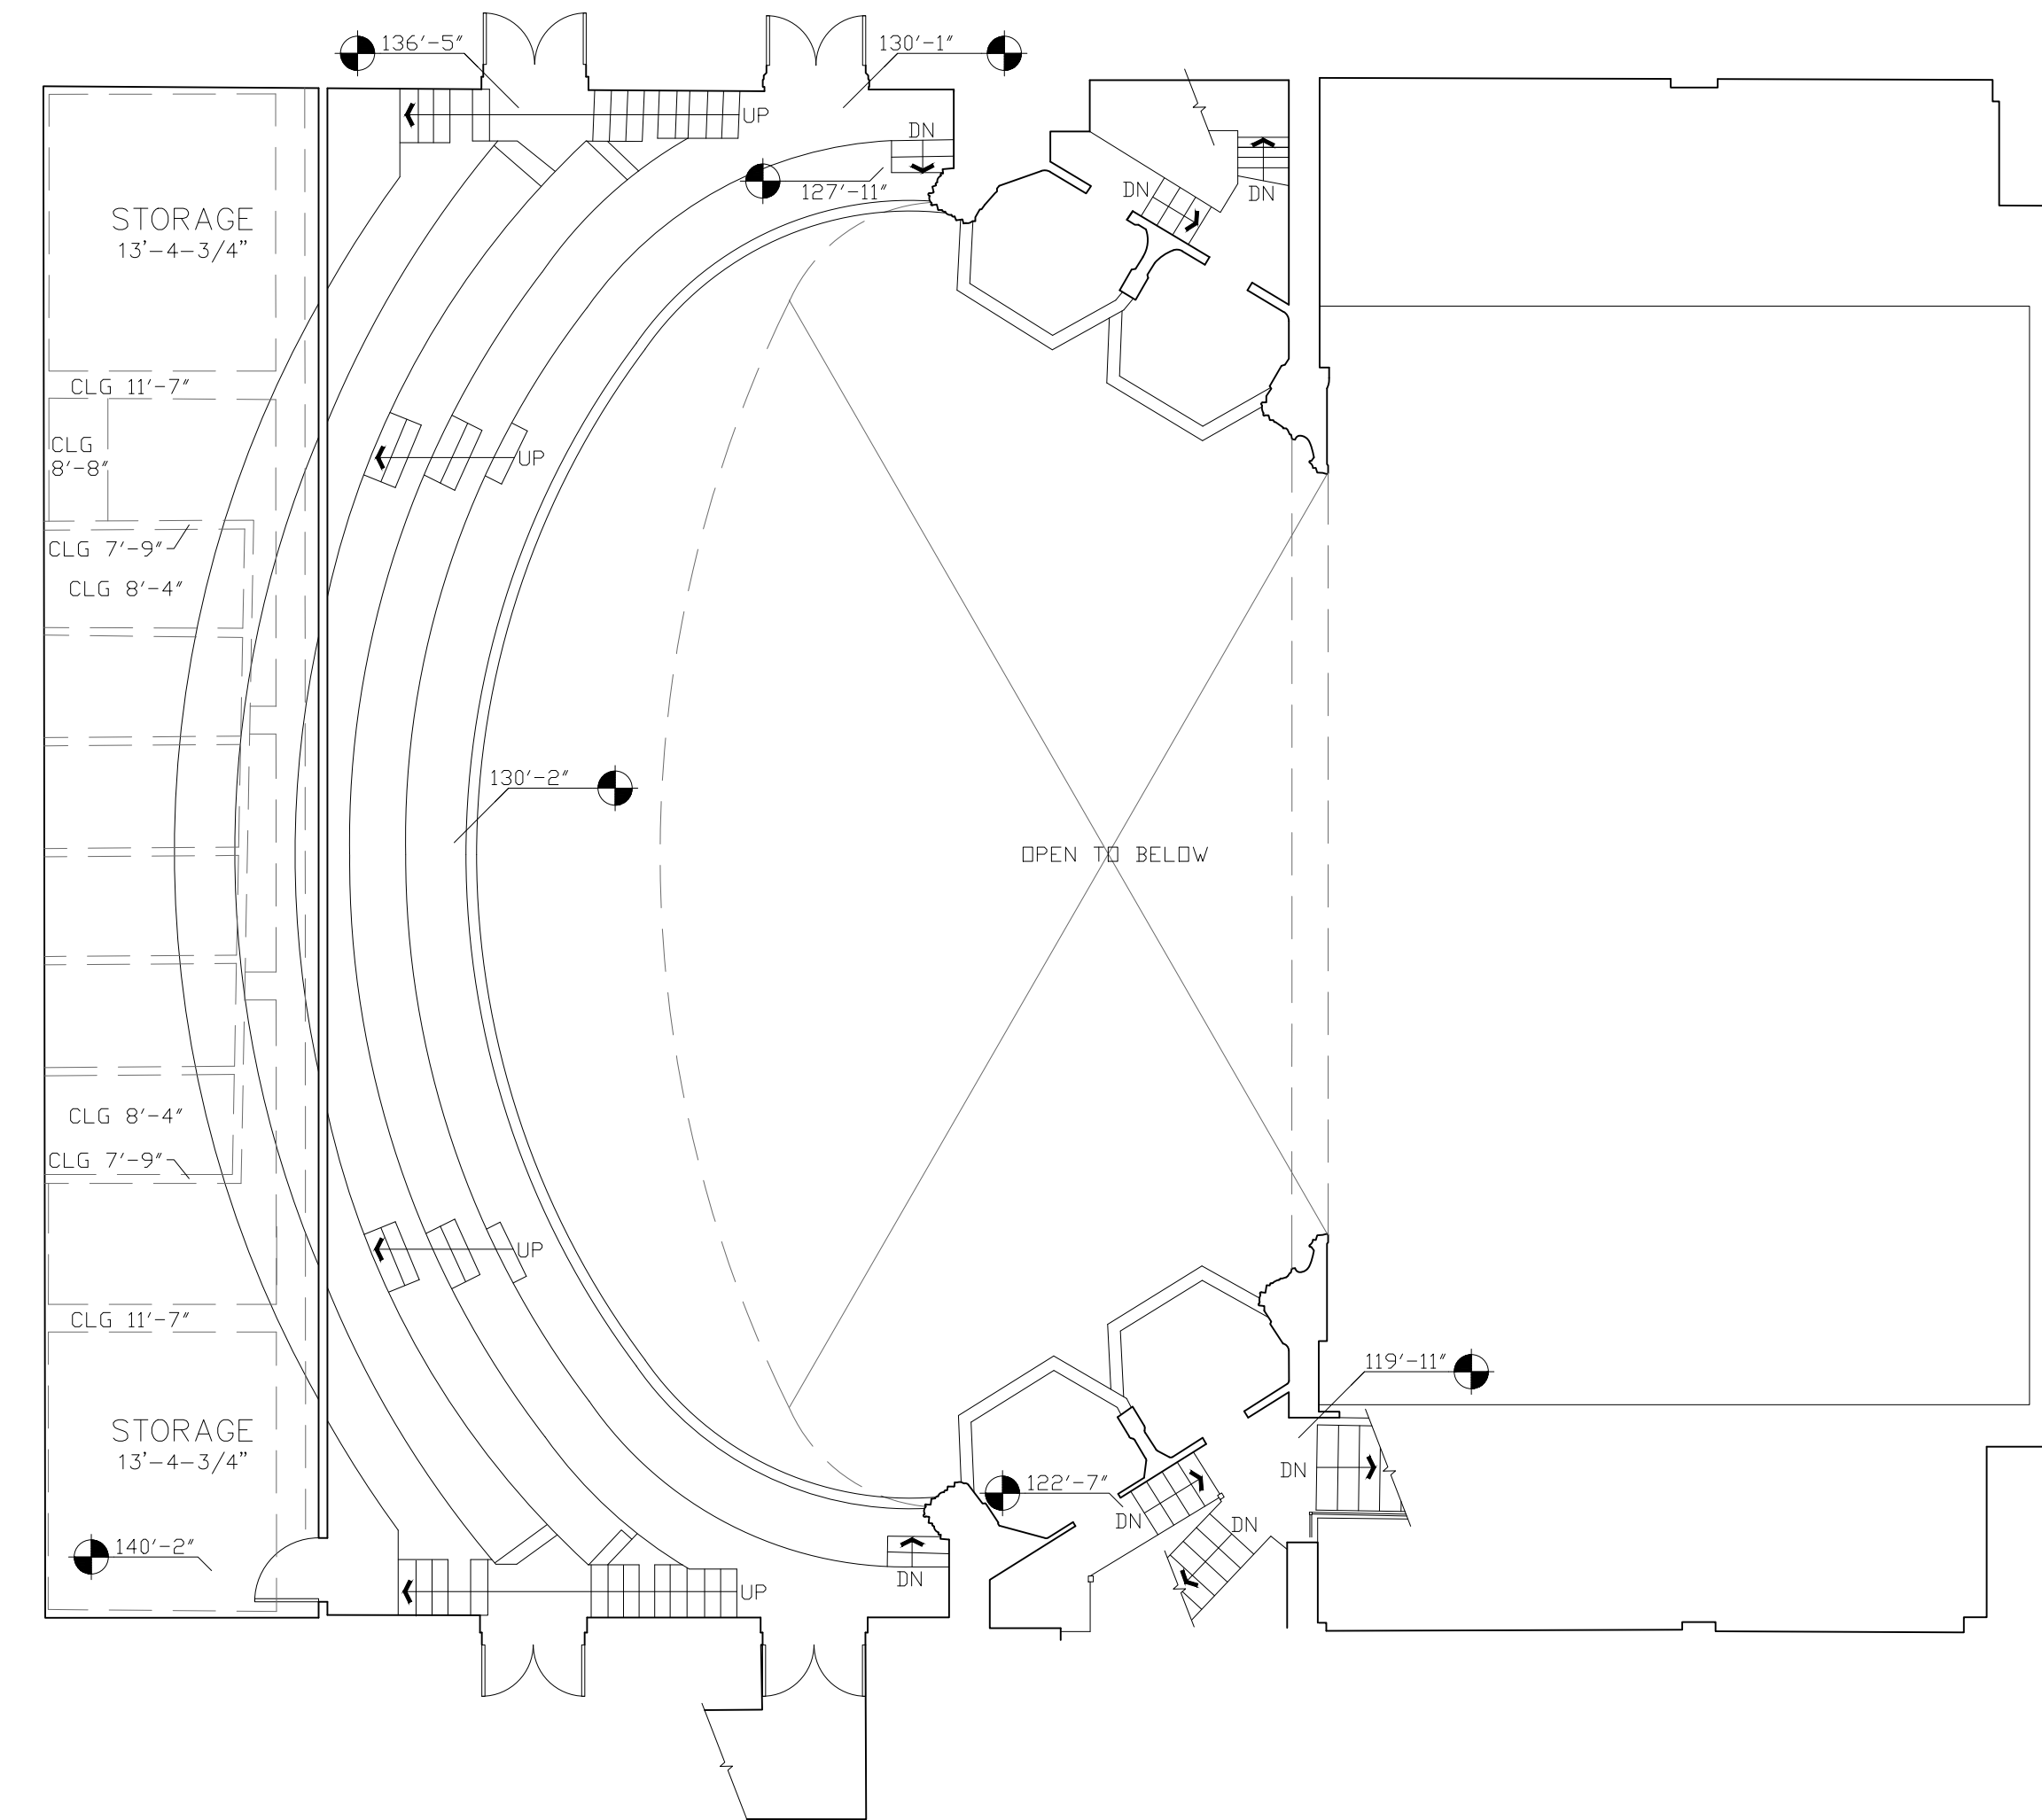 **THIRD FLOOR**

THIRD FLOOR PLAN

HL	PROJECT MANAGER
----	-----------------

HL	PROJECT DIRECTOR
----	------------------

012317-1	PROJECT NUMBER
----------	----------------

1/8"=1'-0" SCALE

CL	DRAWN BY
----	----------

SHEET NUMBER

AB-3