


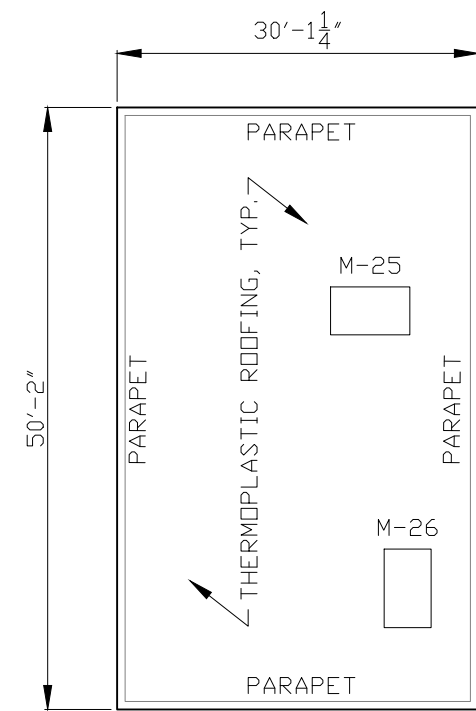


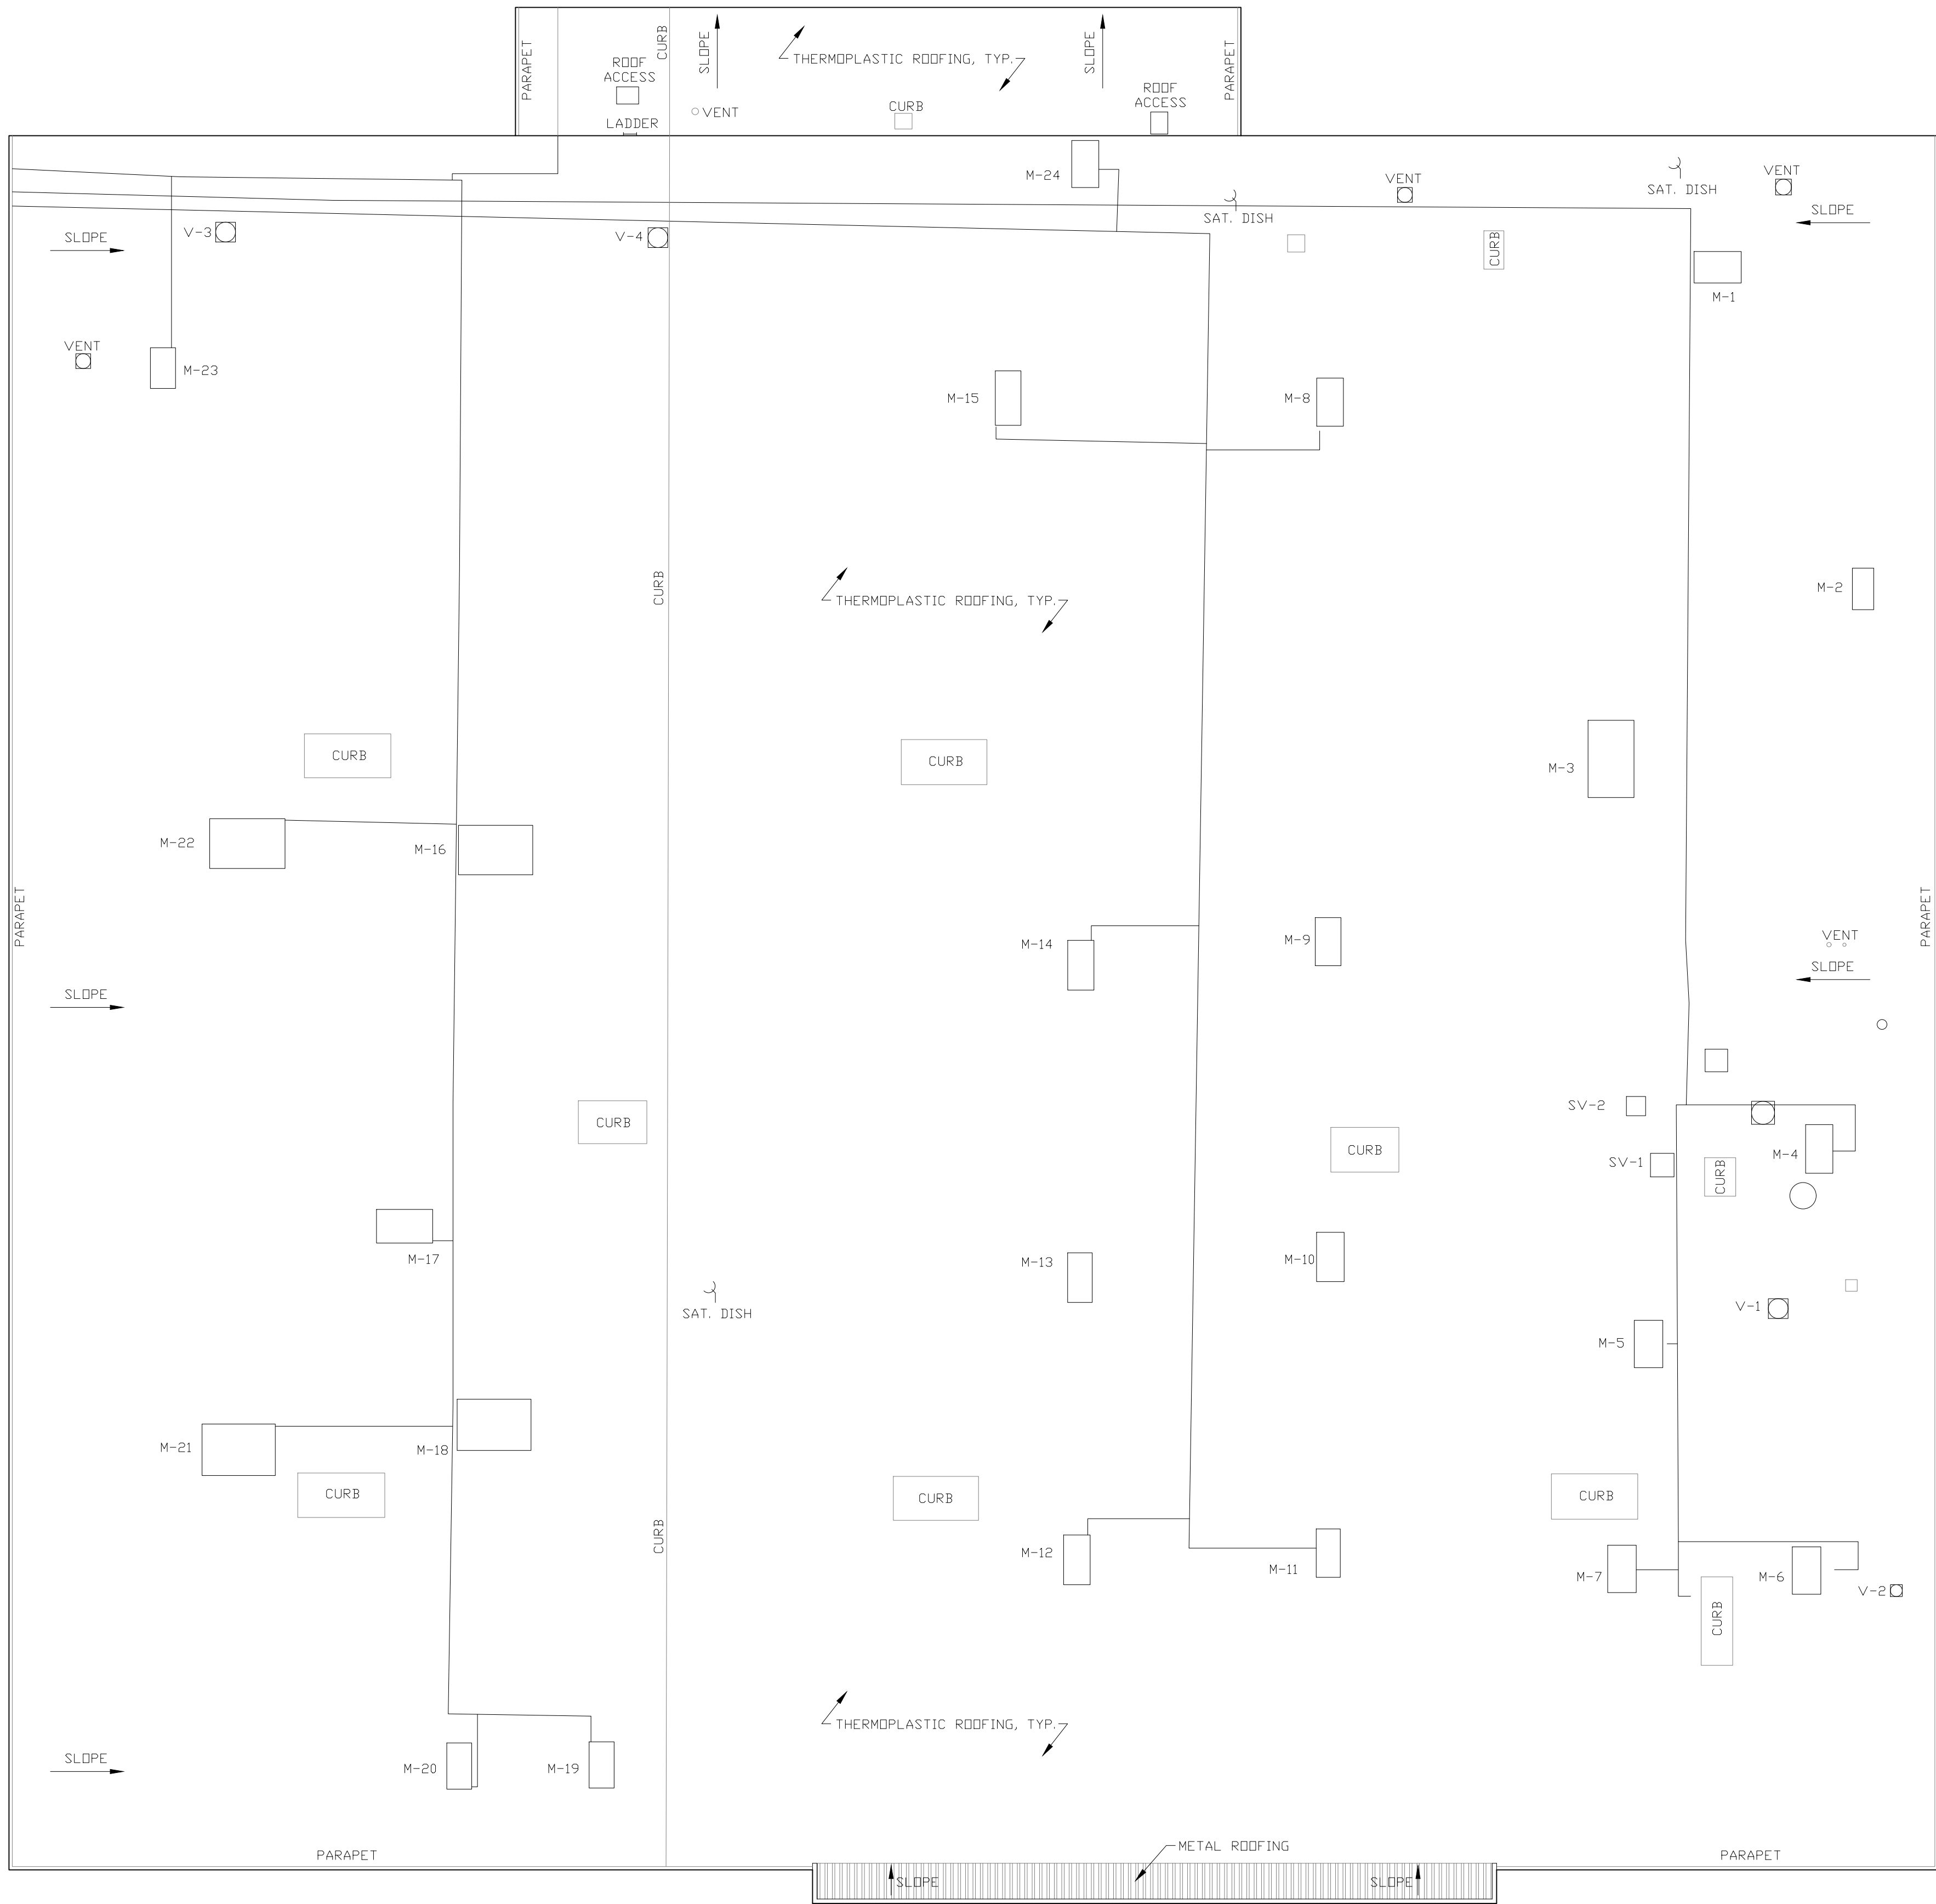

ACCESSORY BUILDING

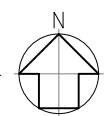

ROOF PLAN

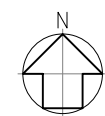

As BUILT

PROFESSIONALS

www.asbuiltprofessionals.com

A DIVISION OF:

AEC

CONSULTANTS INC

844.272.8458





844 A S B U I L T

© 2019 AEC CONSULTANTS INC

ARCHITECTURAL AS BUILT

Hixson, TN 37343

01	100% SUBMISSION	SEE COVER SHEET
NO.	ISSUES REVISIONS	DATE
		SHEET TITLE
ROOF PLAN		
HL	PROJECT MANAGER	
HL	PROJECT DIRECTOR	
012317-1	PROJECT NUMBER	
1/16"=1'-0"	SCALE	
CL	DRAWN BY	
		SHEET NUMBER
AB-3		

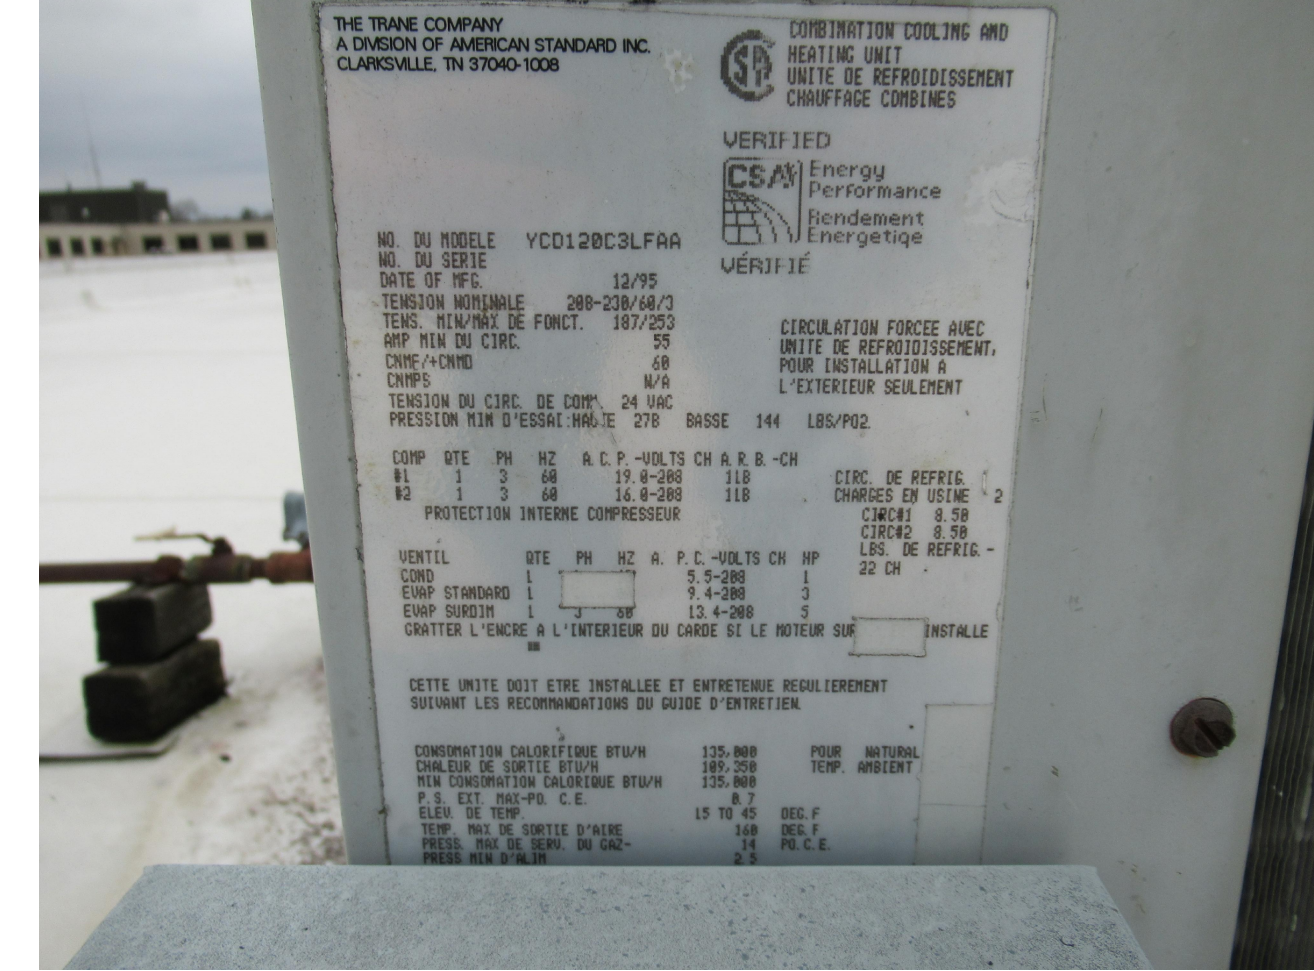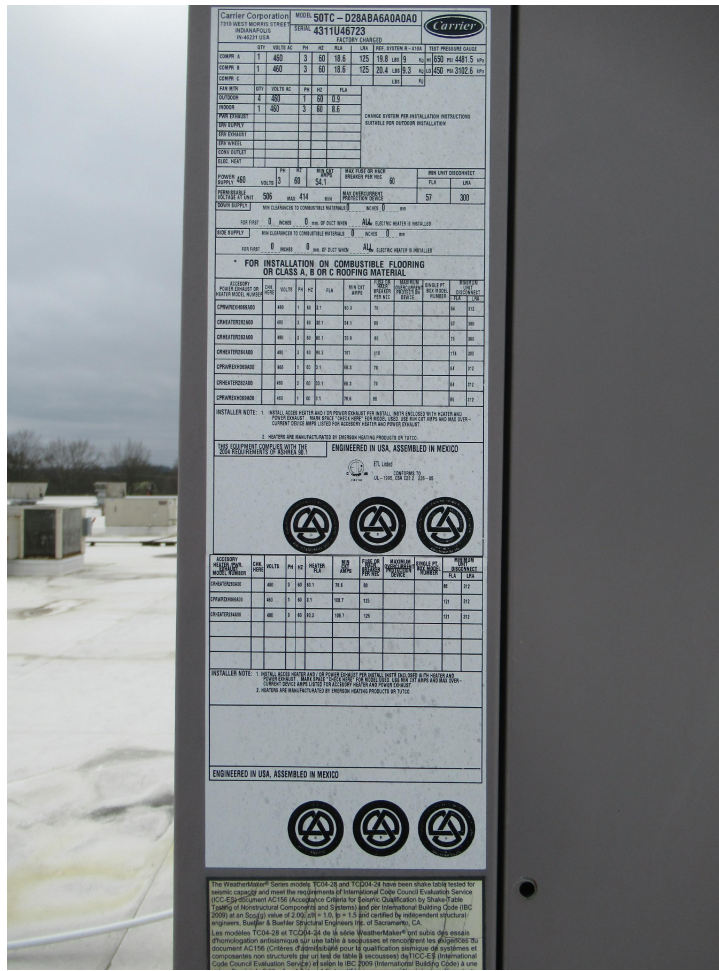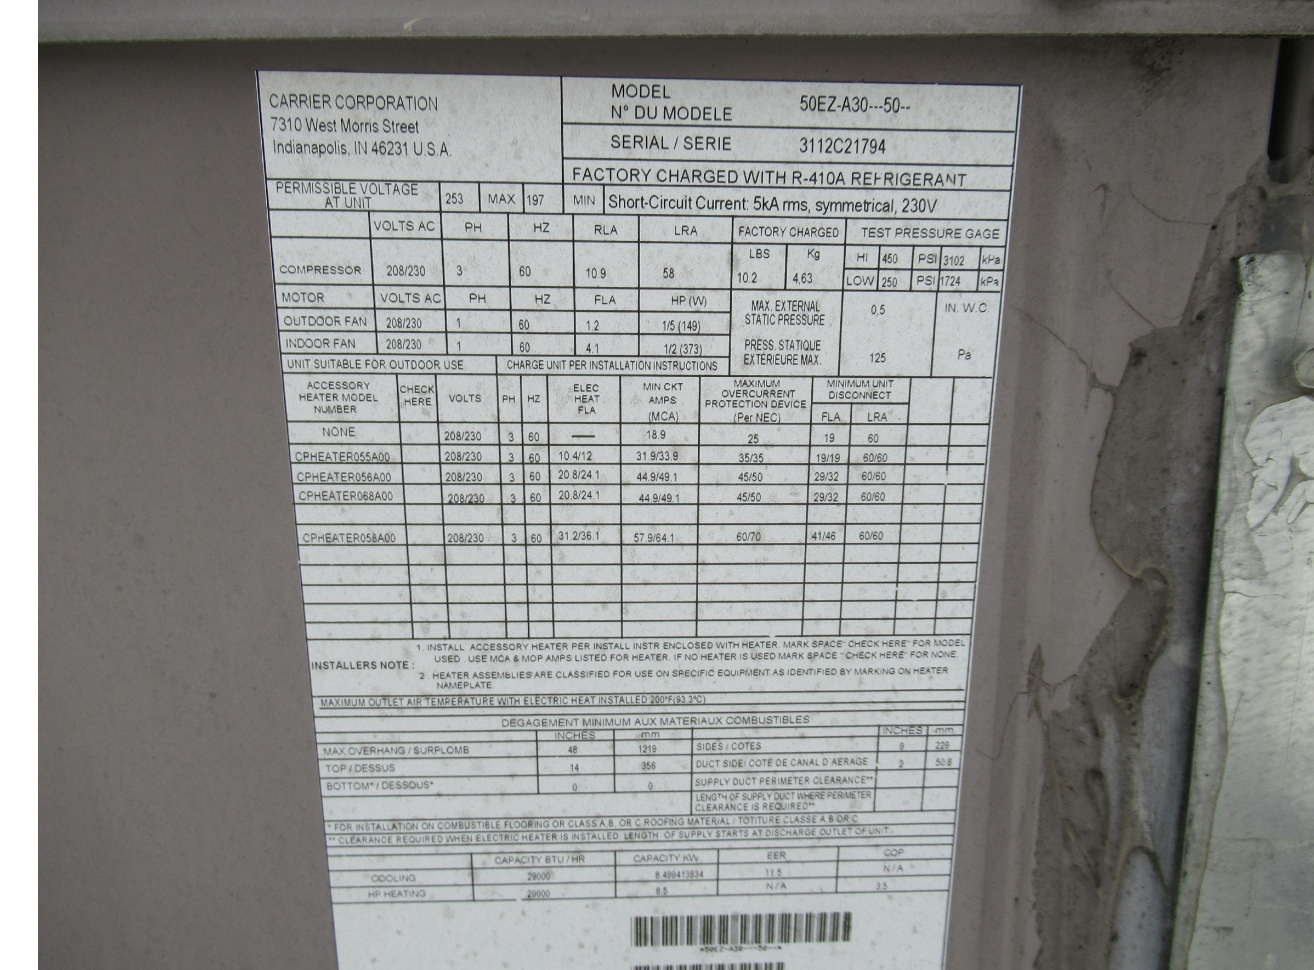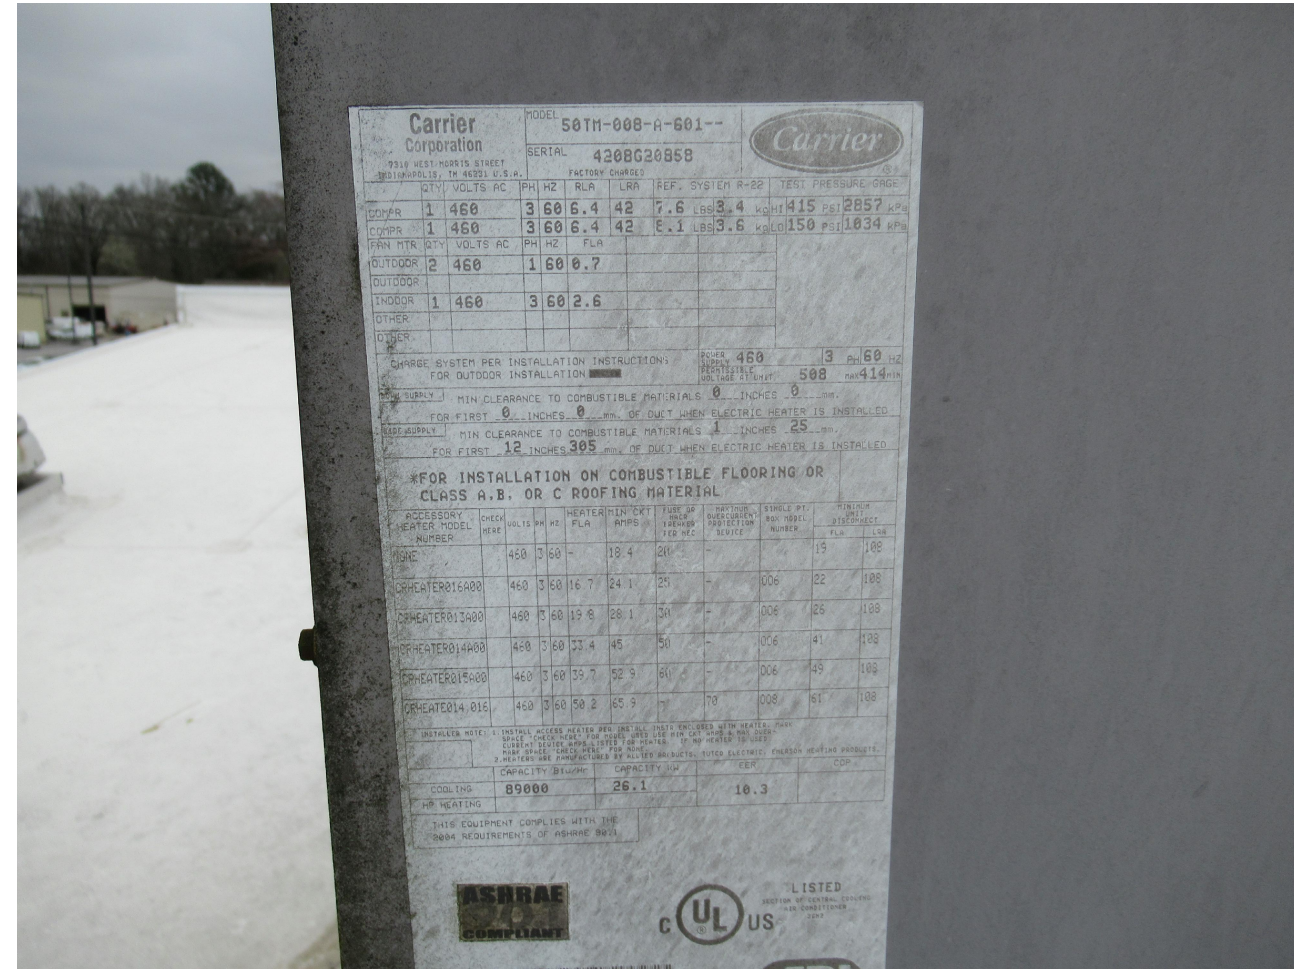

ARCHITECTURAL AS BUILT

Hixson, TN 37343

01	100% SUBMISSION	SEE COVER SHEET
NO.	ISSUES REVISIONS	DATE
		SHEET TITLE
ROOF PLAN		
HL	PROJECT MANAGER	
HL	PROJECT DIRECTOR	
012317-1	PROJECT NUMBER	
1/16"=1'-0"		SCALE
CL	DRAWN BY	
		SHEET NUMBER
AB-4		