

AS-BUILT DOCUMENTATION

(CBI) Aspire

Mesa AZ 85204



 **VICINITY MAP**
NTS

AREA DATA	
LIVING BASEMENT	0 S.F. ±
LIVING FIRST FLOOR	4340 S.F. ±
LIVING SECOND FLOOR	0 S.F. ±
SECOND FLOOR STORAGE	0 S.F. ±
SCREEN ROOM	0 S.F. ±
DECKS	0 S.F. ±
GARAGE	0 S.F. ±
ENTRY	0 S.F. ±
TOTAL LIVING	0 S.F. ±
GRAND TOTAL	4340 S.F. ±

DRAWING INDEX

- C-1 COVER SHEET | DRAWING INDEX
- AB-1 FLOOR PLAN



© 2017 AEC CONSULTANTS INC.

**ARCHITECTURAL AS BUILT
(CBI) ASPIRE**

Mesa, AZ 85204


01	100% SUBMISSION	SEE COVER SHEET
NO.	ISSUES REVISIONS	DATE

COVER SHEET

HL	PROJECT MANAGER
HL	PROJECT DIRECTOR
XXXX	PROJECT NUMBER
	SCALE
BLM	DRAWN BY
	SHEET NUMBER

C-1

100% SUBMITTAL

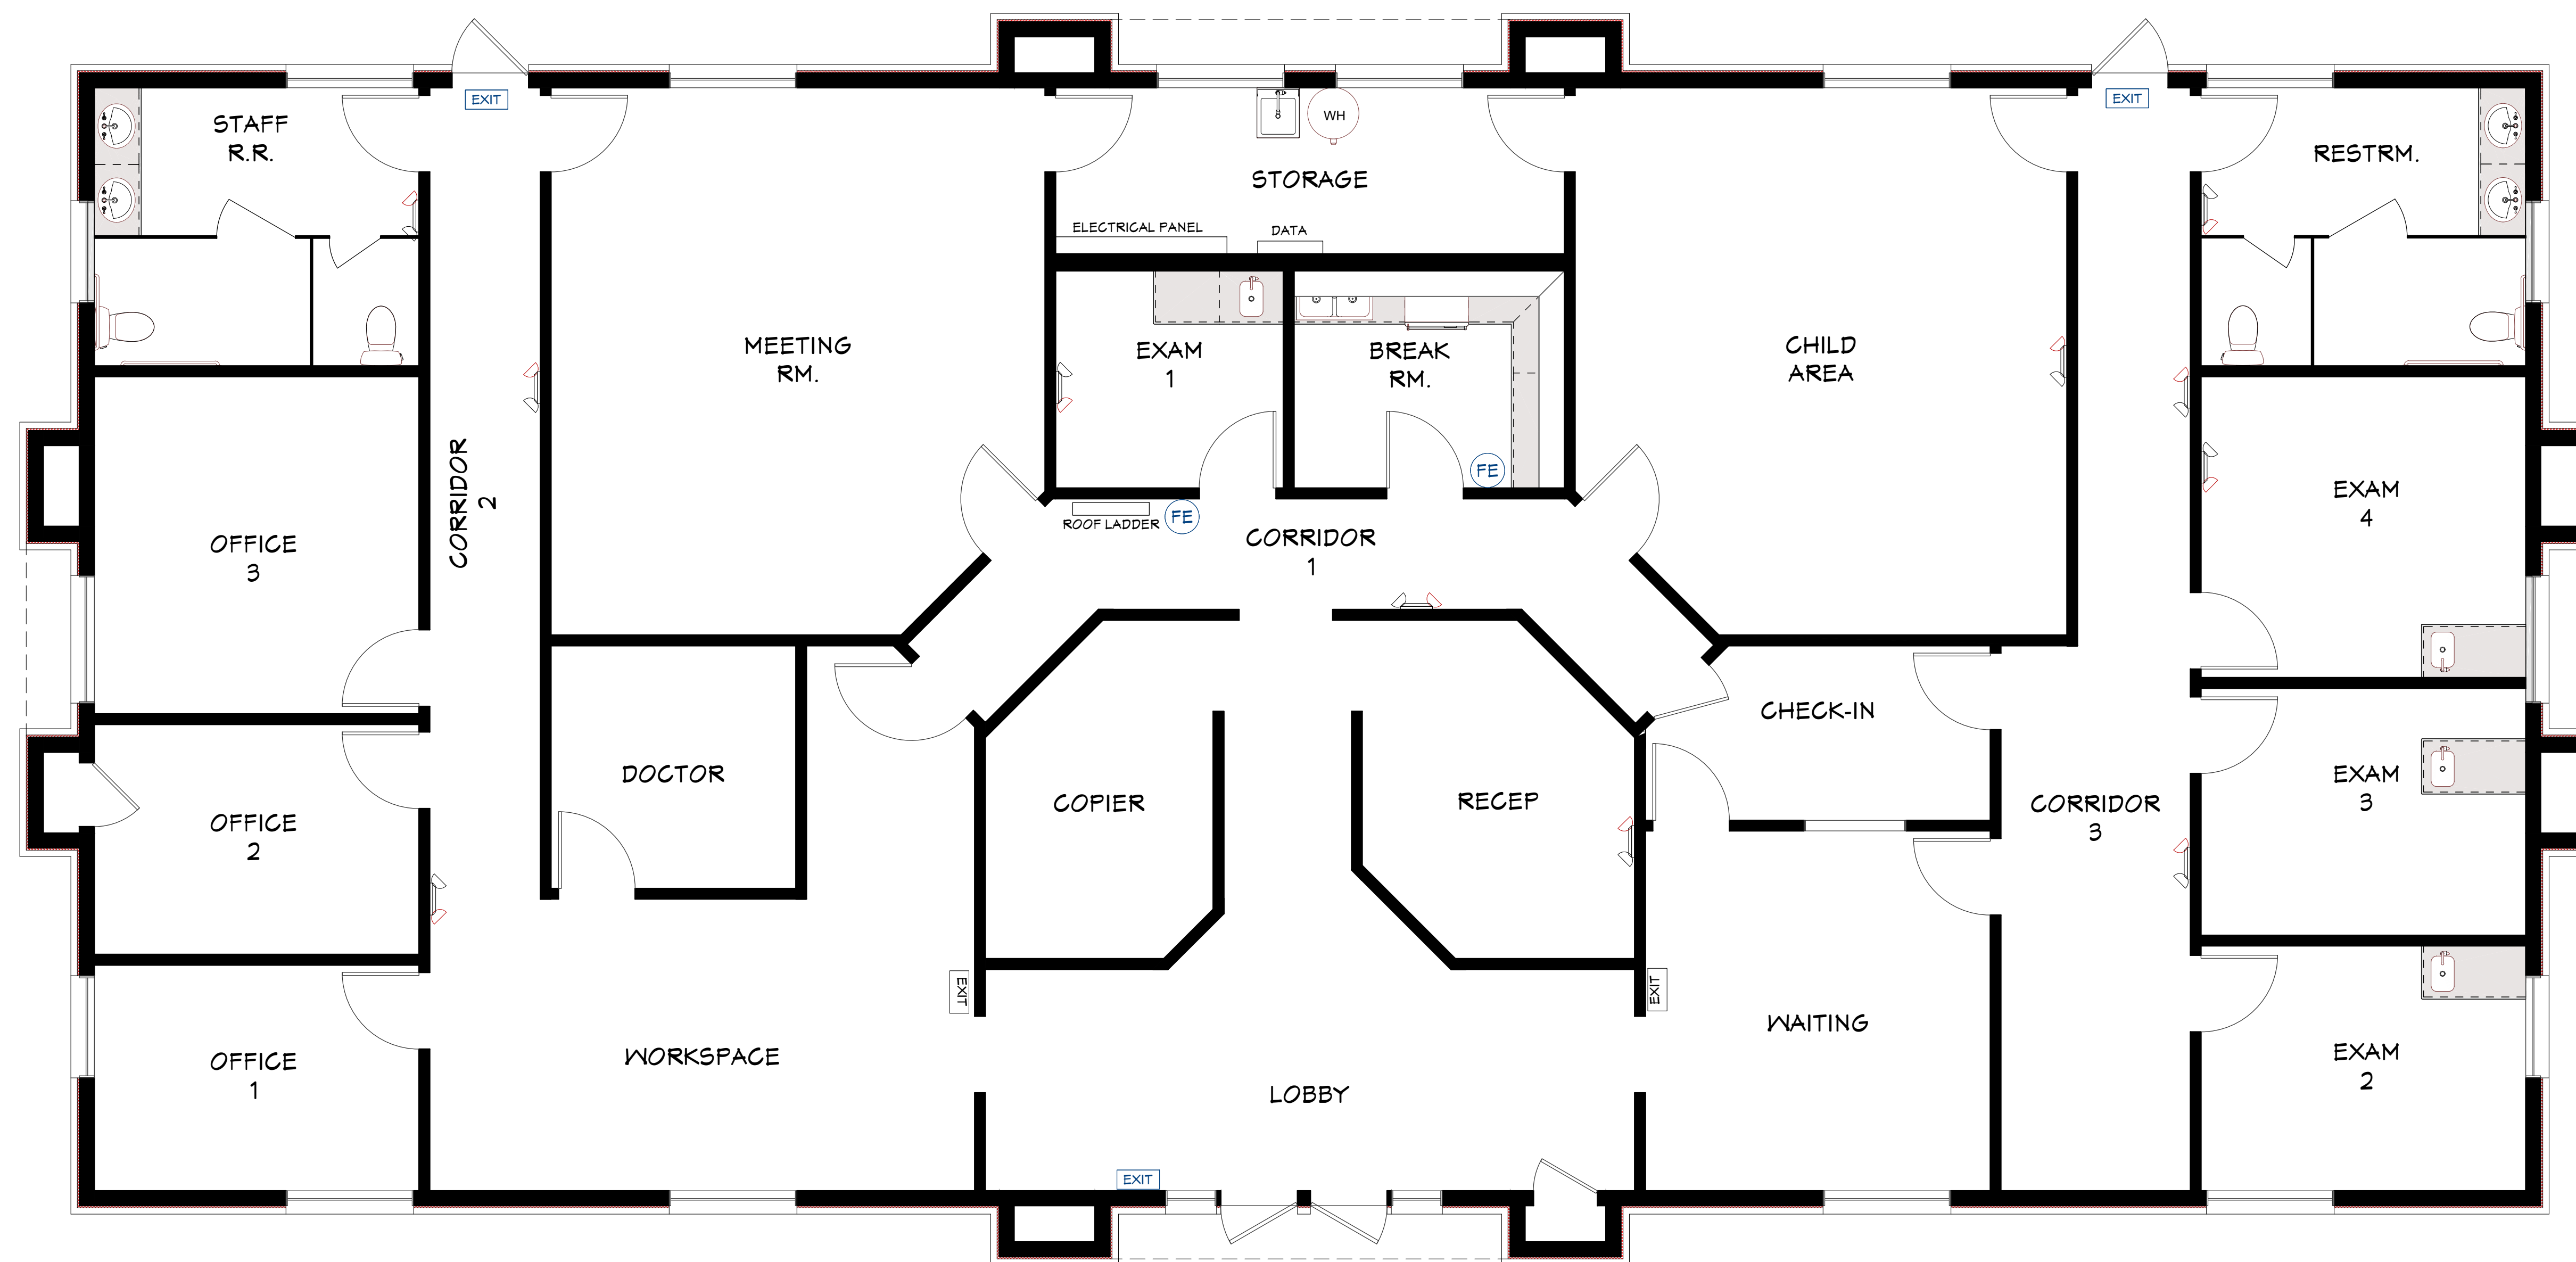

BUILDING
 AREA
 4340 SF

**ARCHITECTURAL AS BUILT
 (CBI) ASPIRE**

Mesa, AZ 85204

01 100% SUBMISSION SEE COVER SHEET

NO. ISSUES | REVISIONS DATE

SHEET TITLE

HL PROJECT MANAGER

HL PROJECT DIRECTOR

XXXX PROJECT NUMBER

1/4"=1'-0" SCALE

BLM DRAWN BY

SHEET NUMBER

AB-1