


AS-BUILT DOCUMENTATION

DRAWING INDEX

- C-1 COVER SHEET | DRAWING INDEX
- AB-1 FIRST AND SECOND FLOOR PLAN
- AB-2 EXTERIOR ELEVATIONS

CHARLOTTE, NC 28208

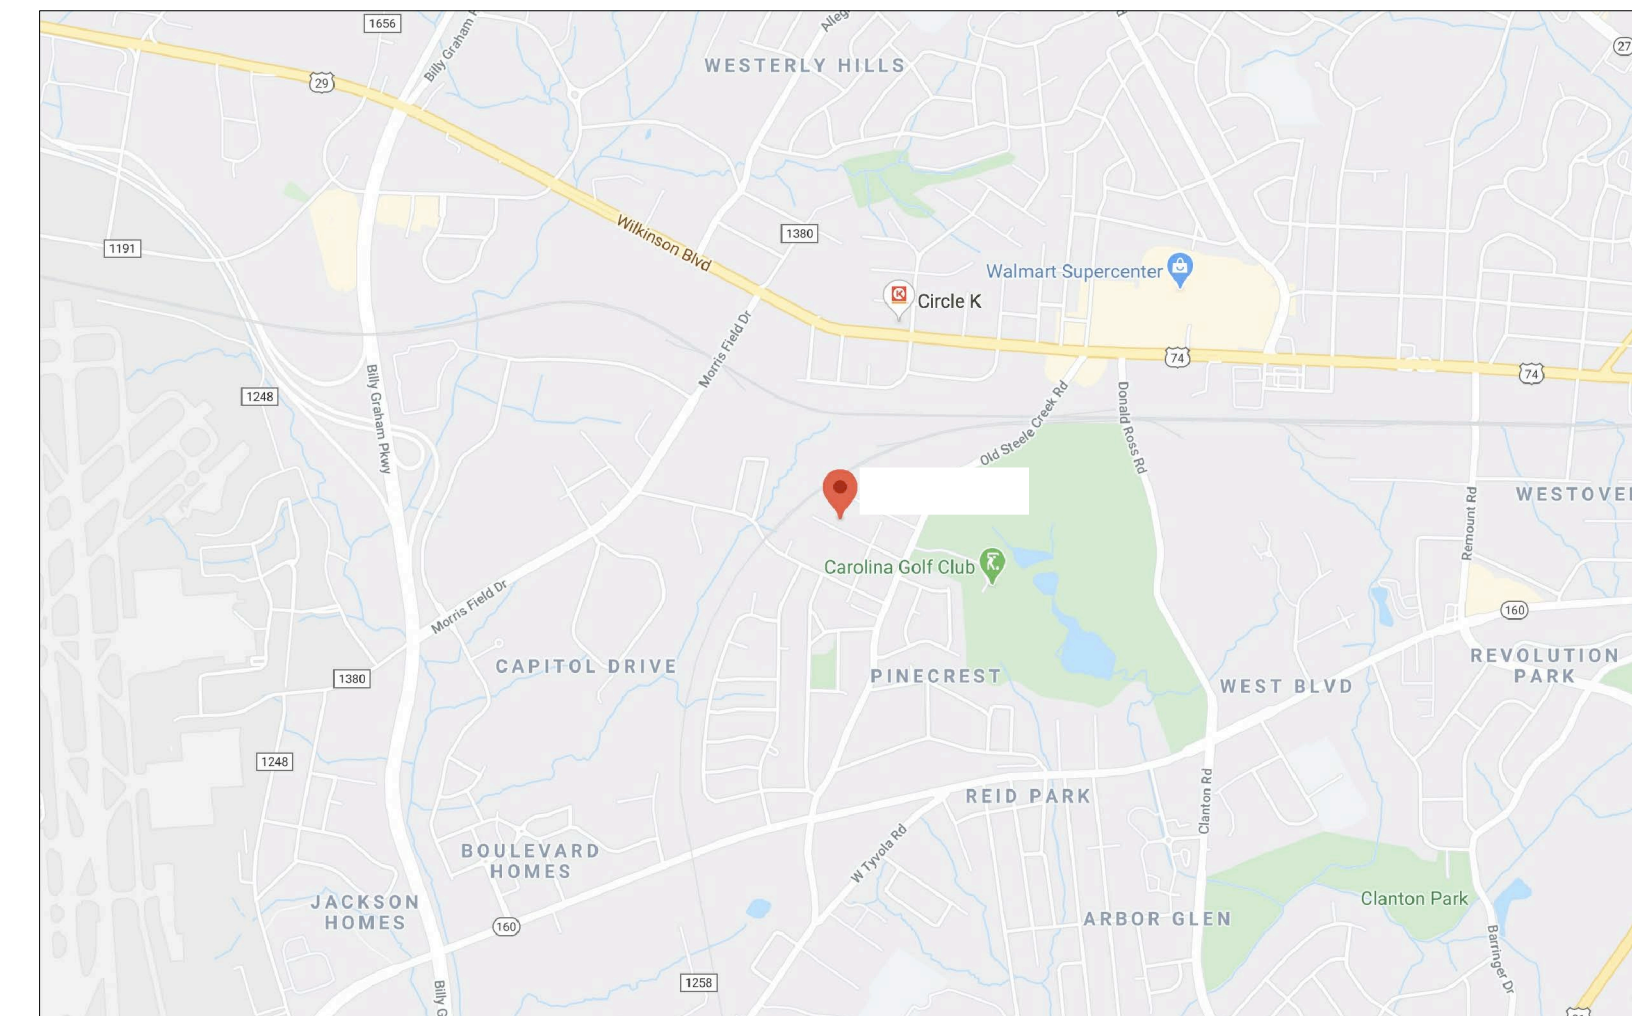

VICINITY MAP
NTS

AREA DATA	
FIRST FLOOR	1,679 S.F. ±
SECOND FLOOR	1,829 S.F. ±
GRAND TOTAL	3,508 S.F. ±

100% SUBMITTAL



© 2020 AEC CONSULTANTS INC

ARCHITECTURAL AS BUILT
MULTI FAMILY RESIDENTIAL


CHARLOTTE, NC 28208

NO.	ISSUES REVISIONS	DATE
01	100% SUBMISSION	SEE COVER SHEET

COVER SHEET


HL	PROJECT MANAGER
HL	PROJECT DIRECTOR
012317-1	PROJECT NUMBER
	SCALE
CB	DRAWN BY
	SHEET NUMBER

C-1

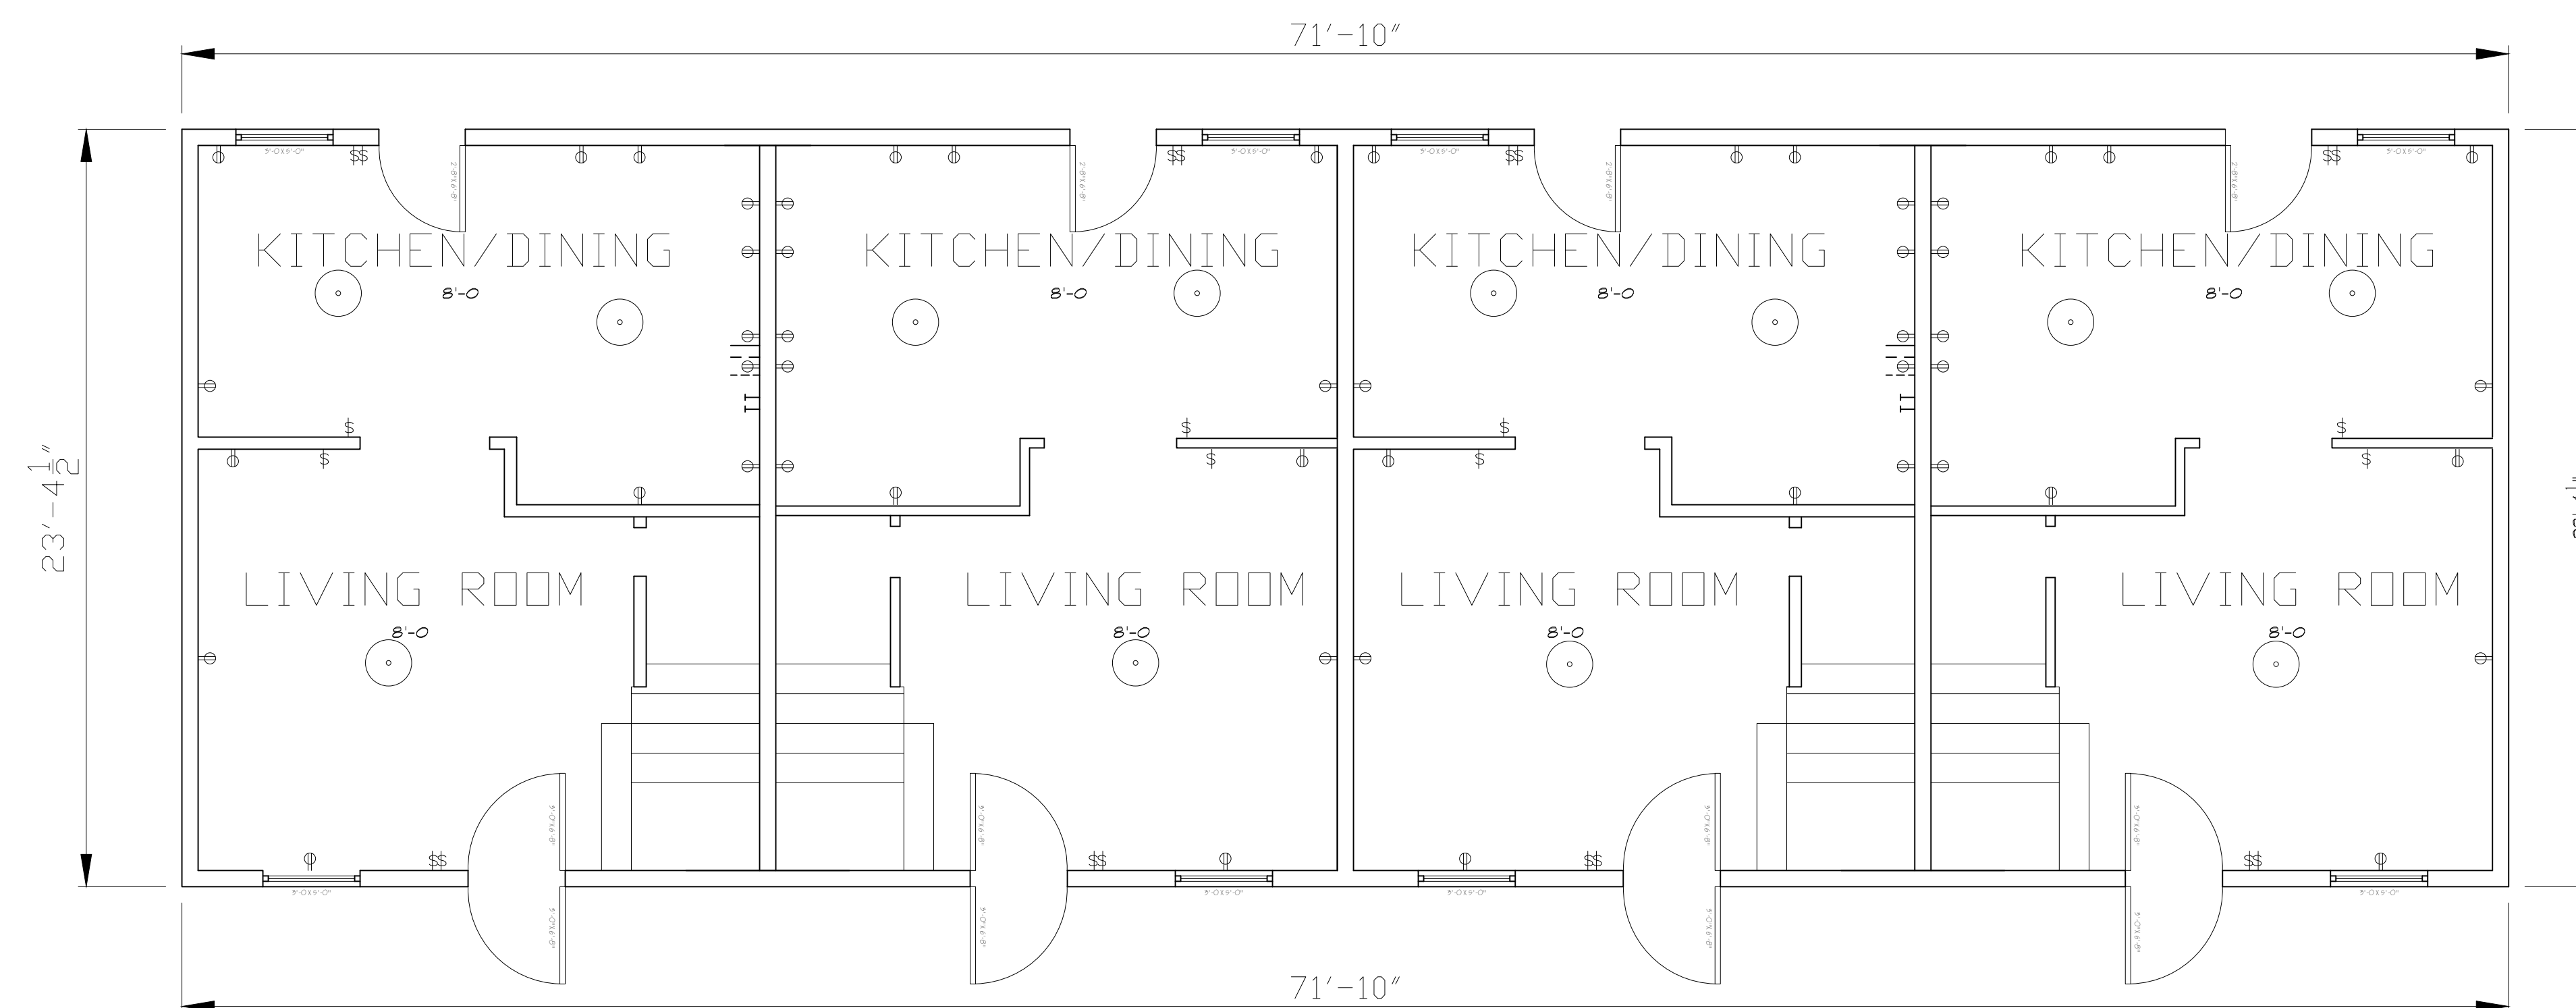

- LEGEND:
- ⊕ LIGHTING CONNECTION (NO FIXTURE)
 - ⊕ DUPLEX AC OUTLET
 - PENDANT LIGHT
 - ⌘ SWITCH
 - ✱ CEILING FAN
 - HOT WATER
 - COLD WATER
 - DRAIN PIPE
 - ⌘ H/C WASHER HOOKUP
 - WALL MOUNTED FIXTURE

FIRST FLOOR PLAN

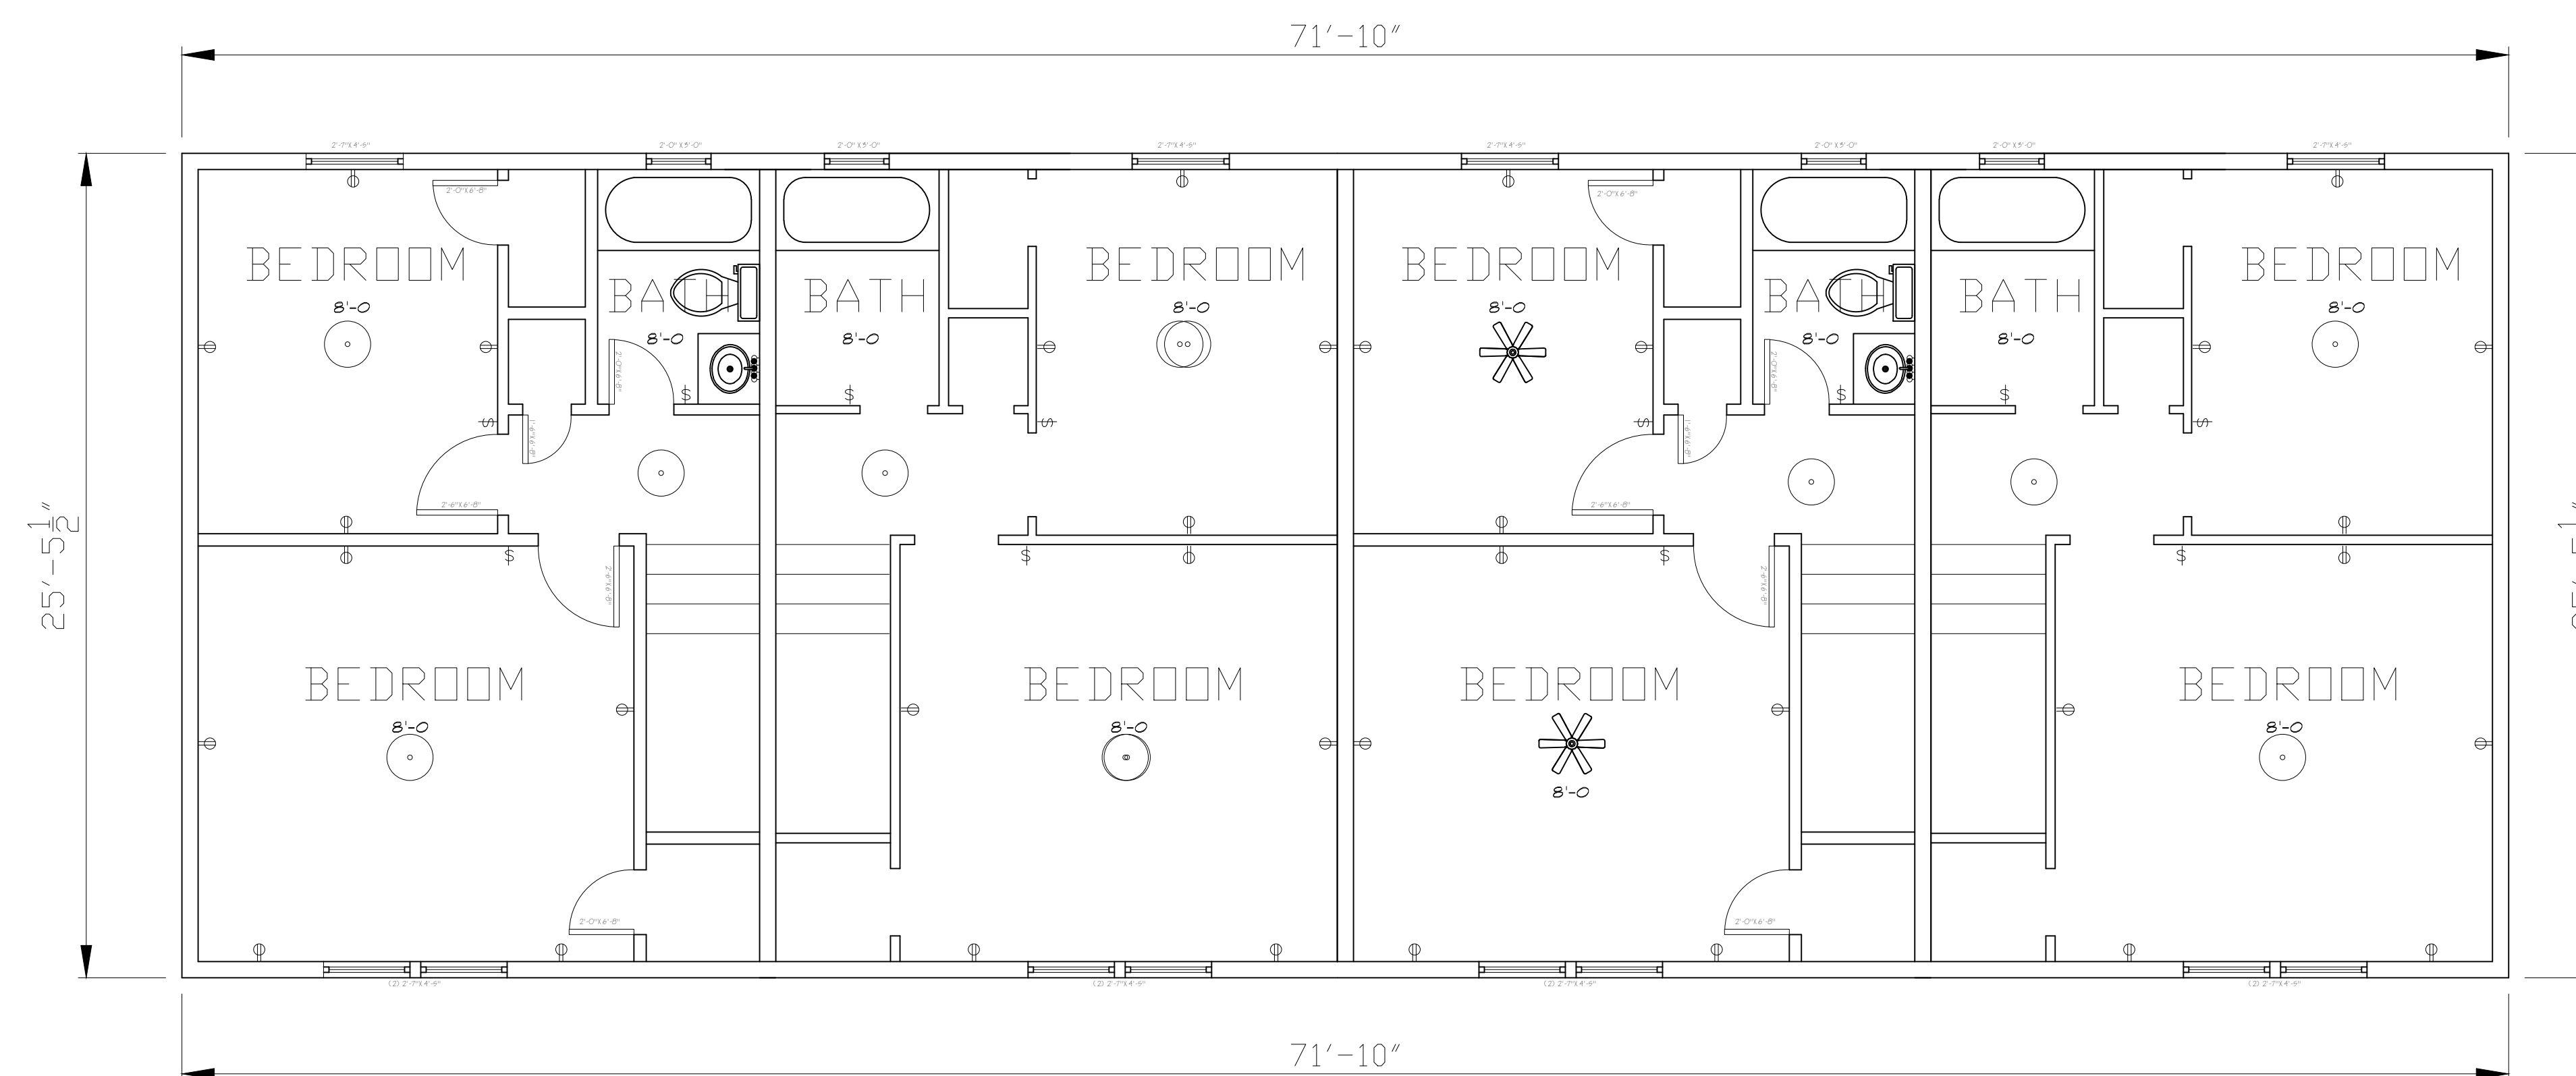

SECOND FLOOR PLAN

**ARCHITECTURAL AS BUILT
MULTI FAMILY RESIDENTIAL**

CHARLOTTE, NC 28208

01	100% SUBMISSION	SEE COVER SHEET
NO.	ISSUES REVISIONS	DATE


SHEET TITLE

HL	PROJECT MANAGER
HL	PROJECT DIRECTOR
012317-1	PROJECT NUMBER
1/4"=1'-0"	SCALE
CB	DRAWN BY
	SHEET NUMBER


AB-1




FRONT ELEVATION

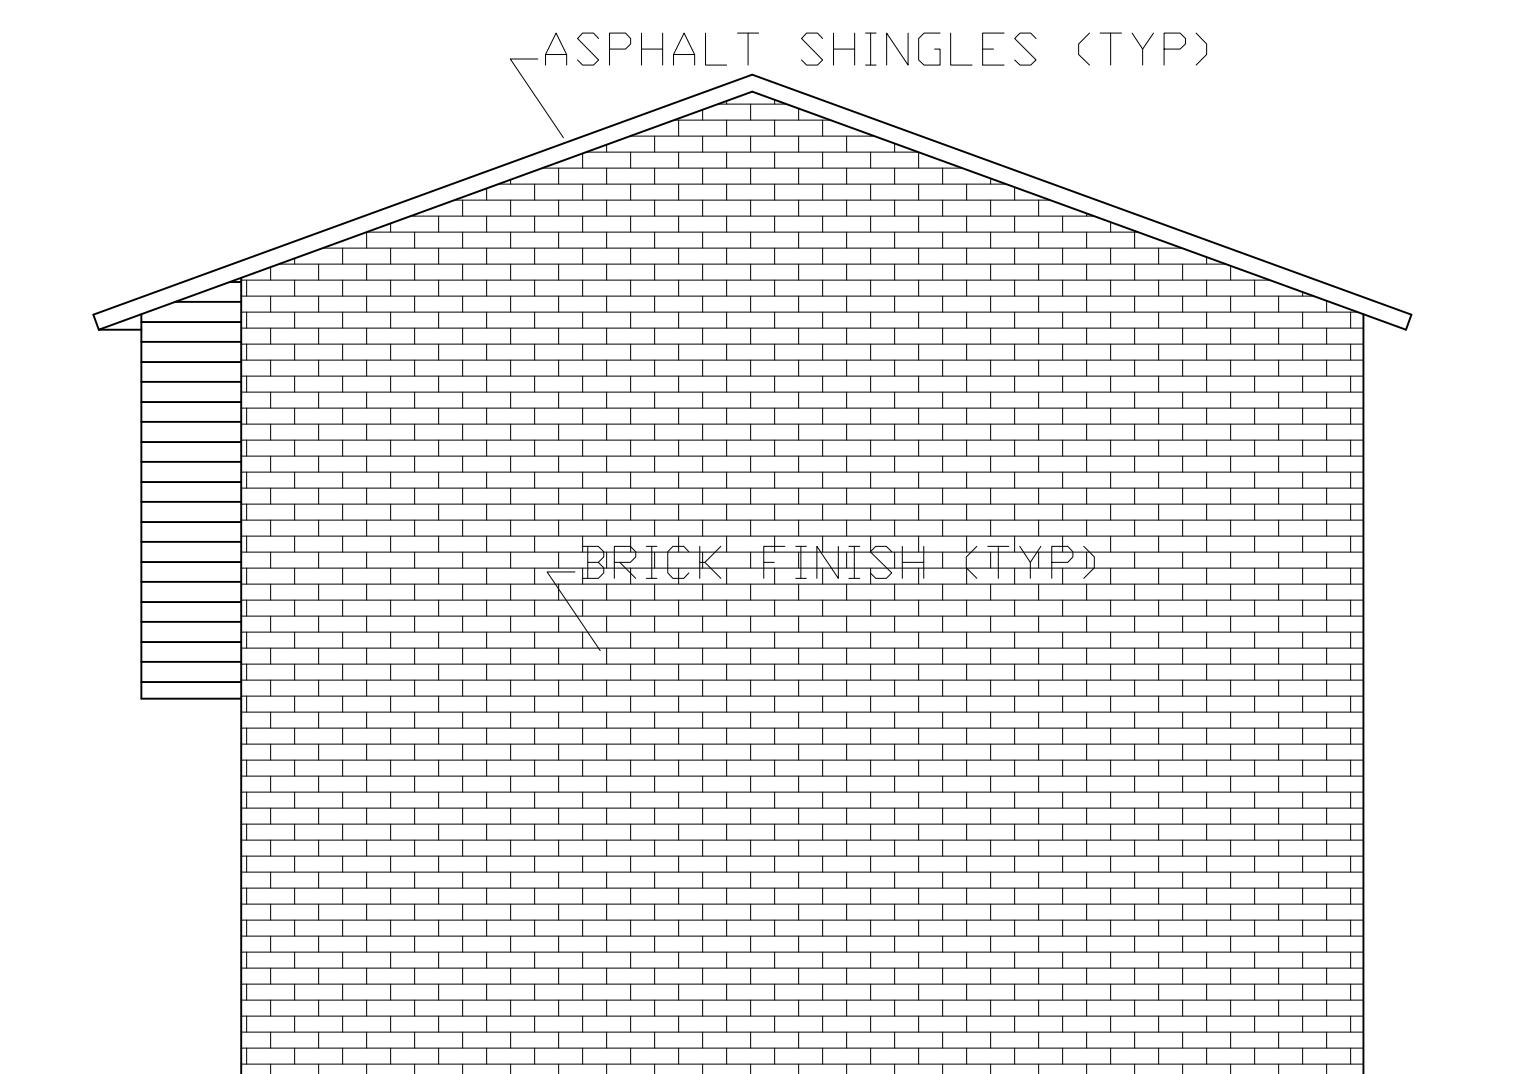

RIGHT ELEVATION

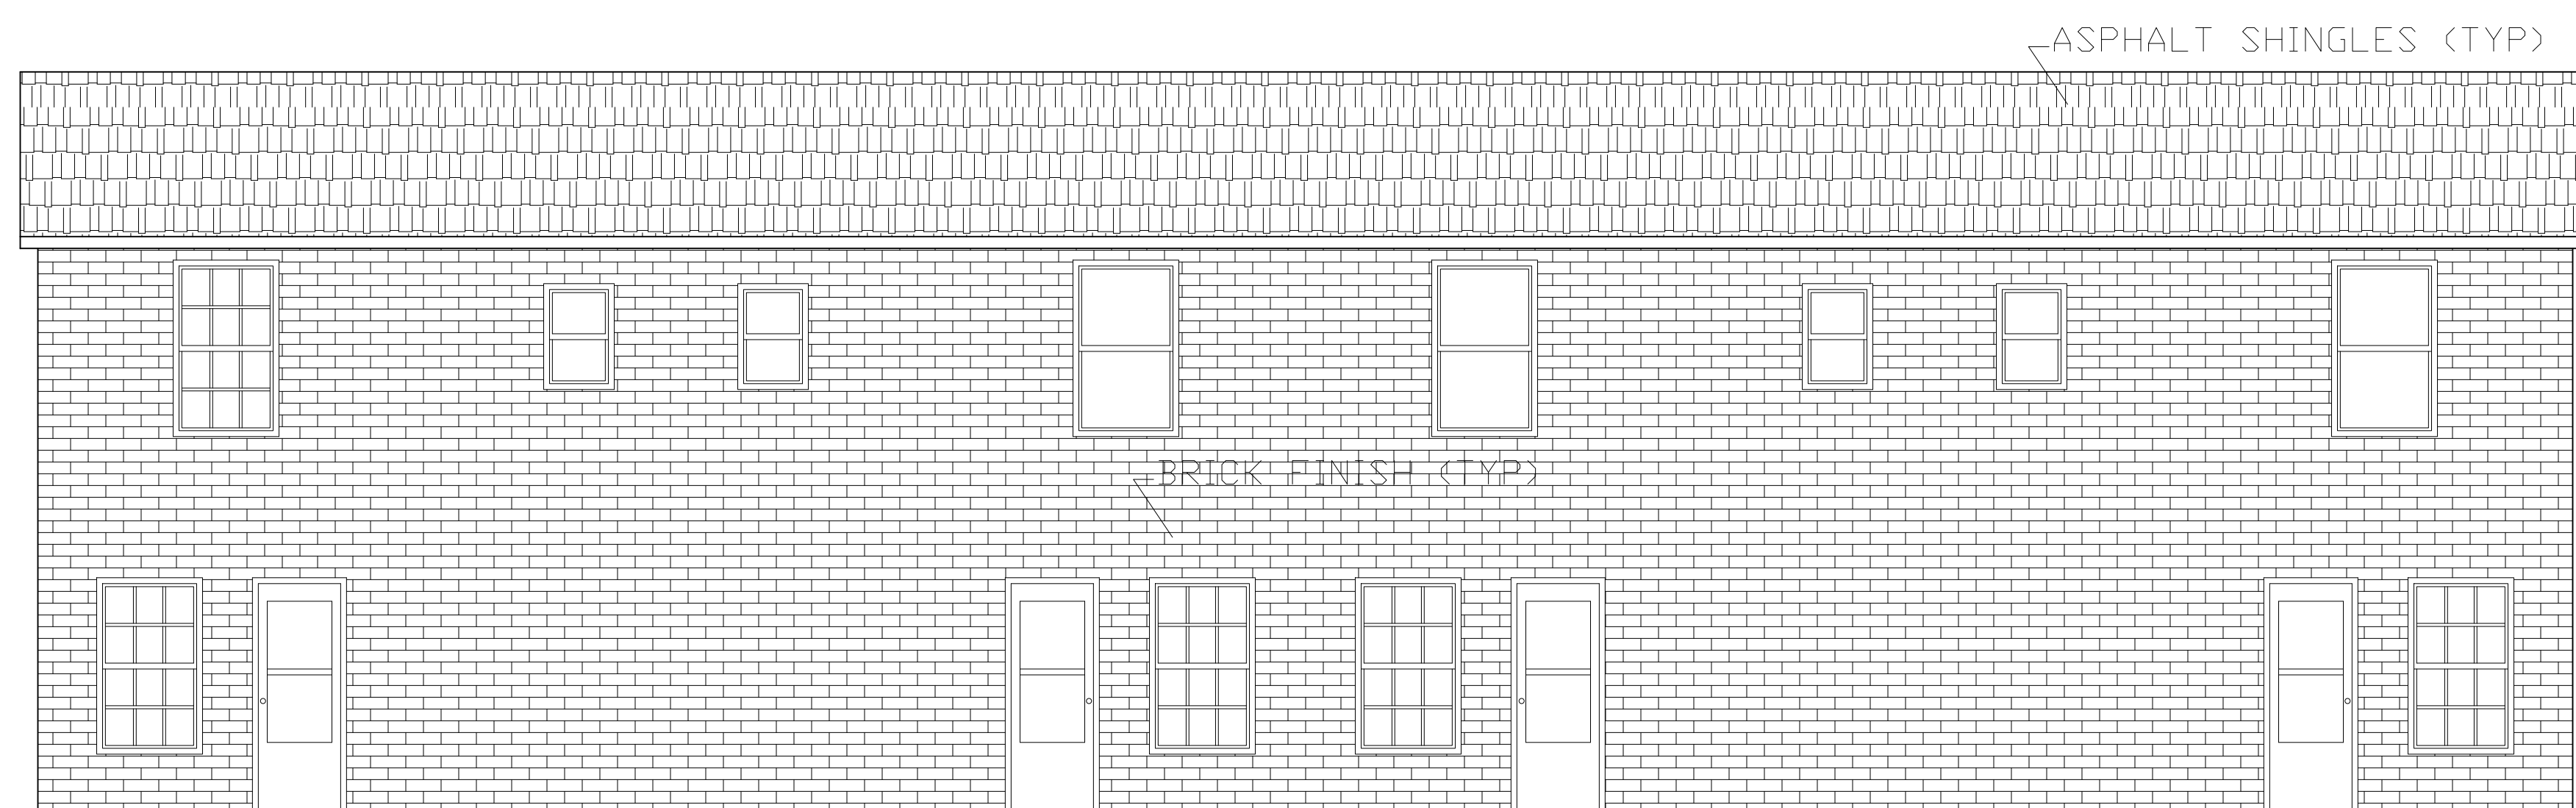

REAR ELEVATION

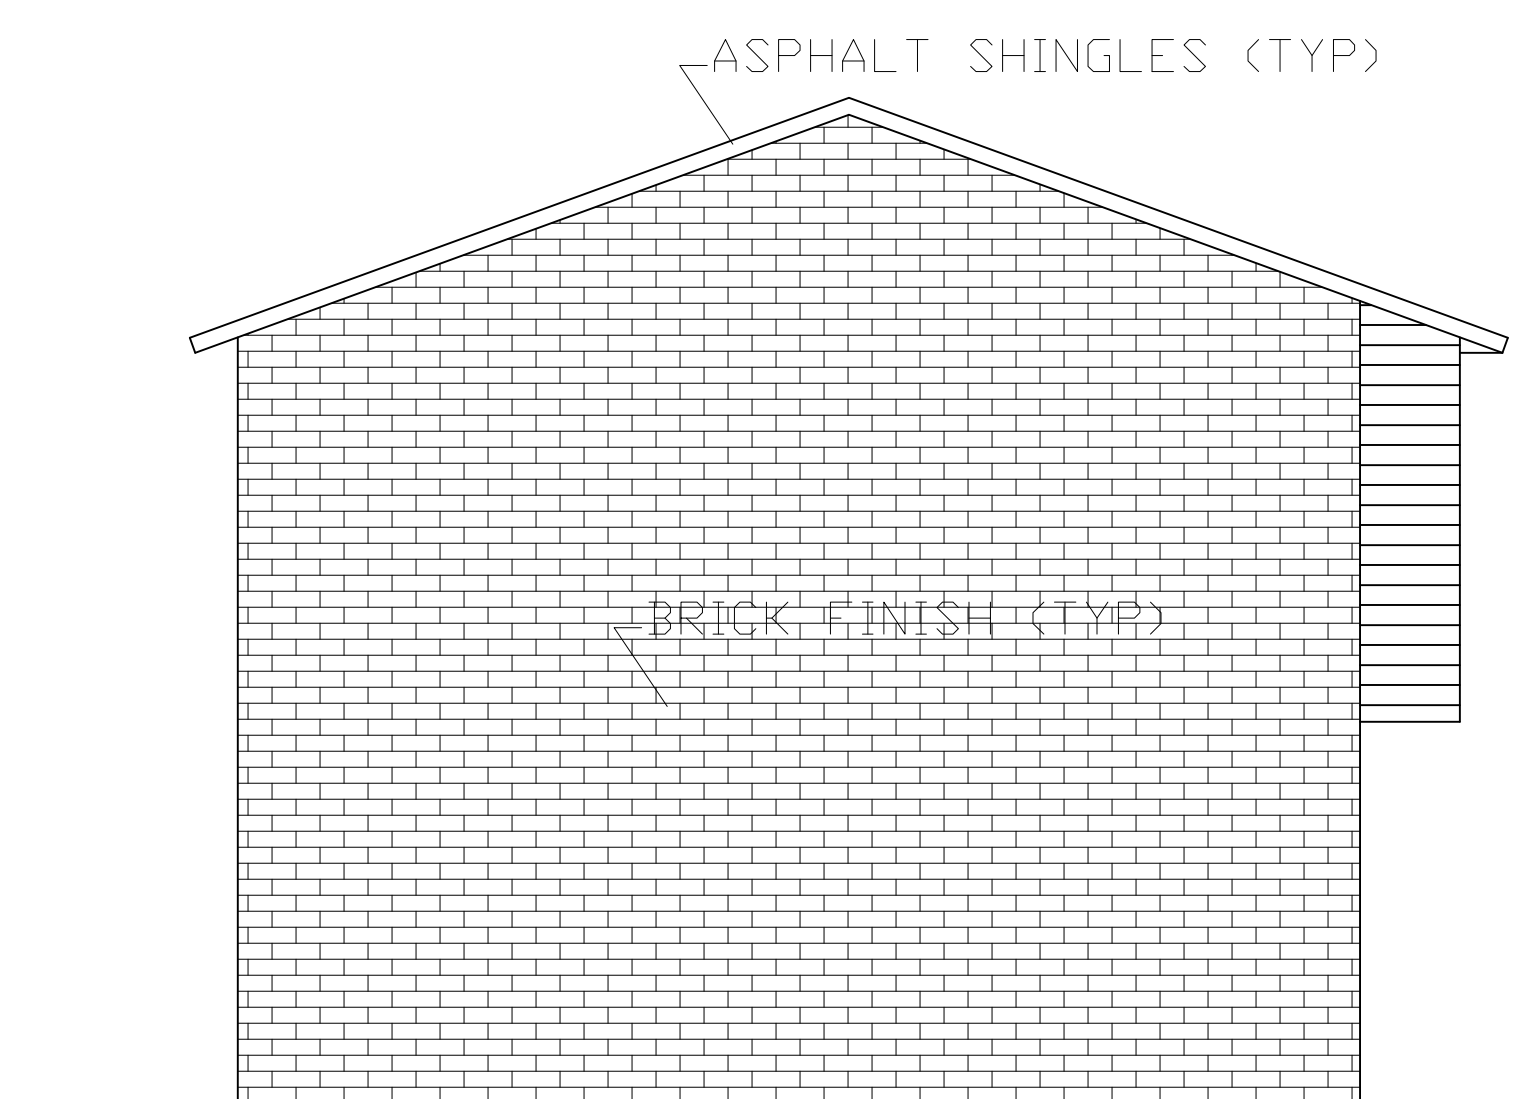

LEFT ELEVATION

**ARCHITECTURAL AS BUILT
MULTI FAMILY RESIDENTIAL**

CHARLOTTE, NC 28208

01	100% SUBMISSION	SEE COVER SHEET
NO.	ISSUES REVISIONS	DATE

SHEET TITLE

HL	PROJECT MANAGER
HL	PROJECT DIRECTOR
012317-1	PROJECT NUMBER
1/4"=1'-0"	SCALE
CB	DRAWN BY
	SHEET NUMBER

AB-2