

AS-BUILT DOCUMENTATION


KIRKLAND, WA 98033



100% SUBMITTAL

DRAWING INDEX

- C-1 COVER SHEET | DRAWING INDEX
- AB-1 FIRST FLOOR PLAN AND RCP
- AB-2 SECOND FLOOR PLAN AND RCP
- AB-3 DOOR & WINDOW SCHEDULES

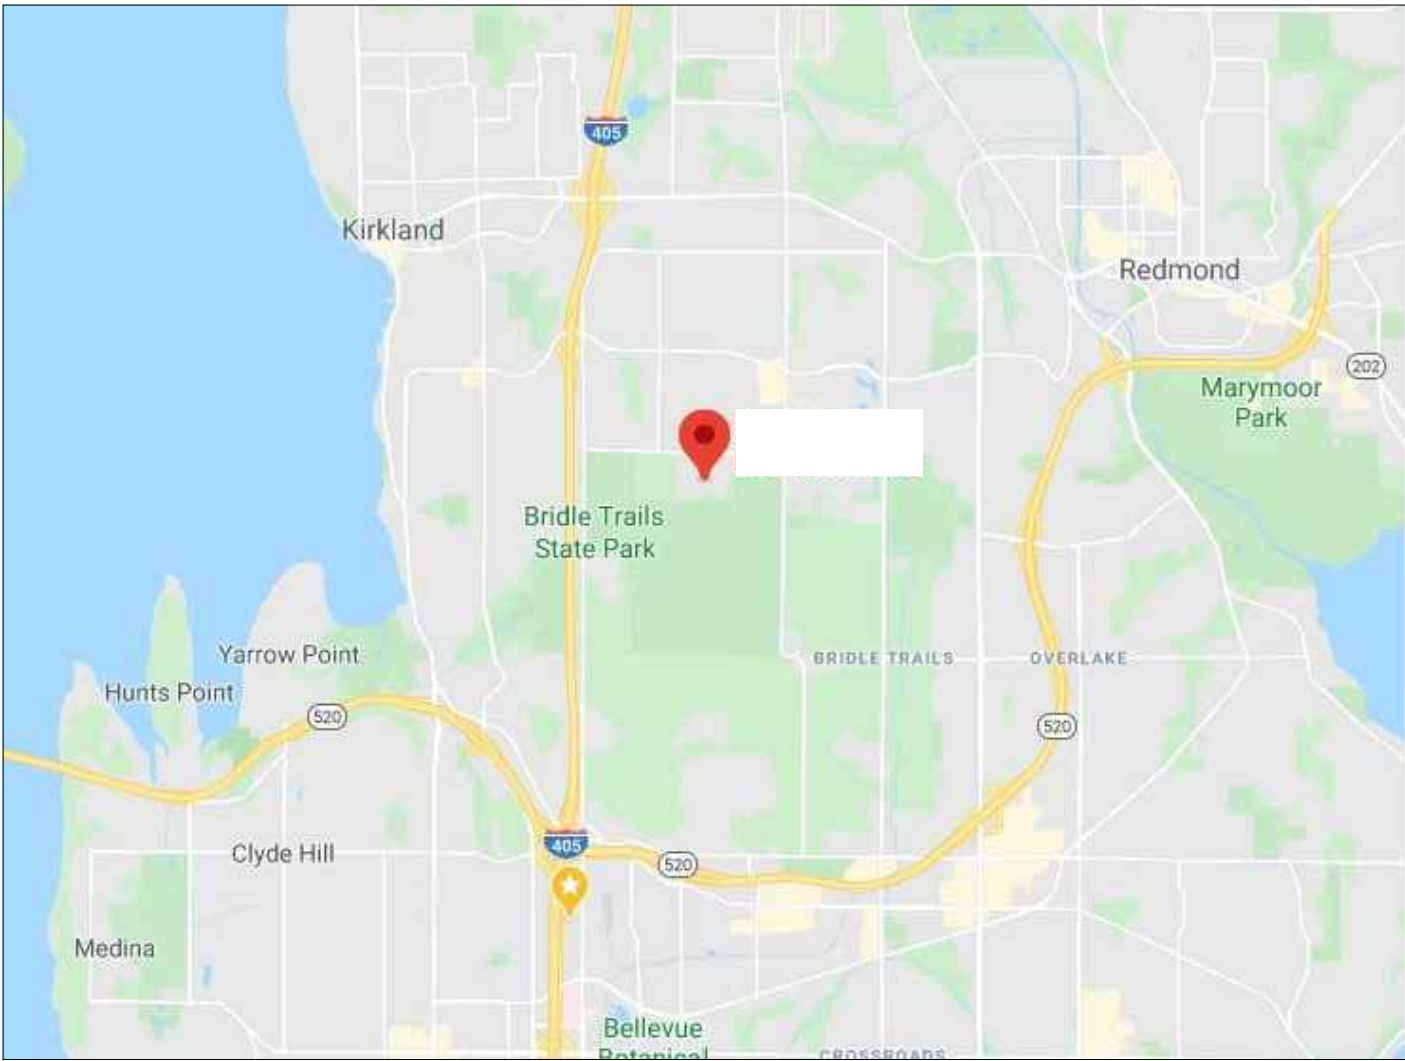

VICINITY MAP

NTS

AREA DATA	
CELLAR	101 S.F. ±
FIRST FLOOR	3,814 S.F. ±
SECOND FLOOR	3,047 S.F. ±
GRAND TOTAL	6,962 S.F. ±

AS BUILT

PROFESSIONALS

www.asbuiltprofessionals.com

A DIVISION OF:

AEC

CONSULTANTS INC

844.272.8458

844 ASBUILT


© 2020 AEC CONSULTANTS, INC.

ARCHITECTURAL AS BUILT

KIRKLAND, WA 98033

01	100% SUBMISSION	
NO.	ISSUES REVISIONS	DATE
SHEET TITLE		
COVER SHEET		
HL	PROJECT MANAGER	
HL	PROJECT DIRECTOR	
	PROJECT NUMBER	
	SCALE	
MM	DRAWN BY	
	SHEET NUMBER	

C-1

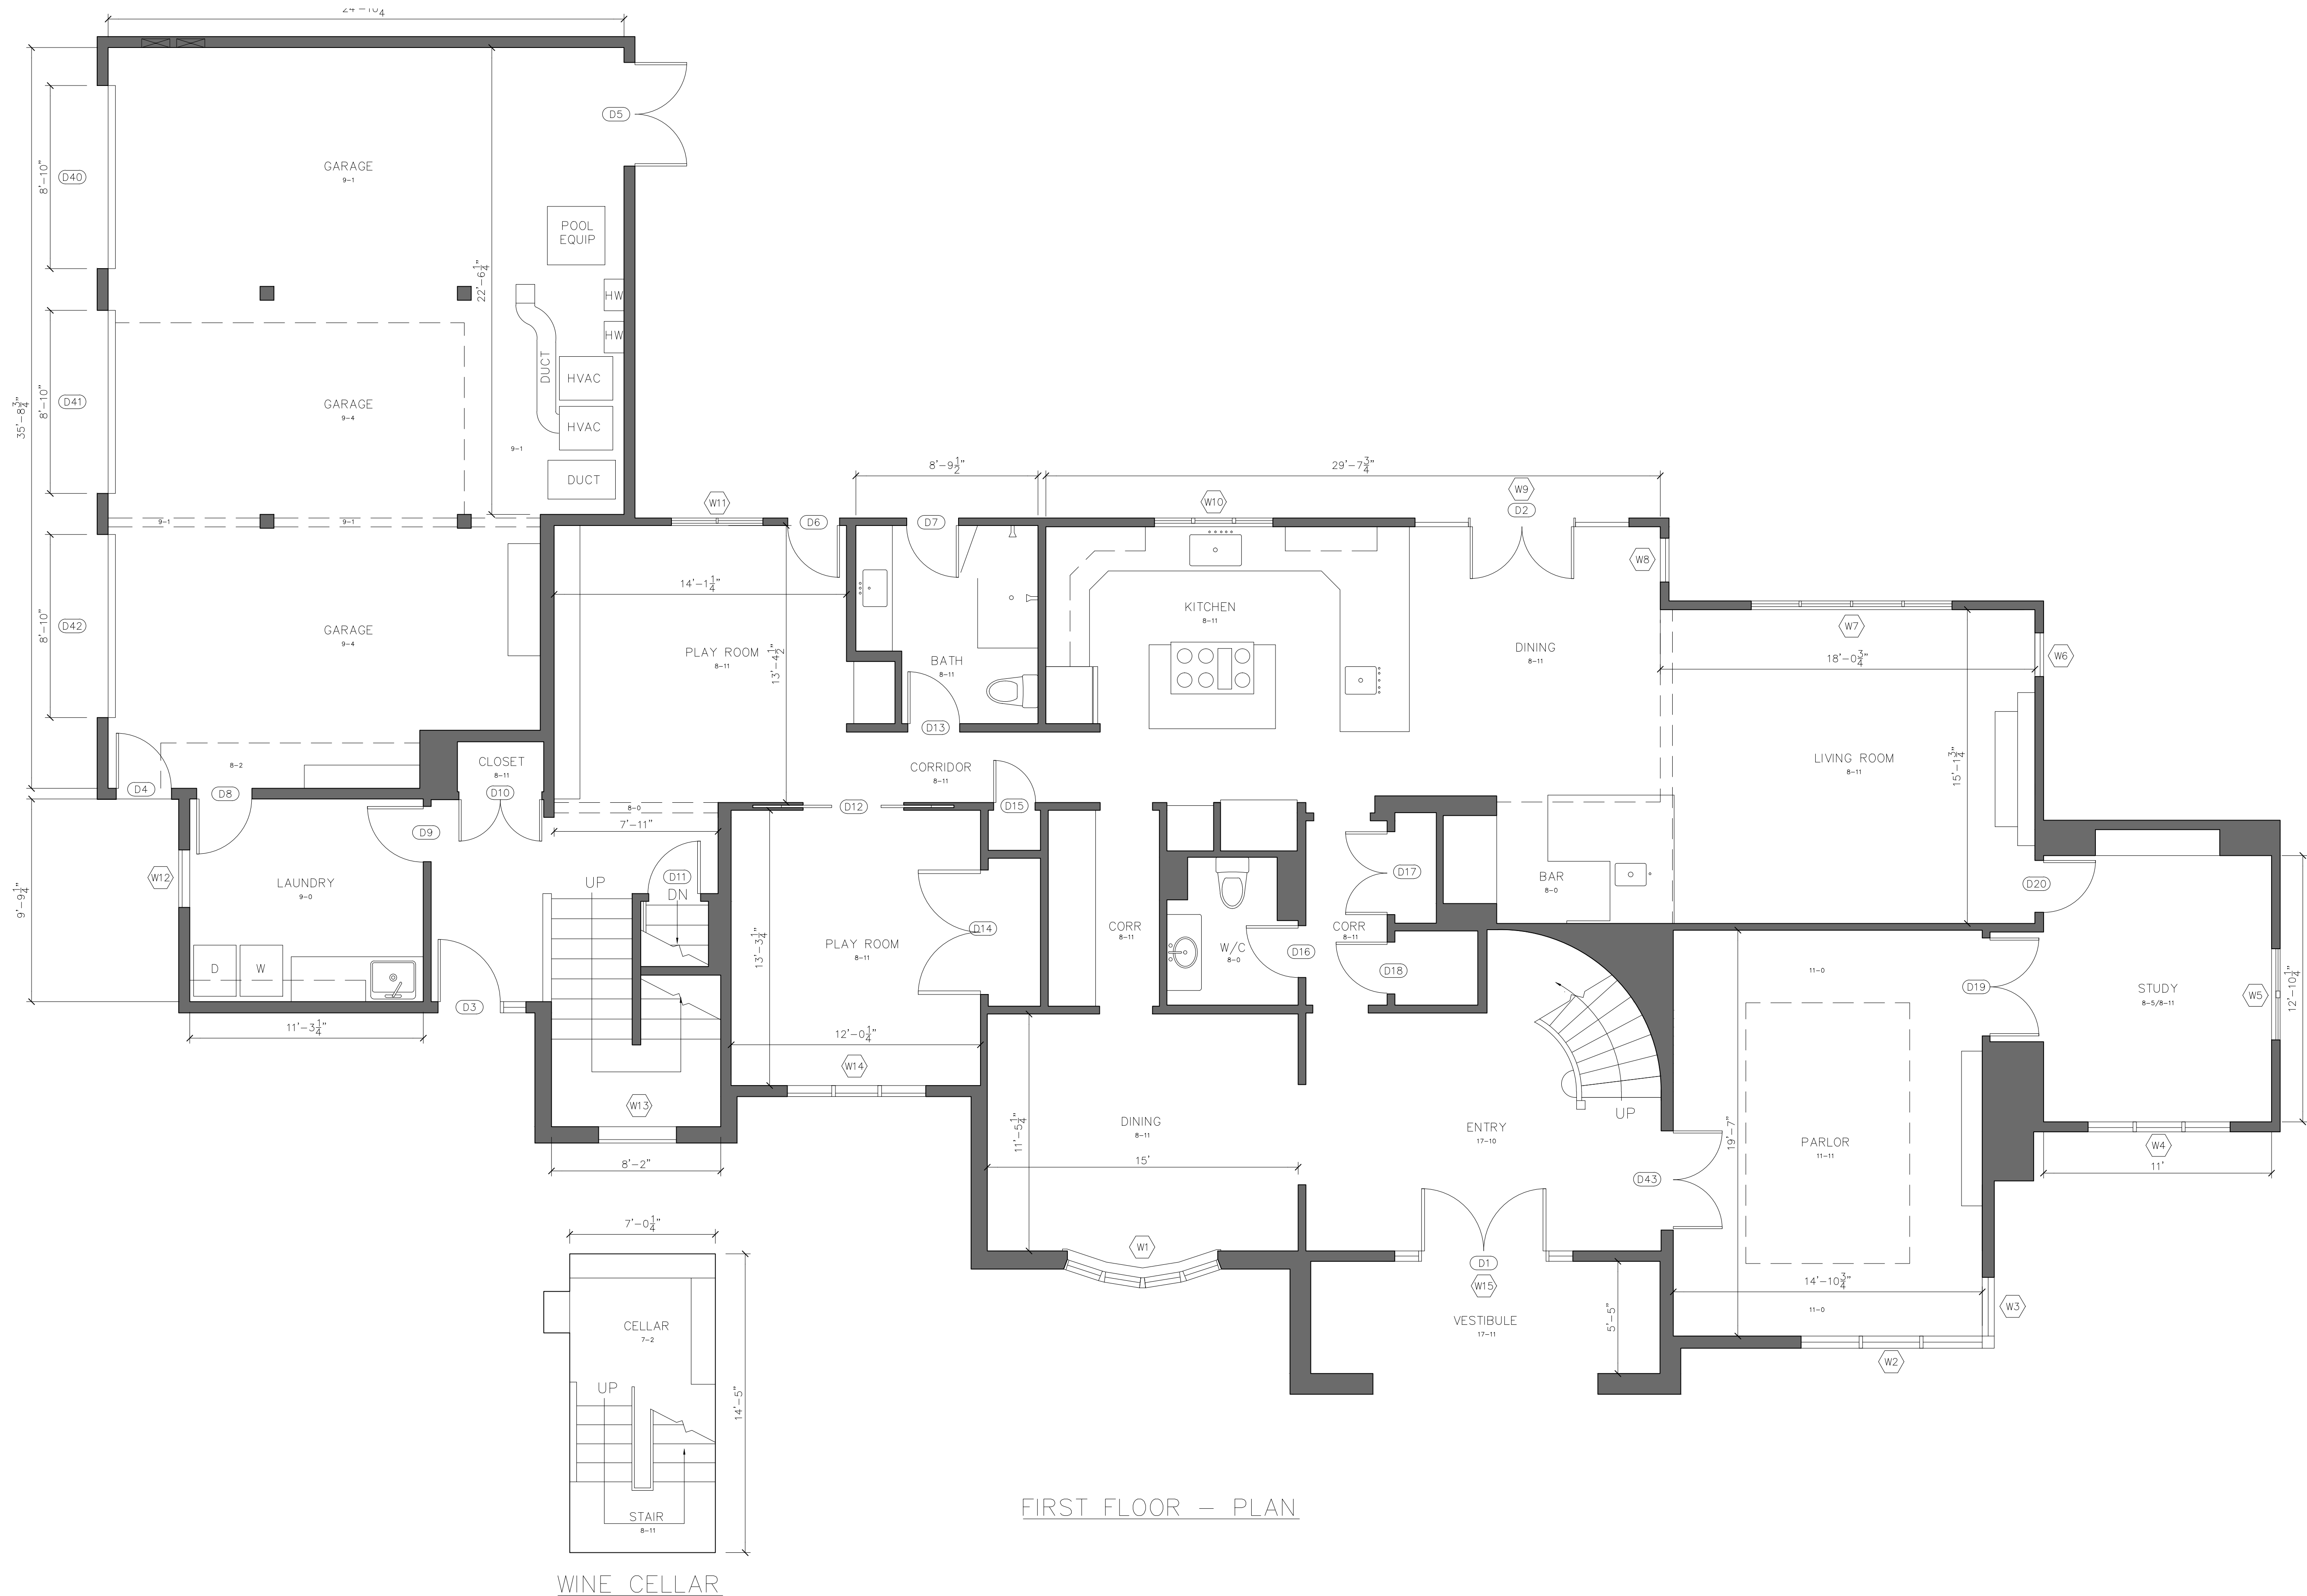

FIRST FLOOR — PLAN

WINE CELLAR

AS BUILT

PROFESSIONALS

www.asbuiltprofessionals.com

A DIVISION OF:

AEC

CONSULTANTS INC

844.272.8458

844 AS BUILT

© 2020 AEC CONSULTANTS INC

ARCHITECTURAL AS BUILT

KIRKLAND, WA 98033


01	100% SUBMISSION	
NO.	ISSUES REVISIONS	DATE
SHEET TITLE		
BASEMENT FLOOR PLAN & RCP		
HL	PROJECT MANAGER	
HL	PROJECT DIRECTOR	
	PROJECT NUMBER	
	SCALE	
MM	DRAWN BY	
	SHEET NUMBER	

AB-1



ARCHITECTURAL AS BUILT

KIRKLAND, WA 98033

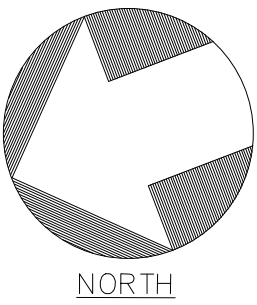

SECOND FLOOR – PLAN

01	100% SUBMISSION	
NO.	ISSUES REVISIONS	DATE
		SHEET TITLE
FIRST FLOOR PLAN & RCP		
HL	PROJECT MANAGER	
HL	PROJECT DIRECTOR	
	PROJECT NUMBER	
1/2"=1'-0"		SCALE
MM	DRAWN BY	
		SHEET NUMBER

FIRST FLOOR PLAN & RCP


AB-2

Door Schedule

Door	Leaf Width	Leaf Height	Trim Int. Ht	Trim Width	Left Trim	Right Trim	Top Trim	Notes
D1	3'-0" ea	8'-0"	8'-1"	8'-7.1"	4.5"	4.5"	N/A	See Elevation "D1"
D2	2'-6" ea	6'-8"	7'-8"	10'-3.1"	3.5"	3.5"	3.5"	Double door with side doors, full lites
D3	3'-0"	6'-8"	6'-9"	4'-3"	3.5"	3.5"	3.5"	Ext. door with full side lite
D4	2'-8"	6'-8"	6'-9"	2'-8.5"	3.5"	3.5"	3.5"	Ext. door w/ half lite on door leaf
D5	2'-6" ea	6'-8"	6'-9"	5'-0.25"	3.5"	3.5"	3.5"	Ext. Double w/ vents, full lites on ea door
D6	2'-6"	6'-8"	6'-9"	2'-6.5"	3.5"	3.5"	3.5"	Ext. door with full lite
D7	2'-6"	6'-8"	6'-9"	2'-6.5"	3.5"	3.5"	3.5"	Ext. door with half lite
D8	2'-8"	6'-8"	6'-9"	2'-8.5"	3.5"	3.5"	3.5"	Ext door to from laundry to garage
D9	2'-6"	6'-8"	6'-9"	2'-6.5"	3.5"	3.5"	3.5"	Int. door
D10	2'-0" ea	6'-8"	6'-9"	4'-0.25	3.5"	3.5"	3.5"	Int. closet double door
D11	2'-6"	6'-8"	6'-9"	2'-6.5"	3.5"	3.5"	3.5"	Int. door w/ half lite
D12	2'-6" ea	6'-8"	6'-9"	4'-10.5"	3.5"	3.5"	3.5"	Int. Double pocket doors
D13	2'-6"	6'-8"	6'-9"	2'-6.5"	3.5"	3.5"	3.5"	Int. door
D14	3'-0" ea	6'-8"	6'-9"	6'-0.25"	3.5"	3.5"	3.5"	Int. closet double door
D15	2'-0"	6'-8"	6'-9"	2'-0.25"	3.5"	3.5"	3.5"	Int. door
D16	2'-6"	6'-8"	6'-9"	2'-6.5"	3.5"	3.5"	3.5"	Int. door
D17	2'-0" ea	6'-8"	6'-9"	4'-0.25"	3.5"	3.5"	3.5"	Int. closet double door
D18	2'-6"	6'-8"	6'-9"	2'-6.5"	3.5"	3.5"	3.5"	Int. door
D19	2'-4" ea	6'-8"	6'-9"	4'-9.25"	5"	5"	5"	double door w/ full lite
D20	2'-6"	6'-8"	6'-9"	2'-6.5"	3.5"	3.5"	3.5"	int. door w/ full lite
D21	2'-4"	6'-8"	6'-9"	4'-9.25"	5"	5"	5"	Int. double doors
D22	2'-6"	6'-8"	6'-9"	2'-5"	3.5"	3.5"	3.5"	Int. pocket door
D23	2'-4"	6'-8"	6'-9"	2'-4.25"	3.5"	3.5"	3.5"	Int. door
D24	2'-4" ea	6'-8"	6'-9"	9'-6.5"	3.5"	3.5"	3.5"	Double door with side doors, full lites
D25	2'-0"	6'-8"	6'-9"	2'-0.25"	3.5"	3.5"	3.5"	Int. door
D26	2'-6"	6'-8"	6'-9"	2'-6.5"	3.5"	3.5"	3.5"	Int. door
D27	2'-6" ea	6'-8"	6'-9"	5'-0.25"	3.5"	3.5"	3.5"	Int. closet double door
D28	2'-6"	6'-8"	6'-9"	2'-6.5"	3.5"	3.5"	3.5"	Int. door
D29	2'-6" ea	6'-8"	6'-9"	5'-0.25"	3.5"	3.5"	3.5"	Int. closet double door
D30	2'-6" ea	6'-8"	6'-9"	5'-0.25"	3.5"	3.5"	3.5"	Int. closet double door
D31	2'-6"	6'-8"	6'-9"	2'-6.5"	3.5"	3.5"	3.5"	Int. door
D32	2'-4"	6'-8"	6'-9"	2'-4.25"	3.5"	3.5"	3.5"	Int. door
D33	2'-4"	6'-8"	6'-9"	2'-3"	3.5"	3.5"	3.5"	Int. pocket door
D34	2'-6"	6'-8"	6'-9"	2'-6.5"	3.5"	3.5"	3.5"	Int. door
D35	2'-2"	6'-8"	6'-9"	3'-10.9"	3.5"	3.5"	3.5"	Int. sliding closet
D36	2'-6"	6'-8"	6'-9"	2'-6.5"	3.5"	3.5"	3.5"	Int. door
D37	2'-2"	6'-8"	6'-9"	3'-10.9"	3.5"	3.5"	3.5"	Int. sliding closet
D38	2'-6"	6'-8"	6'-9"	2'-4"	3.5"	3.5"	3.5"	Int. pocket door
D39	2'-4"	6'-8"	6'-9"	2'-4.25"	3.5"	3.5"	3.5"	Int. door
D40	9'-0"	8'-0"	7'-11"	8'-10"	1.5"	1.5"	1.5"	Roll-up Garage door
D41	9'-0"	8'-0"	7'-11"	8'-10"	1.5"	1.5"	1.5"	Roll-up Garage door
D42	9'-0"	8'-0"	7'-11"	8'-10"	1.5"	1.5"	1.5"	Roll-up Garage door
D43	2'-4"	6'-8"	6'-9"	4'-9.5"	5"	5"	5"	double door w/ glass
D44	2'-1.5"	6'-8"	6'-9"	4'-3"	3.5"	3.5"	3.5"	Int. closet double door

Window Schedule

Window	Width	Height	Sill Height	Left Trim	Right Trim	Top Trim	Btm Trim	Notes
W1	7'-3.1	4'-10.6"	1'-10.5"	4.5"	4.5"	4.5"	4.5"	Bay window, operable
W2	8'-9"	7'-2"	1'-11.5"	N/A	5"	5"	5"	operable
W3	2'-10"	7'-2"	1'-11.5"	5"	N/A	5"	5"	operable
W4	6'-10.2"	4'-9"	1'-11"	5"	5"	5"	5"	operable
W5	4'-4.8"	4'-9"	1'-11"	5"	5"	5"	5"	operable
W6	2'-1.5"	4'-9"	1'-11.2"	4.5"	4.5"	4.5"	4.5"	operable
W7	9'-8.3"	4'-9"	1'-11.2"	3.5"	3.5"	3.5"	3.5"	operable
W8	2'-1.5"	5'-10"	2'-0.1"	3.5"	3.5"	3.5"	3.5"	operable
W9	10'-3.1"	11.1"	6'-11"	3.5"	3.5"	3.5"	N/A	Transom
W10	5'-8.5"	3'-10.8"	3'-11.25"	3.5"	3.5"	3.5"	3.5"	operable
W11	4'-5"	4'-9"	1'-11.5"	3.5"	3.5"	3.5"	3.5"	operable
W12	2'-9.25"	3'-8.8"	2'-11.75"	3.5"	3.5"	3.5"	3.5"	operable
W13	3'-9"	8'-8.4"	2'-9.8"	3.5"	3.5"	3.5"	3.5"	operable
W14	6'-8.1"	4'-9.1"	1'-11.3"	3.5"	3.5"	3.5"	3.5"	operable
W15	8'-7.1"	Varies	8'-2.5"	4.5"	4.5"	4.5"	N/A	Transom - see Elevation D1
W16	2'-1.2"	3'-9.25"	2'-11"	3.5"	3.5"	3.5"	3.5"	operable
W17	5'-8.8"	1'-7.7"	3'-1.9"	1"	1"	4.5"	4.5"	fixed
W18	1'-5.25"	2'-9.2"	3'-10.5"	3.5"	3.5"	3.5"	3.5"	operable
W19	2'-1.25"	3'-9.3"	2'-11.5"	3.5"	3.5"	3.5"	3.5"	operable
W20	5'-1"	3'-9.3"	2'-11.5"	3.5"	3.5"	3.5"	3.5"	operable
W21	5'-1"	3'-9.3"	2'-11.5"	3.5"	3.5"	3.5"	3.5"	operable
W22	2'-3.2"	3'-9"	3'-0"	3.5"	3.5"	3.5"	3.5"	operable
W23	5'-9"	3'-9"	3'-0"	3.5"	3.5"	3.5"	3.5"	operable
W24	5'-9"	3'-9"	3'-0"	3.5"	3.5"	3.5"	3.5"	operable
W25	3'-9"	3'-9"	3'-0"	3.5"	3.5"	3.5"	3.5"	operable
W26	3'-9"	3'-9"	3'-0"	3.5"	3.5"	3.5"	3.5"	operable
W27	3'-9"	3'-9"	3'-0"	3.5"	3.5"	3.5"	3.5"	operable
W28	7'-7.2"	3'-9.3"	2'-11.5"	3.5"	3.5"	3.5"	3.5"	operable
W29	6'-9"	3'-9.3"	2'-11.5"	3.5"	3.5"	3.5"	3.5"	operable
W30	1'-9.25"	3'-9.3"	2'-11.5"	3.5"	3.5"	3.5"	3.5"	operable
W31	1'-9.25"	3'-9.3"	2'-11.5"	3.5"	3.5"	3.5"	3.5"	operable

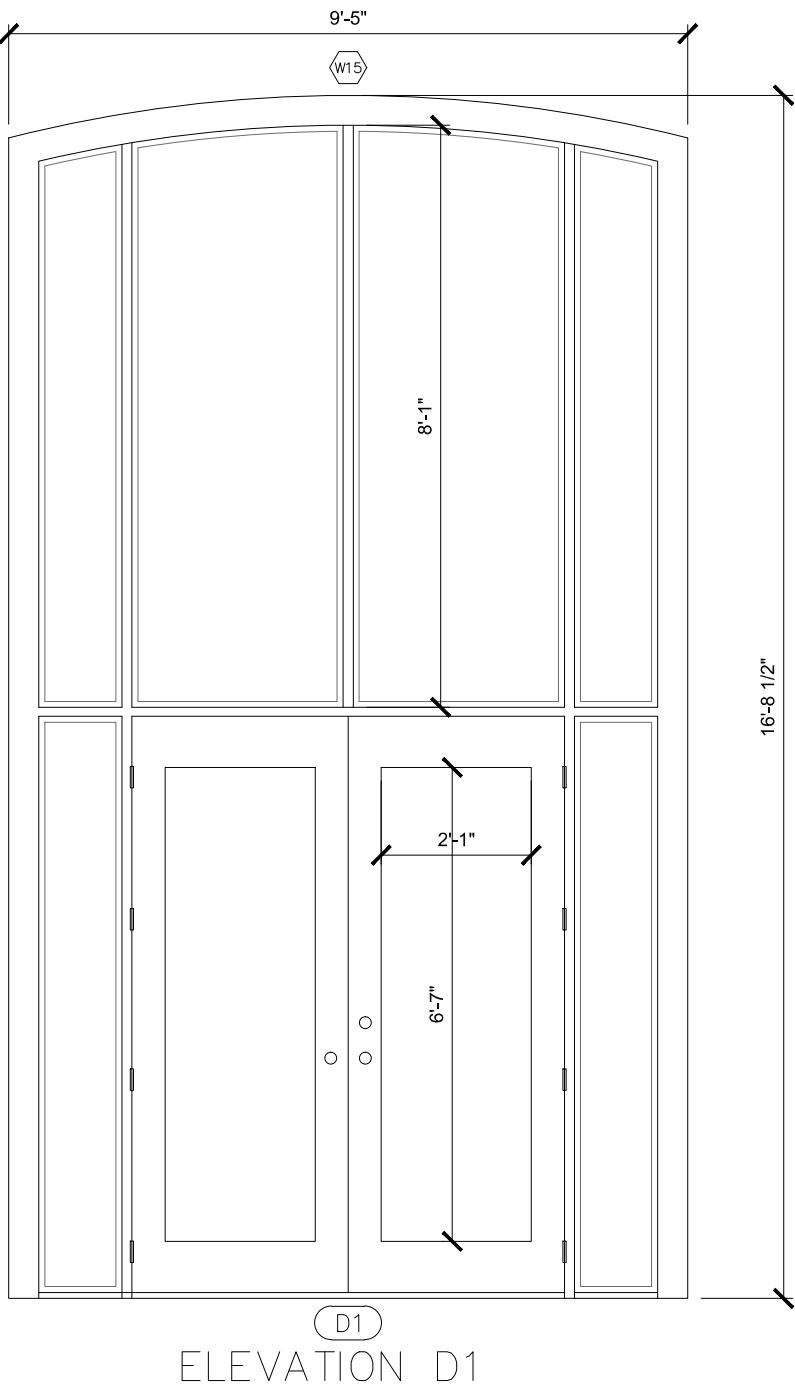

ARCHITECTURAL AS BUILT

KIRKLAND, WA 98033

01	100% SUBMISSION	
NO.	ISSUES REVISIONS	DATE
SHEET TITLE		
DOOR & WINDOW SCHEDULES		
HL	PROJECT MANAGER	
HL	PROJECT DIRECTOR	
	PROJECT NUMBER	
1/2"=1'-0"		SCALE
MM	DRAWN BY	
	SHEET NUMBER	

AB-3