

AS-BUILT DOCUMENTATION


MAPLE VALLEY, WA 98038



100% SUBMITTAL

DRAWING INDEX

- C-1 COVER SHEET | DRAWING INDEX
- AB-1 FLOOR PLAN AND SCHEDULES

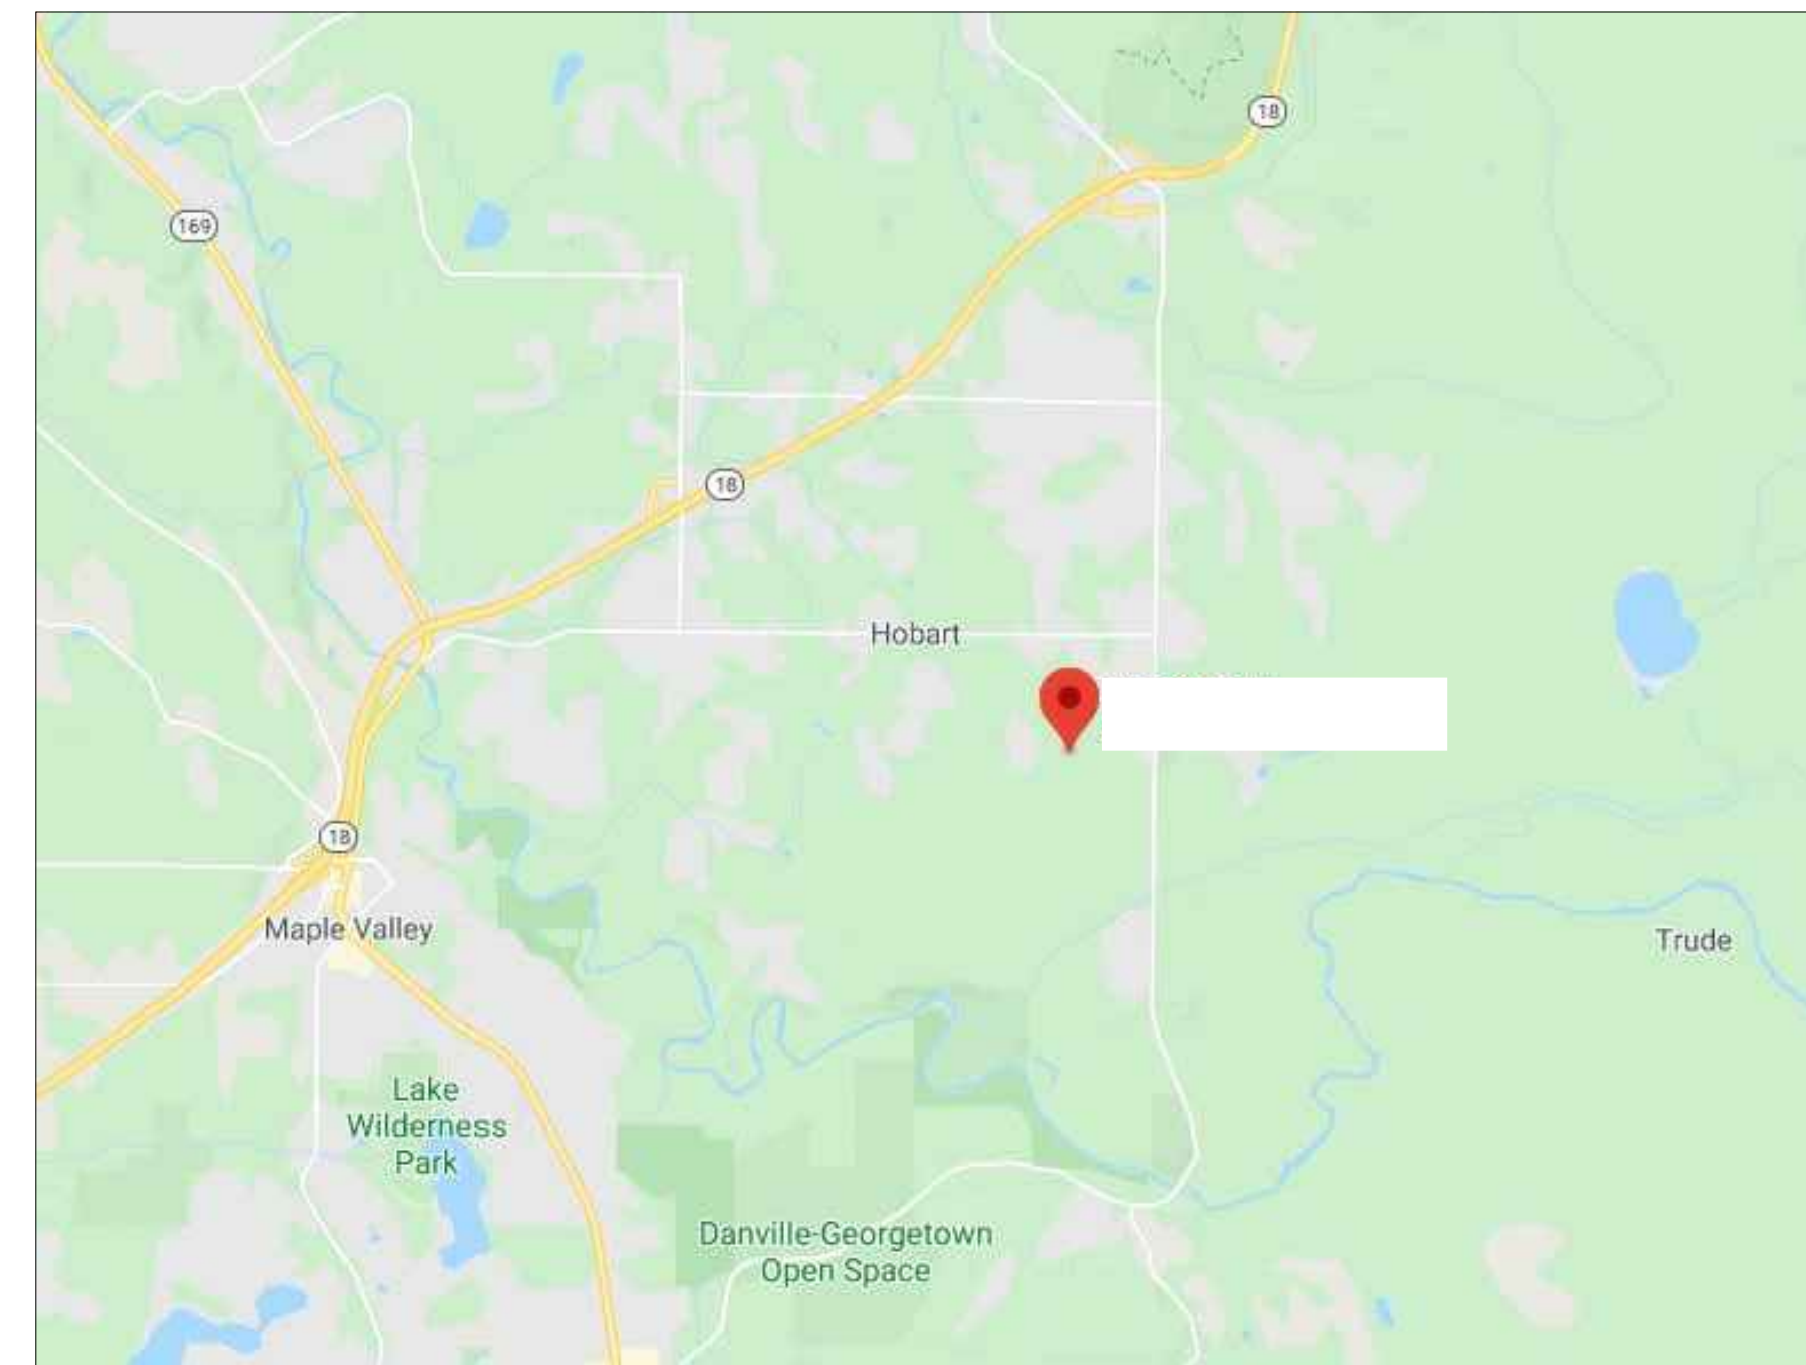

VICINITY MAP
NTS

AREA DATA	
KITCHEN & DINING ROOM	1,120 S.F. ±
GRAND TOTAL	1,120 S.F. ±

AS BUILT
PROFESSIONALS
www.asbuiltprofessionals.com
A DIVISION OF:

AEC
CONSULTANTS INC
844.272.8458
844 AS BUILT

© 2020 AEC CONSULTANTS, INC.

ARCHITECTURAL AS BUILT


MAPLE VALLEY, WA 98038

NO.	ISSUES REVISIONS	DATE
01	100% SUBMISSION	


COVER SHEET

HL	PROJECT MANAGER
HL	PROJECT DIRECTOR
?	PROJECT NUMBER
	SCALE
MM	DRAWN BY
	SHEET NUMBER

C-1

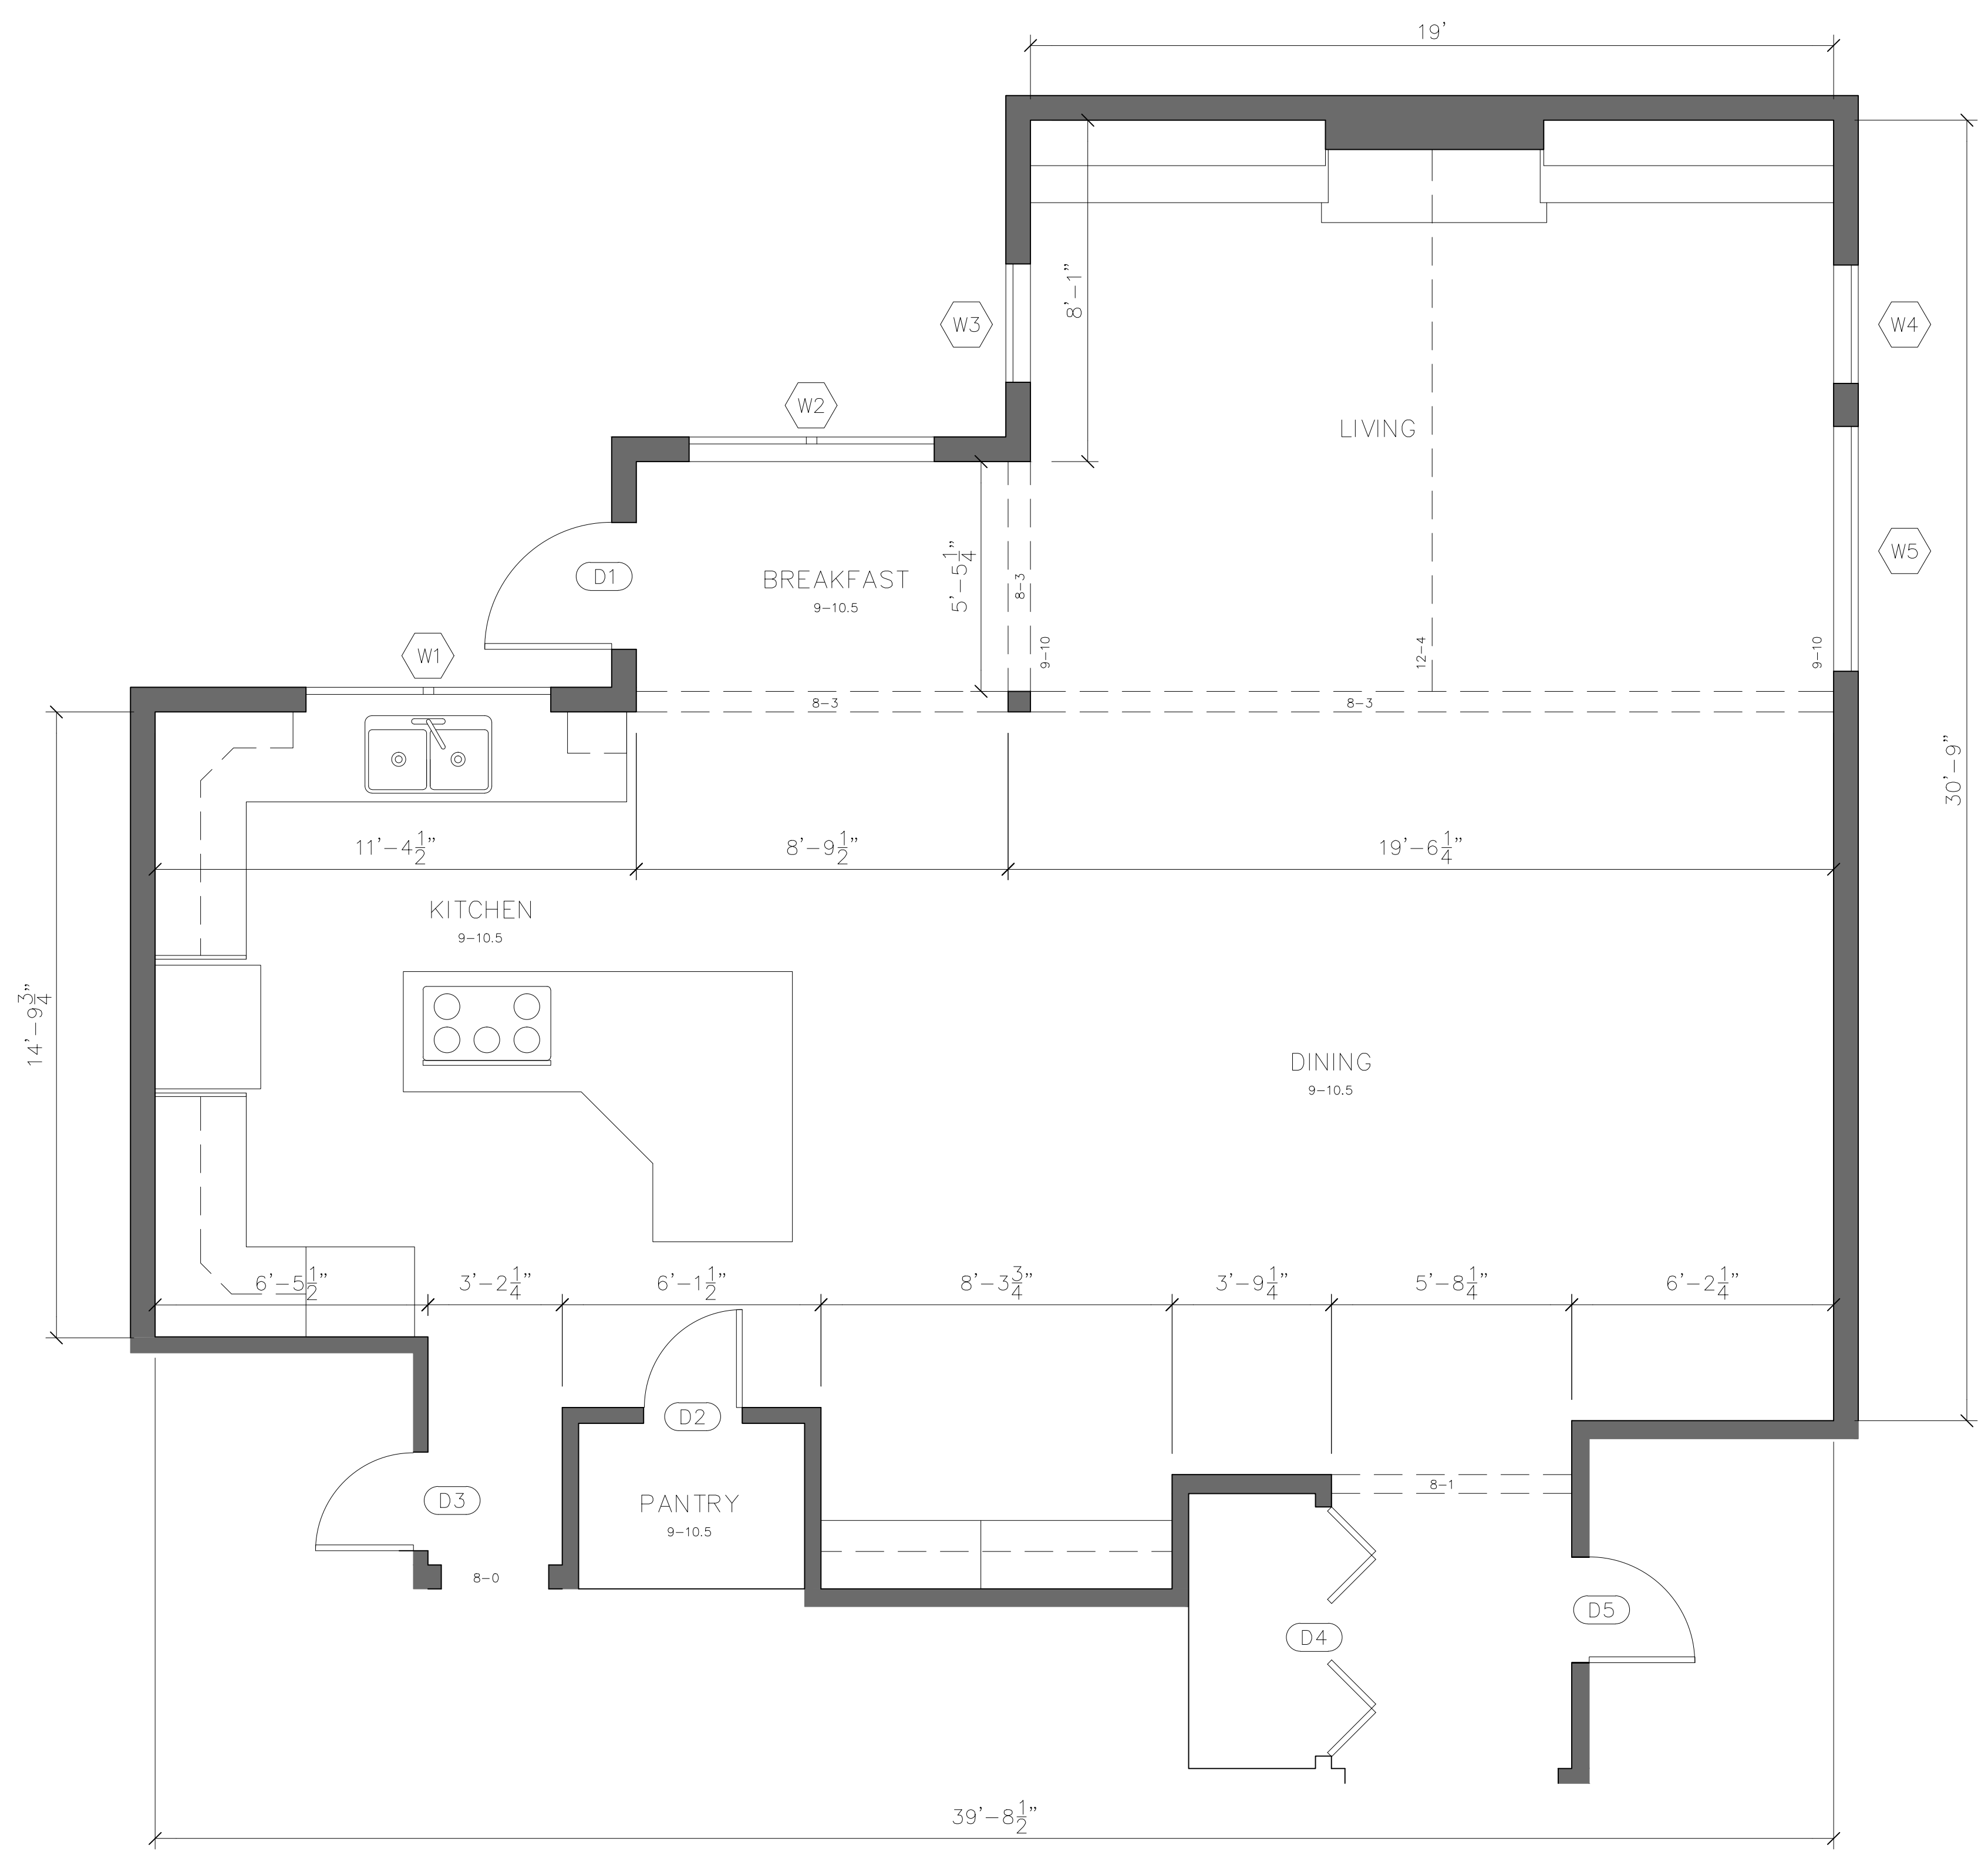

FLOOR PLAN

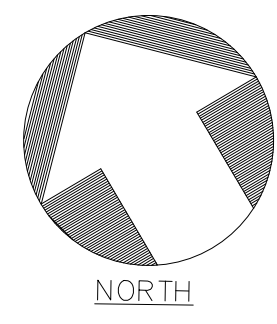

Door Schedule

Door	Leaf Width	Leaf Height	Left Trim	Right Trim	Top Trim	Notes
D1	3'-0"	8'-0"	3.75"	3.75"	3.75"	Ext. door with full lite
D2	2'-4"	6'-8"	3.75"	3.75"	3.75"	Int. door with full lite
D3	2'-4"	6'-9"	3.75"	3.75"	3.75"	bathroom door
D4	5'-10.5"	6'-9"	3.75"	3.75"	3.75"	closet door
D5	2'-6"	6'-9"	3.75"	3.75"	3.75"	Laundry room door

Window Schedule

Window	Width	Height	Sill Height	Left Trim	Right Trim	Top Trim	Btm Trim	Notes
W1	5'-9.5"	4'-9"	3'-0"	3.75"	3.75"	3.75"	N/A	sill is countertop ht
W2	5'-9.3"	4'-9.5"	3'-3.6"	3.75"	3.75"	3.75"	4.1"	
W3	2'-9.6"	4'-9.5"	3'-3.6"	3.75"	3.75"	3.75"	4.1"	
W4	2'-9.7"	4'-9.5"	3'-3.6"	3.75"	3.75"	3.75"	4.1"	
W5	5'-9.3"	4'-9.5"	3'-3.6"	3.75"	3.75"	3.75"	4.1"	

ARCHITECTURAL AS BUILT
MAPLE VALLEY, WA 98038

01	100% SUBMISSION	
NL	ISSUES REVISIONS	DATE
SHEET TITLE		

FLOOR PLAN & SCHEDULES

HL	PROJECT MANAGER
HL	PROJECT DIRECTOR
?	PROJECT NUMBER
3/8"=1'-0"	SCALE
MM	DRAWN BY
	SHEET NUMBER