

AS-BUILT DOCUMENTATION

SEATTLE WA 98103



DRAWING INDEX

- C-1 COVER SHEET | DRAWING INDEX
- AB-1 BASEMENT FLOOR PLAN AND RCP
- AB-2 FIRST FLOOR PLAN AND RCP
- AB-3 SECOND FLOOR PLAN AND RCP
- AB-4 DOOR & WINDOW SCHEDULES



VICINITY MAP

NTS

AREA DATA	
BASEMENT	1,139 S.F. ±
FIRST FLOOR	1,102 S.F. ±
SECOND FLOOR	1,186 S.F. ±
GRAND TOTAL	3,427 S.F. ±

AS BUILT

PROFESSIONALS

www.asbuiltprofessionals.com

A DIVISION OF:

AEC

CONSULTANTS INC

844.272.8458


844 AS BUILT

© 2020 AEC CONSULTANTS INC.


ARCHITECTURAL AS BUILT

SEATTLE, WA 98119

01	100% SUBMISSION	
NO.	ISSUES REVISIONS	DATE
SHEET TITLE		
COVER SHEET		
HL		PROJECT MANAGER
HL		PROJECT DIRECTOR
?		PROJECT NUMBER
		SCALE
MM		DRAWN BY
SHEET NUMBER		
C-1		

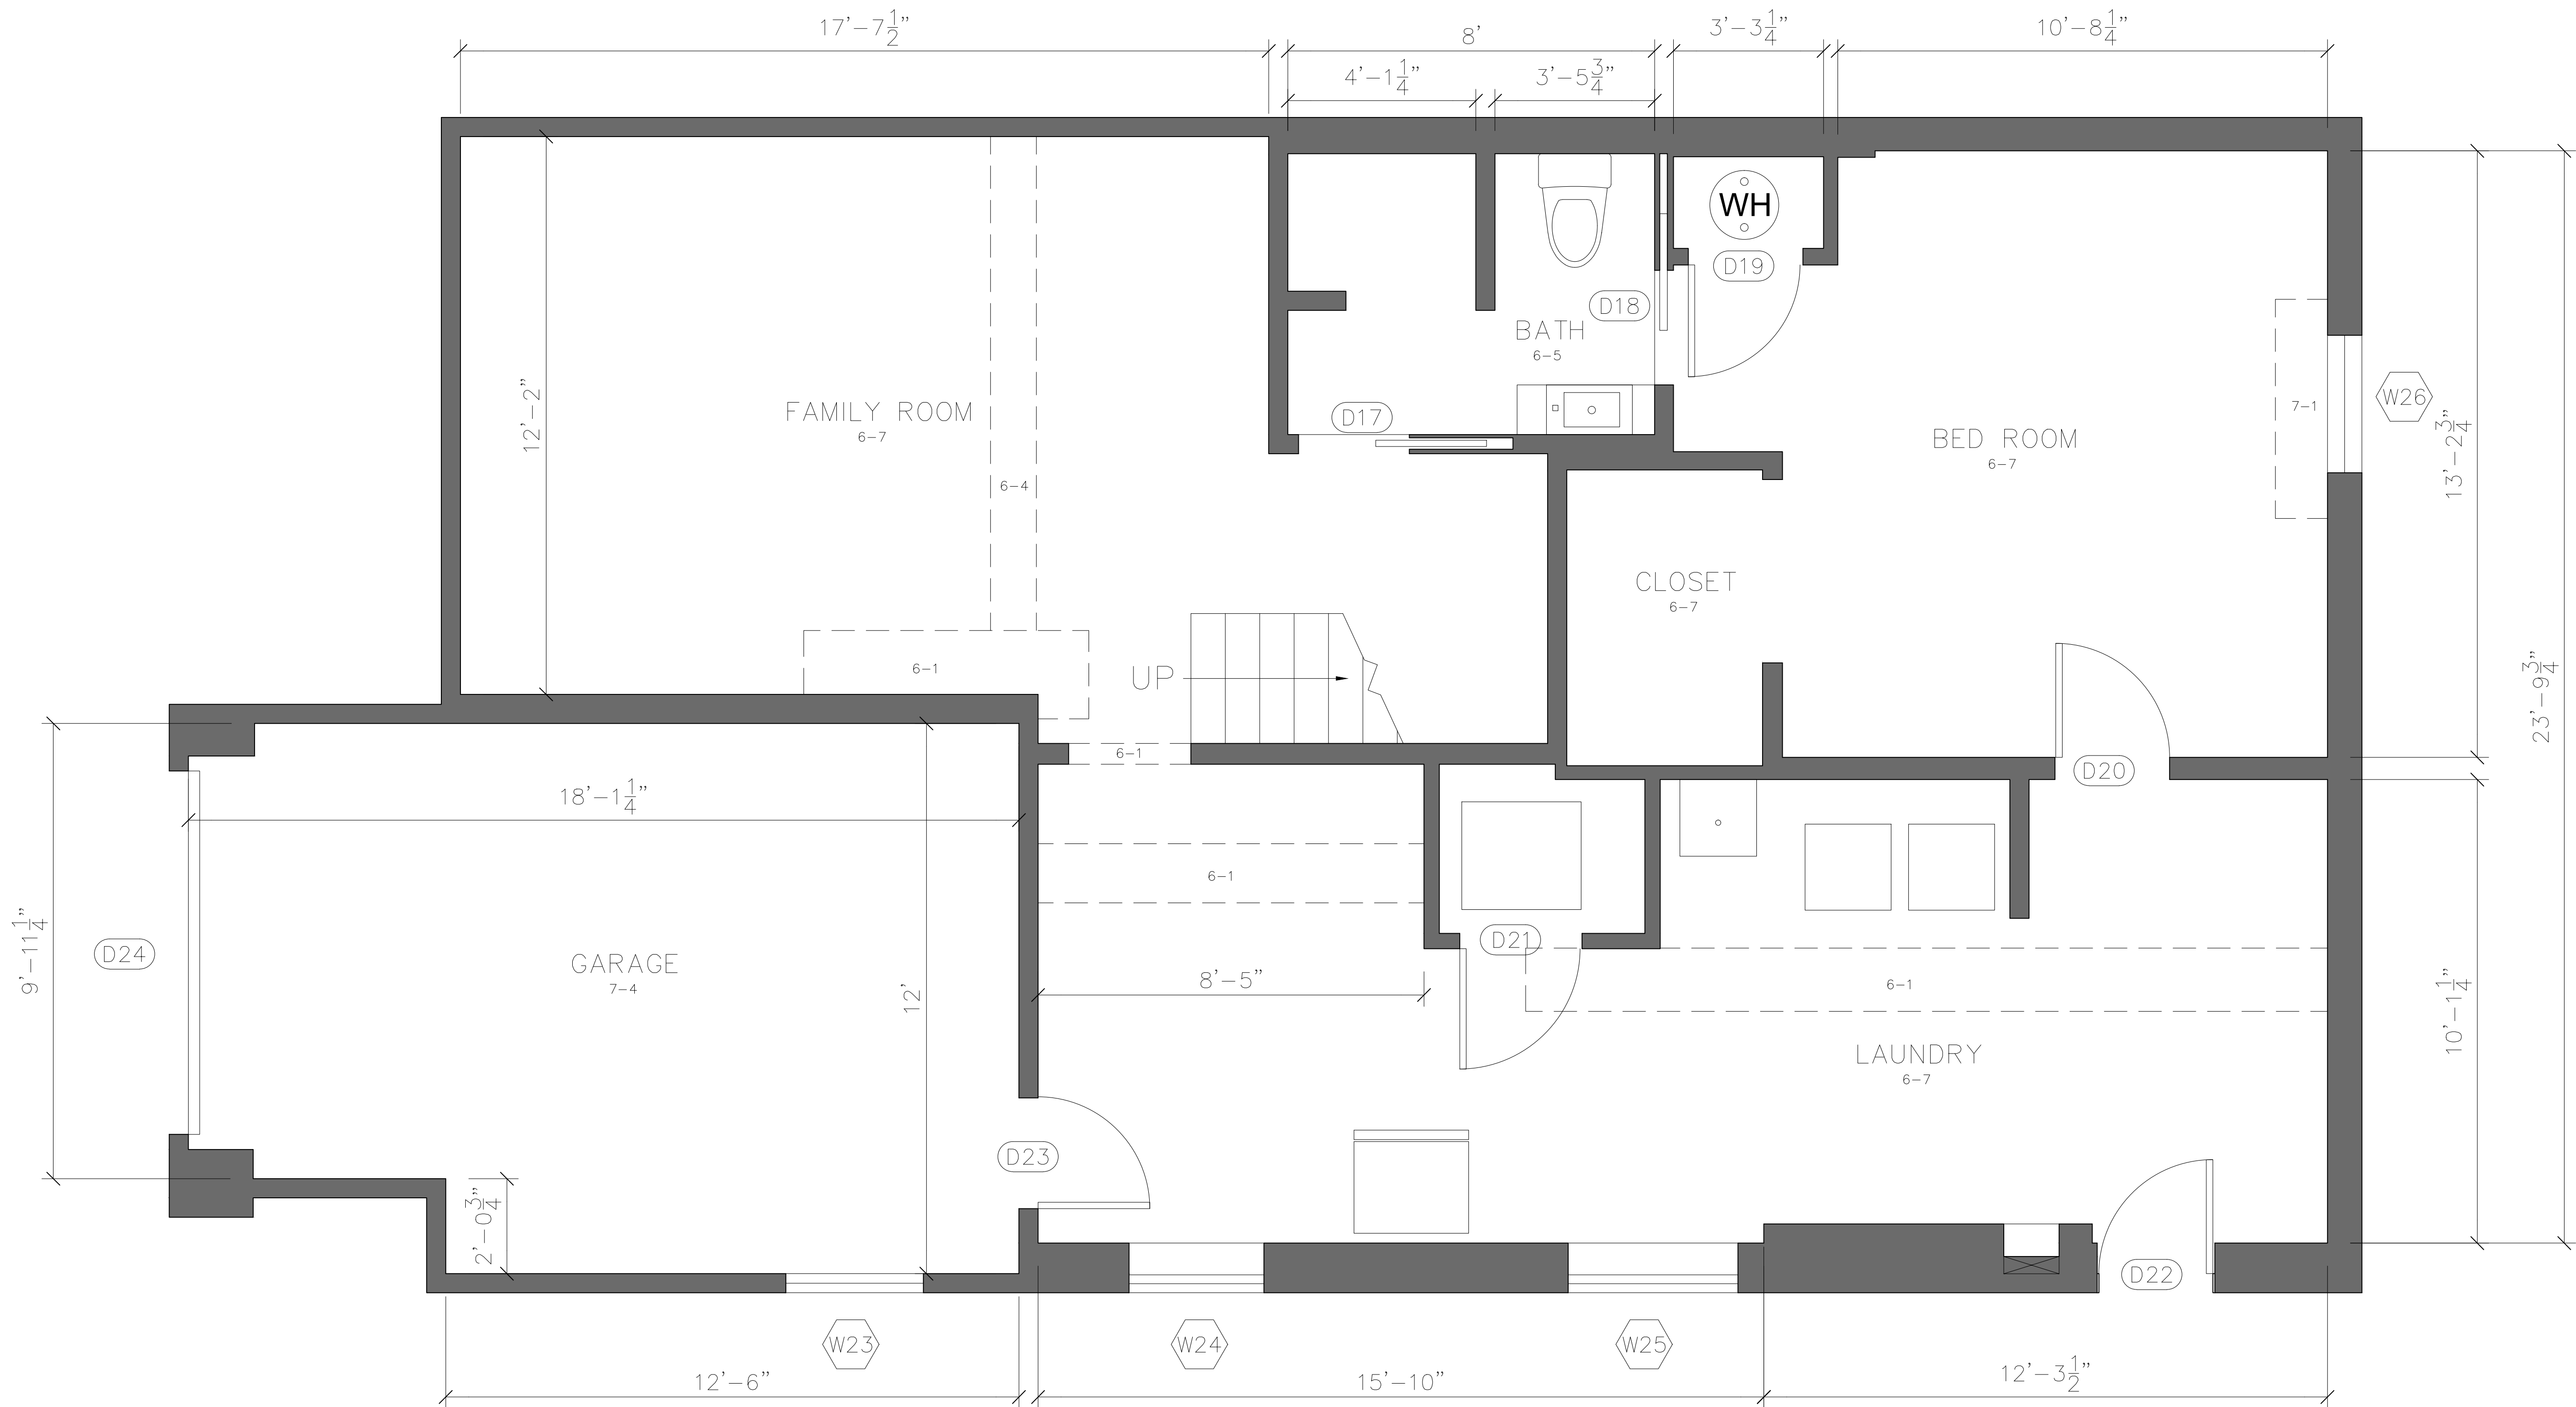

BASEMENT — PLAN

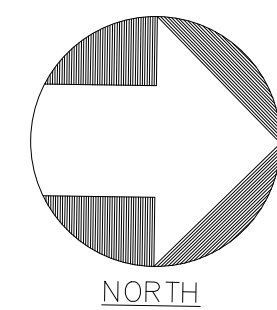

ARCHITECTURAL AS BUILT


SEATTLE, WA 98119

01 100% SUBMISSION
NO. ISSUES | REVISIONS DATE


**BASEMENT
FLOOR PLAN &
RCP**

HL PROJECT MANAGER
HL PROJECT DIRECTOR
? PROJECT NUMBER
1/2"=1'-0" SCALE
MM DRAWN BY
SHEET NUMBER

AB-1

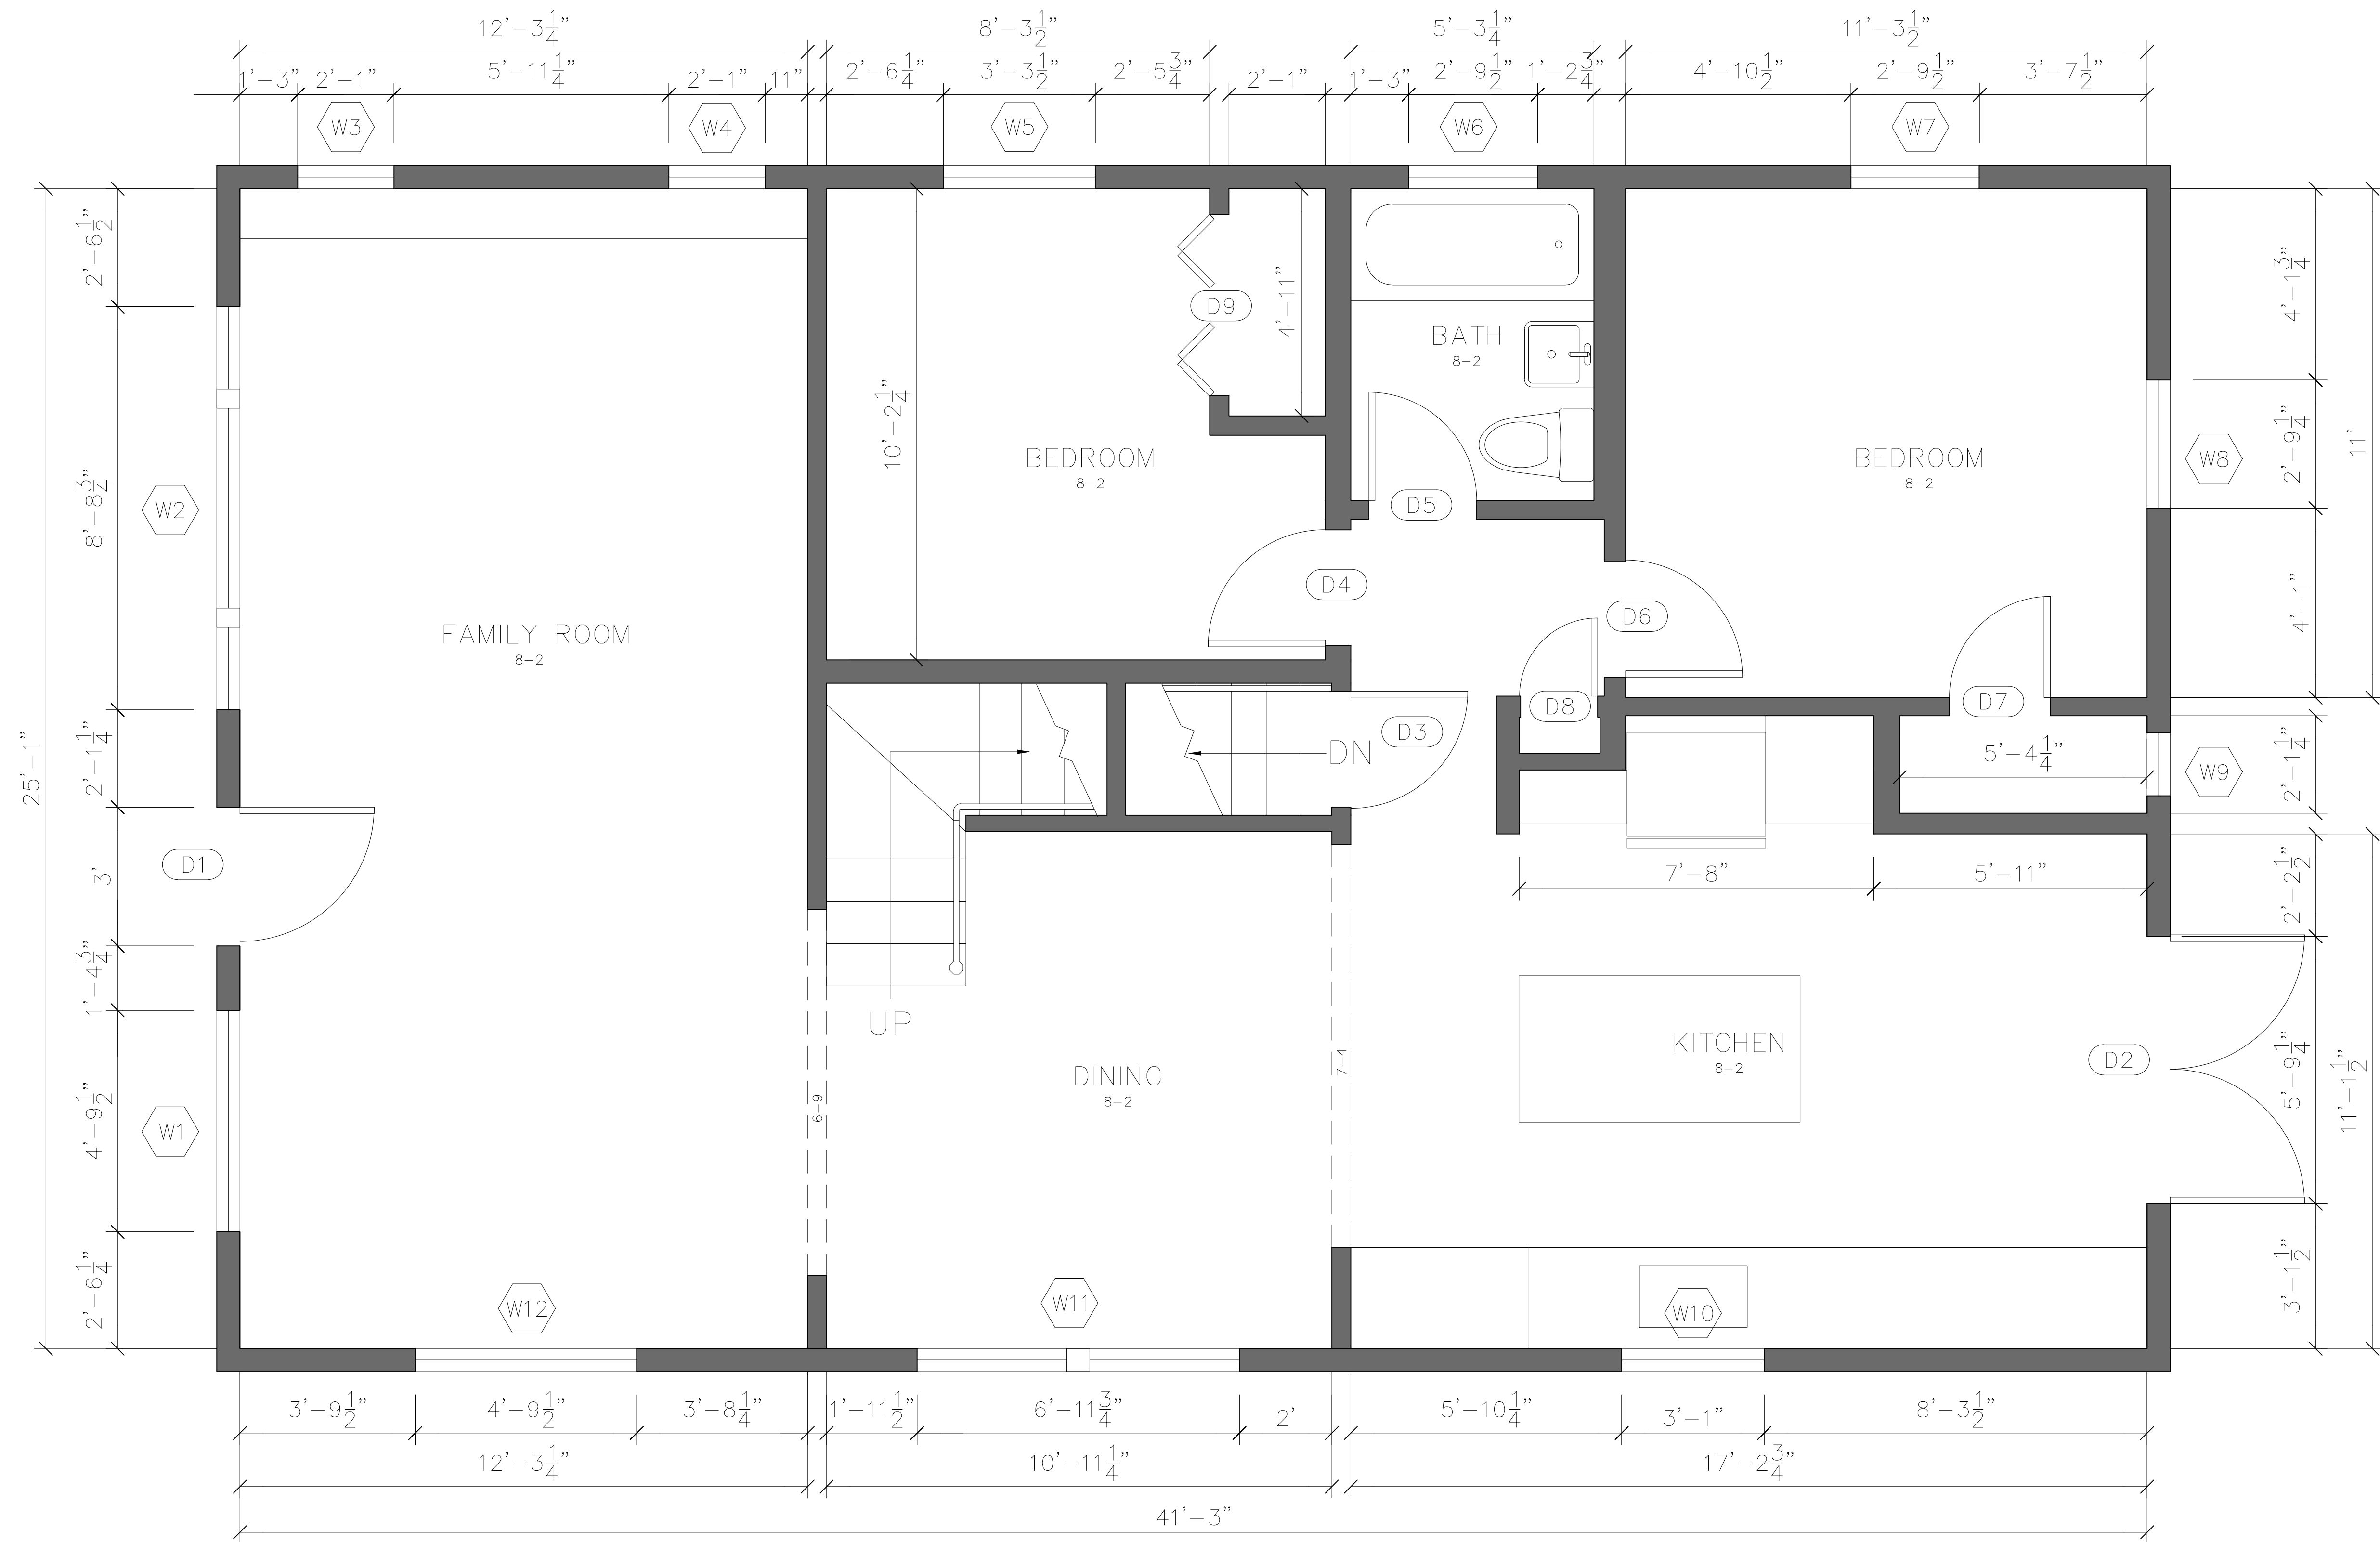

FIRST FLOOR – PLAN

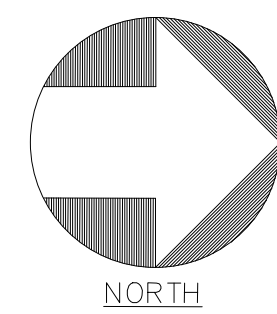

AS BUILT
PROFESSIONALS
www.asbuiltprofessionals.com
A DIVISION OF:


AEC
CONSULTANTS INC
844.272.8458
844 AS BUILT

© 2020 AEC CONSULTANTS INC.


ARCHITECTURAL AS BUILT
SEATTLE, WA 98119

01	100% SUBMISSION	
NO.	ISSUES REVISIONS	DATE
SHEET TITLE		
FIRST FLOOR PLAN & RCP		
HL	PROJECT MANAGER	
HL	PROJECT DIRECTOR	
?	PROJECT NUMBER	
1/2"=1'-0"		SCALE
MM	DRAWN BY	
SHEET NUMBER		

AB-2

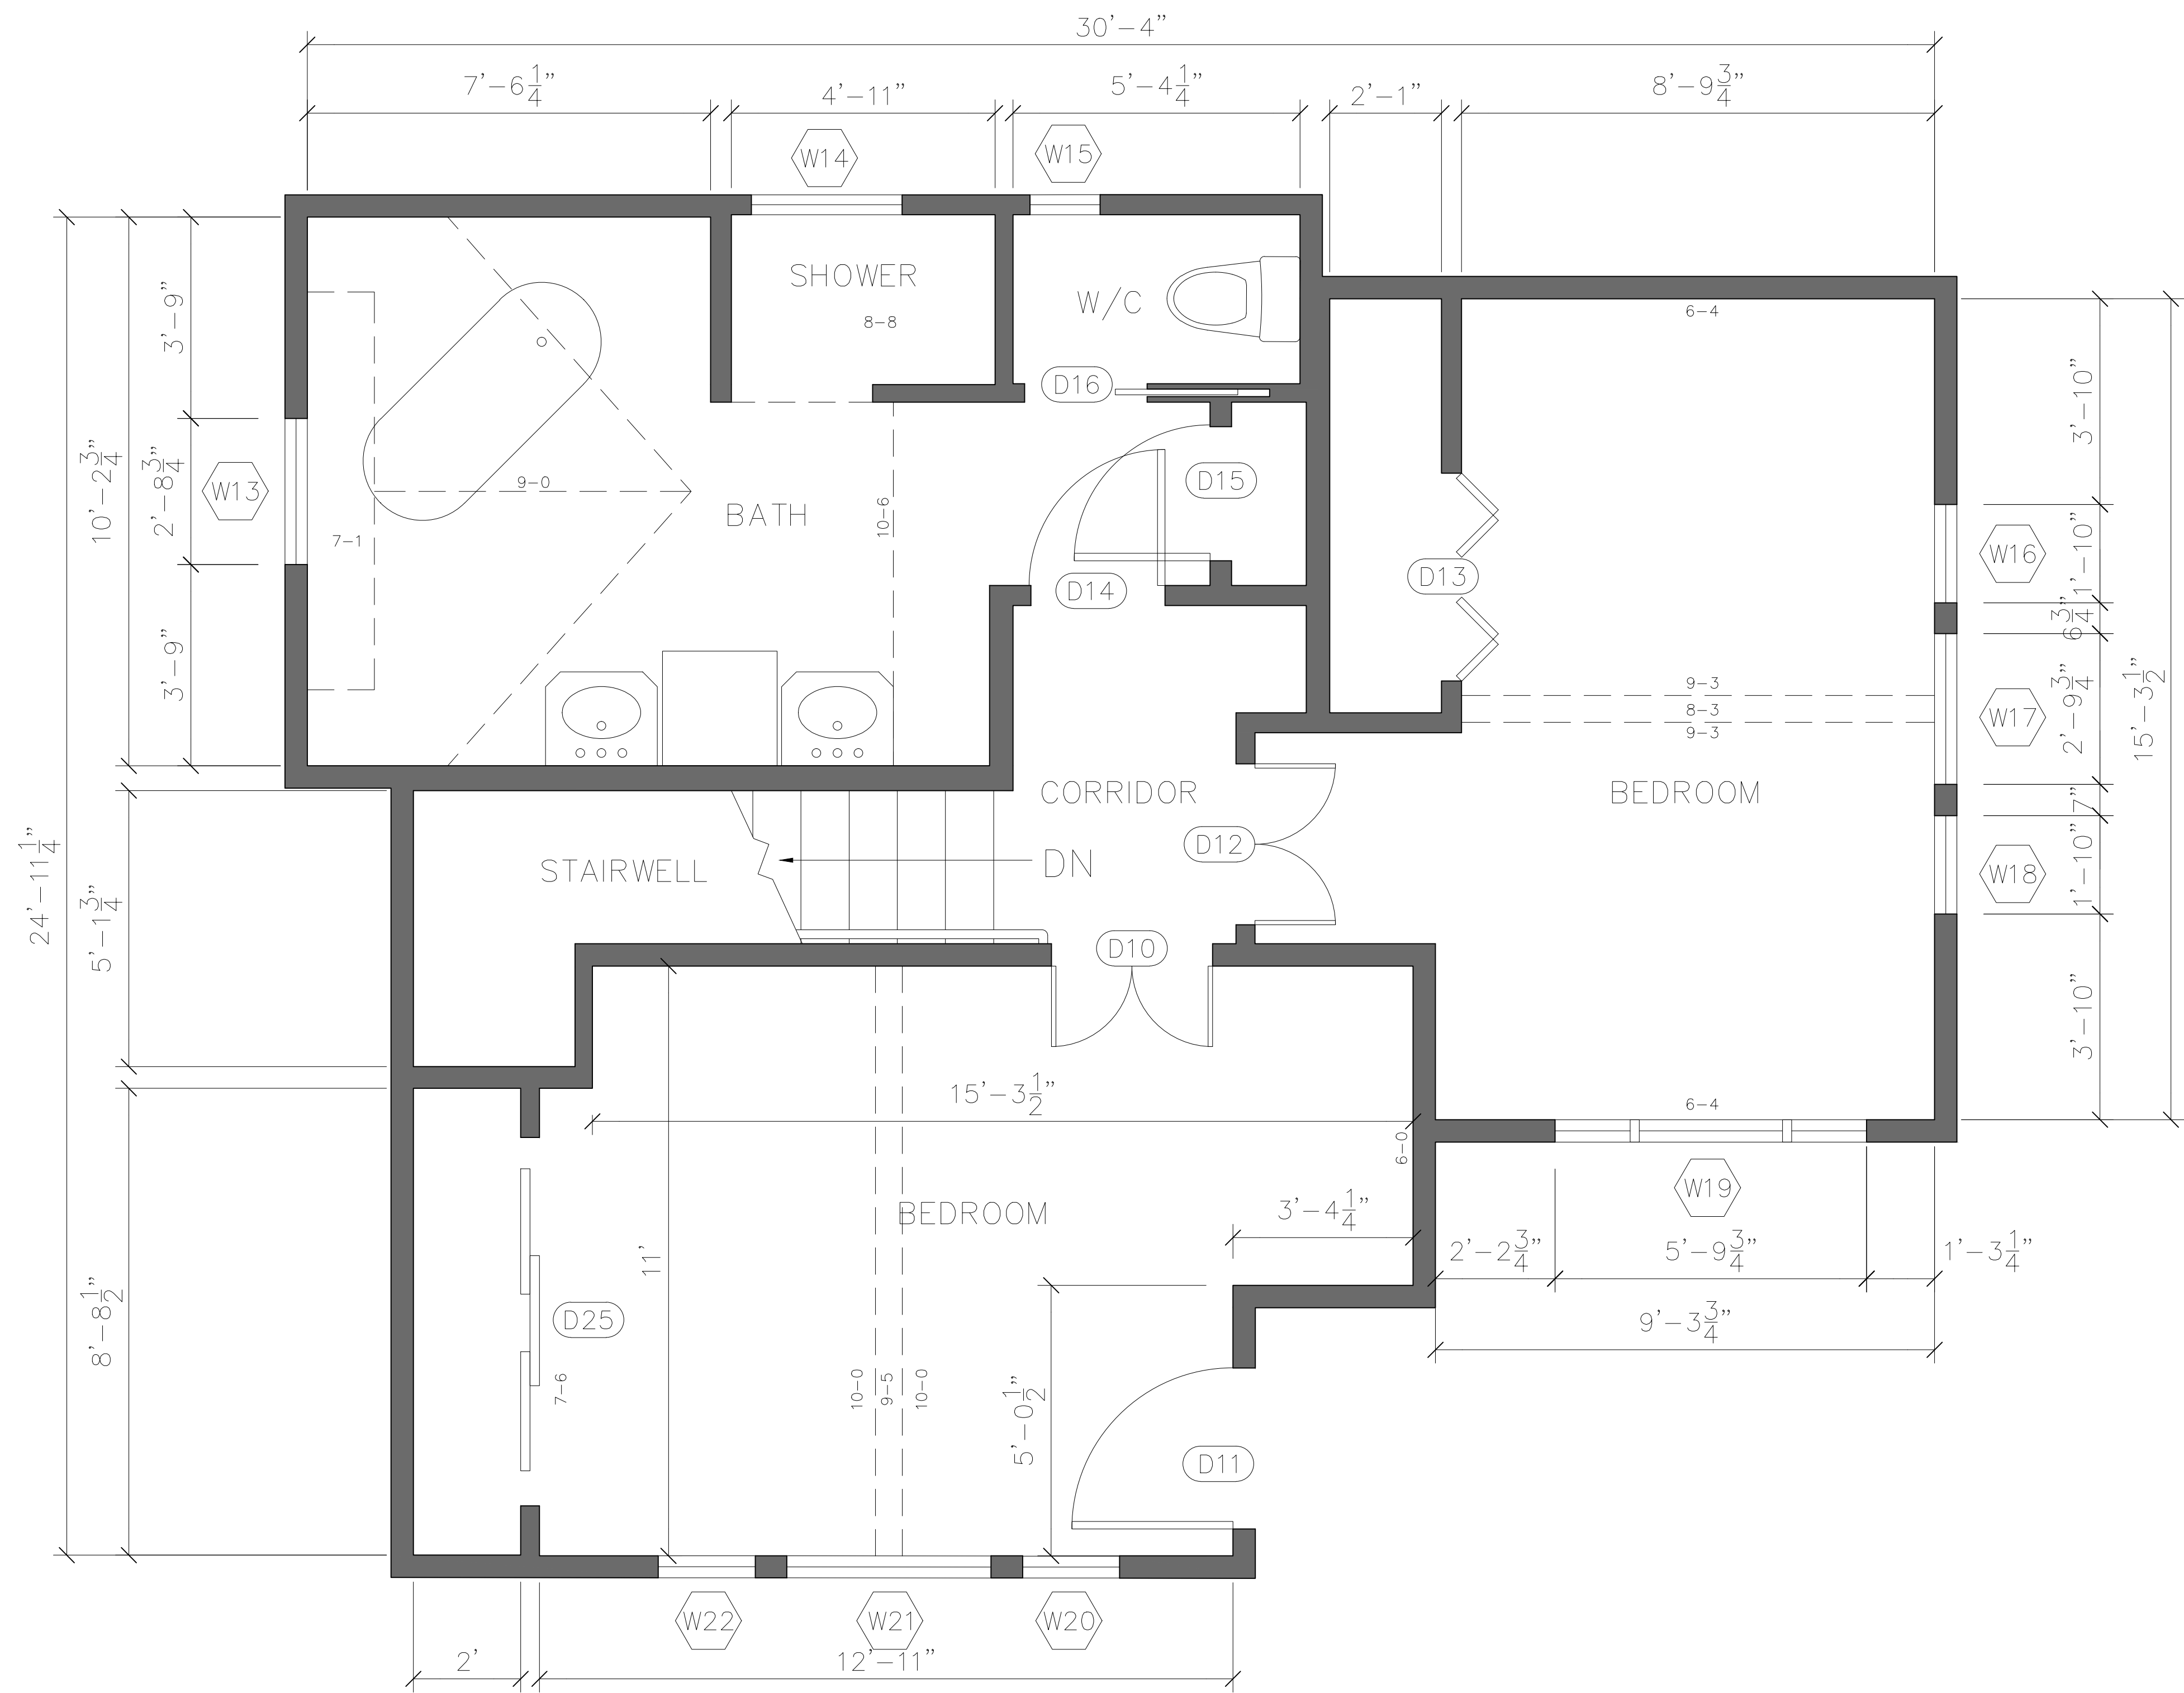

SECOND FLOOR — PLAN

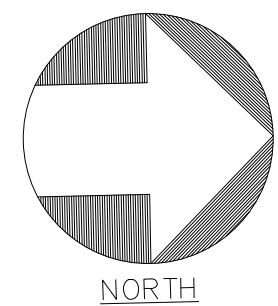

AS BUILT

PROFESSIONALS

www.asbuiltprofessionals.com

A DIVISION OF:

AEC

CONSULTANTS INC

844.272.8458

844 AS BUILT

© 2020 AEC CONSULTANTS INC

ARCHITECTURAL AS BUILT

SEATTLE, WA 98119

01	100% SUBMISSION	
NO.	ISSUES REVISIONS	DATE
SHEET TITLE		
SECOND FLOOR PLAN & RCP		
HL	PROJECT MANAGER	
HL	PROJECT DIRECTOR	
?	PROJECT NUMBER	
1/2"=1'-0"		SCALE
MM	DRAWN BY	
AB-3		SHEET NUMBER

Window Schedule

Window	Width	Height	Sill Height	Top Trim	Left Trim	Right Trim	Bottom Trim
W1	4'-9.5"	4'-8.5"	2'-2"	4.5"	4.5"	4.5"	4.75"
W2	8'-8.5"	4'-8.5"	2'-2"	4.5"	4.5"	4.5"	4.75"
W3	2'-1"	1'-11.4"	4'-11"	4.5"	4.5"	4.5"	1"
W4	2'-1"	1'-11.4"	4'-11"	4.5"	4.5"	4.5"	1"
W5	3'-3.4"	4'-8.3"	2'-0"	4.5"	4.5"	4.5"	4.75"
W6	2'-9.5"	2'-10.4"	3'-10.8"	4.5"	4.5"	4.5"	1"
W7	2'-9.4"	4'-8.8"	2'-0"	4.5"	4.5"	4.5"	4.75"
W8	2'-9.5"	4'-8.8"	2'-0"	4.5"	4.5"	4.5"	4.75"
W9	1'-3.4"	2'-10.5"	3'-11"	4.5"	4.5"	4.5"	4.75"
W10	3'-0"	2'-9"	4'-1"	4.5"	4.5"	4.5"	4.75"
W11	7'-0.5"	4'-8.4"	2'-2"	4.5"	4.5"	4.5"	4.75"
W12	4'-9.5"	4'-8.5"	2'-2"	4.5"	4.5"	4.5"	4.75"
W13	2'-10"	1'-4"	5'-6"	2.5"	2.5"	2.5"	2.5"
W14	2'-9.7"	9.5"	7'-0"	2.5"	2.5"	2.5"	2.5"
W15	1'-4"	2'-9"	3'-10"	2.5"	2.5"	2.5"	2.5"
W16	1'-9.3"	3'-9.8"	2'-0"	2.5"	2.5"	2.5"	2.5"
W17	2'-9"	3'-9.8"	2'-0"	2.5"	2.5"	2.5"	2.5"
W18	1'-9.3"	3'-9.8"	2'-0"	2.5"	2.5"	2.5"	2.5"
W19	5'-10"	3'-4"	3'-1"	2.5"	2.5"	2.5"	2.5"
W20	1'-10"	3'-9.7"	2'-10"	2.5"	2.5"	2.5"	2.5"
W21	3'-9.8"	3'-9.7"	2'-10"	2.5"	2.5"	2.5"	2.5"
W22	1'-10"	3'-9.7"	2'-10"	2.5"	2.5"	2.5"	2.5"
W23	3'-1"	3'-5"	3'-9.8"	N/A	N/A	N/A	N/A
W24	2'-11.25"	3'-4.5"	3'-0"	N/A	N/A	N/A	N/A
W25	3'-8"	2'-4.8"	3'-9.4"	N/A	N/A	N/A	N/A
W26	2'-11.4"	2'-2"	4'-8"	N/A	N/A	N/A	4.5"

Door Schedule

Door	Leaf Width	Leaf Height	Trim Int. Ht	Trim Int Wd	Left Trim	Right Trim	Top Trim
D1	3'-0"	6'-9"	6'-10"	3'-0"	4.5"	4.5"	4.5"
D2	2'-10"	6'-7"	6'-9.4"	5'-9.4"	4.5"	4.5"	4.5"
D3	2'-6"	6'-7"	6'-8"	2'-6"	4.5"	4.5"	4.5"
D4	2'-6"	6'-7"	6'-8"	2'-6"	4.5"	4.5"	4.5"
D5	2'-4"	6'-7"	6'-8"	2'-6"	4.5"	4.5"	4.5"
D6	2'-6"	6'-7"	6'-8"	2'-6"	4.5"	4.5"	4.5"
D7	2'-2"	6'-7"	6'-8"	2'-6"	4.5"	4.5"	4.5"
D8	1'-8"	6'-7"	6'-8"	2'-6"	4.5"	4.5"	4.5"
D9	11.25"	6'-7"	6'-8"	3'-11"	4.5"	4.5"	4.5"
D10	1'-6"	6'-8"	6'-9"	3'-0"	2.5"	2.5"	2.5"
D11	3'-0"	6'-8"	6'-9"	3'-0"	2.5"	2.5"	2.5"
D12	1'-6"	6'-8"	6'-9"	3'-0"	2.5"	2.5"	2.5"
D13	11.25"	6'-7"	6'-8"	3'-11"	4.5"	4.5"	4.5"
D14	2'-6"	6'-8"	6'-9"	2'-6"	2.5"	2.5"	2.5"
D15	2'-5"	6'-7"	6'-8"	2'-5"	2.5"	2.5"	2.5"
D16	2'-3"	6'-7"	6'-8"	2'-3"	2.5"	2.5"	2.5"
D17	2'-8"	6'-1.5"	n/a	n/a	n/a	n/a	n/a
D18	2'-5"	6'-1.8	n/a	n/a	n/a	n/a	n/a
D19	2'-6"	6'-5"	n/a	n/a	n/a	n/a	n/a
D20	2'-6"	6'-1"	n/a	n/a	n/a	n/a	n/a
D21	2'-8"	6'-7.4"	n/a	n/a	n/a	n/a	n/a
D22	2'-6"	6'-0"	n/a	n/a	n/a	n/a	n/a
D23	2'-6"	6'-0"	6'-1"	2'-6"	3.8"	3.8"	4"
D24	7'-9"	6'-10"	n/a	n/a	n/a	n/a	n/a
D25	3'-0"	6'-8"	6'-9"	6'-10.4"	2.5"	2.5"	2.5"

ARCHITECTURAL AS BUILT

SEATTLE, WA 98119

01	100% SUBMISSION	
NO.	ISSUES REVISIONS	DATE
		SHEET TITLE
DOOR & WINDOW SCHEDULES		
HL	PROJECT MANAGER	
HL	PROJECT DIRECTOR	
?	PROJECT NUMBER	
1/2"=1'-0"		SCALE
MM	DRAWN BY	
		SHEET NUMBER