




© 2020 AEC CONSULTANTS INC

ARCHITECTURAL AS BUILT

SEATTLE, WA 98177

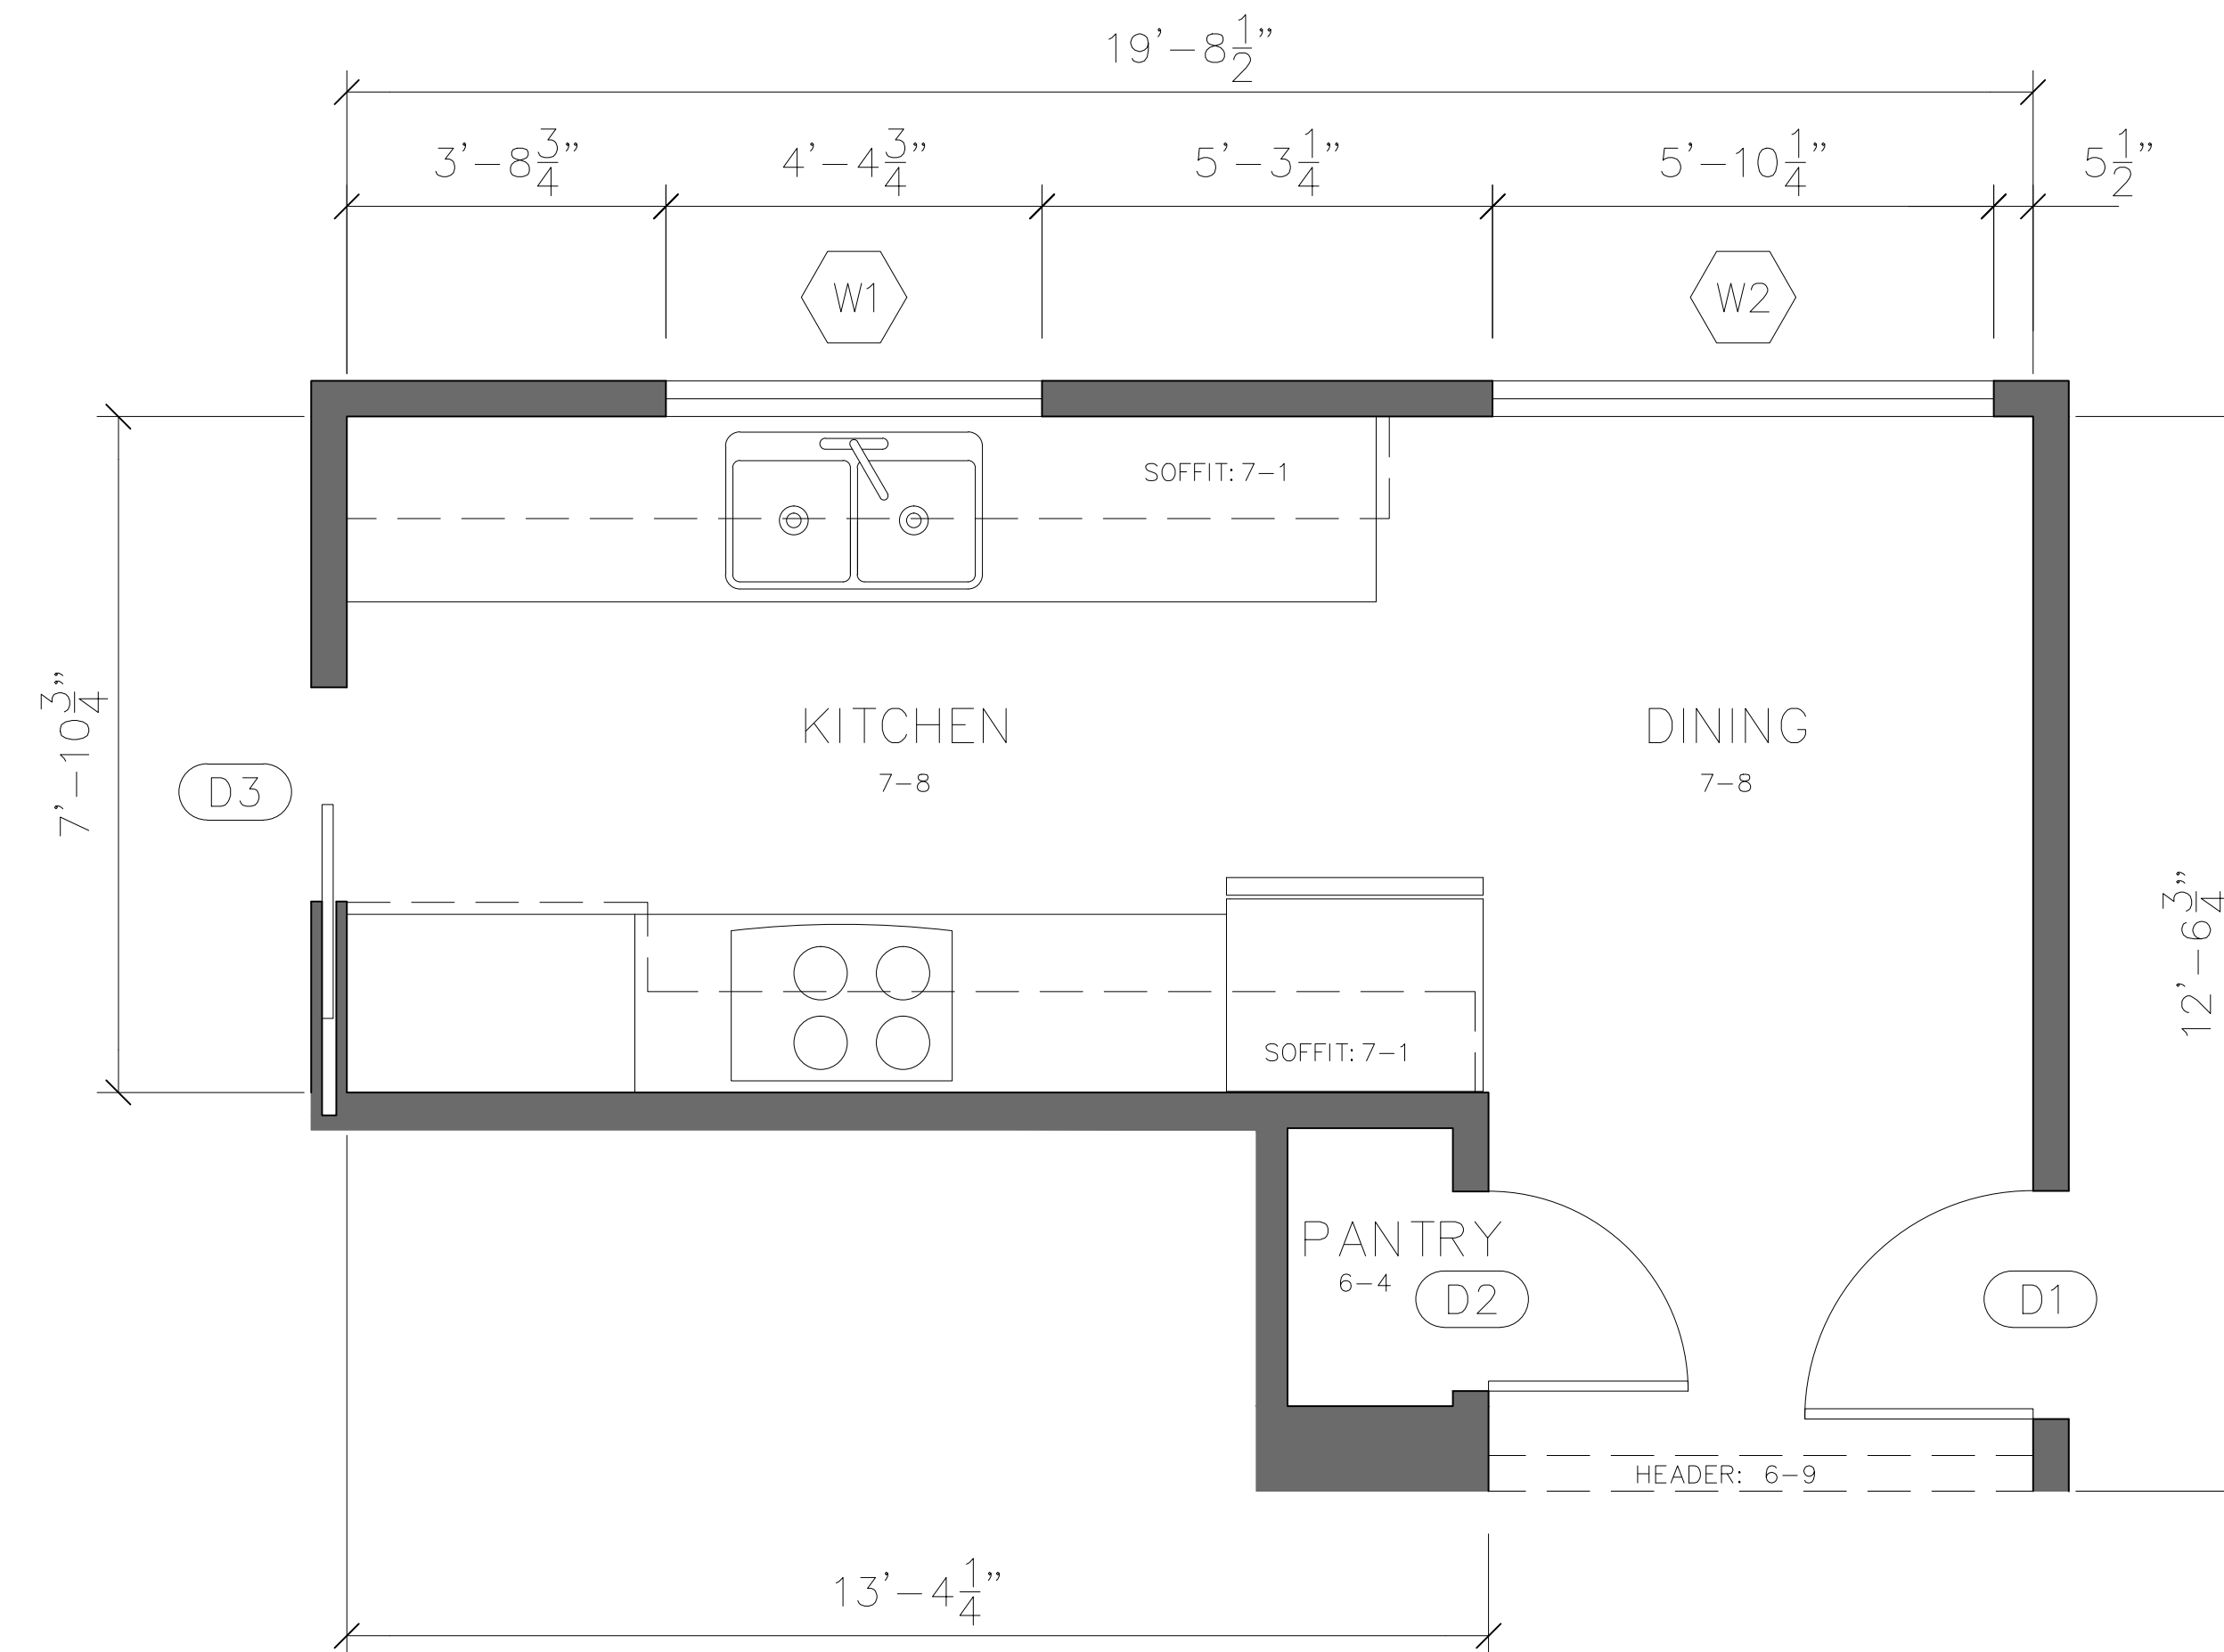


Door Schedule

Door	Leaf Width	Leaf Height	Left Trim	Right Trim	Top Trim	Notes
D1	2'-8"	6'-8"	2"	2"	2"	
D2	2'-4"	6'-8"	2"	2"	2"	
D3	2'-5.8"	6'-7.2"	2"	2"	2"	pocket door

Window Schedule

Window	Width	Height	Sill Height	Left Trim	Right Trim	Top Trim	Btm Trim	Notes
W1	4'-5"	2'-10.8"	3'-9"	2.2"	2.2"	2.2"	0.75"	
W2	5'-10.25"	4'-0"	2'-9"	2.5"	2.5"	2.5"	2.75"	

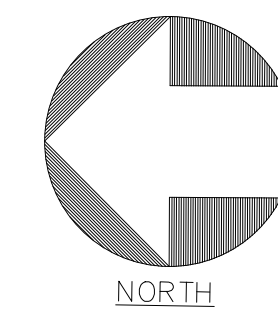

01	100% SUBMISSION	
NO.	ISSUES REVISIONS	DATE
		SHEET TITLE
FLOOR PLAN & SCHEDULES		
HL		PROJECT MANAGER
HL		PROJECT DIRECTOR
?		PROJECT NUMBER
1/2"=1'-0"		SCALE
MM		DRAWN BY
		SHEET NUMBER

AB-1