

# AS-BUILT DOCUMENTATION


## SEATTLE, WA 98122



### 100% SUBMITTAL

### DRAWING INDEX

- C-1 COVER SHEET | DRAWING INDEX
- AB-1 FLOOR PLANS AND SCHEDULES

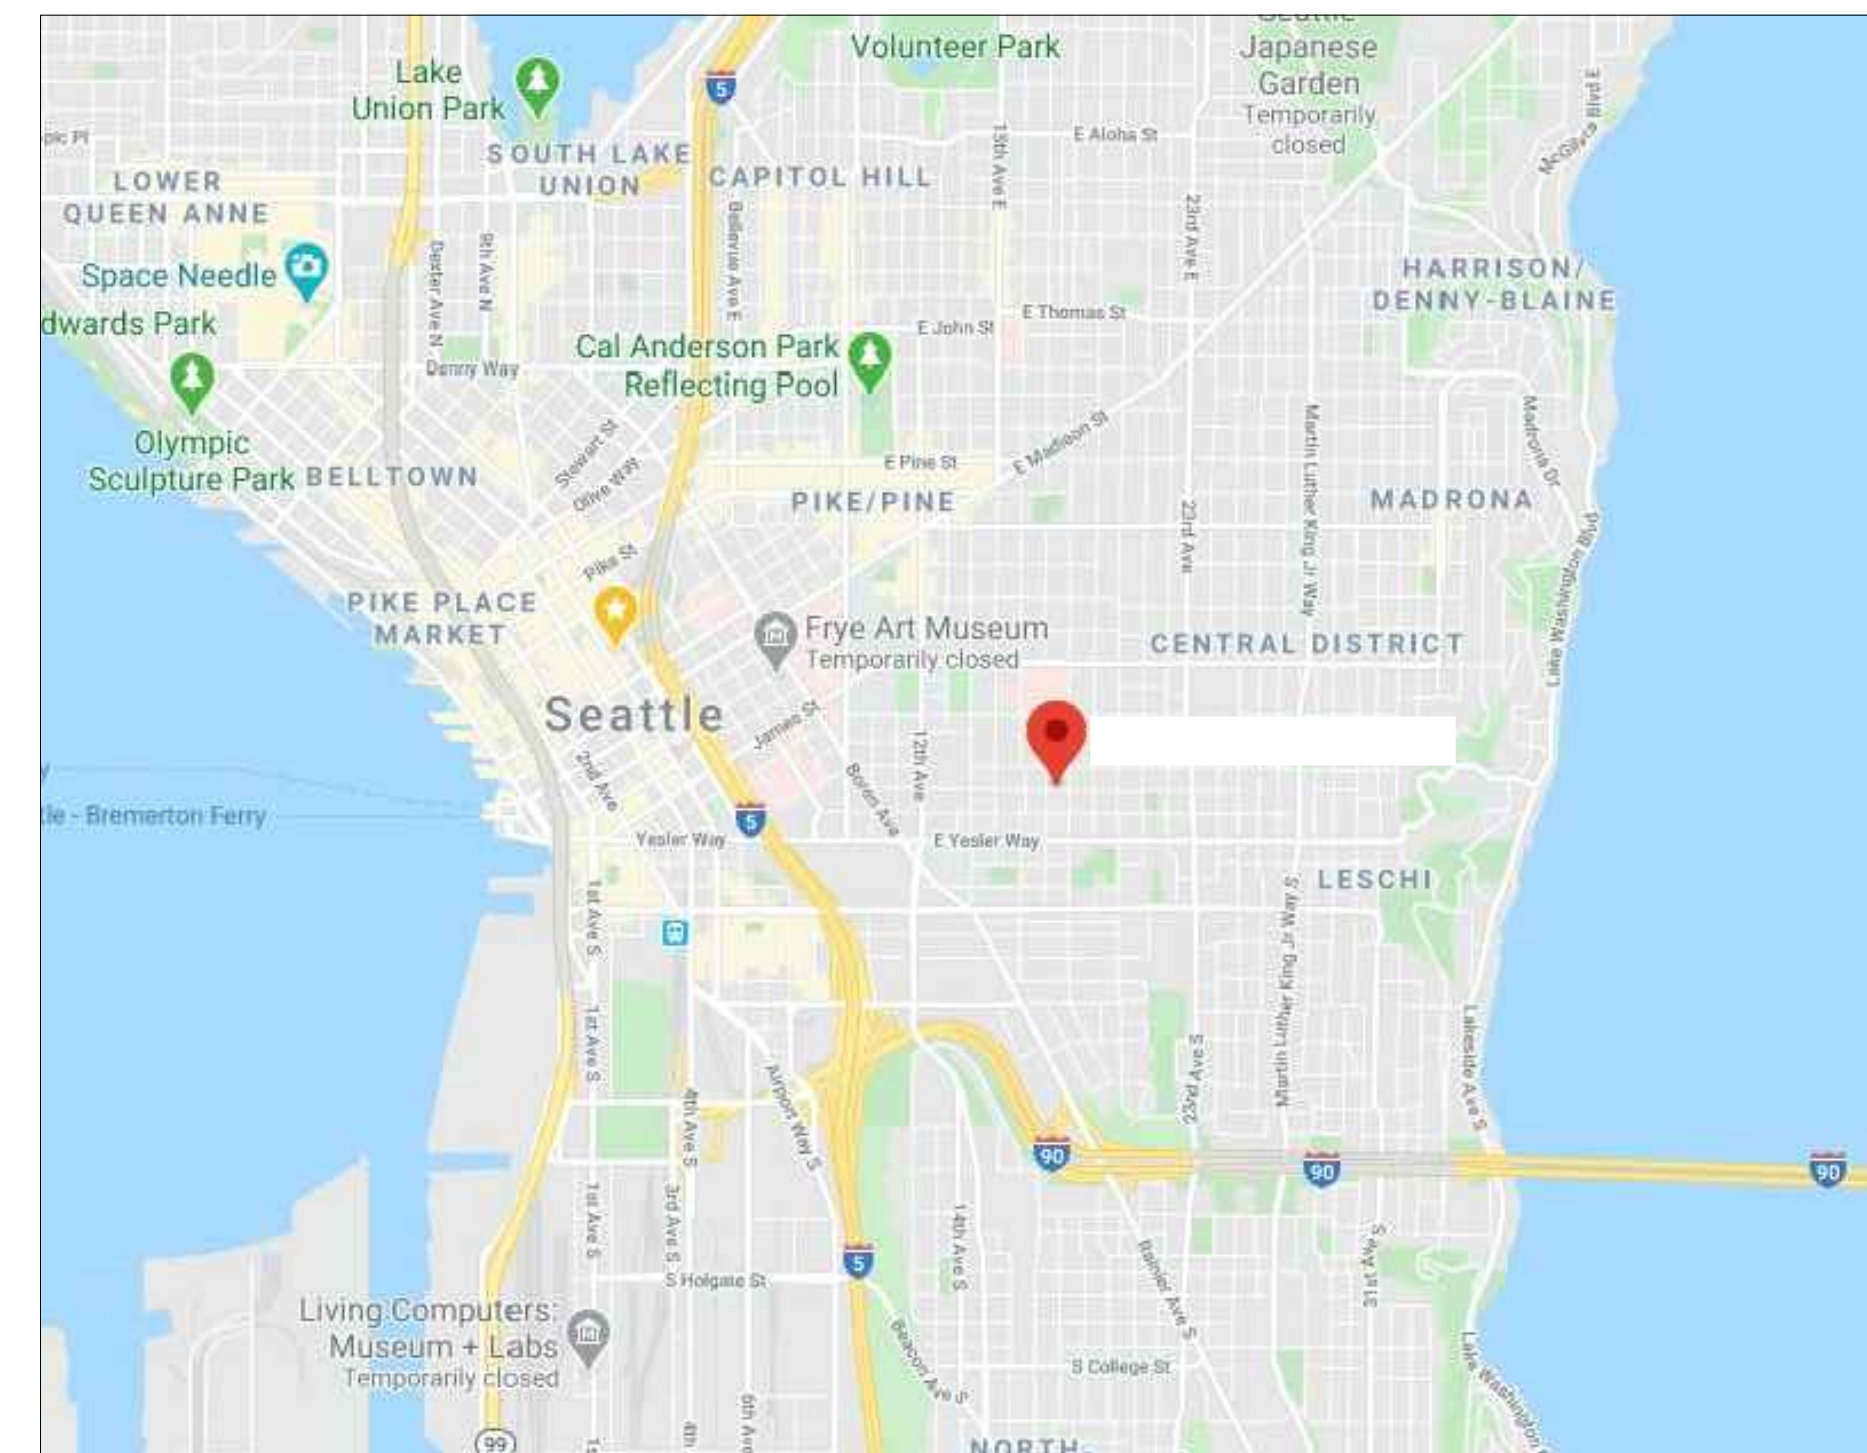

VICINITY MAP  
NTS

AREA DATA	
FIRST FLOOR	752 S.F. ±
SECOND FLOOR	710 S.F. ±
ATTIC	526 S.F. ±
<b>GRAND TOTAL</b>	<b>1,988 S.F. ±</b>

**AS BUILT**  
PROFESSIONALS  
www.asbuiltprofessionals.com  
A DIVISION OF:

**AEC**  
CONSULTANTS INC

844.272.8458  
844 ASBUILT

© 2020 AEC CONSULTANTS INC

**ARCHITECTURAL AS BUILT**

**SEATTLE, WA 98122**

NO.	ISSUES   REVISIONS	DATE

SHEET TITLE

**COVER SHEET**

HL	PROJECT MANAGER
HL	PROJECT DIRECTOR
?	PROJECT NUMBER
	SCALE
MM	DRAWN BY
	SHEET NUMBER

**C-1**




844.272.8458  
844 ASBUILT


© 2020 AEC CONSULTANTS INC

**ARCHITECTURAL AS BUILT**

**SEATTLE, WA 98122**

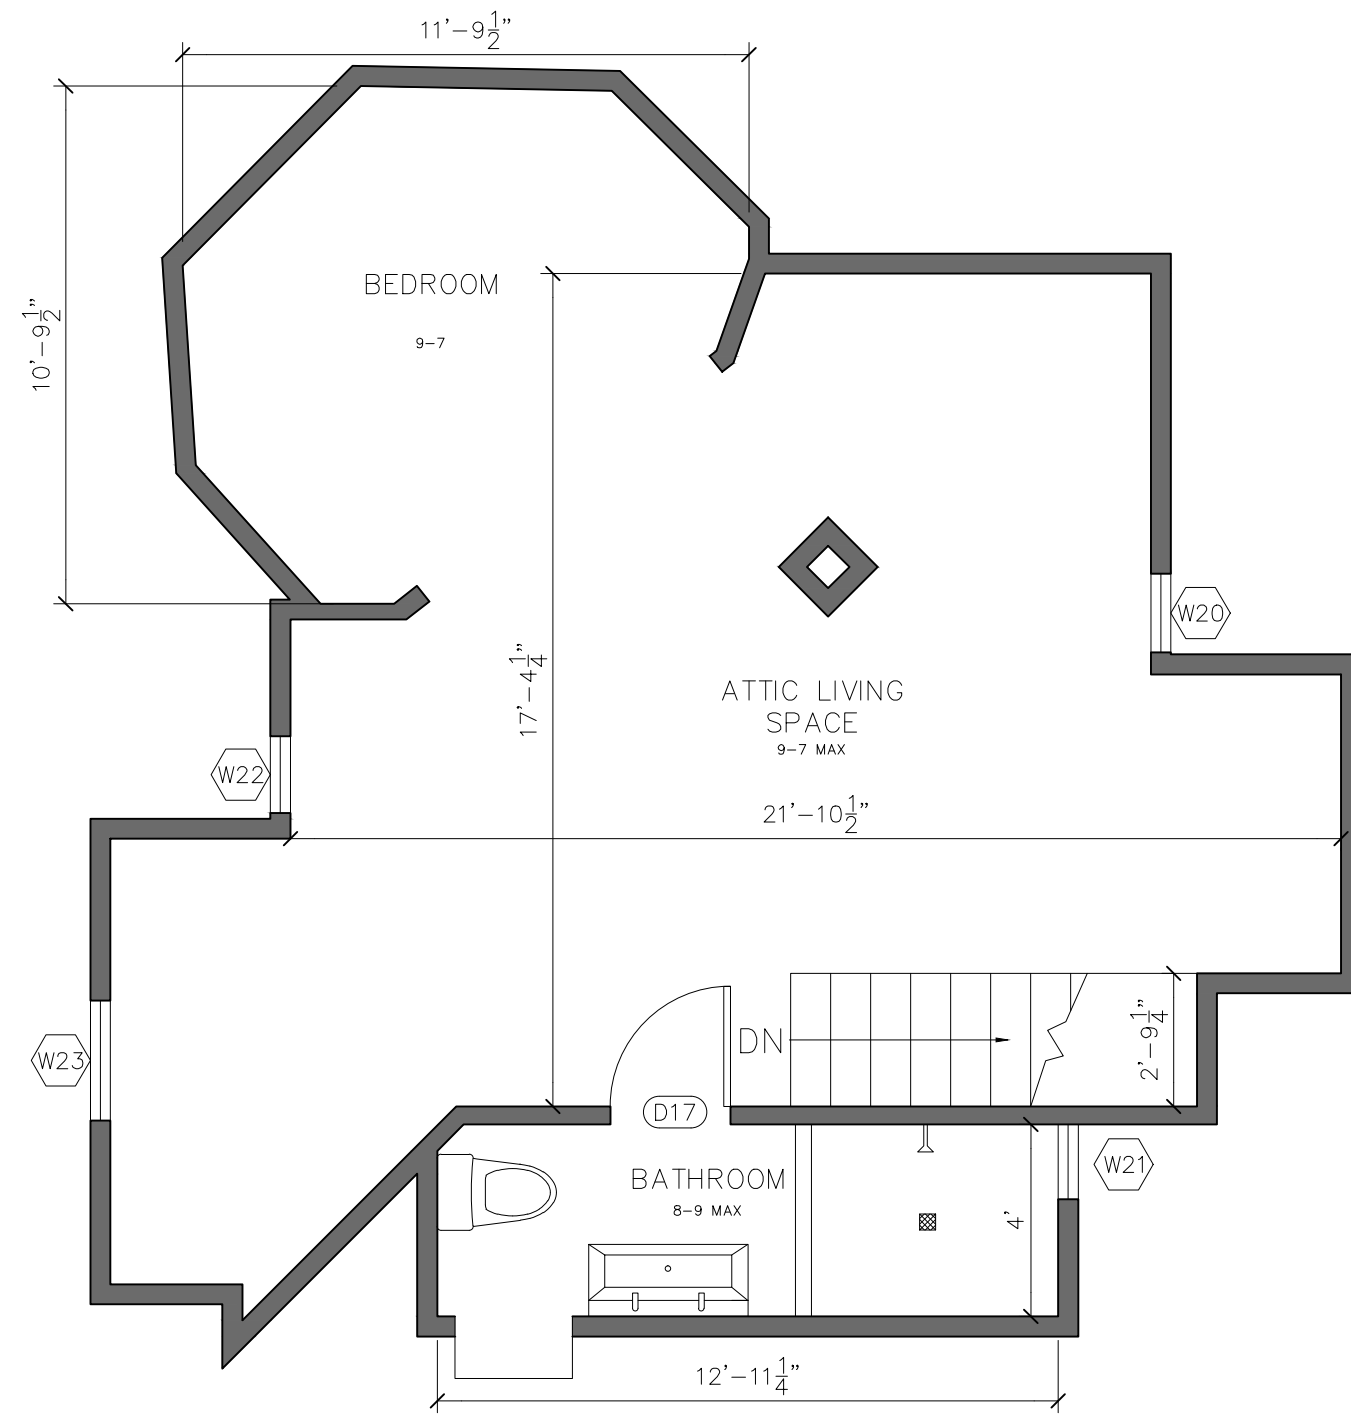

ATTIC - PLAN

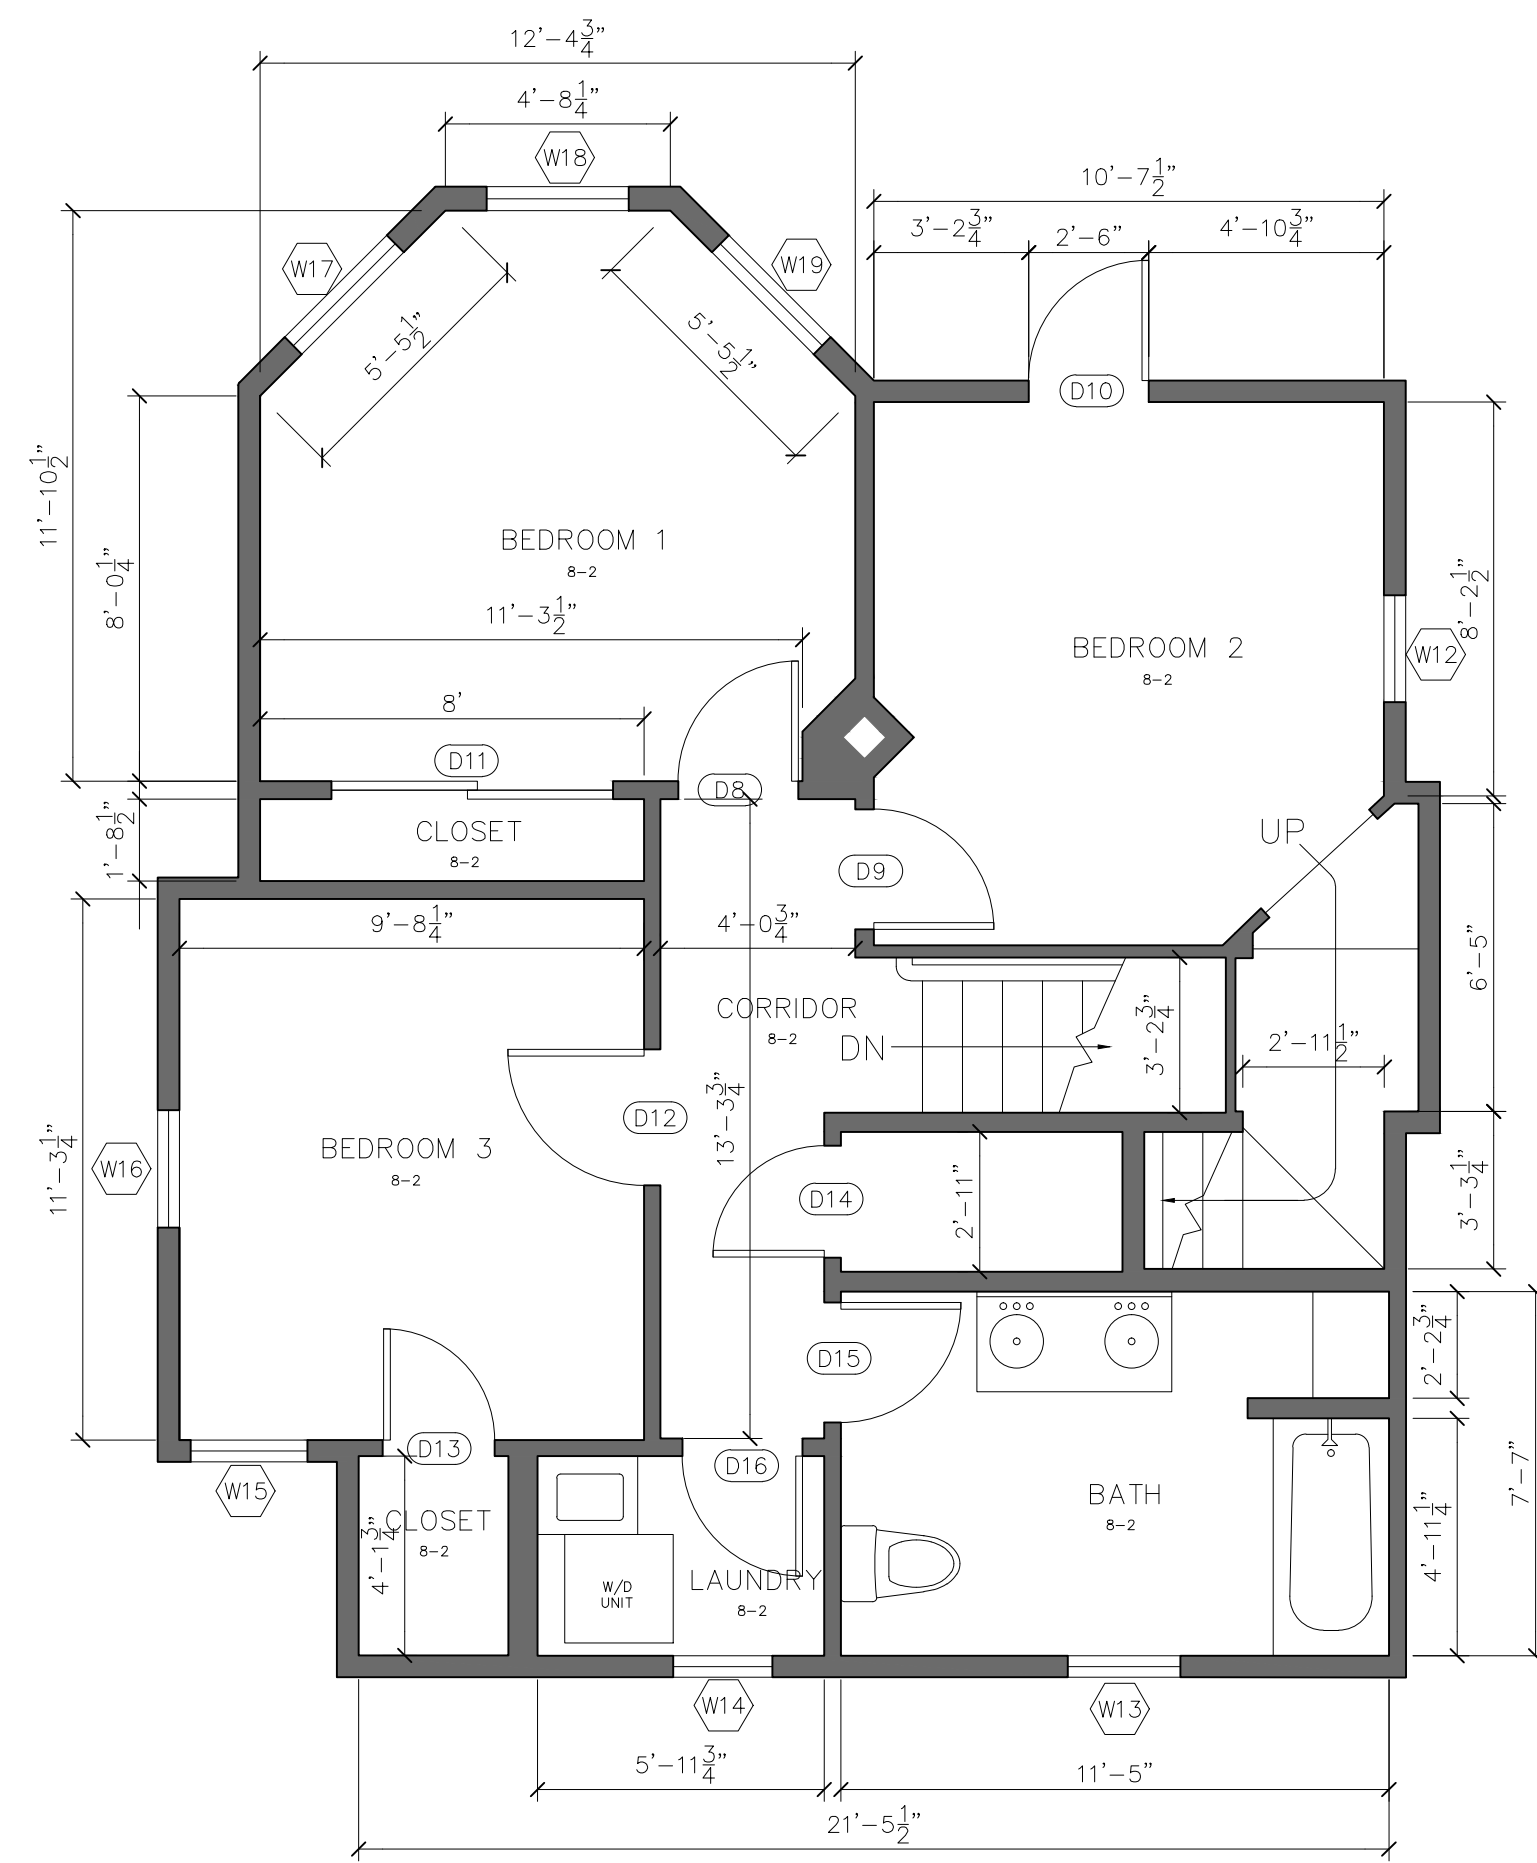


SECOND FLOOR - PLAN

**Door Schedule**


Door	Leaf Width	Leaf Height	Trim Int. Ht	Trim Width	Left Trim	Right Trim	Top Trim	Notes
D1	3'-0"	6'-8"	8'-0"	3'-0"	4.5"	4.5"	6"	2'-5"X5'-0" LITE
D2	4'-0"	7'-6"	7'-6"	4'-0"	4.5"	4.5"	6"	
D3	2'-9"	7'-6"	7'-6"	5'-6"	4.5"	4.5"	6"	POCKET DOOR
D4	2'-9"	7'-6"	7'-6"	5'-6"	4.5"	4.5"	6"	POCKET DOOR
D5	2'-6"	6'-6"	6'-8"	2'-6"	4.5"	4.5"	6"	
D6	2'-0"	6'-7"	6'-8"	2'-0"	4.5"	4.5"	6"	
D7	2'-8"	6'-8"	6'-9"	2'-8"	4.5"	4.5"	6"	
D8	2'-6"	6'-6"	6'-7"	2'-0.5"	4.5"	4.5"	6"	
D9	2'-6"	6'-6"	6'-7"	2'-6"	4"	4.5"	6"	
D10	2'-6"	6'-6"	6'-7"	2'-6"	4.5"	4.5"	6"	
D11	3'-0"	6'-8"	6'-8"	5'-10.5"	4.5"	4.5"	6"	
D12	2'-10"	6'-6"	6'-7"	2'-10"	4"	4.5"	6"	
D13	2'-4"	6'-6"	6'-7"	2'-6"	4"	4.5"	6"	
D14	2'-4"	6'-6"	6'-7"	2'-6"	4"	4.5"	6"	
D15	2'-6"	6'-6"	6'-7"	2'-6"	4.5"	4.5"	6"	
D16	2'-6"	6'-6"	6'-7"	2'-6"	4.5"	4.5"	6"	
D17	2'-6"	6'-6"	6'-7"	2'-6"	4"	4.5"	6"	

**Window Schedule**

Window	Width	Height	Sill Height	Left Trim	Right Trim	Top Trim	Btm Trim	Notes
W1	2'-4.5"	3'-5.5"	4'-3.7"	4.5"	4.5"	6"	3"	
W2	2'-5.13"	5'-2.5"	1'-4.7"	4.5"	4.5"	6"	3"	
W3	2'-9.65"	4'-11"	3'-3"	4.5"	4.5"	6"	0.5"	
W4	2'-10.67"	2'-10.4"	3'-0.5"	4.5"	4.5"	6"	3"	
W5	1'-10.5"	1'-10.4"	4'-5.7"	4.5"	4.5"	6"	3"	
W6	2'-1"	5'-8.8"	1'-9"	4.5"	4.5"	6"	3"	
W7	3'-3"	5'-8.8"	1'-9"	4.5"	4.5"	6"	3"	
W8	2'-1"	5'-8.8"	1'-9"	4.5"	4.5"	6"	3"	
W9	2'-4"	5'-8.6"	1'-9"	4.5"	4.5"	6"	3"	
W10	4'-6.8"	5'-8.6"	1'-9"	4.5"	4.5"	6"	3"	
W11	3'-0"	1'-3"	6'-9.5"	4.5"	4.5"	6"	1.5"	transom
W12	2'-2.8"	2'-6"	1'-11"	4.5"	4.5"	6"	3"	
W13	2'-4"	5'-1"	1'-5.2"	4.5"	4.5"	6"	3"	
W14	2'-0.86"	3'-10.3"	2'-11.5"	4.5"	4.5"	6"	3"	
W15	2'-5.2	3'-0"	2'-11.4"	4.5"	2.75"	6"	3"	
W16	2'-5.33"	3'-6.38"	2'-11.6"	4.5"	2.75"	6"	3"	
W17	3'-0"	4'-5.6"	2'-3.5"	4.5"	4.5"	6"	3"	
W18	3'-0"	4'-5.6"	2'-3.5"	4.5"	4.5"	6"	3"	
W19	3'-0"	4'-5.6"	2'-3.5"	4.5"	4.5"	6"	3"	
W20	1'-7.6"	4'-4.6"	2'-10"	N/A	N/A	N/A	N/A	
W21	1'-7.25"	4'-4.7"	4'-3"	N/A	N/A	N/A	N/A	
W22	1'-6.7"	4'-4"	2'-10.5"	N/A	N/A	N/A	N/A	
W23	2'-6"	1'-1"	8"	N/A	N/A	N/A	N/A	

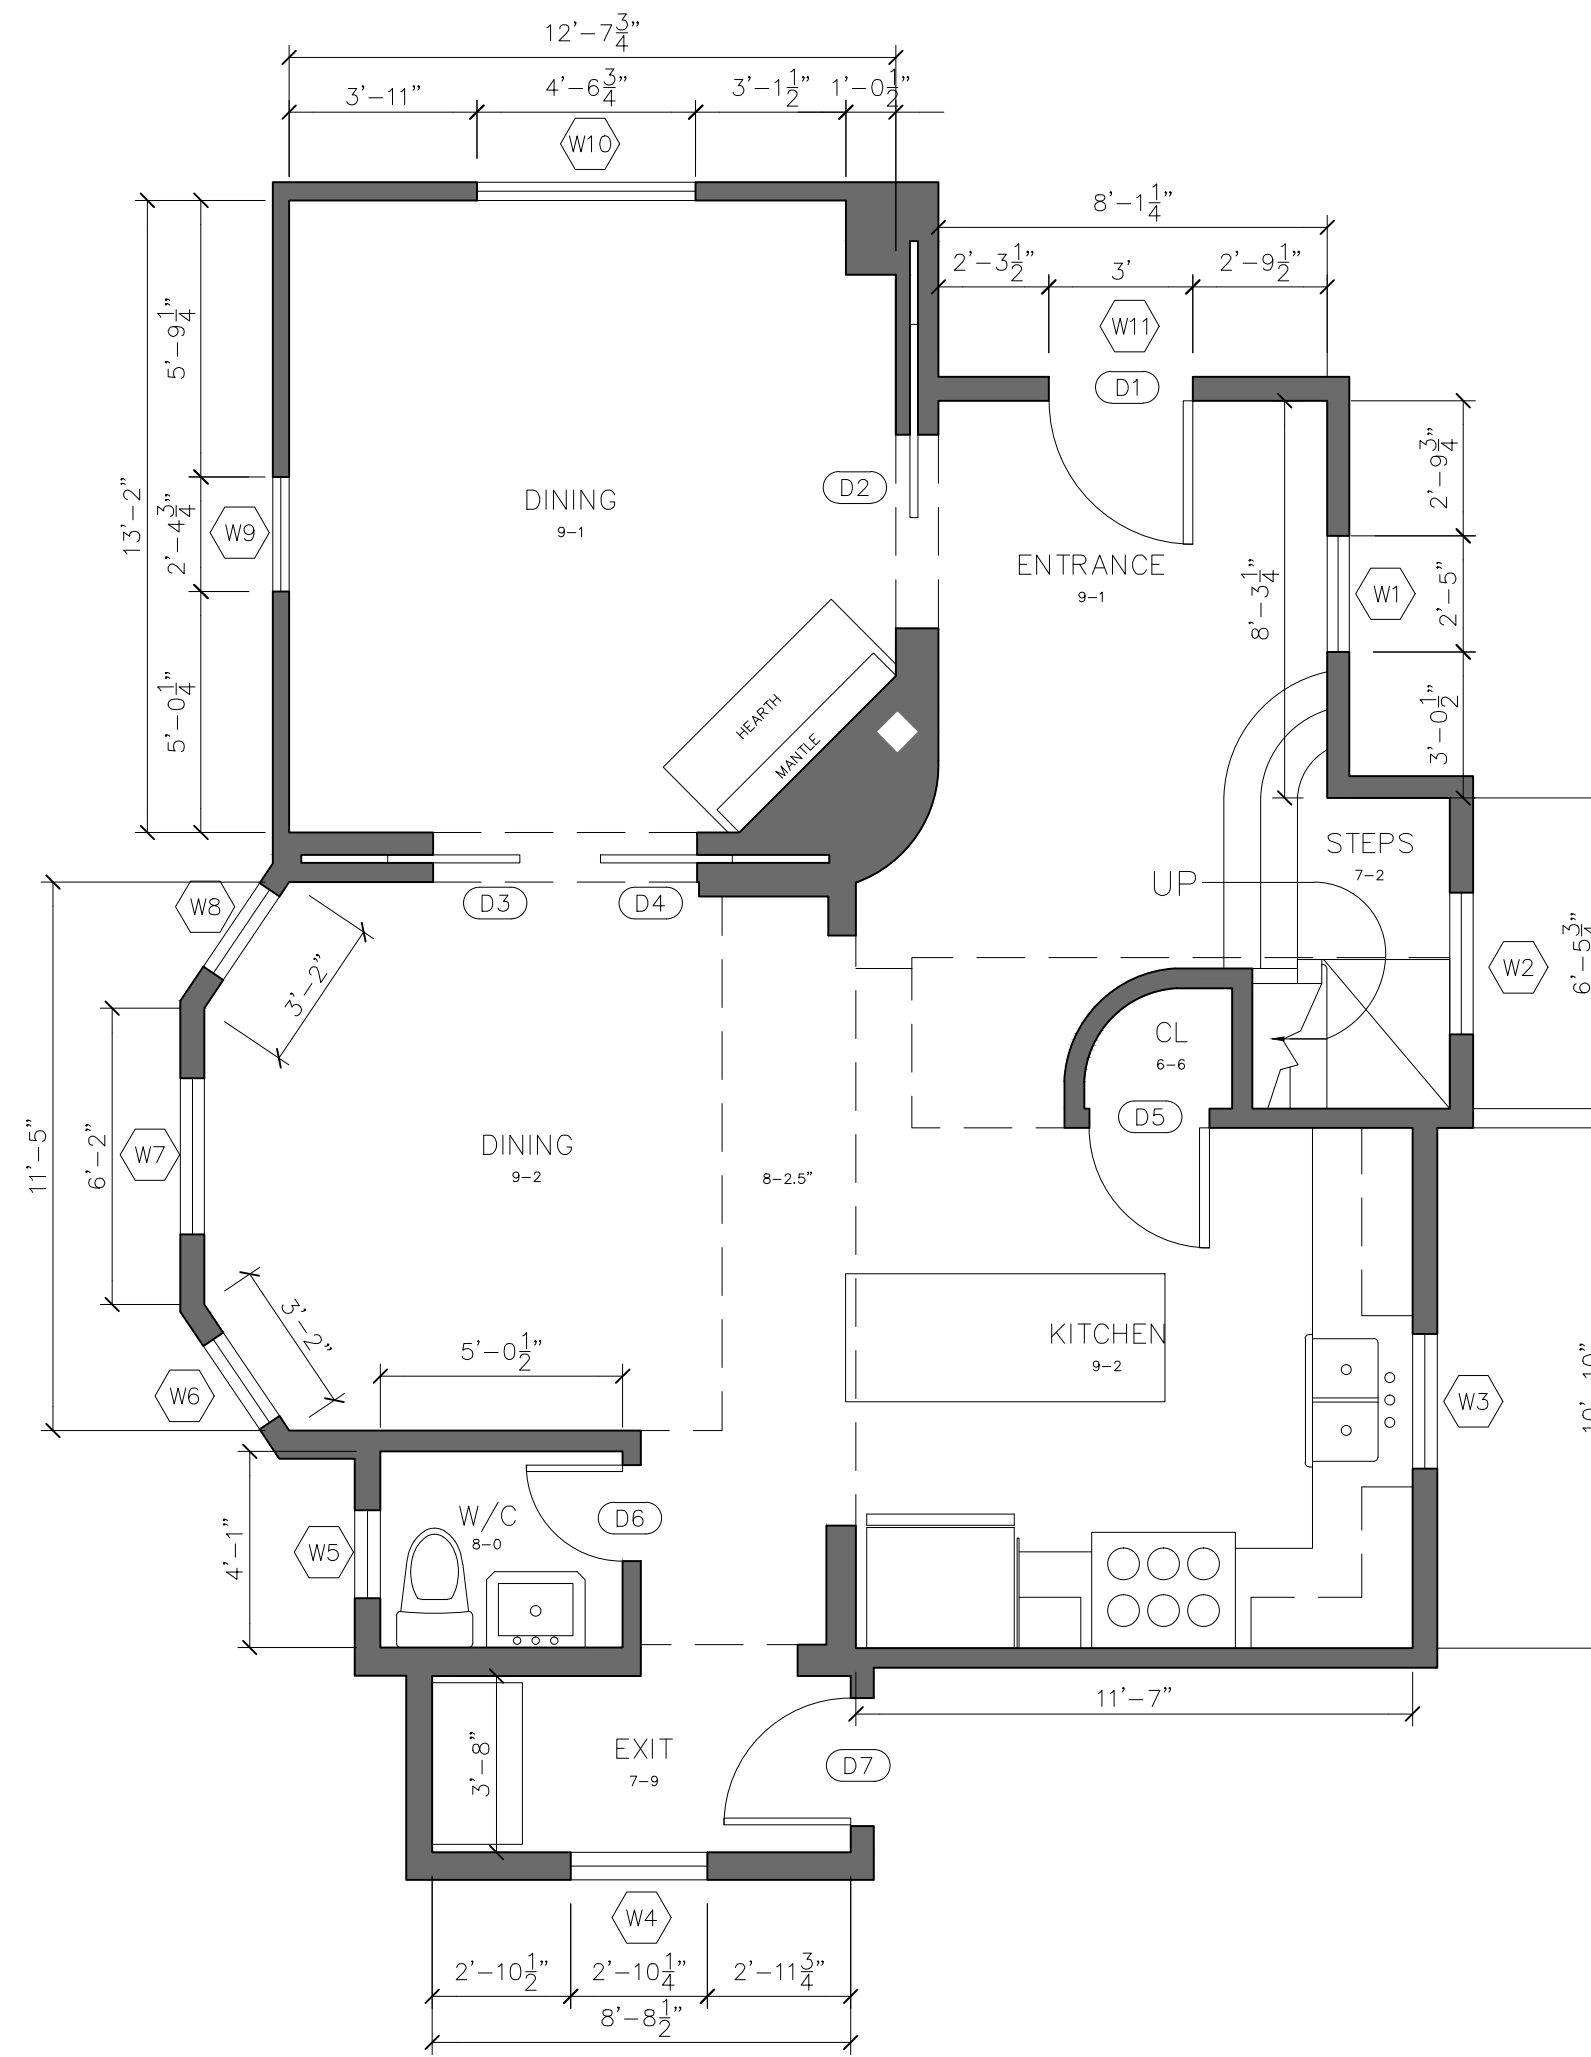

FIRST FLOOR - PLAN

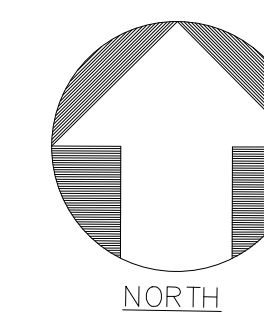

NO. ISSUES | REVISIONS DATE

SHEET TITLE

**FIRST FLOOR PLAN & RCP**

HL PROJECT MANAGER

HL PROJECT DIRECTOR

? PROJECT NUMBER

1/4"=1'-0" SCALE

MM DRAWN BY

SHEET NUMBER

**AB-1**