

AS-BUILT DOCUMENTATION

SEATTLE WA 98112



100% SUBMITTAL

DRAWING INDEX

- C-1 COVER SHEET | DRAWING INDEX
- AB-1 BASEMENT FLOOR PLAN AND RCP
- AB-2 FIRST FLOOR PLAN AND RCP
- AB-3 SECOND FLOOR PLAN AND RCP
- AB-4 DOOR & WINDOW SCHEDULES



VICINITY MAP
NTS

AREA DATA	
GARAGE	619 S.F. ±
BASEMENT	623 S.F. ±
FIRST FLOOR	893 S.F. ±
SECOND FLOOR	893 S.F. ±
GRAND TOTAL	3,028 S.F. ±

AS BUILT

PROFESSIONALS

www.asbuiltprofessionals.com

A DIVISION OF:

AEC

CONSULTANTS INC

844.272.8458


844 AS BUILT

© 2020 AEC CONSULTANTS INC.

ARCHITECTURAL AS BUILT
SEATTLE, WA 98112

NO.		ISSUES REVISIONS	DATE
SHEET TITLE		COVER SHEET	
HL	PROJECT MANAGER		
HL	PROJECT DIRECTOR		
	PROJECT NUMBER		
	SCALE		
MM	DRAWN BY		
	SHEET NUMBER		

C-1

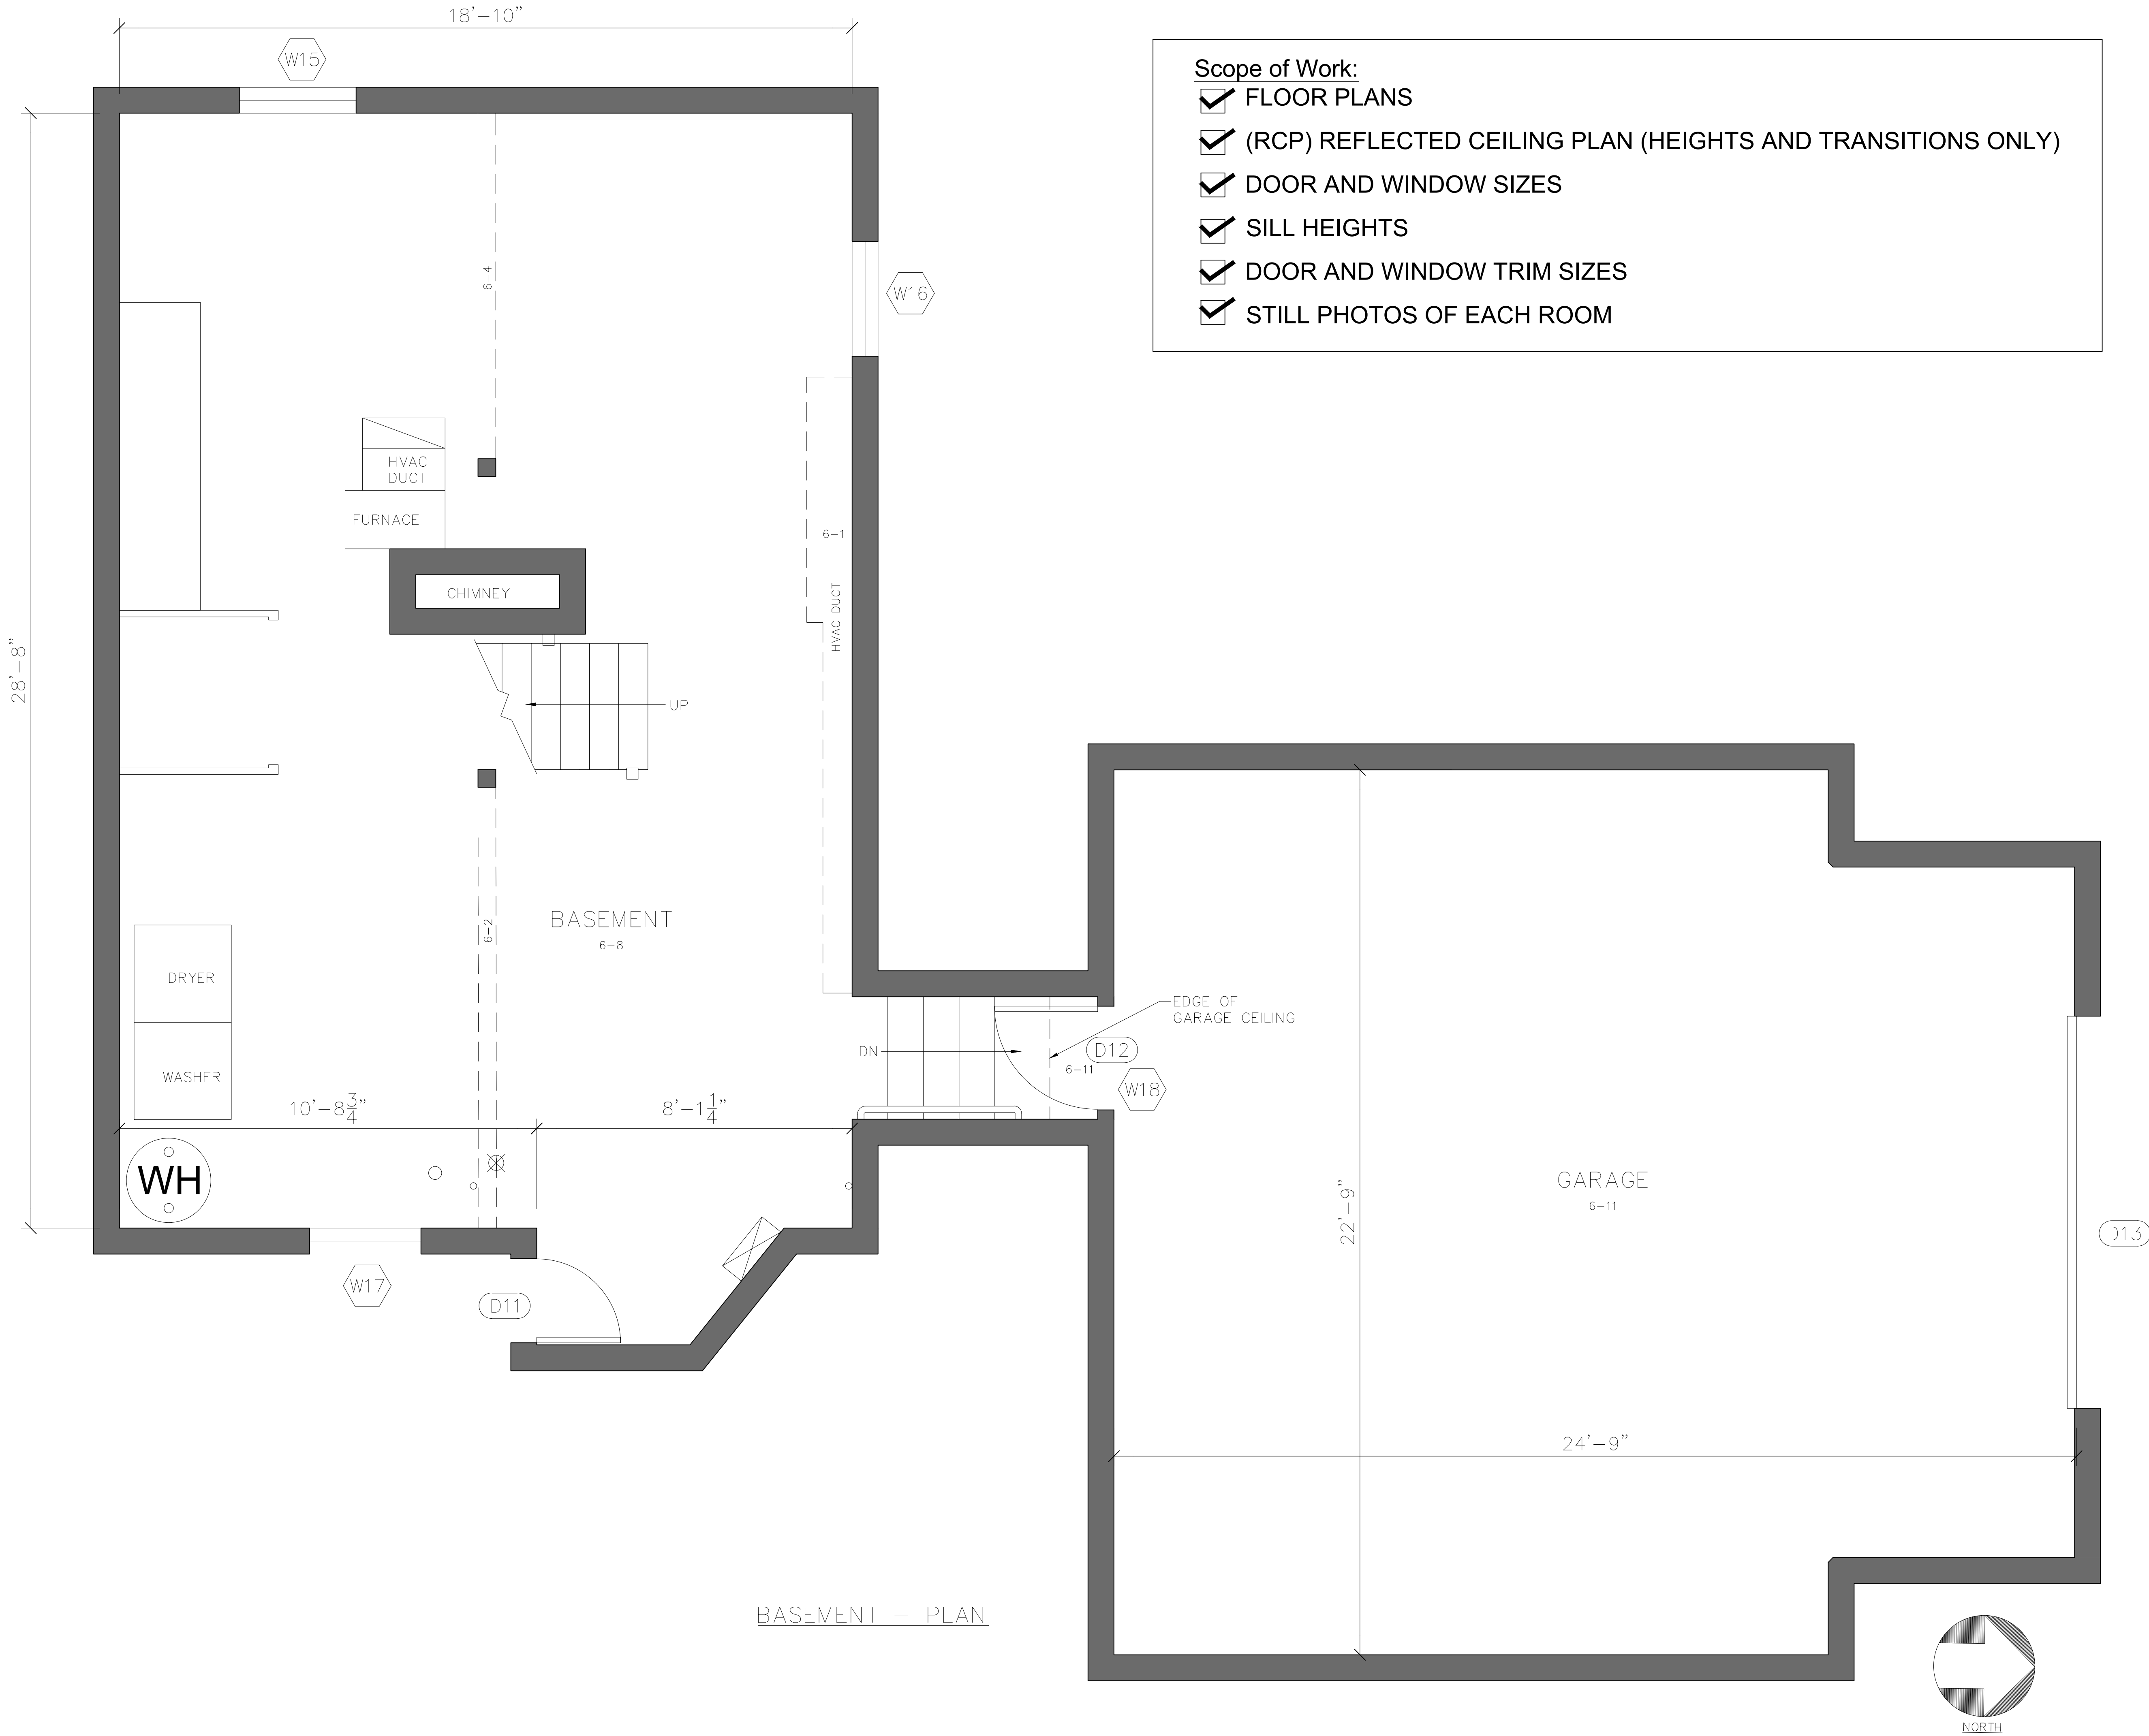

- Scope of Work:
- ✓ FLOOR PLANS
 - ✓ (RCP) REFLECTED CEILING PLAN (HEIGHTS AND TRANSITIONS ONLY)
 - ✓ DOOR AND WINDOW SIZES
 - ✓ SILL HEIGHTS
 - ✓ DOOR AND WINDOW TRIM SIZES
 - ✓ STILL PHOTOS OF EACH ROOM

ARCHITECTURAL AS BUILT

SEATTLE, WA 98112

BASEMENT
FLOOR PLAN &
RCP


HL	PROJECT MANAGER
HL	PROJECT DIRECTOR
	PROJECT NUMBER
1/2"=1'-0"	SCALE
MM	DRAWN BY
	SHEET NUMBER

AB-1



ARCHITECTURAL AS BUILT


SEATTLE, WA 98112

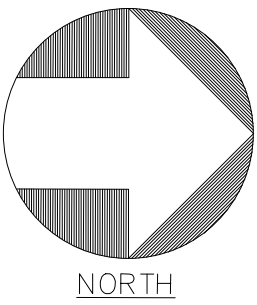

FIRST FLOOR – PLAN

NO.	ISSUES REVISIONS	DATE
		SHEET TITLE
FIRST FLOOR PLAN & RCP		
HL	PROJECT MANAGER	
HL	PROJECT DIRECTOR	
	PROJECT NUMBER	
1/2"=1'-0"		SCALE
MM	DRAWN BY	
	SHEET NUMBER	


AB-2

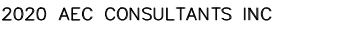

SEATTLE, WA 98112

HL	PROJECT MANAGER
HL	PROJECT DIRECTOR
	PROJECT NUMBER
1/2"=1'-0"	SCALE
MM	DRAWN BY
	SHEET NUMBER

AB-3

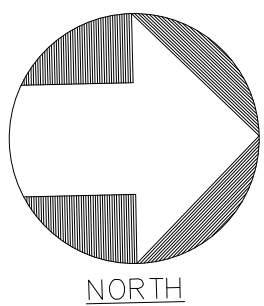

Window Schedule

Window	Width	Height	Sill Height	Left Trim	Right Trim	Top Trim	Btm Trim	Notes
W1	1'-7.2"	2'0"	3'-11"	4.5"	4.5"	4.5"	4.5"	arched top
W2	6'-3.2"	4'-7"	2'-1"	4.5"	4.5"	4.5"	4.5"	
W3	6'-3.2"	4'-7"	2'-1"	4.5"	4.5"	4.5"	4.5"	
W4	4'-1"	4'-7"	2'-1"	4.5"	4.5"	4.5"	4.5"	
W5	1'-11"	4'-7"	2'-1"	4.5"	4.5"	4.5"	4.5"	
W6	1'-11"	4'-7"	2'-1"	4.5"	4.5"	4.5"	4.5"	
W7	1'-7.2"	2'-9"	3'-10.5"	1.6"	1.6"	1.6"	2.5"	
W8	1'-11.3"	2'-9"	3'-10.5"	1.6"	1.6"	1.6"	2.5"	
W9	3'-4.6"	2'-8.4"	3'-1.4"	1.6"	1.6"	1.6"	1"	
W10	6'-1.2"	3'-4.2"	3'-4.8"	1.6"	1.6"	1.6"	1"	
W11	1'-11"	4'-7"	2'-1"	4.5"	4.5"	4.5"	4.5"	TILE WRAPPED
W12	2'-7.2"	4'-7"	2'-1"	4.5"	4.5"	4.5"	4.5"	
W13	1'-11"	4'-7"	2'-1"	4.5"	4.5"	4.5"	4.5"	
W14	6'-3.2"	4'-7"	2'-1"	4.5"	4.5"	4.5"	4.5"	
W15	2'-10.5"	1'-2.5"	5'-3"	N/A	N/A	N/A	N/A	
W16	2'-10.5"	1'-2.5"	5'-3"	N/A	N/A	N/A	N/A	
W17	2'-10.5"	1'-2.5"	5'-3"	N/A	N/A	N/A	N/A	
W18	3'-1"	12"	8'-3"	N/A	N/A	N/A	N/A	
W19	4'-1.2"	3'-11.25"	2'-2"	4.5"	4.5"	4.5"	4.5"	
W20	4'-1.2"	3'-11.25"	2'-2"	4.5"	4.5"	4.5"	4.5"	
W21	4'-1.2"	3'-11.25"	2'-2"	4.5"	4.5"	4.5"	4.5"	
W22	4'-1.2"	3'-11.25"	2'-2"	4.5"	4.5"	4.5"	4.5"	
W23	1'-11"	2'-9.2"	3'-5"	4.5"	4.5"	4.5"	1"	
W24	1'-9.6"	1'-3.2"	4'-9.6"	N/A	N/A	N/A	N/A	
W25	4'-7.2"	4'-4.5"	1'-10"	5"	5"	5"	4.5"	
W26	4'-7.7"	4'-4.5"	1'-10"	5"	5"	5"	4.5"	

Door Schedule

Door	Leaf Width	Leaf Height	Trim Width	Trim Int. Ht	Left Trim	Right Trim	Top Trim	Notes
D1	2'-10"	6'-7"	2'-10"	6'-8"	9.5"	1.5"	4.5"	Entry door
D2	2'-6"	6'-7"	2'-6"	6'-8.6"	4.5"	9.5"	4.5"	coat closet
D3	2'-0"	6'-8"	4'-0"	6'-9"	3"	3"	2.5"	full lite on each leaf
D4	2'-8"	6'-7"	2'-8"	6'-8"	4.5"	4.5"	4.5"	
D5	1'-2"	6'-7"	2'-5"	6'-8"	1.6"	1.6"	1.6"	folding door
D6	1'-2"	6'-7"	2'-5"	6'-8"	1.6"	1.6"	1.6"	folding door
D7	2'-2	6'-7"	2'-2	6'-8"	1.6"	1.6"	1.6"	
D8	2'-8"	6'-6"	5'-3.5"	6'-7.4"	1.6"	1.6"	1.6"	full lite on each leaf
D9	2'-8"	6'-7"	2'-8.5"	6'-8"	1.6"	1.6"	1.6"	door swings both ways
D10	2'-8"	6'-7"	2'-8"	6'-8"	4.5"	3"	4.5"	
D11	2'-2"	6'-6"	N/A	N/A	N/A	N/A	N/A	Basement exit
D12	2'-8"	6'-7"	2'-8"	6'-8"	2"	2"	2"	Garage entrance
D13	9'-11"	6'-4"	9'-11"	6'-4"	1.5"	1.5"	1.5"	Garage exit
D14	2'-6"	6'-5"	2'-6"	6'-6"	4.5"	4.5"	4.5"	
D15	2'-0"	6'-6"	2'-0"	6'-7"	4.5"	4.5"	4.5"	
D16	2'-0"	6'-3"	2'-0"	6'-4"	4.5"	4.5"	4.5"	
D17	2'-6"	6'-6"	2'-6"	6'-7"	4.5"	4.5"	4.5"	
D18	2'-0"	6'-6"	2'-0"	6'-7"	4.5"	4.5"	4.5"	
D19	2'-4"	6'-6"	2'-4"	6'-7"	4.5"	4.5"	4.5"	
D20	2'-0"	6'-6"	2'-0"	6'-8.5"	4.5"	2.5"	4.5"	
D21	2'-4"	6'-7"	2'-6"	6'-8.4"	4.5"	4.5"	4.5"	
D22	1'-6"	6'-7"	6'-0"	6'-8.4"	4.5"	4.5"	4.5"	
D23	2'-6"	6'-7"	2'-6"	6'-8.4"	4.5"	4.5"	4.5"	
D24	2'-6"	6'-1"	2'-6"	6'-2"	2.5"	2.5"	4.5"	
D25	2'-8"	5'-5"	N/A	N/A	N/A	N/A	N/A	glass door

AS BUILT

PROFESSIONALS

www.asbuiltprofessionals.com

A DIVISION OF:

AEC

CONSULTANTS INC

844.272.8458

844 A S B U I L T

© 2020 AEC CONSULTANTS INC.

ARCHITECTURAL AS BUILT

SEATTLE, WA 98112

DOOR &
WINDOW
SCHEDULES

HL	PROJECT MANAGER
HL	PROJECT DIRECTOR
	PROJECT NUMBER
NTS	SCALE
MM	DRAWN BY
	SHEET NUMBER

AB-4