

FLOOR PLAN  
 3/16" = 1'-0"  
 NORTH  
 KEY TO EXTERIOR ELEV  
 WEST EAST  
 SOUTH




**EXISTING RESTAURANT DOCUMENTATION**  
**Lahaina, HAWAII**

NO.	ISSUES   REVISIONS	DATE


HL	PROJECT MANAGER
HL	PROJECT DIRECTOR
6-26-15	PROJECT NUMBER
AS NOTED	SCALE
HL	DRAWN BY
	SHEET NUMBER

A-1



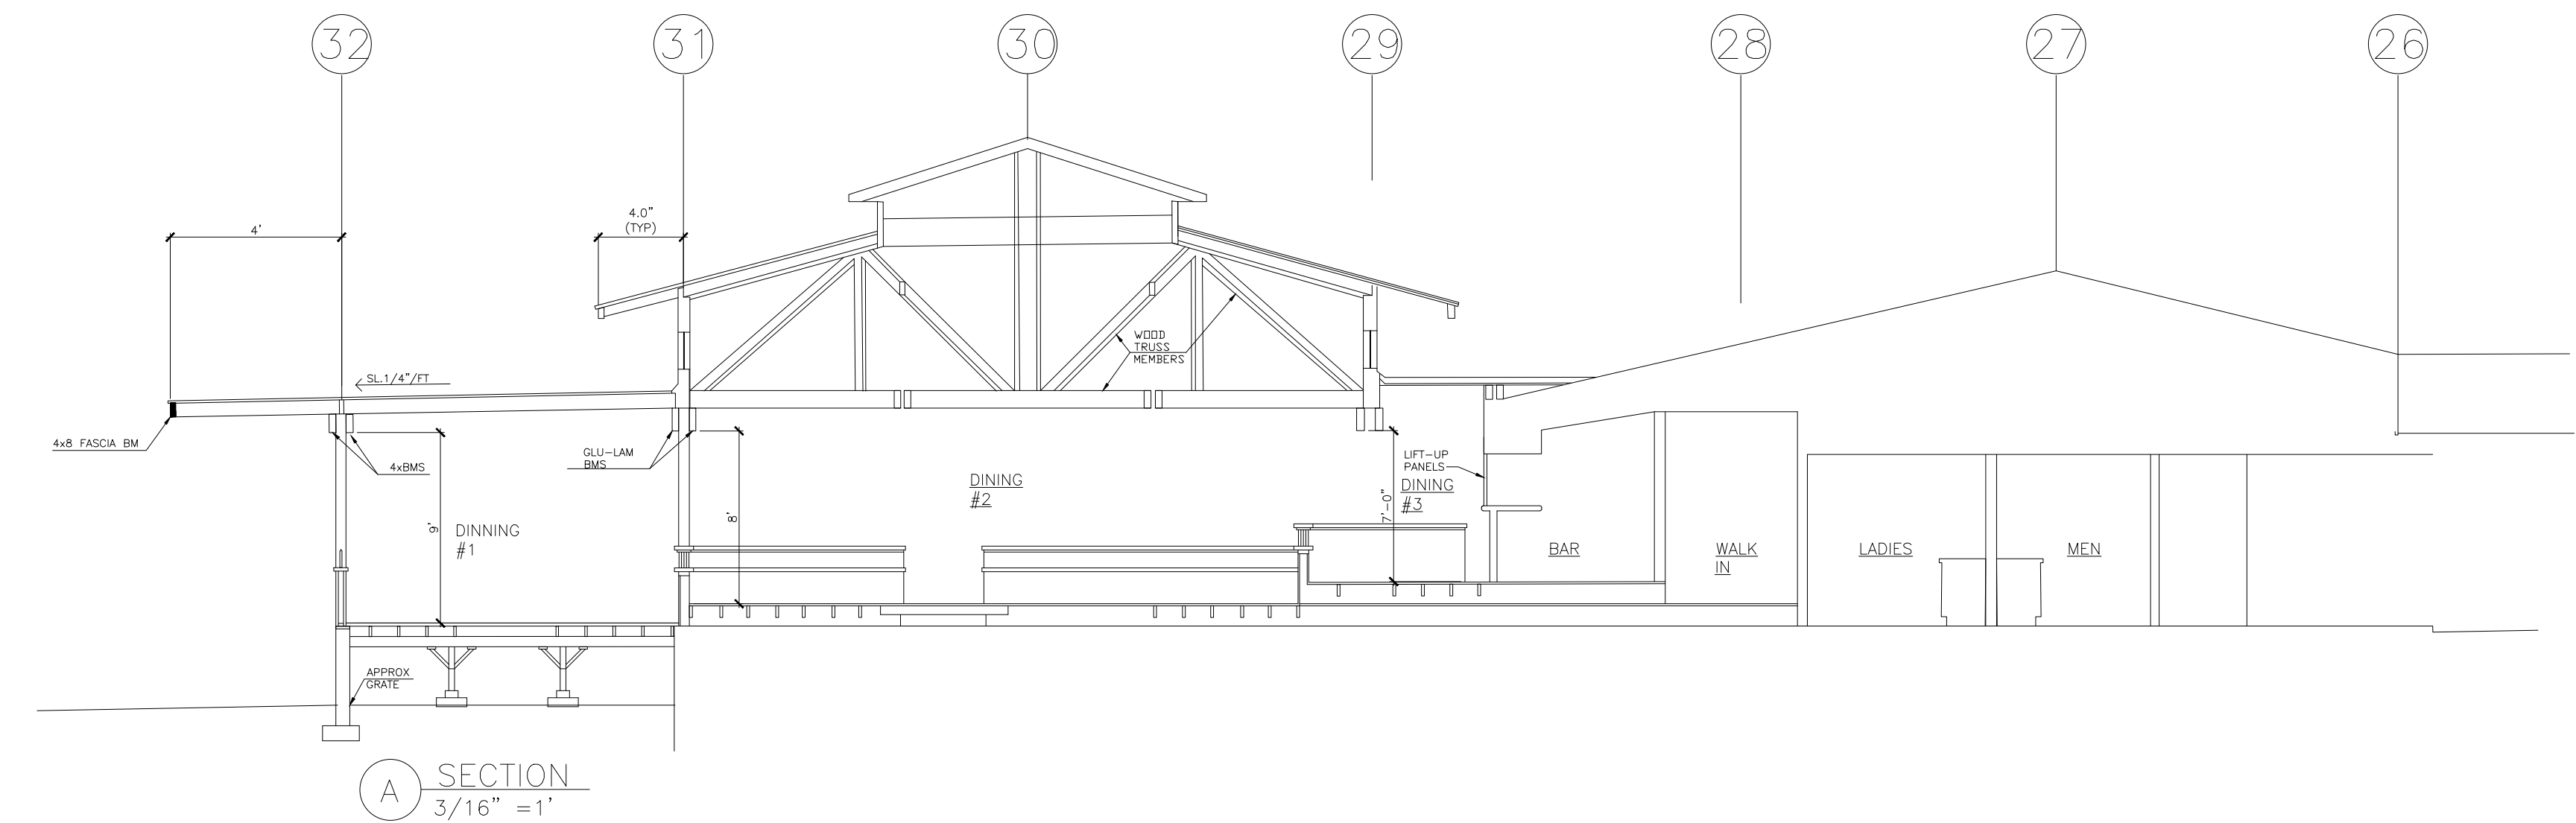

A SECTION  
3/16" = 1'

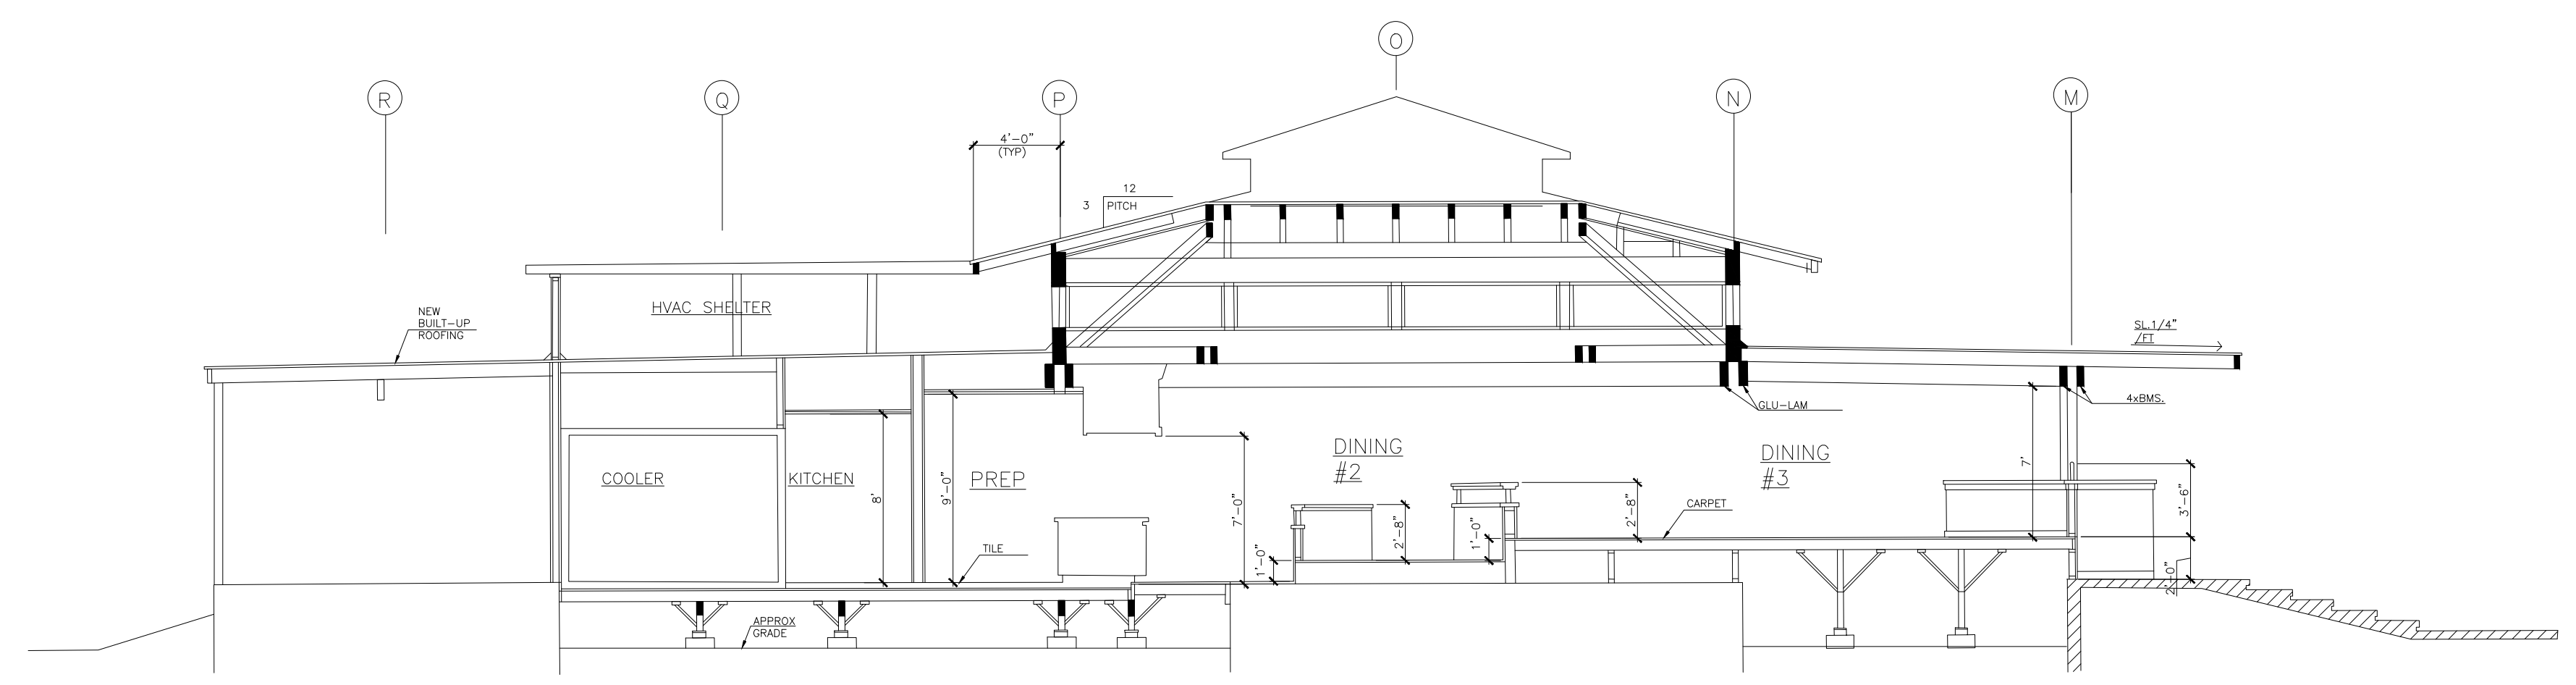


B SECTION  
3/16" = 1'

**EXISTING RESTAURANT DOCUMENTATION**

**Lahaina, HAWAII**

NO. ISSUES   REVISIONS		
DATE	SHEET TITLE	
PROJECT MANAGER	HL	
PROJECT DIRECTOR	HL	
PROJECT NUMBER	6-26-15	
SCALE	AS NOTED	
DRAWN BY	HL	
SHEET NUMBER	A-3	

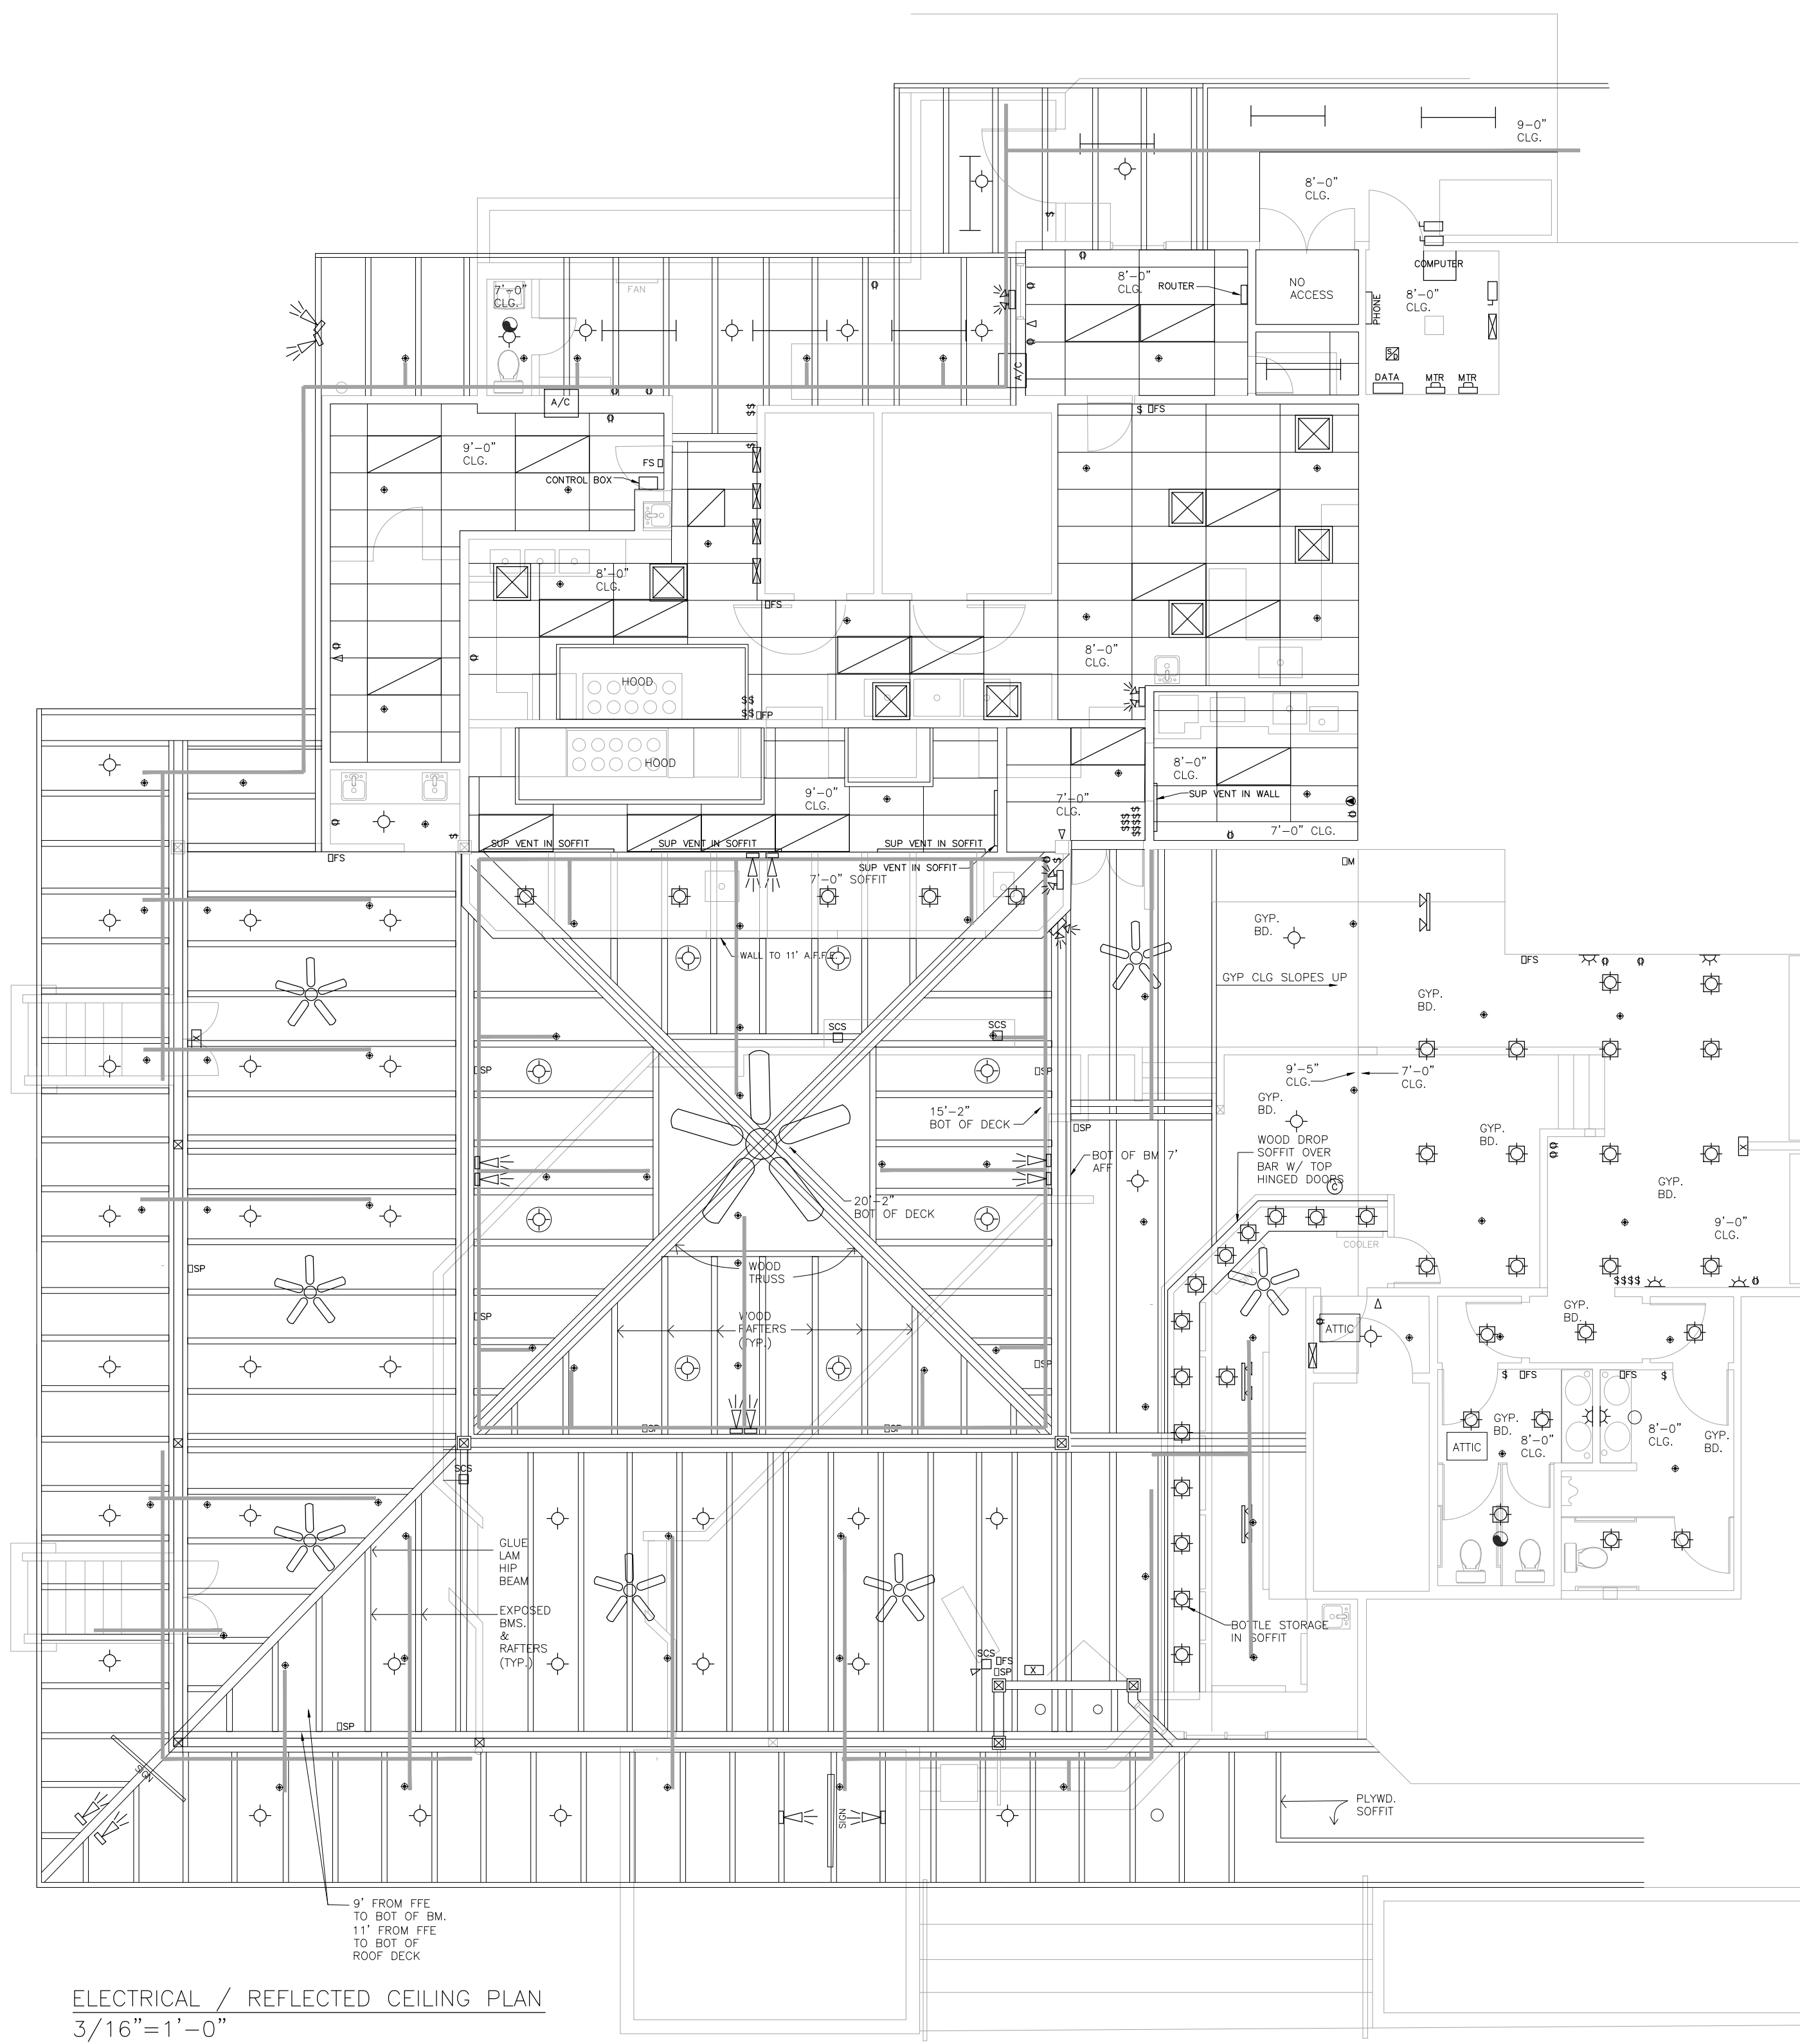

**LEGEND**

☉	EXHAUST VENT	TV	CABLE TELEVISION OUTLET
☉	CEILING MOUNTED LIGHT FIXTURE	☎	TELEPHONE JACK
☉	RECESSED CAN LIGHT	⚡	ELECTRIC SWITCH
☉	WALL MOUNTED LIGHT FIXTURE	⚡	3-WAY ELECTRIC SWITCH
☉	EMERGENCY EXIT SIGN	⚡	4-WAY ELECTRIC SWITCH
☉	EMERGENCY EXIT LIGHT	⚡	DUPLEX RECEPTACLE OUTLET
☉	EMERGENCY EXIT LIGHT W/ SIGN	⚡	DUPLEX RECEPTACLE OUTLET-SPUT WIRE
☉	FLOOD LIGHT	⚡	SPECIAL PURPOSE CONNECTION OR OUTLET
☉	FLOOD LIGHT W/ MOTION SENSOR	⚡	WATERPROOF DUPLEX RECEPTACLE OUTLET
☉	VANITY BAR LIGHT FIXTURE	⚡	GROUND FAULT CIRCUIT INTERRUPTER DUPLEX RECEPTACLE OUTLET
☉	INDIVIDUAL FLOOR, 1W-1R BULB	⚡	QUADRUPLX RECEPTACLE OUTLET
☉	INDIVIDUAL FLOOR, MANUIC 2 BULB	⚡	FLOOR DUPLEX RECEPTACLE OUTLET
☉	INDIVIDUAL FLOOR, FLUSH MOUNT, 4 BULB	⚡	SMOKE DETECTOR
☉	OUTLET BOX & FLUORESCENT FIXTURE TRIP	⚡	ELECTRIC PANEL
☉	PHOTO CELL	⚡	ELECTRIC METER
☉	CEILING FAN	⚡	FIRE EXTINGUISHER
☉	CEILING FAN W/ LIGHT KIT	⚡	THERMOSTAT
☉	DISCONNECT SWITCH	⚡	SURROUND SOUND WIRE & JACK
☉	SPRINKLER HEAD	⚡	CHIME
☉	3070 DOOR AND WINDOW LABELS 7'-2 1/2" WIDE 7'-0" TALL	⚡	BUTTON SWITCH
☉	FLOOR DRAIN	⚡	GARBAGE DISP.
☉	MOTION SENSOR	⚡	COMD. DATA OUTLET
☉	SUP. VENT	⚡	TRACK FIXTURE
☉		⚡	FIRE ALARM
		⚡	EXPOSED WATER LINE ABOVE
		⚡	KEY FOB SECURITY PAN
		⚡	FIRE ALARM PULL
		⚡	CAMERA
		⚡	SPEAKER
		⚡	FIRE STROBE
		⚡	HANGING LIGHT FIXTURE
		⚡	SERVER COMPUTER STATION

**NOTES:**  
 1. ALL CEILINGS ARE 7'-10" - 8' A.F.F.E. AND ARE PLASTER UNDO.  
 2. KITCHEN FLOORING IS TILE WITH RUBBER MATS AND DINING IS CARPET.  
 3. ALL EXPOSED PIPE NOTED APPEARS TO BE WATER LINE FOR SPRINKLING SYSTEM UNDO.  
 4. FURNITURE FIXTURES AND APPLIANCES WERE NOT MOVED ONLY VISIBLE UTILITIES WERE LOCATED.

ELECTRICAL / REFLECTED CEILING PLAN  
 3/16"=1'-0"




**EXISTING RESTAURANT DOCUMENTATION**  
**Lahaina, HAWAII**

NO.	ISSUES   REVISIONS	DATE
SHEET FILE		
HL	PROJECT MANAGER	
HL	PROJECT DIRECTOR	
6-26-15	PROJECT NUMBER	
AS NOTED	SCALE	
HL	DRAWN BY	
	SHEET NUMBER	

A-4

©2015 AEG CONSULTANTS INC

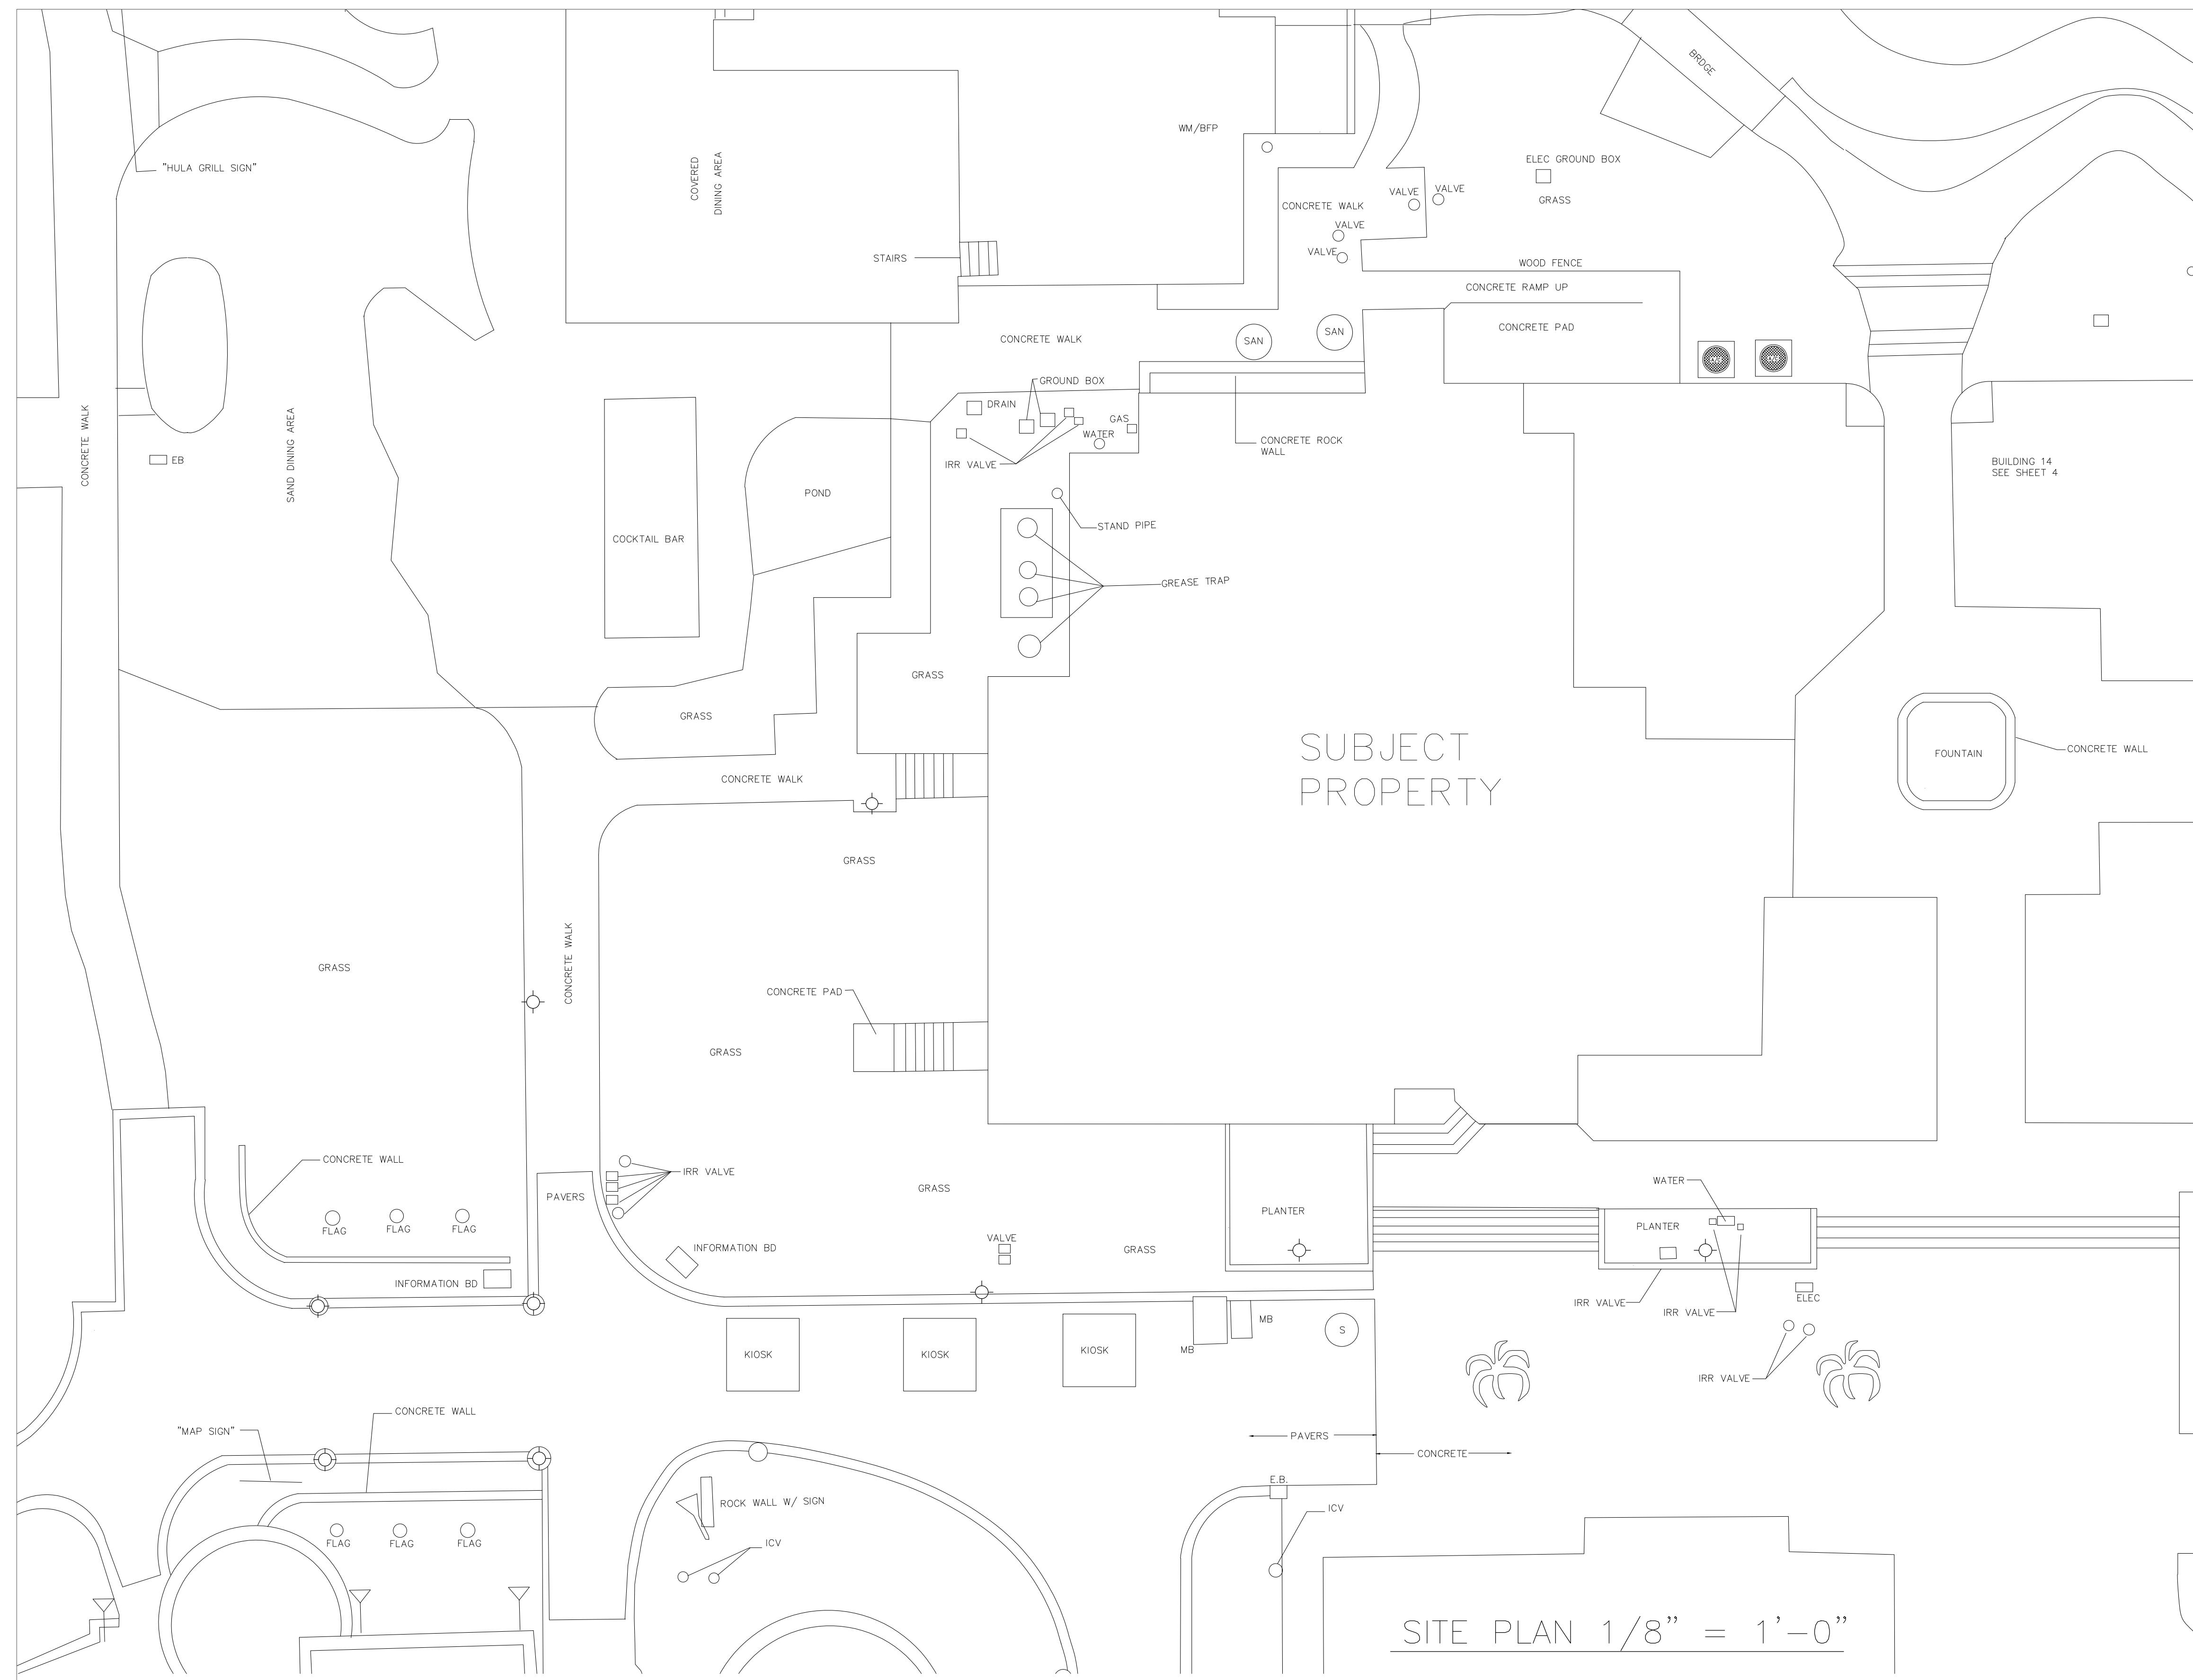

**AEC**  
**CONSULTANTS INC**  
 844.272.8458  
 ASB UITY  
 www.asbuiltprofessionals.com

**EXISTING RESTAURANT DOCUMENTATION**  
**Lahaina, HAWAII**

NO.	ISSUES   REVISIONS	DATE

HL	PROJECT MANAGER
HL	PROJECT DIRECTOR
6-26-15	PROJECT NUMBER
AS NOTED	SCALE
HL	DRAWN BY
	SHEET NUMBER

SITE PLAN 1/8" = 1'-0"

A-5

© 2015 AEC CONSULTANTS INC