


SANTE FE RIDGE APTS


SILVERDALE, WA 98383

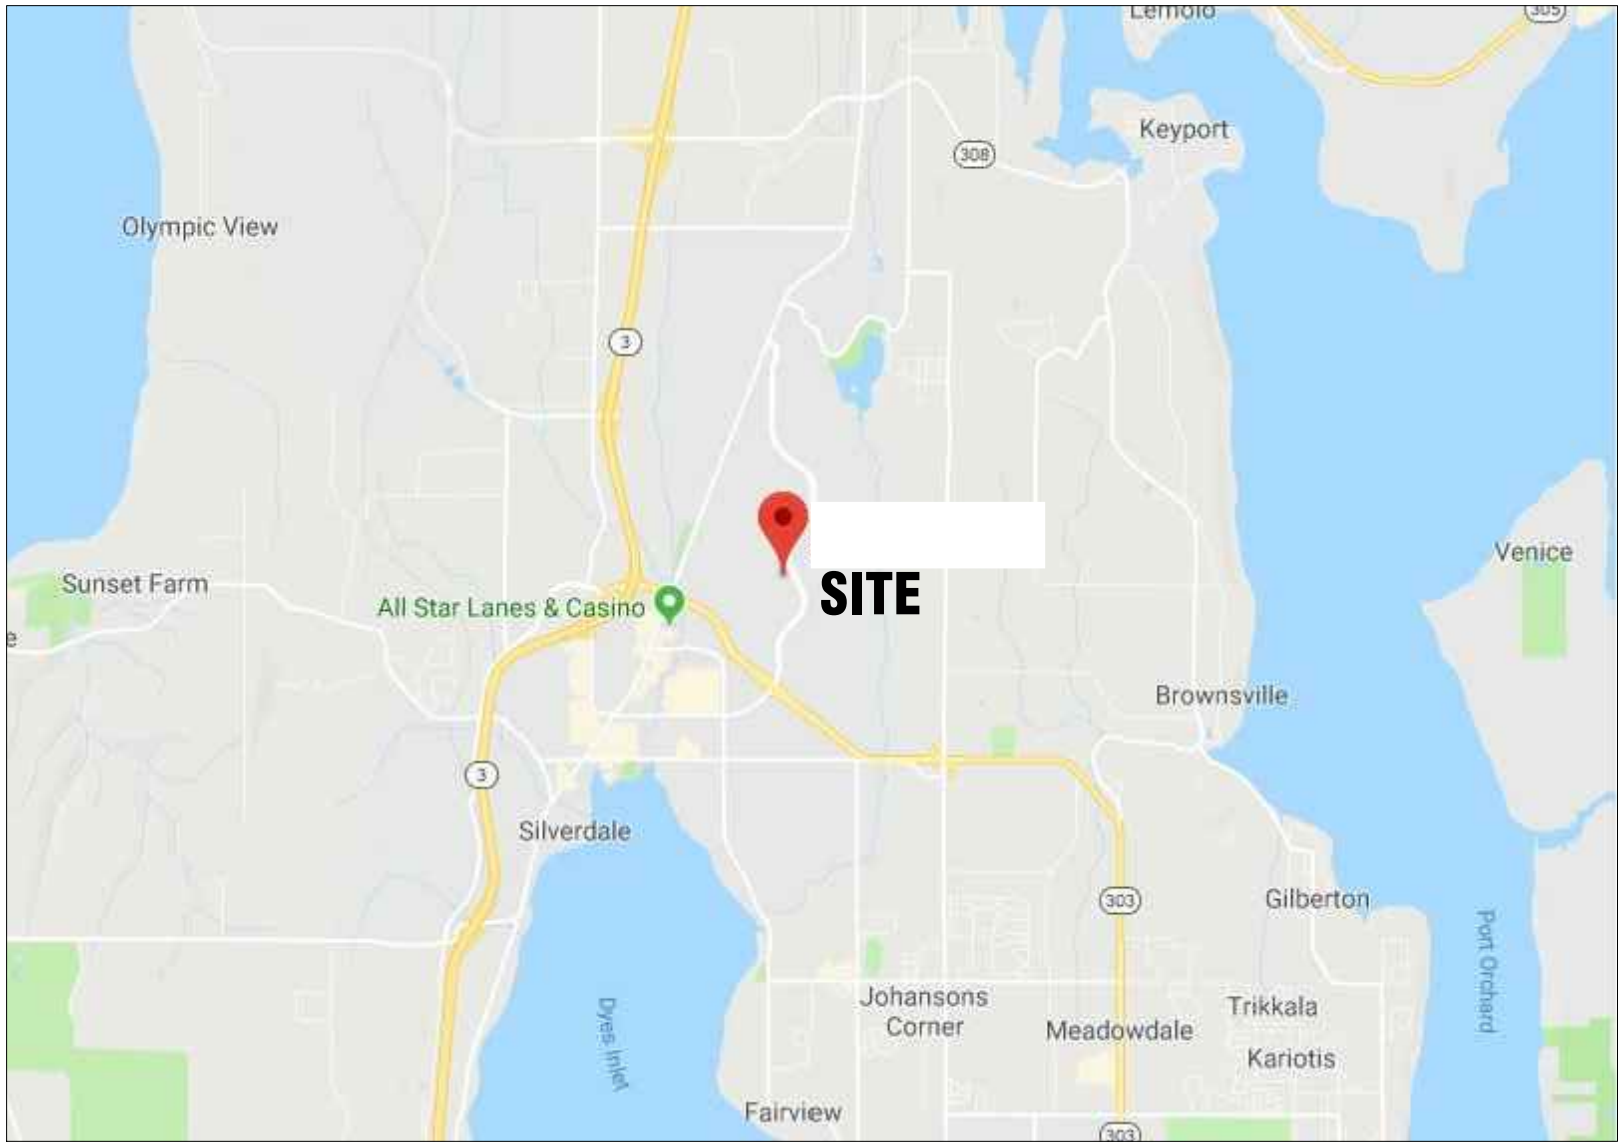

100% SUBMITTAL

DRAWING INDEX

C-1	COVER SHEET DRAWING INDEX
SL	SYMBOLS LEGEND
AB-1	SITE PLAN
AB-2	FLOOR PLAN
AB-3	RCP
AB-4	ELEVATIONS
AB-5	ELEVATIONS

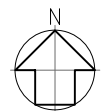

VICINITY MAP

NTS

AREA DATA

GRAND TOTAL	10,898 S.F. ±
-------------	---------------

[illegible]





SILVERDALE, WA 98383

01	100% SUBMISSION	SEE COVER SHEET
NO.	ISSUES REVISIONS	DATE
		SHEET TITLE

FLOORPLAN

HL	PROJECT MANAGER
HL	PROJECT DIRECTOR
012317-1	PROJECT NUMBER
1/8"=1'-0"	SCALE
MM	DRAWN BY
	SHEET NUMBER



AB-2

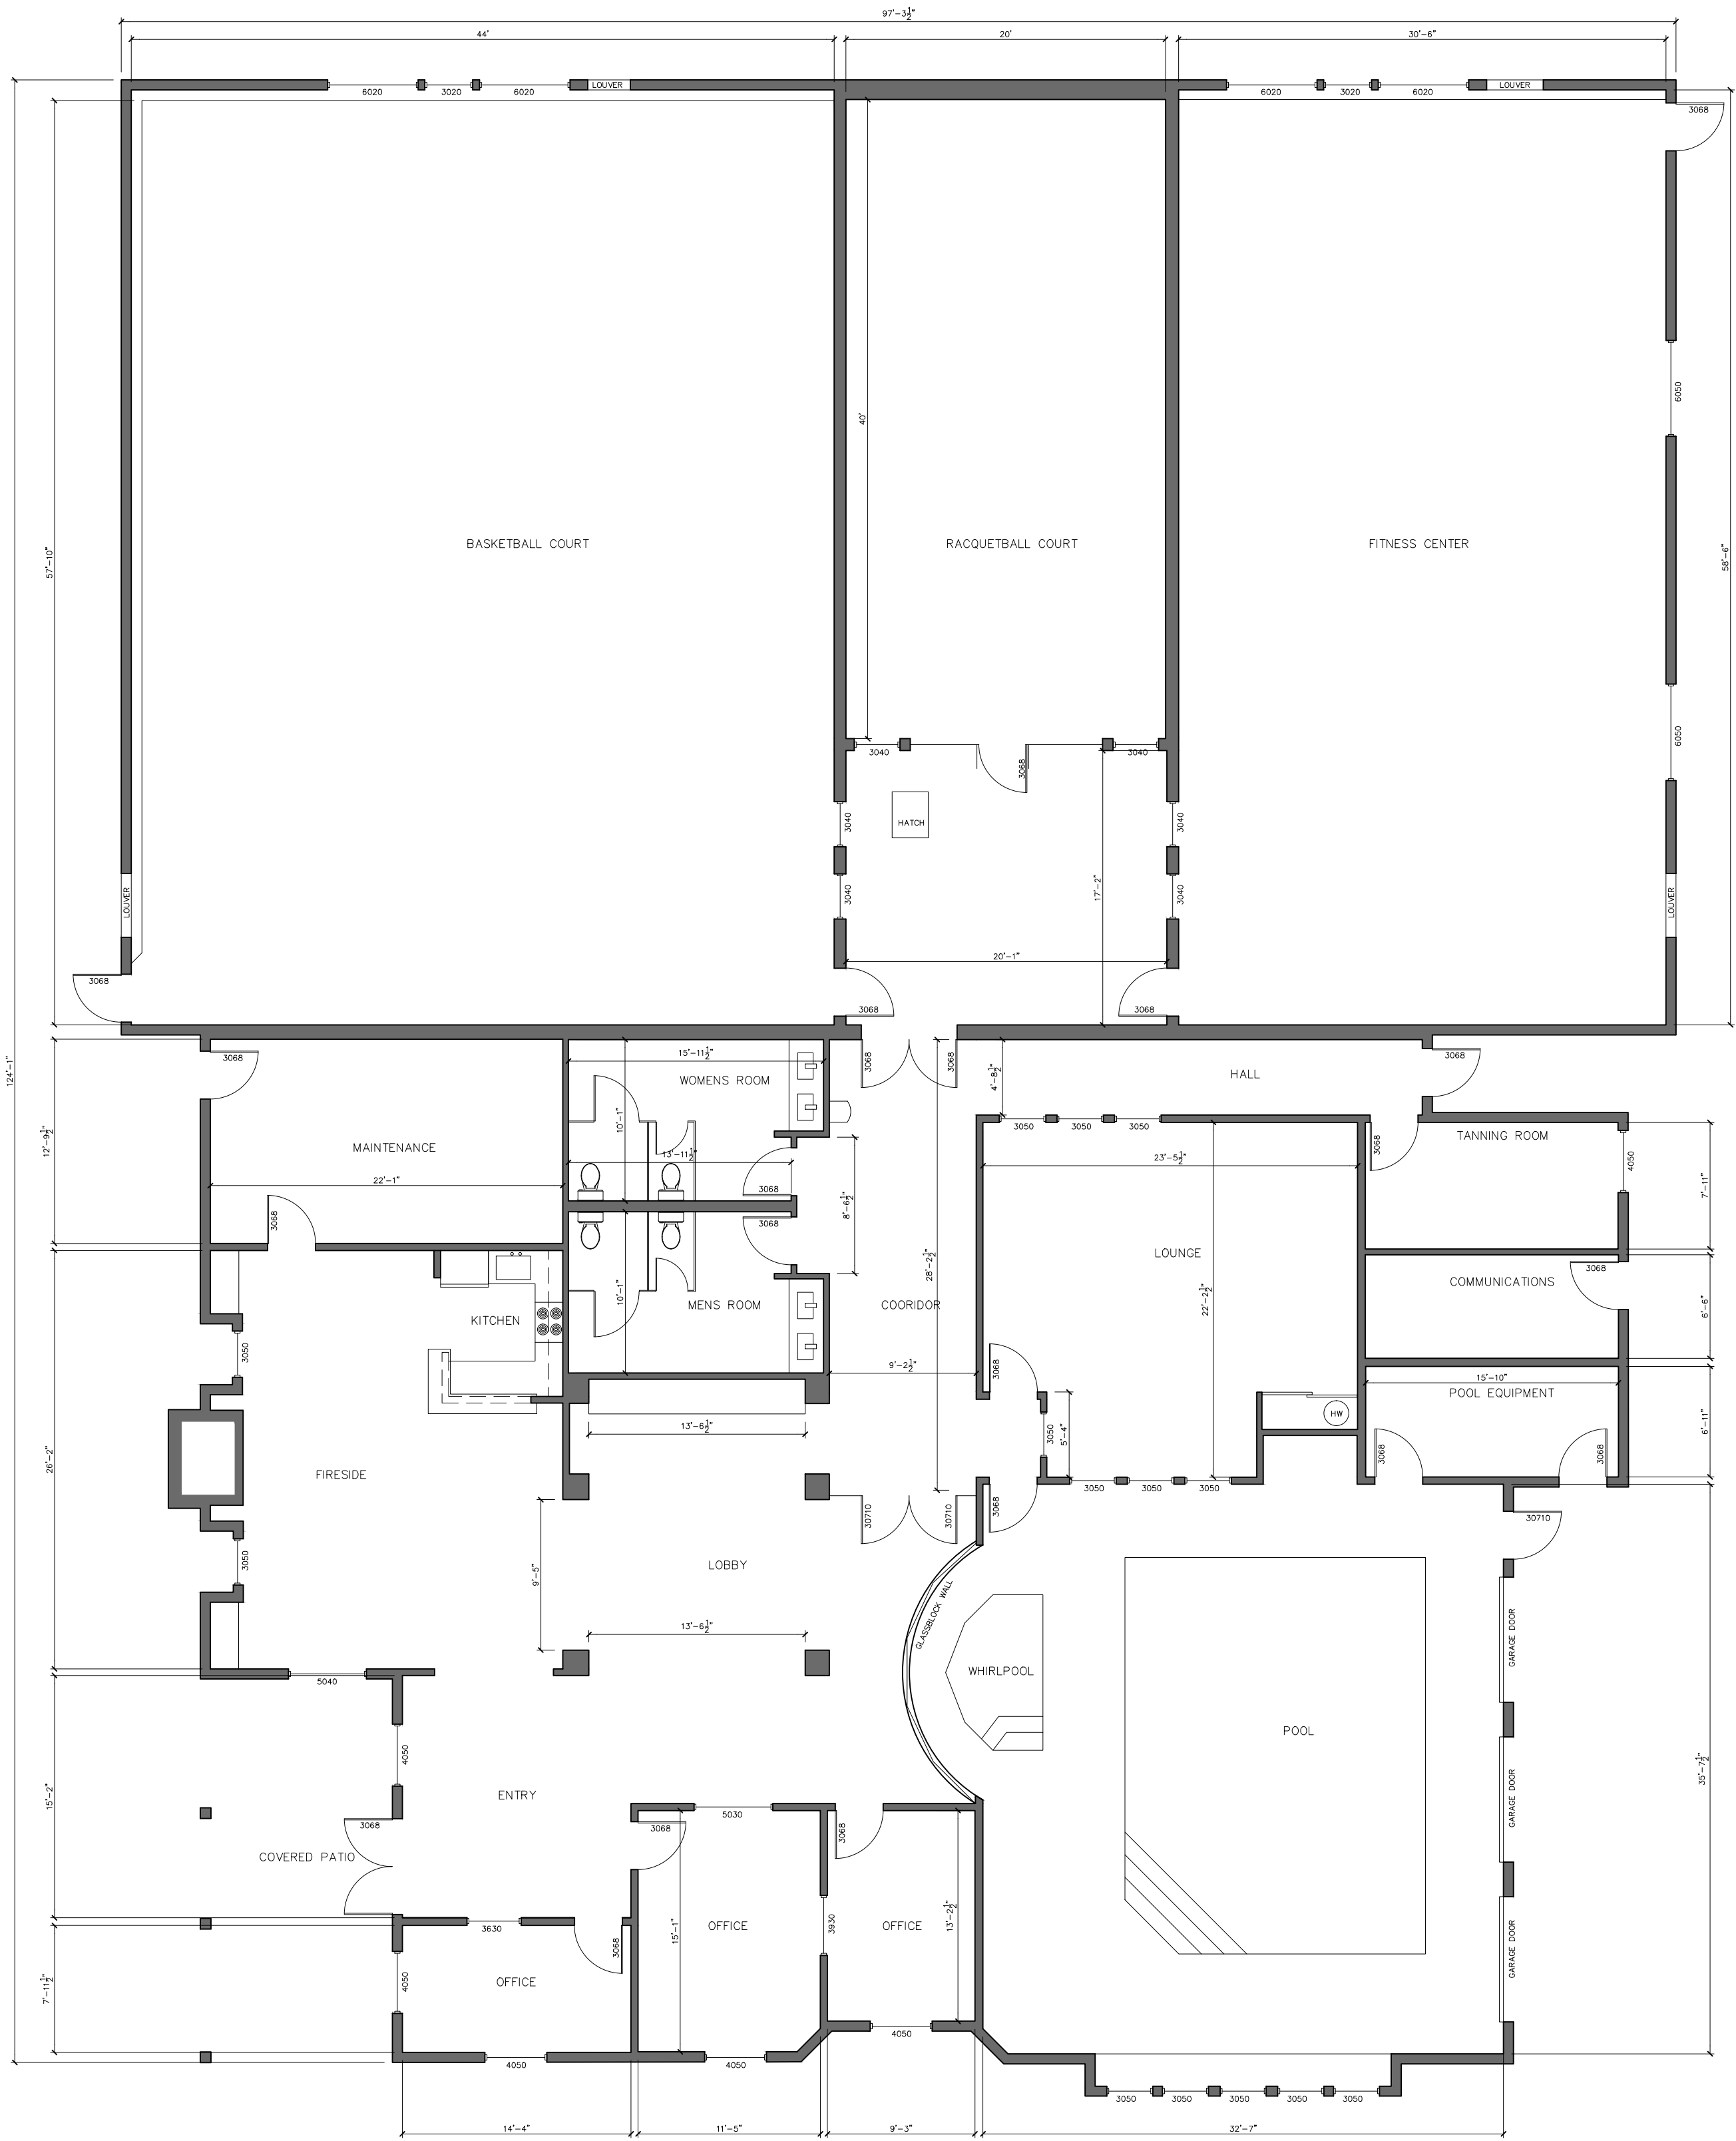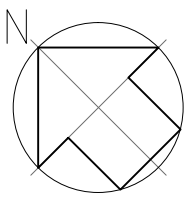



ARCHITECTURAL AS BUILT SANTA FE RIDGE

SILVERDALE, WA 98383

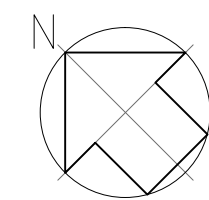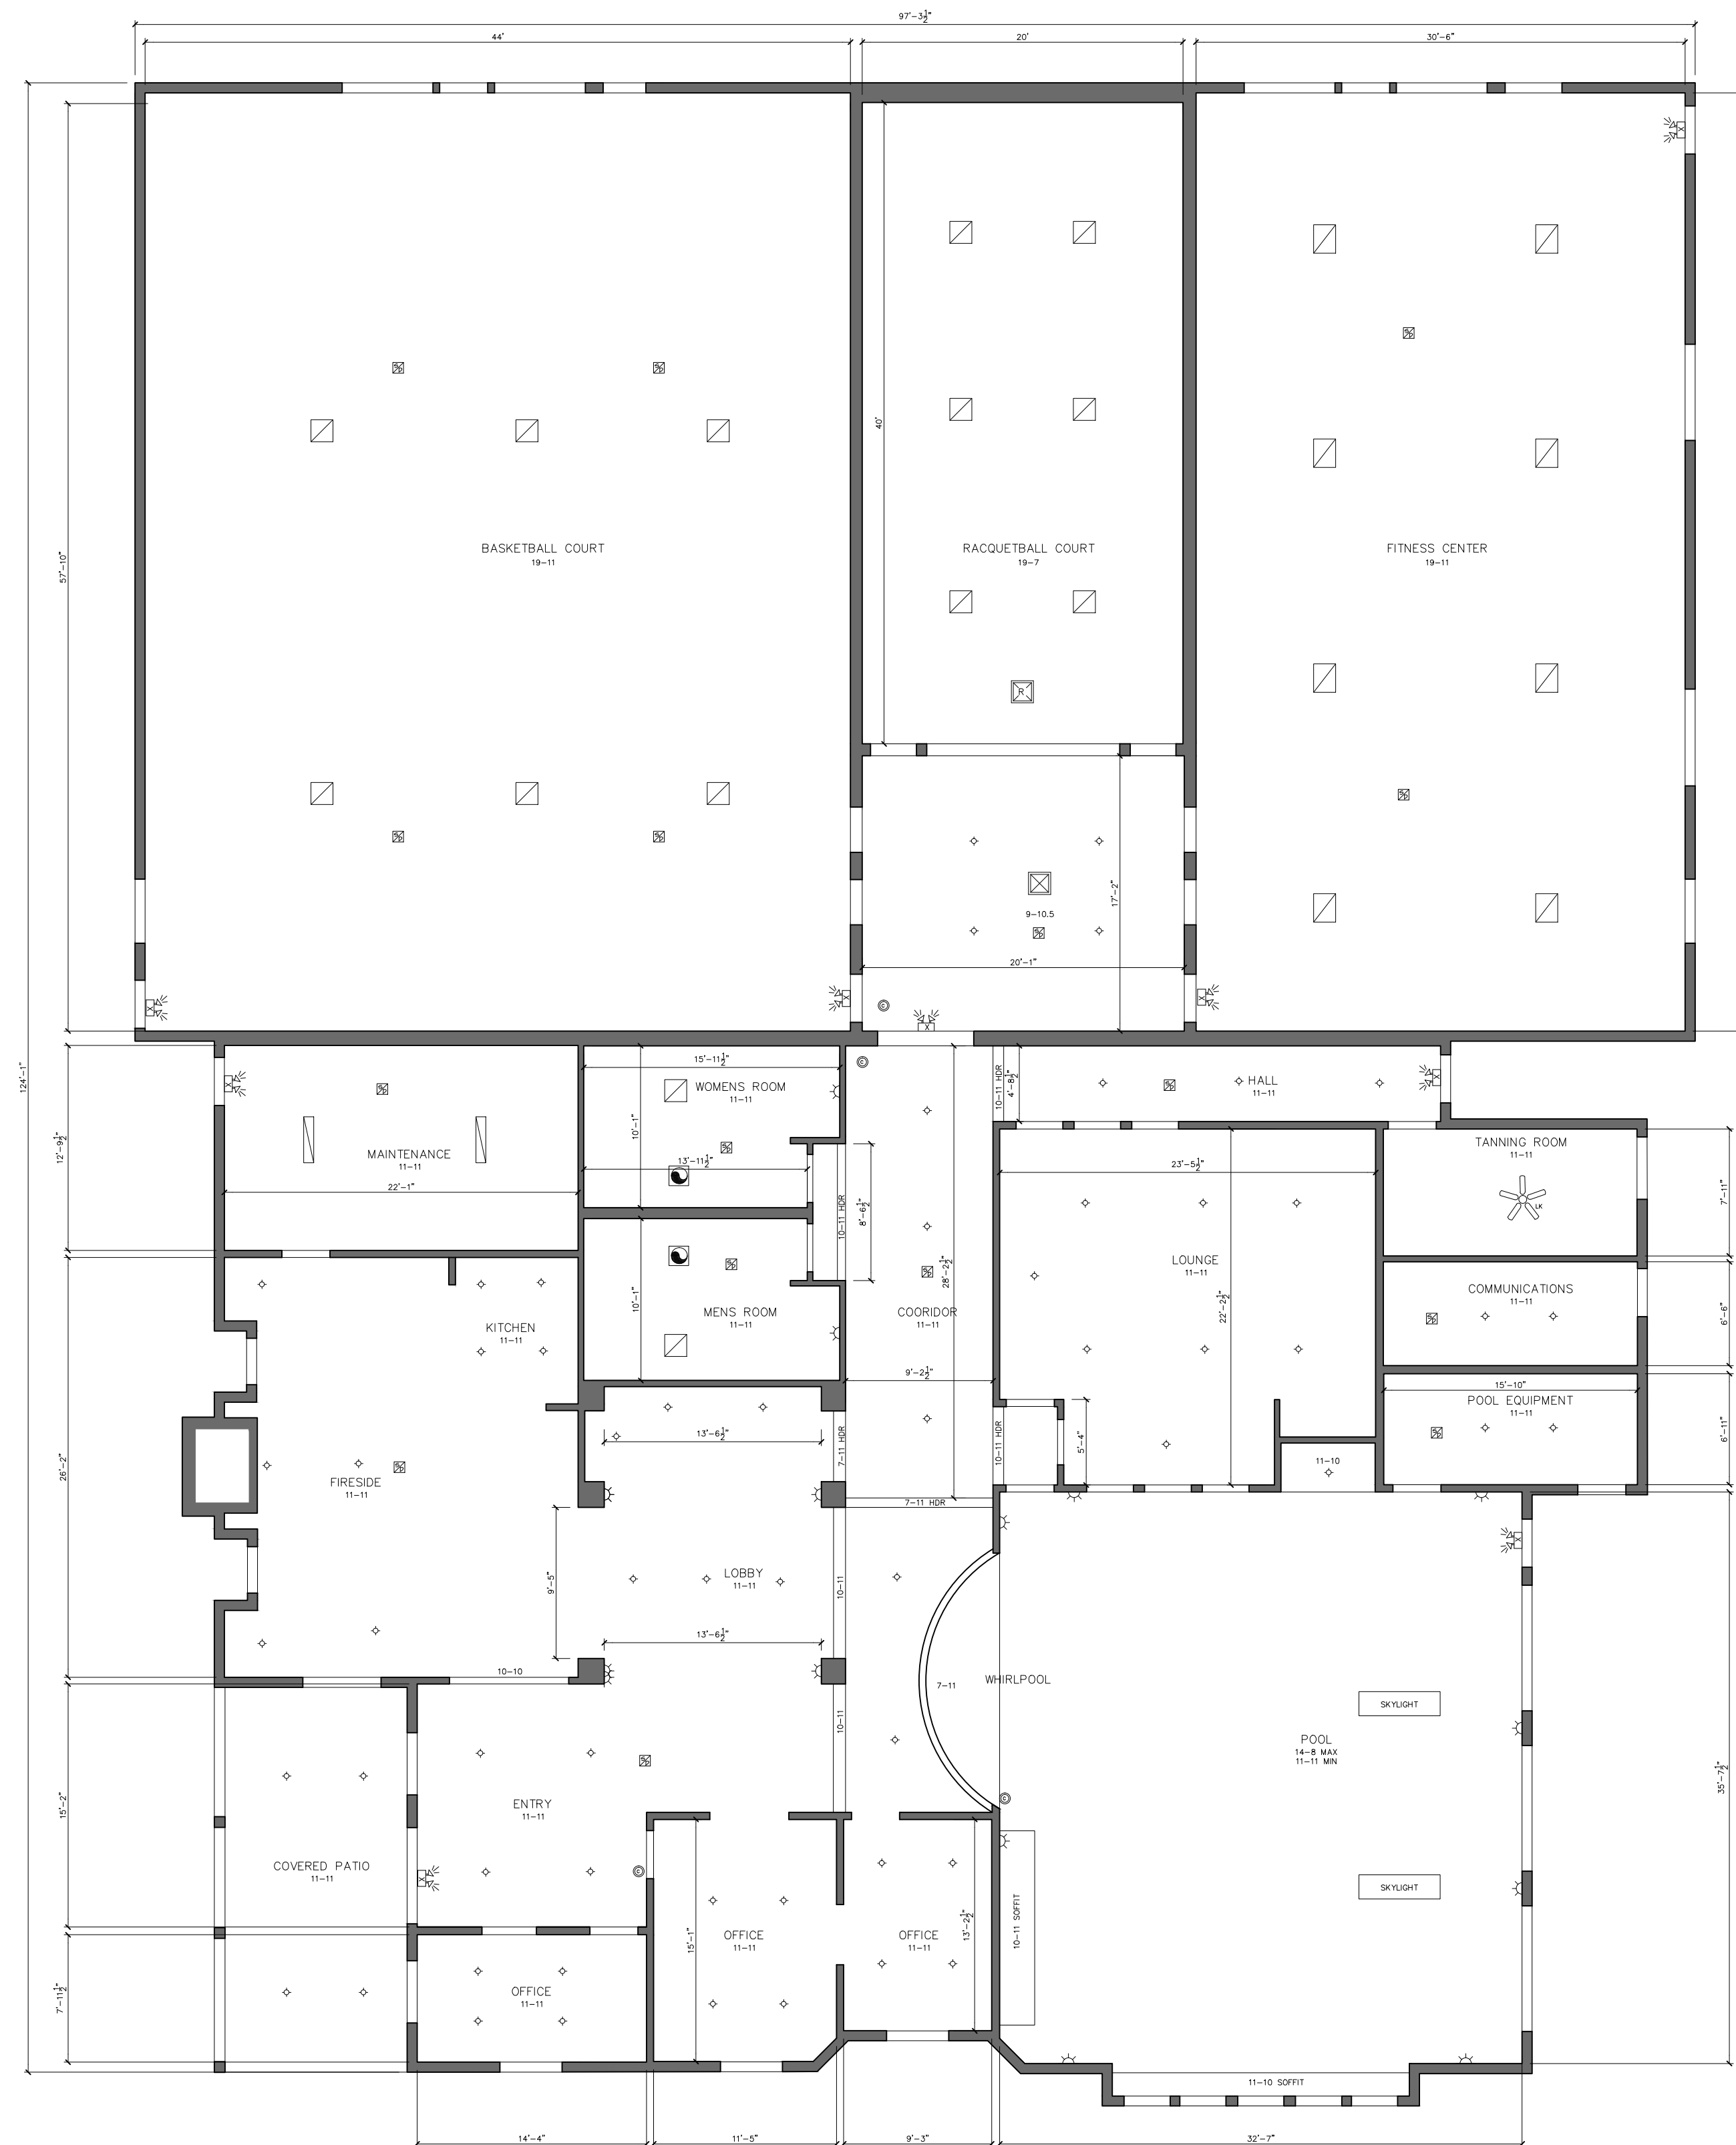

01	100% SUBMISSION	SEE COVER SHEET
NO.	ISSUES REVISIONS	DATE
		SHEET TITLE
RCP		
HL		PROJECT MANAGER
HL		PROJECT DIRECTOR
012317-1		PROJECT NUMBER
1/8"=1'-0"		SCALE
MM		DRAWN BY
		SHEET NUMBER

AB-3

