

BOMA ANALYSIS

Santa Rosa Professional Pavilion

San Antonio, TX

DRAWING INDEX

- C-1 COVER SHEET | DRAWING INDEX
- AB-1 FLOOR 1
- AB-2 FLOOR 2
- AB-3 FLOOR 3 - 8
- AB-4 FLOOR 9
- AB-5 FLOOR 10
- AB-6 FLOOR 11
- AB-7 FLOOR 12

BOMA Legacy Method A - Worksheet

PRELIMINARY VALUES (DO NOT FOR LEASING)												REVENUE-BASED CALCULATIONS (NOT FOR LEASING)												FINAL CHECKS (LEASING)			OPTIONAL ADJUSTMENTS						
A	B	C	D	E	F	G	H	I	J	K	L	M	N	O	P	Q	R	S	T	U	V	W	X	Y	Z	AA	AB	AC	AD				
FLOOR LEVEL	MEASURE	MEASURE	FLOOR TOTALS 1	3274	963	1644	0	3005	2078	93	2261	7424	0	1	1	1	1	1	1	1	1	1	1	1	1	1	1	1	1	1	1	1	1	1		
FLOOR TOTALS 2	3179	862	1731	0	1396	828	0	828	4789	0	1	1	1	1	1	1	1	1	1	1	1	1	1	1	1	1	1	1	1	1	1		
FLOOR TOTALS 3	3384	728	1943	0	925	0	0	0	925	0	0	0	0	0	0	0	0	0	0	0	0	0	0	0	0	0	0	0	0	0	0	0	
FLOOR TOTALS 4	3384	728	1943	0	925	0	0	0	925	0	0	0	0	0	0	0	0	0	0	0	0	0	0	0	0	0	0	0	0	0	0	0	
FLOOR TOTALS 5	3384	728	1943	0	925	0	0	0	925	0	0	0	0	0	0	0	0	0	0	0	0	0	0	0	0	0	0	0	0	0	0	0	
FLOOR TOTALS 6	3384	728	1943	0	925	0	0	0	925	0	0	0	0	0	0	0	0	0	0	0	0	0	0	0	0	0	0	0	0	0	0	0	
FLOOR TOTALS 7	3384	728	1943	0	925	0	0	0	925	0	0	0	0	0	0	0	0	0	0	0	0	0	0	0	0	0	0	0	0	0	0	0	
FLOOR TOTALS 8	3384	728	1943	0	925	0	0	0	925	0	0	0	0	0	0	0	0	0	0	0	0	0	0	0	0	0	0	0	0	0	0	0	
FLOOR TOTALS 9	2943	609	0	0	2833	2415	97	2412	4019	0	1	1	1	1	1	1	1	1	1	1	1	1	1	1	1	1	1	1	1	1	1	1	
FLOOR TOTALS 10	2943	795	0	0	2834	2476	0	2476	3743	0	1	1	1	1	1	1	1	1	1	1	1	1	1	1	1	1	1	1	1	1	1	1	
FLOOR TOTALS 11	2943	795	0	0	2834	2480	0	2480	3895	0	1	1	1	1	1	1	1	1	1	1	1	1	1	1	1	1	1	1	1	1	1	1	
FLOOR TOTALS 12	2943	795	0	0	2834	2477	0	2477	3803	0	1	1	1	1	1	1	1	1	1	1	1	1	1	1	1	1	1	1	1	1	1	1	
FLOOR TOTALS 13																																	
BUILDING TOTALS (1)	38237	9289	20801	0	18297	12910	190	12960	33037	0	1	1	1	1	1	1	1	1	1	1	1	1	1	1	1	1	1	1	1	1	1	1	



Values in this chart represent the measurement of total rent revenue is allowed. Penetration Calculations and Formulas are not for leasing.

KEY:

- NO DATA ENTRY IN THIS AREA
- FORMULA (DO NOT MODIFY)
- USE THESE NUMBERS FOR LEASING

ANALYSIS CHART

All areas determined according to: BOMA International standard methods of measurement for commercial buildings latest edition (2010)

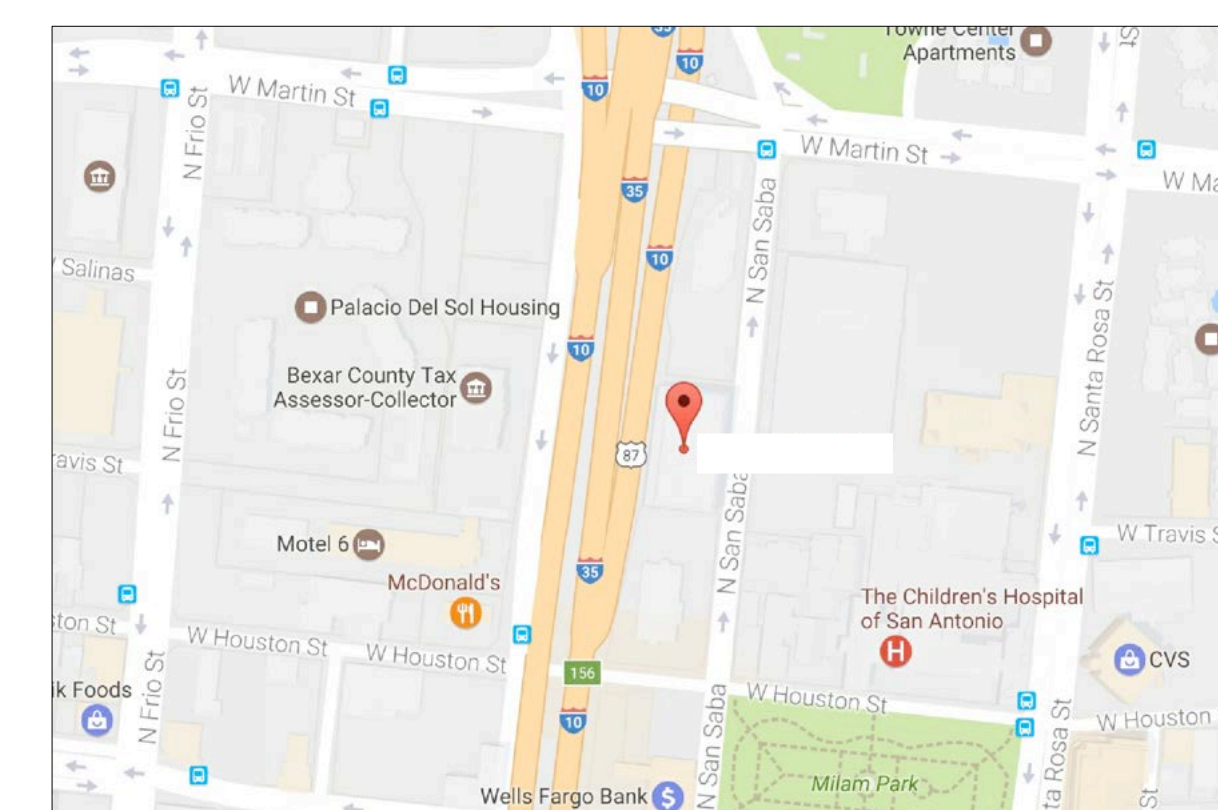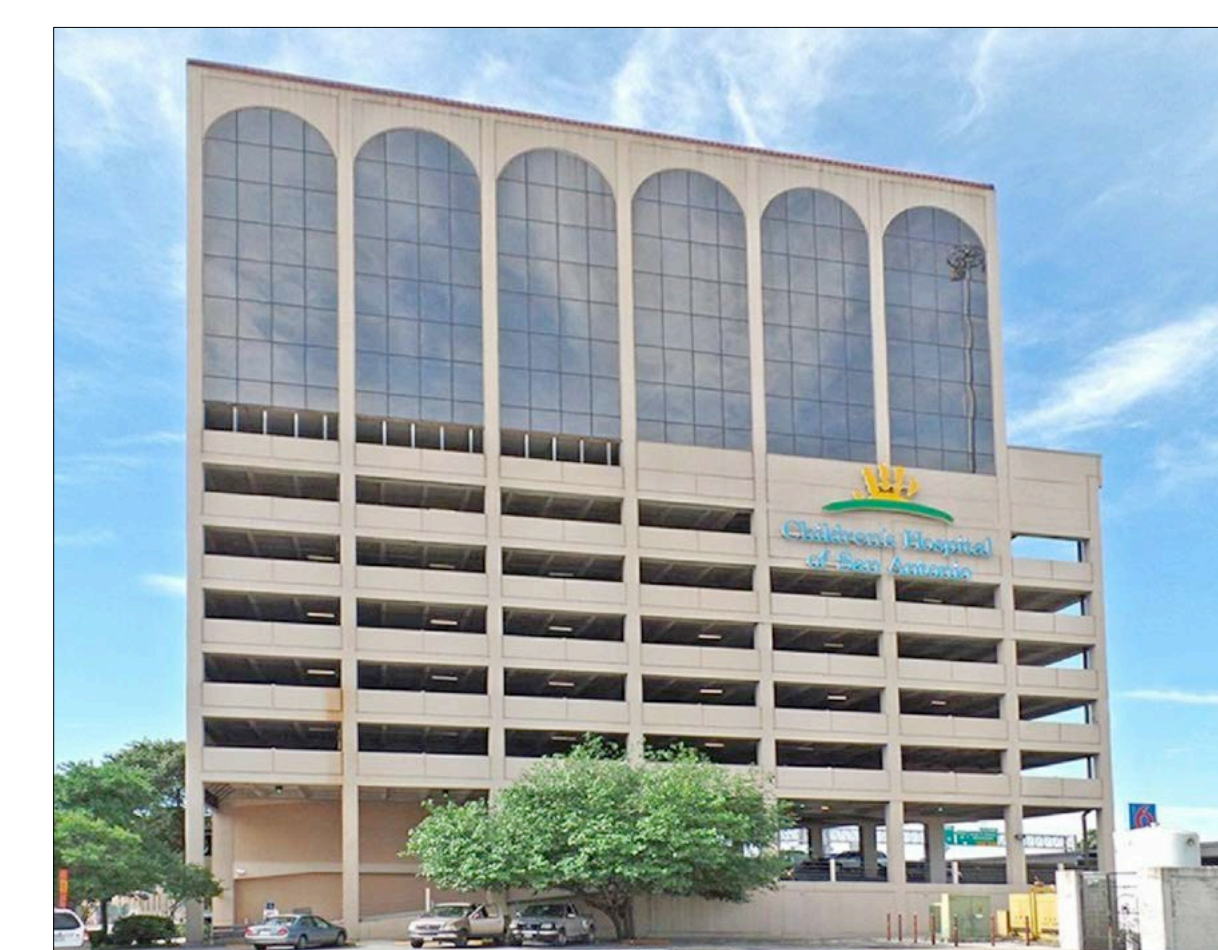

Vicinity Map
NTS



ARCHITECTURAL BOMA ANALYSIS
 Santa Rosa Professional Pavilion
 San Antonio, TX


KEY

- MAJOR VERTICAL PENETRATIONS
- OCCUPANT AREA
- BUILDING AMENITY
- FLOOR SERVICE AREA

100% SUBMITTAL

01	100% SUBMISSION	
NO.	ISSUES REVISIONS	DATE
HL		PROJECT MANAGER
HL		PROJECT DIRECTOR
012317-1		PROJECT NUMBER
		SCALE
CL		DRAWN BY
		SHEET NUMBER

C-1

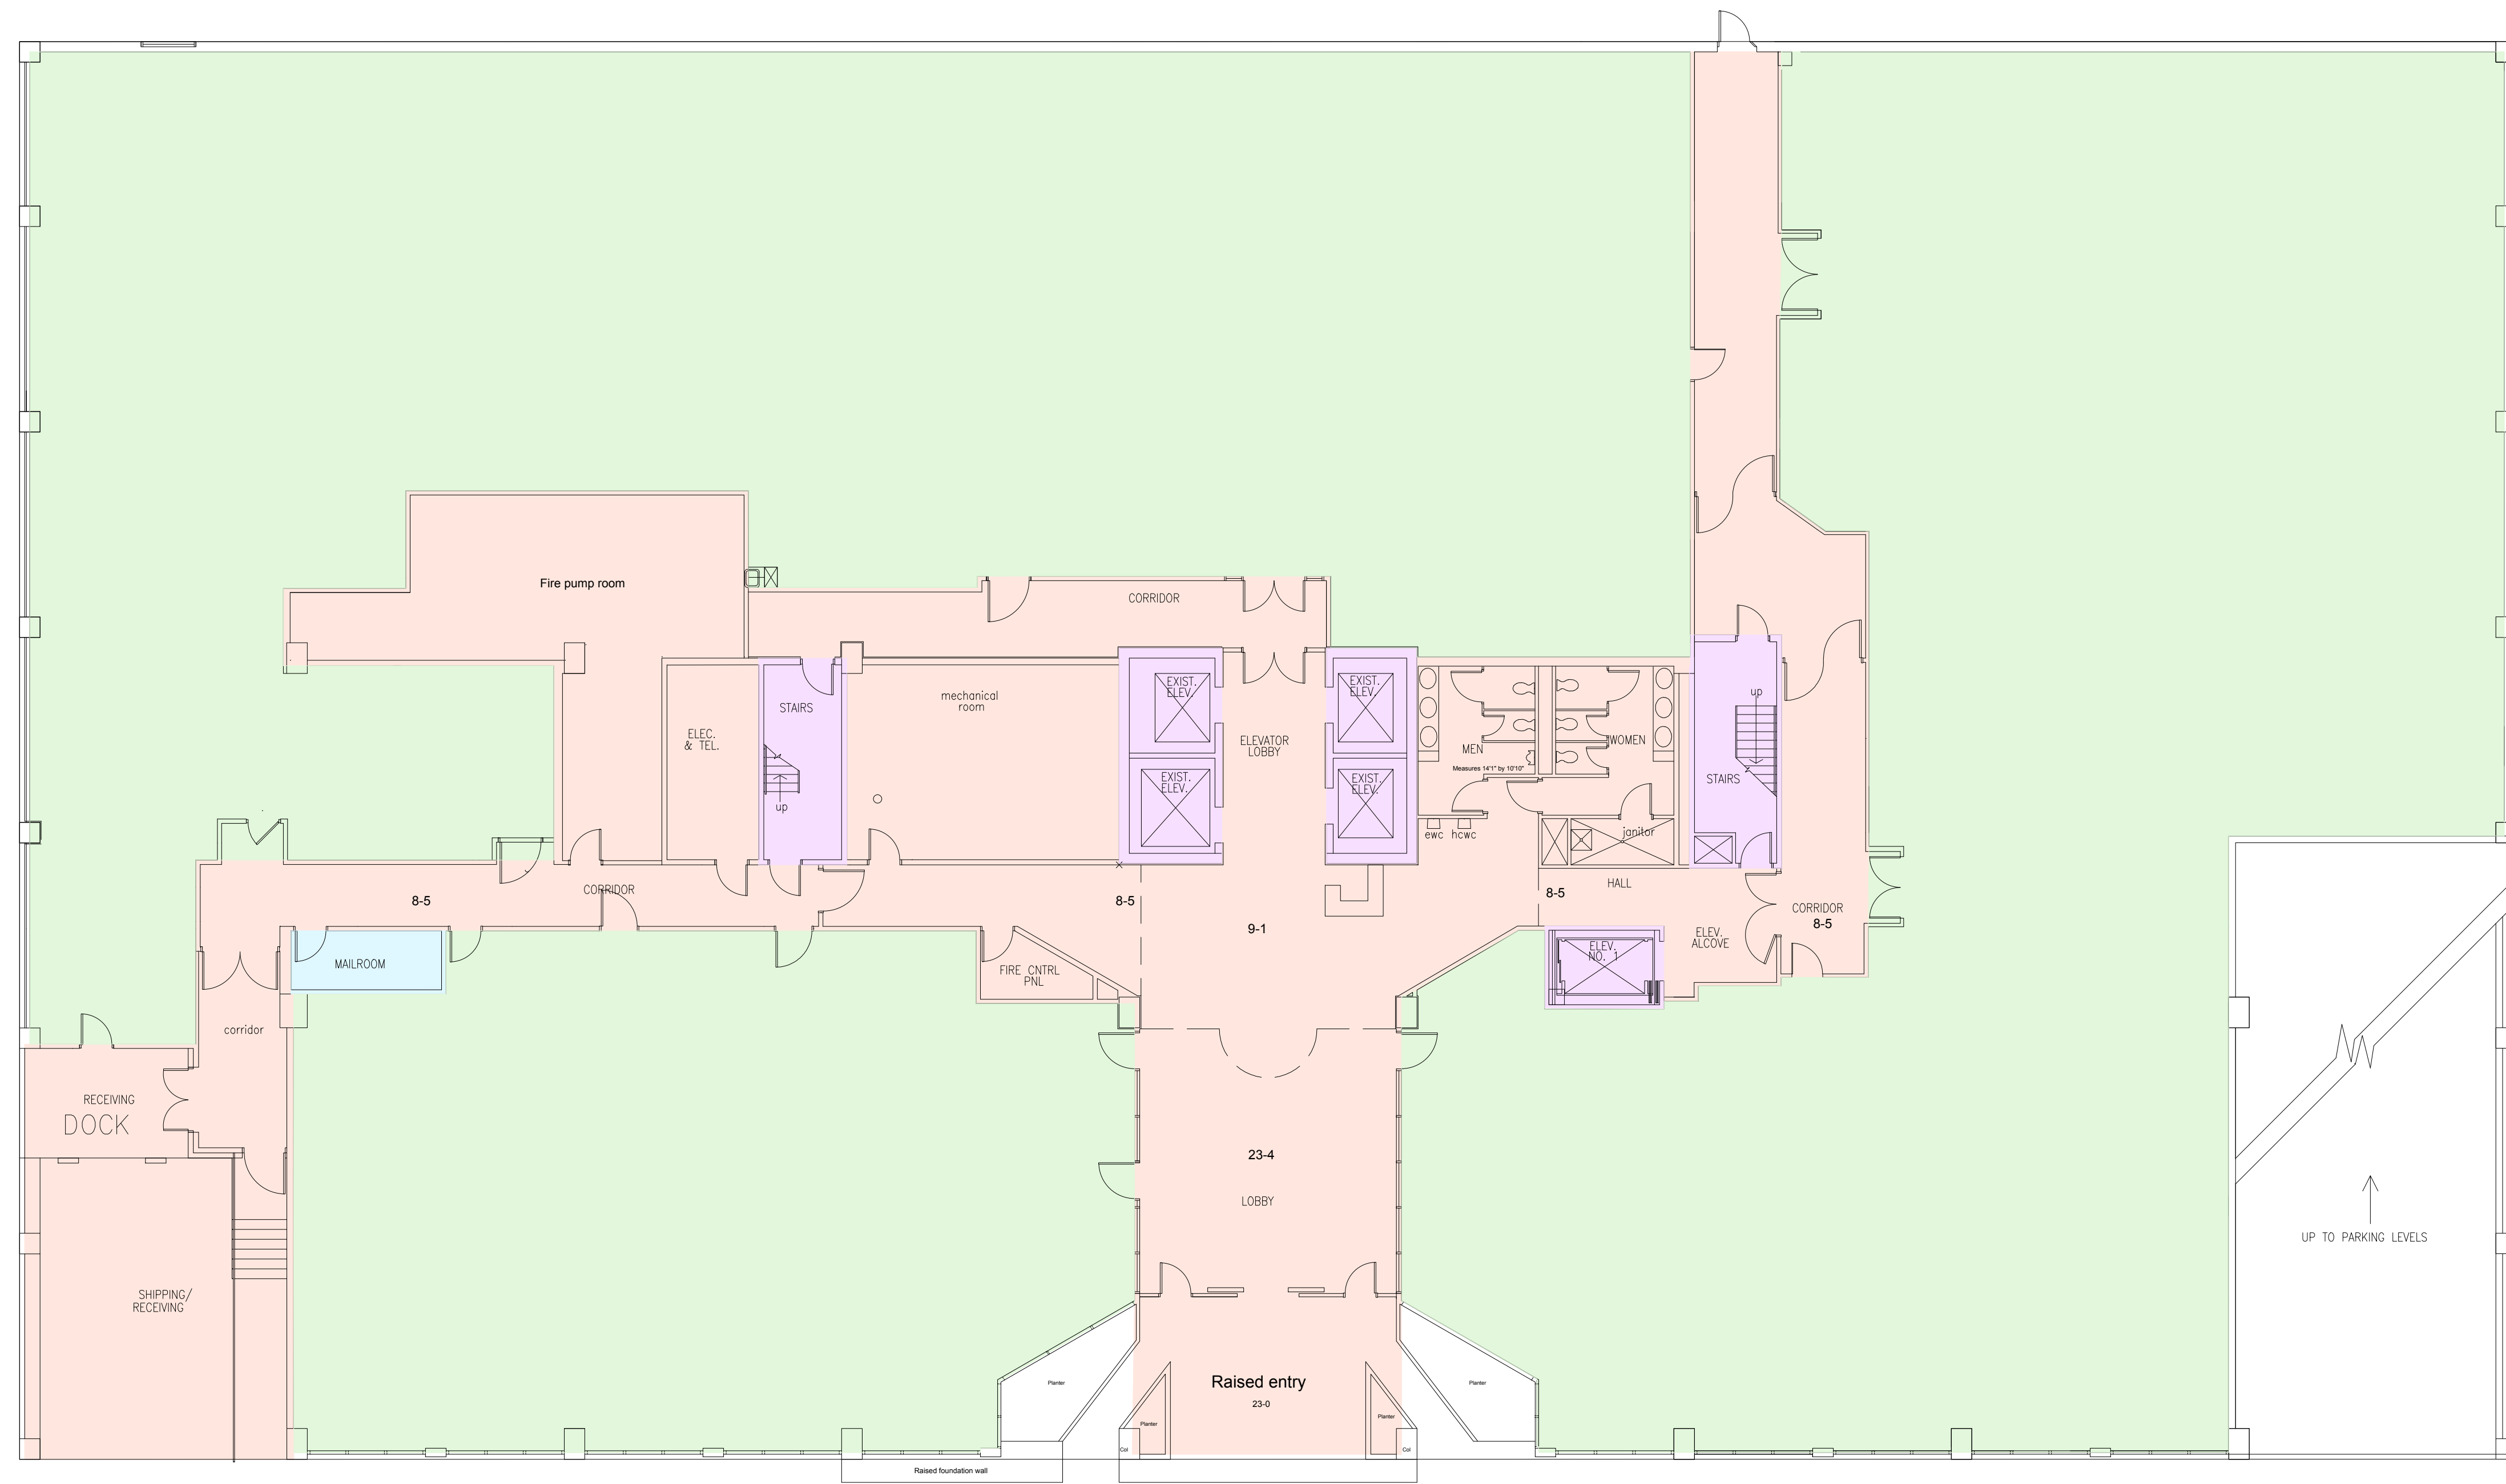

FIRST FLOOR
PAVILLION MEDICAL OFFICE BUILDING

AREA DATA	
INTERIOR GROSS AREA	= 32714
MAJOR VERTICAL PENETRATIONS	= 865
PARKING	= 0
OCCUPANT STORAGE	= 0
OCCUPANT AREA	= 22708
BUILDING AMENITIES	= 93
FLOOR SERVICE AREA	= 7404

ARCHITECTURAL BOMA ANALYSIS
Santa Rosa Professional Pavilion
San Antonio, TX

KEY

- MAJOR VERTICAL PENETRATIONS
- OCCUPANT AREA
- BUILDING AMENITY
- FLOOR SERVICE AREA

01	100% SUBMISSION	
NO.	ISSUES REVISIONS	DATE
HL		PROJECT MANAGER
HL		PROJECT DIRECTOR
012317-1		PROJECT NUMBER
3/32"=1'-0"		SCALE
CL		DRAWN BY
		SHEET NUMBER

ARCHITECTURAL BOMA ANALYSIS
Santa Rosa Professional Pavilion
San Antonio, TX




SECOND FLOOR
PAVILION MEDICAL OFFICE BUILDING

AREA DATA		
INTERIOR GROSS AREA	=	31719
MAJOR VERTICAL PENETRATIONS	=	862
PARKING	=	17791
OCCUPANT STORAGE	=	0
OCCUPANT AREA	=	8268
BUILDING AMENITIES	=	0
FLOOR SERVICE AREA	=	4798

KEY

- MAJOR VERTICAL PENETRATIONS
- OCCUPANT AREA
- BUILDING AMENITY
- FLOOR SERVICE AREA

01	100% SUBMISSION	
NO.	ISSUES REVISIONS	DATE
HL		PROJECT MANAGER
HL		PROJECT DIRECTOR
012317-1		PROJECT NUMBER
3/32"=1'-0"		SCALE
CL		DRAWN BY
		SHEET NUMBER

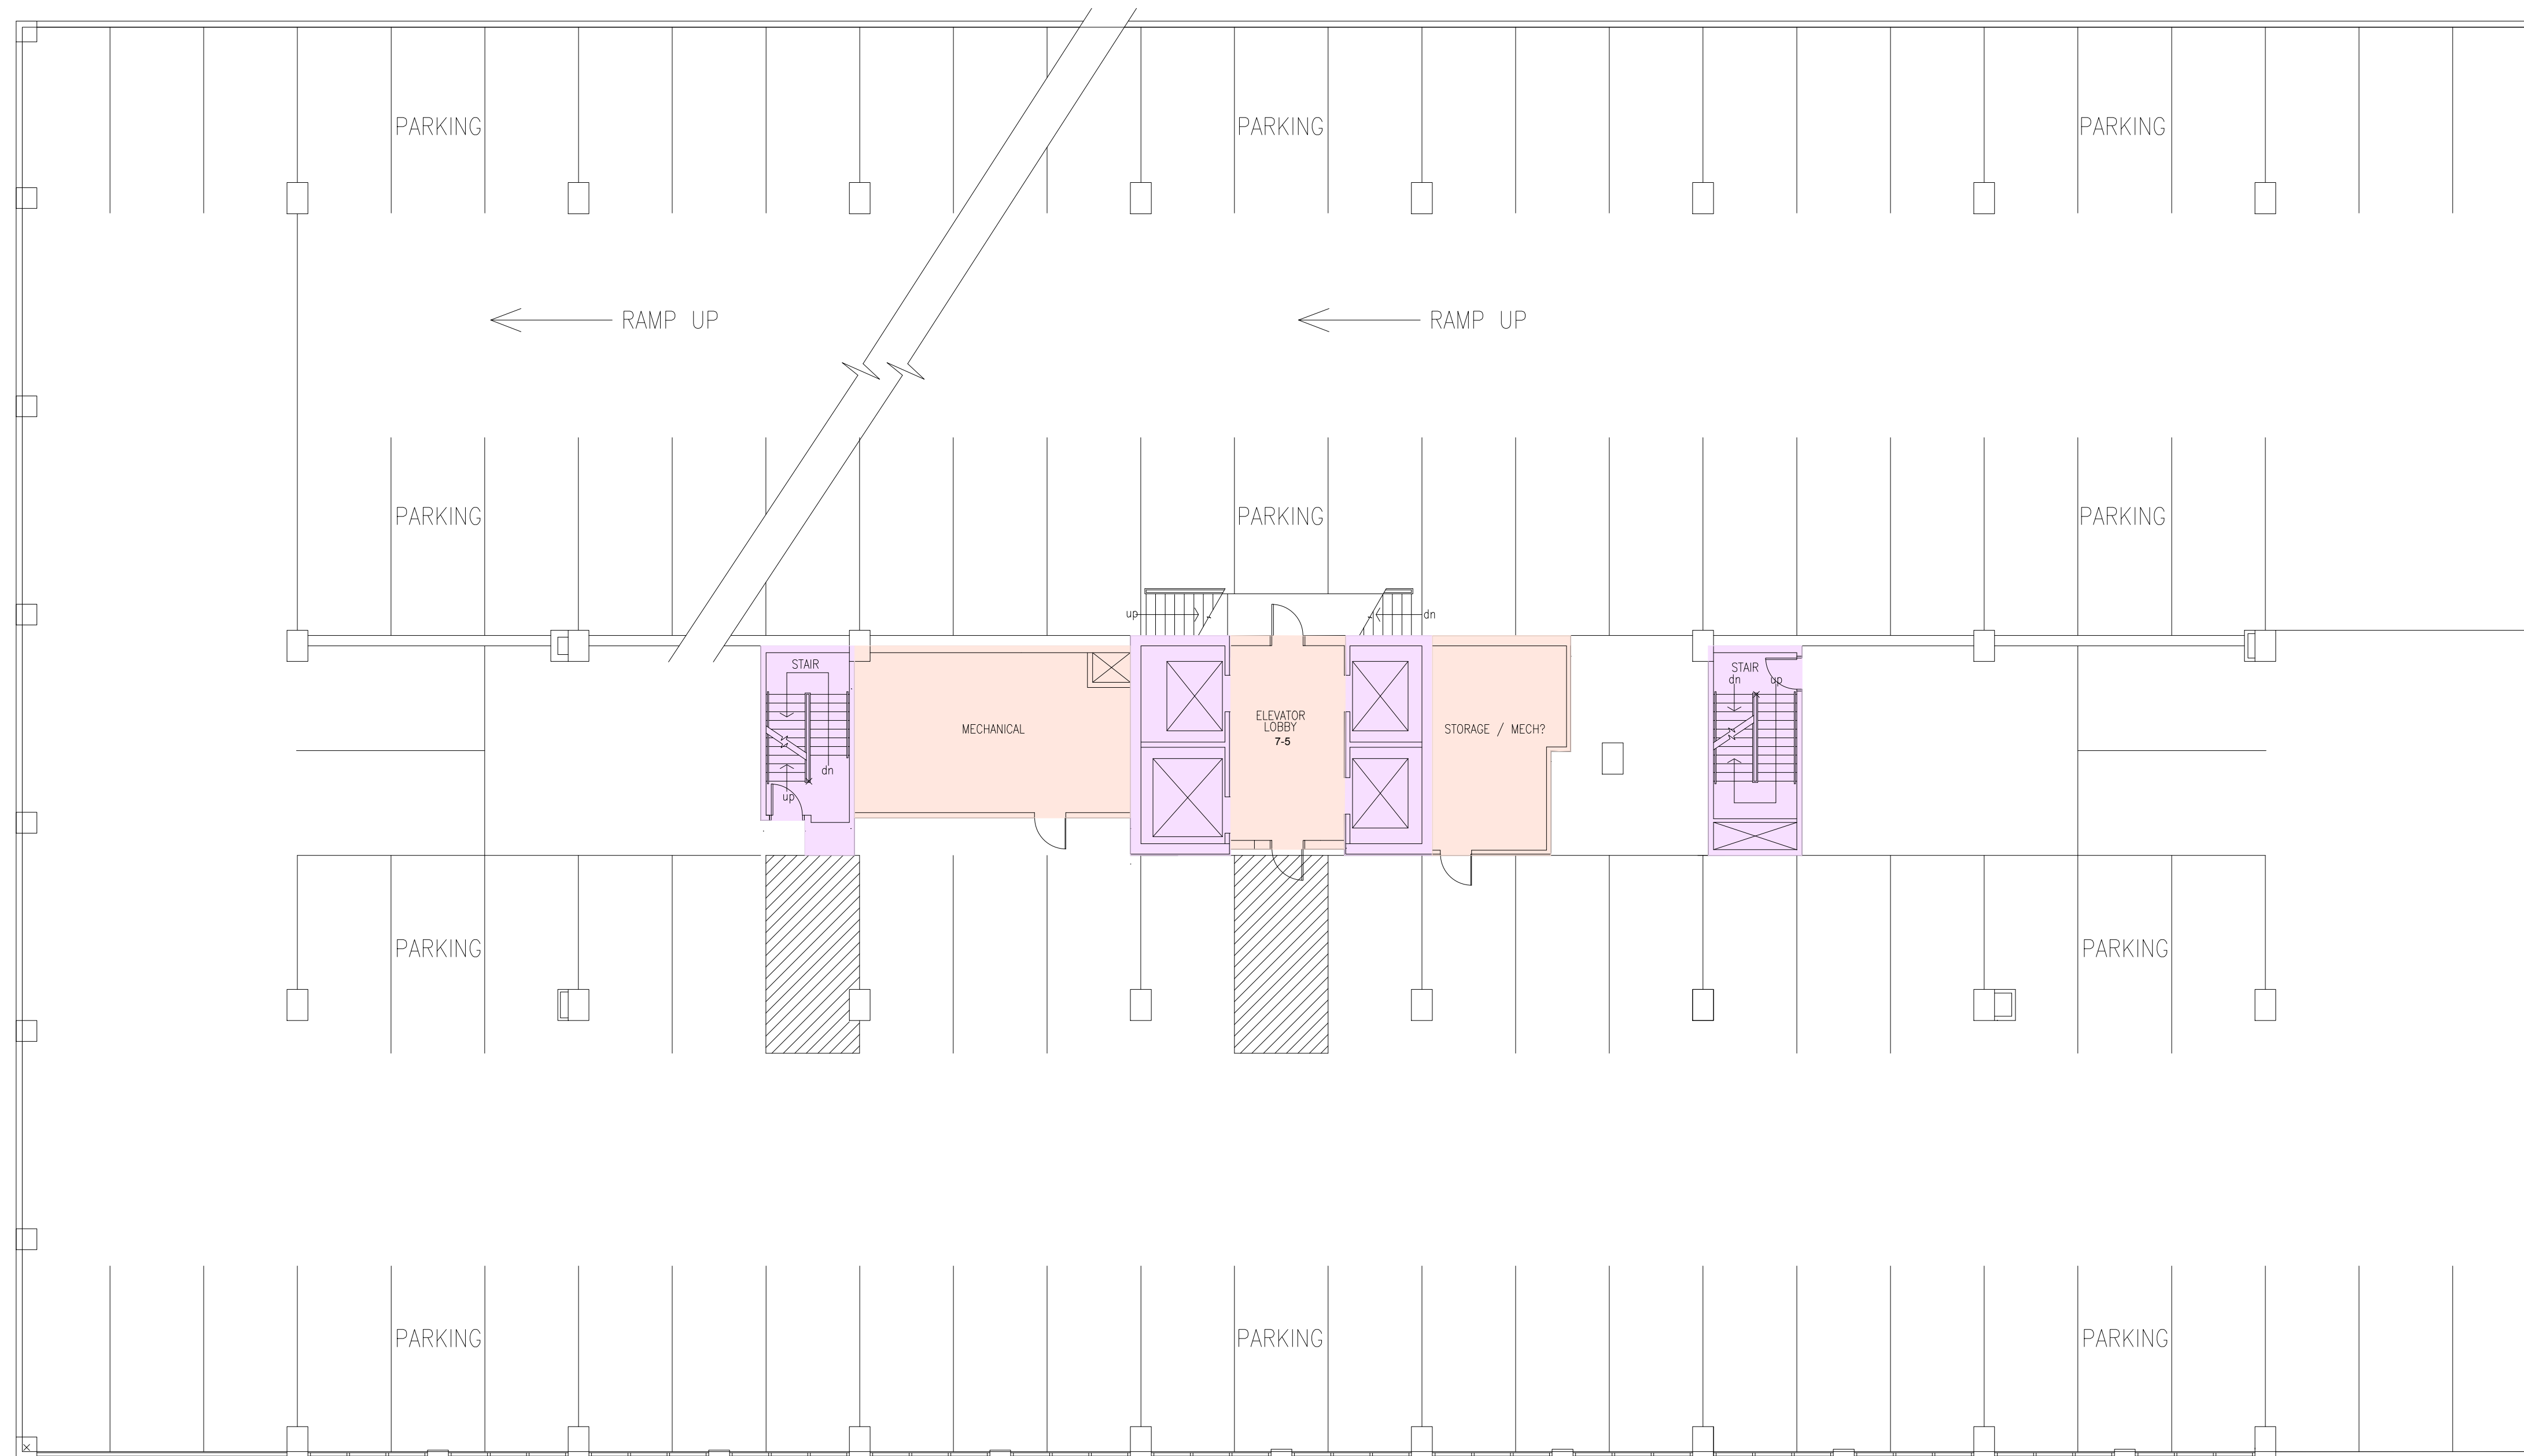

FLOORS THREE THROUGH EIGHT
PAVILION MEDICAL OFFICE BUILDING


AREA DATA	
INTERIOR GROSS AREA	= 33084
MAJOR VERTICAL PENETRATIONS	= 728
PARKING	= 31431
OCCUPANT STORAGE	= 0
OCCUPANT AREA	= 0
BUILDING AMENITIES	= 0
FLOOR SERVICE AREA	= 925

ARCHITECTURAL BOMA ANALYSIS
Santa Rosa Professional Pavilion
San Antonio, TX

KEY

- MAJOR VERTICAL PENETRATIONS
- OCCUPANT AREA
- BUILDING AMENITY
- FLOOR SERVICE AREA

01	100% SUBMISSION	
NO.	ISSUES REVISIONS	DATE
HL		PROJECT MANAGER
HL		PROJECT DIRECTOR
012317-1		PROJECT NUMBER
3/32"=1'-0"		SCALE
CL		DRAWN BY
		SHEET NUMBER

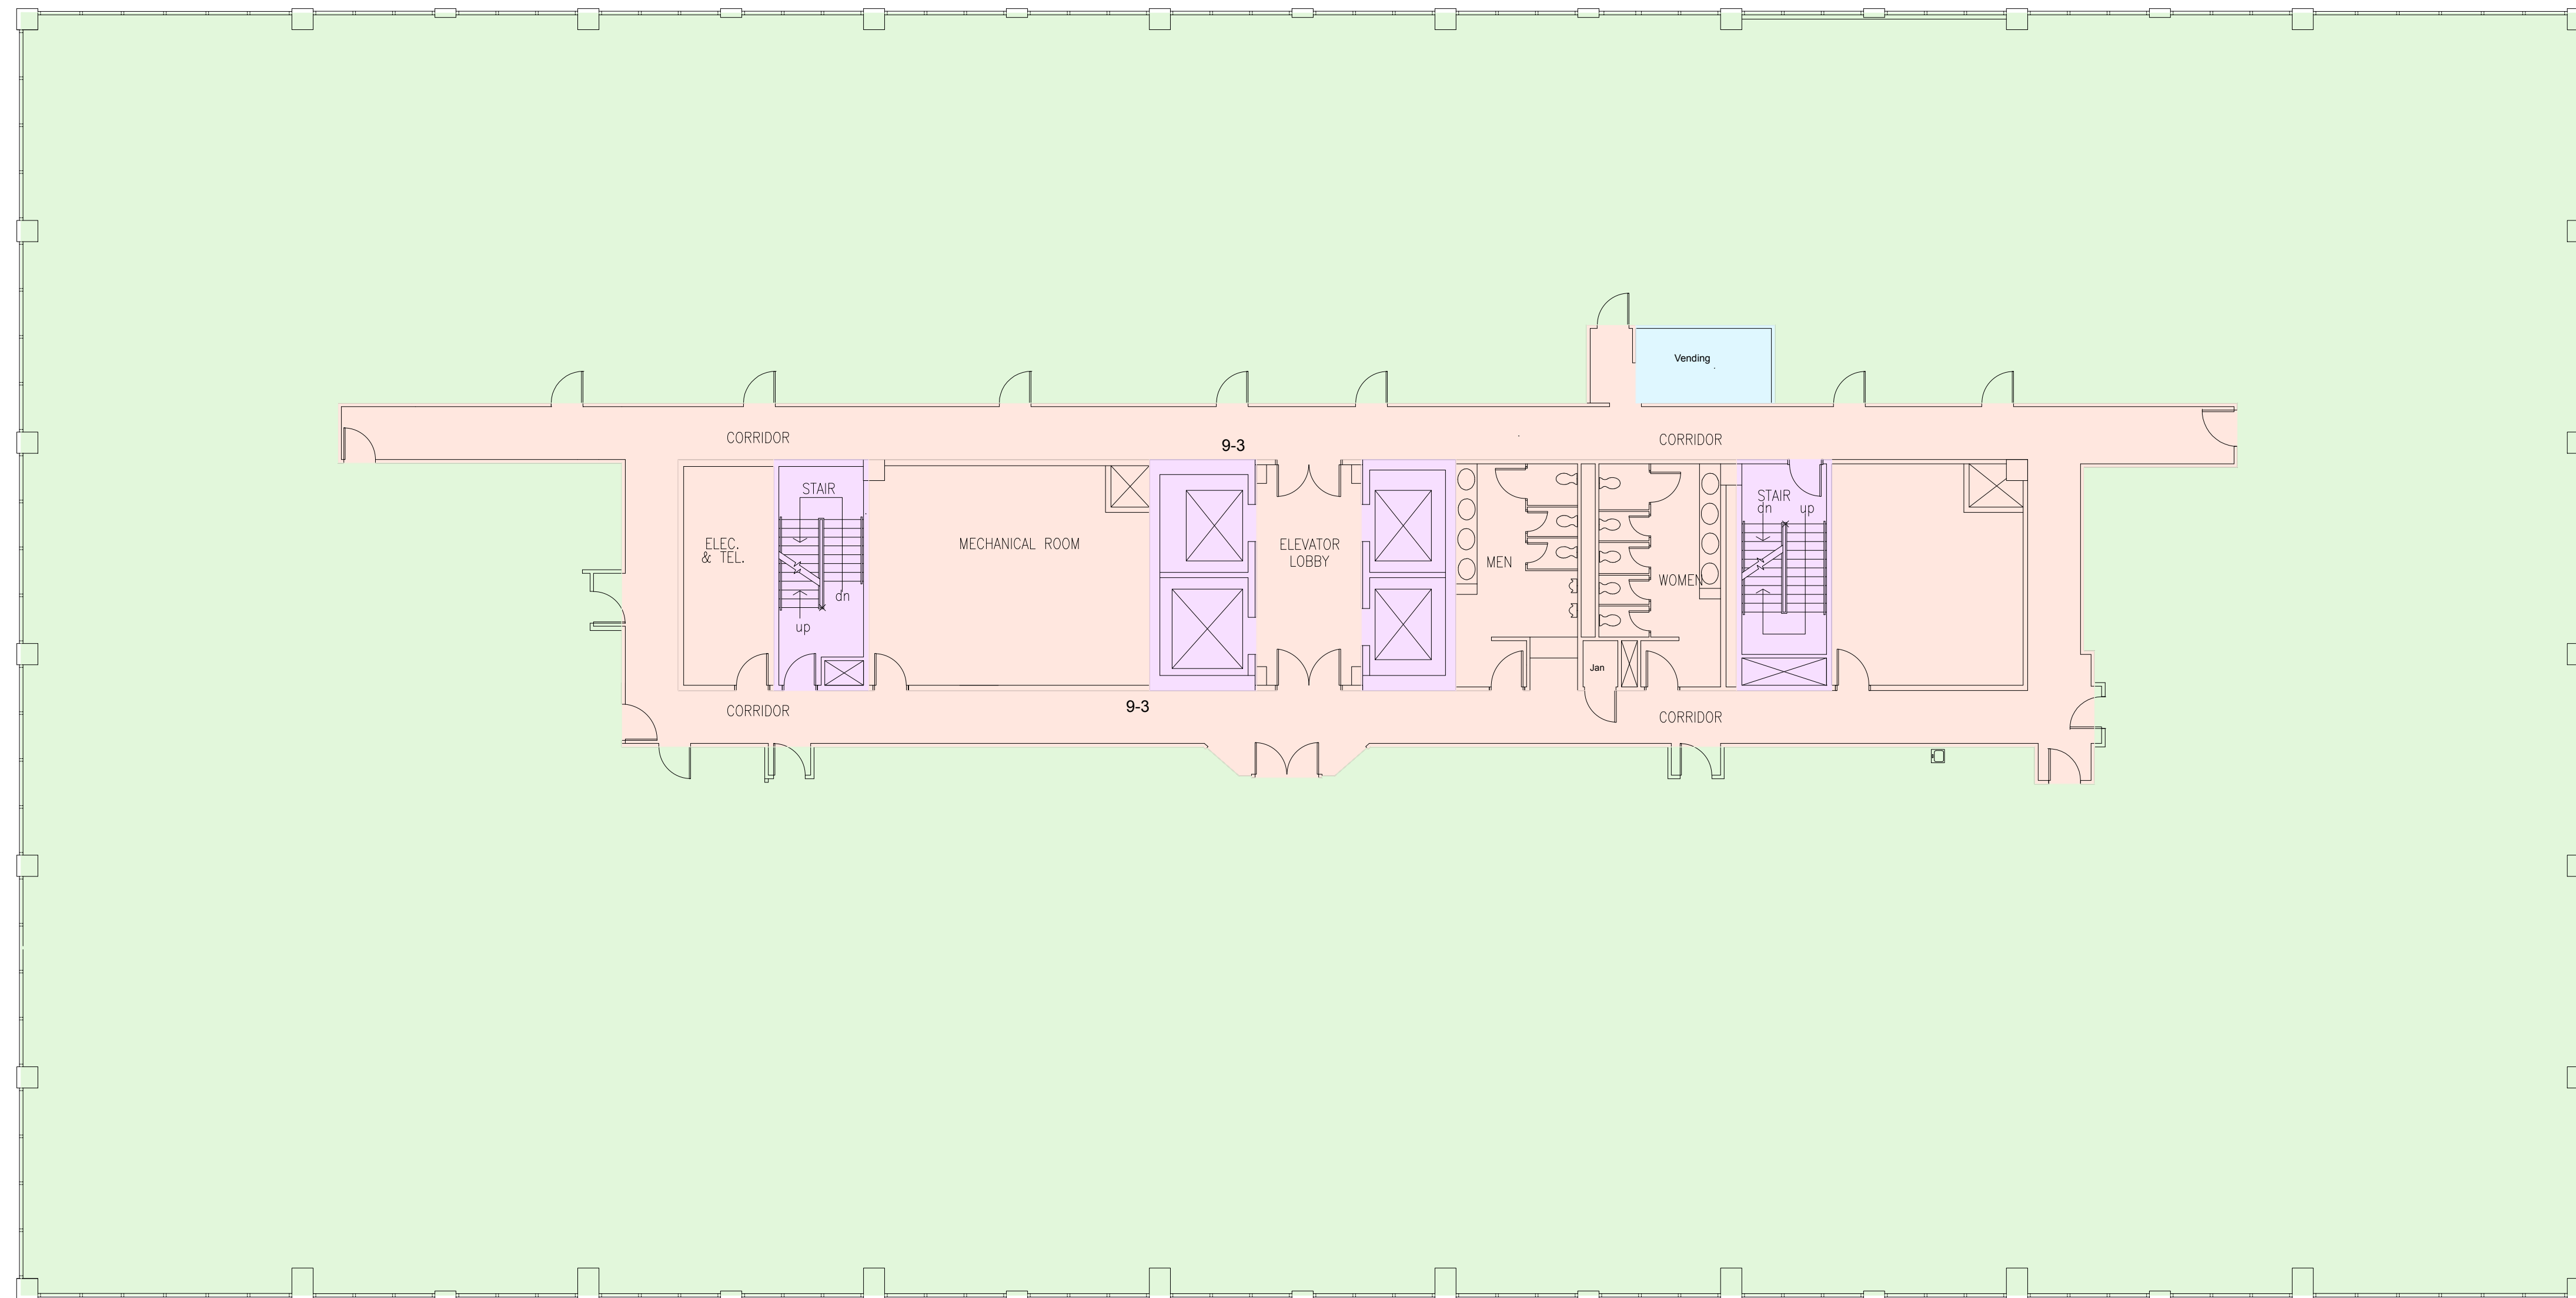

NINTH FLOOR
PAVILION MEDICAL OFFICE BUILDING


AREA DATA	
INTERIOR GROSS AREA	= 29340
MAJOR VERTICAL PENETRATIONS	= 809
PARKING	= 0
OCCUPANT STORAGE	= 0
OCCUPANT AREA	= 24415
BUILDING AMENITIES	= 97
FLOOR SERVICE AREA	= 4019

ARCHITECTURAL BOMA ANALYSIS
Santa Rosa Professional Pavilion
San Antonio, TX

KEY

- MAJOR VERTICAL PENETRATIONS
- OCCUPANT AREA
- BUILDING AMENITY
- FLOOR SERVICE AREA

01	100% SUBMISSION	
NO.	ISSUES REVISIONS	DATE
HL		PROJECT MANAGER
HL		PROJECT DIRECTOR
012317-1		PROJECT NUMBER
3/32"=1'-0"		SCALE
CL		DRAWN BY
		SHEET NUMBER

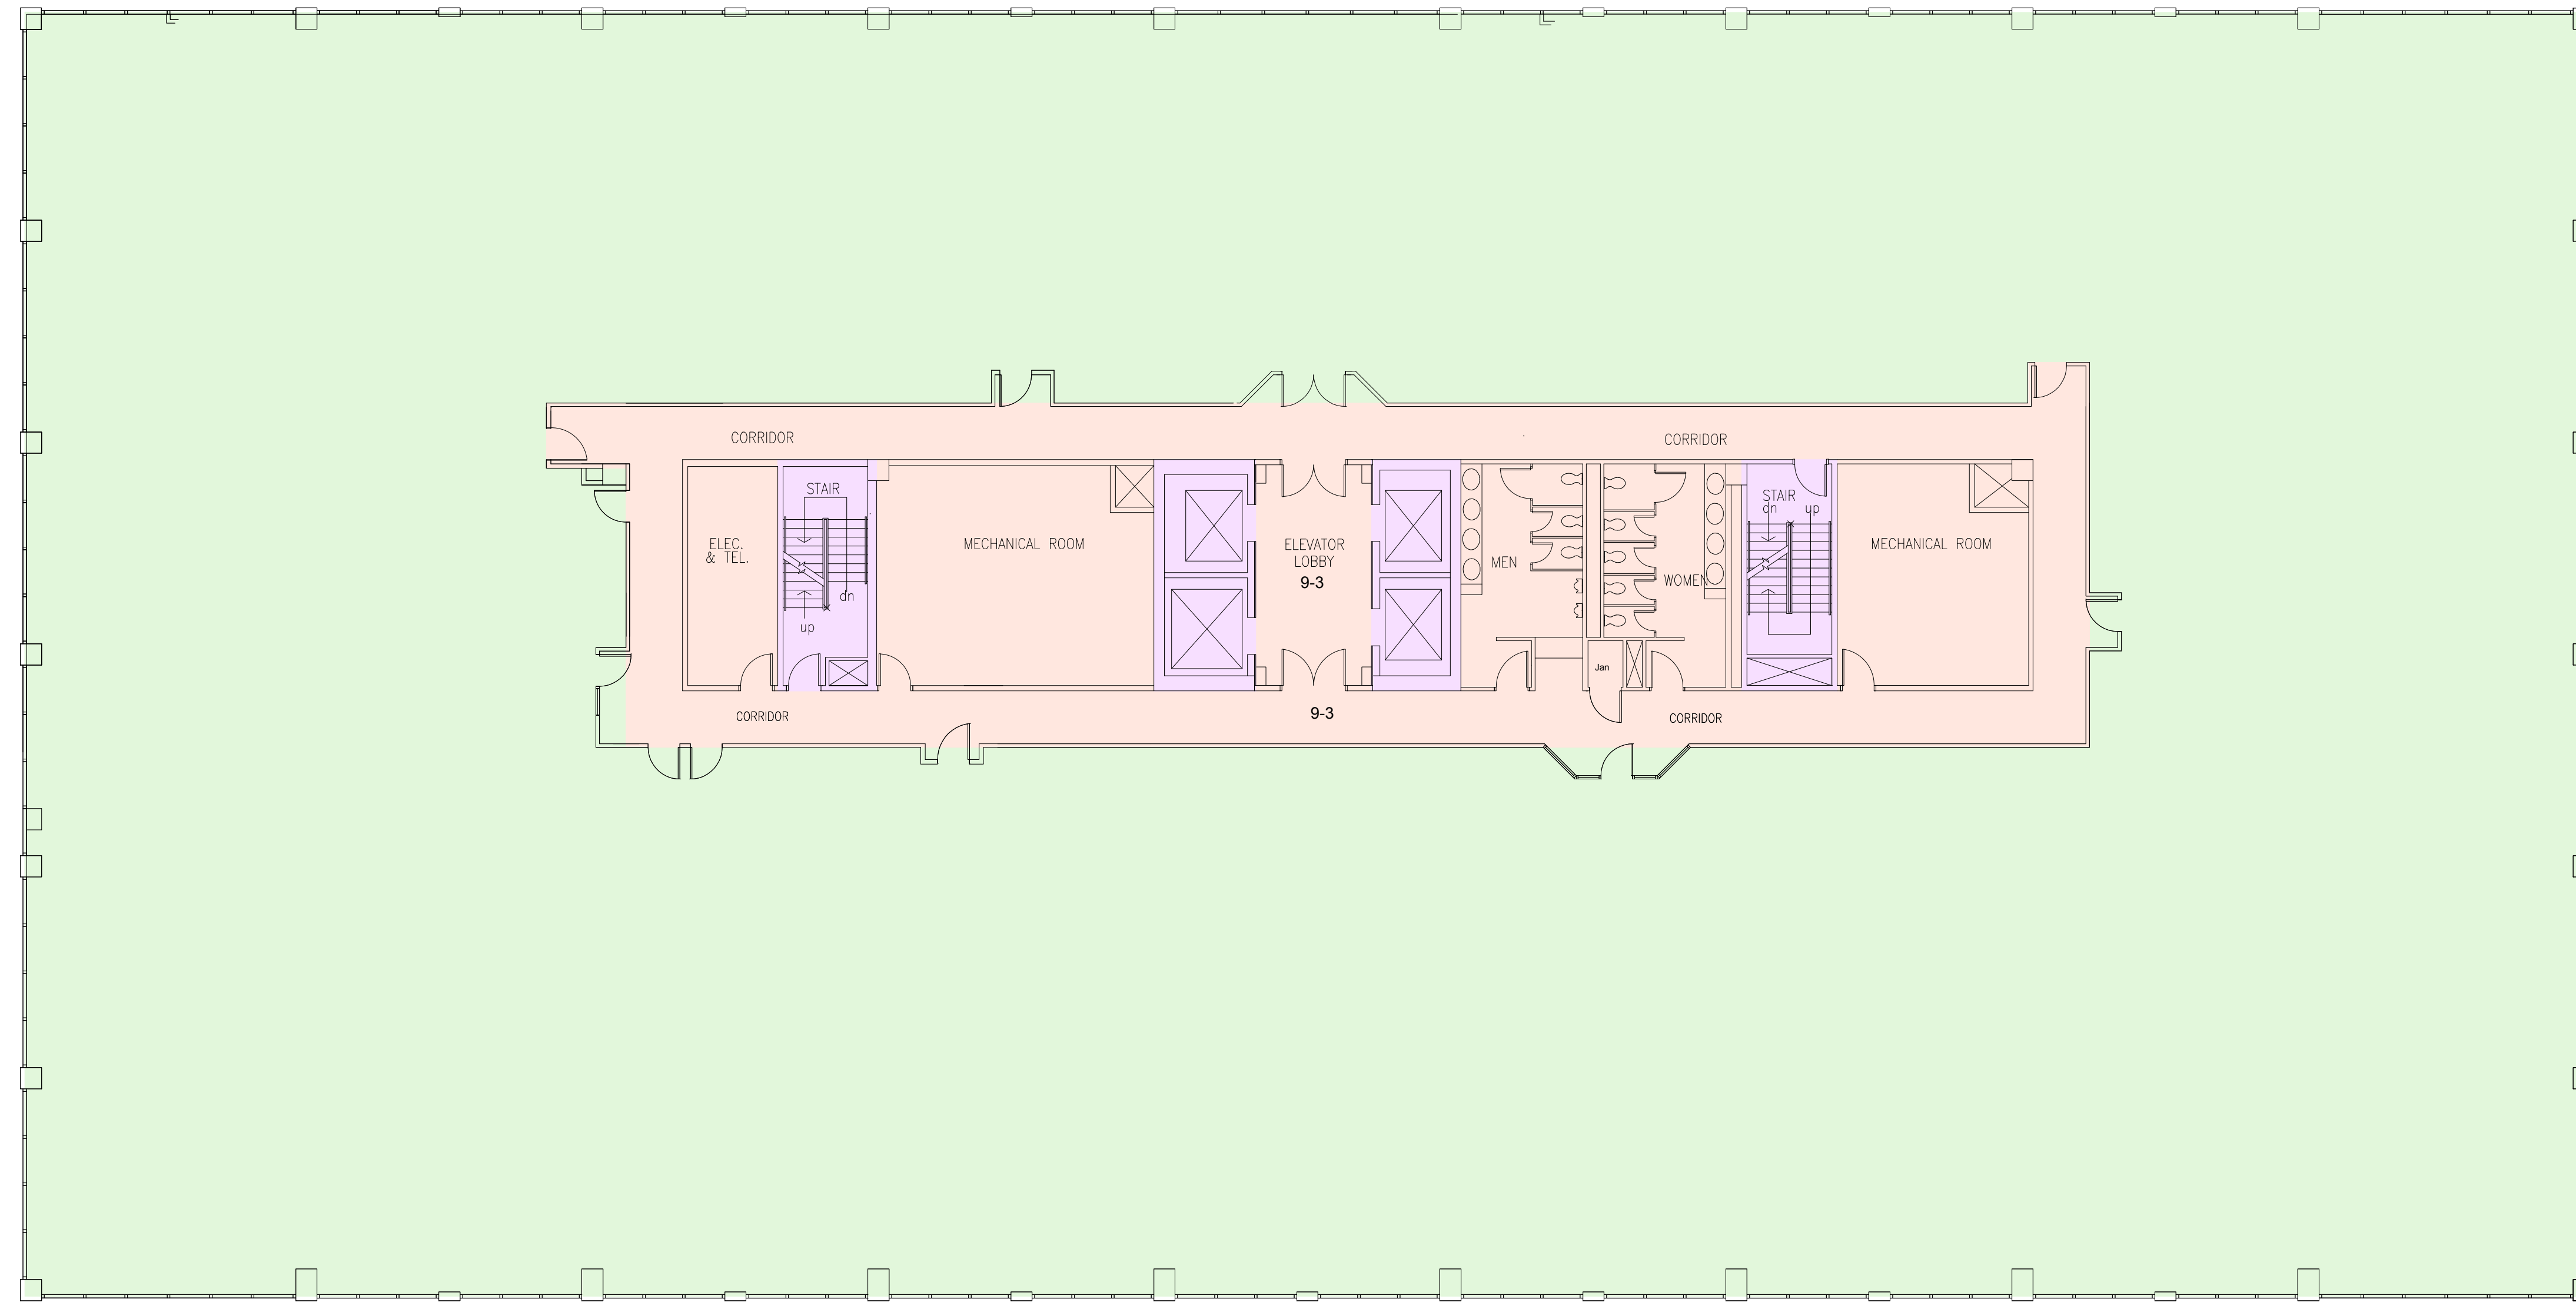

TENTH FLOOR
PAVILION MEDICAL OFFICE BUILDING


AREA DATA	
INTERIOR GROSS AREA	= 29340
MAJOR VERTICAL PENETRATIONS	= 795
PARKING	= 0
OCCUPANT STORAGE	= 0
OCCUPANT AREA	= 24782
BUILDING AMENITIES	= 0
FLOOR SERVICE AREA	= 3763

ARCHITECTURAL BOMA ANALYSIS
Santa Rosa Professional Pavilion
San Antonio, TX

KEY

- MAJOR VERTICAL PENETRATIONS
- OCCUPANT AREA
- BUILDING AMENITY
- FLOOR SERVICE AREA

01	100% SUBMISSION	
NO.	ISSUES REVISIONS	DATE
HL		PROJECT MANAGER
HL		PROJECT DIRECTOR
012317-1		PROJECT NUMBER
3/32"=1'-0"		SCALE
CL		DRAWN BY
		SHEET NUMBER

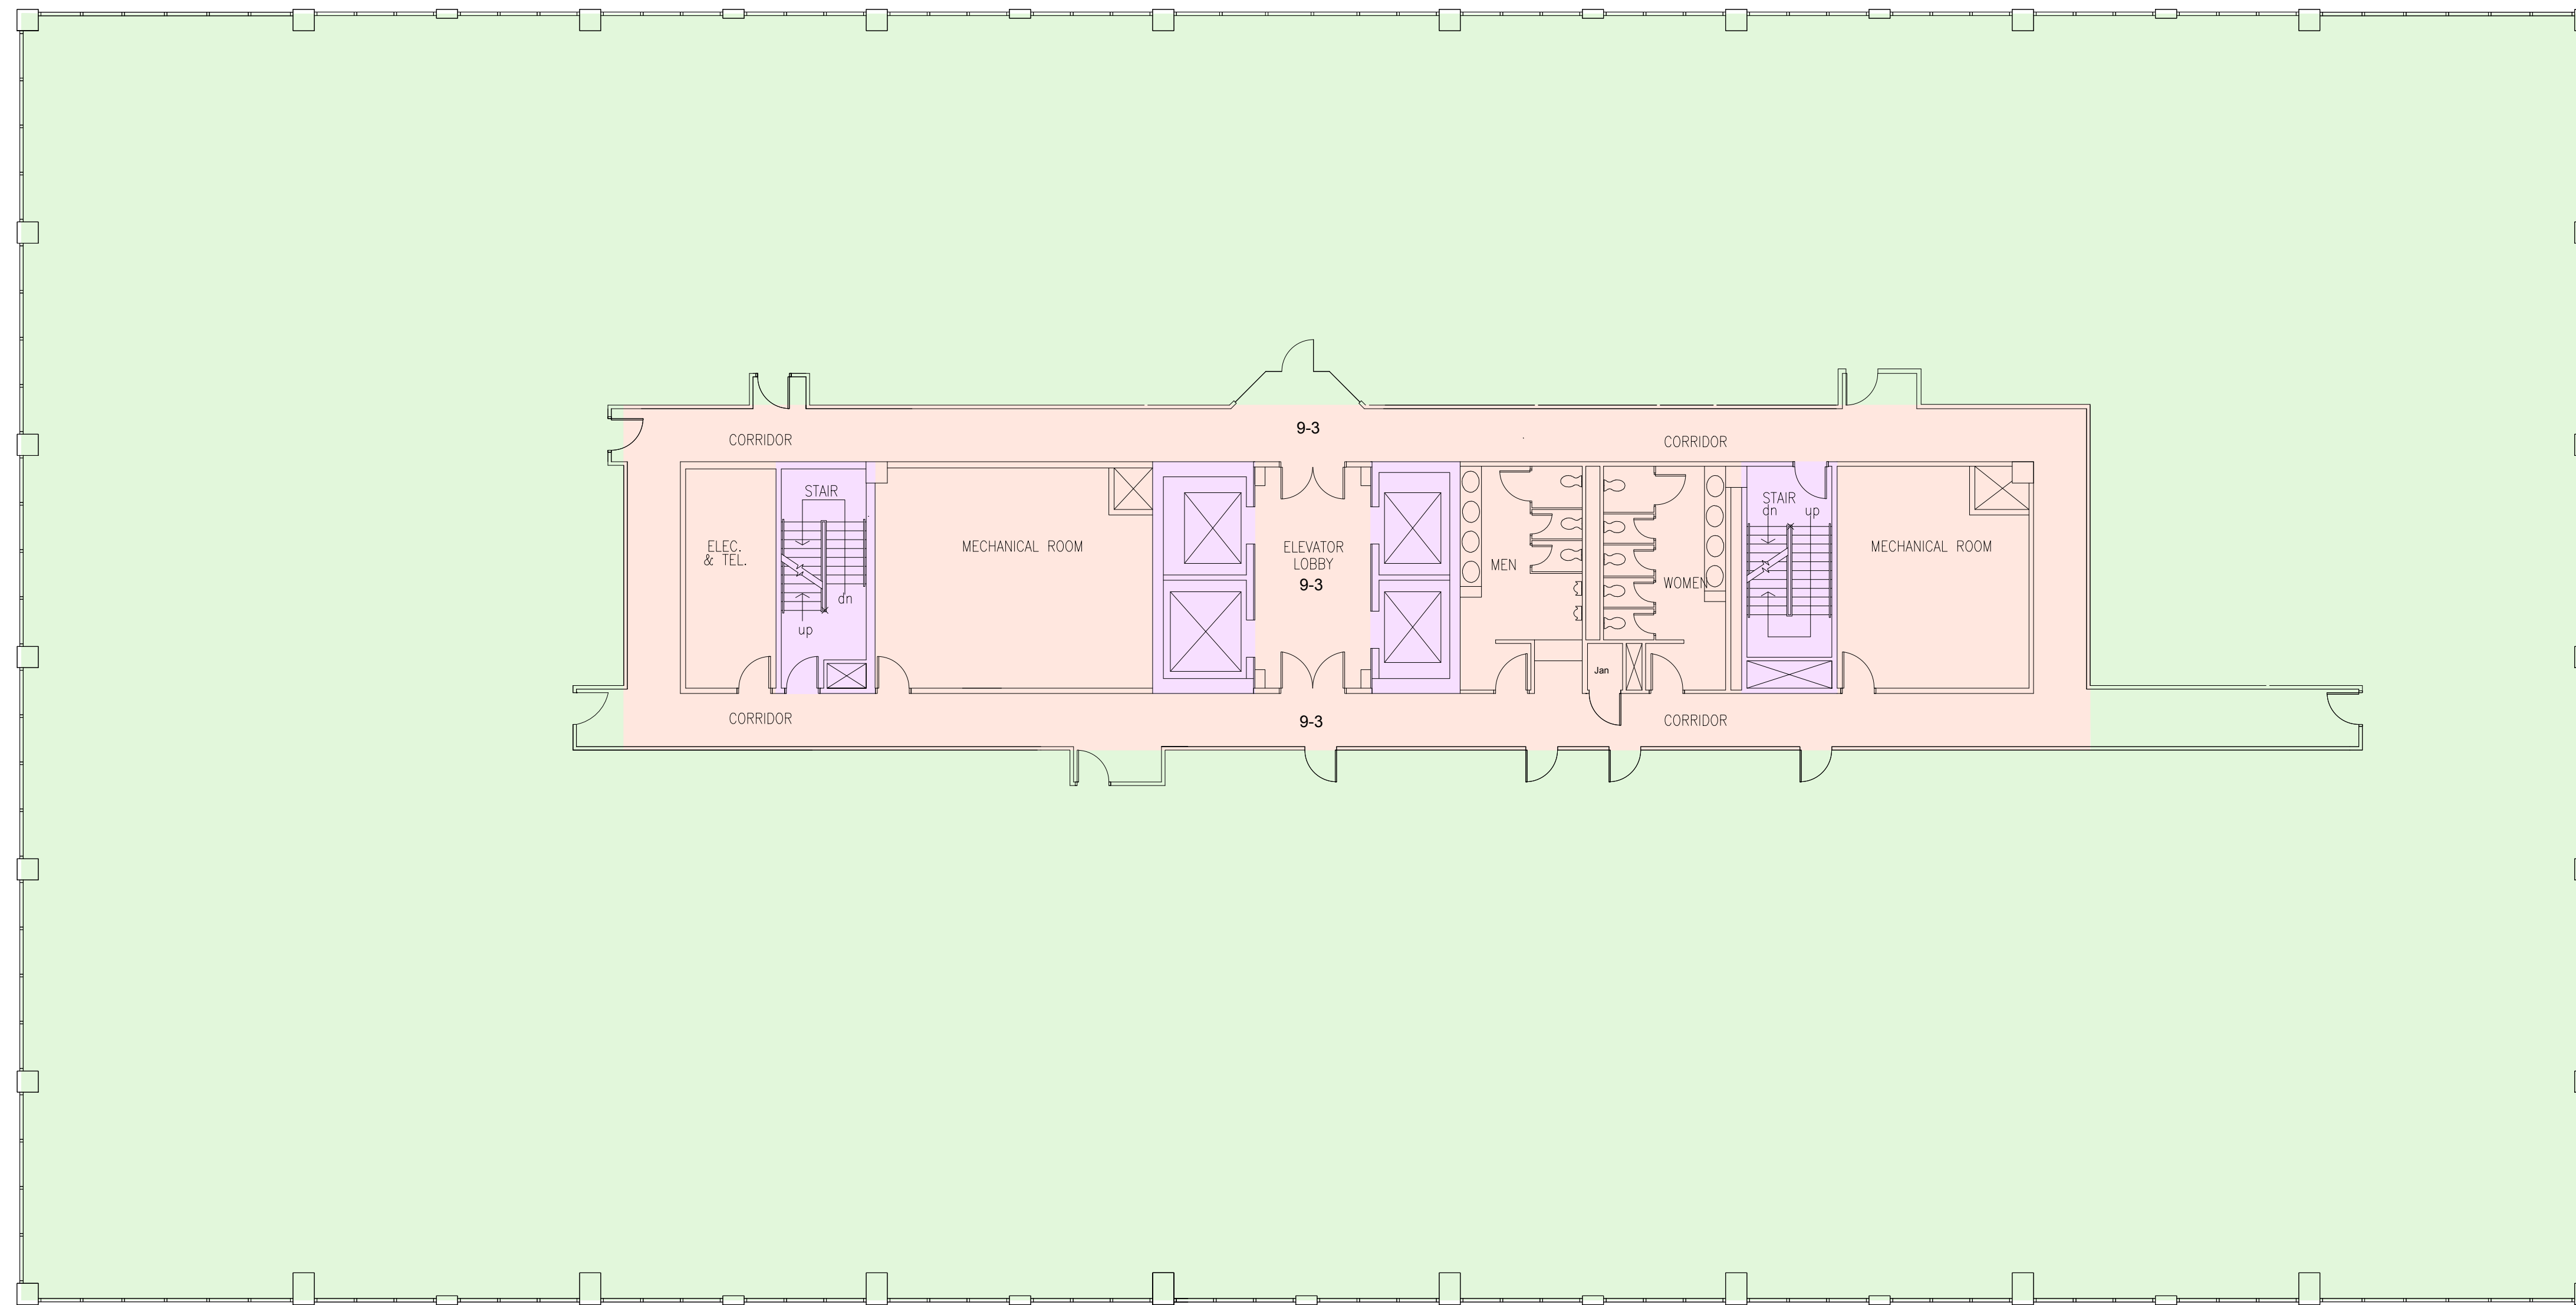

ELEVENTH FLOOR
PAVILION MEDICAL OFFICE BUILDING


AREA DATA	
INTERIOR GROSS AREA	= 29340
MAJOR VERTICAL PENETRATIONS	= 795
PARKING	= 0
OCCUPANT STORAGE	= 0
OCCUPANT AREA	= 24850
BUILDING AMENITIES	= 0
FLOOR SERVICE AREA	= 3695

ARCHITECTURAL BOMA ANALYSIS
Santa Rosa Professional Pavilion
San Antonio, TX

KEY

- MAJOR VERTICAL PENETRATIONS
- OCCUPANT AREA
- BUILDING AMENITY
- FLOOR SERVICE AREA

01	100% SUBMISSION	
NO.	ISSUES REVISIONS	DATE
HL		PROJECT MANAGER
HL		PROJECT DIRECTOR
012317-1		PROJECT NUMBER
3/32"=1'-0"		SCALE
CL		DRAWN BY
		SHEET NUMBER

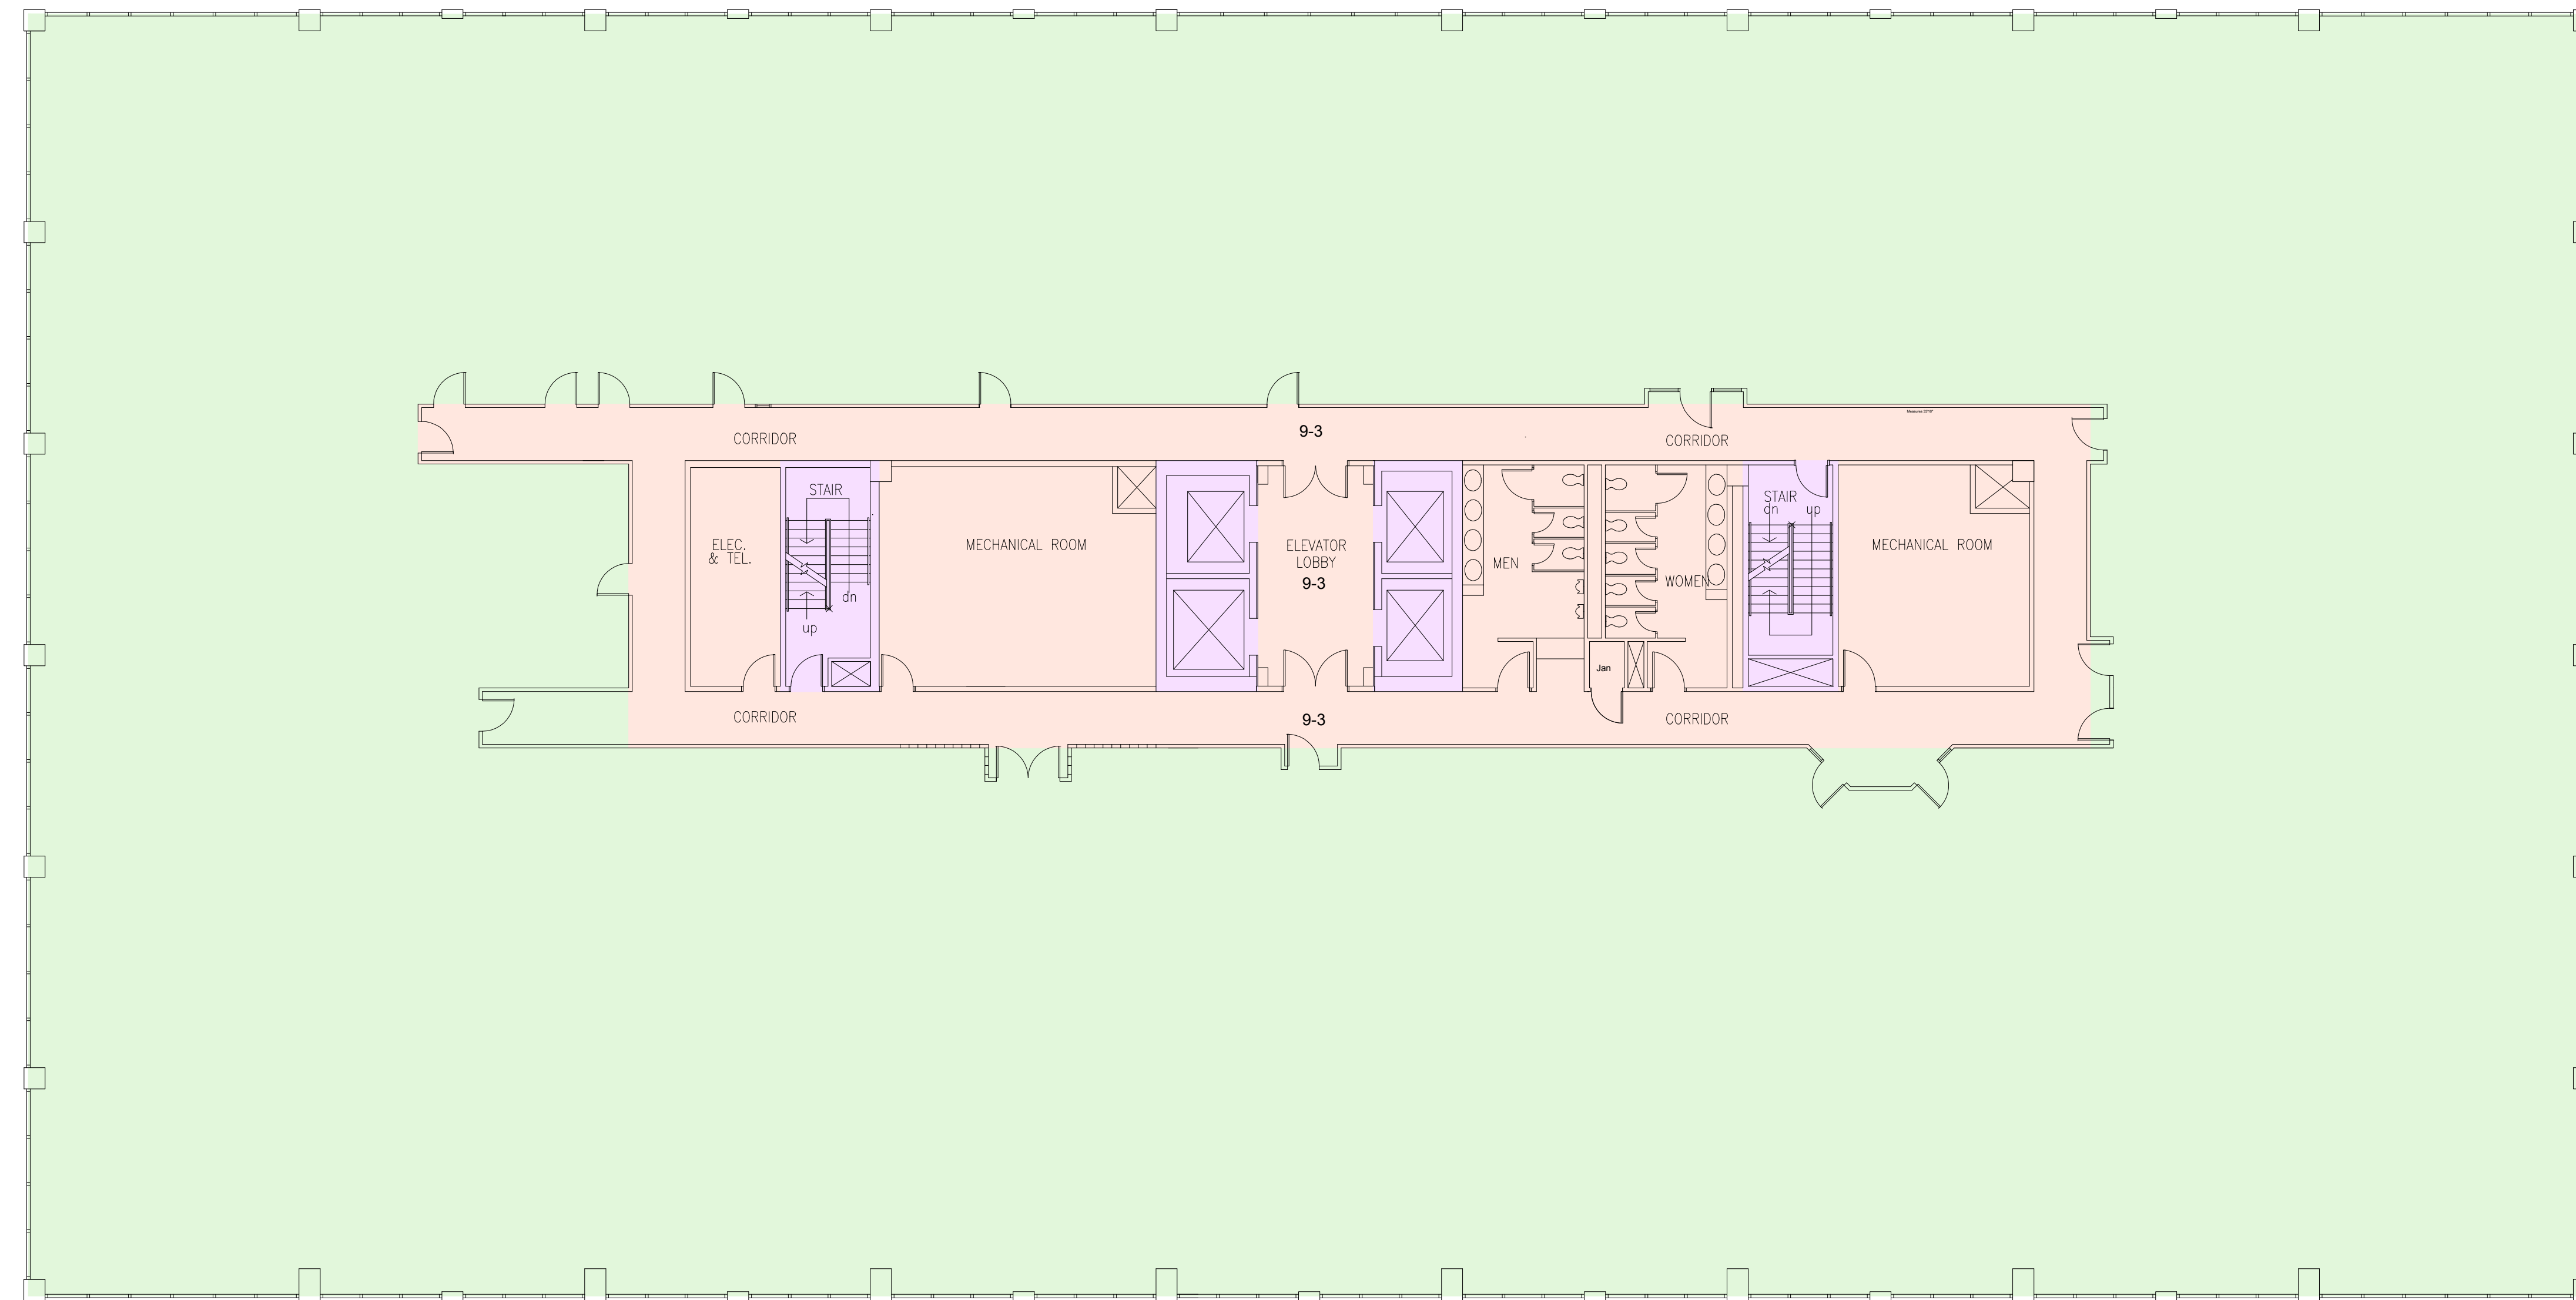

TWELFTH FLOOR
PAVILION MEDICAL OFFICE BUILDING

AREA DATA	
INTERIOR GROSS AREA	= 29340
MAJOR VERTICAL PENETRATIONS	= 795
PARKING	= 0
OCCUPANT STORAGE	= 0
OCCUPANT AREA	= 24737
BUILDING AMENITIES	= 0
FLOOR SERVICE AREA	= 3808

ARCHITECTURAL BOMA ANALYSIS
Santa Rosa Professional Pavilion
San Antonio, TX

KEY

- MAJOR VERTICAL PENETRATIONS
- OCCUPANT AREA
- BUILDING AMENITY
- FLOOR SERVICE AREA

01	100% SUBMISSION	
NO.	ISSUES REVISIONS	DATE
HL		PROJECT MANAGER
HL		PROJECT DIRECTOR
012317-1		PROJECT NUMBER
3/32"=1'-0"		SCALE
CL		DRAWN BY
		SHEET NUMBER