


01	100% SUBMISSION	SEE COVER SHEET
NO.	ISSUES REVISIONS	DATE
		SHEET TITLE

HL	PROJECT MANAGER
HL	PROJECT DIRECTOR
012317-1	PROJECT NUMBER
3/16"=1'-0"	SCALE
CL	DRAWN BY
	SHEET NUMBER


AB-1

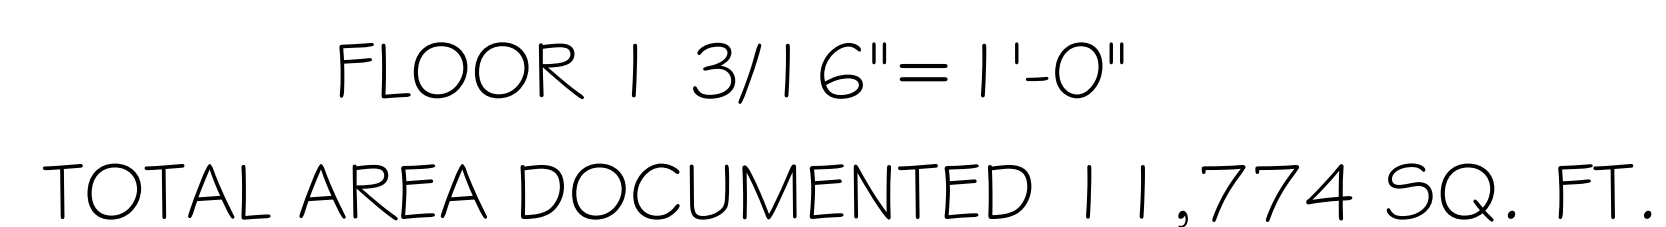

UNIT AREAS			
1-A 2404 SQ. FT.	1-B 1460 SQ. FT.	1-C 445 SQ. FT.	1-D 901 SQ. FT.

WEST TOWER

EAST TOWER

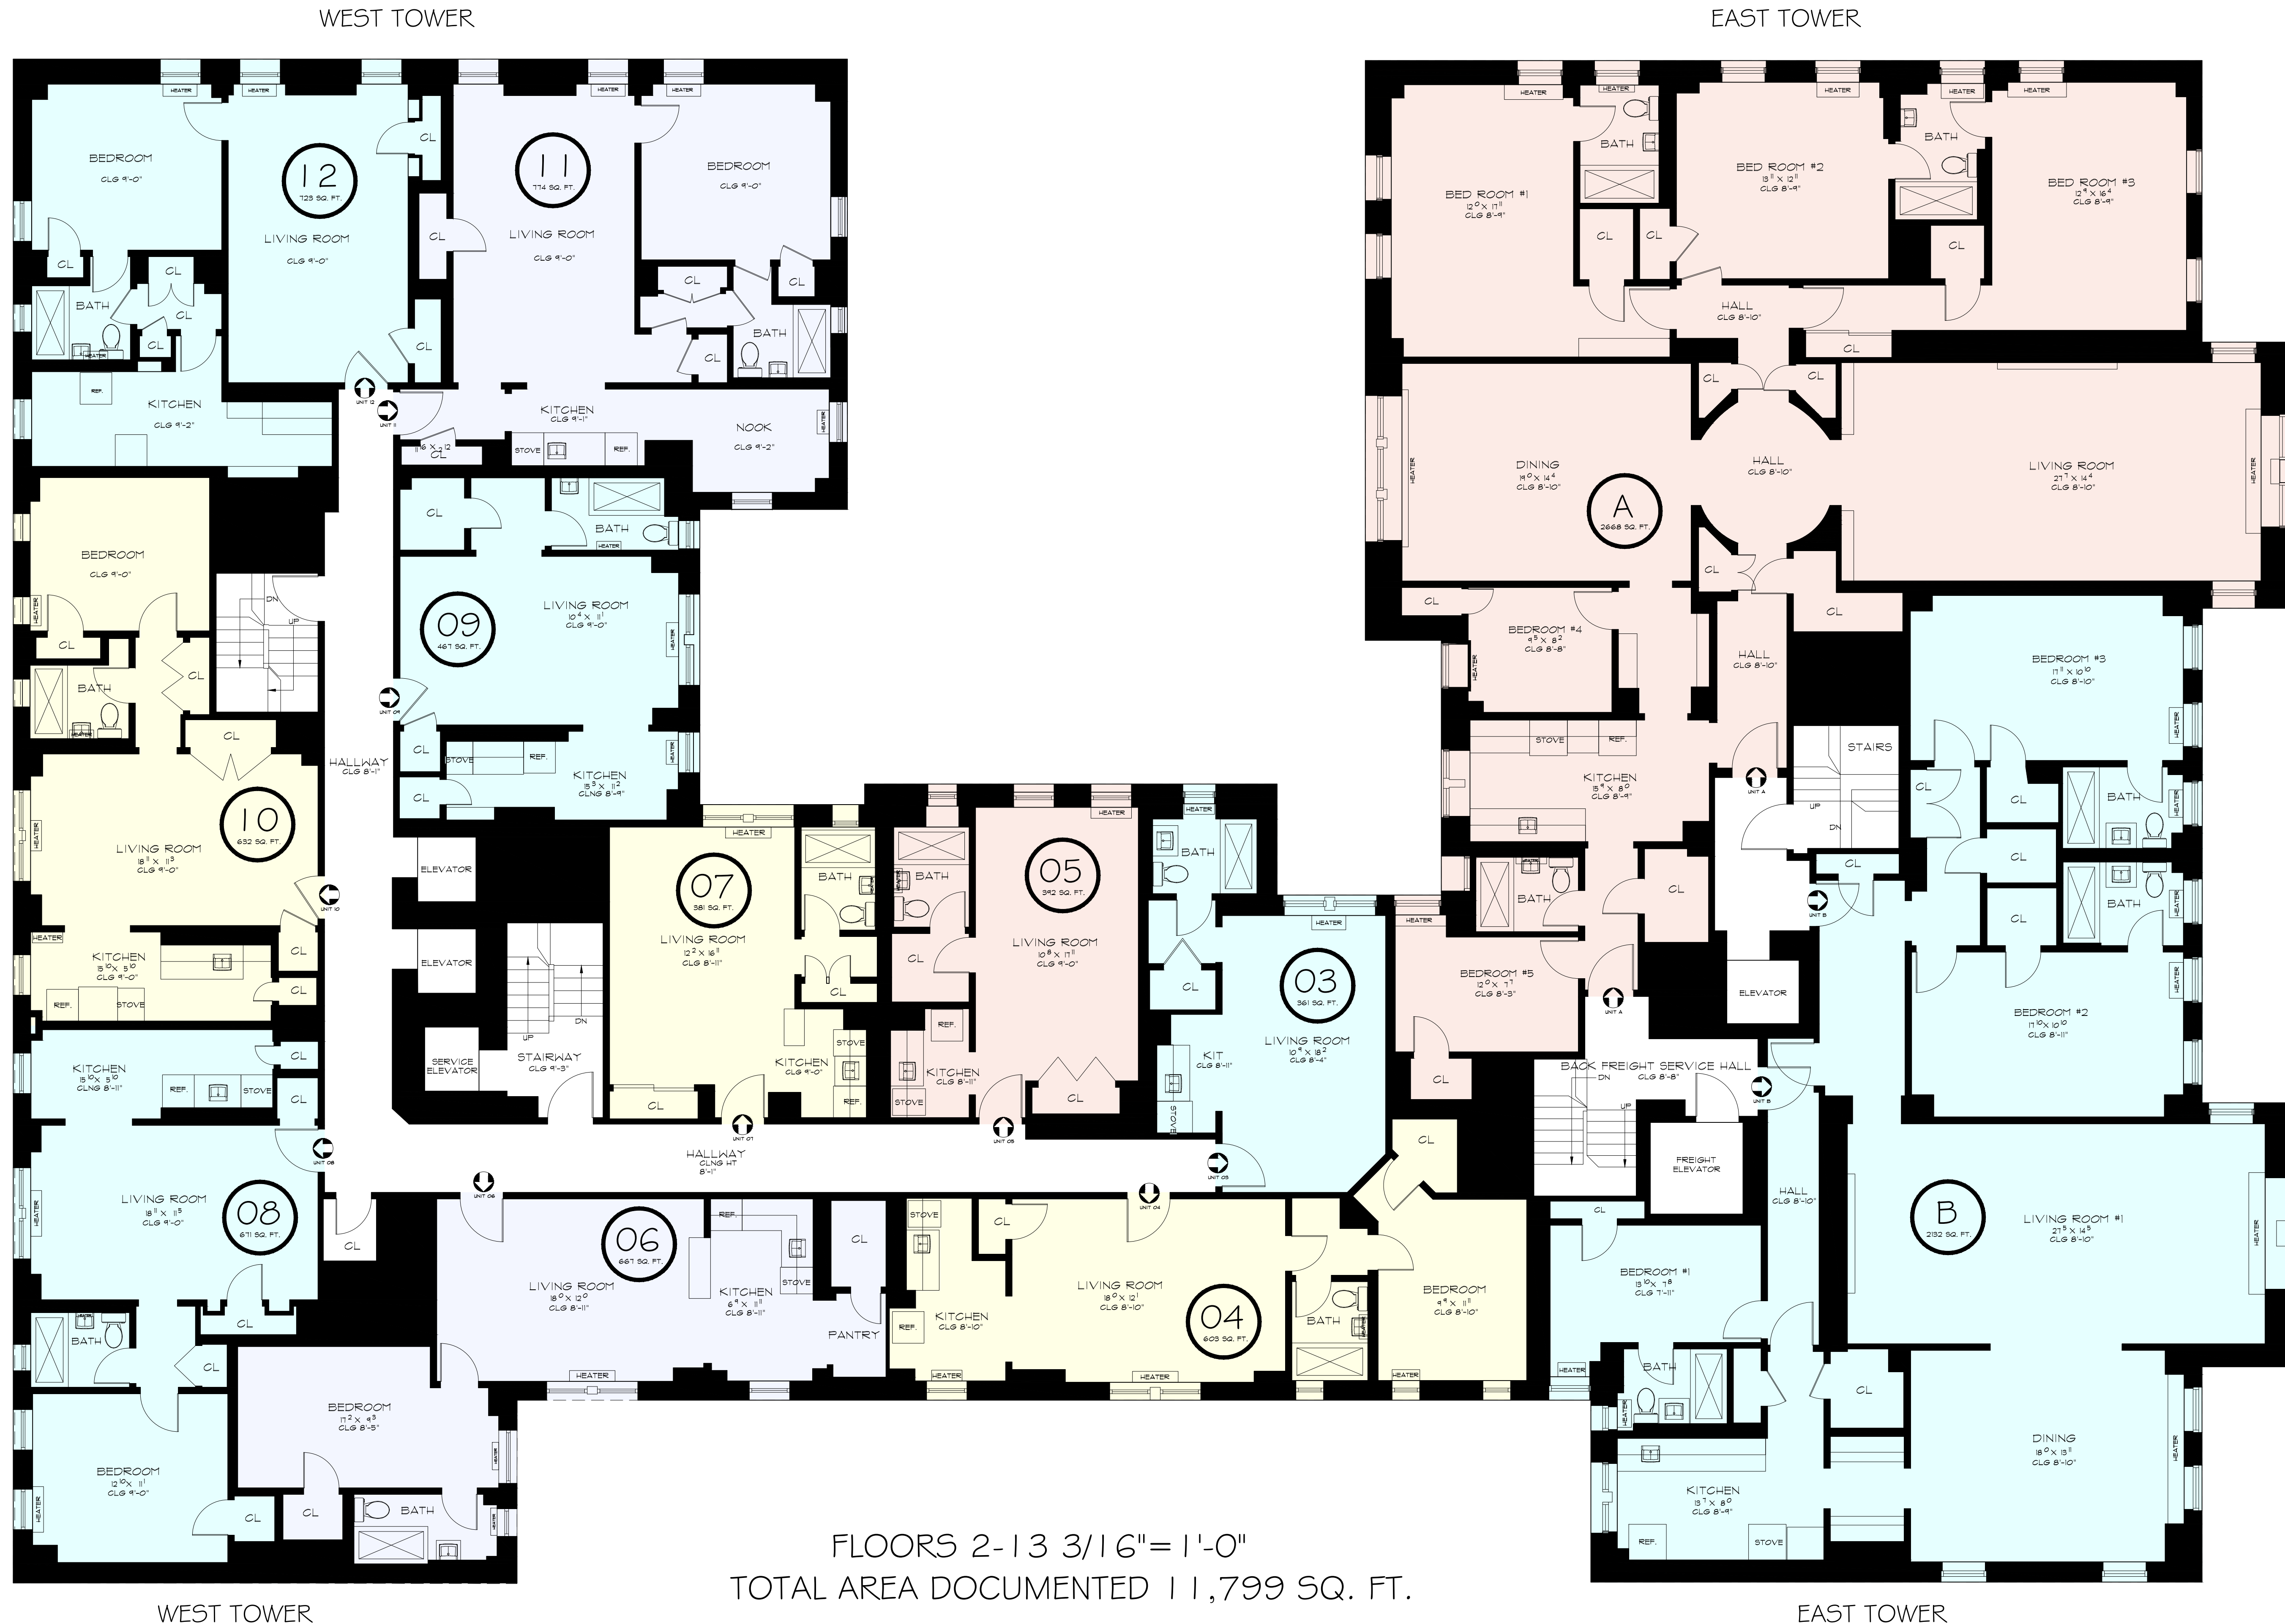

FLOORS 2-13 3/16"=1'-0"
TOTAL AREA DOCUMENTED 11,799 SQ. FT.

UNIT AREAS											
A	B	03	04	05	06	07	08	09	10	11	12
2668 SQ. FT.	232 SQ. FT.	361 SQ. FT.	603 SQ. FT.	392 SQ. FT.	661 SQ. FT.	361 SQ. FT.	671 SQ. FT.	461 SQ. FT.	632 SQ. FT.	714 SQ. FT.	123 SQ. FT.


AS BUILT
PROFESSIONALS
www.asbuiltprofessionals.com
A DIVISION OF:
AEC
CONSULTANTS INC
844.272.8458
844 AS BUILT
© 2020 AEC CONSULTANTS INC

ARCHITECTURAL AS BUILT
SHOREWIND
CHICAGO 60649

01	100% SUBMISSION	SEE COVER SHEET
NO.	ISSUES REVISIONS	DATE
		SHEET TITLE
FLOORS 2-13		
HL	PROJECT MANAGER	
HL	PROJECT DIRECTOR	
012317-1	PROJECT NUMBER	
3/16"=1'-0"	SCALE	
CL	DRAWN BY	
	SHEET NUMBER	

AB-2

WEST TOWER

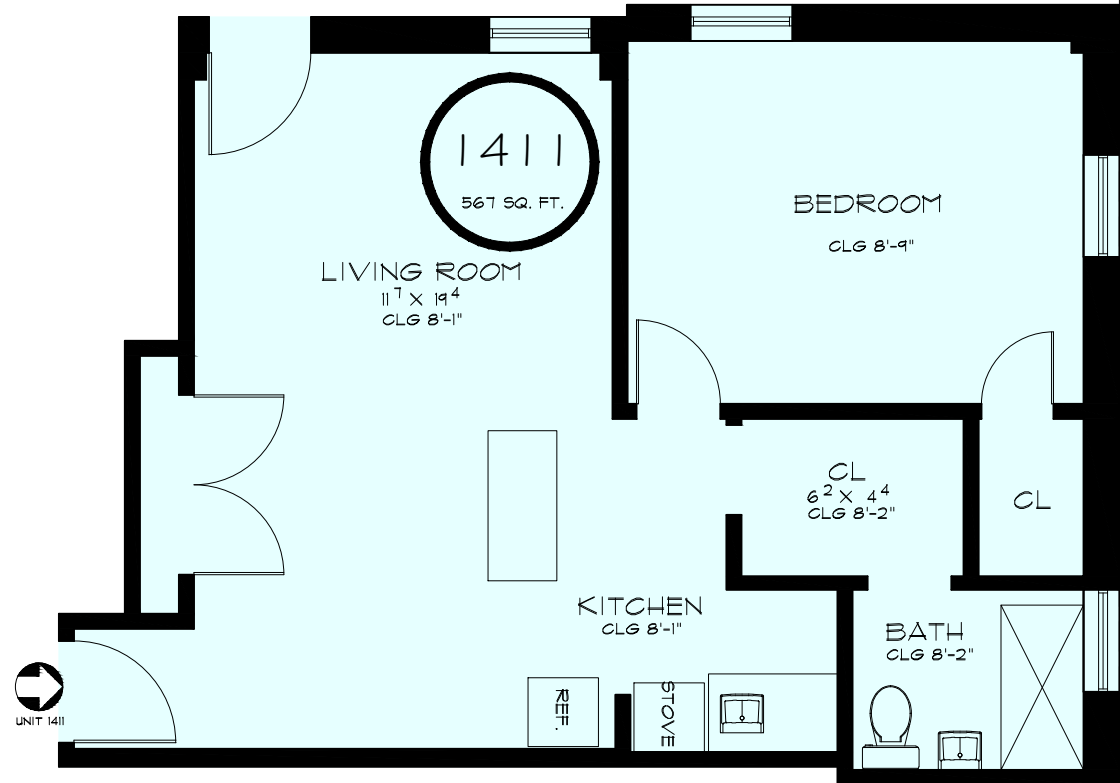

WEST TOWER

FLOOR 14 3/16"=1'-0"
TOTAL AREA DOCUMENTED 5,498 SQ. FT.

UNIT AREAS		
A	B	1411
2564 SQ. FT.	2130 SQ. FT.	561 SQ. FT.

EAST TOWER



EAST TOWER

AS BUILT
PROFESSIONALS
www.asbuiltprofessionals.com
A DIVISION OF:
AEC
CONSULTANTS INC
844.272.8458
844 AS BUILT
© 2020 AEC CONSULTANTS INC

**ARCHITECTURAL AS BUILT
SHOREWIND
CHICAGO 60649**

01	100% SUBMISSION	SEE COVER SHEET
NO.	ISSUES REVISIONS	DATE




FLOOR 14

HL	PROJECT MANAGER
HL	PROJECT DIRECTOR
012317-1	PROJECT NUMBER
3/16"=1'-0"	SCALE
CL	DRAWN BY
	SHEET NUMBER

AB-3

WEST TOWER

EAST TOWER

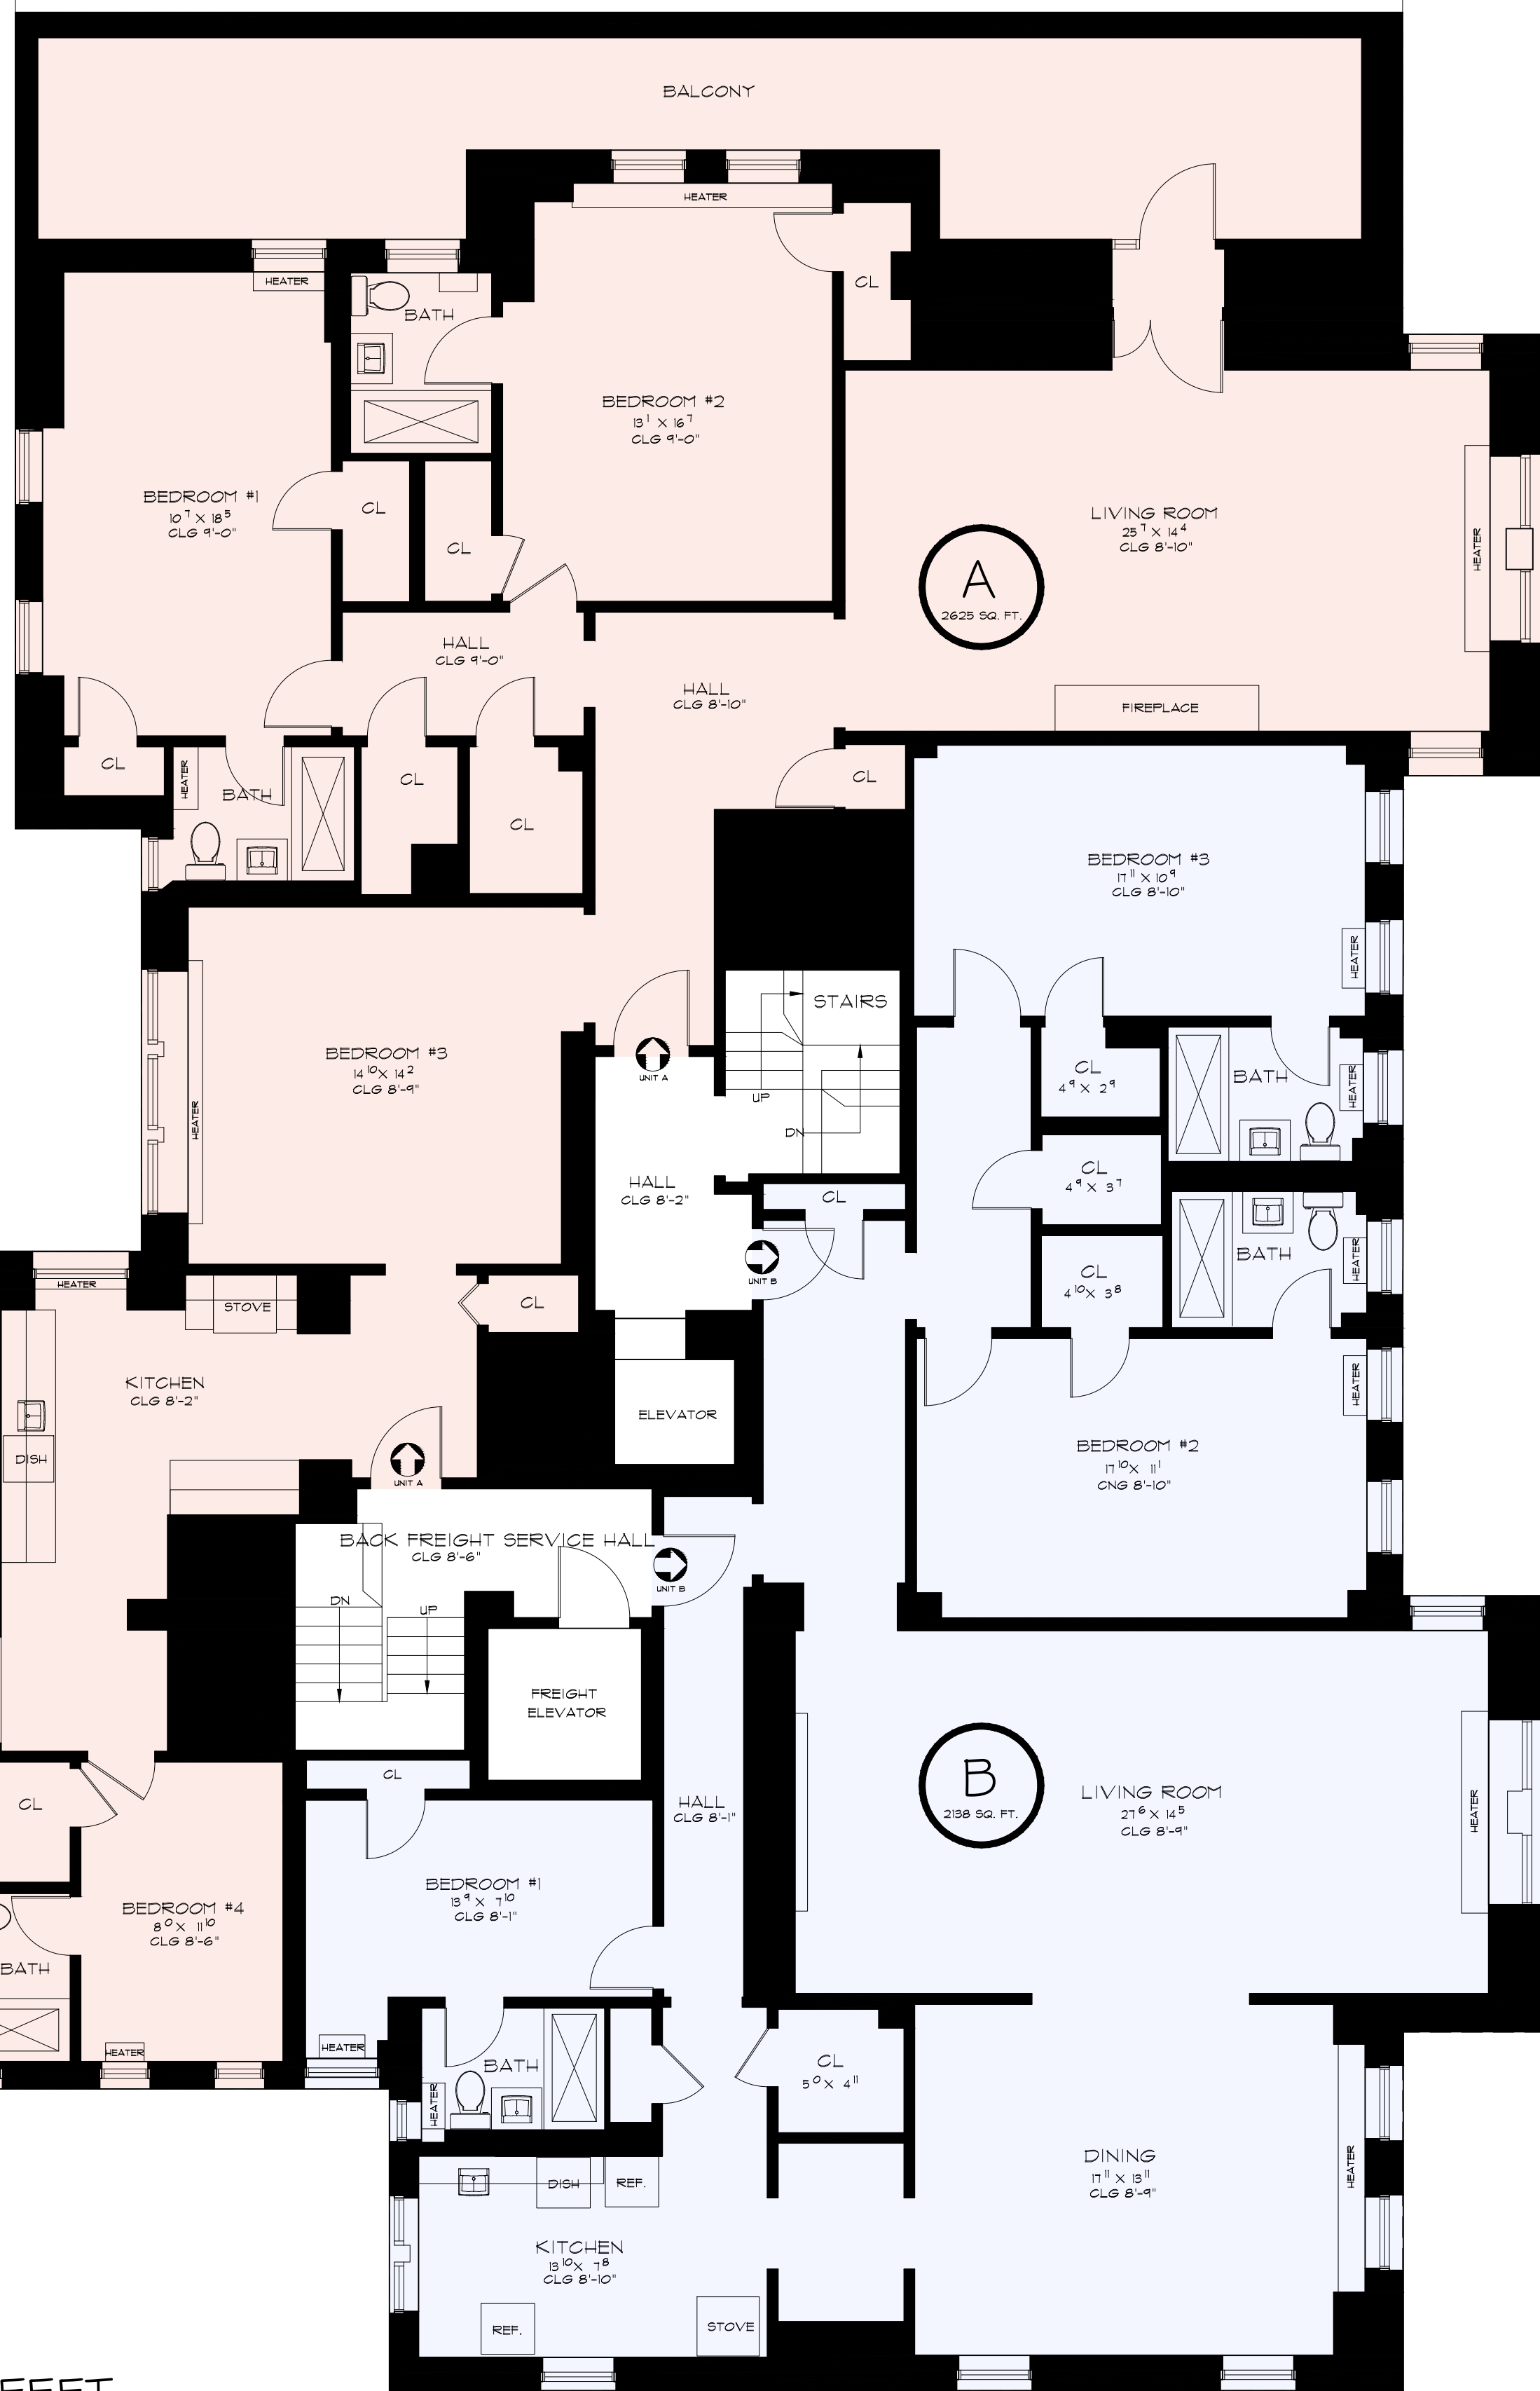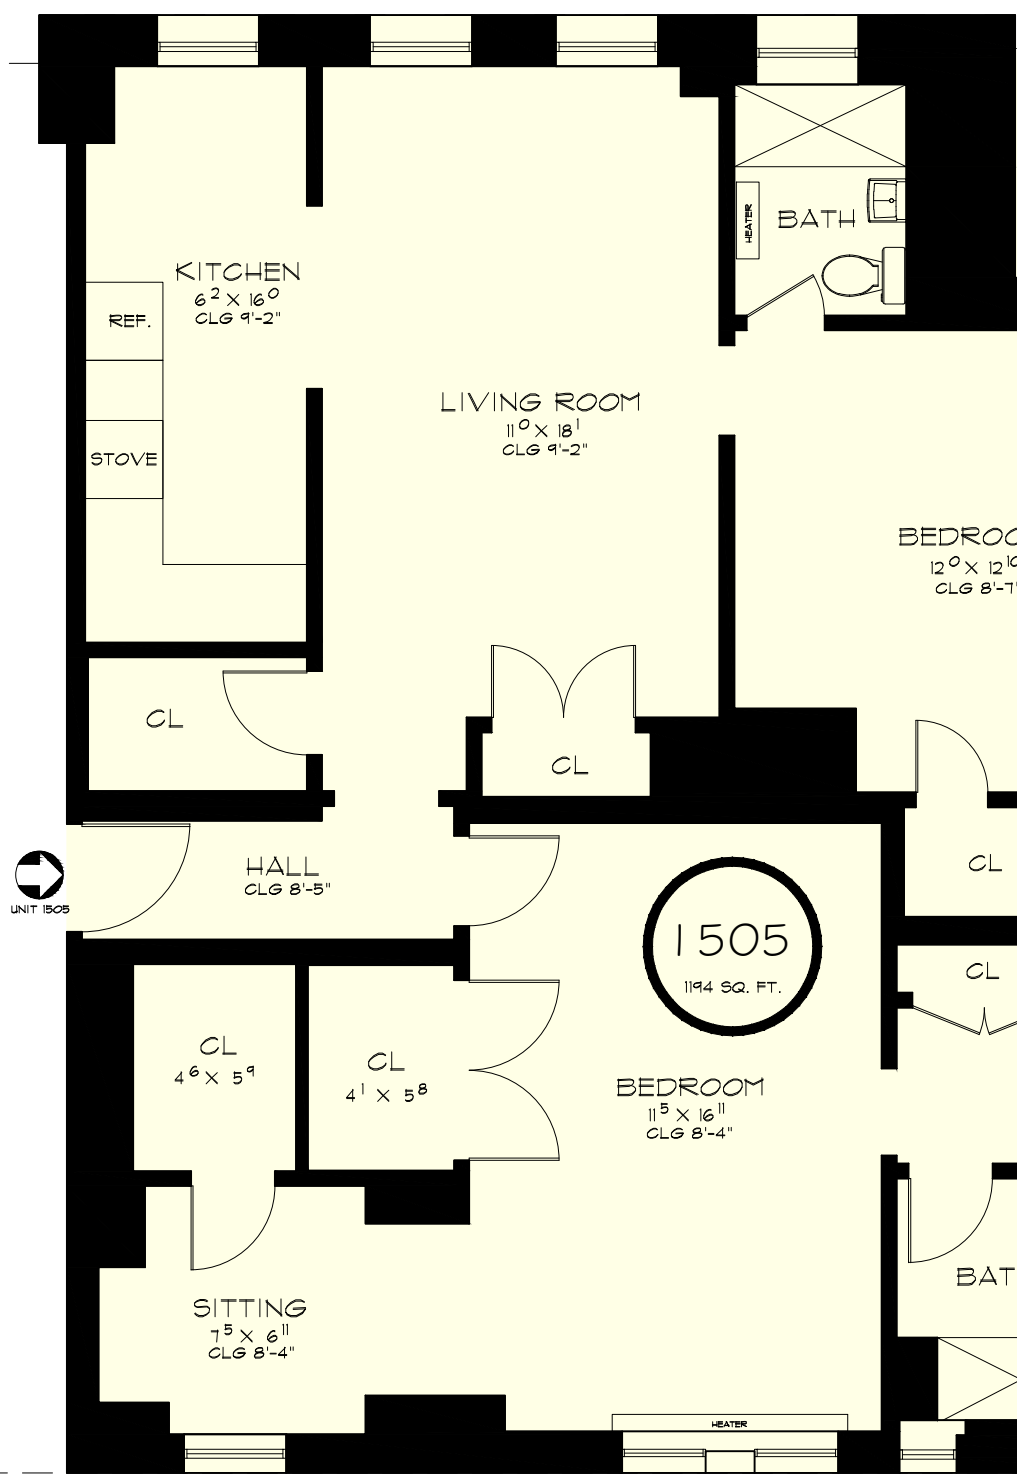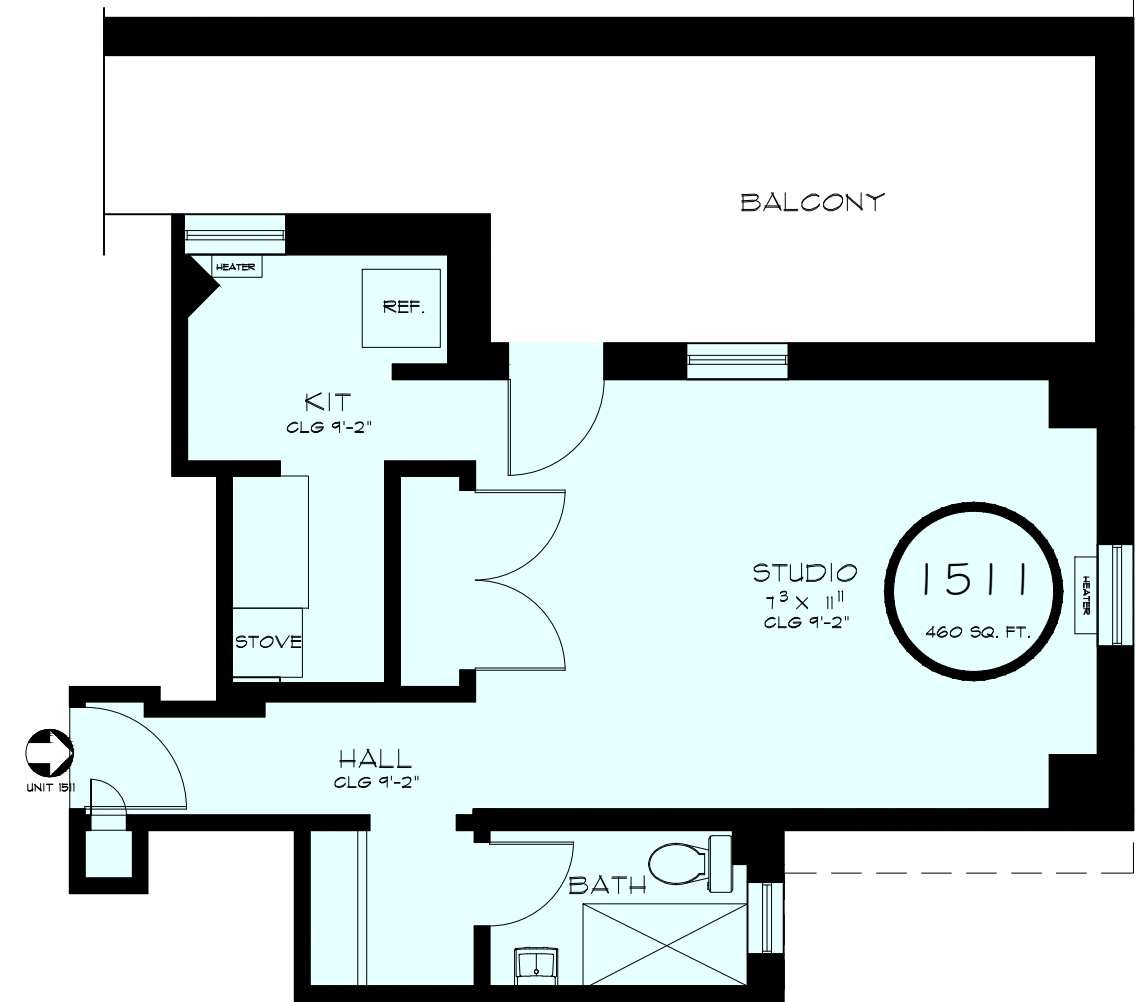

FLOOR 15 3/16"=1'-0"
TOTAL AREA DOCUMENTED 7,062 SQ. FEET

UNIT AREAS			
A	B	1505	1511
2625 SQ. FT.	2198 SQ. FT.	1194 SQ. FT.	460 SQ. FT.

WEST TOWER

EAST TOWER



ARCHITECTURAL AS BUILT SHOREWIND CHICAGO 60649

01	100% SUBMISSION	SEE COVER SHEET
NO.	ISSUES REVISIONS	DATE

FLOOR 15

HL	PROJECT MANAGER
HL	PROJECT DIRECTOR
012317-1	PROJECT NUMBER
3/16"=1'-0"	SCALE
CL	DRAWN BY
	SHEET NUMBER

AB-4



WEST TOWER

EAST TOWER

FLOOR 16 3/16"=1'-0"
TOTAL AREA DOCUMENTED 5,895 SQ. FT.

UNIT AREAS		
A	B	1605
2194 SQ. FT.	2136 SQ. FT.	1942 SQ. FT.

As BUILT

PROFESSIONALS

www.asbuiltprofessionals.com

A DIVISION OF:

AEC

CONSULTANTS INC

844.272.8458

844 AS BUILT

@ 2020 AEC CONSULTANTS INC

ARCHITECTURAL AS BUILT

SHOREWIND

CHICAGO 60649

01	100% SUBMISSION	SEE COVER SHEET
NO.	ISSUES REVISIONS	DATE
		SHEET TITLE
FLOOR 16		
HL	PROJECT MANAGER	
HL	PROJECT DIRECTOR	
012317-1	PROJECT NUMBER	
3/16"=1'-0"	SCALE	
CL	DRAWN BY	
		SHEET NUMBER

AB-5