



BOMA CALCULATIONS

01	100% SUBMISSION
----	-----------------


SHEET TITLE

HL	PROJECT MANAGER
----	-----------------


12201601	PROJECT NUMBER
----------	----------------

CL	DRAWN BY
----	----------


AB-1

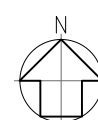

AREA DATA	
ONE STORY	4,129 S.F. ±
TWO STORY	140,443 S.F. ±
GRAND TOTAL	145,112 S.F. ±

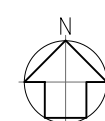

AREA DATA	
ONE STORY	1956 SF. ±
TWO STORY	54,522 SF. ±
METHOD B (LOADING DOCK)	3,991 SF. ±
GRAND TOTAL	60,469 SF. ±

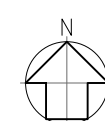

AREA DATA	
ONE STORY	4,913 S.F. ±
METHOD B (TRUCK MAINTENANCE)	12,98 S.F. ±
GRAND TOTAL	6,211 S.F. ±