



# Yosemite West KOA

Midpines, CA 95345

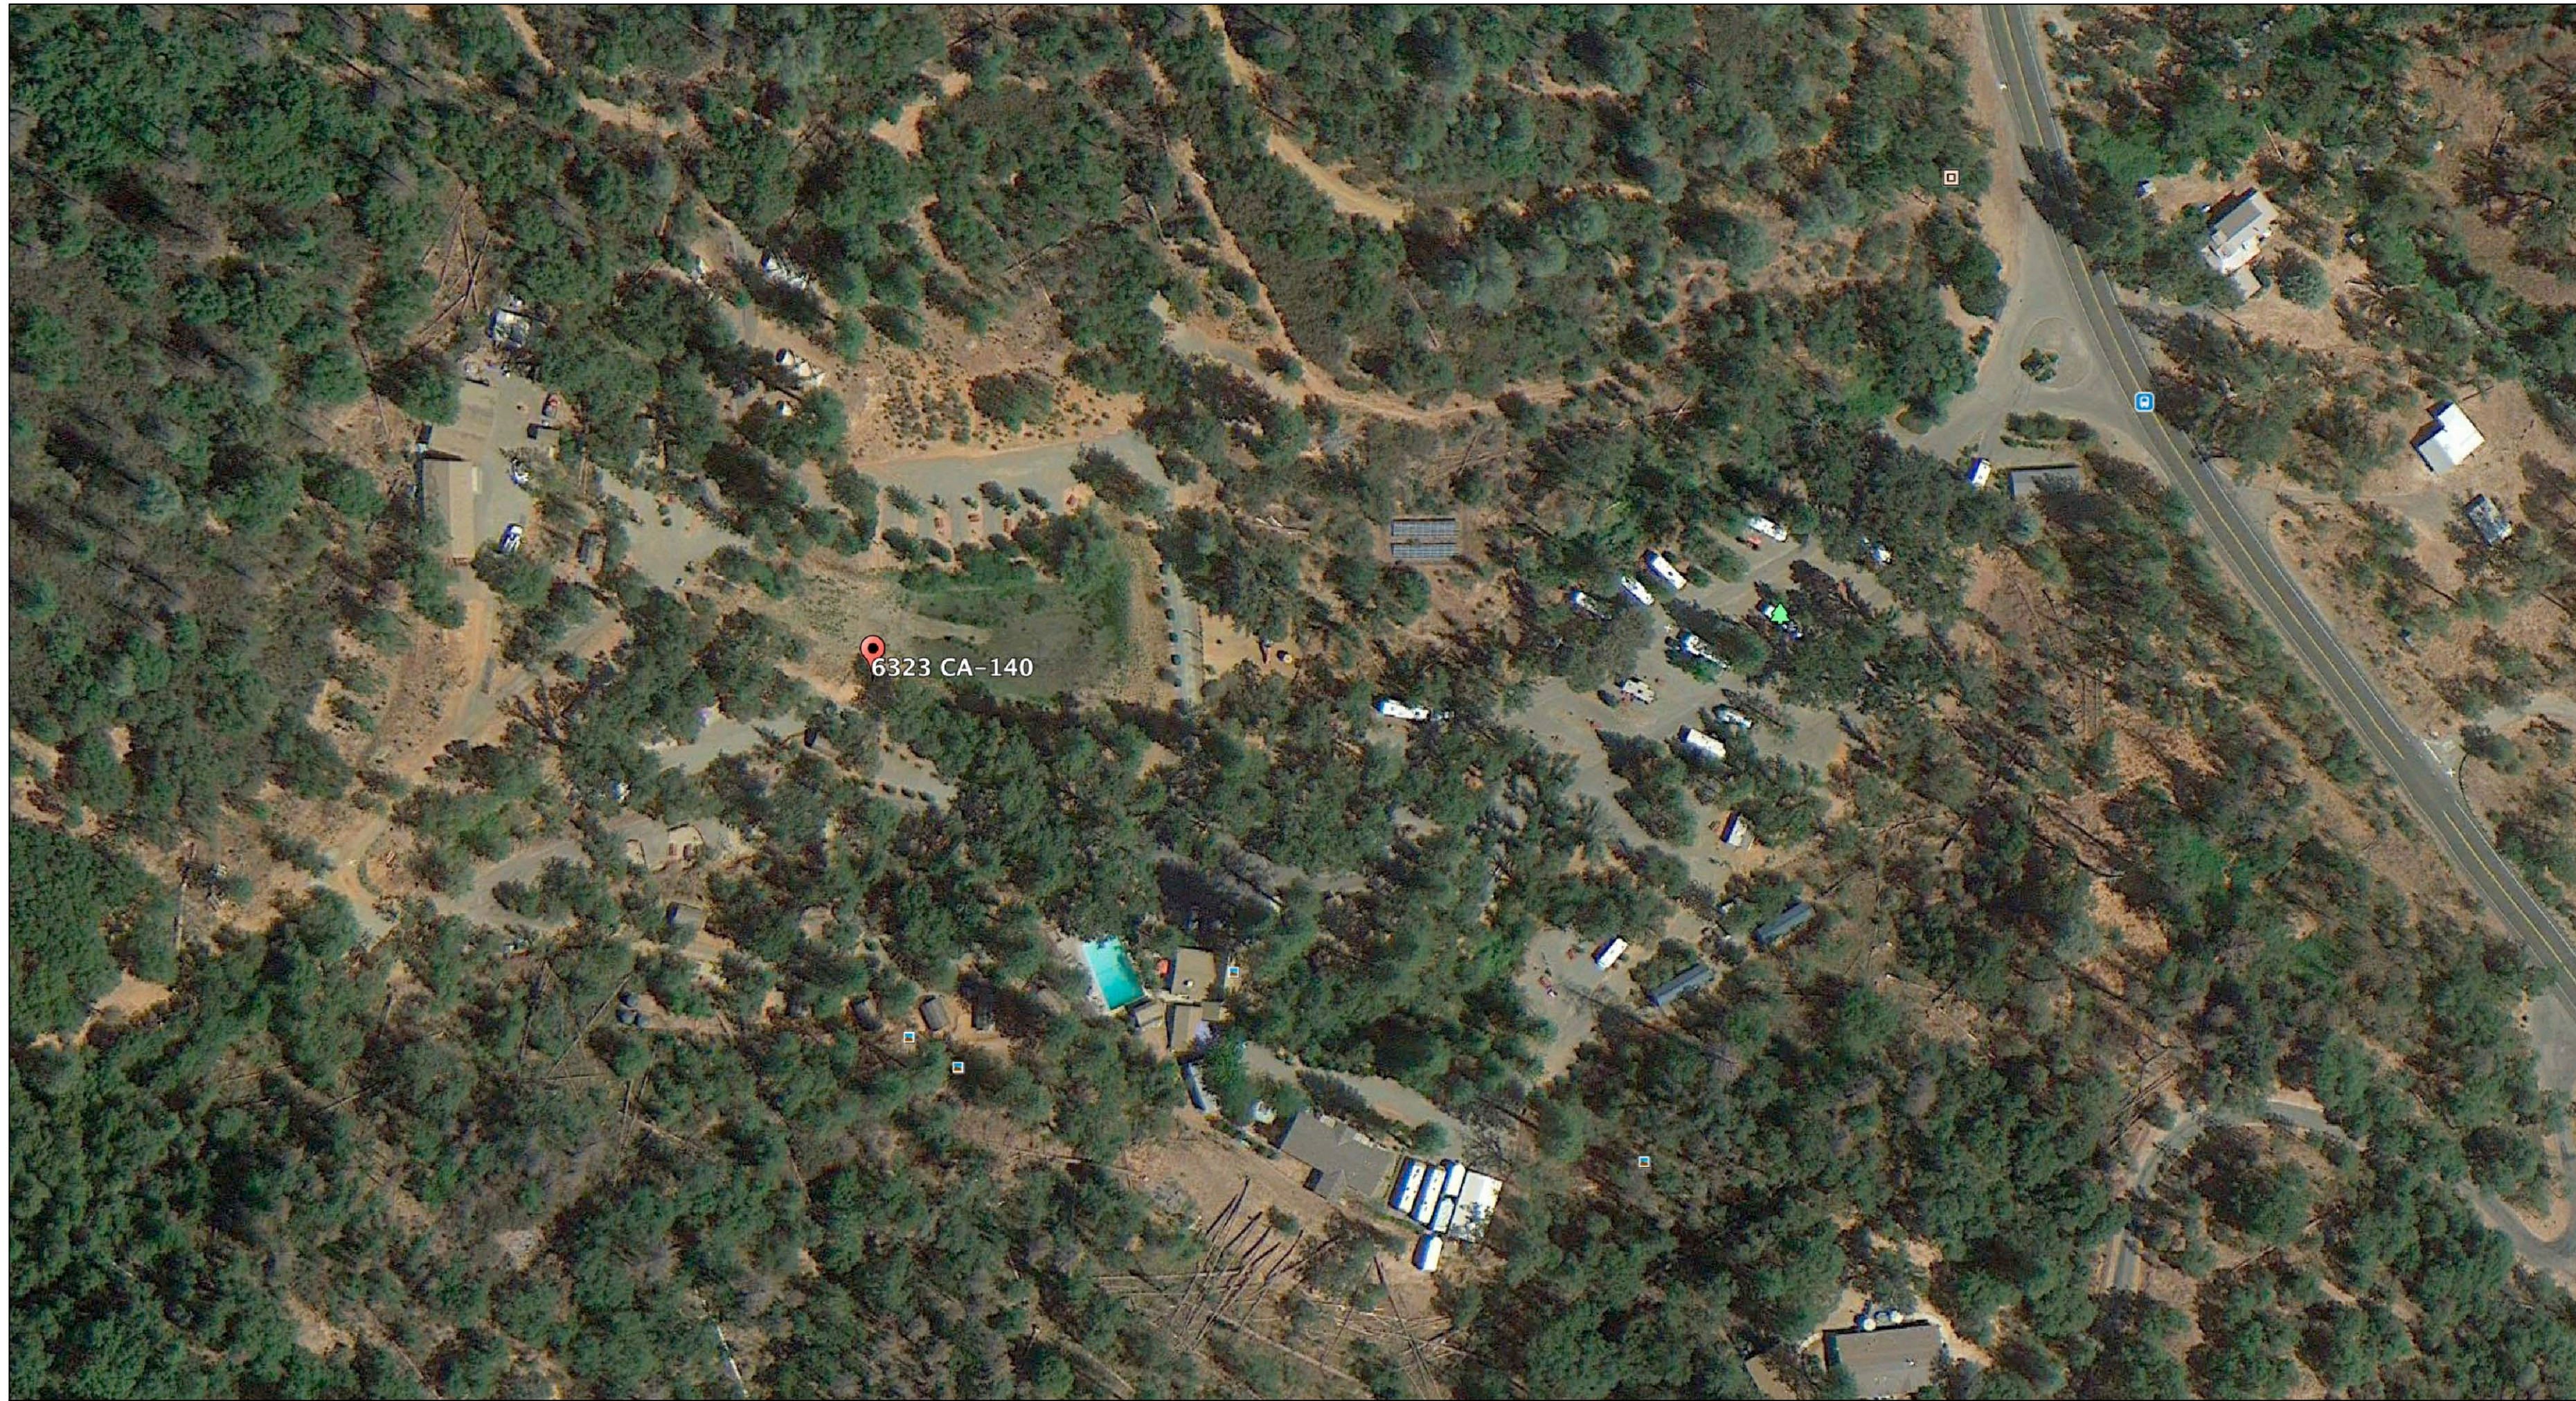

# 100% SUBMITTAL

C-1	COVER SHEET   DRAWING INDEX
SL	SYMBOLS LEGEND
AB-1	MOBILE HOME FLOOR PLAN
AB-2	DELUXE CABIN FLOOR PLAN AND 8 ELEVATIONS
AB-3	ADA CABIN FLOOR PLAN AND 10 ELEVATIONS
AB-4	LARGE MAINTENANCE SHED 4 EXTERIOR ELEVATIONS
AB-5	LARGE MAINTENANCE SHED 4 INTERIOR ELEVATIONS

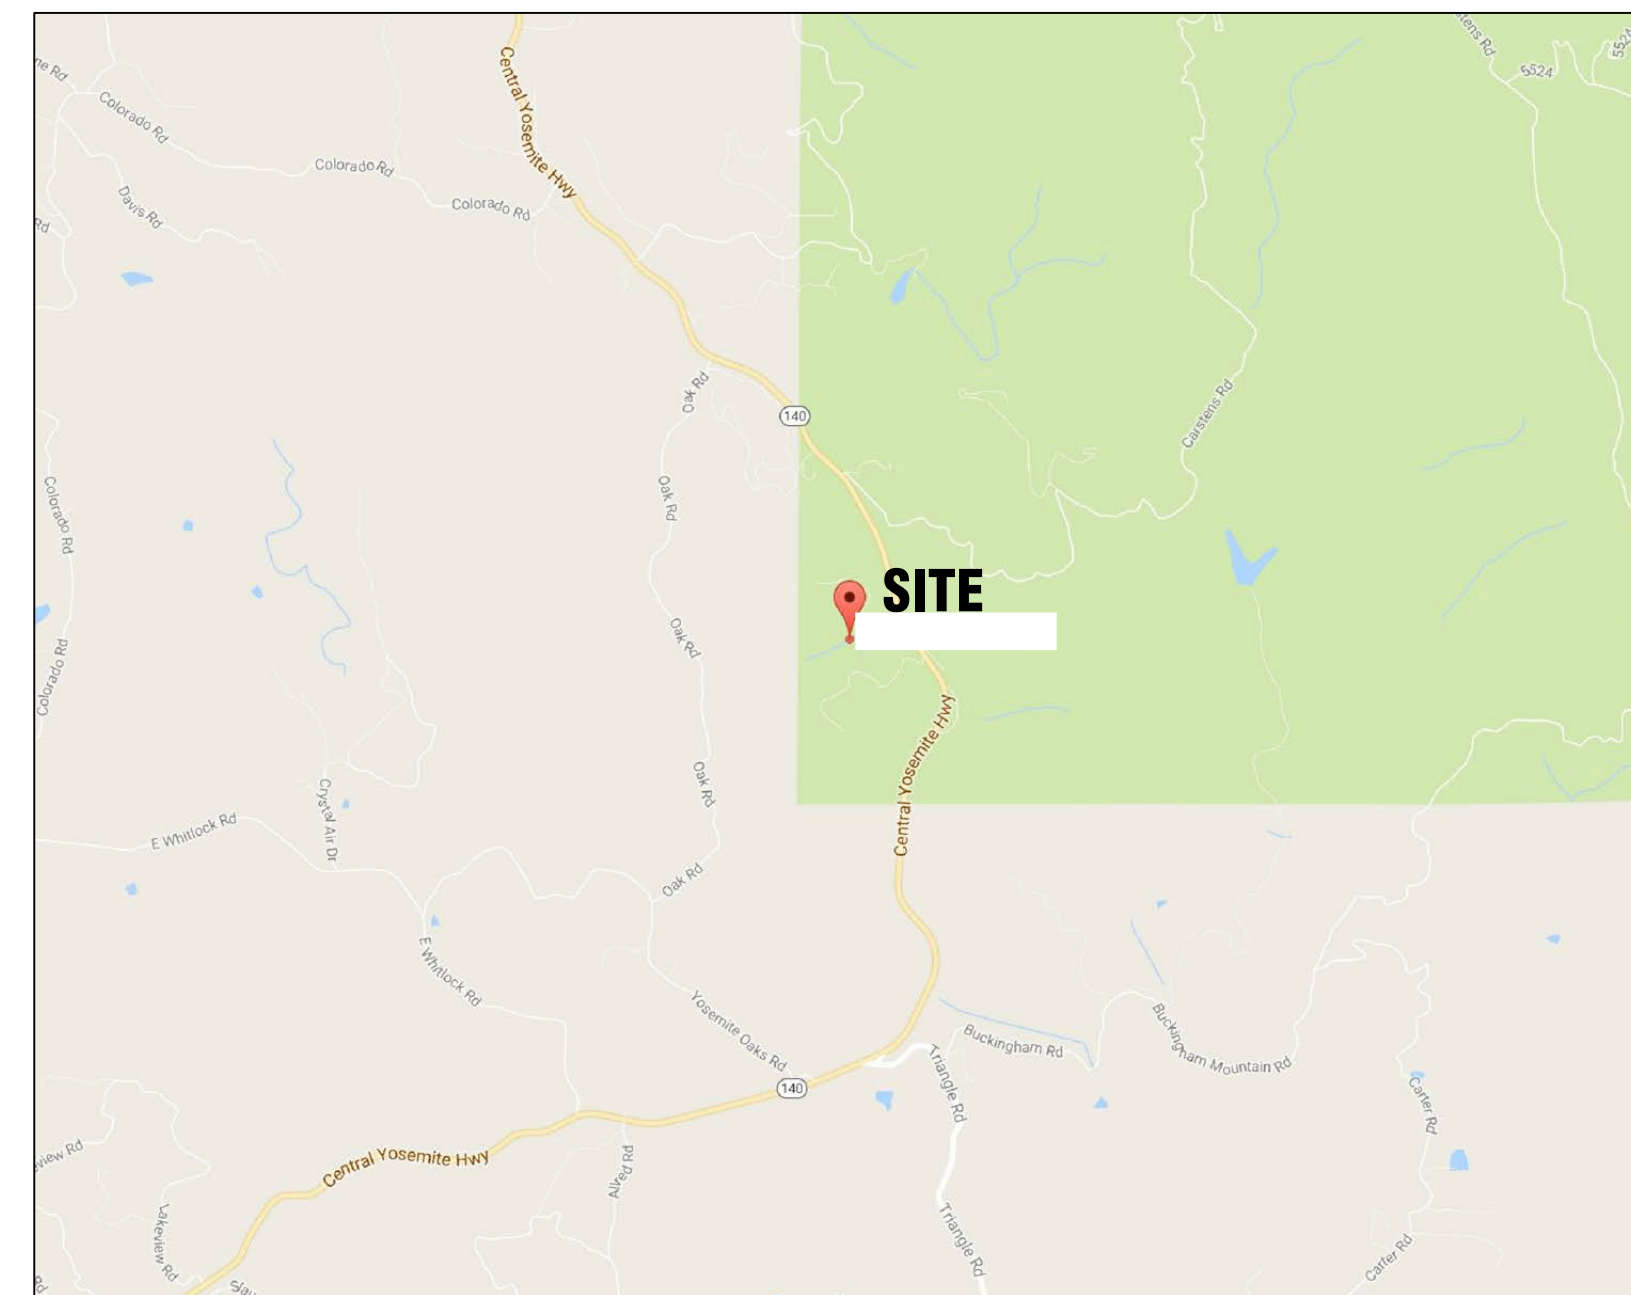

## VICINITY MAP



**AEC**  
CONSULTANTS INC  
844.272.8458  
844 AS BUILT

**ARCHITECTURAL AS BUILT**  
**Yosemite West KOA**  
**Midpines, CA 95345**


O1	100% SUBMISSION	DATE
NO.	ISSUES   REVISIONS	DATE
		SHEET TITLE
COVER SHEET		
HL		PROJECT MANAGER
HL		PROJECT DIRECTOR
O12317-1		PROJECT NUMBER
		SCALE
CL		DRAWN BY
		SHEET NUMBER


# C-1





SYMBOLS LEGEND


RCP


- 

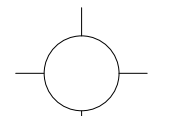
EXHAUST VENT
- 

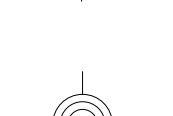
CEILING MOUNTED LIGHT FIXTURE
- 

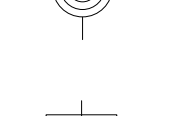
CEILING MOUNTED DIRECTIONAL LIGHT
- 

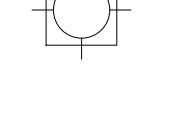
RECESSED CAN LIGHT
- 


EYEBALL OR SMALL CAN LIGHT
- 

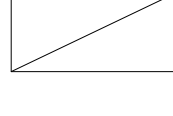
PENDANT LIGHT
- 

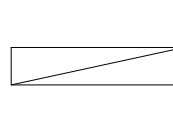
INDIVIDUAL FLUOR. LAY-IN FIXTURE 4 BULB
- 

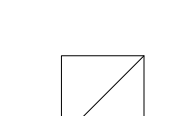
INDIVIDUAL FLUOR. HANGING FIXTURE 2 BULB
- 


INDIVIDUAL FLUOR. FLUSH MOUNT FIXTURE 4 BULB
- 


CAMERA
- 

MOTION DET.
- 

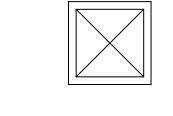
SUPPLY VENT
- 

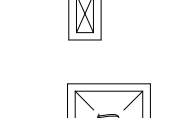
SUPPLY VENT
- 

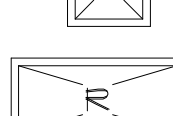
RETURN VENT
- 

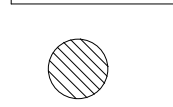
RETURN VENT
- 


SPEAKER

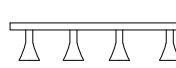
- 

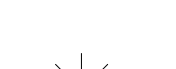
TRACK LIGHT OR VANITY LIGHT
- 

WALL-MOUNTED LIGHT FIXTURE
- 

EMERGENCY EXIT SIGN
- 

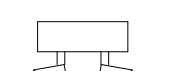EMERGENCY EXIT LIGHT
- 

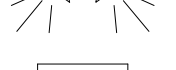EMERGENCY EXIT LIGHT W/ SIGN
- 

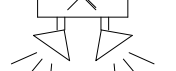LIGHTED STAIR SIGN
- 




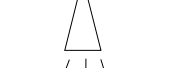
FLOOD LIGHT
- 

PHOTO CELL
- 


CEILING FAN
- 


CEILING FAN W/ LIGHT KIT
- 7-2-6


CEILING HEIGHT AND TRIM 7'-2" ABOVE FLOOR BELOW WITH 6" CROWN MOULDING. NOTE: ALL CEILINGS NOT LABELED ARE PLASTER. CEILINGS SHOWN WITH A GRID ARE LAY IN ACOUSTICAL TILE..
- 


JUNCTION BOX


ELECTRIC


- 


DATA OUTLET
- 


TELEPHONE JACK
- 


ELECTRIC SWITCH
- 

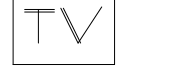
CABLE TELEVISION OUTLET
- 


DUPLEX RECEPTACLE OUTLET
- 


SPECIAL PURPOSE CONNECTION OR OUTLET
- 


QUADRUPLEX RECEPTACLE OUTLET
- 


FLOOR DUPLEX RECEPTACLE OUTLET
- 

ELECTRIC PANEL
- 

ELECTRIC METER
- 


BUTTON SWITCH
- 


DISCONNECT SWITCH
- 

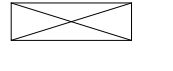
GROUND/FLOOR LIGHT
- 


KEY PAD


FIRE PROTECTION


- 


FIRE EXTINGUISHER
- 

FIRE PULL
- 

FIRE ALARM (HORN/SRTO)
- 


SMOKE DETECTOR
- 

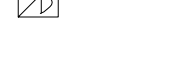
SMOKE ALARM SPEAKER
- 

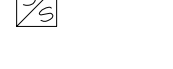
SPRINKLER HEAD CEILING MOUNT
- 


SPRINKLER HEAD WALL MOUNT


MEP


- 

THERMOSTAT
- 

FLOOR DRAIN
- 

VALVE
- 

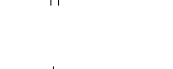HOSE BIB
- 

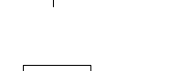WATER SUPPLY
- 

SUSPENDED GAS HEATER

MISC

- 


BOLLARD
- 

11-4-11/16 SPOT ELEVATION

7-2-6

CEILING HEIGHT AND TRIM 7'-2" ABOVE FLOOR BELOW WITH 6" CROWN MOULDING. NOTE: ALL CEILINGS NOT LABELED ARE PLASTER. CEILINGS SHOWN WITH A GRID ARE LAY IN ACOUSTICAL TILE..

INTERIOR ELEVATIONS

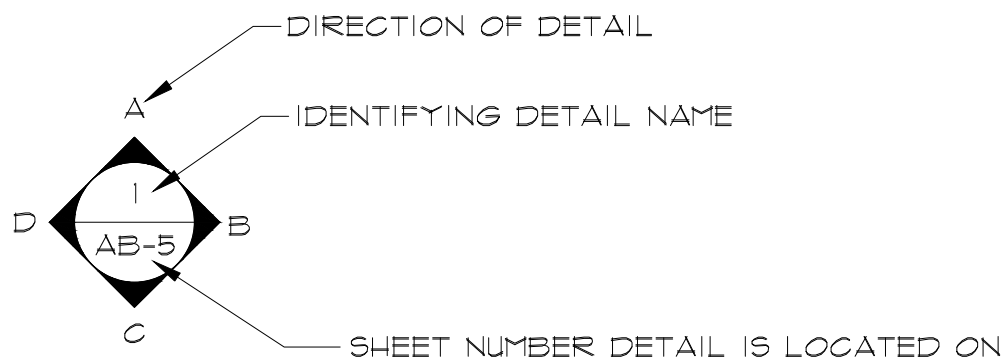

BUILDING SECTION

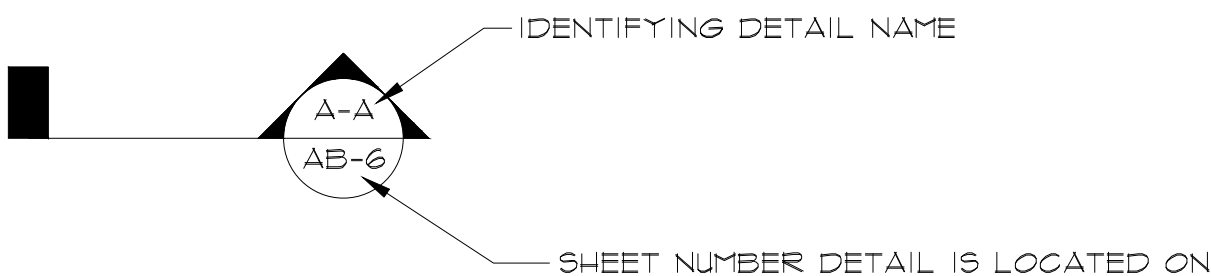


PHOTO DOCUMENTATION LEGEND

- 

INDICATES LOCATION OF CAMERA
- 

INDICATES DIRECTION OF CAMERA LENS AND CORRESPONDING PHOTO / VIDEO NUMBER

TYPES OF DOCUMENTATION

- 

GROUND BASED PHOTO
- 

V-001
- 

360° SPHERICAL PHOTO
- 

AERIAL BASED PHOTO
- 

V-000



As BUILT PROFESSIONALS  
www.asbuiltprofessionals.com  
A DIVISION OF:




AEC CONSULTANTS INC  
844.272.8458  
844 AS BUILT

© 2011 AEC CONSULTANTS INC

ARCHITECTURAL AS BUILT  
Yosemite West KOA  
Midpines, CA 95345

01	100% SUBMISSION	
NO.	ISSUES   REVISIONS	DATE
		SHEET TITLE
HL		PROJECT MANAGER
HL		PROJECT DIRECTOR
012317-1		PROJECT NUMBER
NOT TO SCALE		SCALE
CL		DRAWN BY
		SHEET NUMBER

SL

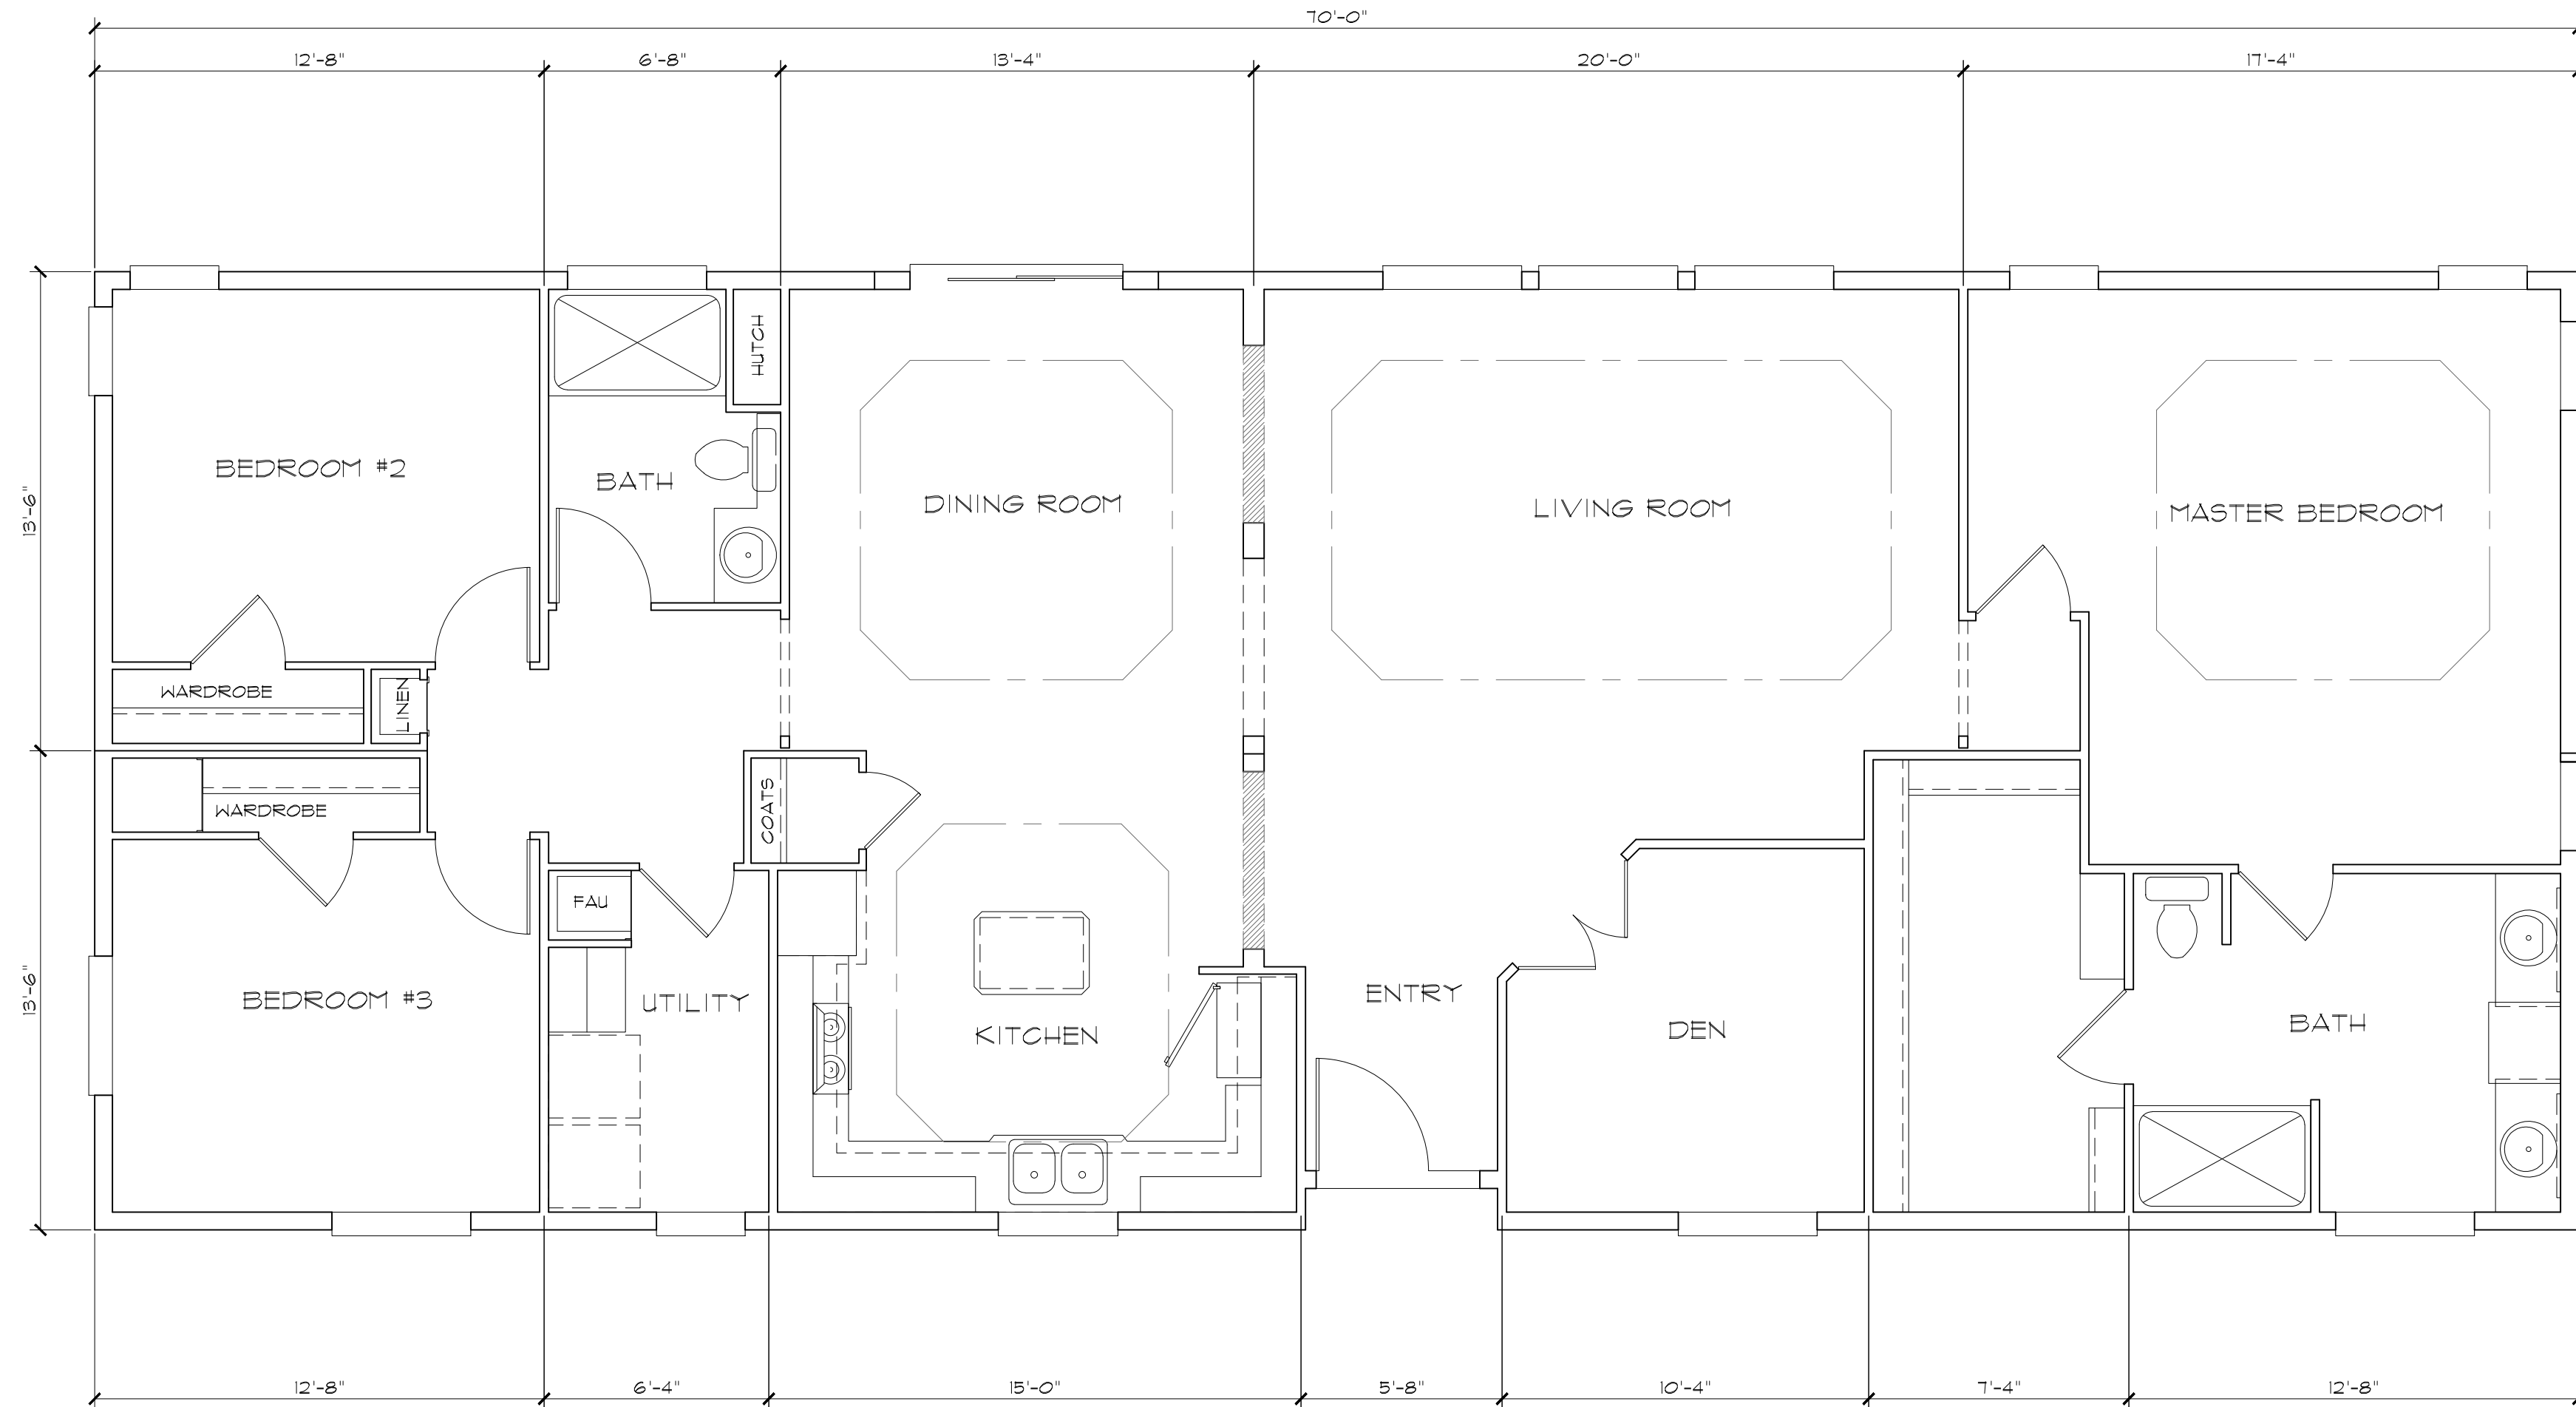

FLOOR PLAN

As BUILT

PROFESSIONALS

www.asbuiltprofessionals.com

A DIVISION OF:

AEC

CONSULTANTS INC

844.272.8458

844 AS BUILT

© 2017 AEC CONSULTANTS INC


ARCHITECTURAL AS BUILT

Yosemite West KOA


Midpines, CA 95345

01	100% SUBMISSION	
NO.	ISSUES   REVISIONS	DATE
		SHEET TITLE
HL	PROJECT MANAGER	
HL	PROJECT DIRECTOR	
012317-1	PROJECT NUMBER	
1/4"=1'-0"	SCALE	
CL	DRAWN BY	
	SHEET NUMBER	

AB-1

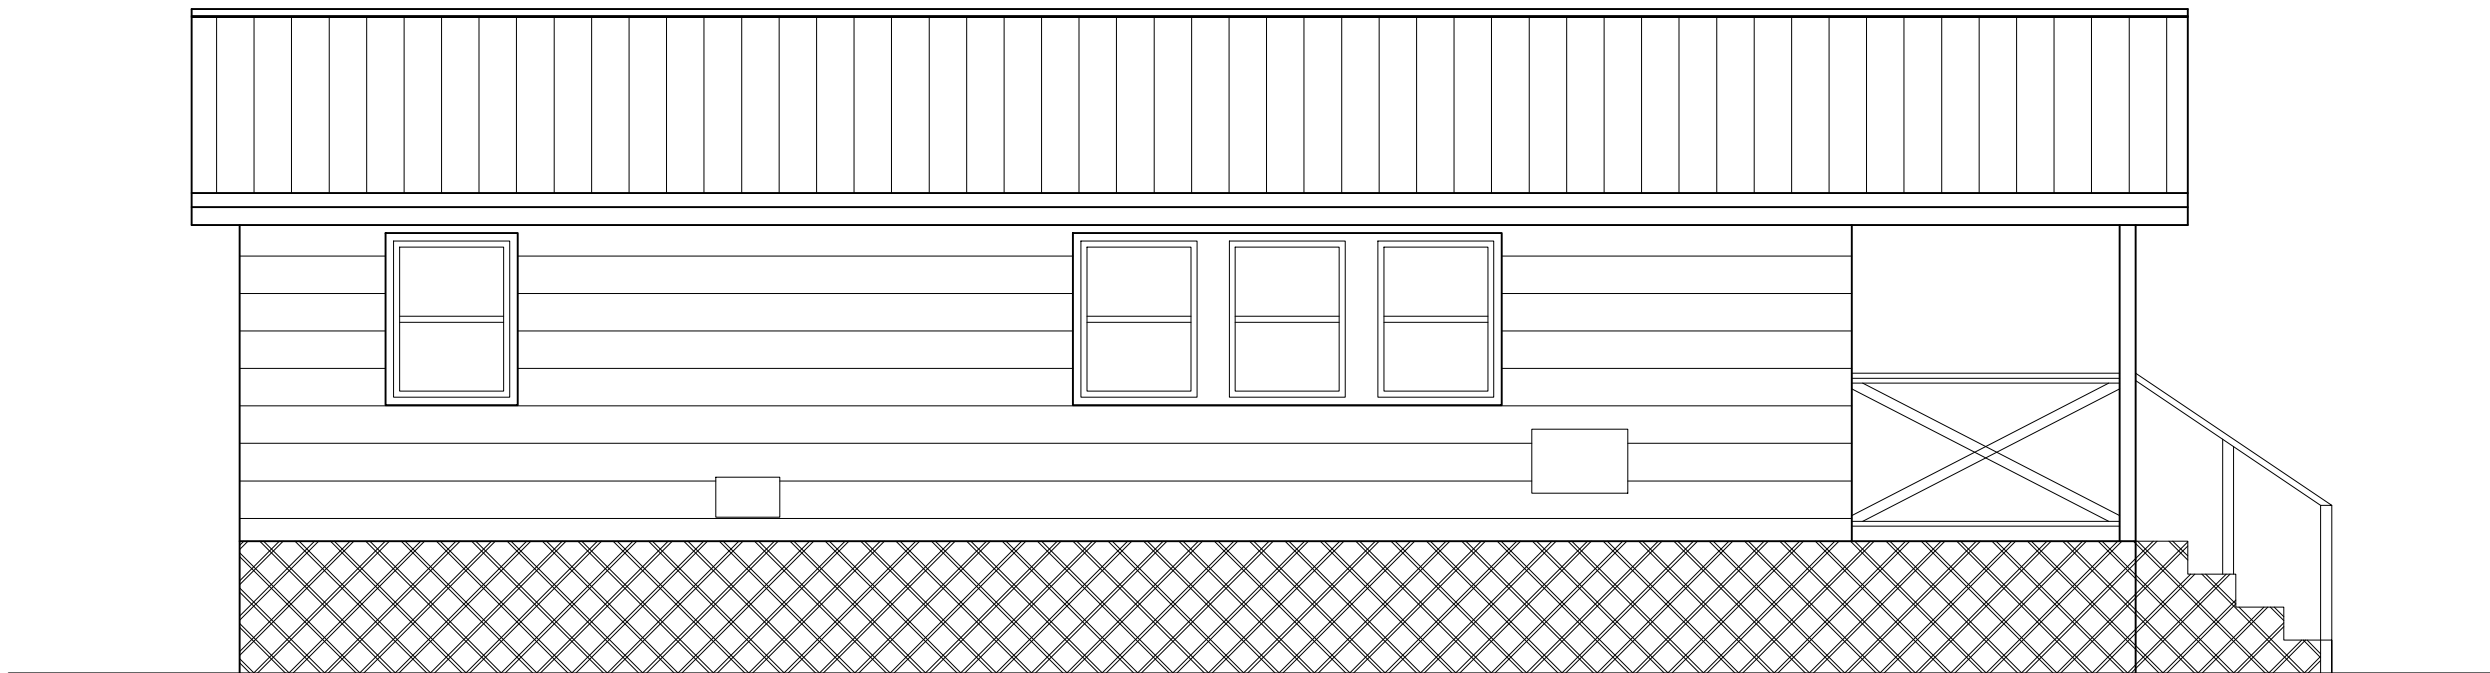


LEFT SIDE ELEVATION

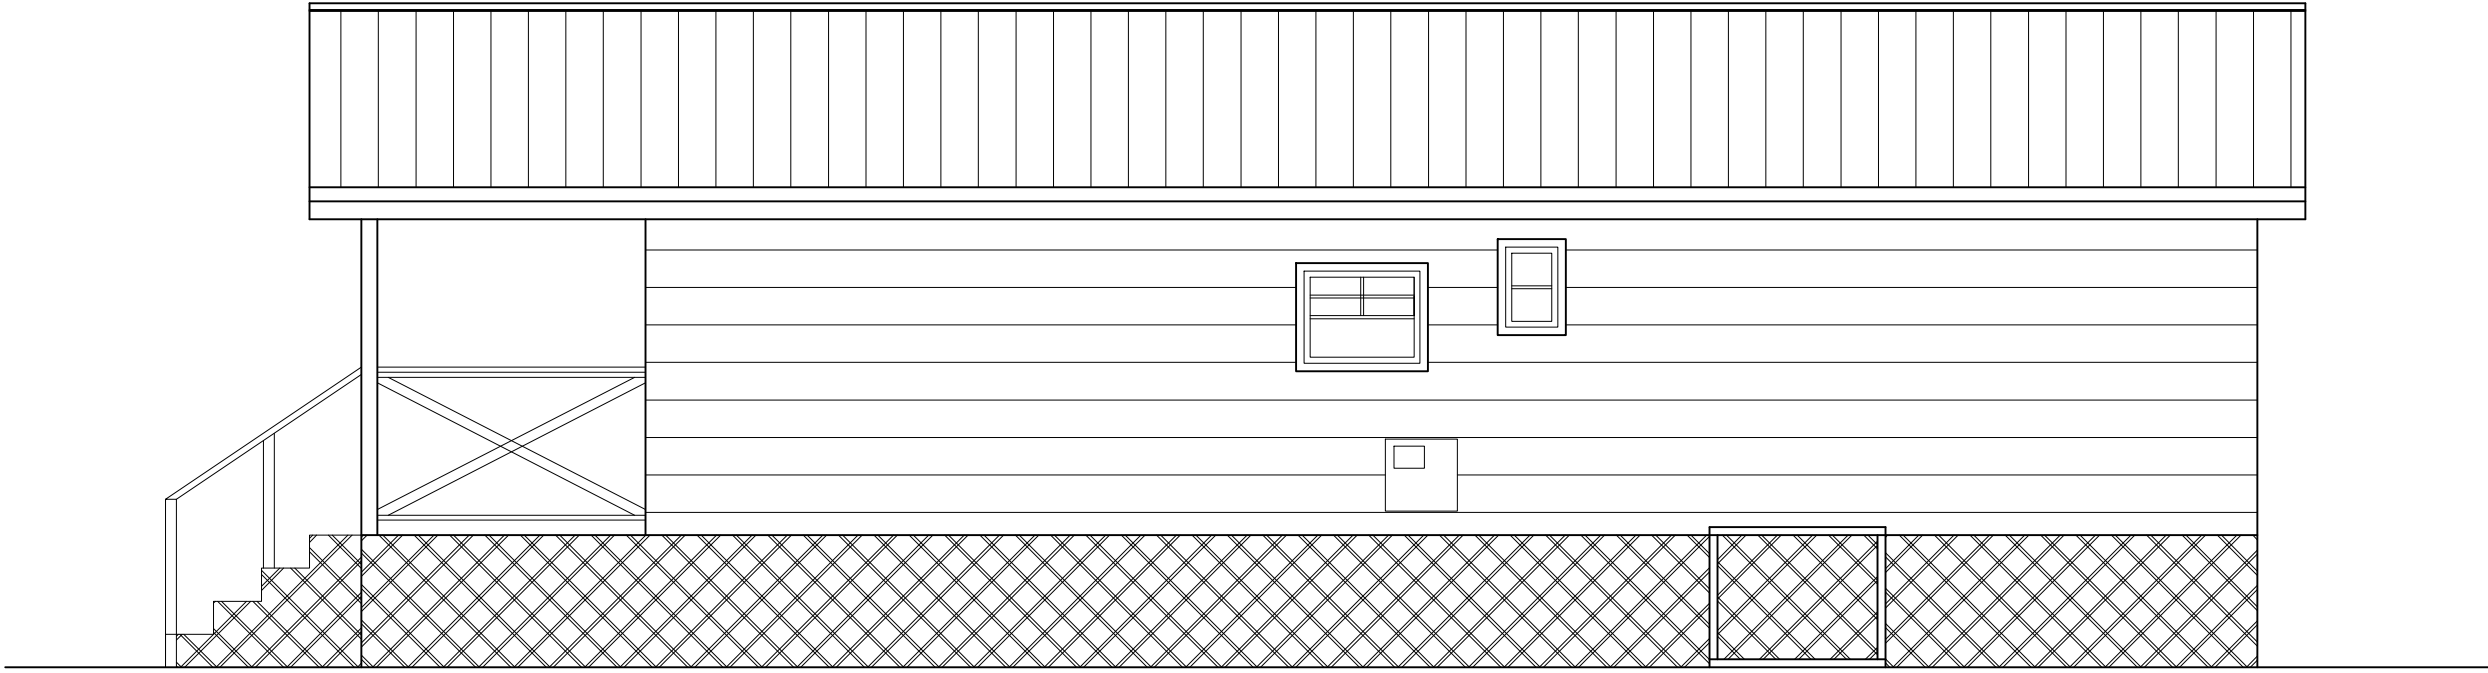


RIGHT SIDE ELEVATION




FRONT ELEVATION

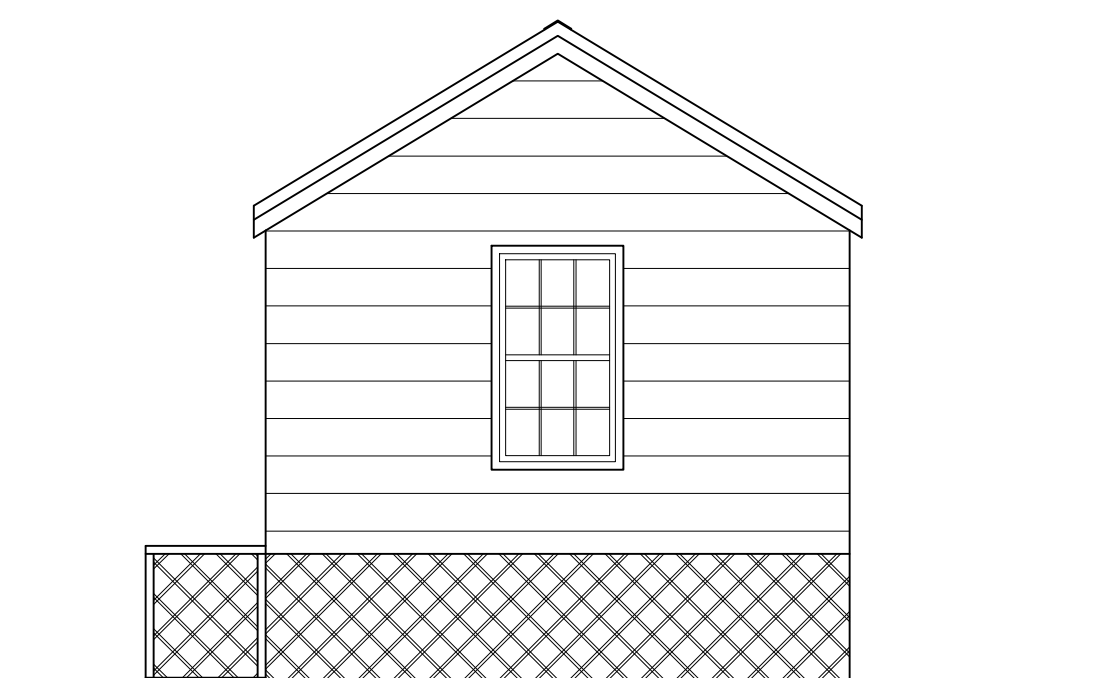


REAR ELEVATION

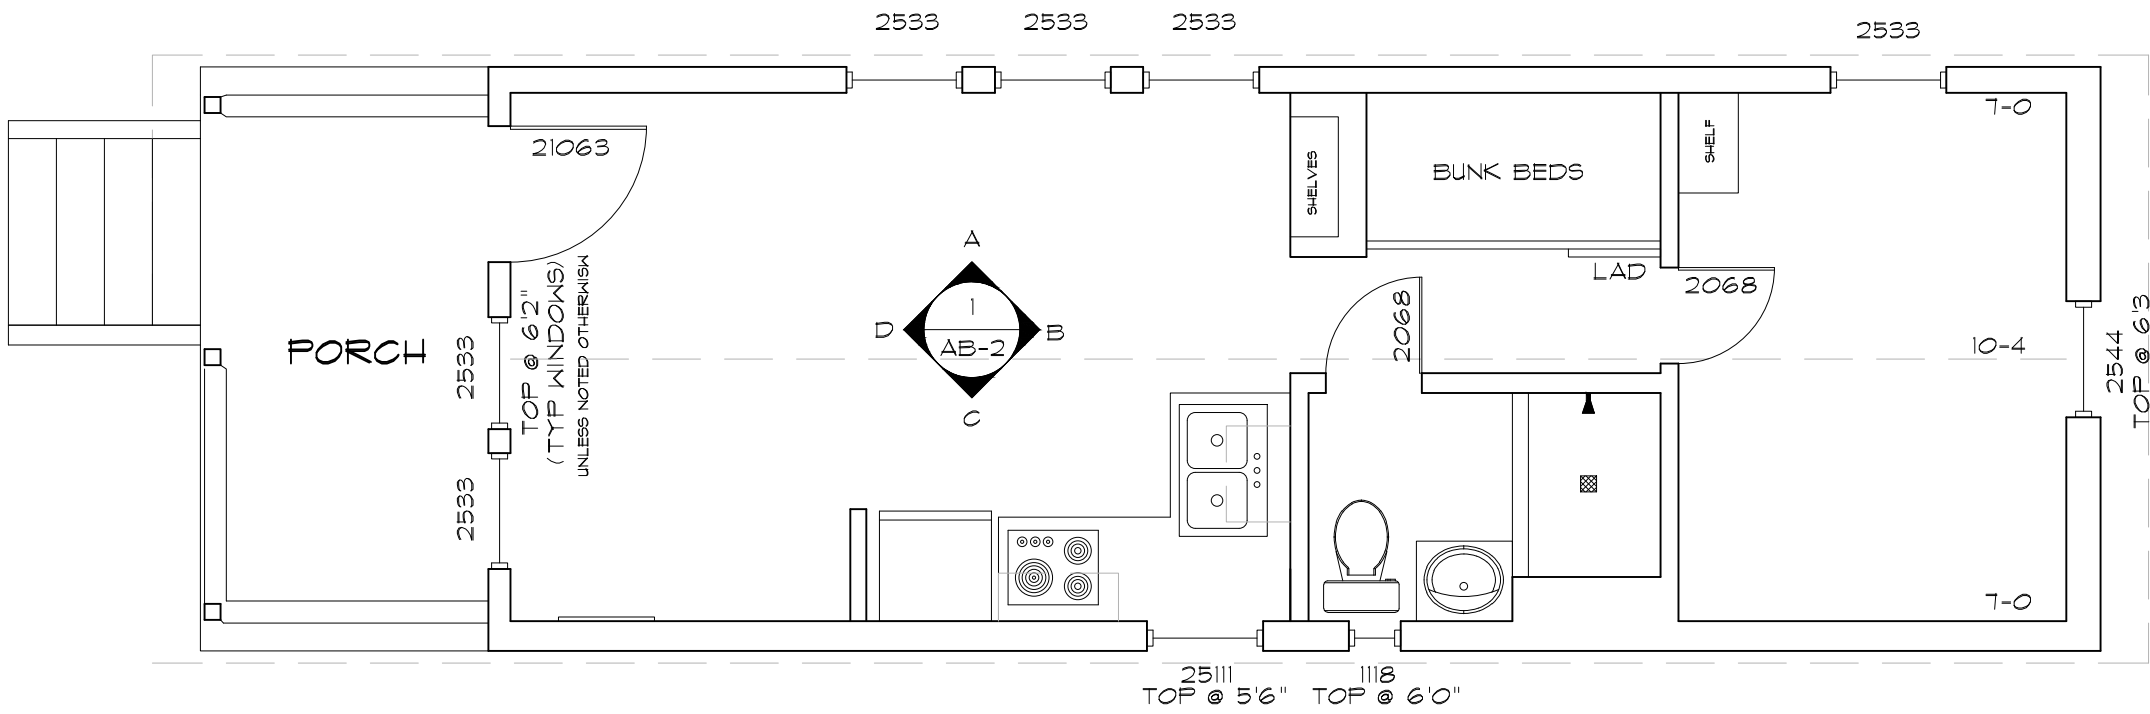


FLOOR PLAN DELUXE CABIN DK2

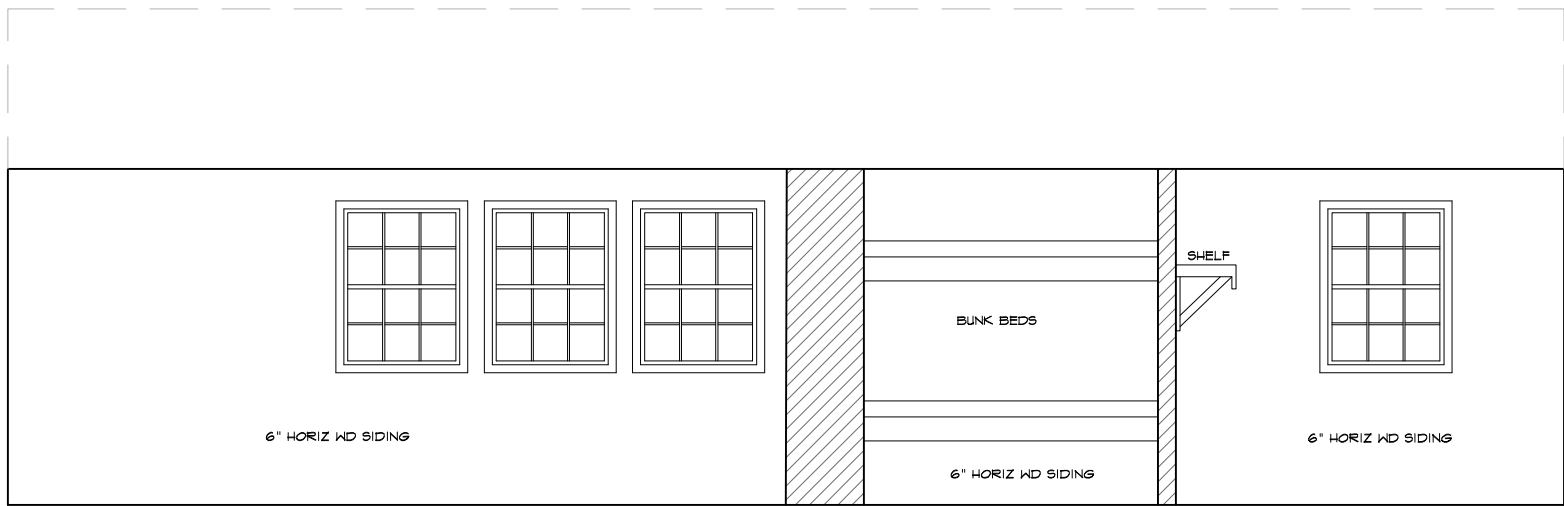

INTERIOR ELEVATION 2-A

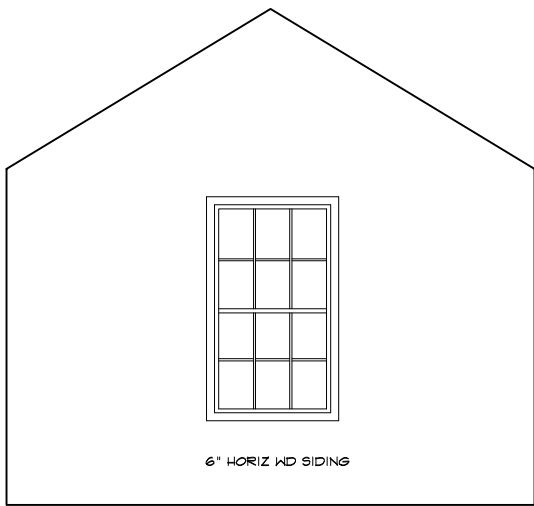

INTERIOR ELEVATION 2-B

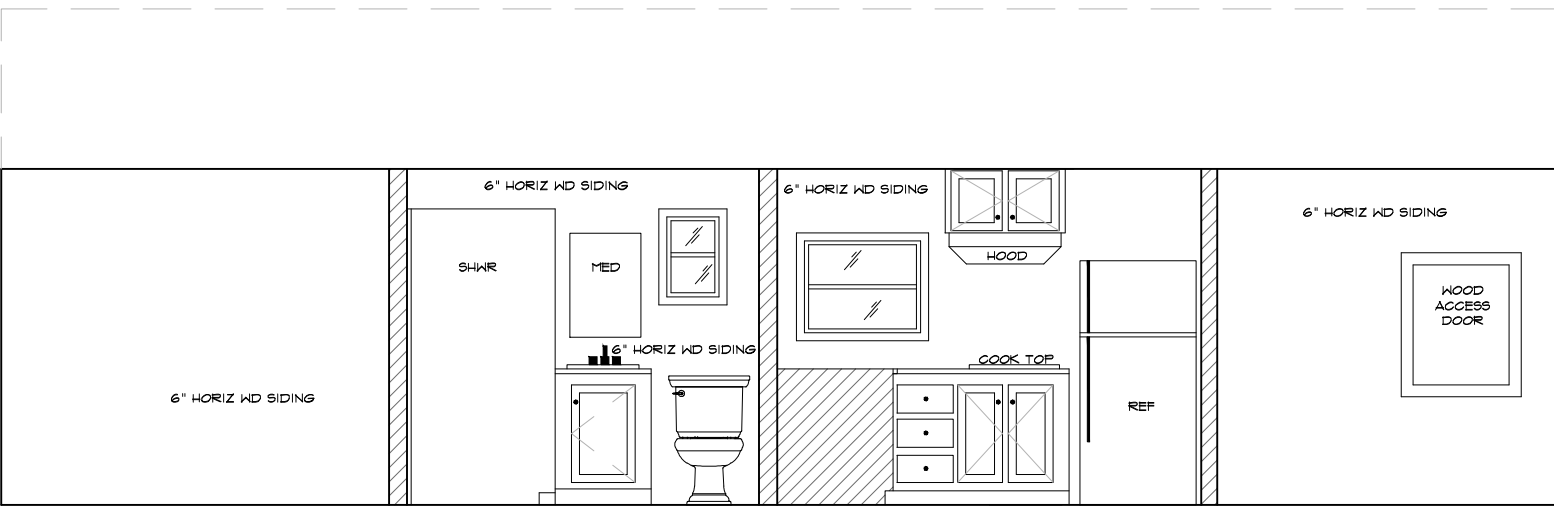

INTERIOR ELEVATION 2-C



INTERIOR ELEVATION 2-D

As BUILT

PROFESSIONALS

www.asbuiltprofessionals.com

A DIVISION OF:

AEC

CONSULTANTS INC

844.272.8458

844 AS BUILT

© 2011 AEC CONSULTANTS INC

ARCHITECTURAL AS BUILT

Yosemite West KOA

Midpines, CA 95345

01

100% SUBMISSION

NO.

ISSUES | REVISIONS

DATE

SHEET TITLE

HL

PROJECT MANAGER

HL

PROJECT DIRECTOR

012317-1

PROJECT NUMBER

1/4"=1'-0"

SCALE


CL

DRAWN BY

SHEET NUMBER

AB-2




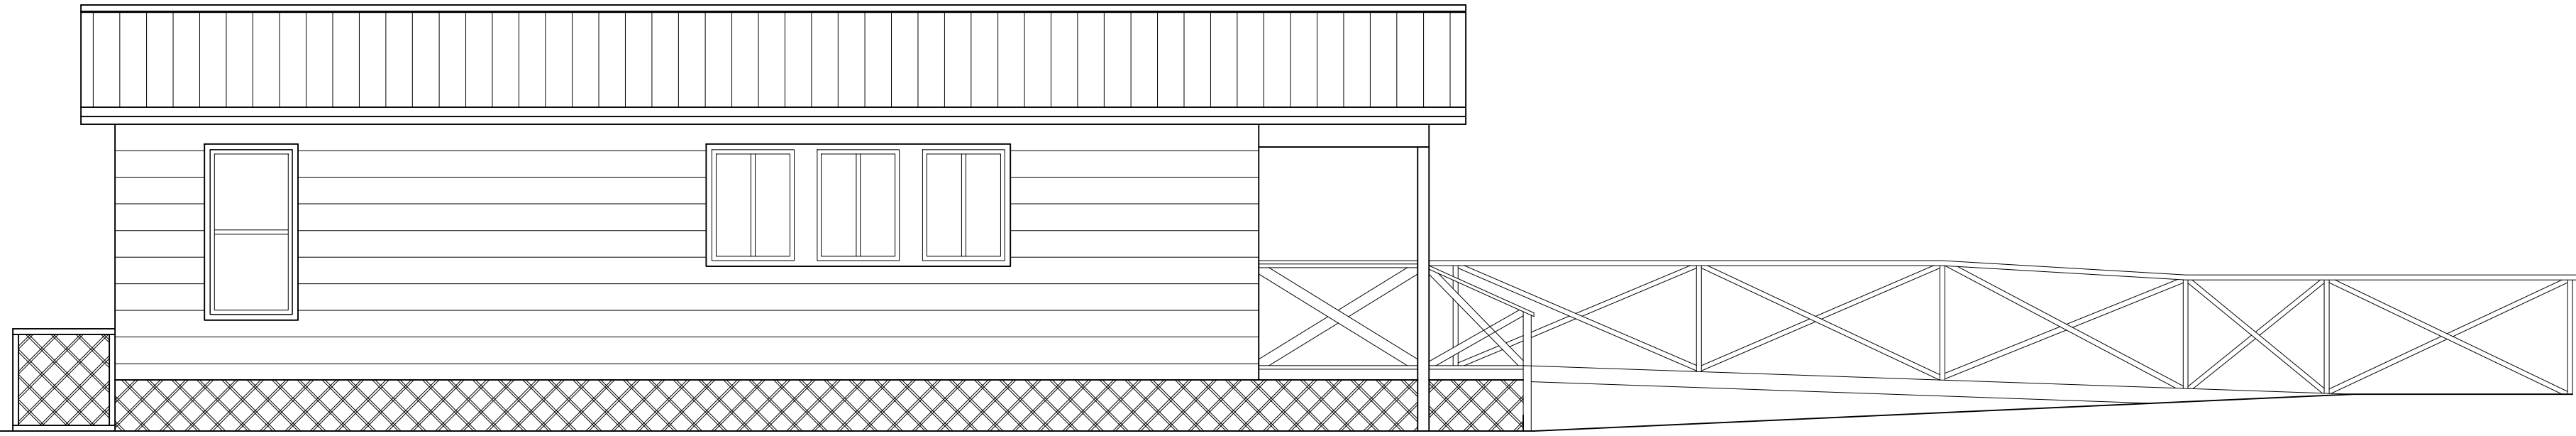


LEFT SIDE ELEVATION




FRONT ELEVATION

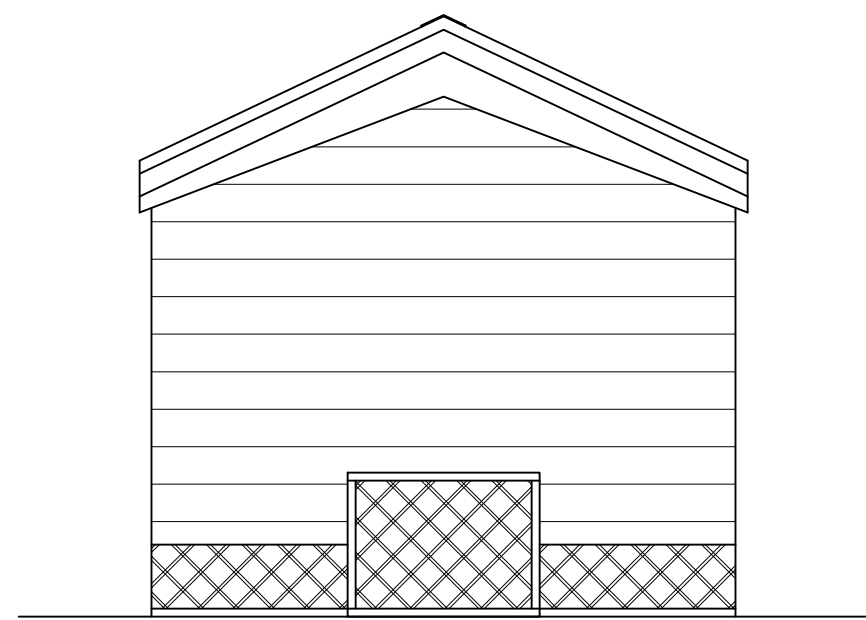


REAR ELEVATION

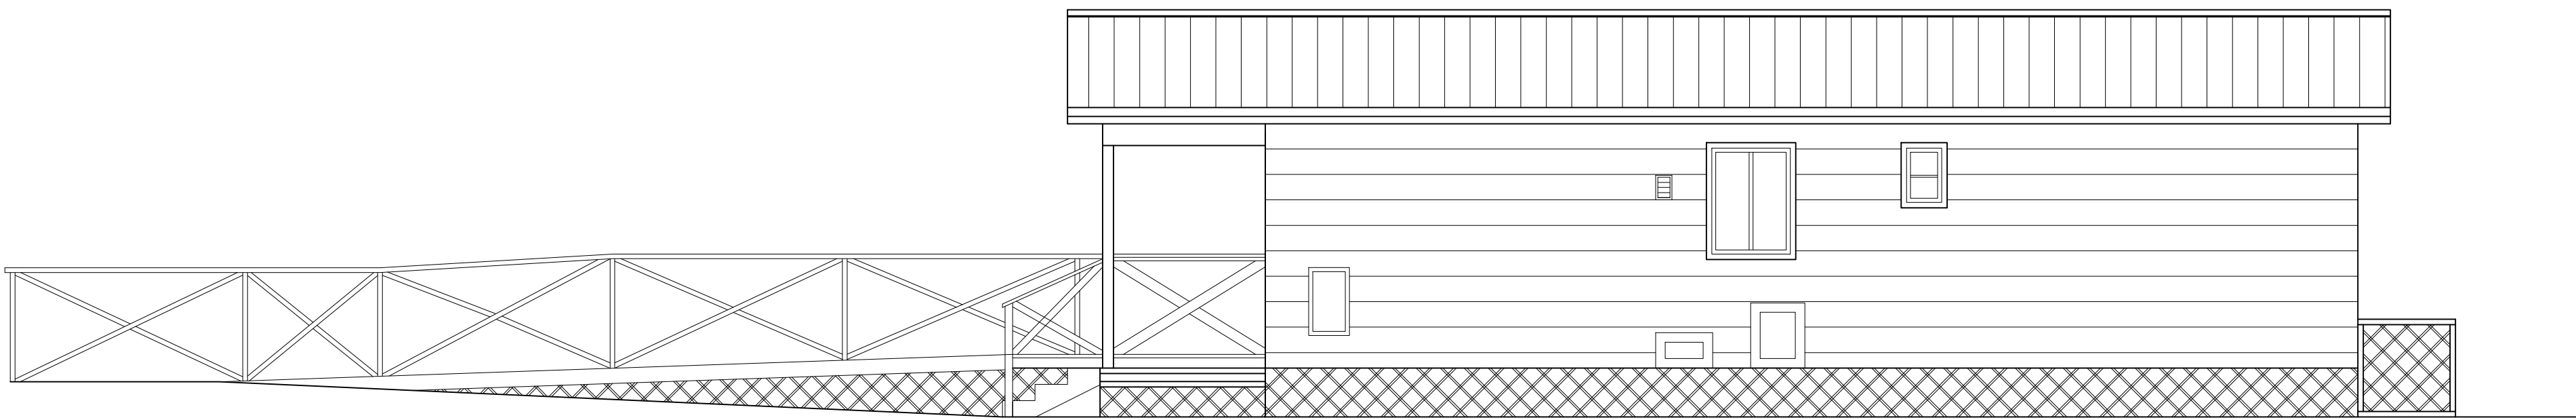


RIGHT SIDE ELEVATION

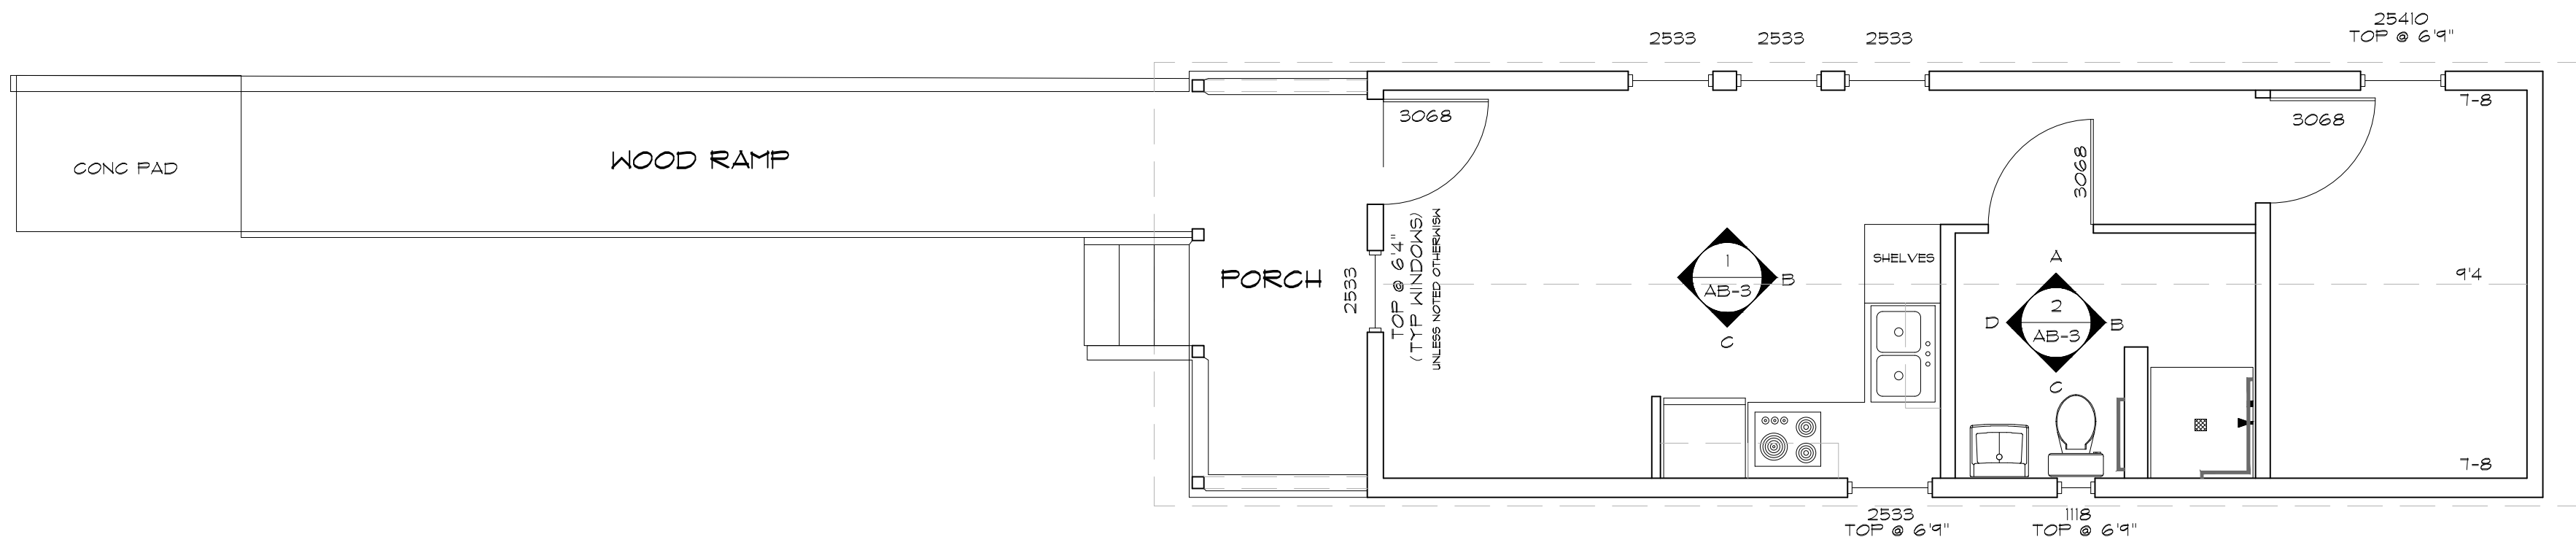


FLOOR PLAN ADA CABIN DK3

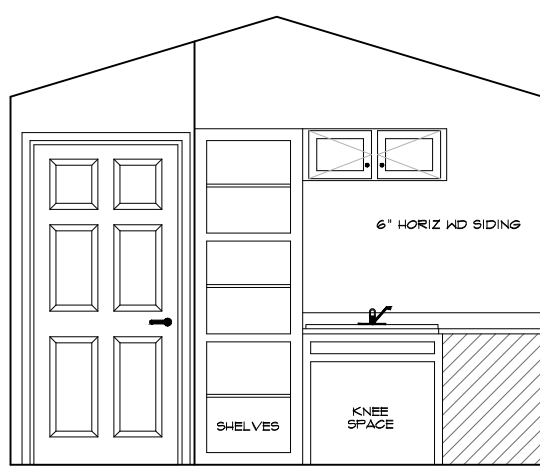


INTERIOR ELEVATION 1-B

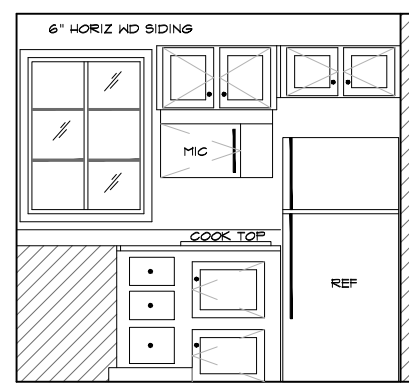


INTERIOR ELEVATION 1-C

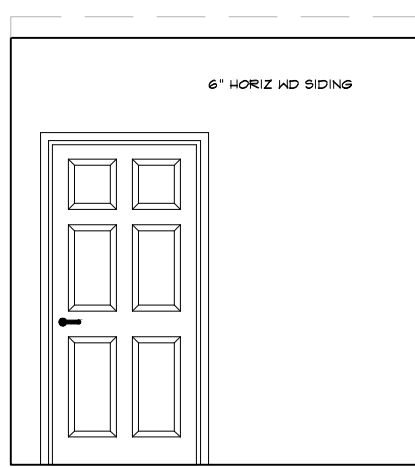


INTERIOR ELEVATION 2-A

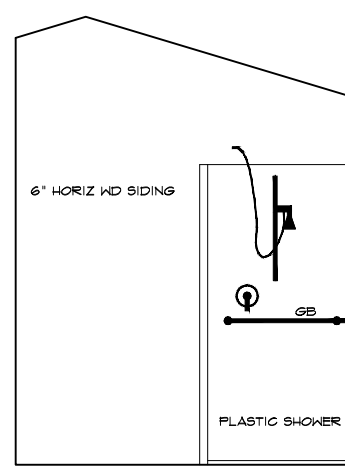

INTERIOR ELEVATION 2-B

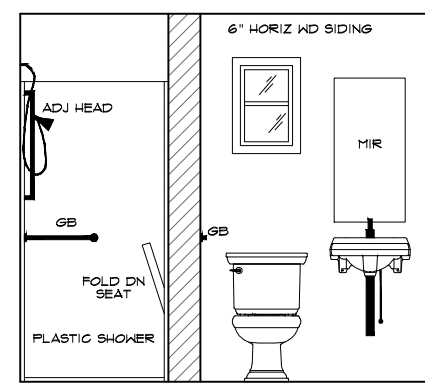

INTERIOR ELEVATION 2-C

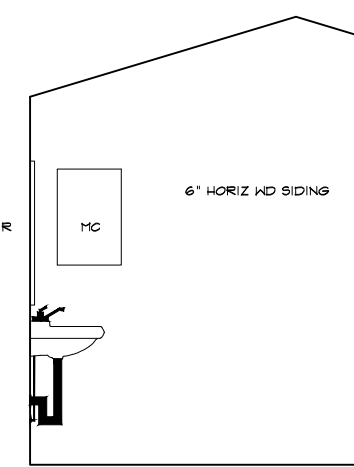




INTERIOR ELEVATION 2-D



ARCHITECTURAL AS BUILT  
Yosemite West KOA  
Midpines, CA 95345


01	100% SUBMISSION	
NO.	ISSUES   REVISIONS	DATE
SHEET TITLE		
HL	PROJECT MANAGER	
HL	PROJECT DIRECTOR	
012317-1	PROJECT NUMBER	
1/4"=1'-0"	SCALE	
CL	DRAWN BY	
SHEET NUMBER		

AB-3

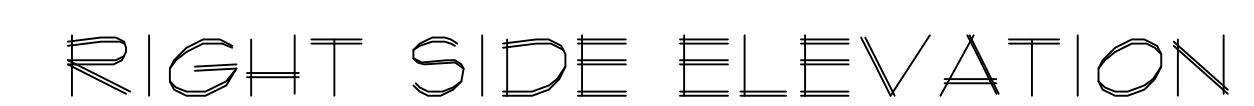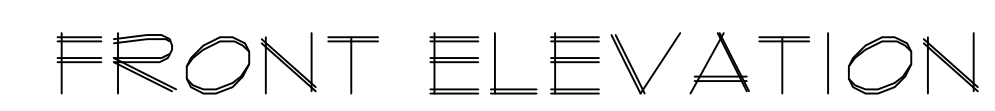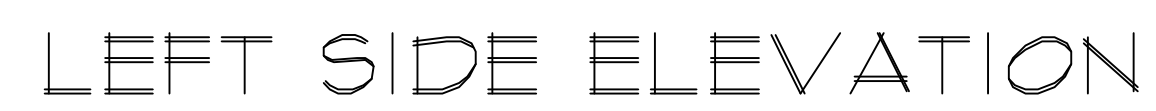


**ARCHITECTURAL AS BUILT**  
**Yosemite West KOA**  
**Midpines, CA 95345**


01	100% SUBMISSION	
NO.	ISSUES   REVISIONS	DATE
		SHEET TITLE
HL	PROJECT MANAGER	
HL	PROJECT DIRECTOR	
012317-1	PROJECT NUMBER	
1/4"=1'-0"		SCALE
CL	DRAWN BY	
		SHEET NUMBER
AB-4		

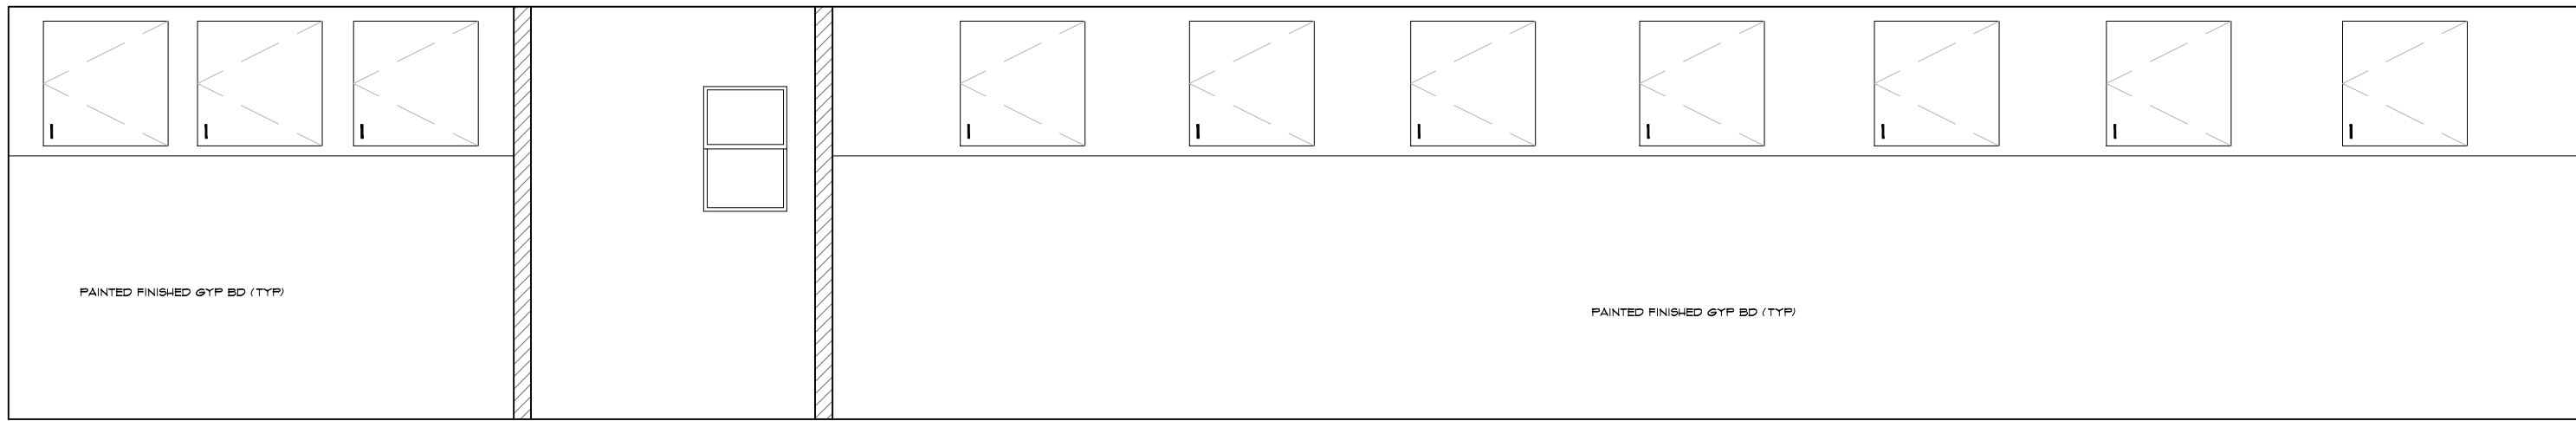

INTERIOR REAR ELEVATION

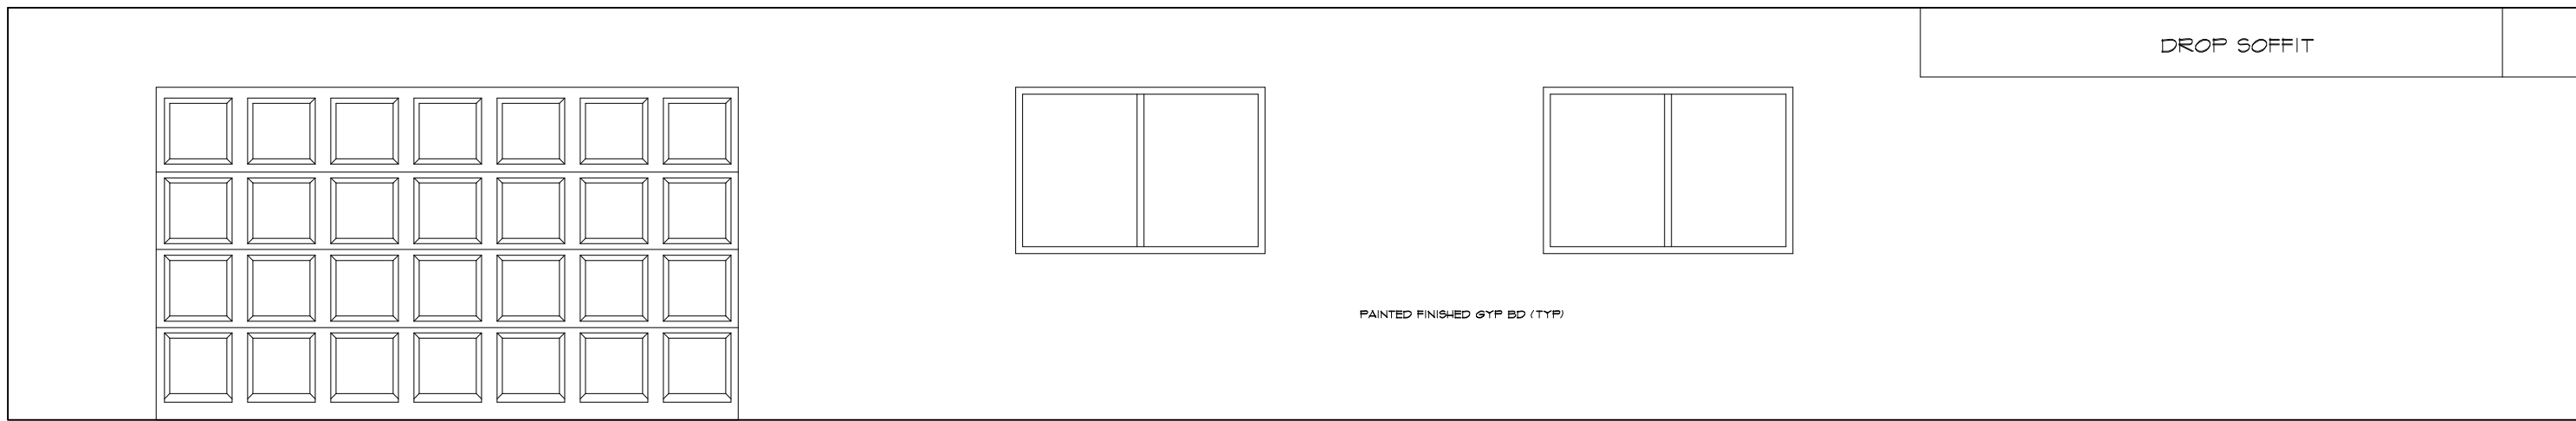

INTERIOR FRONT ELEVATION

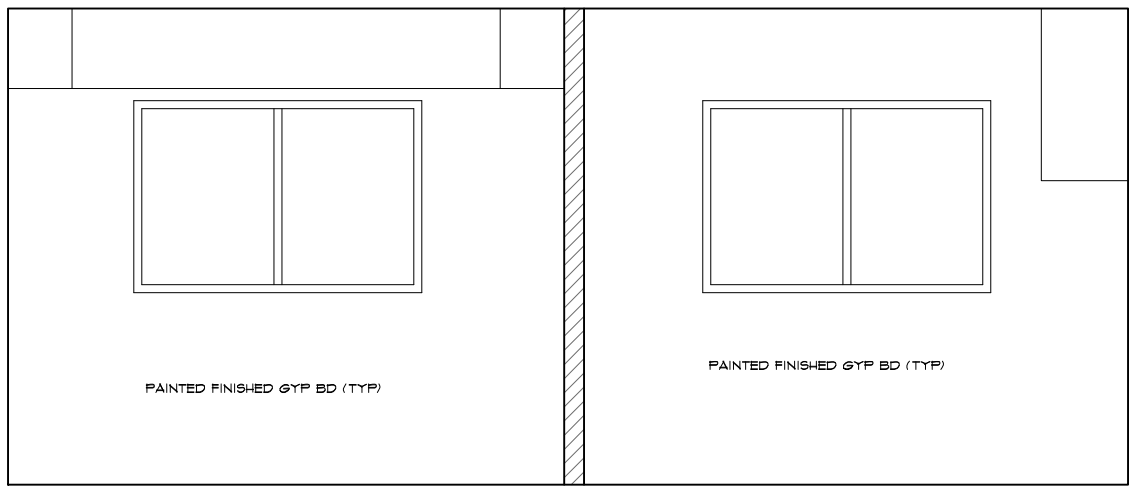

INTERIOR LEFT SIDE ELEVATION



INTERIOR RIGHT SIDE ELEVATION

As BUILT

PROFESSIONALS

www.asbuiltprofessionals.com

A DIVISION OF:

AEC

CONSULTANTS INC

844.272.8458

844 AS BUILT

@ 2017 AEC CONSULTANTS INC

ARCHITECTURAL AS BUILT  
Yosemite West KOA  
Midpines, CA 95345

01	100% SUBMISSION	
NO.	ISSUES   REVISIONS	DATE
		SHEET TITLE
HL	PROJECT MANAGER	
HL	PROJECT DIRECTOR	
012317-1	PROJECT NUMBER	
1/4"=1'-0"	SCALE	
CL	DRAWN BY	
		SHEET NUMBER
AB-5		