




**ARCHITECTURAL AS BUILT
 HIGHLAND PARK RESIDENCE**

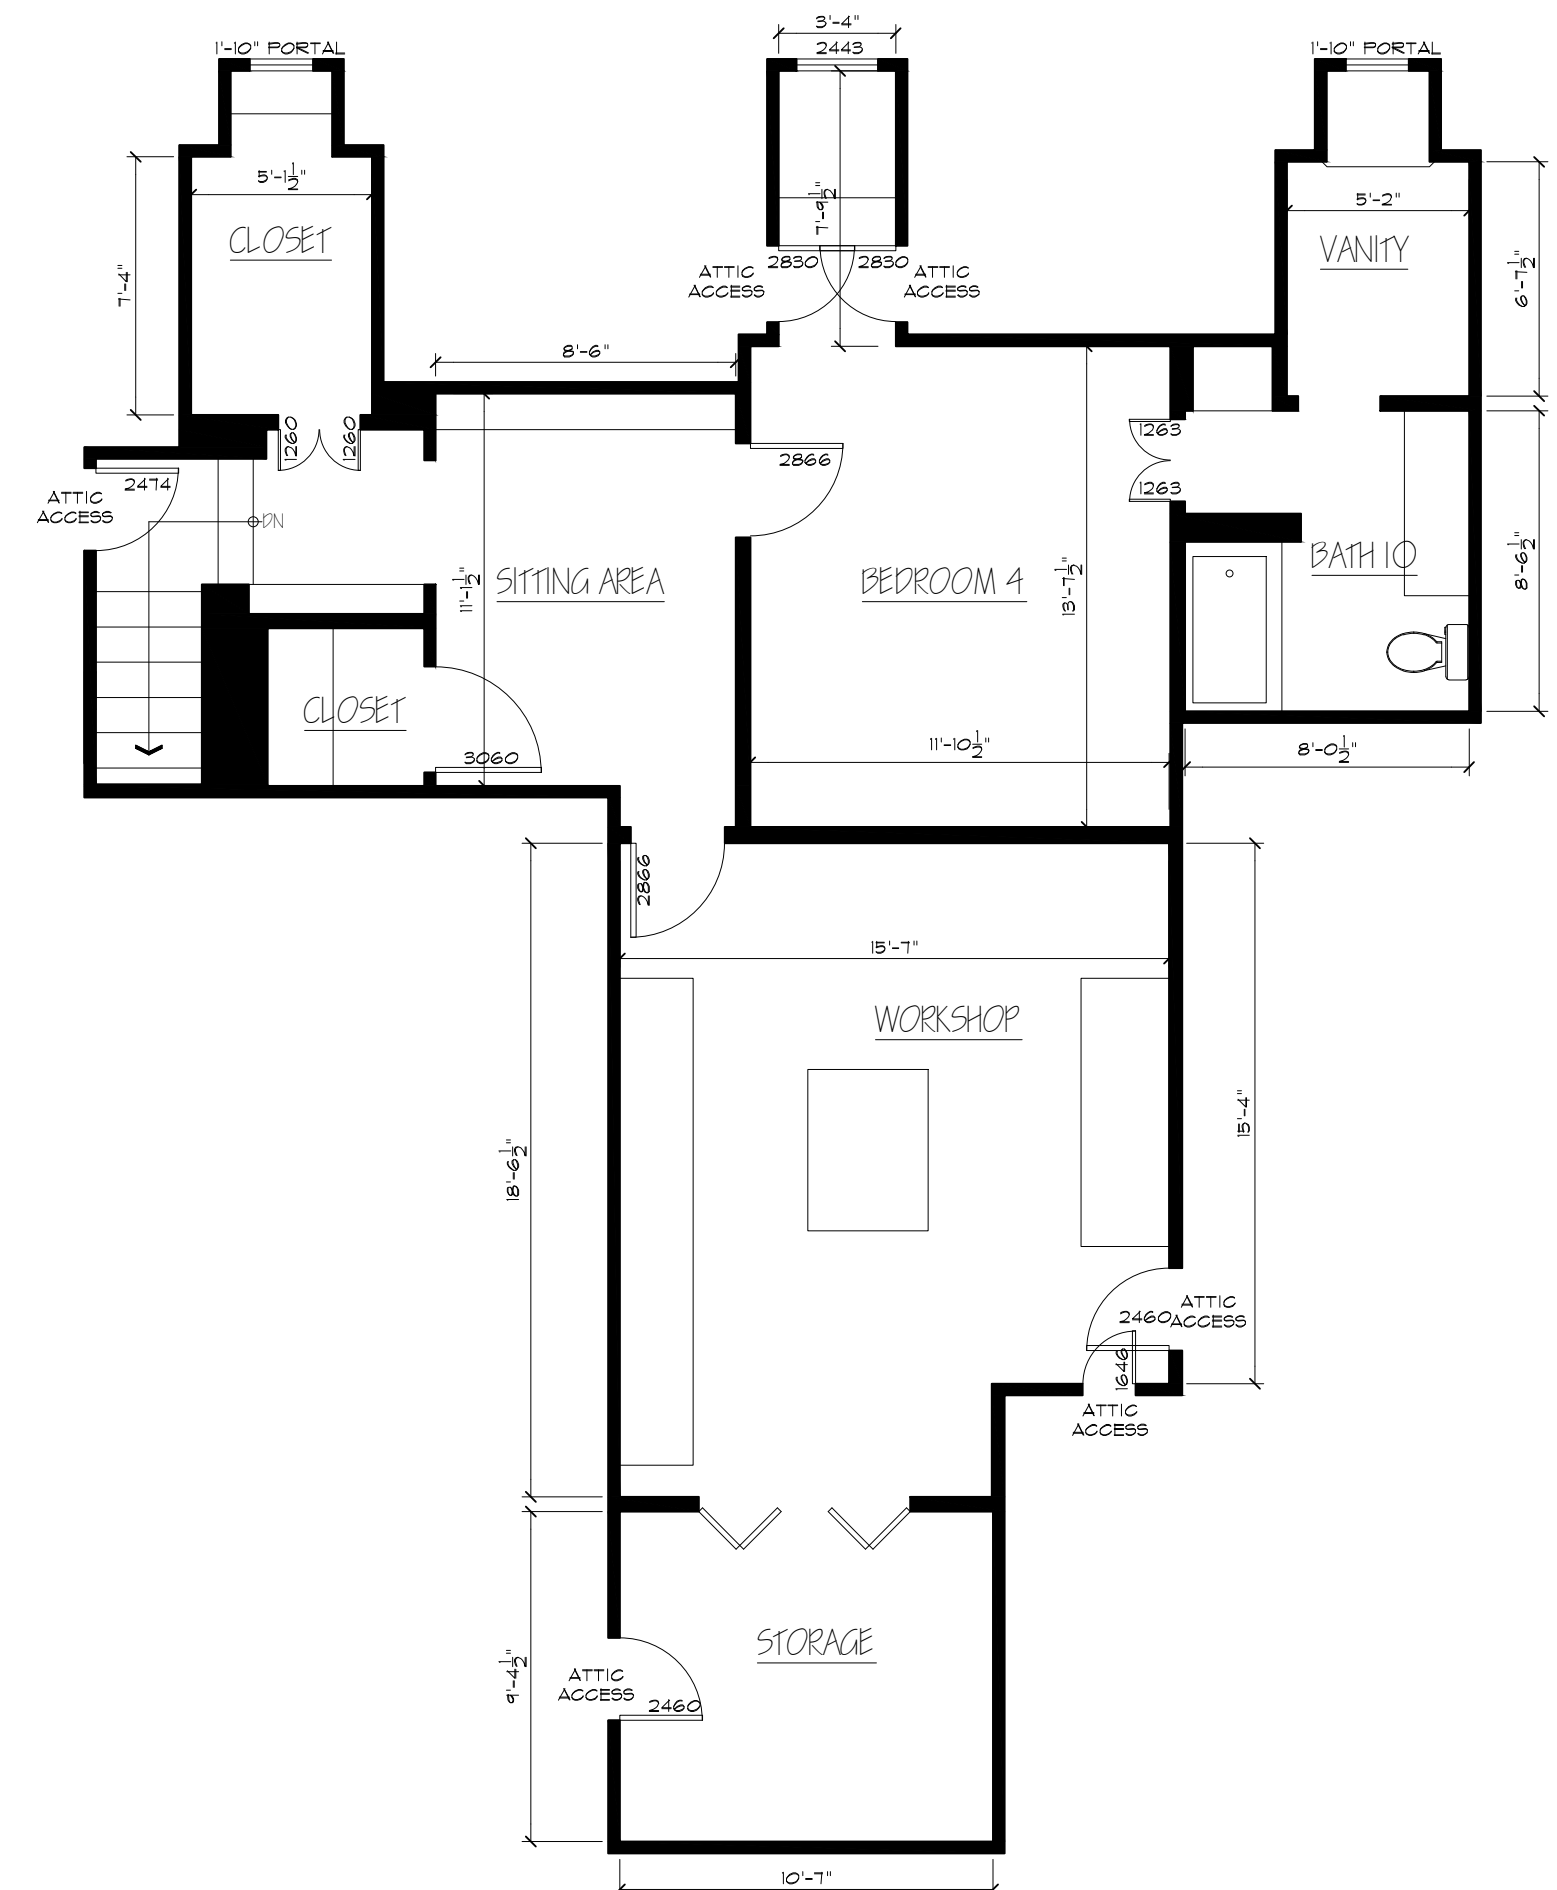

THIRD FLOOR PLAN

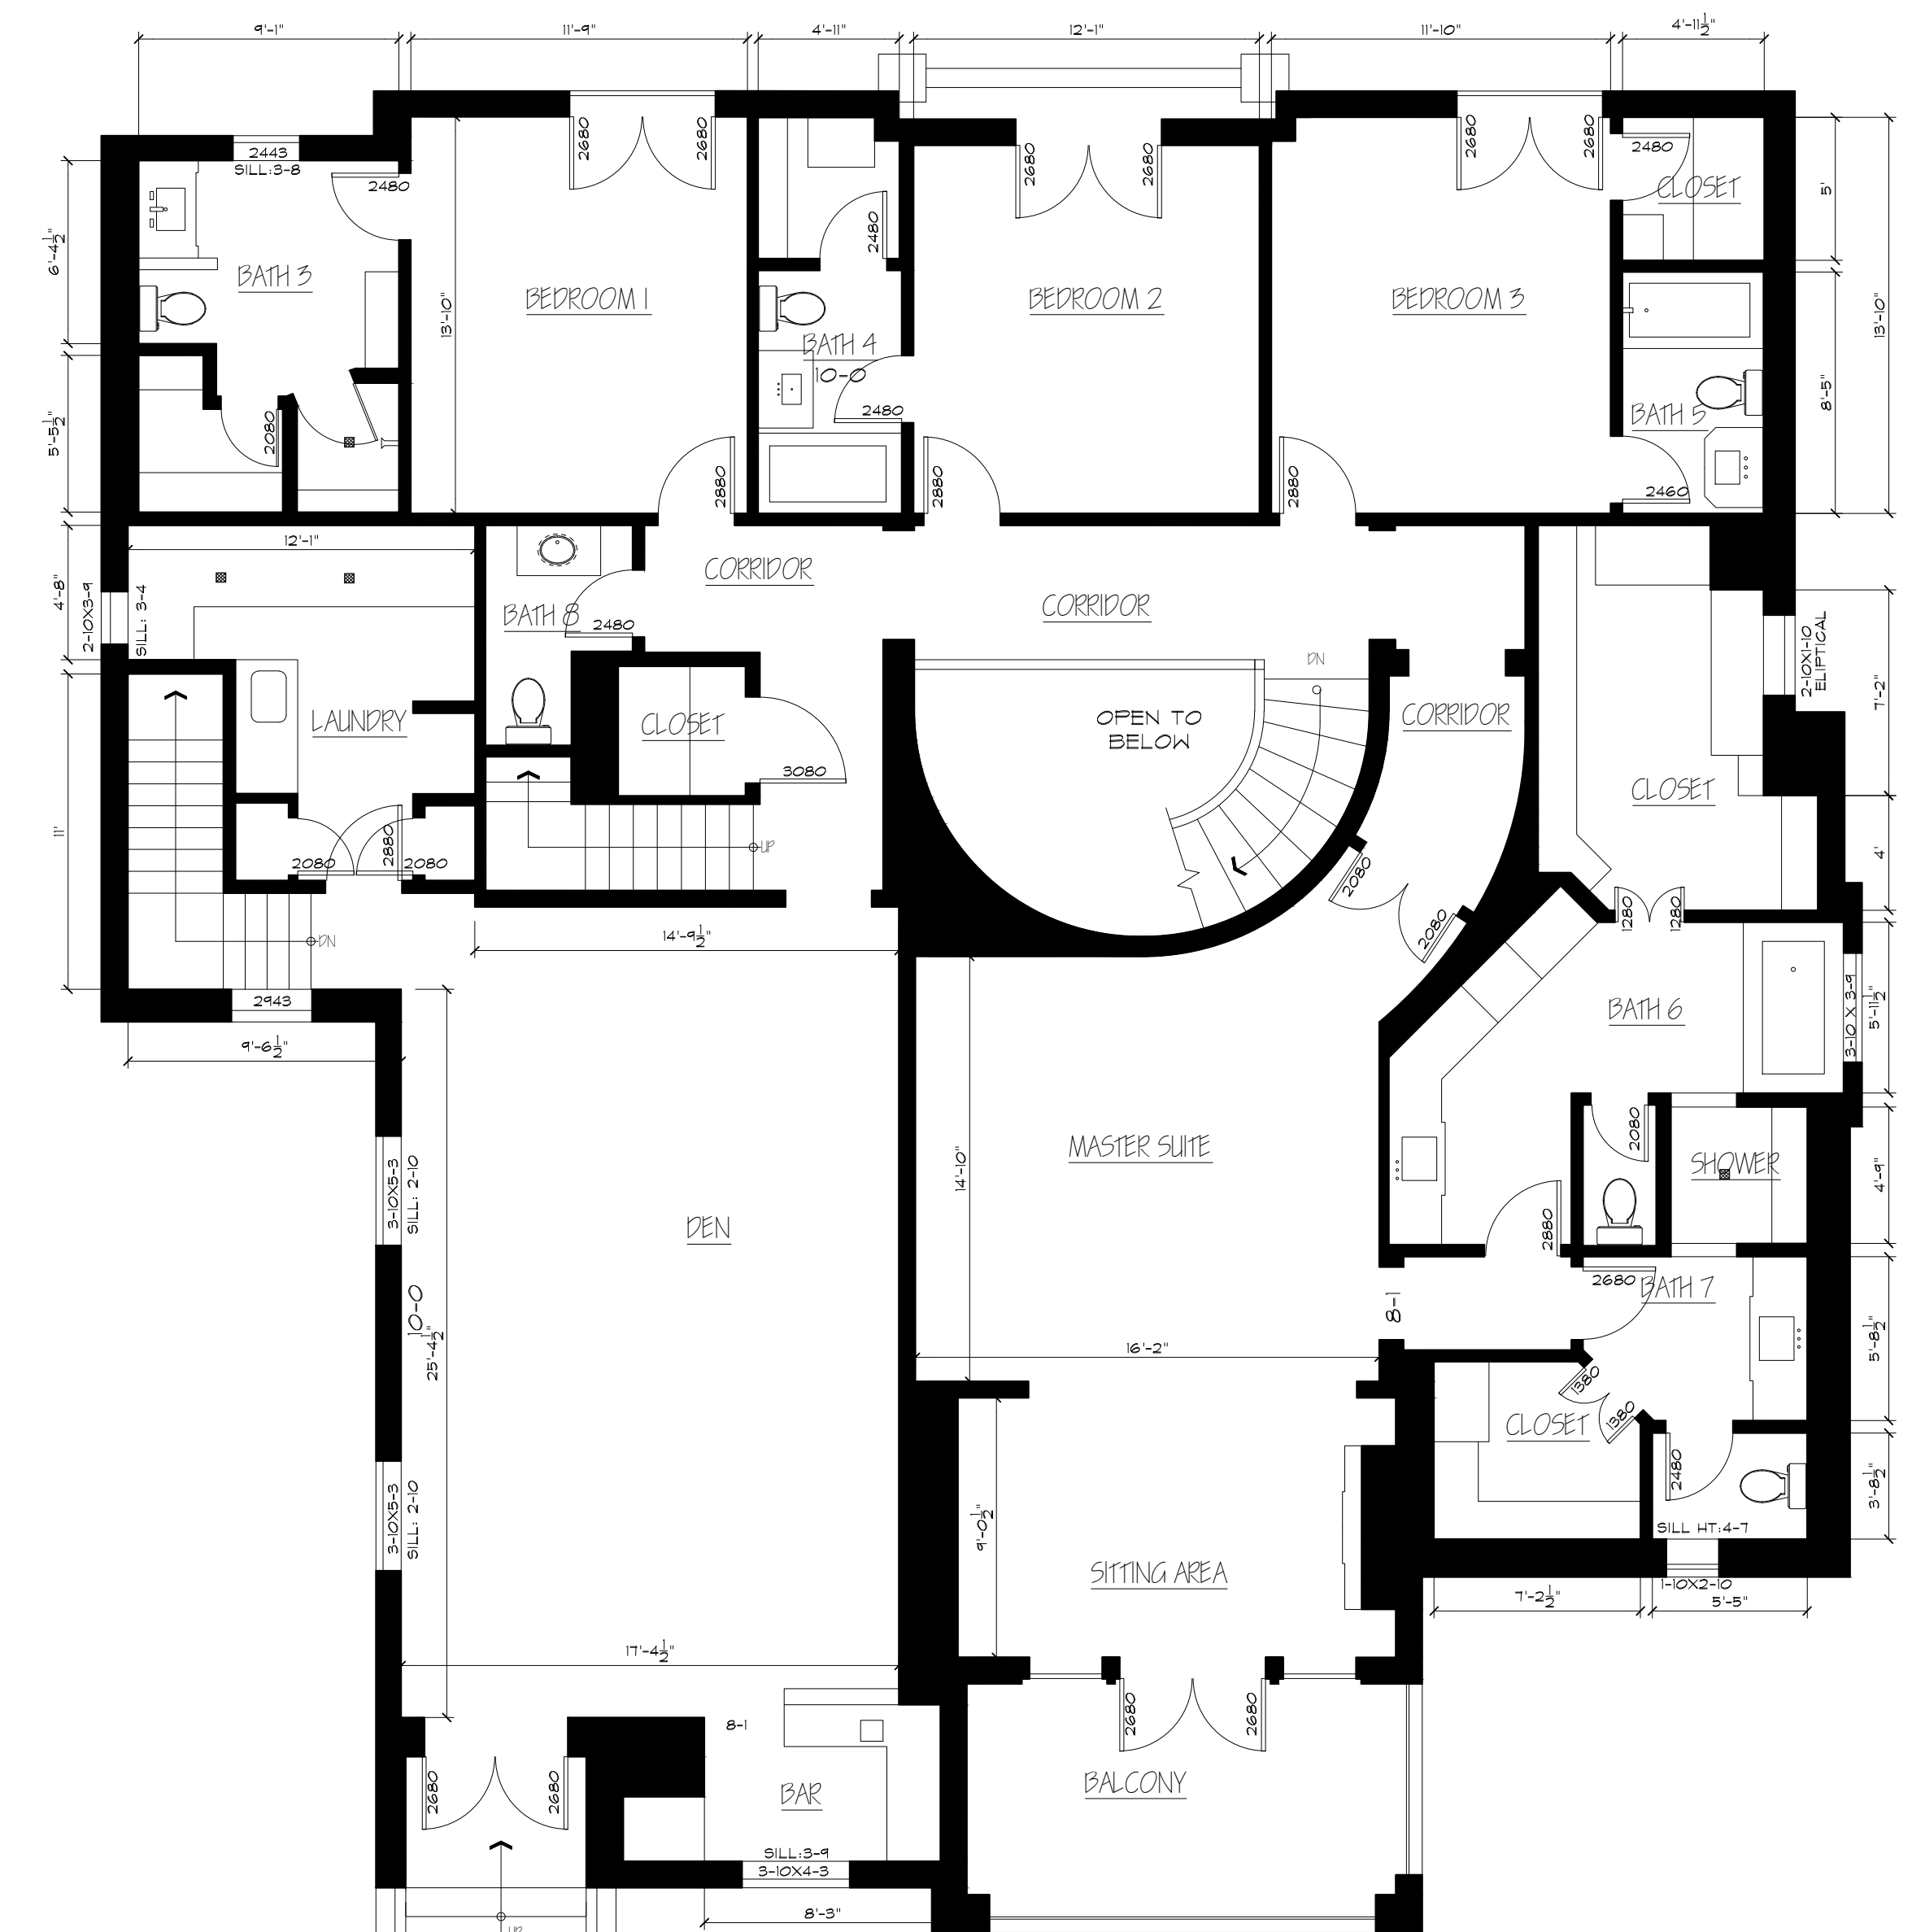

SECOND FLOOR PLAN

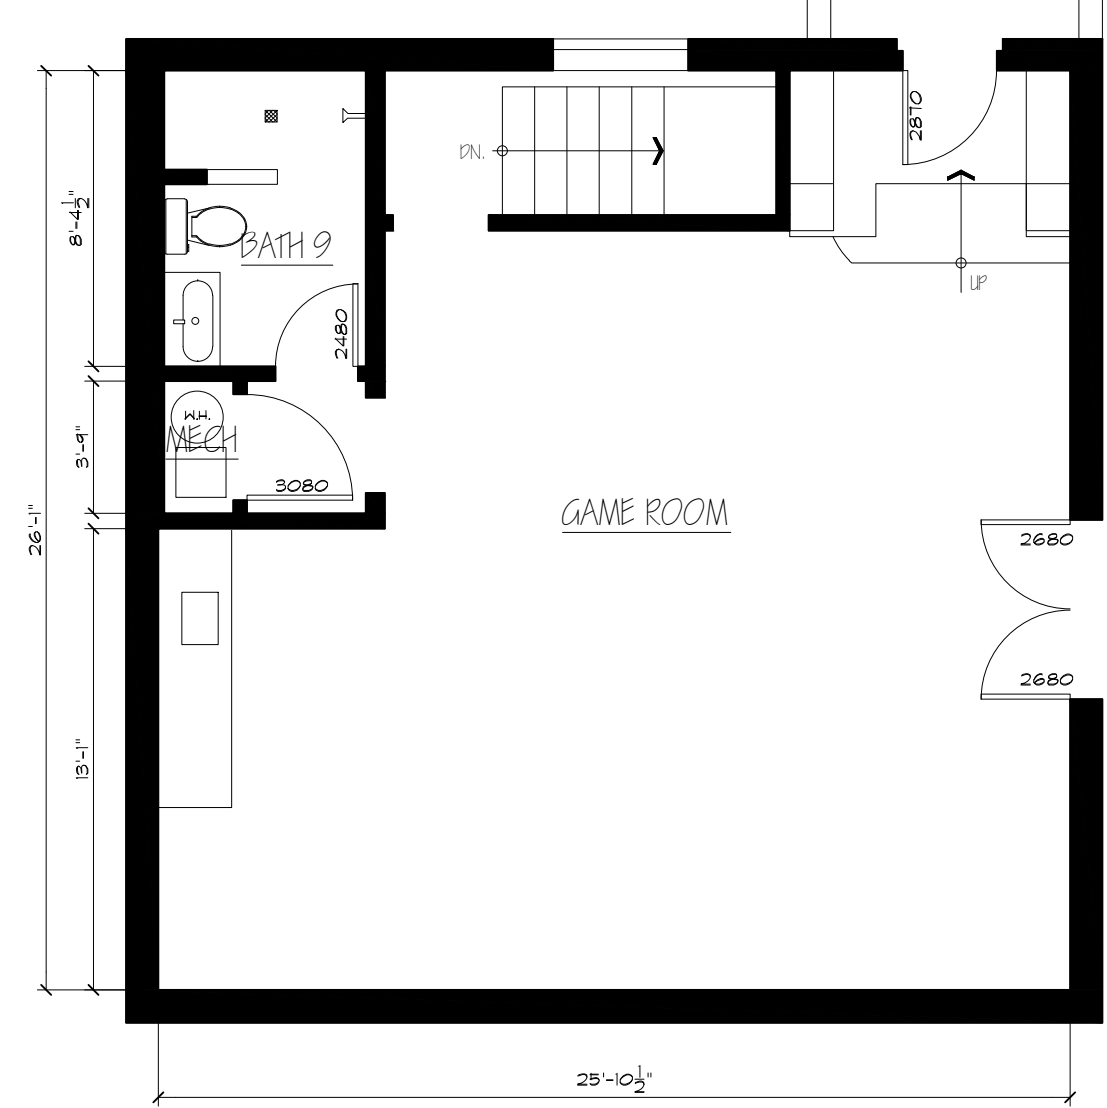

3RD FLOOR FINISH SCHEDULE				
ROOM NAME	FLOOR	WALLS	CEILING	NOTES
STORAGE ROOM	STAINED WOOD	PAINTED DRYWALL	PAINTED DRYWALL	
SITTING AREA	STAINED WOOD	PAINTED DRYWALL	PAINTED DRYWALL	
BEDROOM 4	STAINED WOOD	PAINTED DRYWALL	PAINTED DRYWALL	
BATH 10	TILE	PAINTED DRYWALL	PAINTED DRYWALL	
VANITY	TILE	PAINTED DRYWALL	PAINTED DRYWALL	
WORKSHOP	STAINED WOOD	PAINTED DRYWALL	PAINTED DRYWALL	

2ND FLOOR FINISH SCHEDULE				
ROOM NAME	FLOOR	WALLS	CEILING	NOTES
GAME ROOM	WOOD	PAINTED DRYWALL	PAINTED DRYWALL	
BATH 9	TILE	PAINTED CONCRETE	PAINTED METAL	TILE WAINSCOT UP TO 36"
DEN	STAINED WOOD	PAINTED DRYWALL	WOOD BEAMS	
LAUNDRY	STAINED WOOD	PAINTED DRYWALL	PAINTED DRYWALL	
BEDROOM 1	STAINED WOOD	PAINTED DRYWALL	PAINTED DRYWALL	
BATH 3	TILE	PAINTED DRYWALL	PAINTED DRYWALL	
BEDROOM 2	STAINED WOOD	PAINTED DRYWALL	PAINTED DRYWALL	
BATH 4	TILE	PAINTED DRYWALL	PAINTED DRYWALL	
BEDROOM 3	STAINED WOOD	PAINTED DRYWALL	PAINTED DRYWALL	
BATH 5	TILE	PAINTED DRYWALL	PAINTED DRYWALL	
MASTER SUITE	STAINED WOOD	PAINTED DRYWALL	PAINTED DRYWALL	
SITTING AREA	STAINED WOOD	PAINTED DRYWALL	PAINTED DRYWALL	
BATH 6	TILE	PAINTED DRYWALL	PAINTED DRYWALL	
BATH 7	TILE	WALL PAPER	WALL PAPER	
DINING ROOM	STAINED WOOD	PAINTED DRYWALL	PAINTED DRYWALL	WAINSCOT UP TO 36"
DESSERT ROOM	STAINED WOOD	PAINTED DRYWALL	PAINTED DRYWALL	
ENTRY	TILE	PAINTED DRYWALL	PAINTED DRYWALL	
LIVING ROOM	STAINED WOOD	PAINTED DRYWALL	PAINTED DRYWALL	
BATH 2	STAINED WOOD	PAINTED DRYWALL	PAINTED DRYWALL	TILE WAINSCOT UP TO 36"

NO. ISSUES | REVISIONS DATE

SHEET TITLE

**SECOND AND
 THIRD FLOOR
 PLAN**

HL PROJECT MANAGER

HL PROJECT DIRECTOR

012317-1 PROJECT NUMBER

3/16"=1'-0" SCALE

MM DRAWN BY

SHEET NUMBER