


**ARCHITECTURAL AS BUILT**  
**Gallatin, TN**

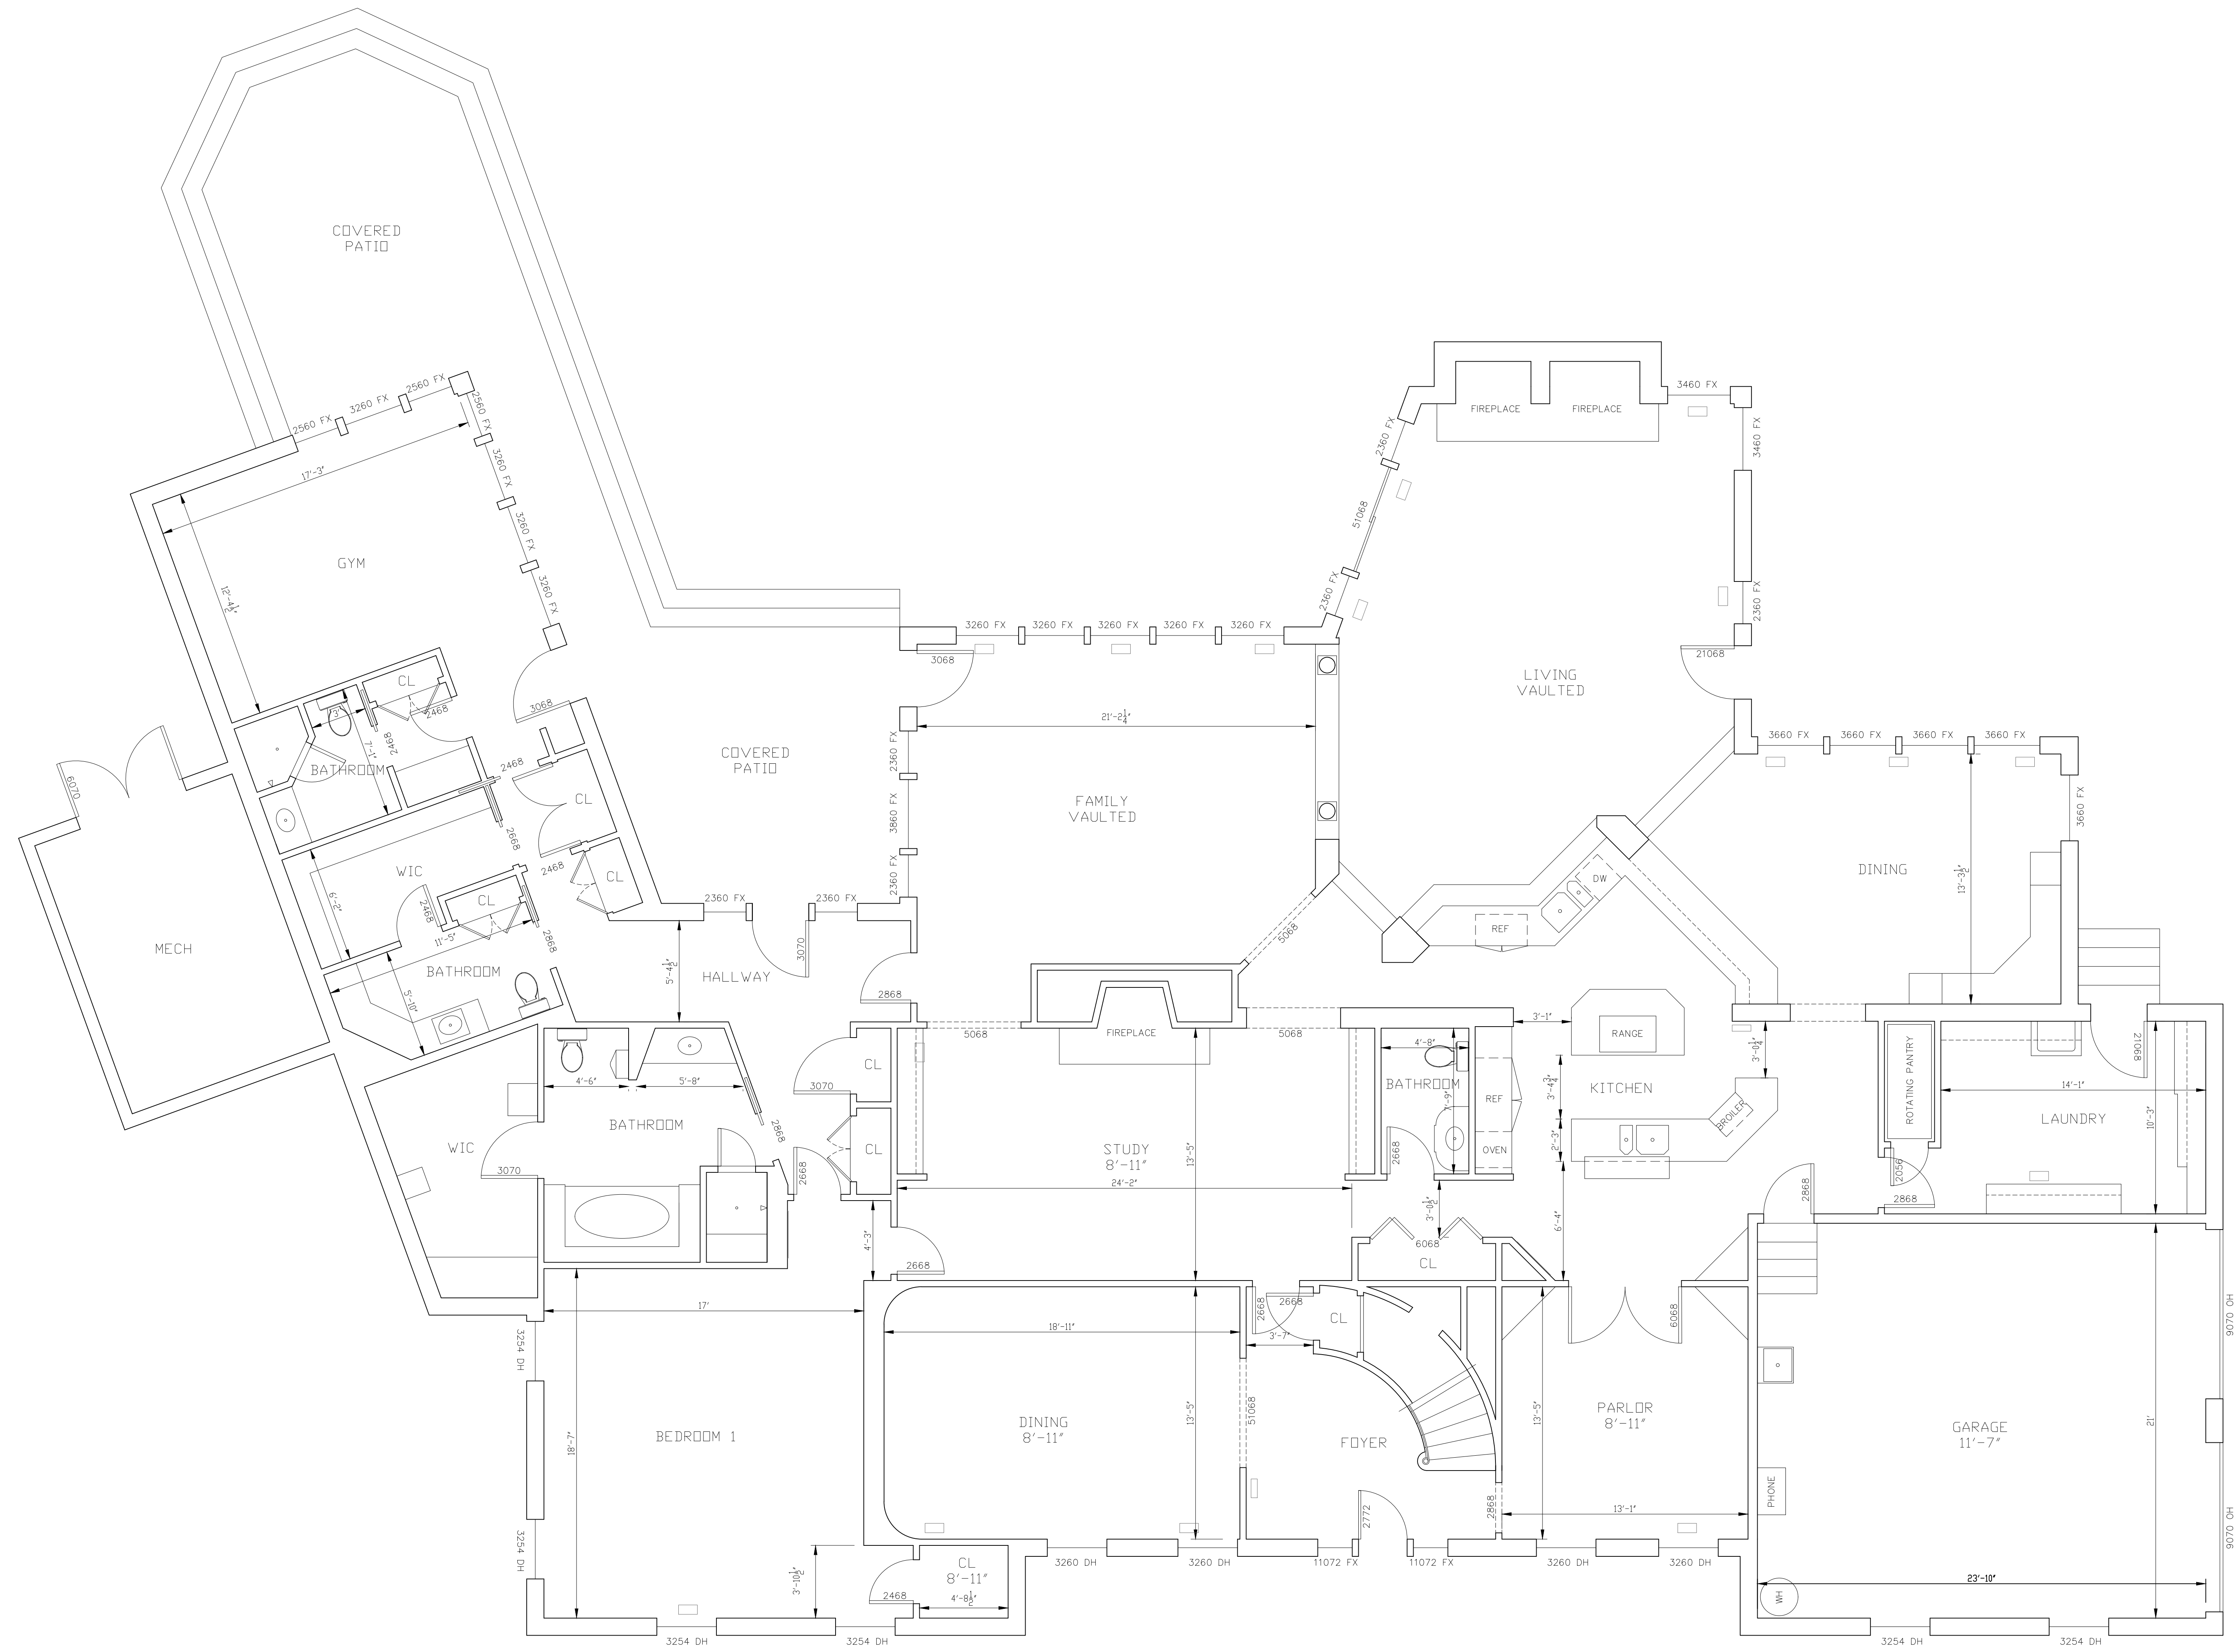

**FIRST FLOOR**

01	100% SUBMISSION	SEE COVER SHEET
NO.	ISSUES   REVISIONS	DATE
		SHEET TITLE

	<b>FIRST FLOOR</b>
HL	PROJECT MANAGER
HL	PROJECT DIRECTOR
012317-1	PROJECT NUMBER
1/16"=1'-0"	SCALE
CL	DRAWN BY
	SHEET NUMBER

**AB-1**