



INTERIOR ELEVATION 8-A




INTERIOR ELEVATION 8-B

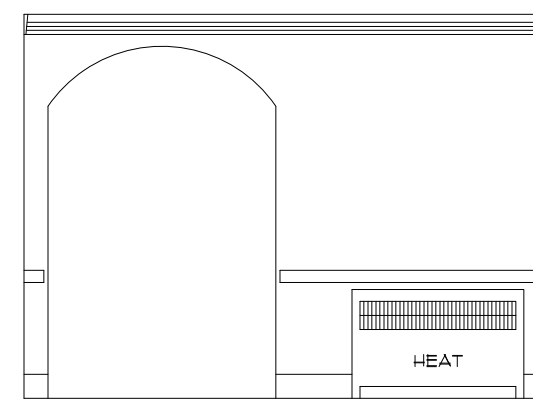


INTERIOR ELEVATION 8-C

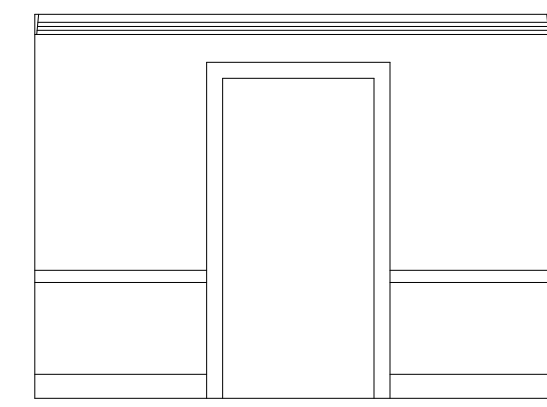


INTERIOR ELEVATION 8-D

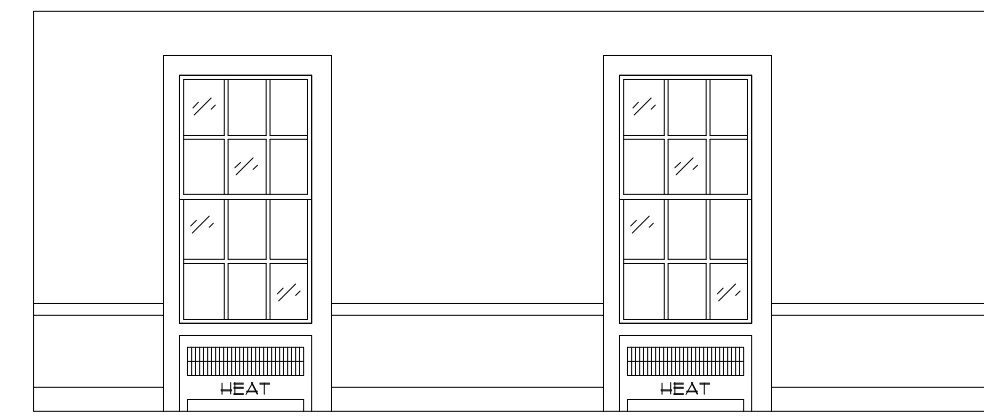

INTERIOR ELEVATION 9-A

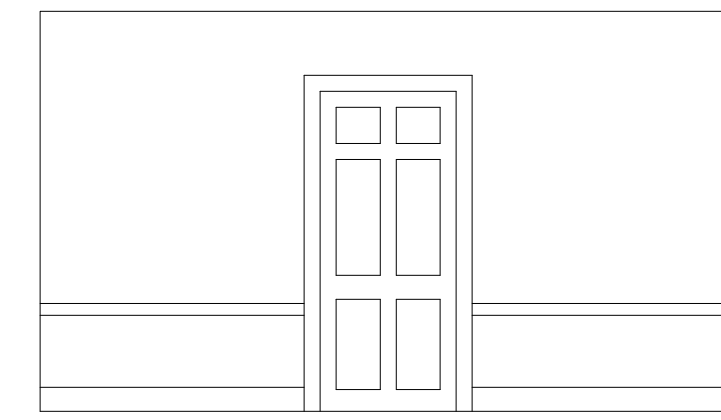

INTERIOR ELEVATION 9-B

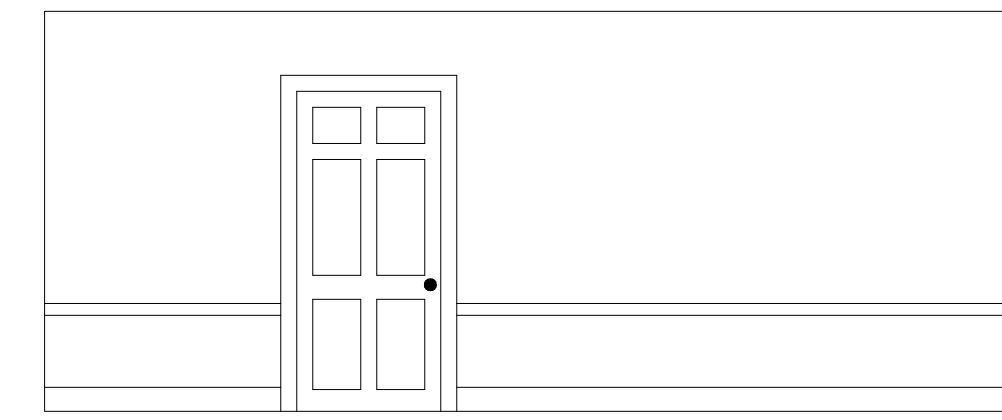

INTERIOR ELEVATION 9-C




INTERIOR ELEVATION 9-D




INTERIOR ELEVATION 10-A



INTERIOR ELEVATION 10-B

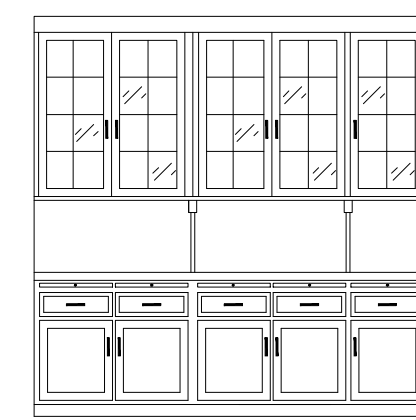


INTERIOR ELEVATION 10-C

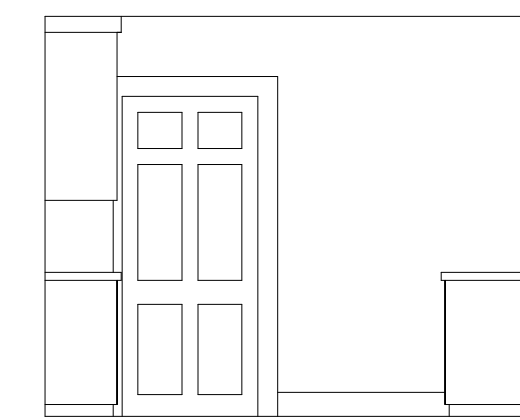


INTERIOR ELEVATION 10-D




INTERIOR ELEVATION 11-A

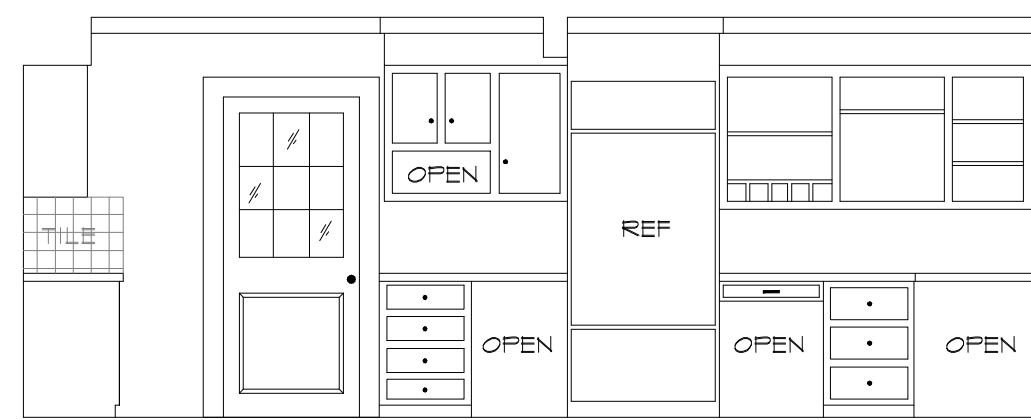


INTERIOR ELEVATION 11-B

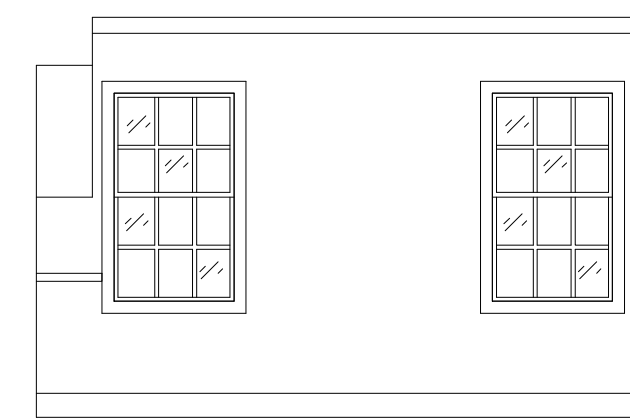


INTERIOR ELEVATION 11-C

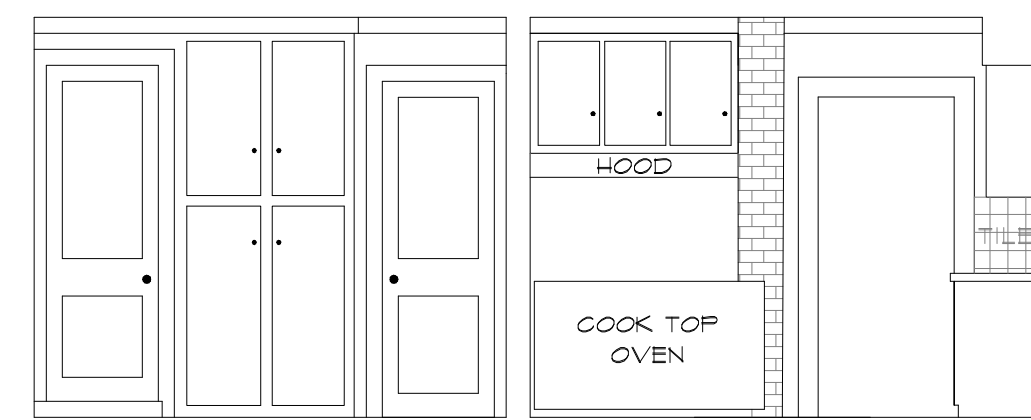


INTERIOR ELEVATION 11-D

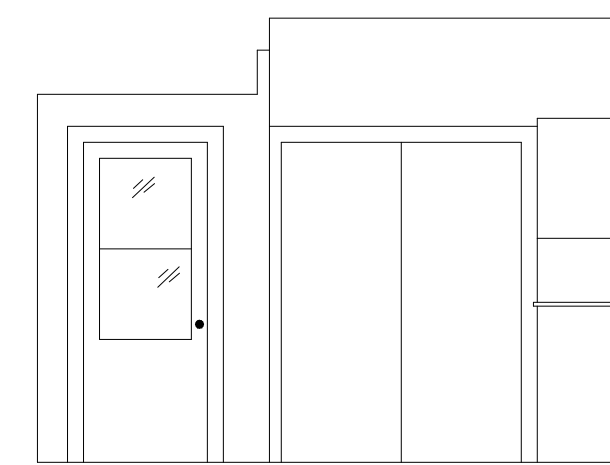


INTERIOR ELEVATION 13-A
WOOD WALLS AND CEILING

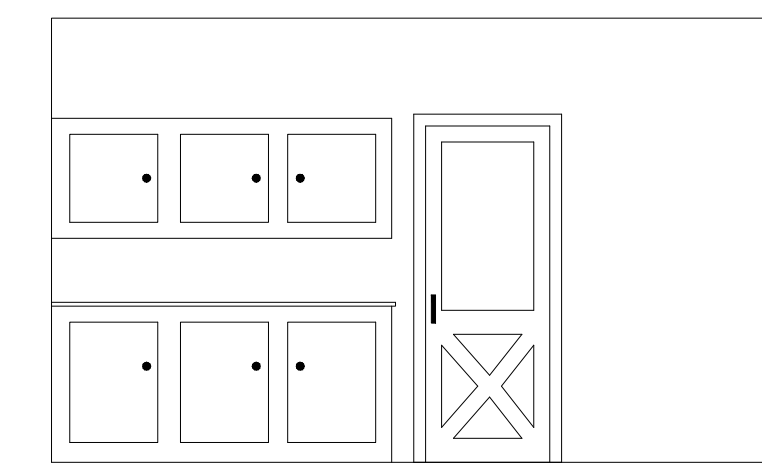


INTERIOR ELEVATION 13-B
WOOD WALLS AND CEILING

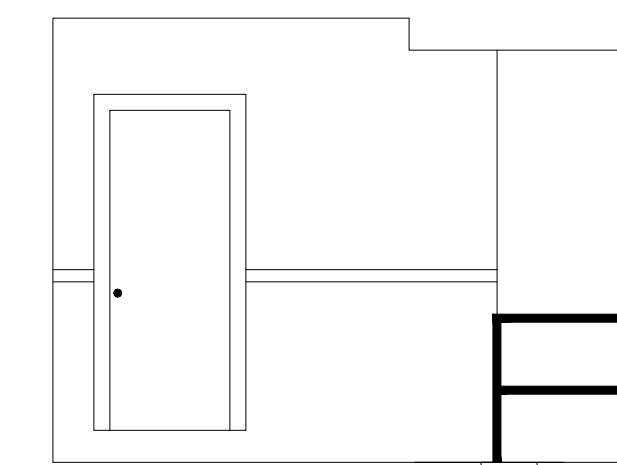


INTERIOR ELEVATION 13-C
WOOD WALLS AND CEILING

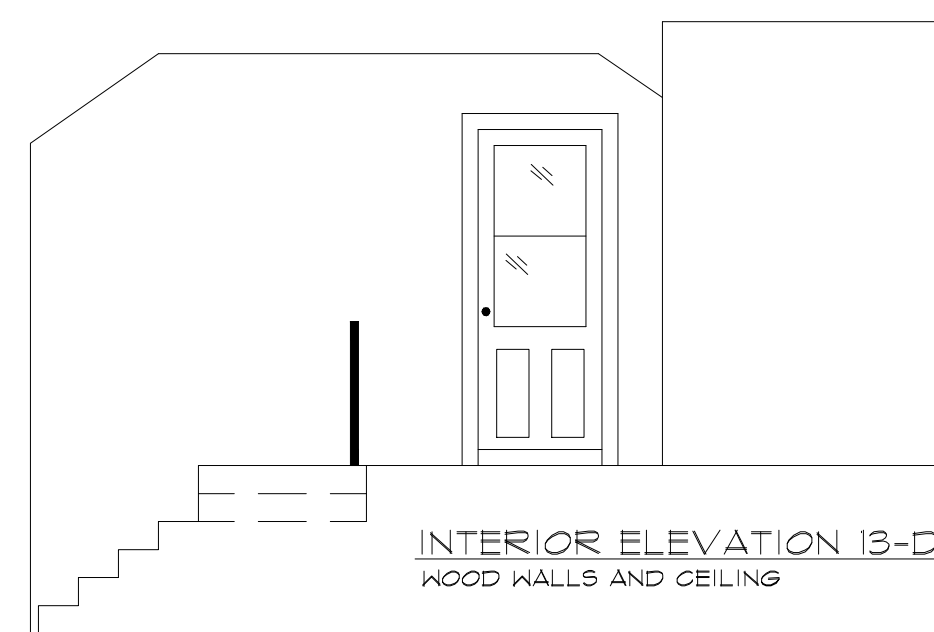


INTERIOR ELEVATION 13-D
WOOD WALLS AND CEILING

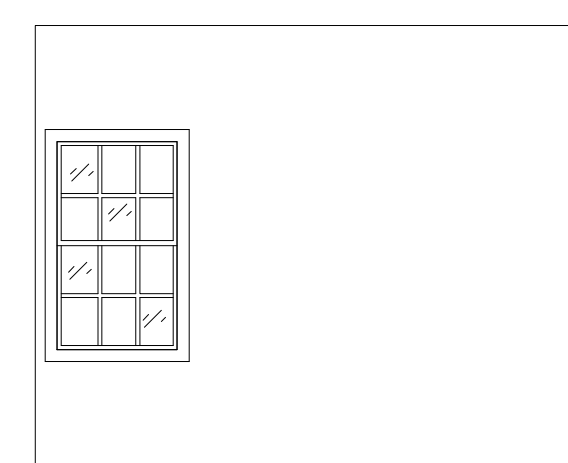


INTERIOR ELEVATION 14-A
WOOD WALLS AND CEILING

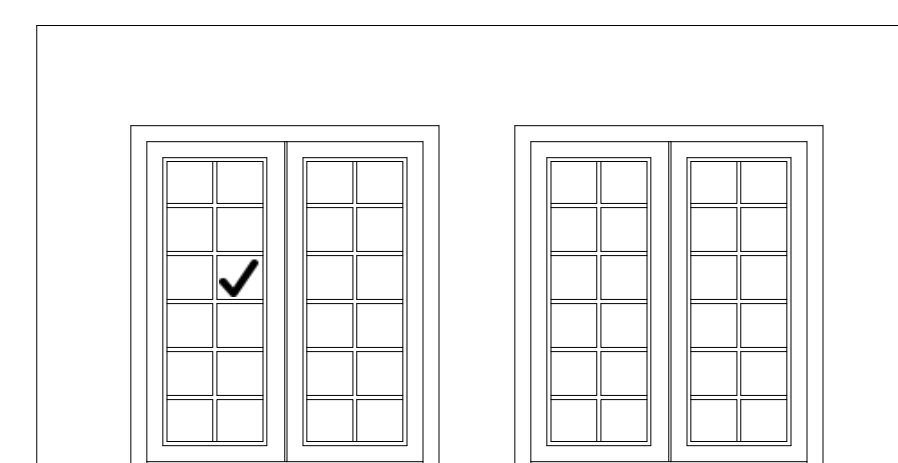

 
INTERIOR ELEVATION 14-B
WOOD WALLS AND CEILING



INTERIOR ELEVATION 15-A

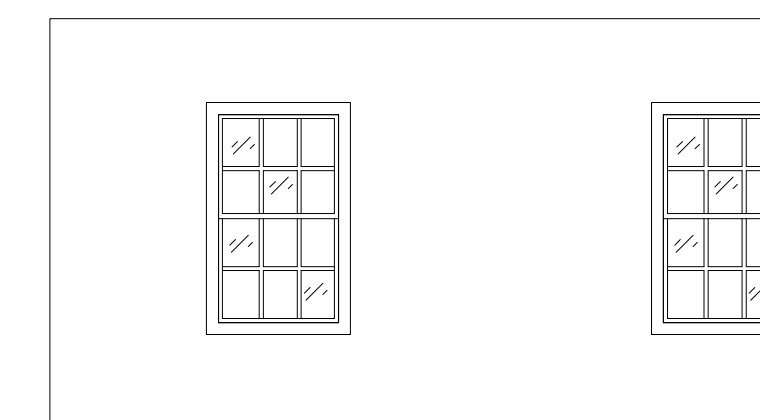

INTERIOR ELEVATION 15-C

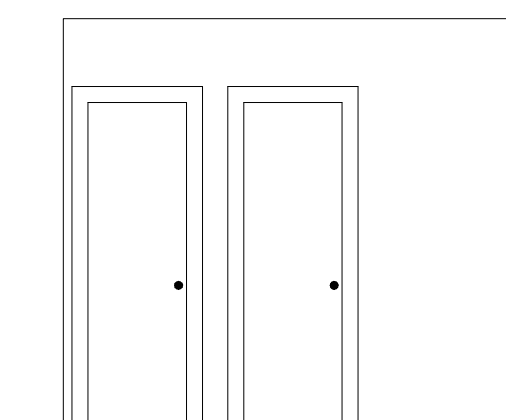

INTERIOR ELEVATION 15-D

AS BUILT
PROFESSIONALS

A DIVISION OF:

AEC

CONSULTANTS INC

www.aecconsultantsinc.com

844.272.8458

© 2011 AEC CONSULTANTS INC

ARCHITECTURAL AS BUILT
FOXFIRE FARM

MONKTON MARYLAND 21111

01 100% SUBMISSION

NO. ISSUES | REVISIONS DATE

SHEET TITLE

HL PROJECT MANAGER

HL PROJECT DIRECTOR

012317-1 PROJECT NUMBER

1/4"=1'-0" SCALE

CL DRAWN BY

SHEET NUMBER

AB-7