


CHICAGO, IL 60649



100% SUBMITTAL

DRAWING INDEX

C-1	COVER SHEET DRAWING INDEX
AB-1	FLOOR 1
AB-2	FLOOR 2-13
AB-3	FLOOR 14
AB-4	FLOOR 15
AB-5	FLOOR 16

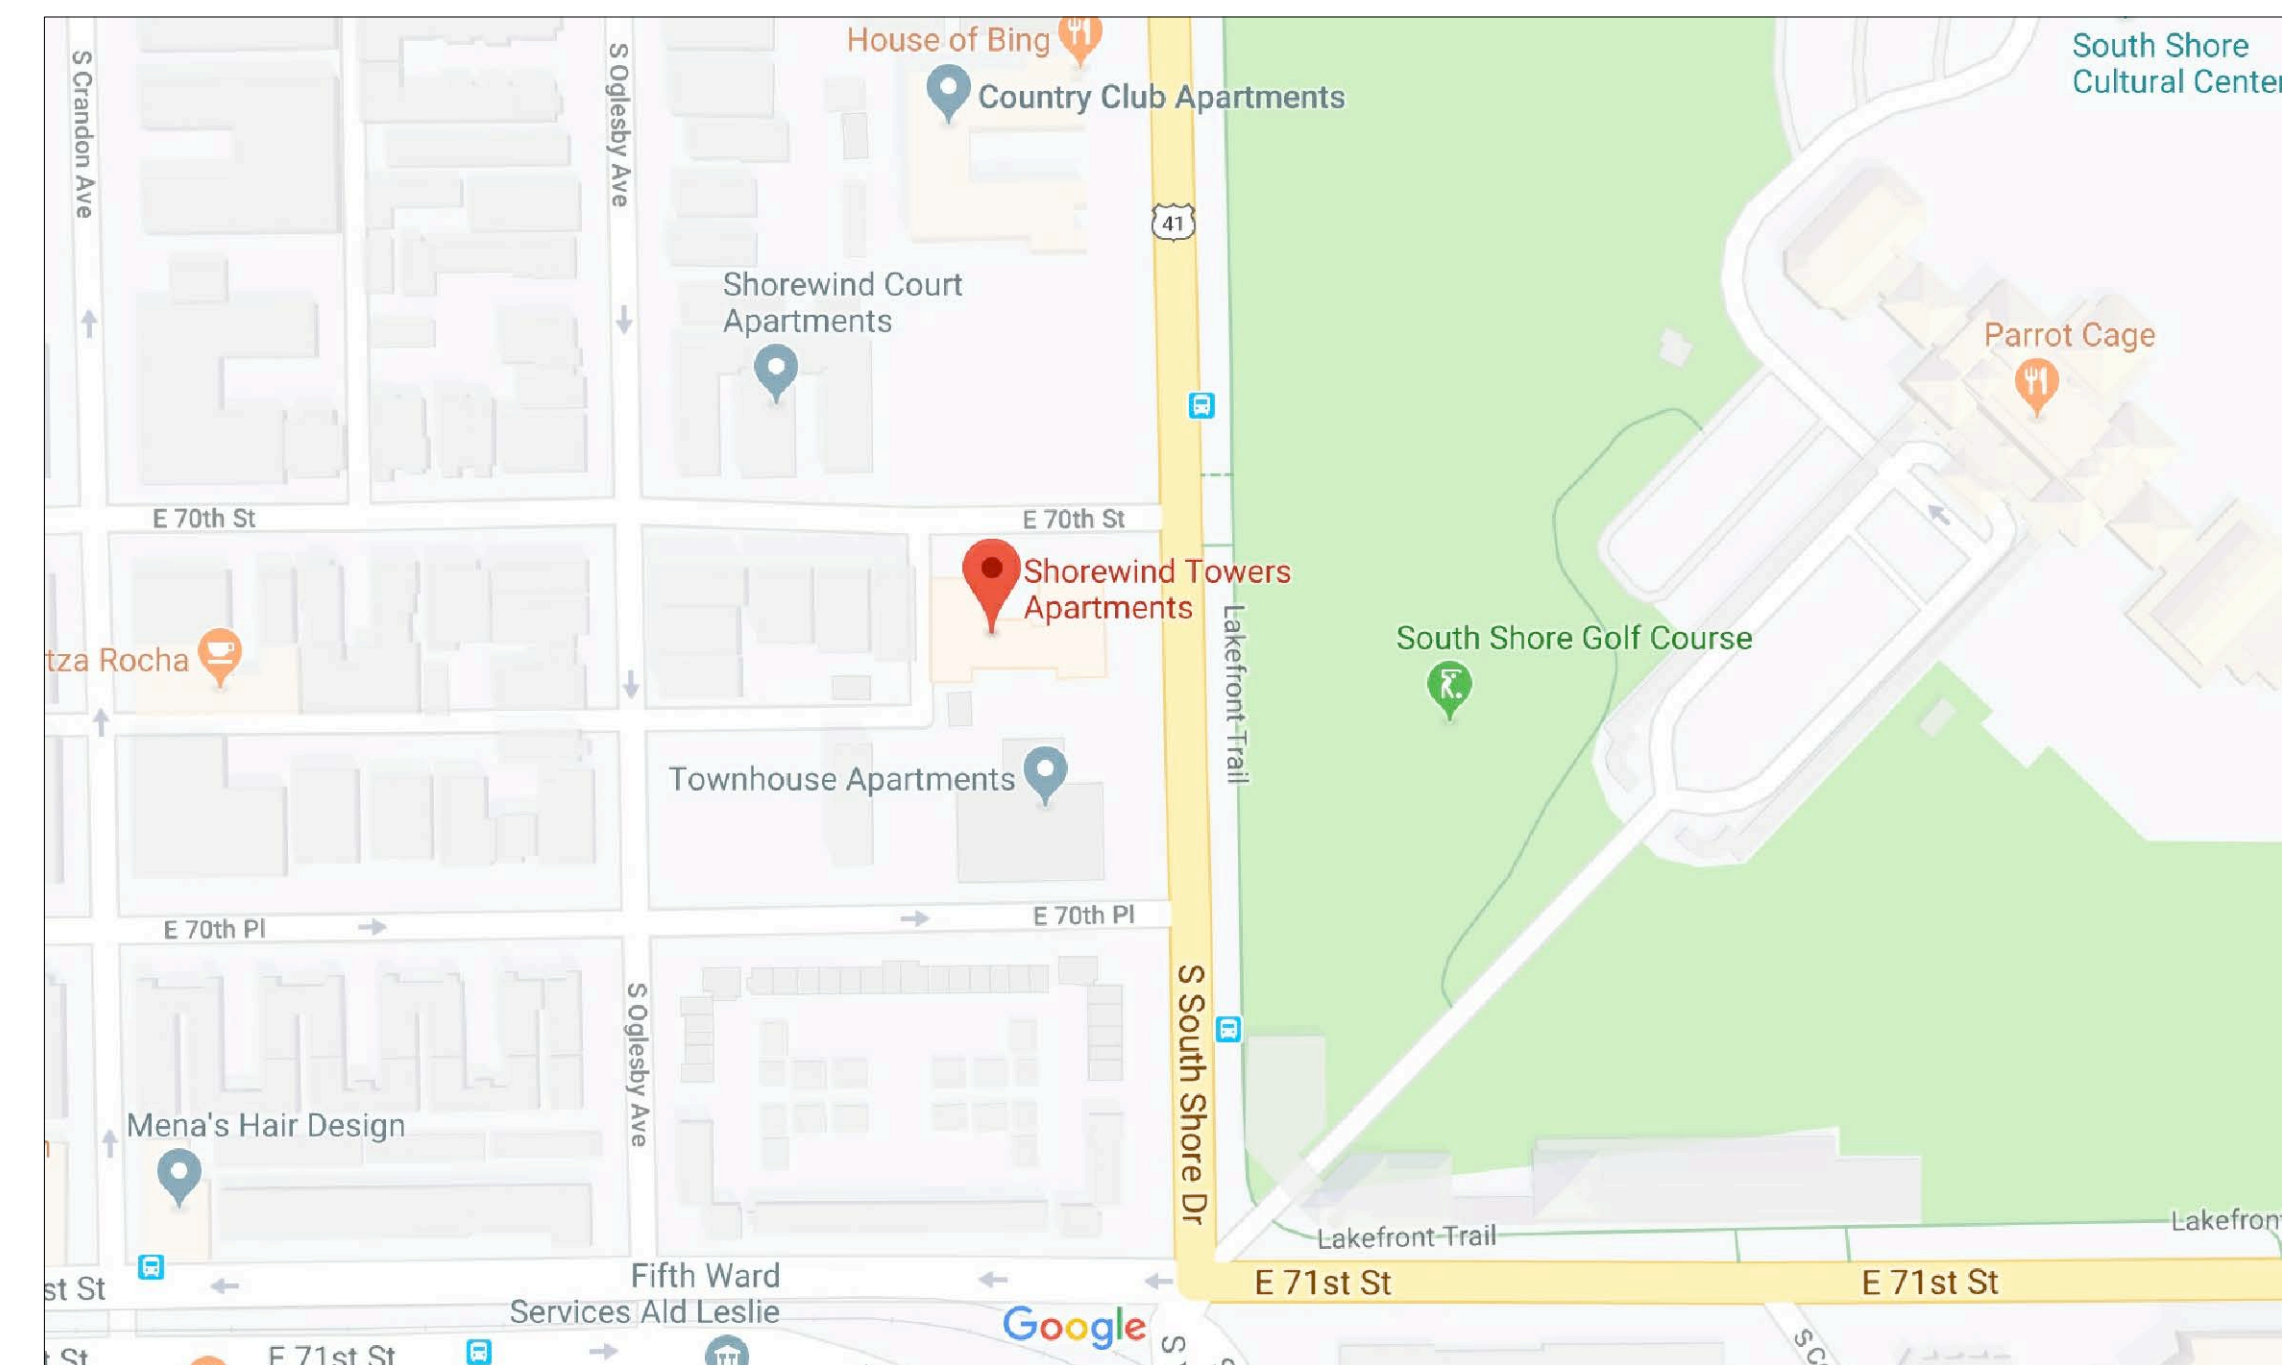

VICINITY MAP


<u>AREA DOCUMENTED</u>	
FLOOR 1	11774 S.F. :
FLOOR 2-13	11799 S.F. :
FLOOR 14	5498 S.F. :
FLOOR 15	7062 S.F. :
FLOOR 16	5895 S.F. :
GRAND TOTAL	42,028 S.F. :



**ARCHITECTURAL AS BUILT
SHOREWIND
CHICAGO 60649**

O1	100% SUBMISSION	SEE COVER SHEET
NO.	ISSUES REVISIONS	DATE
		SHEET TITLE
COVER SHEET		
HL		PROJECT MANAGER
HL		PROJECT DIRECTOR
012317-1		PROJECT NUMBER
		SCALE
CL		DRAWN BY
		SHEET NUMBER

C-1

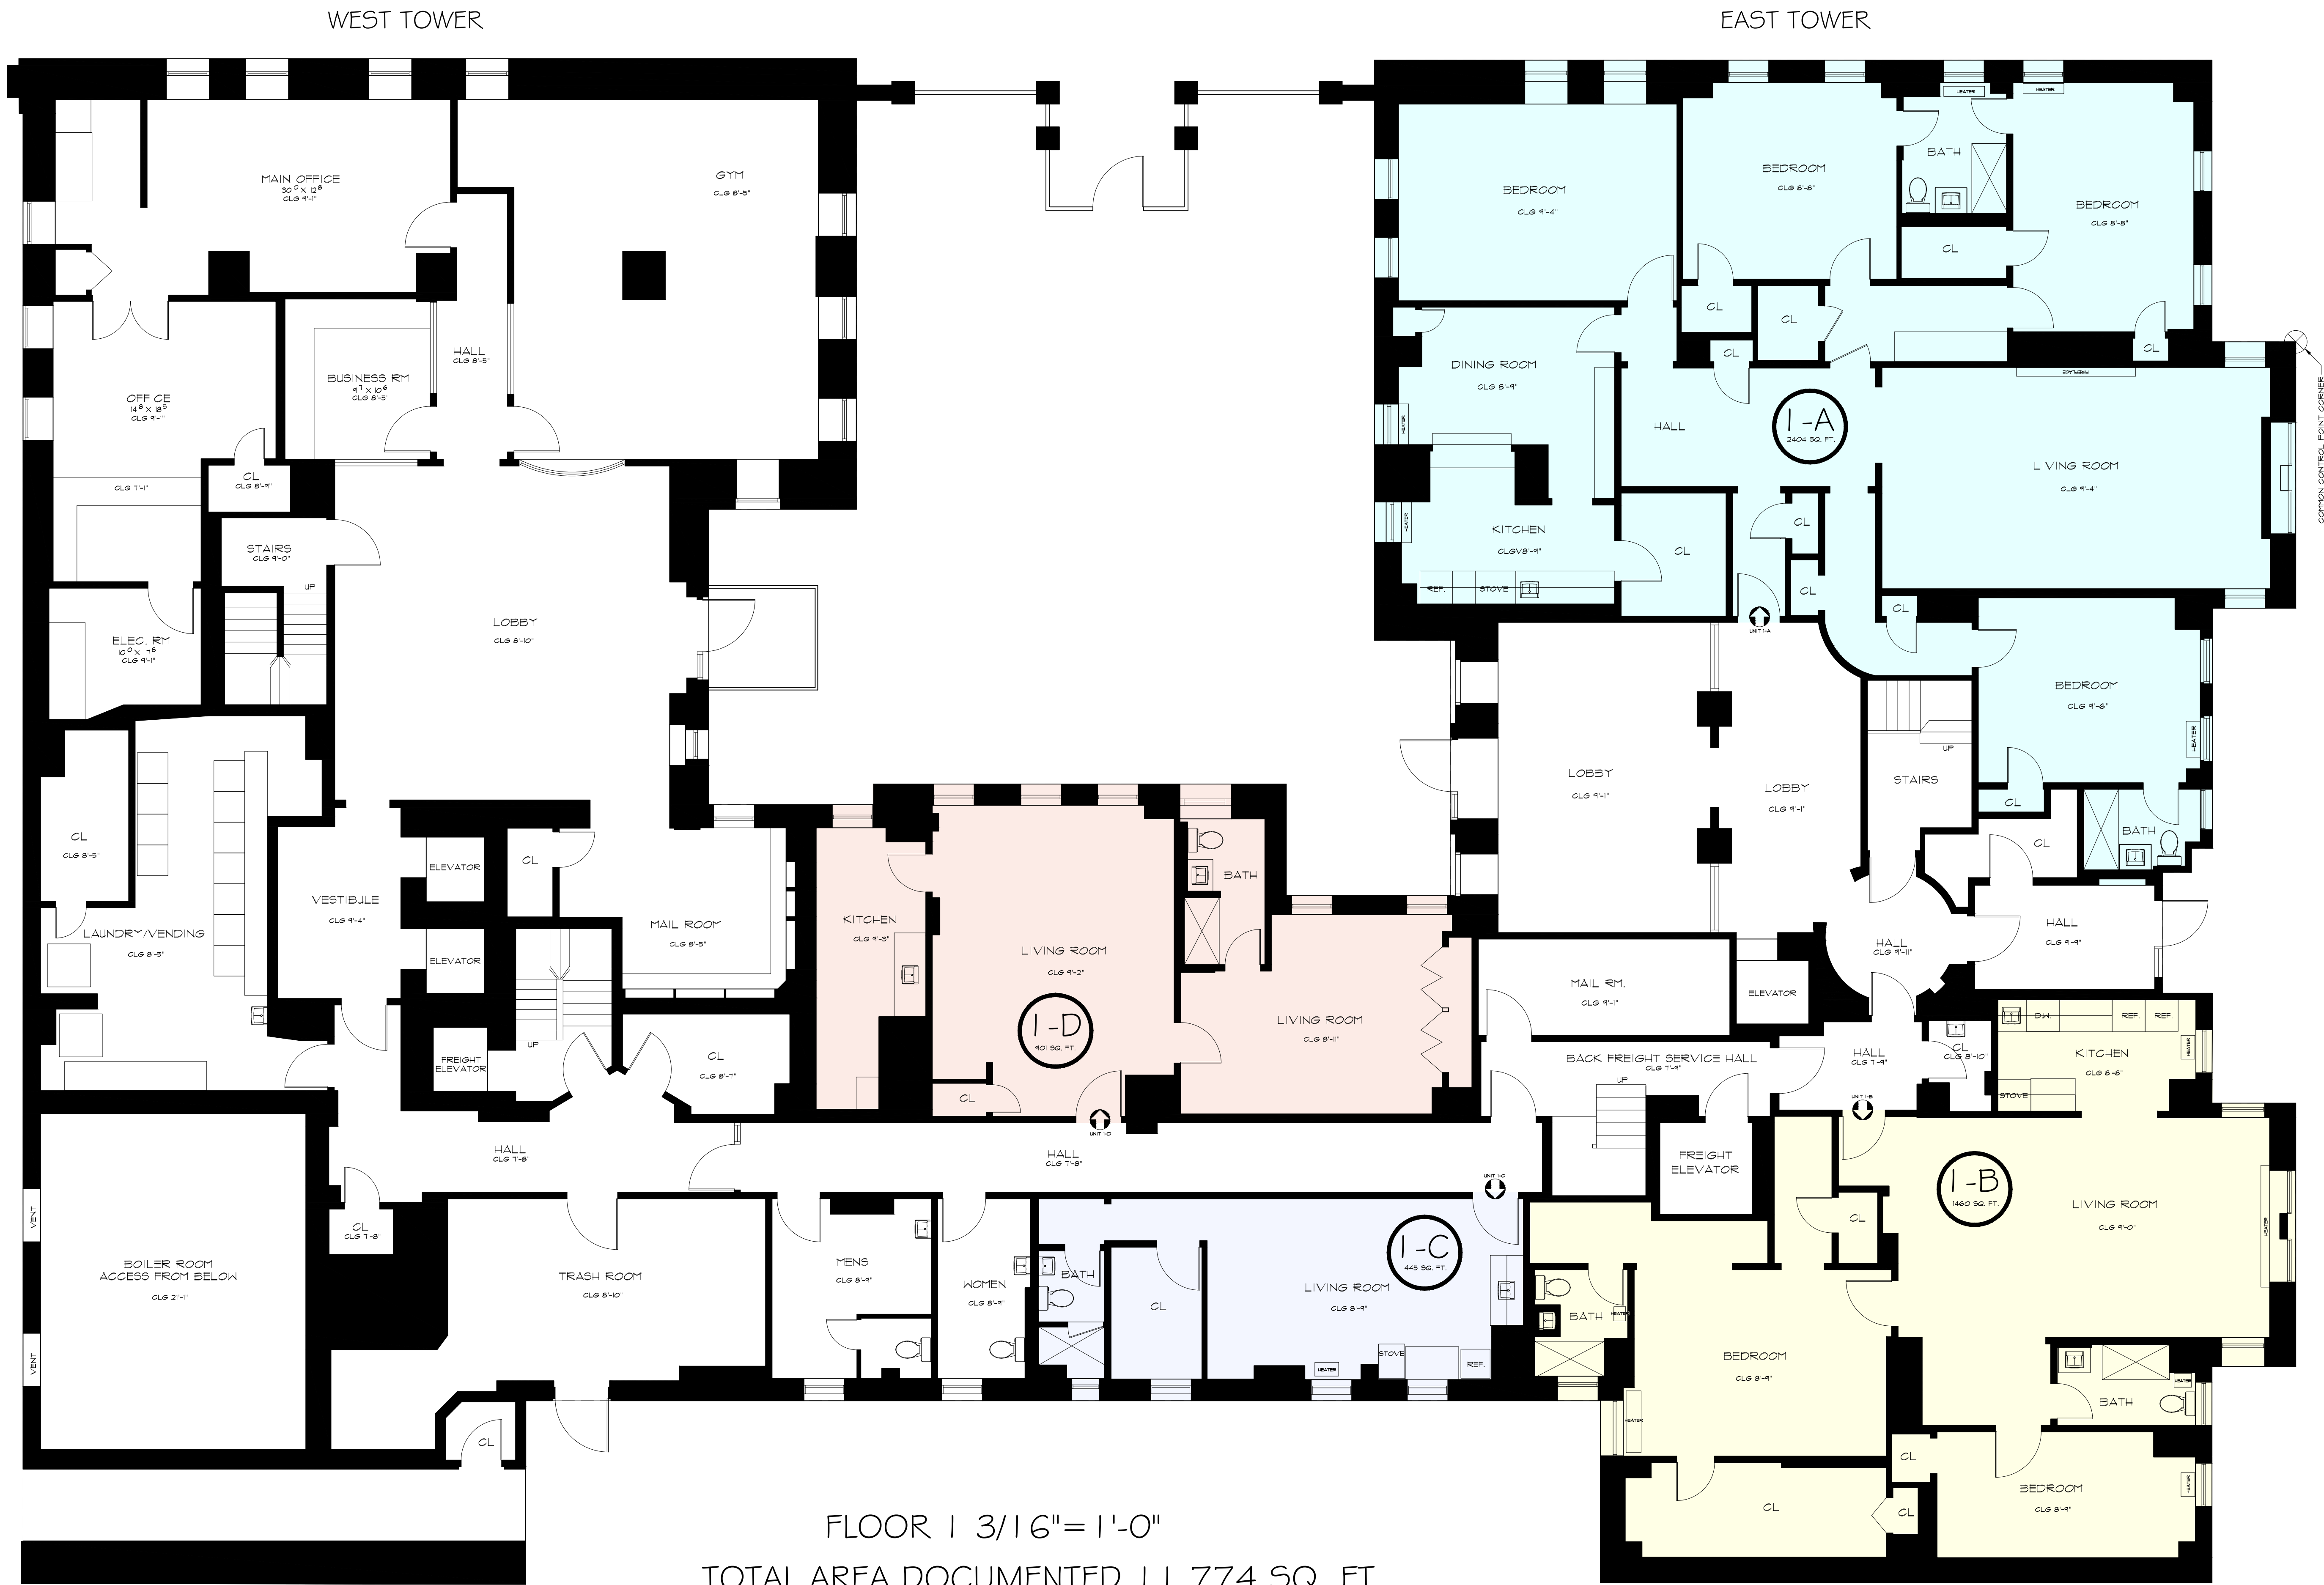

FLOOR 1 3/16"=1'-0"
TOTAL AREA DOCUMENTED 11,774 SQ. FT.

UNIT AREAS			
1-A	1-B	1-C	1-D
2404 SQ. FT.	1460 SQ. FT.	445 SQ. FT.	101 SQ. FT.

As BUILT

PROFESSIONALS

www.asbuiltprofessionals.com

A DIVISION OF:

AEC

CONSULTANTS INC

844.272.8458


844 AS BUILT

© 2020 AEC CONSULTANTS INC

ARCHITECTURAL AS BUILT
SHOREWIND
CHICAGO 60649

01	100% SUBMISSION	SEE COVER SHEET
NO.	ISSUES REVISIONS	DATE
		SHEET TITLE
FLOOR 1		
HL	PROJECT MANAGER	
HL	PROJECT DIRECTOR	
012317-1	PROJECT NUMBER	
3/16"=1'-0"	SCALE	
CL	DRAWN BY	
		SHEET NUMBER

AB-1

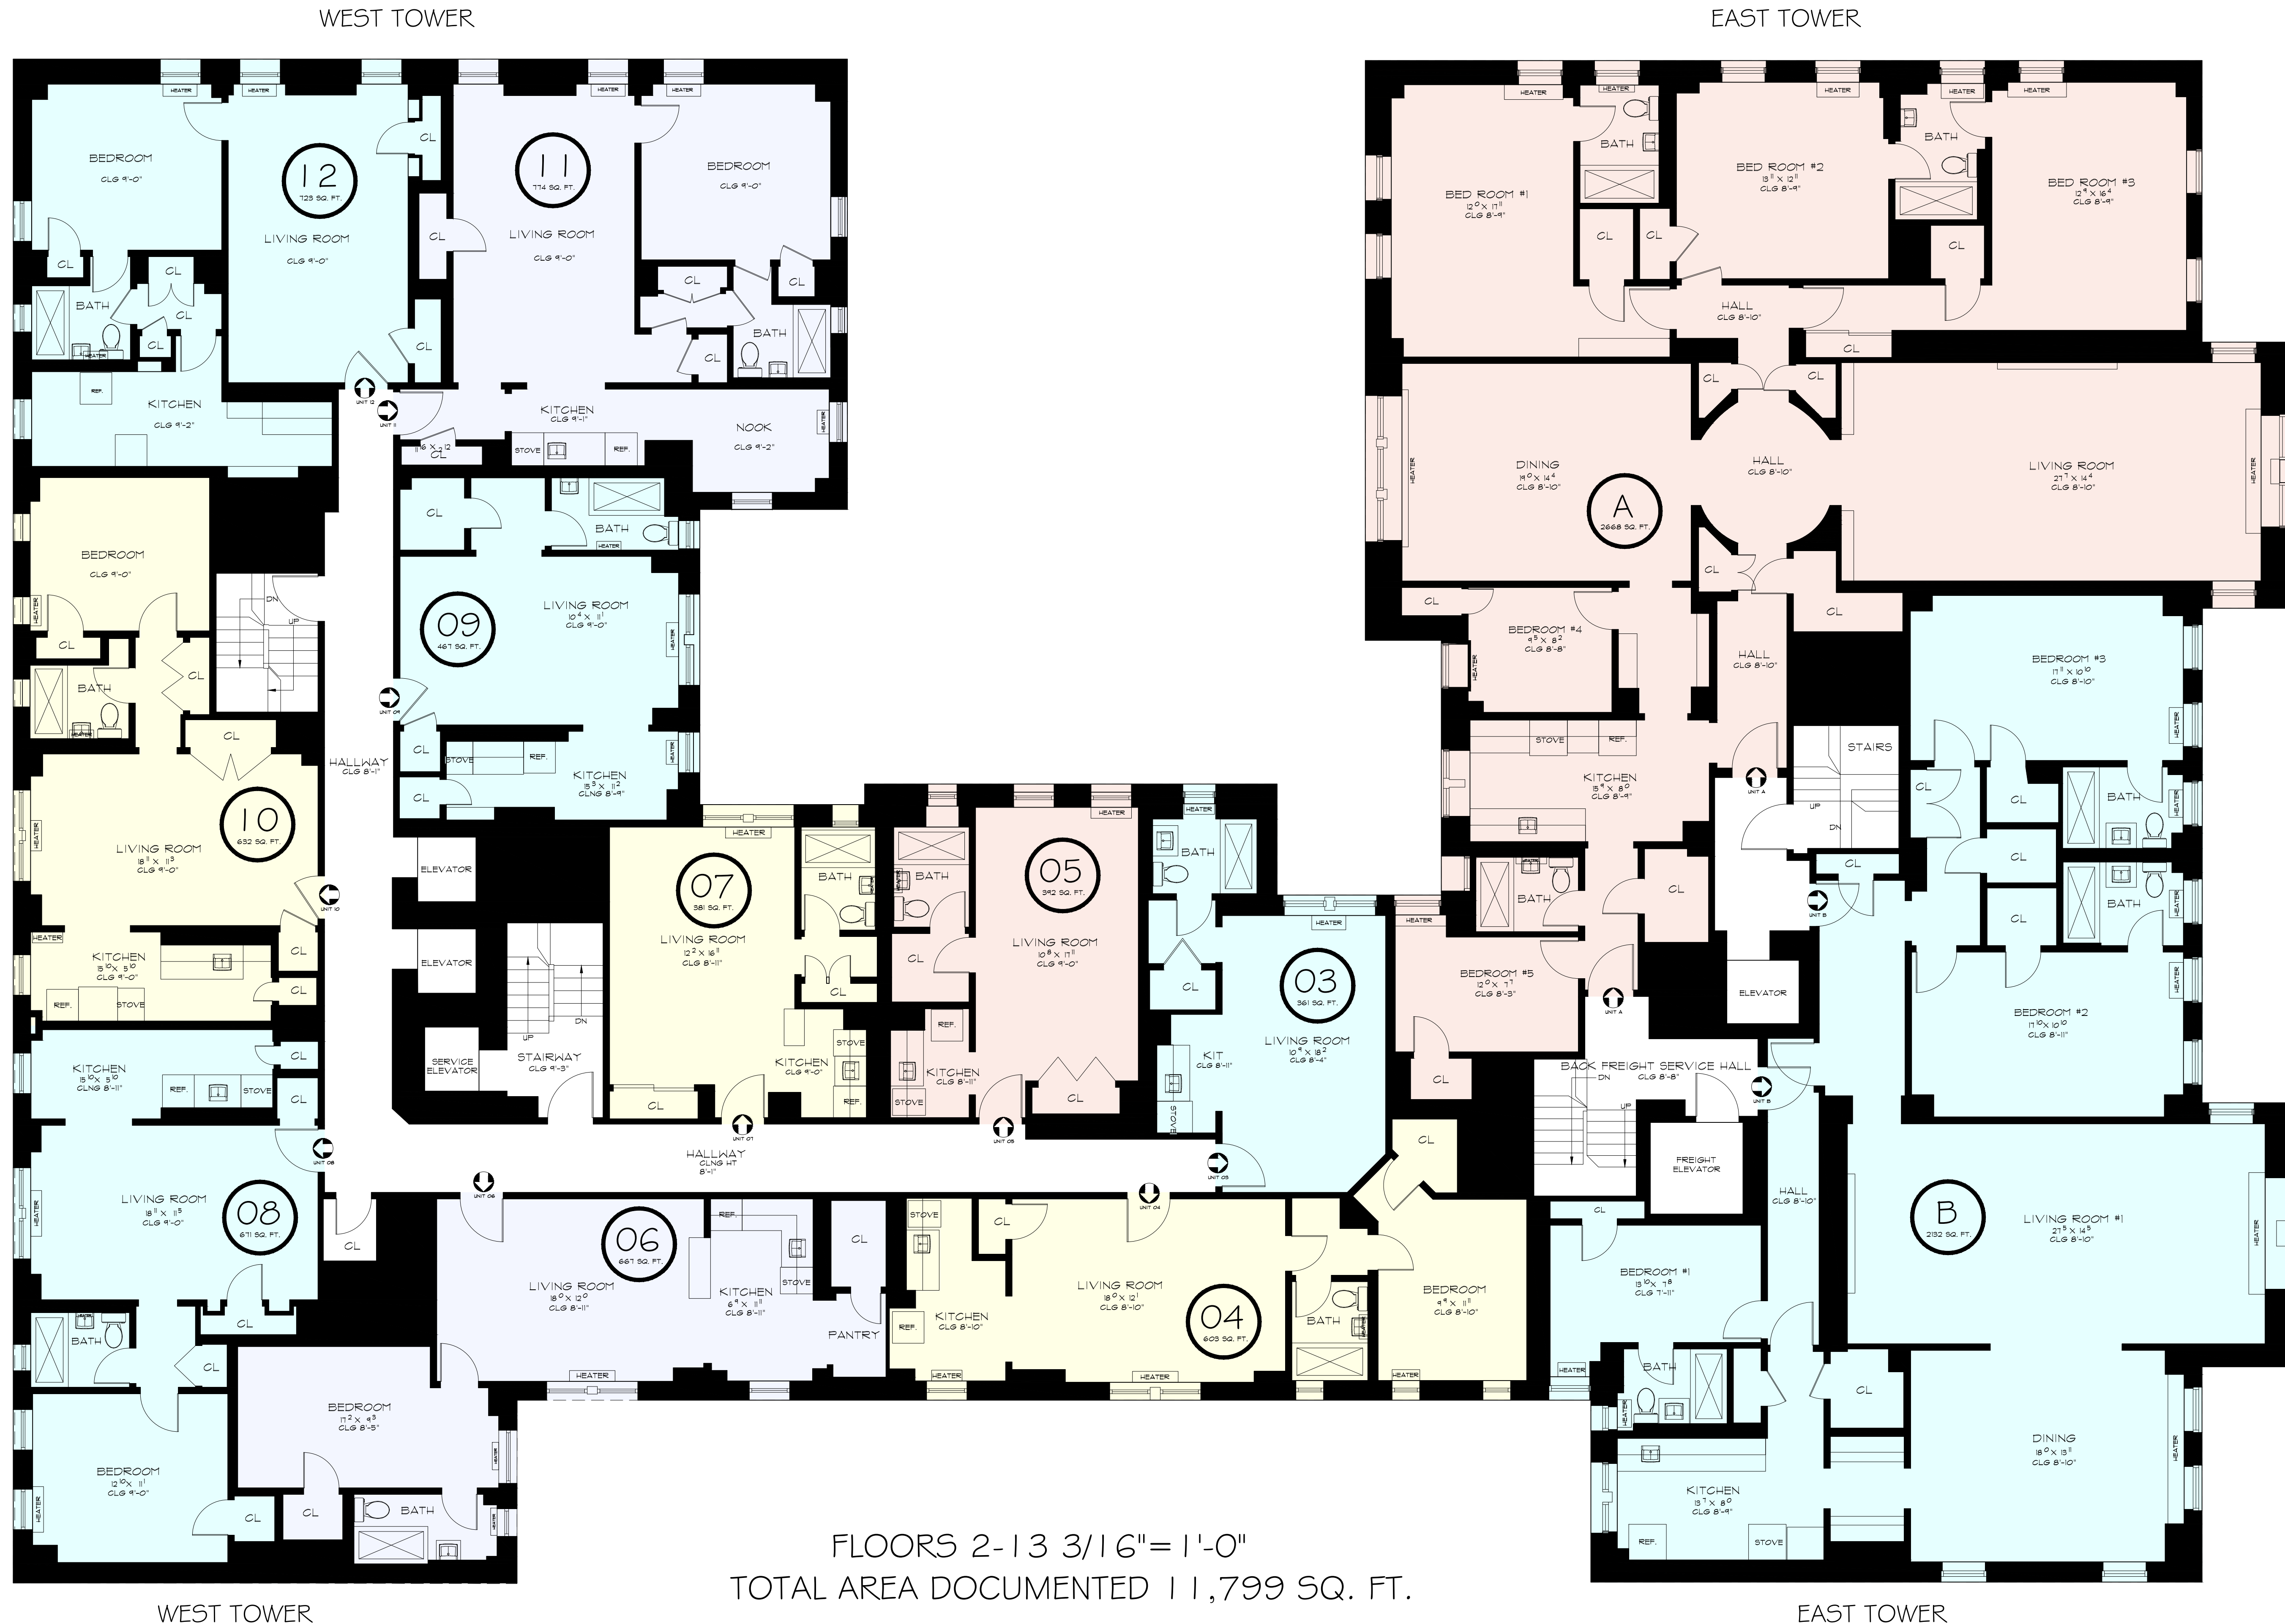


AS BUILT PROFESSIONALS
 www.asbuiltprofessionals.com
 A DIVISION OF:
AEC CONSULTANTS INC
 844.272.8458
 844 AS BUILT
 © 2020 AEC CONSULTANTS INC

**ARCHITECTURAL AS BUILT
 SHOREWIND
 CHICAGO 60649**

01	100% SUBMISSION	SEE COVER SHEET
NO.	ISSUES REVISIONS	DATE
SHEET TITLE		
FLOORS 2-13		
HL	PROJECT MANAGER	
HL	PROJECT DIRECTOR	
012317-1	PROJECT NUMBER	
3/16"=1'-0"	SCALE	
CL	DRAWN BY	
SHEET NUMBER		

AB-2

WEST TOWER

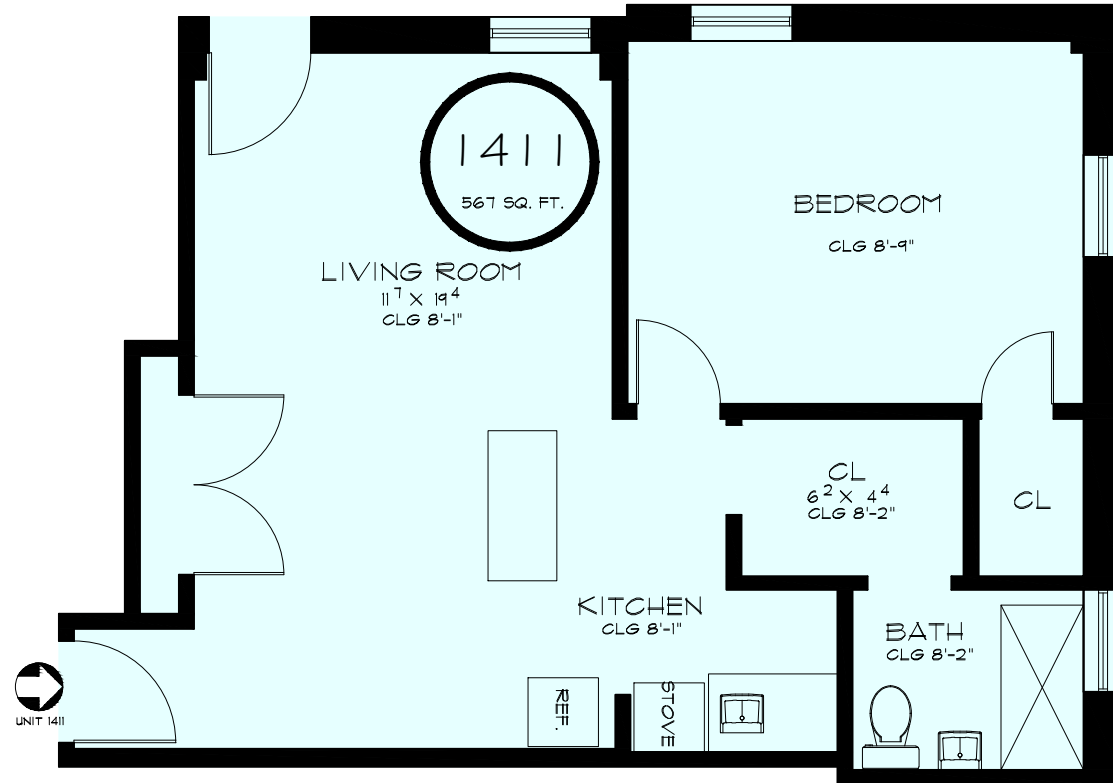


WEST TOWER

FLOOR 14 3/16"=1'-0"
TOTAL AREA DOCUMENTED 5,498 SQ. FT.

UNIT AREAS		
A	B	1411
2564 SQ. FT.	2130 SQ. FT.	561 SQ. FT.

EAST TOWER

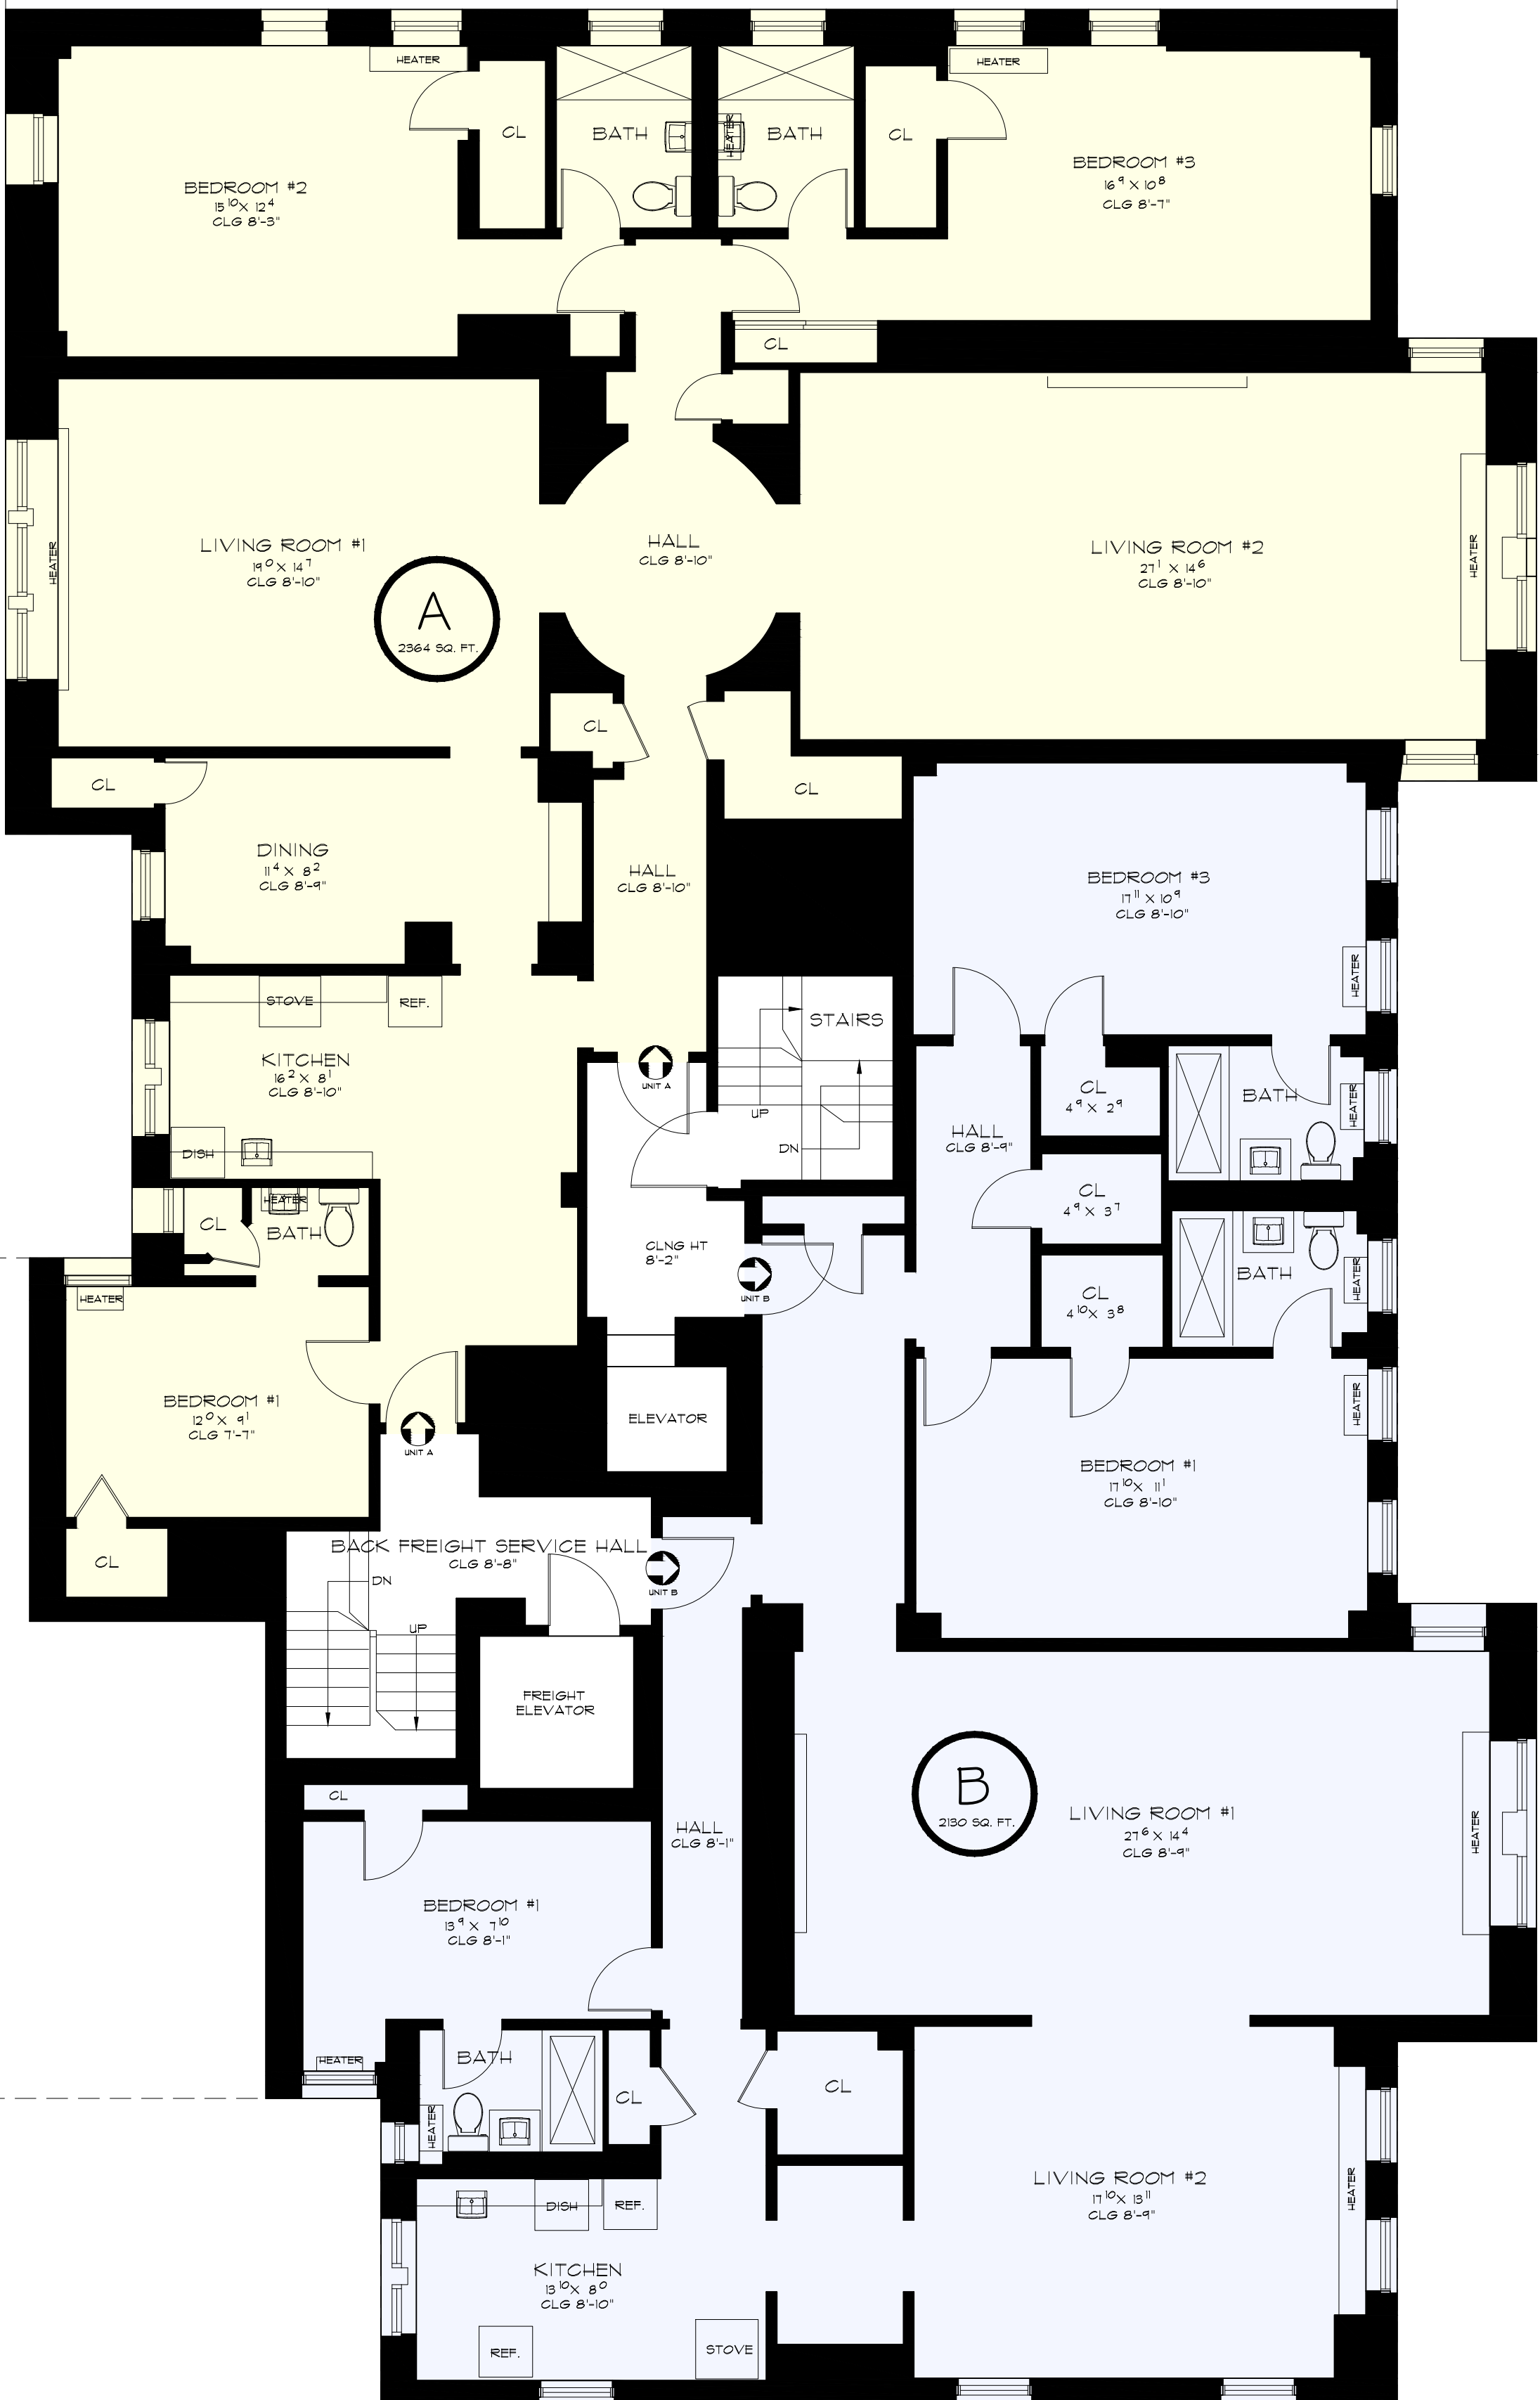

EAST TOWER

As BUILT

PROFESSIONALS

www.asbuiltprofessionals.com

A DIVISION OF:

AEC

CONSULTANTS INC

844.272.8458

844 AS BUILT

© 2020 AEC CONSULTANTS INC




ARCHITECTURAL AS BUILT
SHOREWIND
CHICAGO 60649

01	100% SUBMISSION	SEE COVER SHEET
NO.	ISSUES REVISIONS	DATE
		SHEET TITLE
FLOOR 14		
HL	PROJECT MANAGER	
HL	PROJECT DIRECTOR	
012317-1	PROJECT NUMBER	
3/16"=1'-0"	SCALE	
CL	DRAWN BY	
		SHEET NUMBER

AB-3

WEST TOWER

EAST TOWER

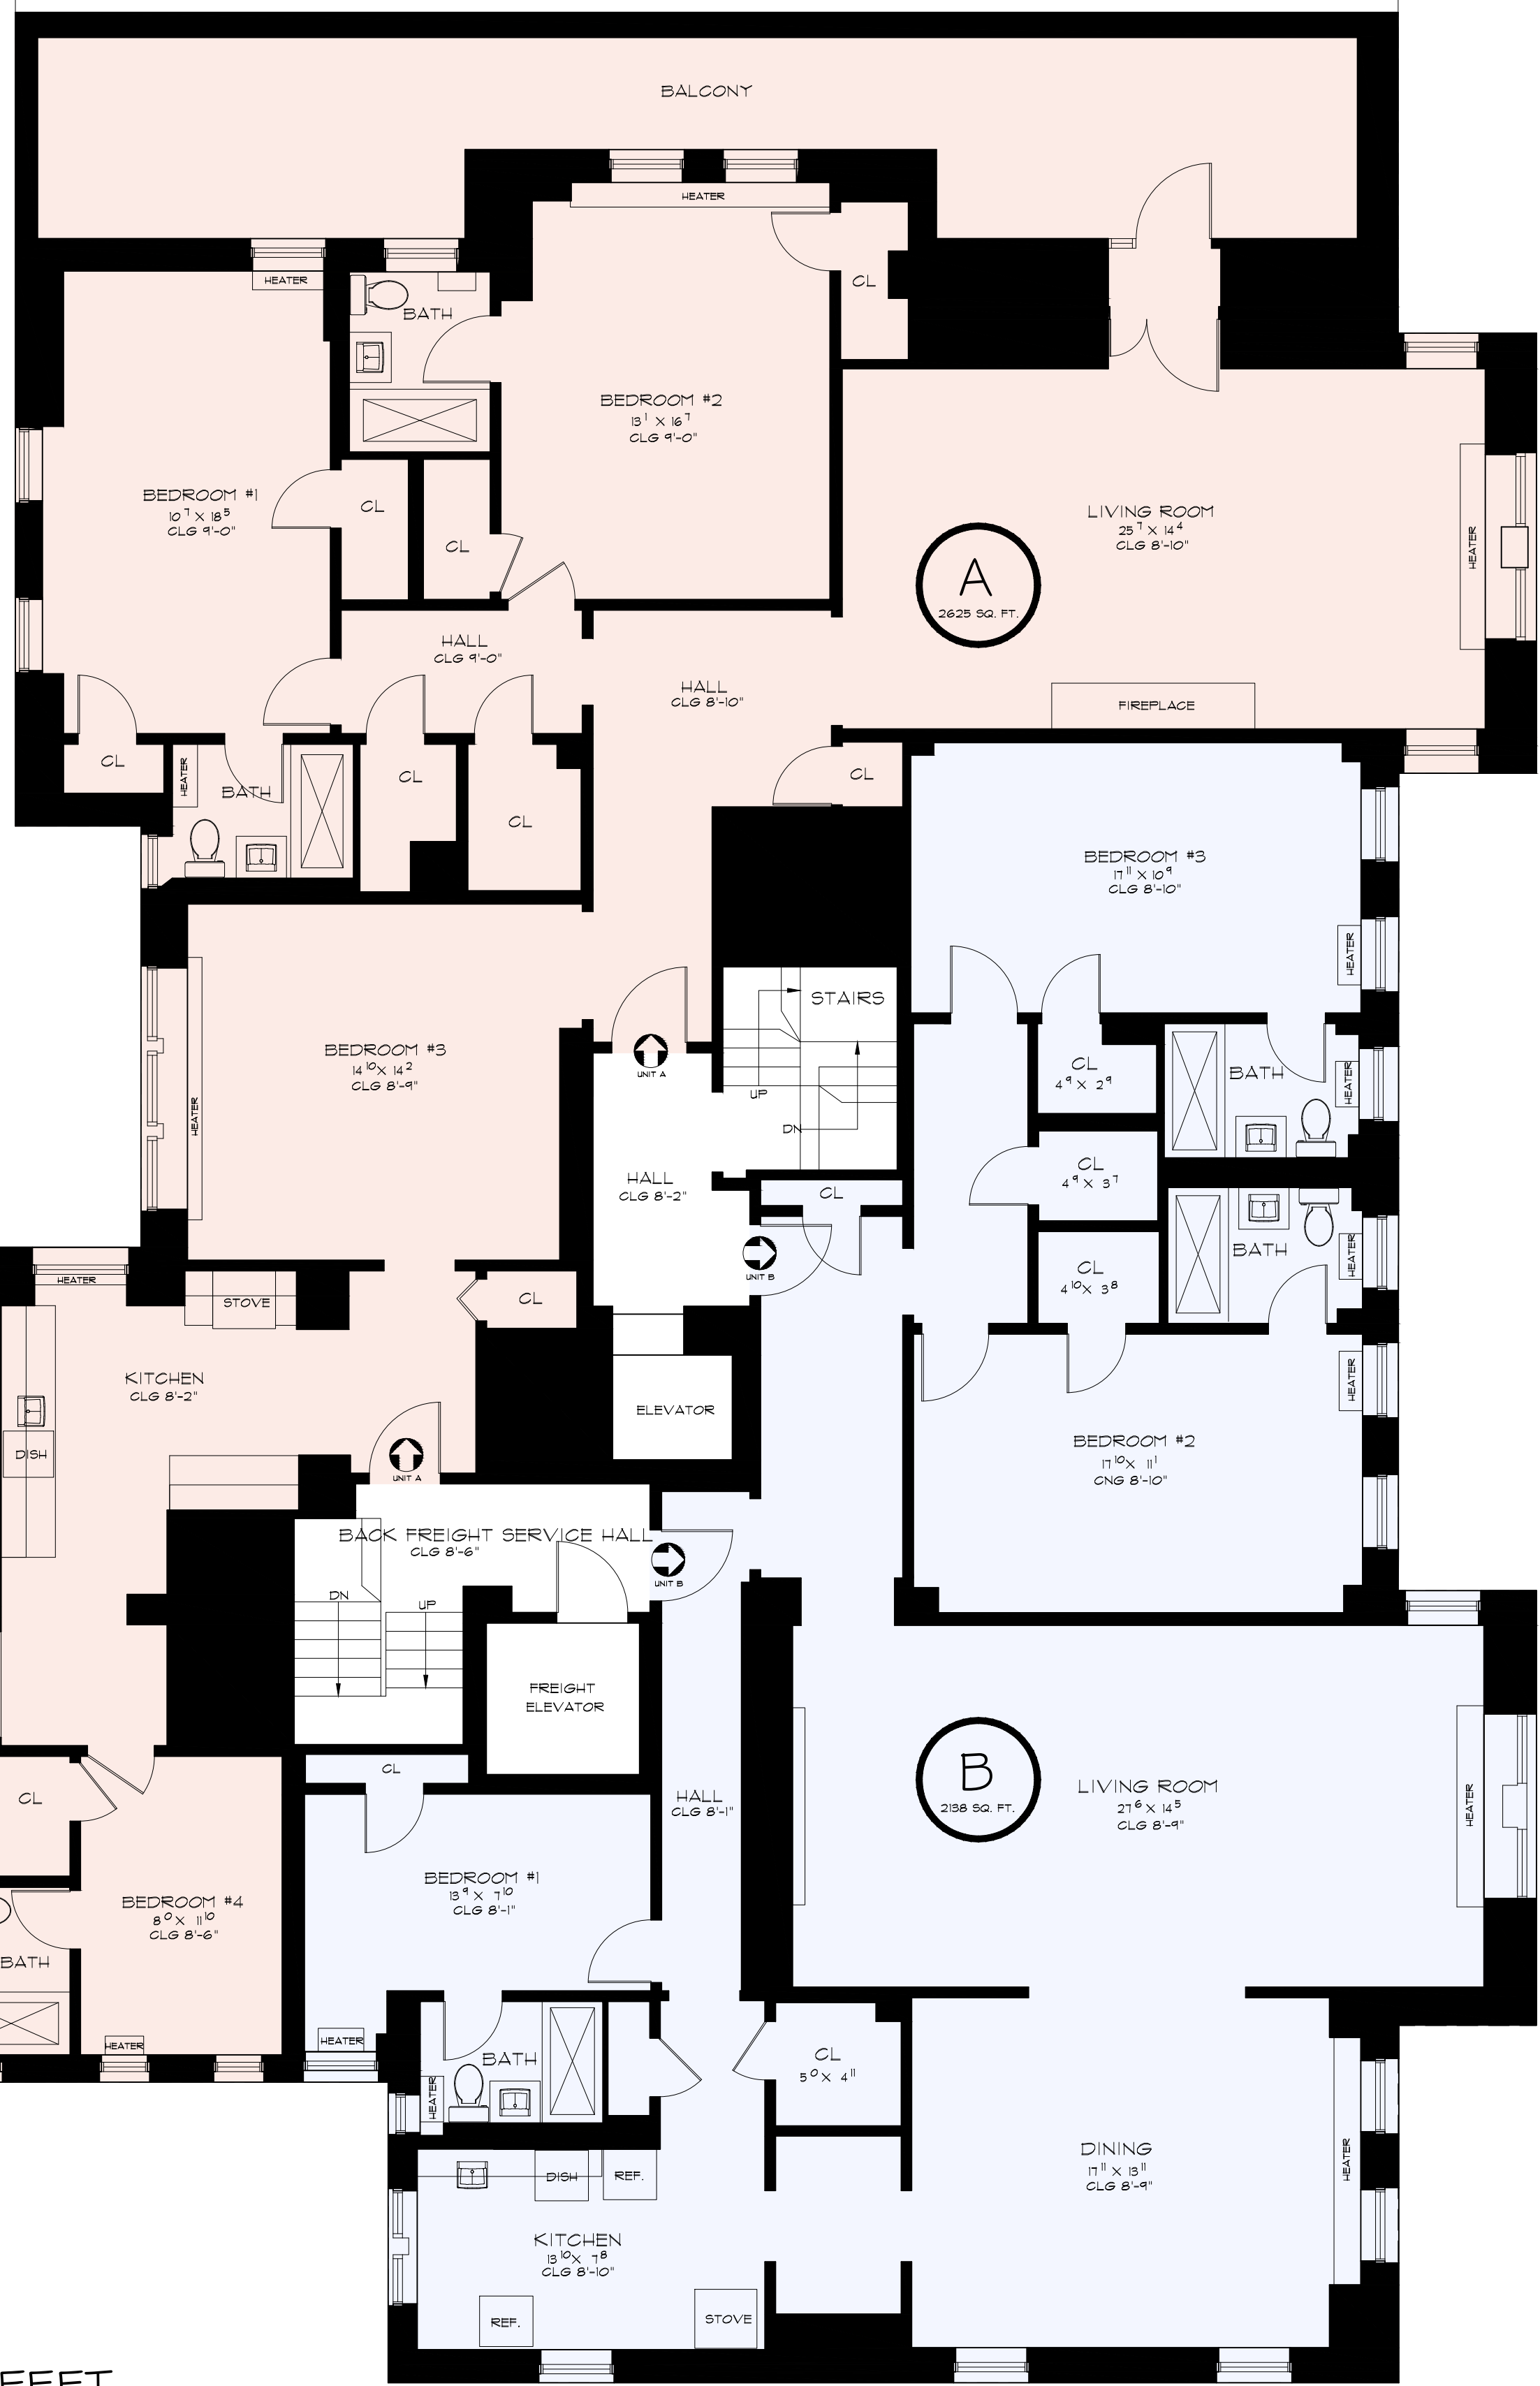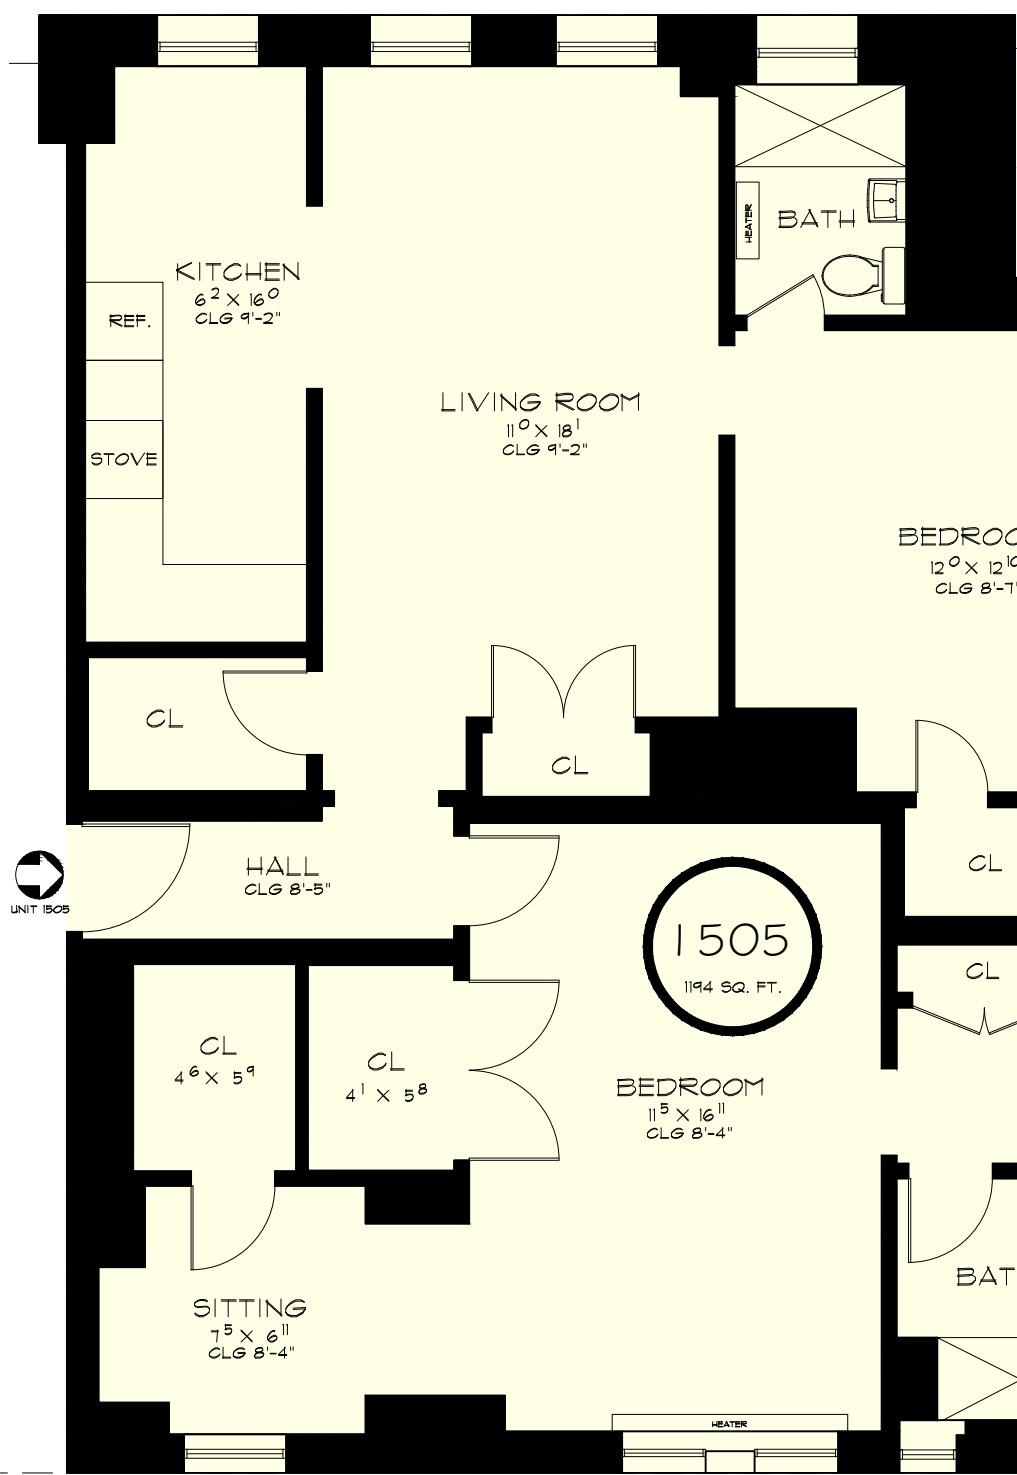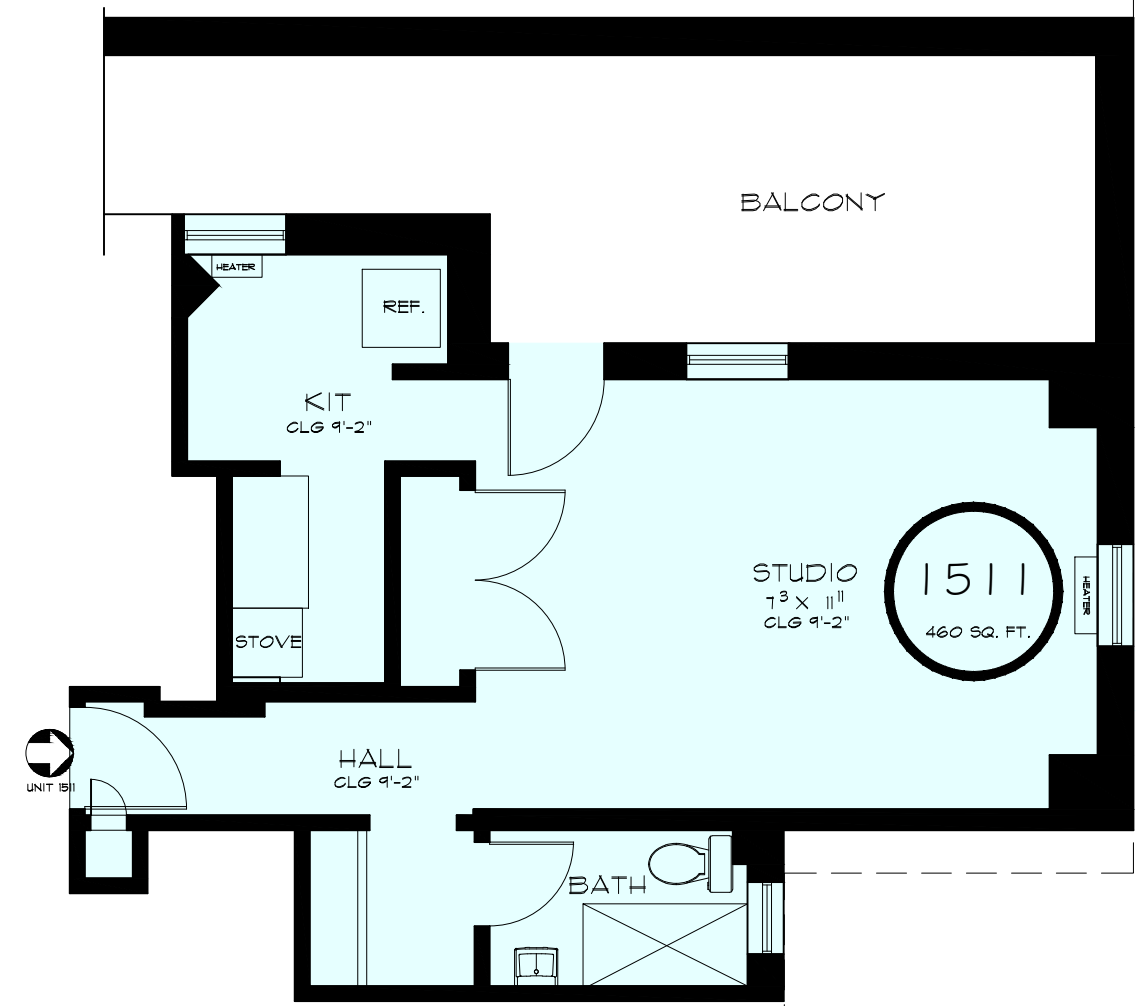

FLOOR 15 3/16"=1'-0"
TOTAL AREA DOCUMENTED 7,062 SQ. FEET

UNIT AREAS			
A	B	1505	1511
2625 SQ. FT.	2198 SQ. FT.	1194 SQ. FT.	460 SQ. FT.

WEST TOWER

EAST TOWER



ARCHITECTURAL AS BUILT SHOREWIND CHICAGO 60649


01	100% SUBMISSION	SEE COVER SHEET
NO.	ISSUES REVISIONS	DATE

FLOOR 15

HL	PROJECT MANAGER
HL	PROJECT DIRECTOR
012317-1	PROJECT NUMBER
3/16"=1'-0"	SCALE
CL	DRAWN BY
	SHEET NUMBER

AB-4

EAST TOWER

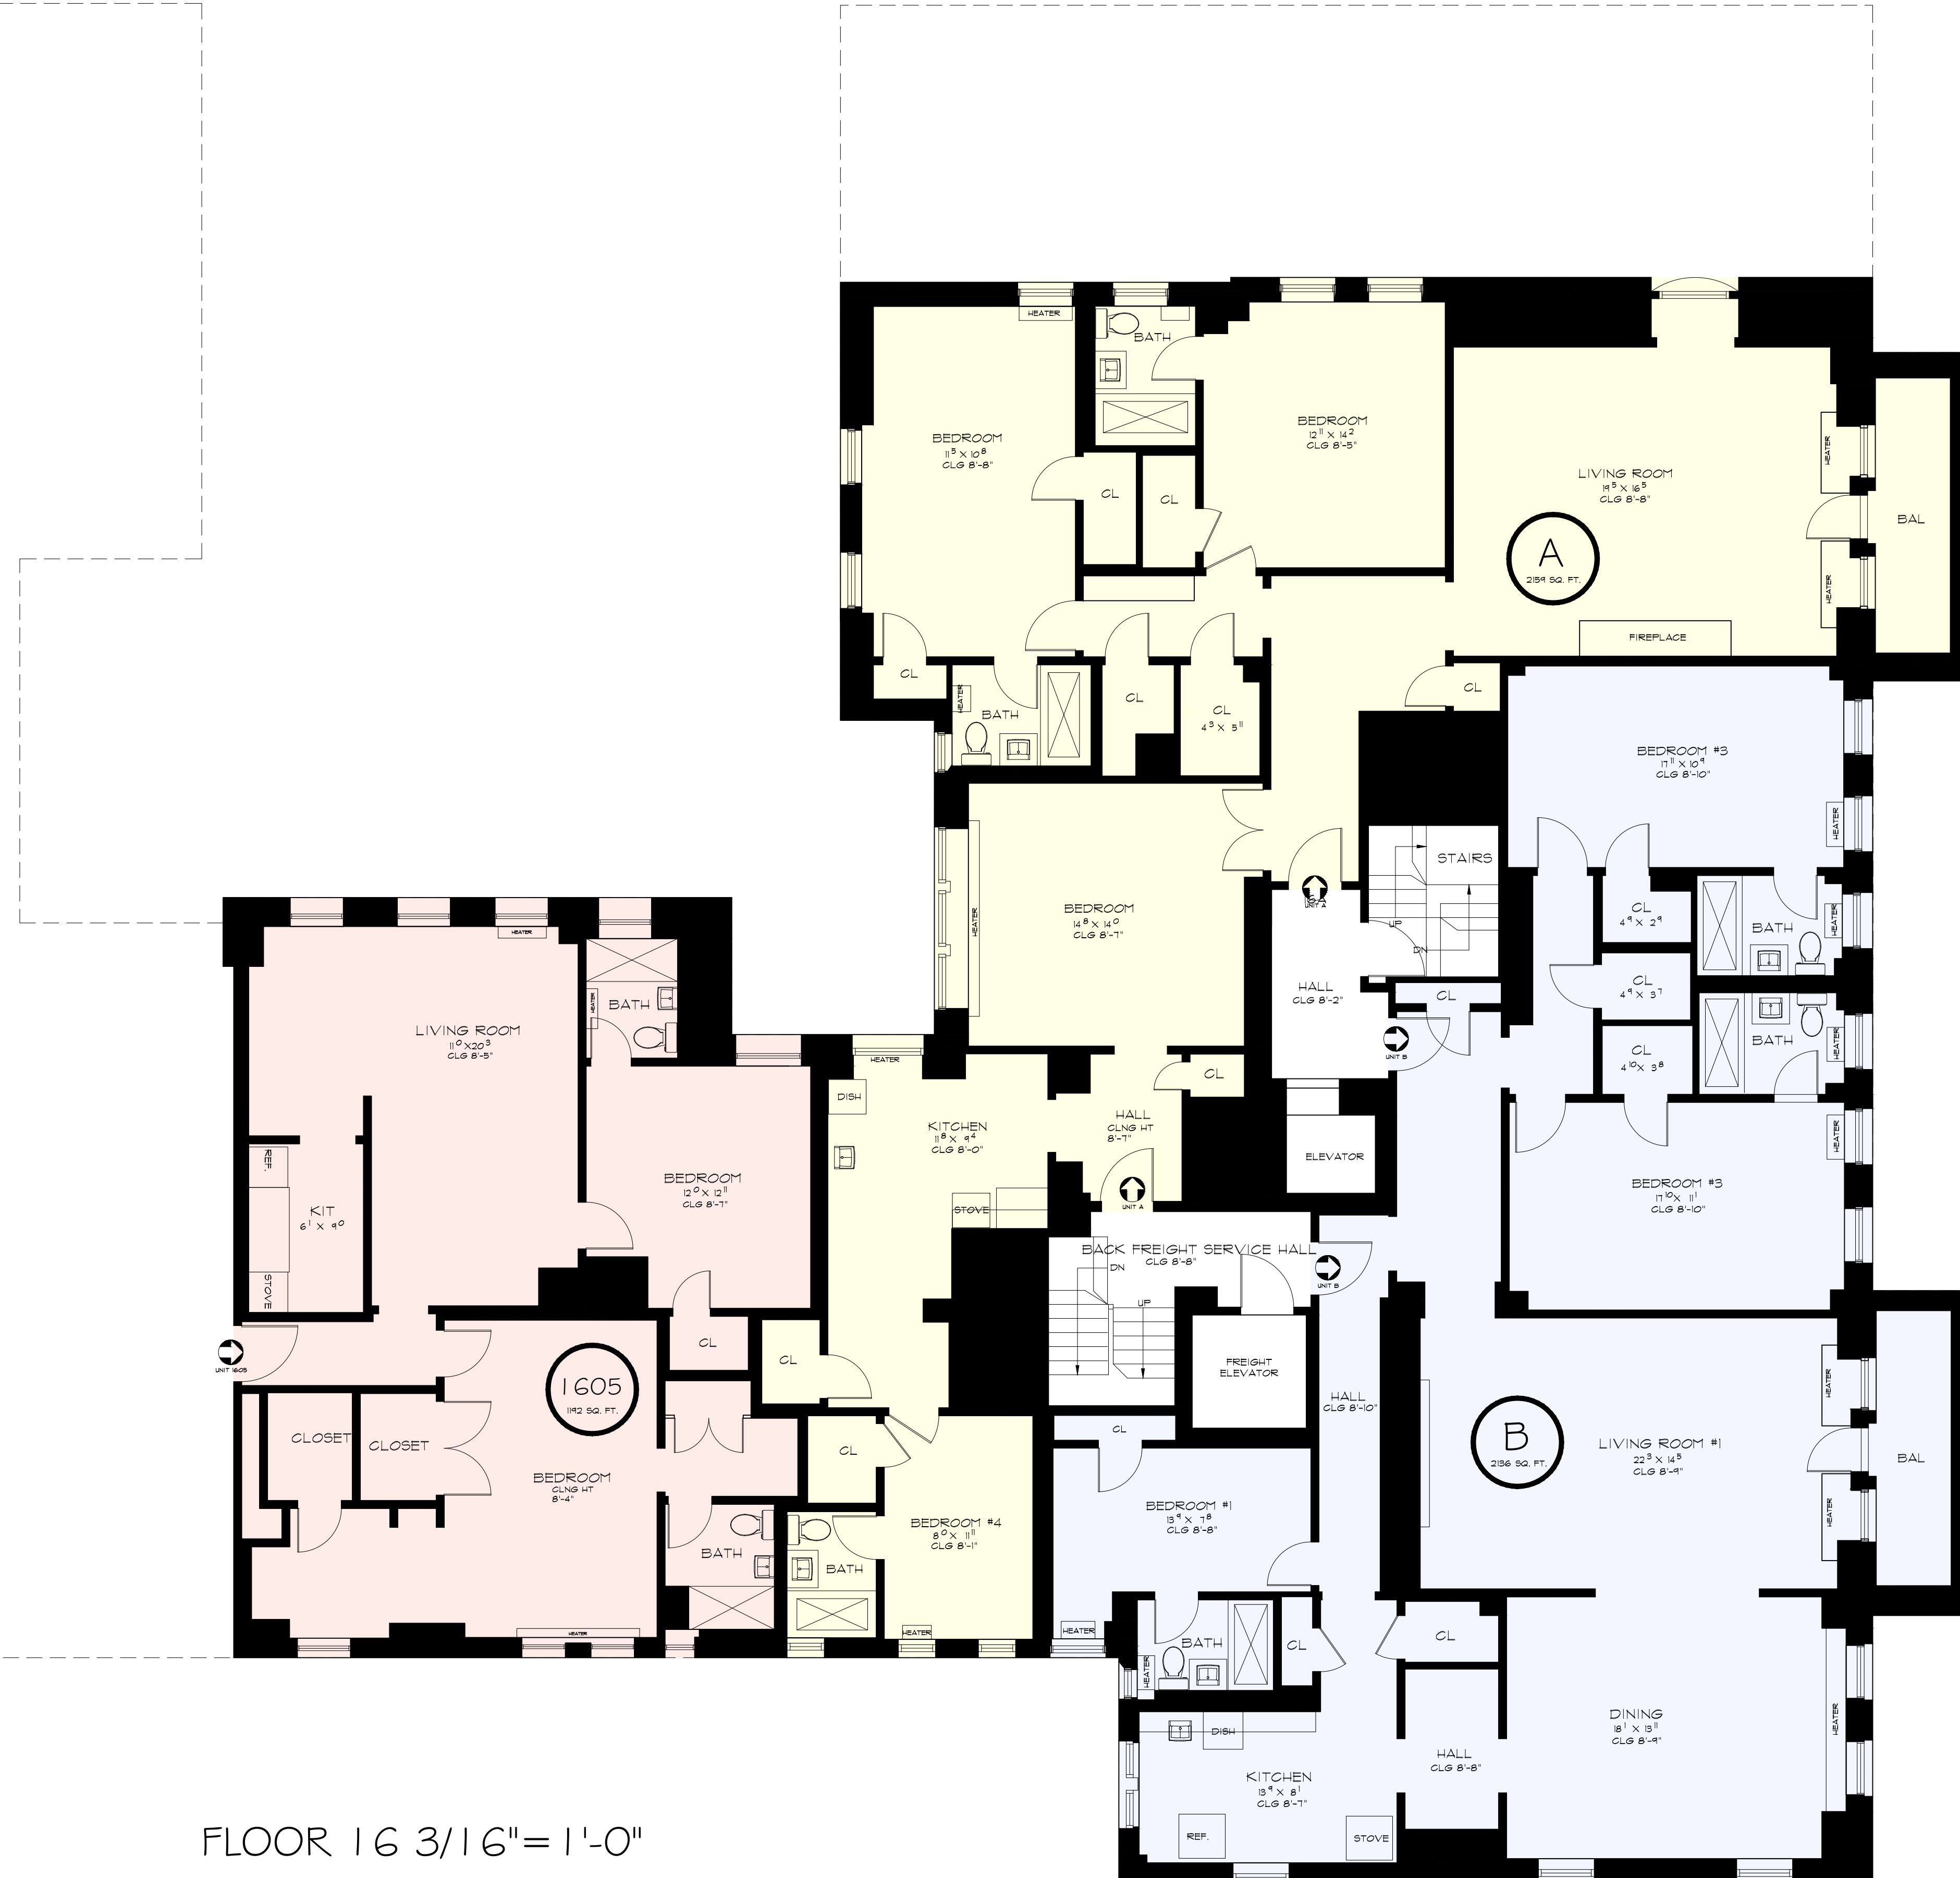

EAST TOWER

FLOOR 16 3/16"=1'-0"
TOTAL AREA DOCUMENTED 5,895 SQ. FT.

UNIT AREAS		
A	B	1605
2154 SQ. FT.	2196 SQ. FT.	1912 SQ. FT.



**ARCHITECTURAL AS BUILT
SHOREWIND
CHICAGO 60649**

01	100% SUBMISSION	SEE COVER SHEET
NO.	ISSUES REVISIONS	DATE
		SHEET TITLE
FLOOR 16		
HL	PROJECT MANAGER	
HL	PROJECT DIRECTOR	
012317-1		PROJECT NUMBER
3/16"=1'-0"		SCALE
CL	DRAWN BY	
		SHEET NUMBER

AB-5