

AS-BUILT DOCUMENTATION


MERCER ISLAND, WA 98040



100% SUBMITTAL

DRAWING INDEX

- C-1 COVER SHEET | DRAWING INDEX
- AB-1 FIRST FLOOR PLAN AND RCP
- AB-2 SECOND FLOOR PLAN AND RCP
- AB-3 DOOR & WINDOW SCHEDULES

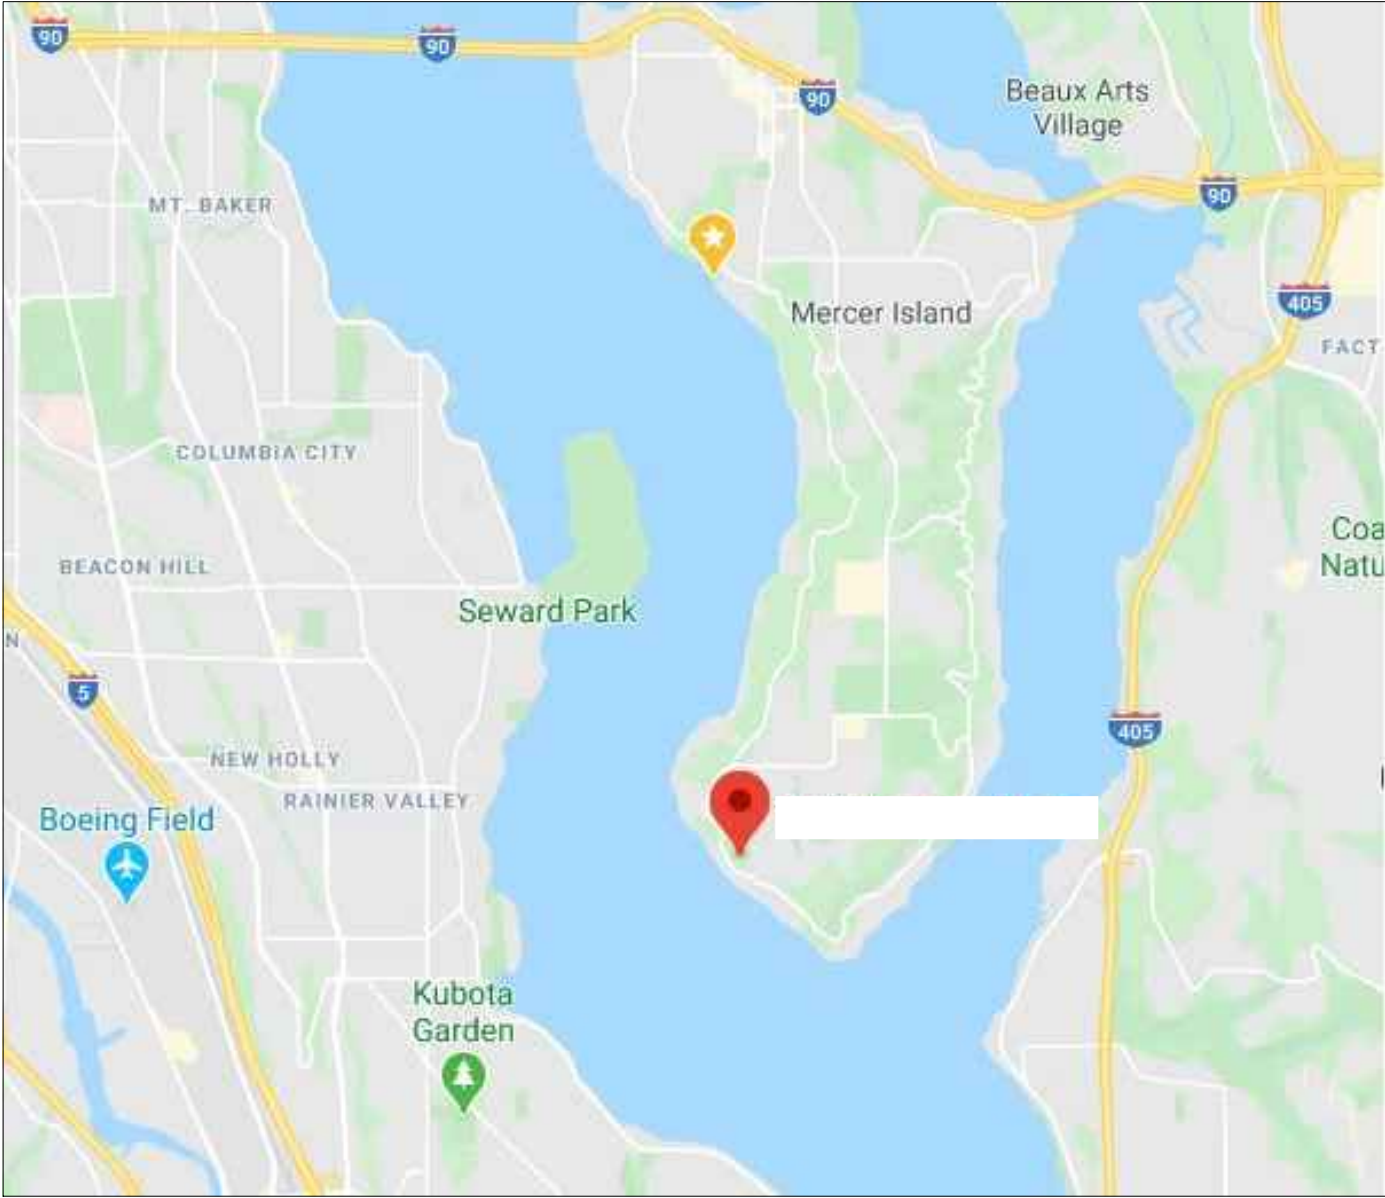

VICINITY MAP
NTS

AREA DATA	
CELLAR	350 S.F. ±
FIRST FLOOR	1,943 S.F. ±
SECOND FLOOR	2,168 S.F. ±
GRAND TOTAL	4,461 S.F. ±

AS BUILT

PROFESSIONALS

www.asbuiltprofessionals.com

A DIVISION OF:

AEC

CONSULTANTS INC

844.272.8458

844 AS BUILT

© 2020 AEC CONSULTANTS, INC.

ARCHITECTURAL AS BUILT
MERCER ISLAND, WA 98040

01	100% SUBMISSION	
NO.	ISSUES REVISIONS	DATE
SHEET TITLE		
COVER SHEET		
HL	PROJECT MANAGER	
HL	PROJECT DIRECTOR	
	PROJECT NUMBER	
	SCALE	
MM	DRAWN BY	
SHEET NUMBER		
C-1		



ARCHITECTURAL AS BUILT



MERCER ISLAND, WA 98040

01	100% SUBMISSION	
NQ.	ISSUES REVISIONS	DATE
		SHEET TITLE


FIRST FLOOR PLAN & RCP

HL	PROJECT MANAGER
HL	PROJECT DIRECTOR
	PROJECT NUMBER
1/4"=1'-0"	SCALE
MM	DRAWN BY
	SHEET NUMBER


AB-1

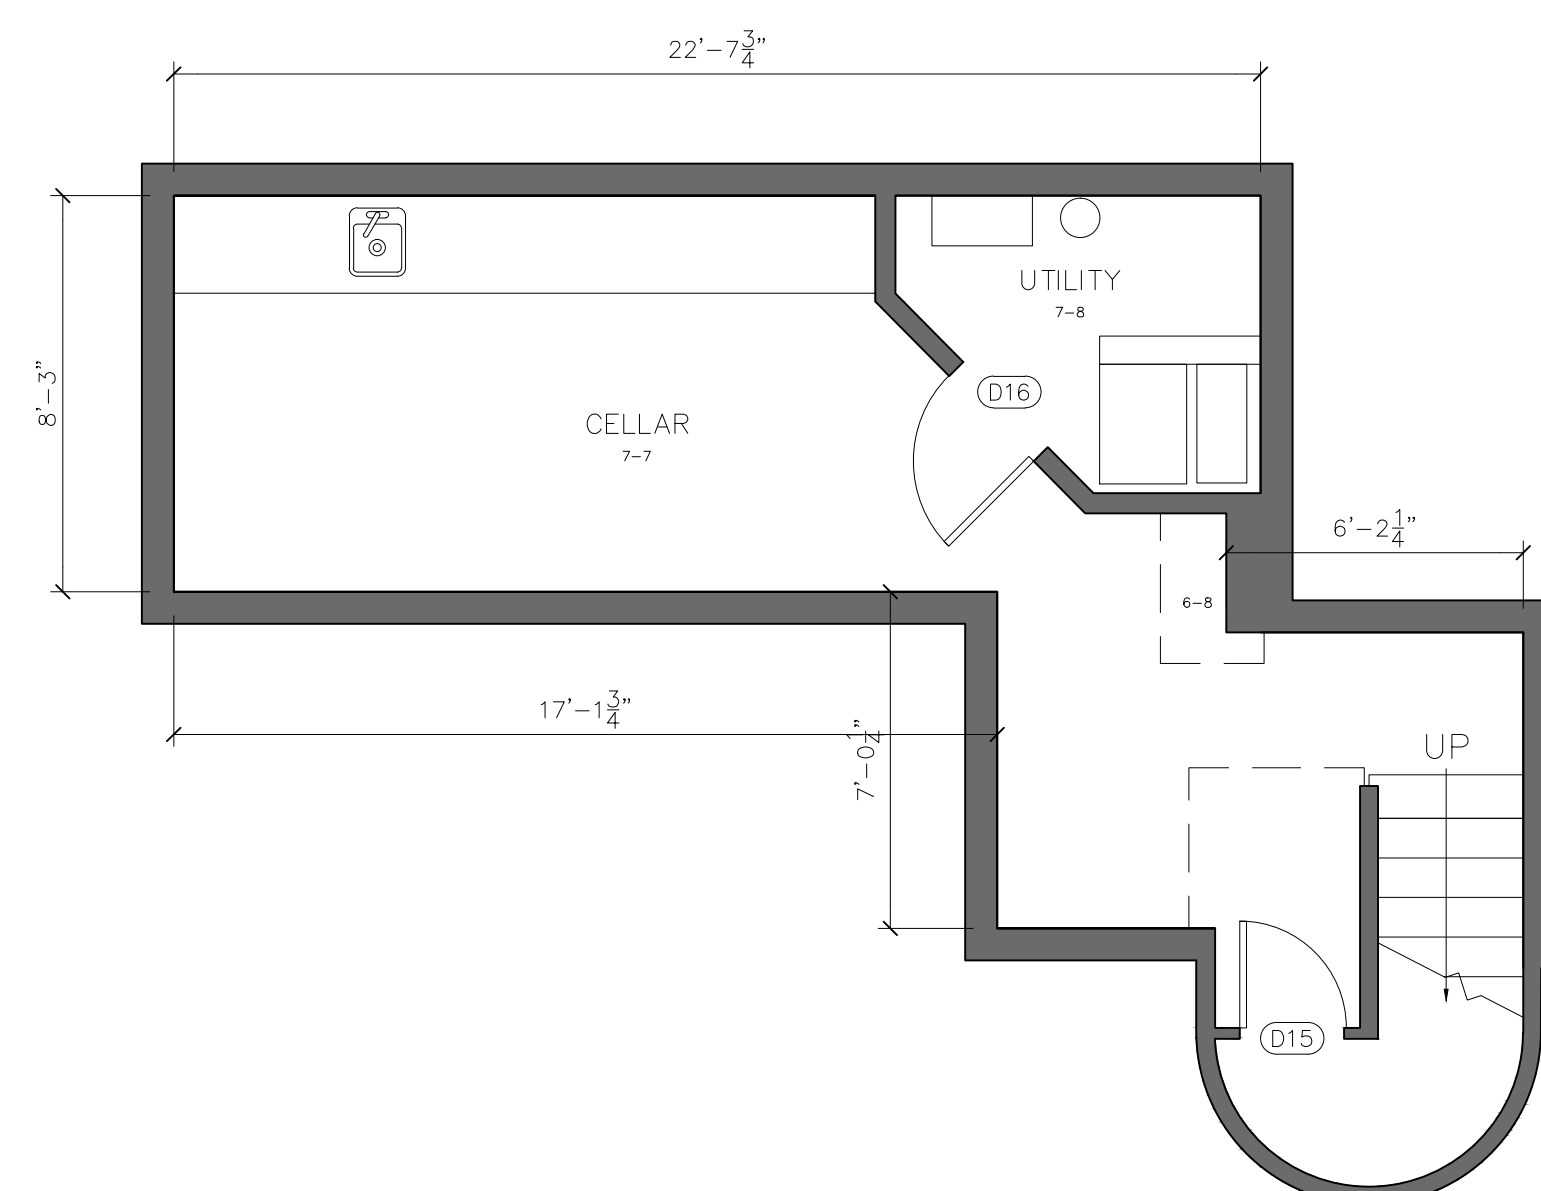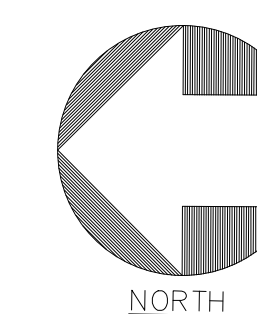

WINE CELLAR

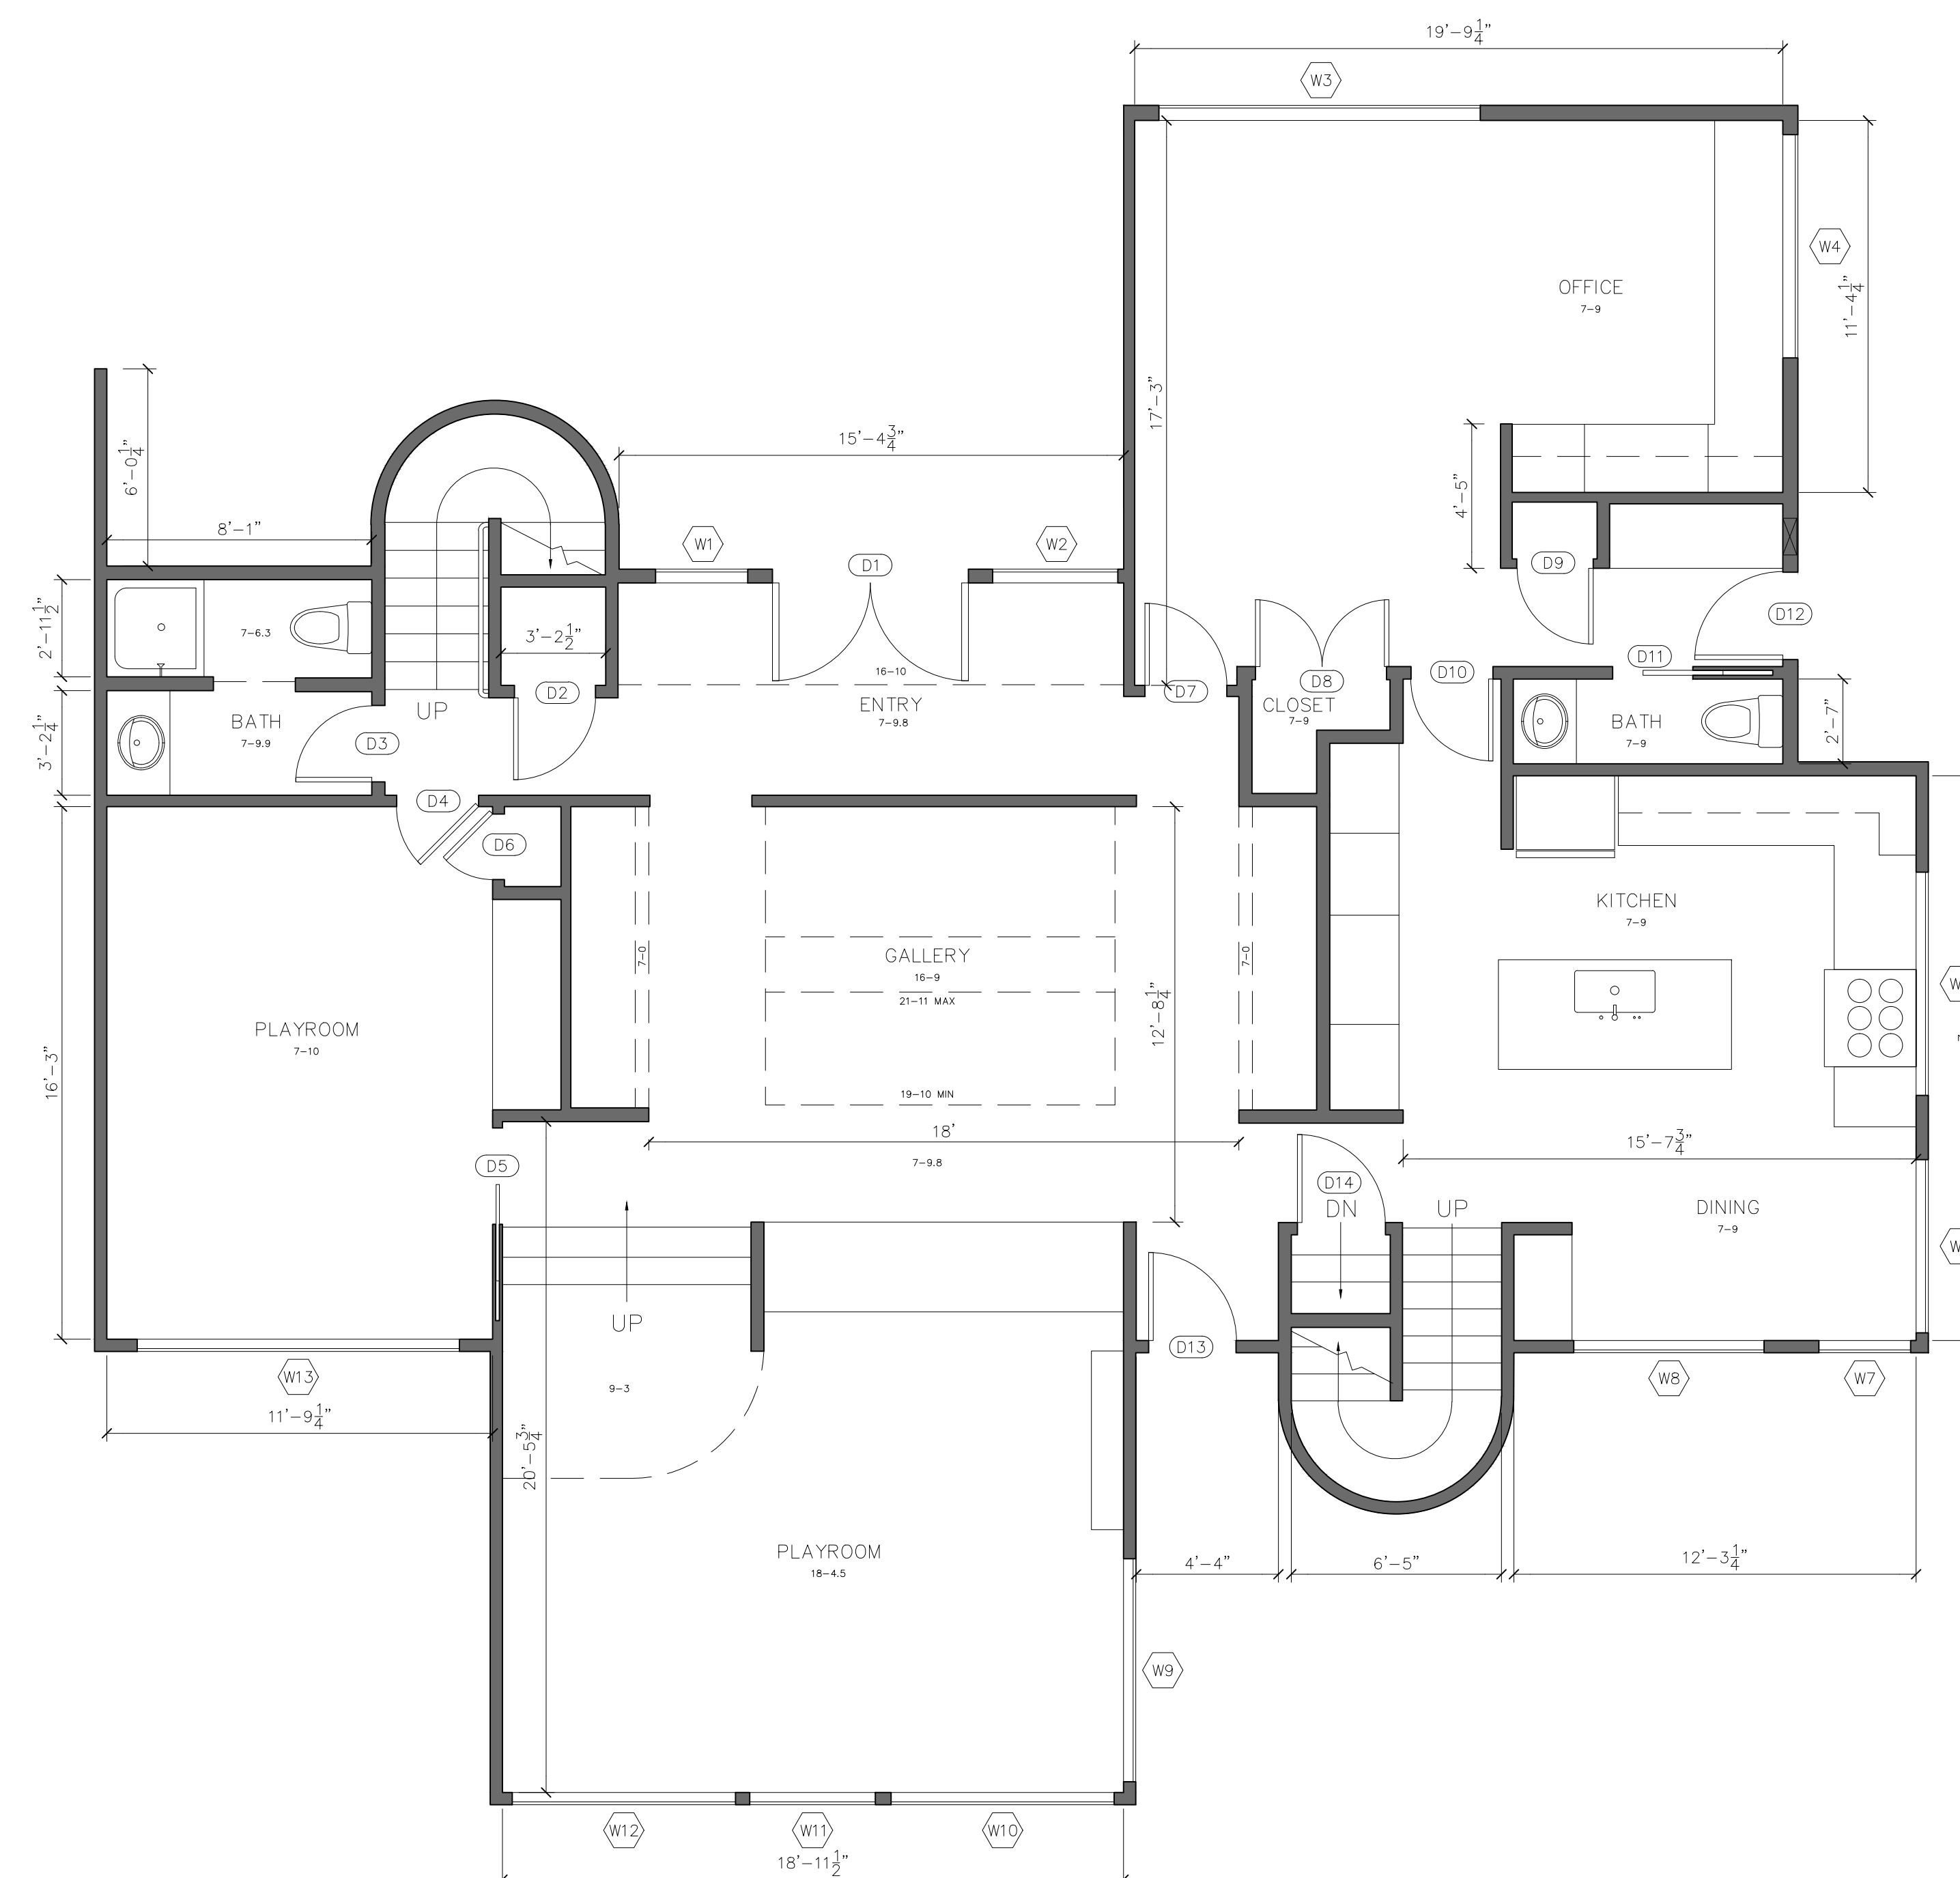

FIRST FLOOR – PLAN

 


MERCER ISLAND, WA 98040

SHEET TITLE

HL	PROJECT MANAGER
HL	PROJECT DIRECTOR
	PROJECT NUMBER
1/4"=1'-0"	SCALE
MM	DRAWN BY
	SHEET NUMBER

AB-2

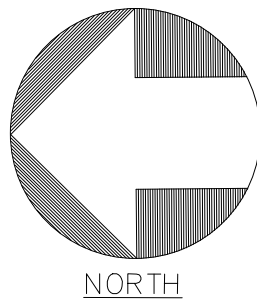

Window Schedule

Window	Width	Height	Sill Height	Left Trim	Right Trim	Top Trim	Btm Trim	Notes
W1	2'-9.3"	7'-3.5"	5"	0.75"	0.75"	0.75"	0.75"	
W2	3'-10"	7'-3.5"	5"	0.75"	0.75"	0.75"	0.75"	
W3	9'-9.6"	5'-3.3"	1'-4.5"	0.75"	0.75"	0.75"	0.75"	
W4	6'-9.6"	3'-9.1"	2'-11.2"	0.75"	0.75"	0.75"	0.75"	opperable
W5	6'-9.7"	3'-3.3"	3'-5.3"	0.75"	0.75"	0.75"	0.75"	opperable
W6	5'-3.5"	5'-3.3"	1'-5.1"	0.75"	0.75"	0.75"	0.75"	
W7	2'-9.8"	5'-3.3"	1'-5.1"	0.75"	0.75"	0.75"	0.75"	
W8	5'-9.7"	5'-3.3"	1'-5.1"	0.75"	0.75"	0.75"	0.75"	
W9	6'-9.75"	7'-9.1"	5"	0.75"	0.75"	0.75"	0.75"	opperable
W10	6'-9.75"	7'-9.1"	5"	0.75"	0.75"	0.75"	0.75"	opperable
W11	3'-10"	4'-1"	4'-1.5"	0.75"	0.75"	0.75"	0.75"	
W12	6'-9.75"	7'-9.1"	5"	0.75"	0.75"	0.75"	0.75"	opperable
W13	9'-9.8"	5'-3"	1'-5"	0.75"	0.75"	0.75"	0.75"	opperable
W14	2'-9.8"	6'-5.8"	9'-3"	0.75"	0.75"	0.75"	0.75"	
W15	6'-0"	6'-5.8"	9'-3"	0.75"	0.75"	0.75"	0.75"	
W16	3'-10"	6'-5.8"	9'-3"	0.75"	0.75"	0.75"	0.75"	
W17	4'-3.6"	3'-9.8"	2'-11"	0.75"	0.75"	0.75"	0.75"	
W18	5'-9.8"	3'-9.8"	2'-11"	0.75"	0.75"	0.75"	0.75"	opperable
W19	6'-9.6"	3'-9.1"	2'-11.2"	0.75"	0.75"	0.75"	0.75"	
W20	2'-10"	3'-9.1"	2'-11.2"	0.75"	0.75"	0.75"	0.75"	
W21	5'-9.1"	3'-9.1"	2'-11.2"	0.75"	0.75"	0.75"	0.75"	
W22	2'-9.8	3'-9.1"	2'-11.2"	0.75"	0.75"	0.75"	0.75"	opperable
W23	2'-3.7"	3'-9.1"	2'-11.2"	0.75"	0.75"	0.75"	0.75"	
W24	6'-9.7"	6'-9.7"	9'-3"	0.75"	0.75"	0.75"	0.75"	
W25	6'-9.7"	6'-9.7"	9'-3"	0.75"	0.75"	0.75"	0.75"	
W26	6'-9.7"	6'-9.7"	9'-3"	0.75"	0.75"	0.75"	0.75"	
W27	9'-9.5"	3'-9.1"	2'-11.2"	0.75"	0.75"	0.75"	0.75"	operable
W28	4'-9.5"	3'-9.1"	2'-11.2"	0.75"	0.75"	0.75"	0.75"	
W29	2'-9.2"	3'-10"	1'-2.5"	n/a	n/a	n/a	n/a	tile wrapped

Door Schedule

Door	Leaf Width	Leaf Height	Trim Int. Ht	Trim Width	Left Trim	Right Trim	Top Trim	Notes
D1	3'-0"	7'-7"	7'-8"	6'-0"	1.5"	1.5"	1.5"	Ext. double door
D2	2'-6"	6'-7"	6'-8"	2'-6"	1.5"	1.5"	1.5"	Int. closet door
D3	2'-4"	6'-7"	6'-8"	2'-6"	1.5"	1.5"	1.5"	Int. door
D4	2'-6"	6'-7"	6'-8"	2'-6"	1.5"	1.5"	1.5"	Int. door
D5	3'-0"	7'-9"	7'-8.9"	2'-11.25"	1.5"	1.5"	1"	Int. pocket door
D6	2'-0"	6'-7"	6'-8"	2'-0"	1.5"	1.5"	1.5"	Int. door
D7	2'-6"	6'-7"	6'-8"	2'-6"	1.5"	1.5"	1.5"	Int. door
D8	2'-0" ea	6'-7"	6'-8"	4'-0"	1.5"	1.5"	1.5"	Int. door
D9	2'-4"	6'-7"	6'-8"	2'-6"	1.5"	1.5"	1.5"	Int. door
D10	2'-6"	6'-7"	6'-8"	2'-6"	1.5"	1.5"	1.5"	Int. door
D11	2'-6"	6'-7"	6'-8"	2'-6"	1.5"	1.5"	1.5"	Int. pocket door
D12	2'-8"	6'-7"	6'-8"	2'-8"	1.5"	1.5"	1.5"	Ext. door with full lite
D13	2'-8"	6'-7"	6'-8"	2'-8"	1.5"	1.5"	1.5"	Ext. door with full lite
D14	2'-8"	6'-7"	6'-8"	2'-8"	1.5"	1.5"	1.5"	Int door
D15	2'-2"	3'-2"	3'-2"	2'-2"	1.5"	1.5"	1.5"	Int door
D16	2'-6"	6'-2"	6'-3"	2'-6"	1.5"	1.5"	1.5"	Int door
D17	2'-4"	6'-7"	6'-8"	2'-3.1"	1.5"	1.5"	1.5"	Int. pocket door
D18	2'-6"	6'-7"	6'-3"	2'-6"	1.5"	1.5"	1.5"	Int door
D19	2'-6"	6'-7"	6'-3"	2'-6"	1.5"	1.5"	1.5"	Int door
D20	2'-10" ea	6'-7"	6'-8"	8'-7.75"	1.5"	1.5"	1.5"	sliding door
D21	2'-10" ea	6'-7"	6'-8"	8'-7.75"	1.5"	1.5"	1.5"	sliding door
D22	2'-6"	6'-2"	6'-3"	2'-6"	1.5"	1.5"	1.5"	Int door
D23	3'-0"	6'-7"	6'-8"	3'-0"	1.5"	1.5"	1.5"	Int double door
D24	2'-6"	6'-2"	6'-3"	2'-6"	1.5"	1.5"	1.5"	Int door
D25	2'-11"	6'-8"	6'-8"	5'-10"	0.75"	0.75"	0.75"	Ext. Sliding Glass door
D26	2'-6"	6'-7"	6'-3"	2'-6"	1.5"	1.5"	1.5"	Int door
D27	2'-6"	6'-7"	6'-3"	2'-6"	1.5"	1.5"	1.5"	Int door
D28	2'-10" ea	6'-7"	6'-8"	8'-7.75"	1.5"	1.5"	1.5"	sliding door
D29	3'-3"	6'-7"	6'-8"	6'-6.8"	1.5"	1.5"	1.5"	sliding door
D30	2'-4"	6'-7"	6'-8"	2'-3"	1.5"	1.5"	1.5"	Int. pocket door
D31	2'-4"	6'-7"	6'-8"	2'-3"	1.5"	1.5"	1.5"	Int. pocket door

AS BUILT

PROFESSIONALS

www.asbuiltprofessionals.com

A DIVISION OF:

AEC

CONSULTANTS INC

844.272.8458

844 A S B U I L T

© 2020 AEC CONSULTANTS INC.

ARCHITECTURAL AS BUILT

MERCER ISLAND, WA 98040

DOOR & WINDOW SCHEDULES

HL	PROJECT MANAGER
HL	PROJECT DIRECTOR
	PROJECT NUMBER
	SCALE
MM	DRAWN BY
	SHEET NUMBER

AB-3