


ARCHITECTURAL AS BUILT
ROSEBOROUGH RESIDENCE
Atlanta, GA 30327

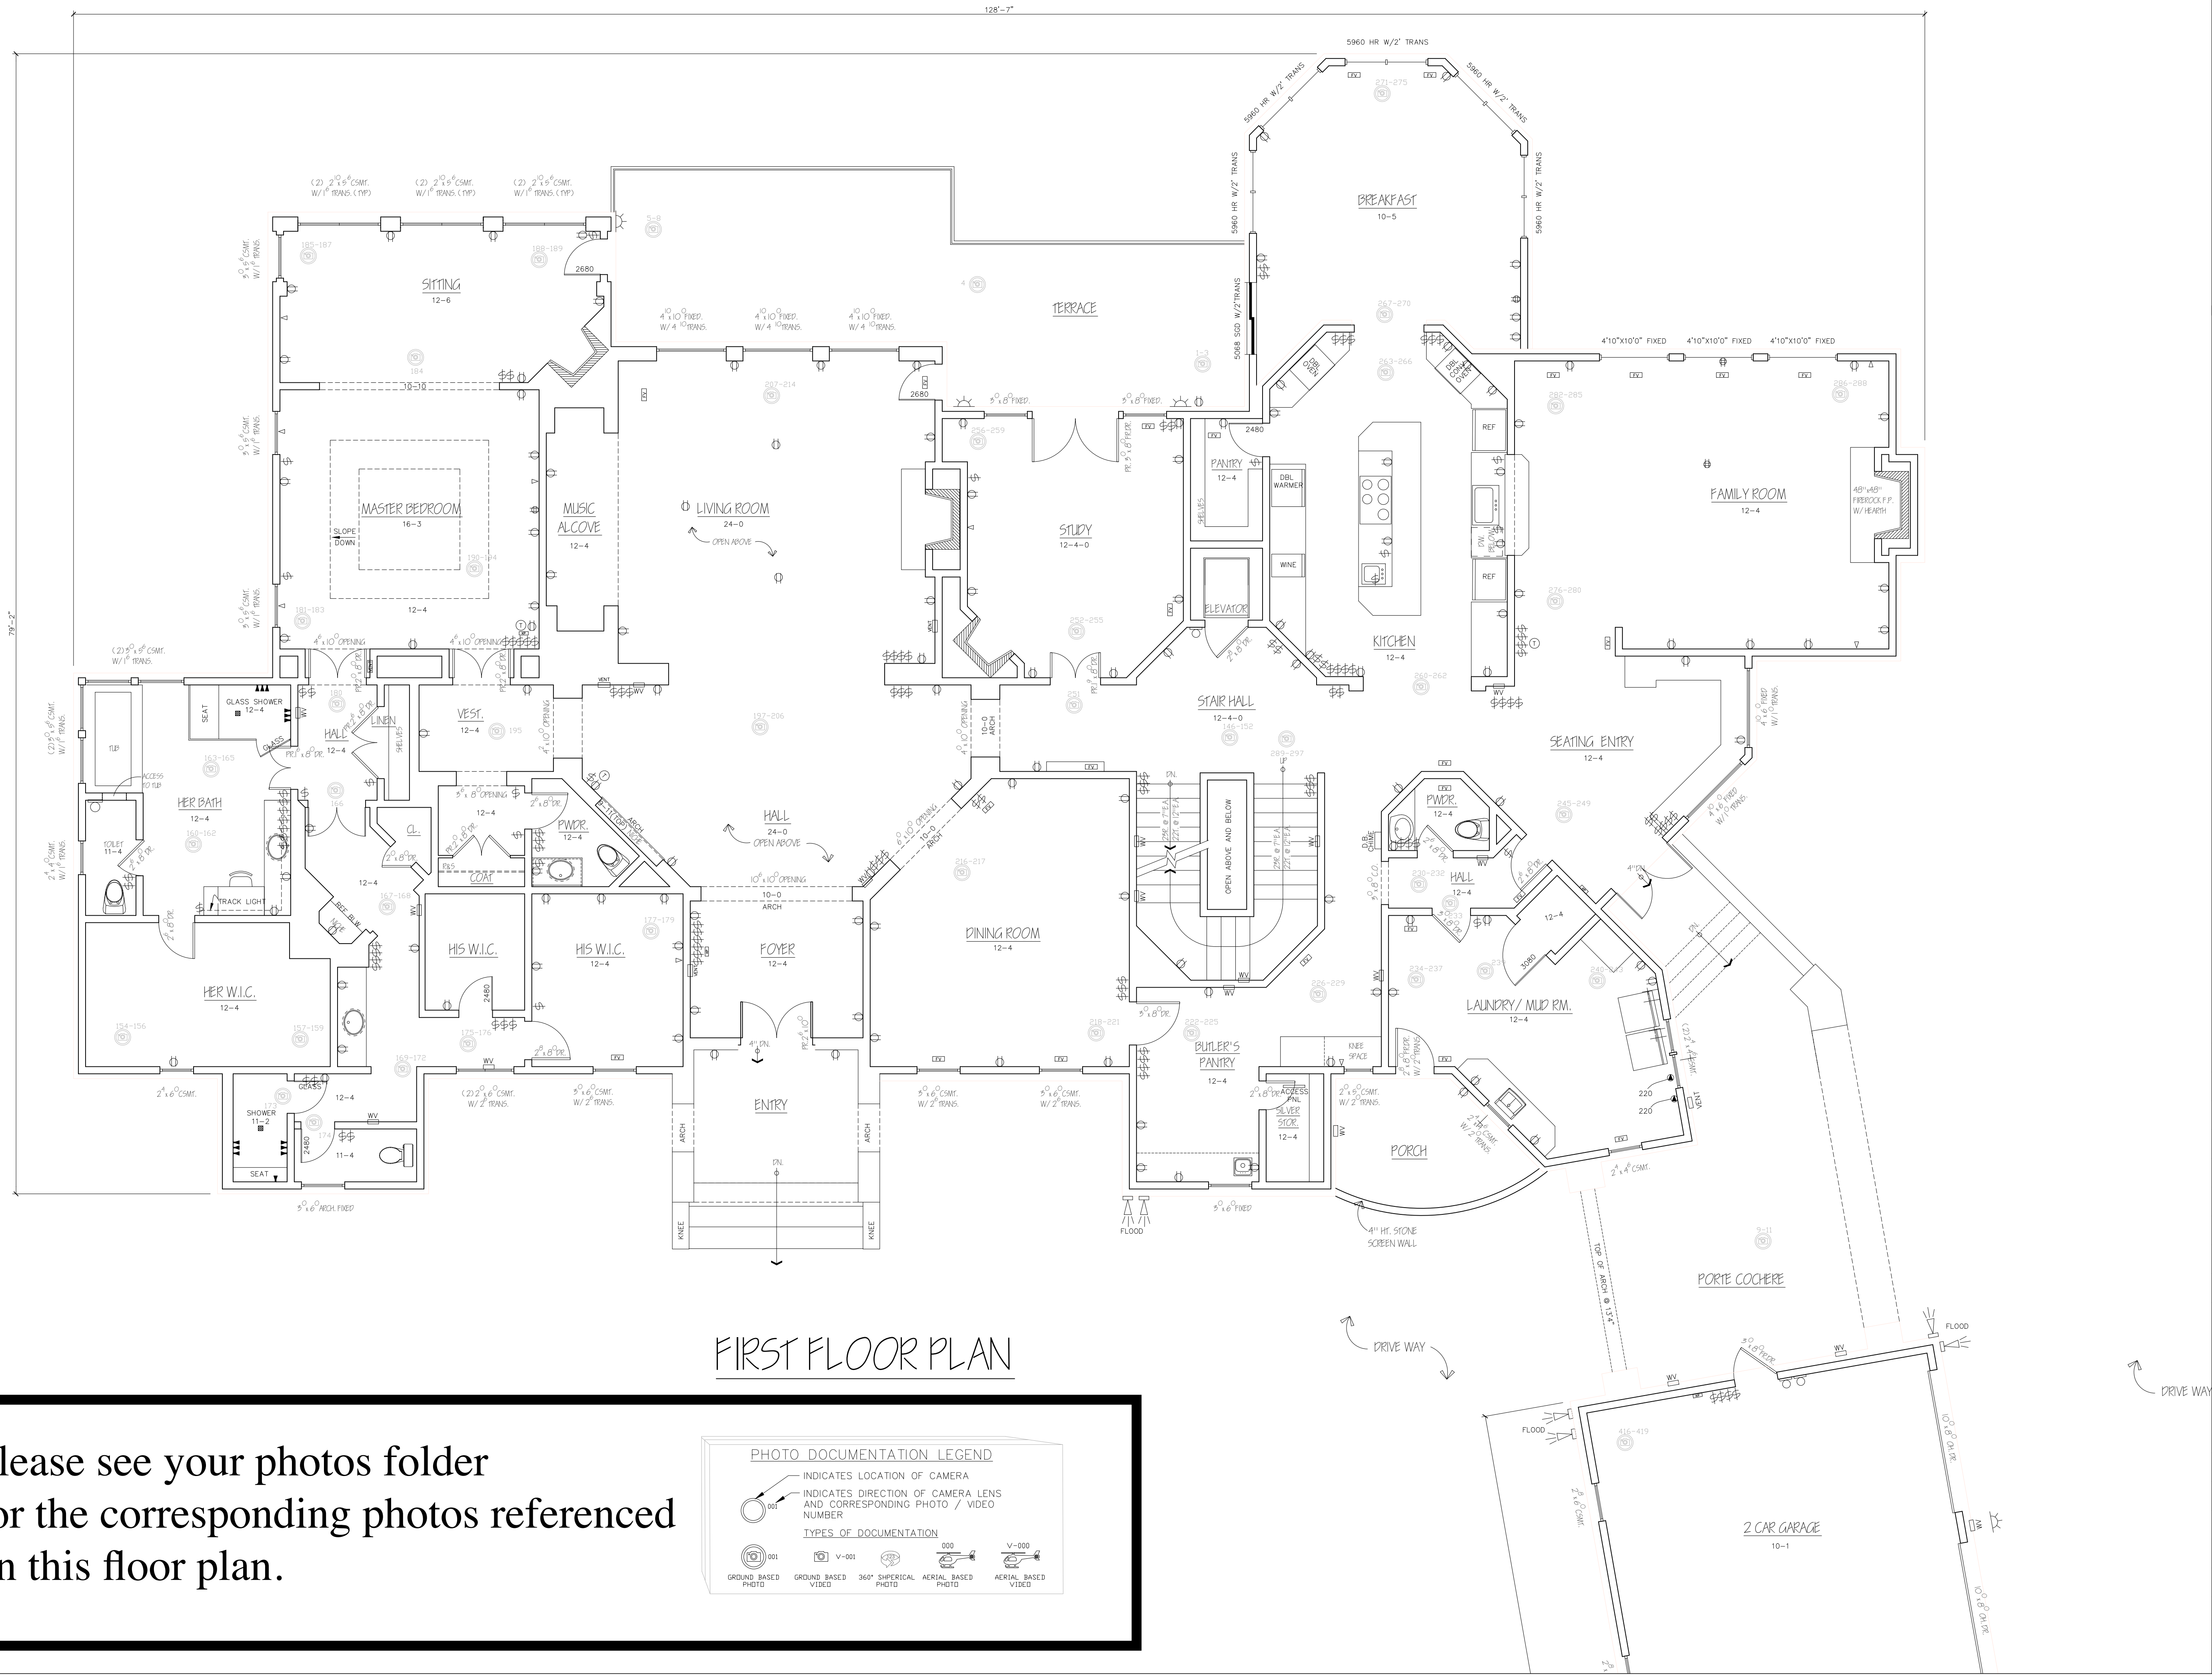

FIRST FLOOR PLAN

Please see your photos folder for the corresponding photos referenced on this floor plan.

PHOTO DOCUMENTATION LEGEND

INDICATES LOCATION OF CAMERA

INDICATES DIRECTION OF CAMERA LENS AND CORRESPONDING PHOTO / VIDEO NUMBER

TYPES OF DOCUMENTATION

001 GROUND BASED PHOTO 002 GROUND BASED VIDEO 003 360° SPHERICAL PHOTO 004 AERIAL BASED PHOTO 005 AERIAL BASED VIDEO

01	100% SUBMISSION	
NO.	ISSUES REVISIONS	DATE
SHEET TITLE		
HL		PROJECT MANAGER
HL		PROJECT DIRECTOR
012317-1		PROJECT NUMBER
3/16"=1'-0"		SCALE
CL		DRAWN BY
		SHEET NUMBER