



ARCHITECTURAL AS BUILT


Hixson, TN 37343

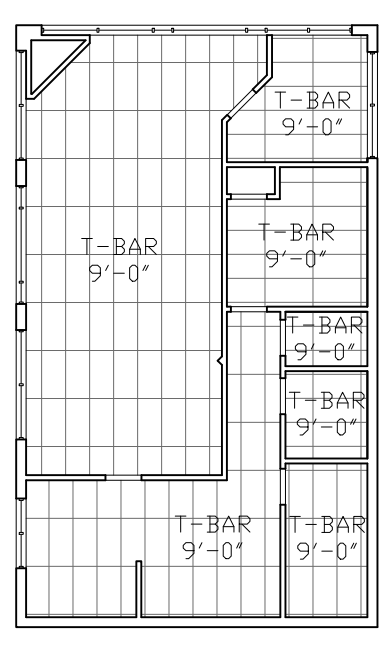


SECOND FLOOR

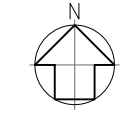

ACCESSORY BUILDING

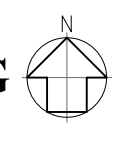

REFLECTED CEILING PLAN

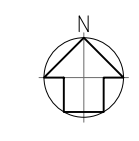

01	100% SUBMISSION	SEE COVER SHEET
NO.	ISSUES REVISIONS	DATE

REFLECTED CEILING PLANS

HL	PROJECT MANAGER
HL	PROJECT DIRECTOR
012317-1	PROJECT NUMBER
1/16"=1'-0"	SCALE
CL	DRAWN BY
	SHEET NUMBER

AB-2