


**ARCHITECTURAL AS BUILT**  
**Nashville, TN 37204**

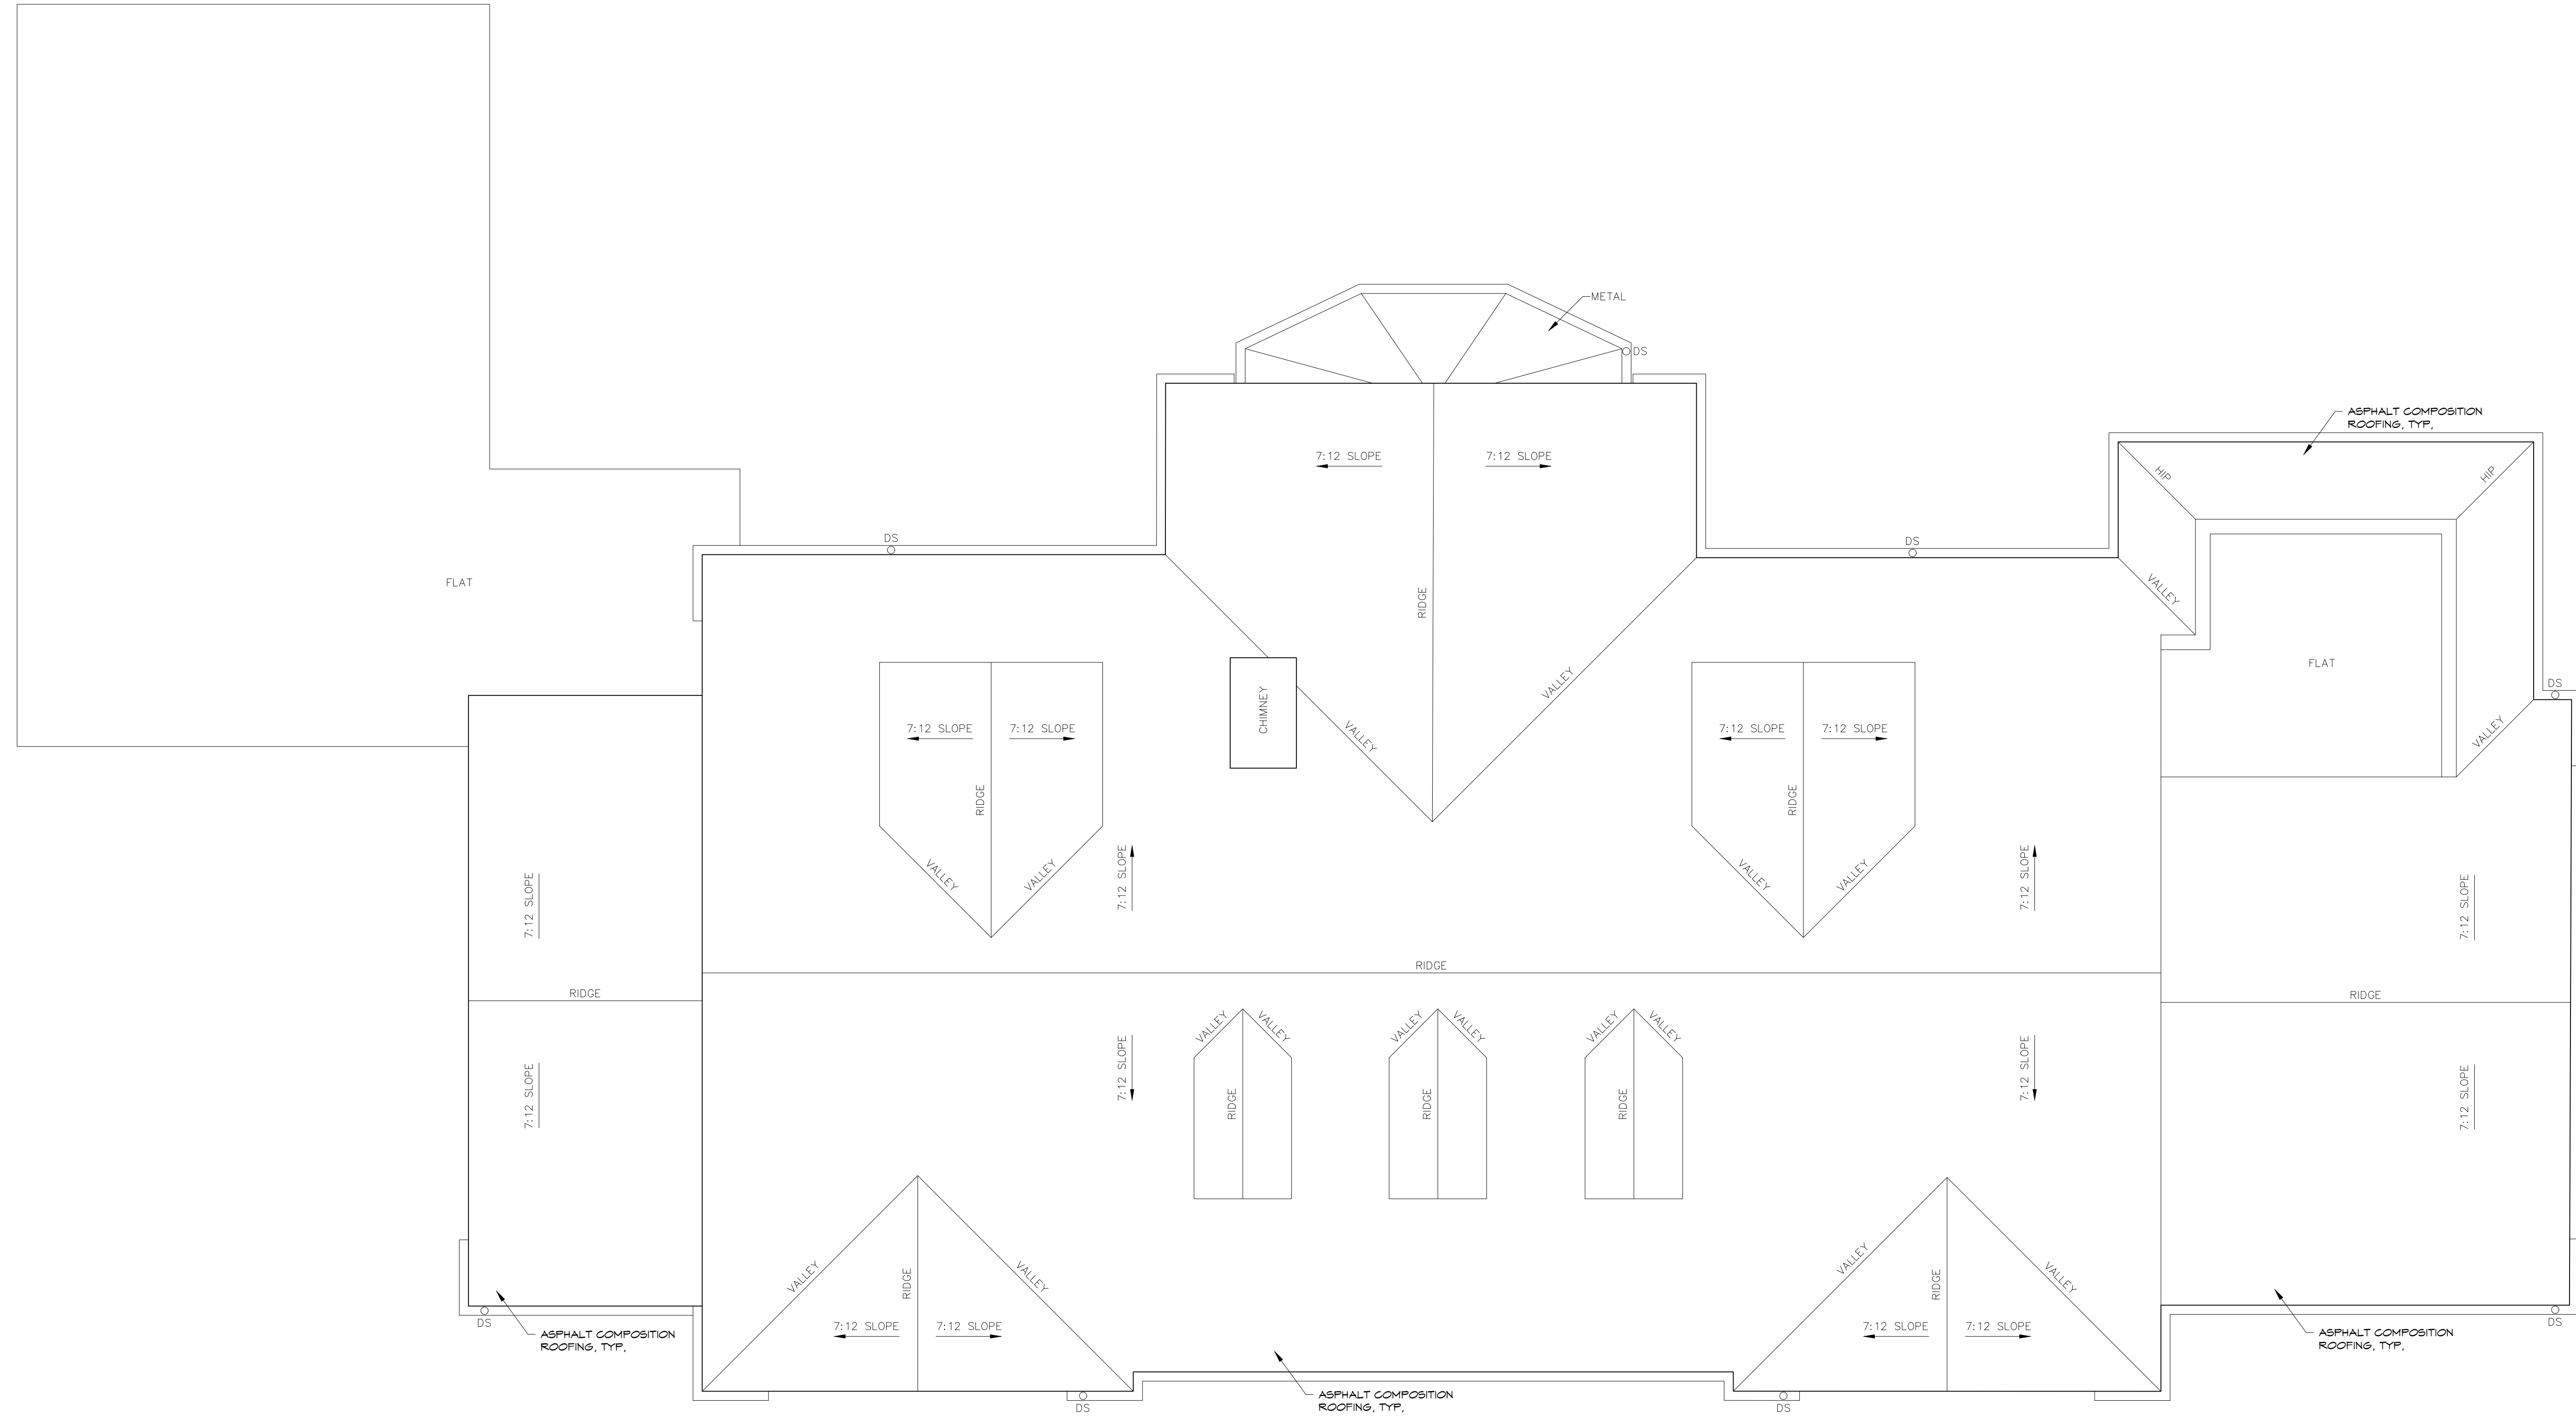

01	100% SUBMISSION	SEE COVER SHEET
NO.	ISSUES   REVISIONS	DATE

SHEET TITLE	
<b>831 ROOF PLAN</b>	
HL	PROJECT MANAGER
HL	PROJECT DIRECTOR
012317-1	PROJECT NUMBER
<b>1/4"=1'-0"</b>	SCALE
CL	DRAWN BY
	SHEET NUMBER