

AS-BUILT DOCUMENTATION

Faena House


Miami
Beach FL, 33140



100% SUBMITTAL

DRAWING INDEX

- C-1 COVER SHEET | DRAWING INDEX
- SL SYMBOLS LEGEND
- AB-1 CEILING ELEVATIONS AND DOCUMENTATION
- AB-2 FLOOR ELEVATIONS AND DOCUMENTATION

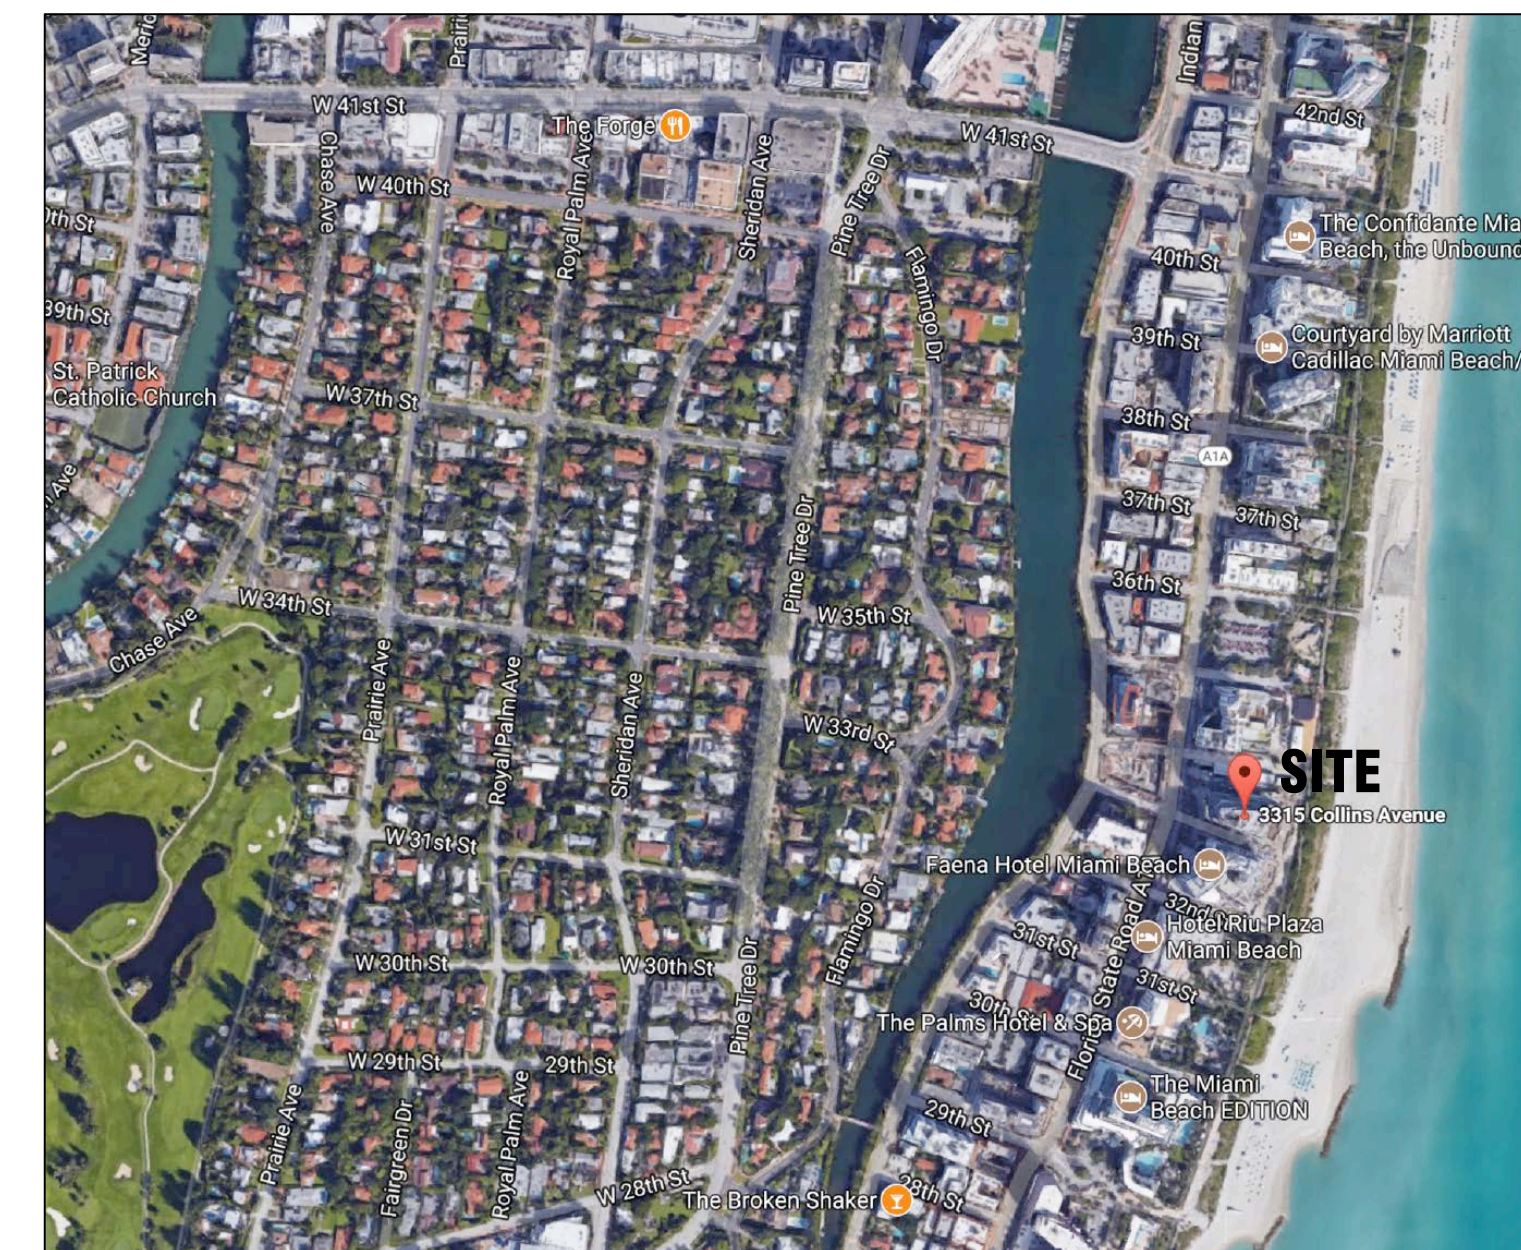

VICINITY MAP
NTS

AS BUILT
PROFESSIONALS
www.asbuiltprofessionals.com
A DIVISION OF:

AEC
CONSULTANTS INC
844.272.8458
844 AS BUILT

© 2017 AEC CONSULTANTS INC

ARCHITECTURAL AS BUILT
Faena House
Miami Beach FL, 33140

NO.	ISSUES REVISIONS	DATE
01	100% SUBMISSION	

COVER SHEET

HL	PROJECT MANAGER
HL	PROJECT DIRECTOR
012317-1	PROJECT NUMBER
	SCALE
CL	DRAWN BY
	SHEET NUMBER

C-1

SYMBOLS LEGEND

RCP

- EXHAUST VENT
- CEILING MOUNTED LIGHT FIXTURE
- CEILING MOUNTED DIRECTIONAL LIGHT
- RECESSED CAN LIGHT
- EYEBALL OR SMALL CAN LIGHT
- PENDANT LIGHT
- INDIVIDUAL FLUOR. LAY-IN FIXTURE 4 BULB
- INDIVIDUAL FLUOR. HANGING FIXTURE 2 BULB
- INDIVIDUAL FLUOR. FLUSH MOUNT FIXTURE 4 BULB
- CAMERA
- MOTION DET.
- SUPPLY VENT
- SUPPLY VENT
- RETURN VENT
- RETURN VENT
- SPEAKER

- TRACK LIGHT OR VANITY LIGHT
- WALL-MOUNTED LIGHT FIXTURE
- EMERGENCY EXIT SIGN
- EMERGENCY EXIT LIGHT
- EMERGENCY EXIT LIGHT W/ SIGN
- LIGHTED STAIR SIGN
- FLOOD LIGHT
- PHOTO CELL
- CEILING FAN
- CEILING FAN W/ LIGHT KIT
- JUNCTION BOX

7-2-6 CEILING HEIGHT AND TRIM 1'-2" ABOVE FLOOR BELOW WITH 6" CROWN MOULDING. NOTE: ALL CEILINGS NOT LABELED ARE PLASTER. CEILINGS SHOWN WITH A GRID ARE LAY IN ACOUSTICAL TILE..

ELECTRIC

- DATA OUTLET
- TELEPHONE JACK
- ELECTRIC SWITCH
- CABLE TELEVISION OUTLET
- DUPLEX RECEPTACLE OUTLET
- SPECIAL PURPOSE CONNECTION OR OUTLET
- QUADRUPLEX RECEPTACLE OUTLET
- FLOOR DUPLEX RECEPTACLE OUTLET
- ELECTRIC PANEL
- ELECTRIC METER
- BUTTON SWITCH
- DISCONNECT SWITCH
- GROUND/FLOOR LIGHT
- KEY PAD

FIRE PROTECTION

- FIRE EXTINGUISHER
- FIRE PULL
- FIRE ALARM (HORN/SRTO)
- SMOKE DETECTOR
- SMOKE ALARM SPEAKER
- SPRINKLER HEAD CEILING MOUNT
- SPRINKLER HEAD WALL MOUNT

MEP

- THERMOSTAT
- FLOOR DRAIN
- VALVE
- HOSE BIB
- WATER SUPPLY
- SUSPENDED GAS HEATER



MISC

- BOLLARD
- SPOT ELEVATION

PHOTO DOCUMENTATION LEGEND

- INDICATES LOCATION OF CAMERA
 - INDICATES DIRECTION OF CAMERA LENS AND CORRESPONDING PHOTO / VIDEO NUMBER
- TYPES OF DOCUMENTATION
- GROUND BASED PHOTO
 - GROUND BASED VIDEO
 - 360° SPHERICAL PHOTO
 - AERIAL BASED PHOTO
 - AERIAL BASED VIDEO


7-2-6 CEILING HEIGHT AND TRIM 1'-2" ABOVE FLOOR BELOW WITH 6" CROWN MOULDING. NOTE: ALL CEILINGS NOT LABELED ARE PLASTER. CEILINGS SHOWN WITH A GRID ARE LAY IN ACOUSTICAL TILE..

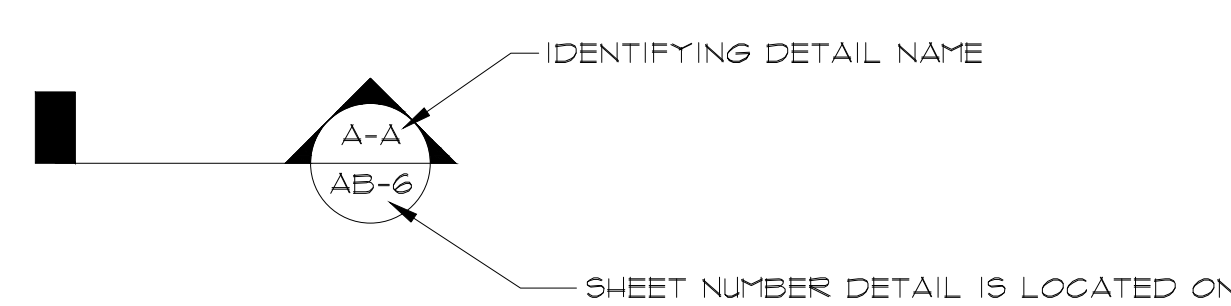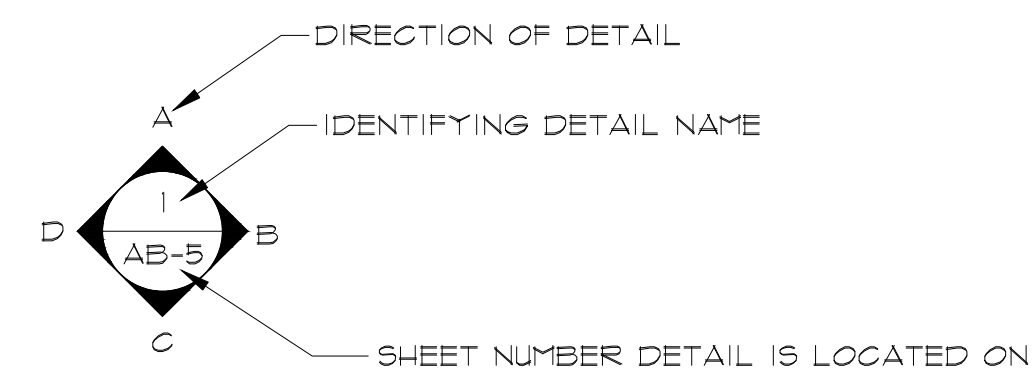

ARCHITECTURAL AS BUILT
Faena House
Miami Beach FL, 33140

01	100% SUBMISSION	
NO.	ISSUES REVISIONS	DATE
SHEET TITLE		
HL		PROJECT MANAGER
HL		PROJECT DIRECTOR
012317-1		PROJECT NUMBER
NOT TO SCALE		SCALE
CL		DRAWN BY
		SHEET NUMBER

SL

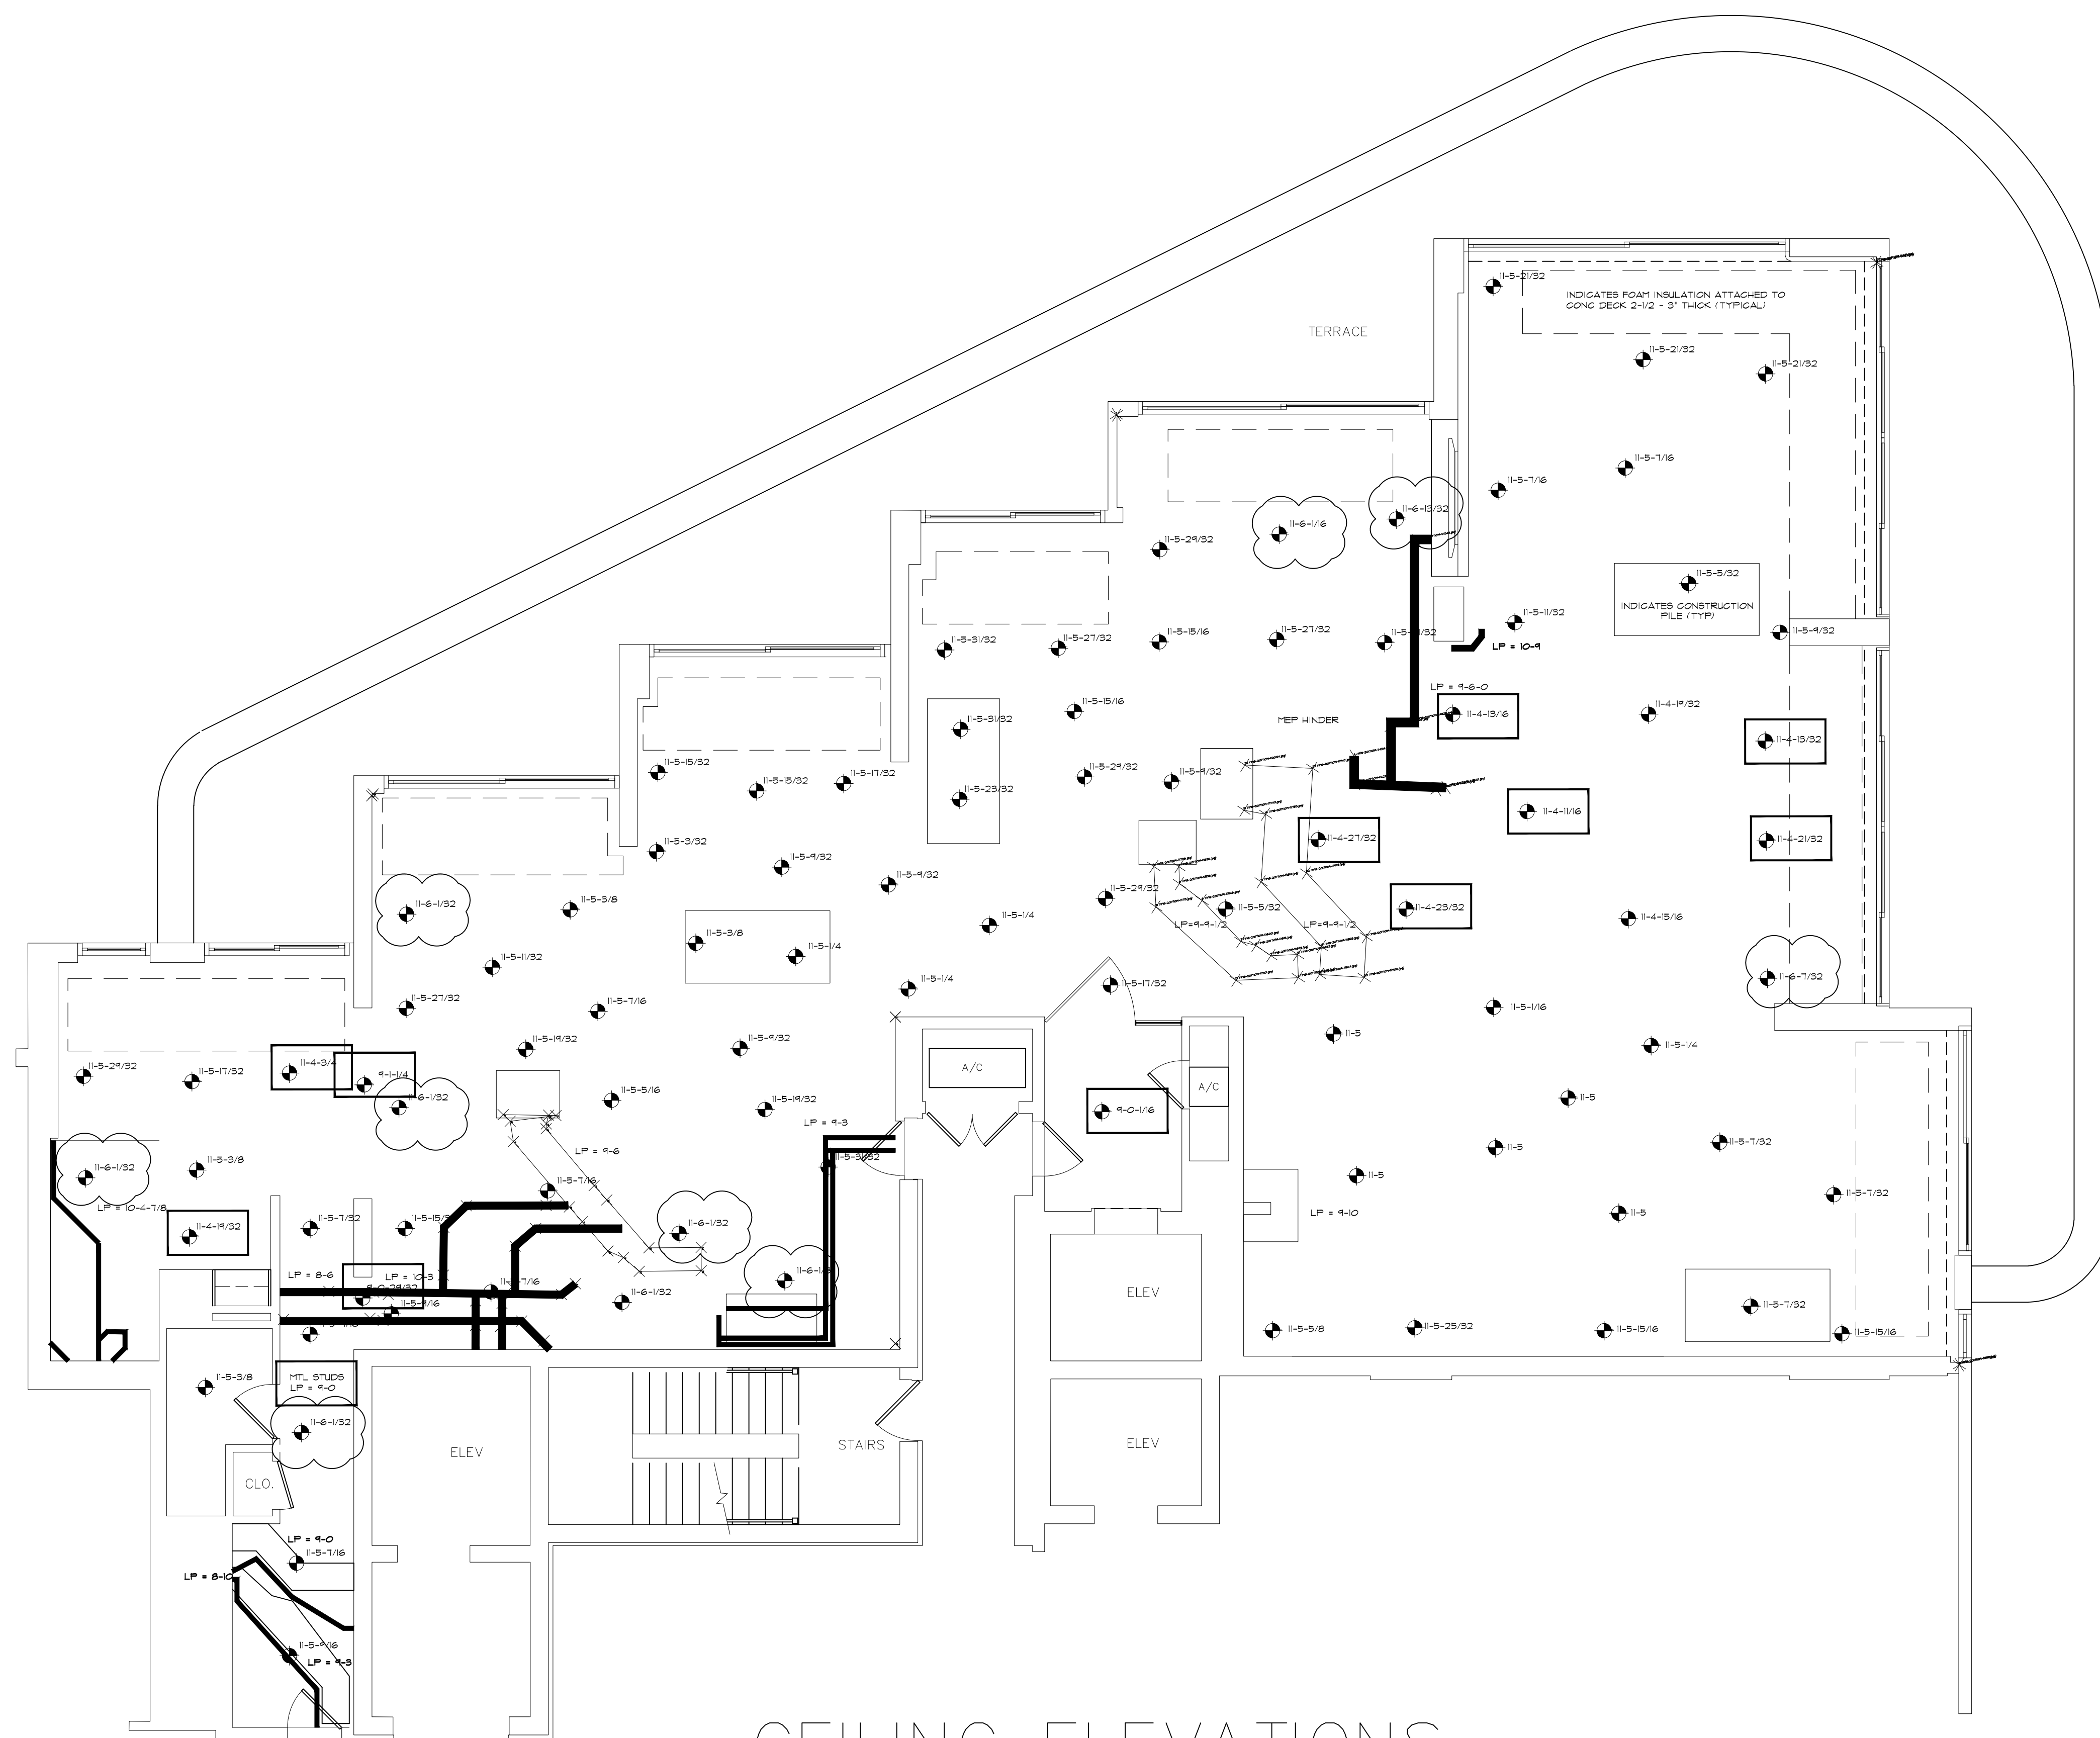

CEILING ELEVATIONS

 INDICATES ELEVATIONS HIGHER THAN 11'6" ABOVE THE FRONT DOOR THRESHOLD BENCHMARK OF 0'-0"

 INDICATES ELEVATIONS LOWER THAN 11'5" ABOVE THE FRONT DOOR THRESHOLD BENCHMARK OF 0'-0"


ARCHITECTURAL AS BUILT Faena House

Miami Beach FL, 33140

01	100% SUBMISSION	
NO.	ISSUES REVISIONS	DATE

HL	PROJECT MANAGER
HL	PROJECT DIRECTOR
012317-1	PROJECT NUMBER
3/16"=1'-0"	SCALE
CL	DRAWN BY
	SHEET NUMBER

AB-1

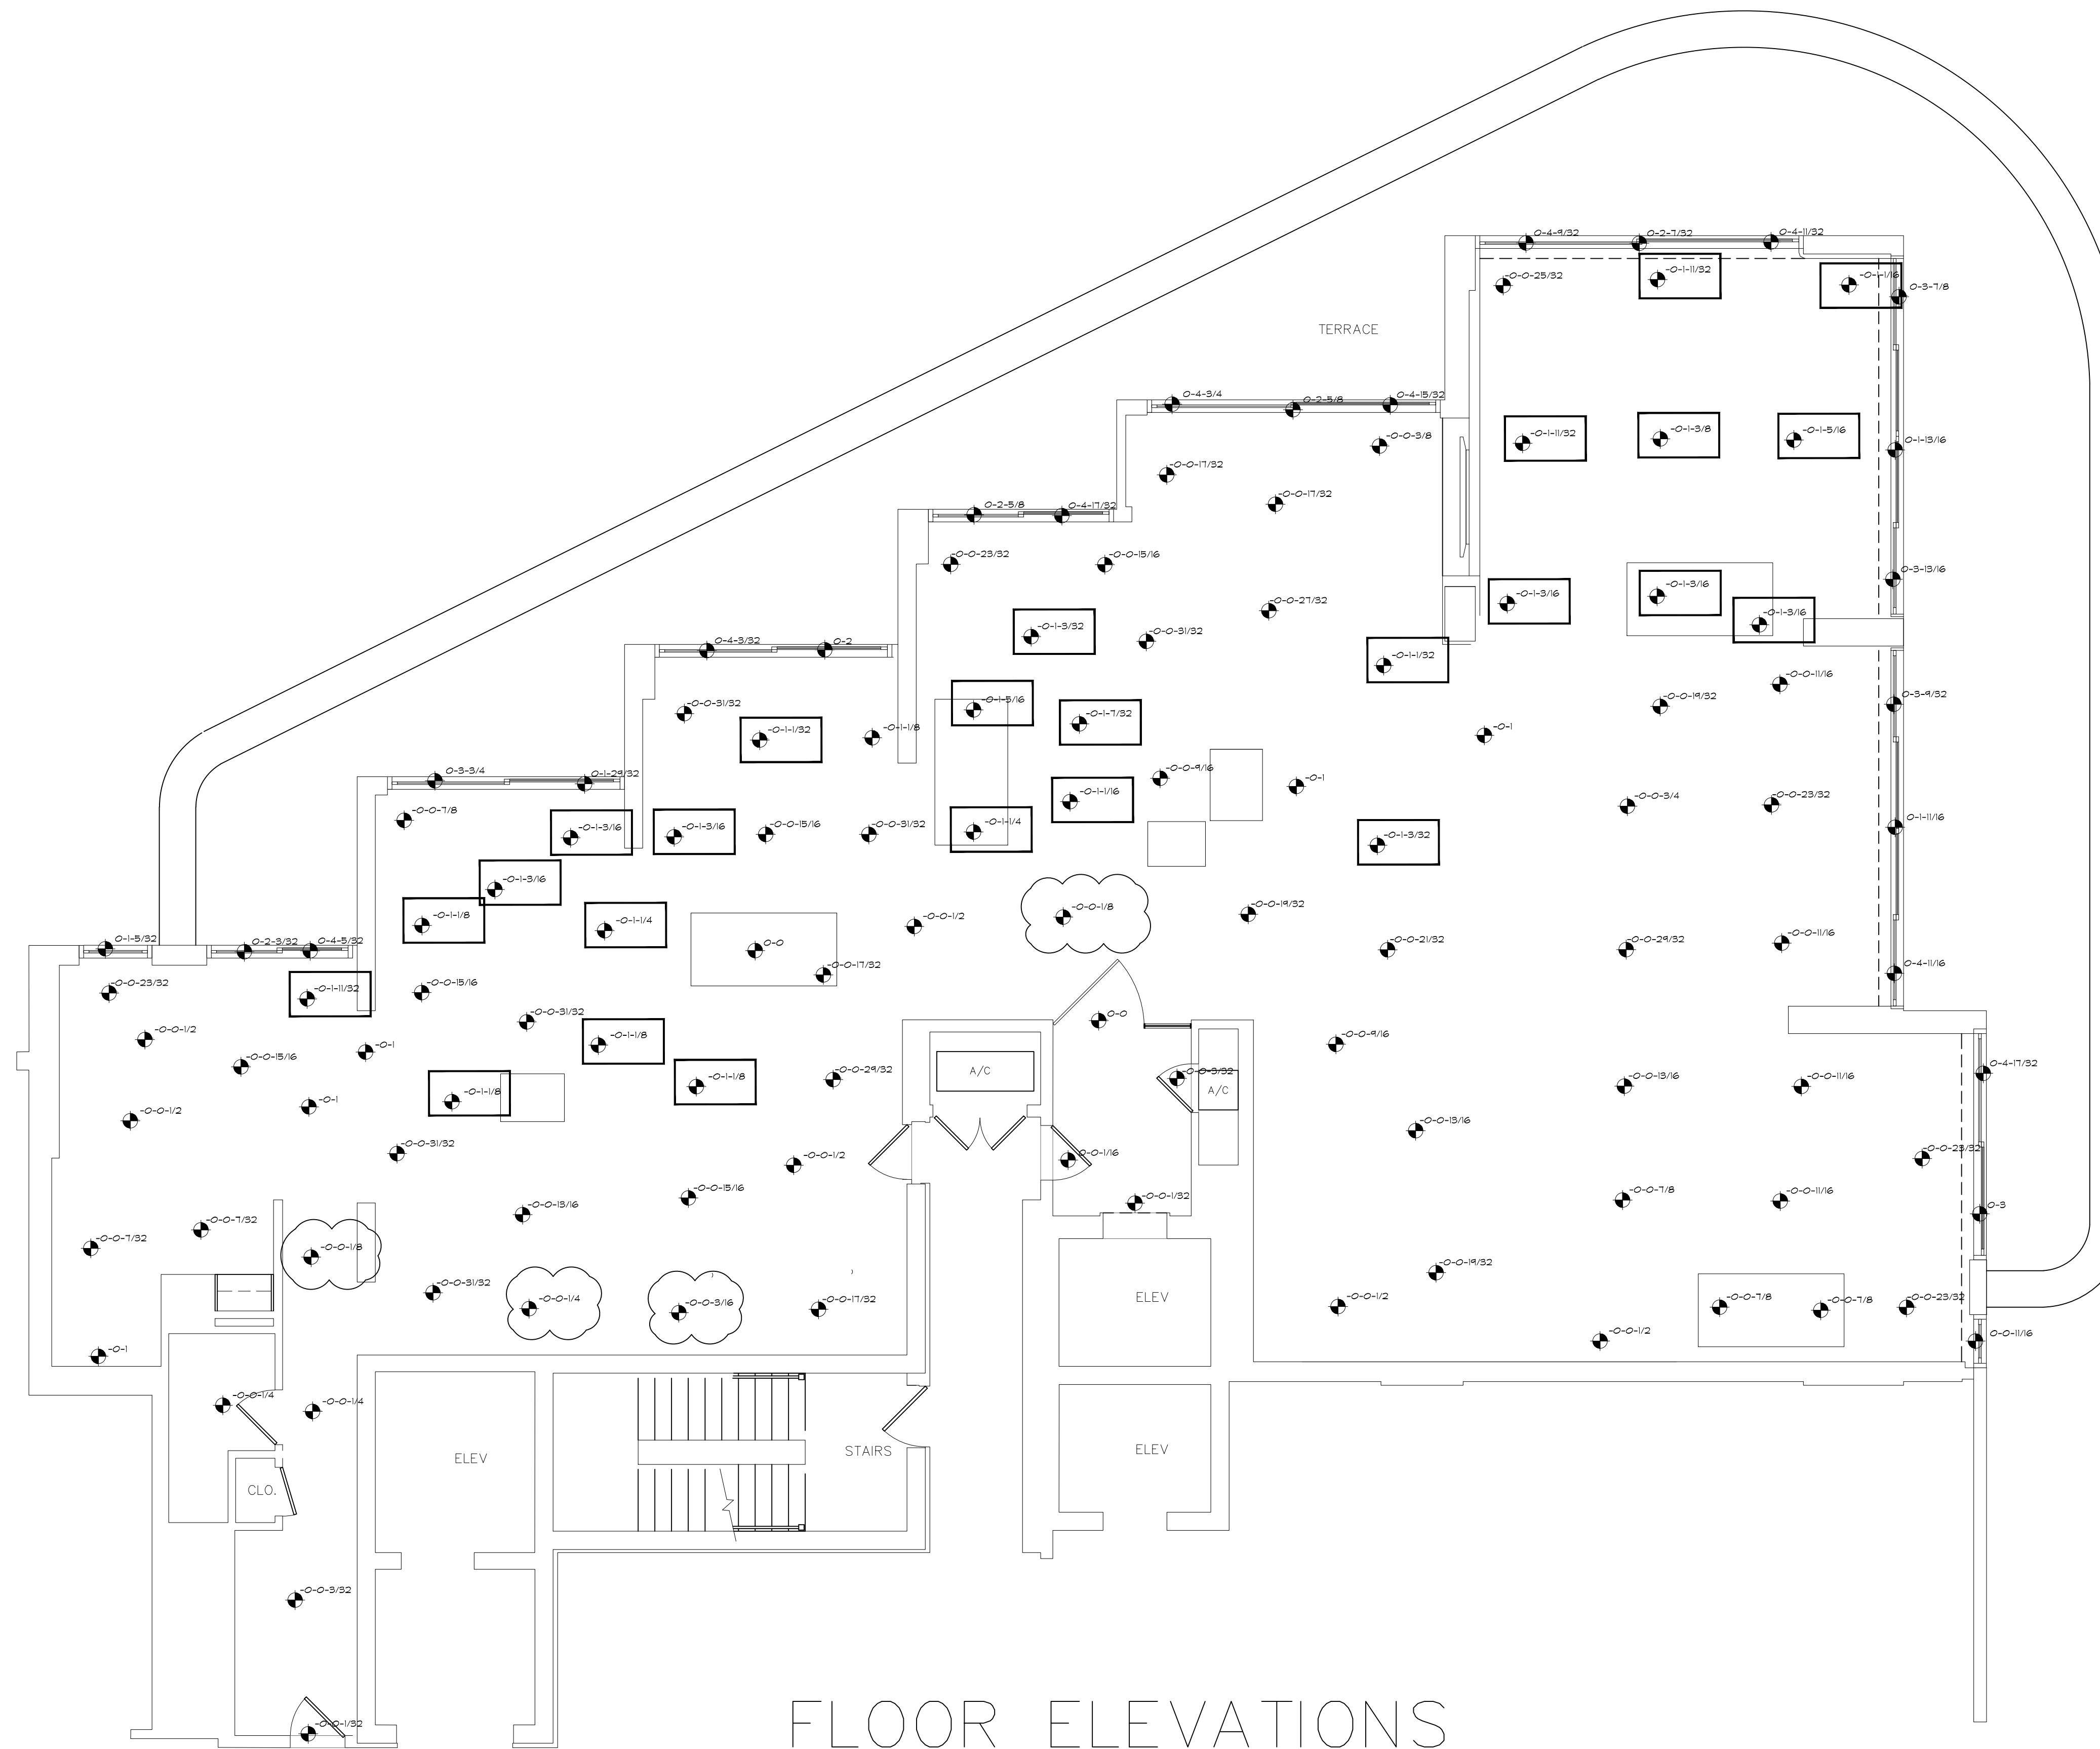

FLOOR ELEVATIONS

INDICATES HIGH ELEVATIONS WITHIN 1/4" OF THE FRONT DOOR THRESHOLD BENCHMARK OF 0'-0"

INDICATES ELEVATIONS LOWER THAN 1" OF THE FRONT DOOR THRESHOLD BENCHMARK OF 0'-0"

ARCHITECTURAL AS BUILT
Faena House
Miami Beach FL, 33140

NO.	ISSUES REVISIONS	DATE
01	100% SUBMISSION	

HL	PROJECT MANAGER
HL	PROJECT DIRECTOR
012317-1	PROJECT NUMBER
3/8"=1'-0"	SCALE
CL	DRAWN BY
	SHEET NUMBER

AB-2