

AS-BUILT DOCUMENTATION

Franklin, TN



100% SUBMITTAL

DRAWING INDEX

C-1	COVER SHEET DRAWING INDEX
SL	SYMBOLS LEGEND
AB-1	BASEMENT PLAN
AB-2	FIRST FLOOR PLAN
AB-3	SECOND FLOOR PLAN
AB-4	EXTERIOR ELEVATIONS
AB-5	EXTERIOR ELEVATIONS

AREA DATA	
GARAGE	1,469 S.F. ±
BASEMENT FLOOR	2,783 S.F. ±
FIRST FLOOR	4,253 S.F. ±
SECOND FLOOR	1,982 S.F. ±
GRAND TOTAL	10,487 S.F. ±



ARCHITECTURAL AS BUILT


Franklin, TN

01	100% SUBMISSION	SEE COVER SHEET
NO.	ISSUES REVISIONS	DATE
SHEET TITLE		
COVER SHEET		
HL	PROJECT MANAGER	
HL	PROJECT DIRECTOR	
012317-1	PROJECT NUMBER	
	SCALE	
CL	DRAWN BY	
	SHEET NUMBER	

C-1

RCP EXHAUST VENT CEILING MOUNTED LIGHT FIXTURE CEILING MOUNTED DIRECTIONAL LIGHT RECESSED CAN LIGHT EYEBALL OR SMALL CAN LIGHT PENDANT LIGHT INDIVIDUAL FLUOR. LAY-IN FIXTURE 4 BULB INDIVIDUAL FLUOR. HANGING FIXTURE 2 BULB INDIVIDUAL FLUOR. FLUSH MOUNT FIXTURE 4 BULB CAMERA MOTION DET. SUPPLY VENT RETURN VENT SPEAKER TRACK LIGHT OR VANITY LIGHT WALL-MOUNTED LIGHT FIXTURE EMERGENCY EXIT SIGN EMERGENCY EXIT LIGHT EMERGENCY EXIT LIGHT W/ SIGN LIGHTED STAIR SIGN FLOOD LIGHT PHOTO CELL CEILING FAN CEILING FAN W/ LIGHT KIT 7-2-6 CEILING HEIGHT AND TRIM 7'-2" ABOVE FLOOR BELOW WITH 6" CROWN MOULDING. NOTE: ALL CEILINGS NOT LABELED ARE PLASTER. CEILINGS SHOWN WITH A GRID ARE LAY IN ACOUSTICAL TILE. JUNCTION BOX	ELECTRIC DATA OUTLET TELEPHONE JACK ELECTRIC SWITCH CABLE TELEVISION OUTLET DUPLEX RECEPTACLE OUTLET SPECIAL PURPOSE CONNECTION OR OUTLET QUADRUPLEX RECEPTACLE OUTLET FLOOR DUPLEX RECEPTACLE OUTLET ELECTRIC PANEL ELECTRIC METER BUTTON SWITCH DISCONNECT SWITCH GROUND/FLOOR LIGHT KEY PAD	FIRE PROTECTION FIRE EXTINGUISHER FIRE PULL FIRE ALARM (HORN/SRTOBE) SMOKE DETECTOR SMOKE ALARM SPEAKER SPRINKLER HEAD CEILING MOUNT SPRINKLER HEAD WALL MOUNT MEP THERMOSTAT FLOOR DRAIN VALVE HOSE BIB WATER SUPPLY SUSPENDED GAS HEATER MISC BOLLARD 1-4=11/16 SPOT ELEVATION
--	--	---

INTERIOR ELEVATIONS	BUILDING SECTION	PHOTO DOCUMENTATION LEGEND TYPES OF DOCUMENTATION - GROUND BASED PHOTO - GROUND BASED VIDEO 360° SPHERICAL PHOTO - AERIAL BASED PHOTO - AERIAL BASED VIDEO
------------------------------	---------------------------	--

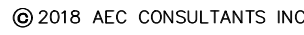

01	100% SUBMISSION	SEE COVER SHEET
NO.	ISSUES REVISIONS	DATE


01	100% SUBMISSION	SEE COVER SHEET
NO.	ISSUES REVISIONS	DATE

SHEET TITLE

HL	PROJECT MANAGER
HL	PROJECT DIRECTOR
012317-1	PROJECT NUMBER
1/4"=1'-0"	SCALE
CL	DRAWN BY
	SHEET NUMBER

AB-1



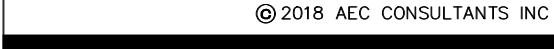

01	100% SUBMISSION	SEE COVER SHEET
NO.	ISSUES REVISIONS	DATE

SHEET TITLE

PROJECT MANAGER

PROJECT DIRECTOR

012317-1	PROJECT NUMBER
----------	----------------

1/4"=1'-0" SCALE

CL DRAWN BY

SHEET NUMBER

AD 2





01	100% SUBMISSION	SEE COVER SHEET
NO.	ISSUES REVISIONS	DATE
		SHEET TITLE
SECOND FLOOR		
HL		PROJECT MANAGER
HL		PROJECT DIRECTOR
012317-1		PROJECT NUMBER
1/4"=1'-0"		SCALE
CL		DRAWN BY
		SHEET NUMBER
AB-2		

