


AS-BUILT DOCUMENTATION

Nashville, TN 37204



100% SUBMITTAL

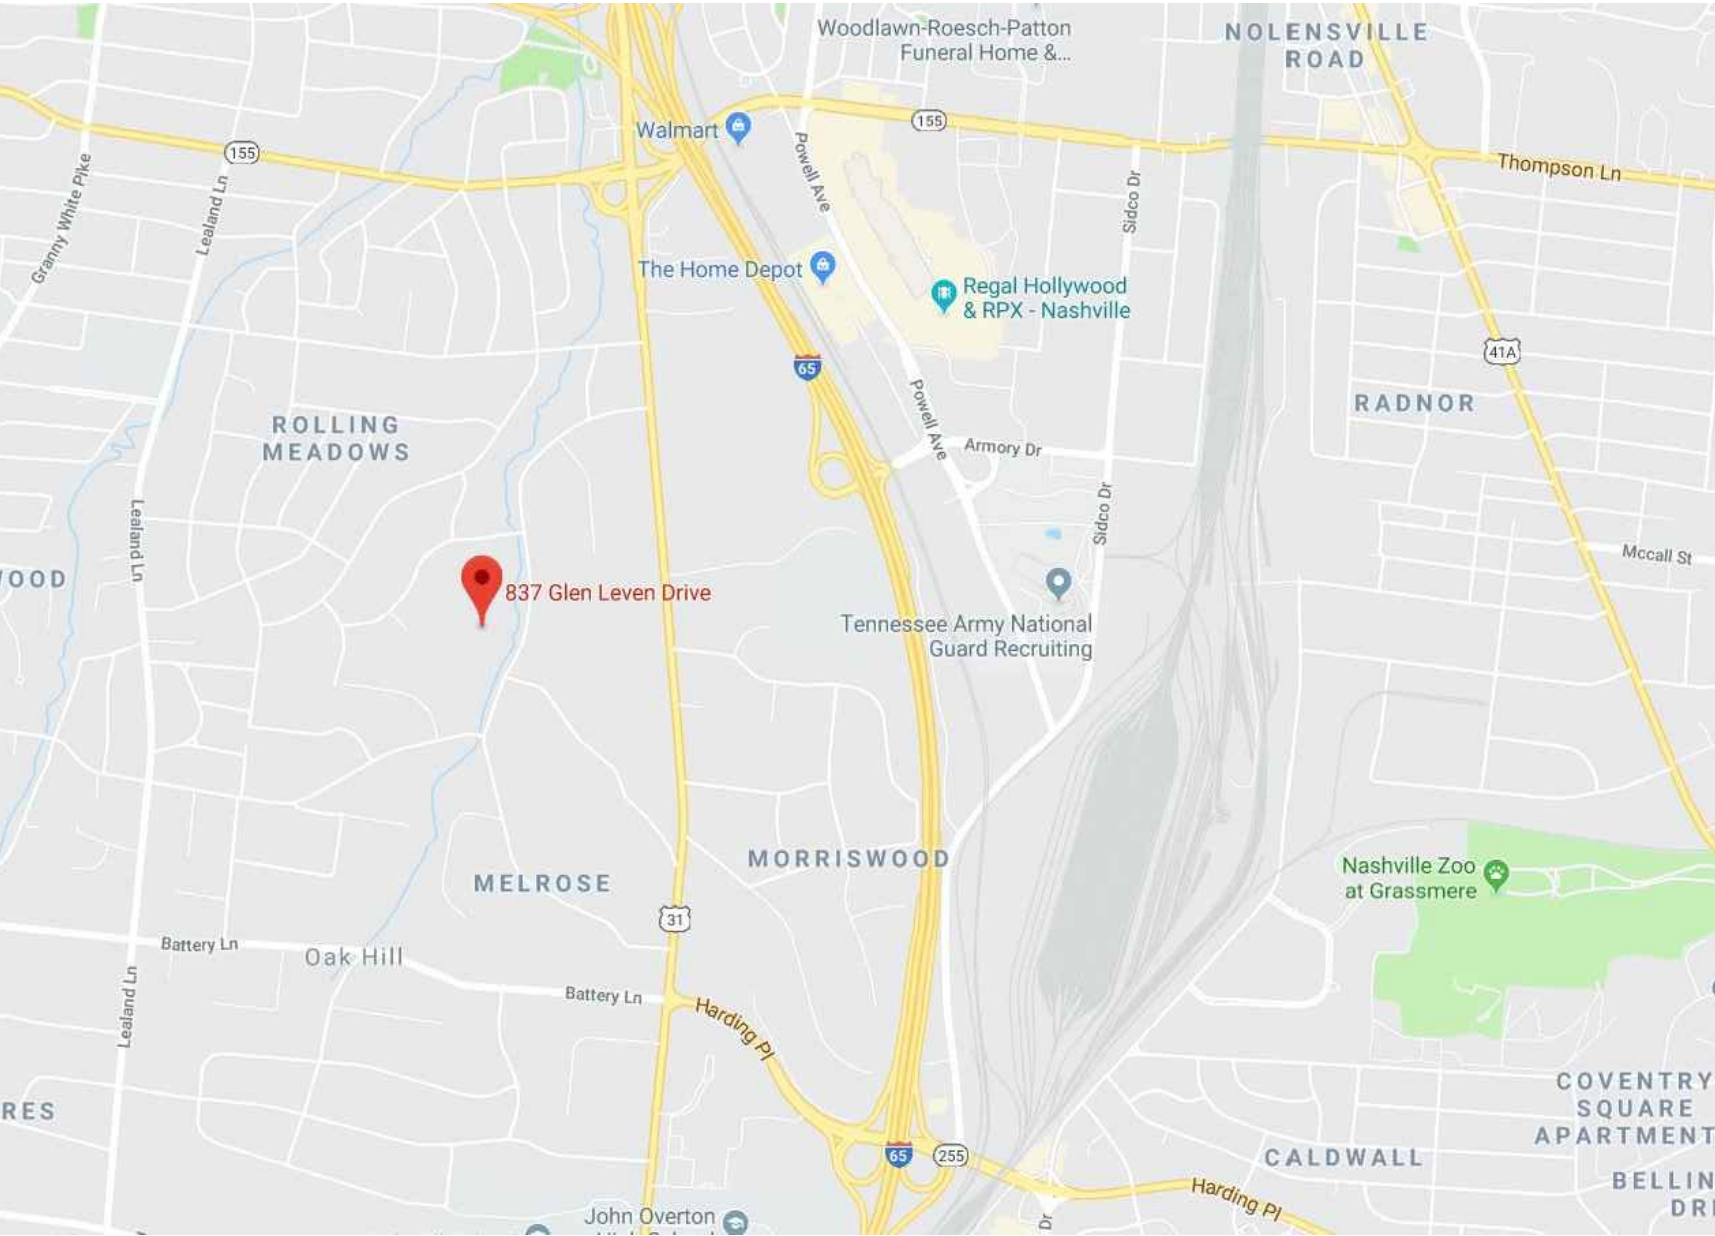

VICINITY MAP
NTS

837 AREA DATA		
BASEMENT FLOOR	486 SQ. FT. ±	
FIRST FLOOR	3699 SQ. FT.±	
SECOND FLOOR	2425 SQ. FT. ±	
ATTIC FLOOR	844 SQ. FT. ±	
GRAND TOTAL	7,454 SQ. FT. ±	

831 AREA DATA		
FIRST FLOOR	3339 SQ. FT. ±	
SECOND FLOOR	1703 SQ. FT. ±	
GRAND TOTAL	5,042 SQ. FT. ±	

DRAWING INDEX

C-1	COVER SHEET DRAWING INDEX
SL	SYMBOLS LEGEND
AB-1	837 FIRST FLOOR PLAN
AB-2	837 SECOND FLOOR PLAN
AB-3	837 BASEMENT & ATTIC PLAN
AB-4	837 ROOF PLAN
AB-5	837 EXTERIOR ELEVATIONS
AB-6	837 EXTERIOR ELEVATIONS
AB-7	831 FIRST FLOOR PLAN
AB-8	831 SECOND FLOOR PLAN
AB-9	831 ROOF PLAN
AB-10	831 EXTERIOR ELEVATIONS

AS BUILT

PROFESSIONALS

www.asbuiltprofessionals.com

A DIVISION OF:

AEC

CONSULTANTS INC

844.272.8458

844 AS BUILT

© 2019 AEC CONSULTANTS, INC.

ARCHITECTURAL AS BUILT

Nashville, TN 37204

01	100% SUBMISSION	SEE COVER SHEET
NO.	ISSUES REVISIONS	DATE

COVER SHEET


HL	PROJECT MANAGER
HL	PROJECT DIRECTOR
012317-1	PROJECT NUMBER
	SCALE
CL	DRAWN BY
	SHEET NUMBER

C1


[illegible]

HL	PROJECT MANAGER
HL	PROJECT DIRECTOR
012317-1	PROJECT NUMBER
1/4"=1'-0"	SCALE
CL	DRAWN BY
	SHEET NUMBER

SHEET NUMBER

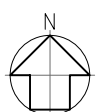

FIRST FLOOR

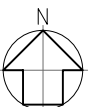

SHEET NUMBER


SHEET NUMBER

01	100% SUBMISSION	SEE COVER SHEET
NO.	ISSUES REVISIONS	DATE

837 SECOND FLOOR PLAN


HL	PROJECT MANAGER
HL	PROJECT DIRECTOR
012317-1	PROJECT NUMBER
1/4"=1'-0"	SCALE
CL	DRAWN BY

AB-2

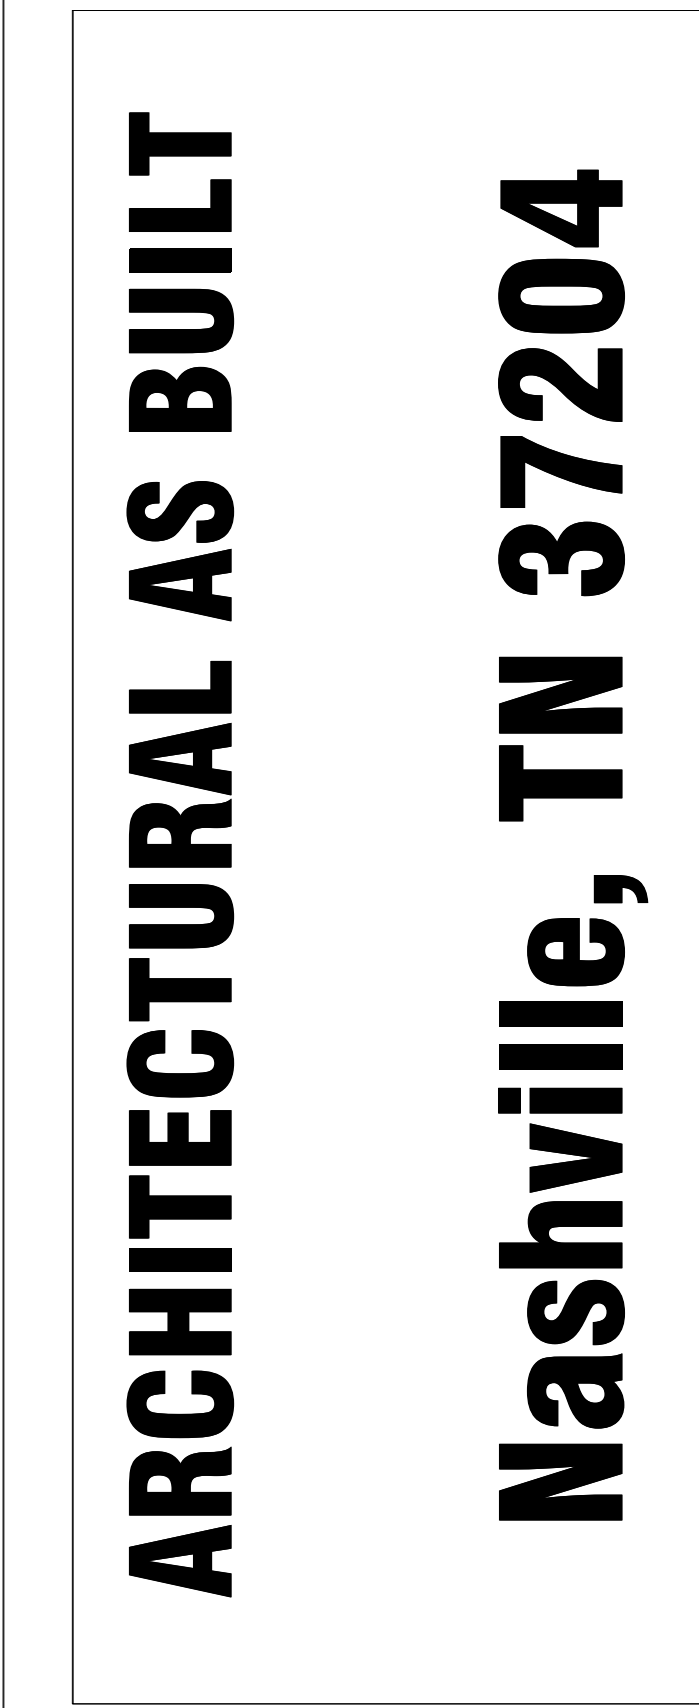
[illegible]

HL	PROJECT MANAGER
HL	PROJECT DIRECTOR
012317-1	PROJECT NUMBER
1/4"=1'-0"	SCALE
CL	DRAWN BY
	SHEET NUMBER


AB-3

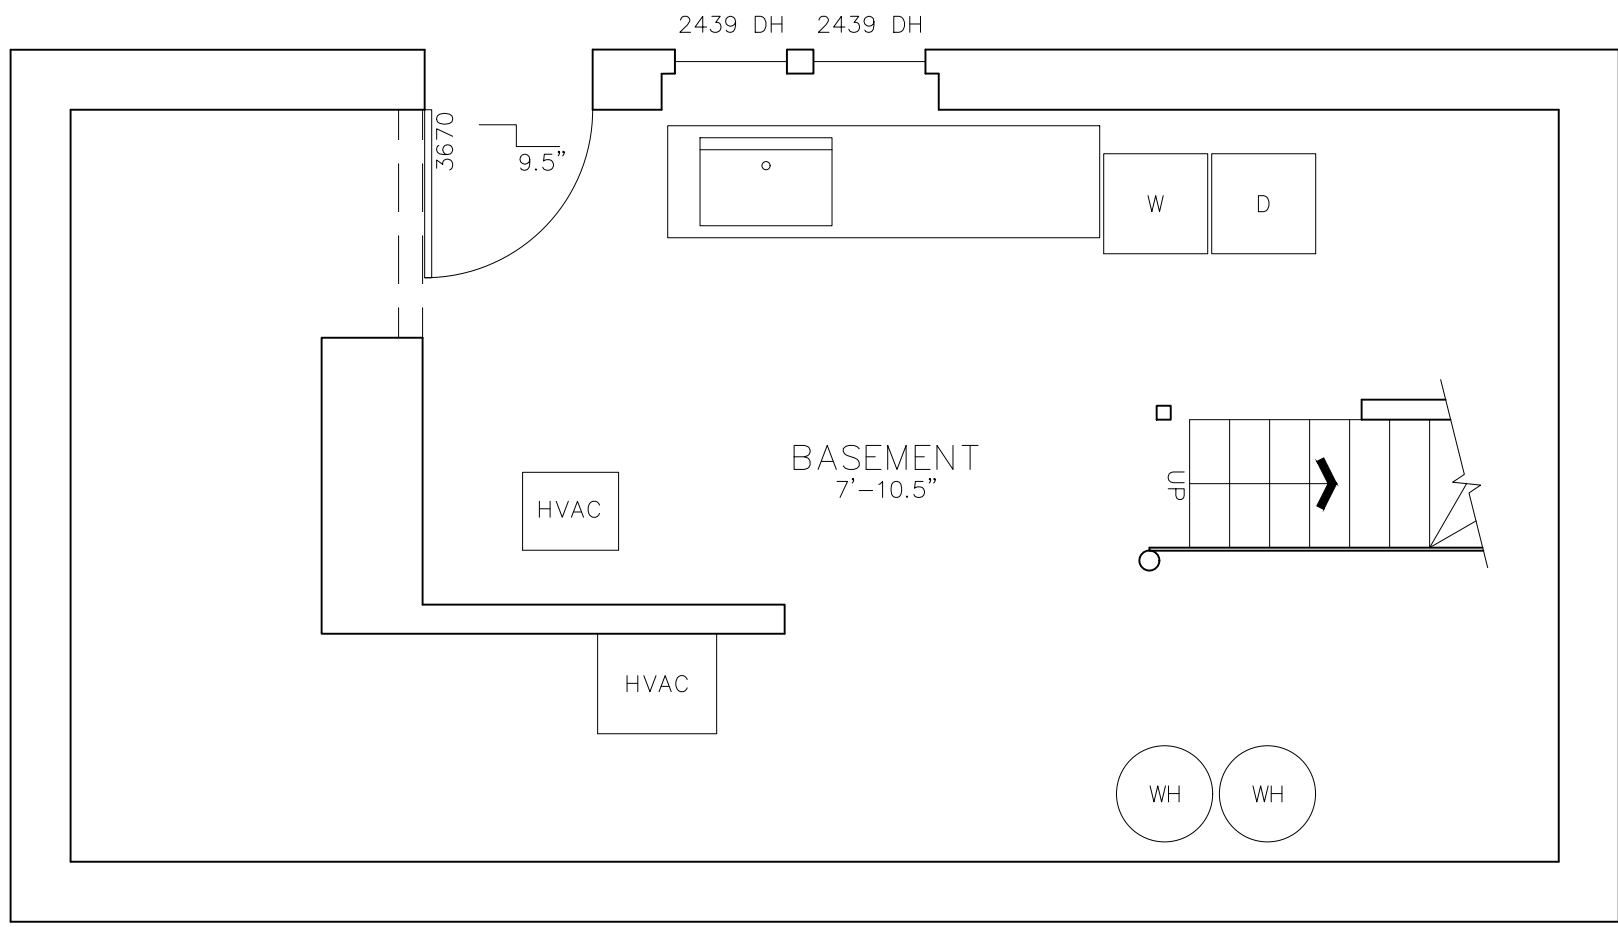

 **BASEMENT PLAN**

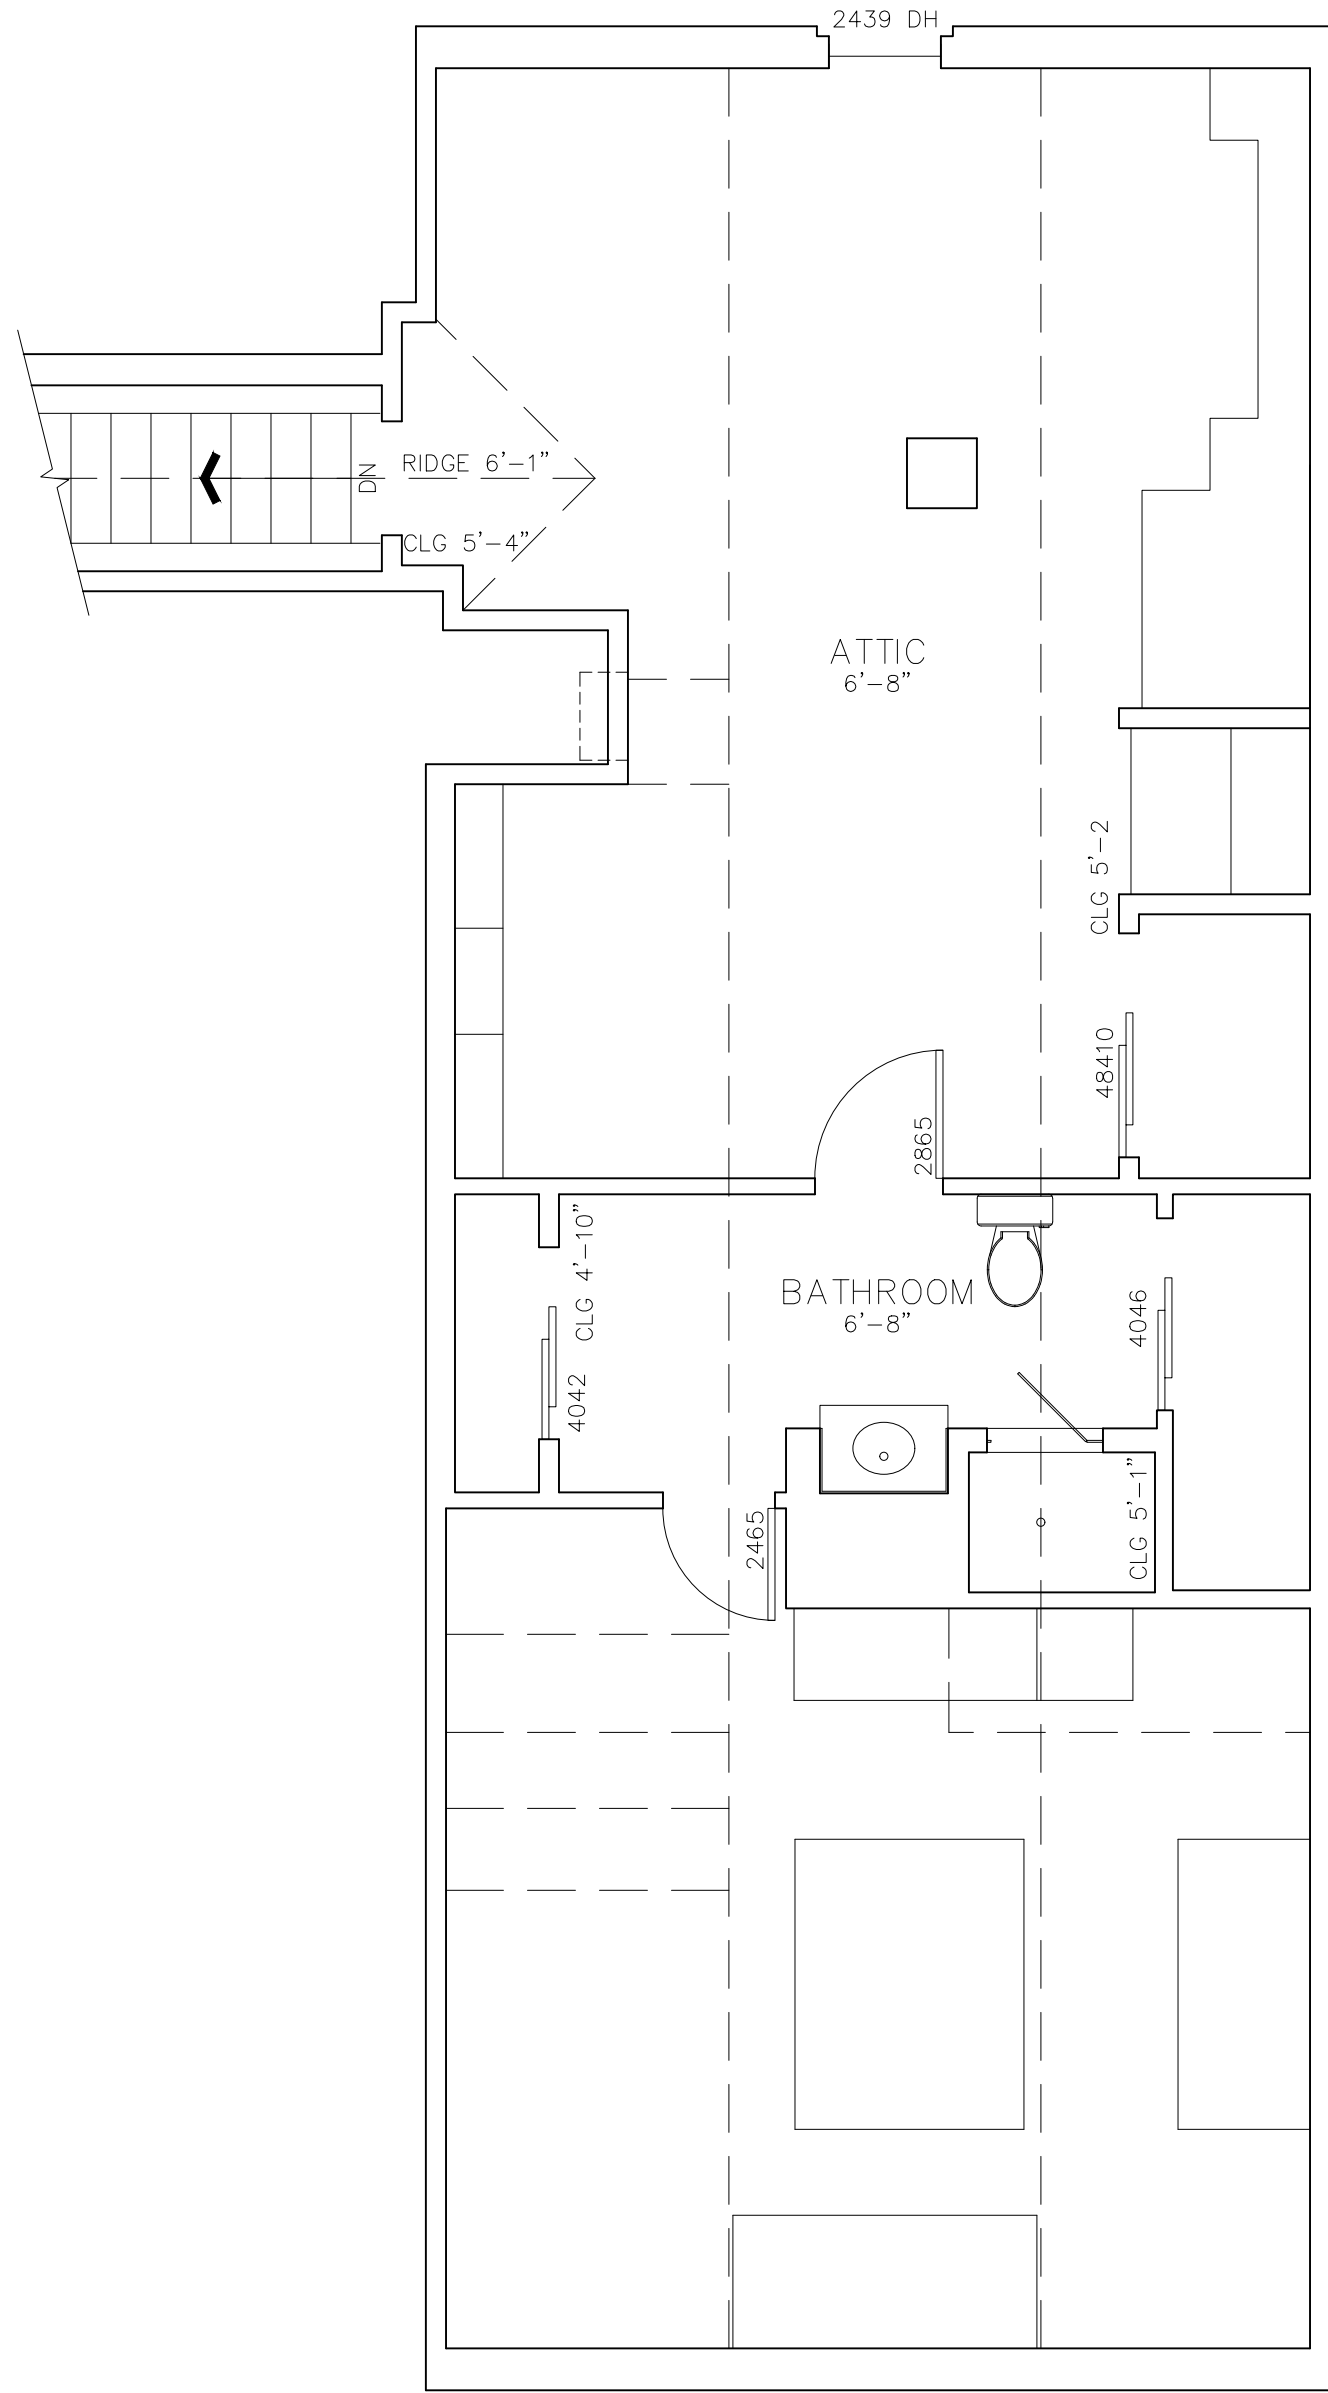

ATTIC PLAN

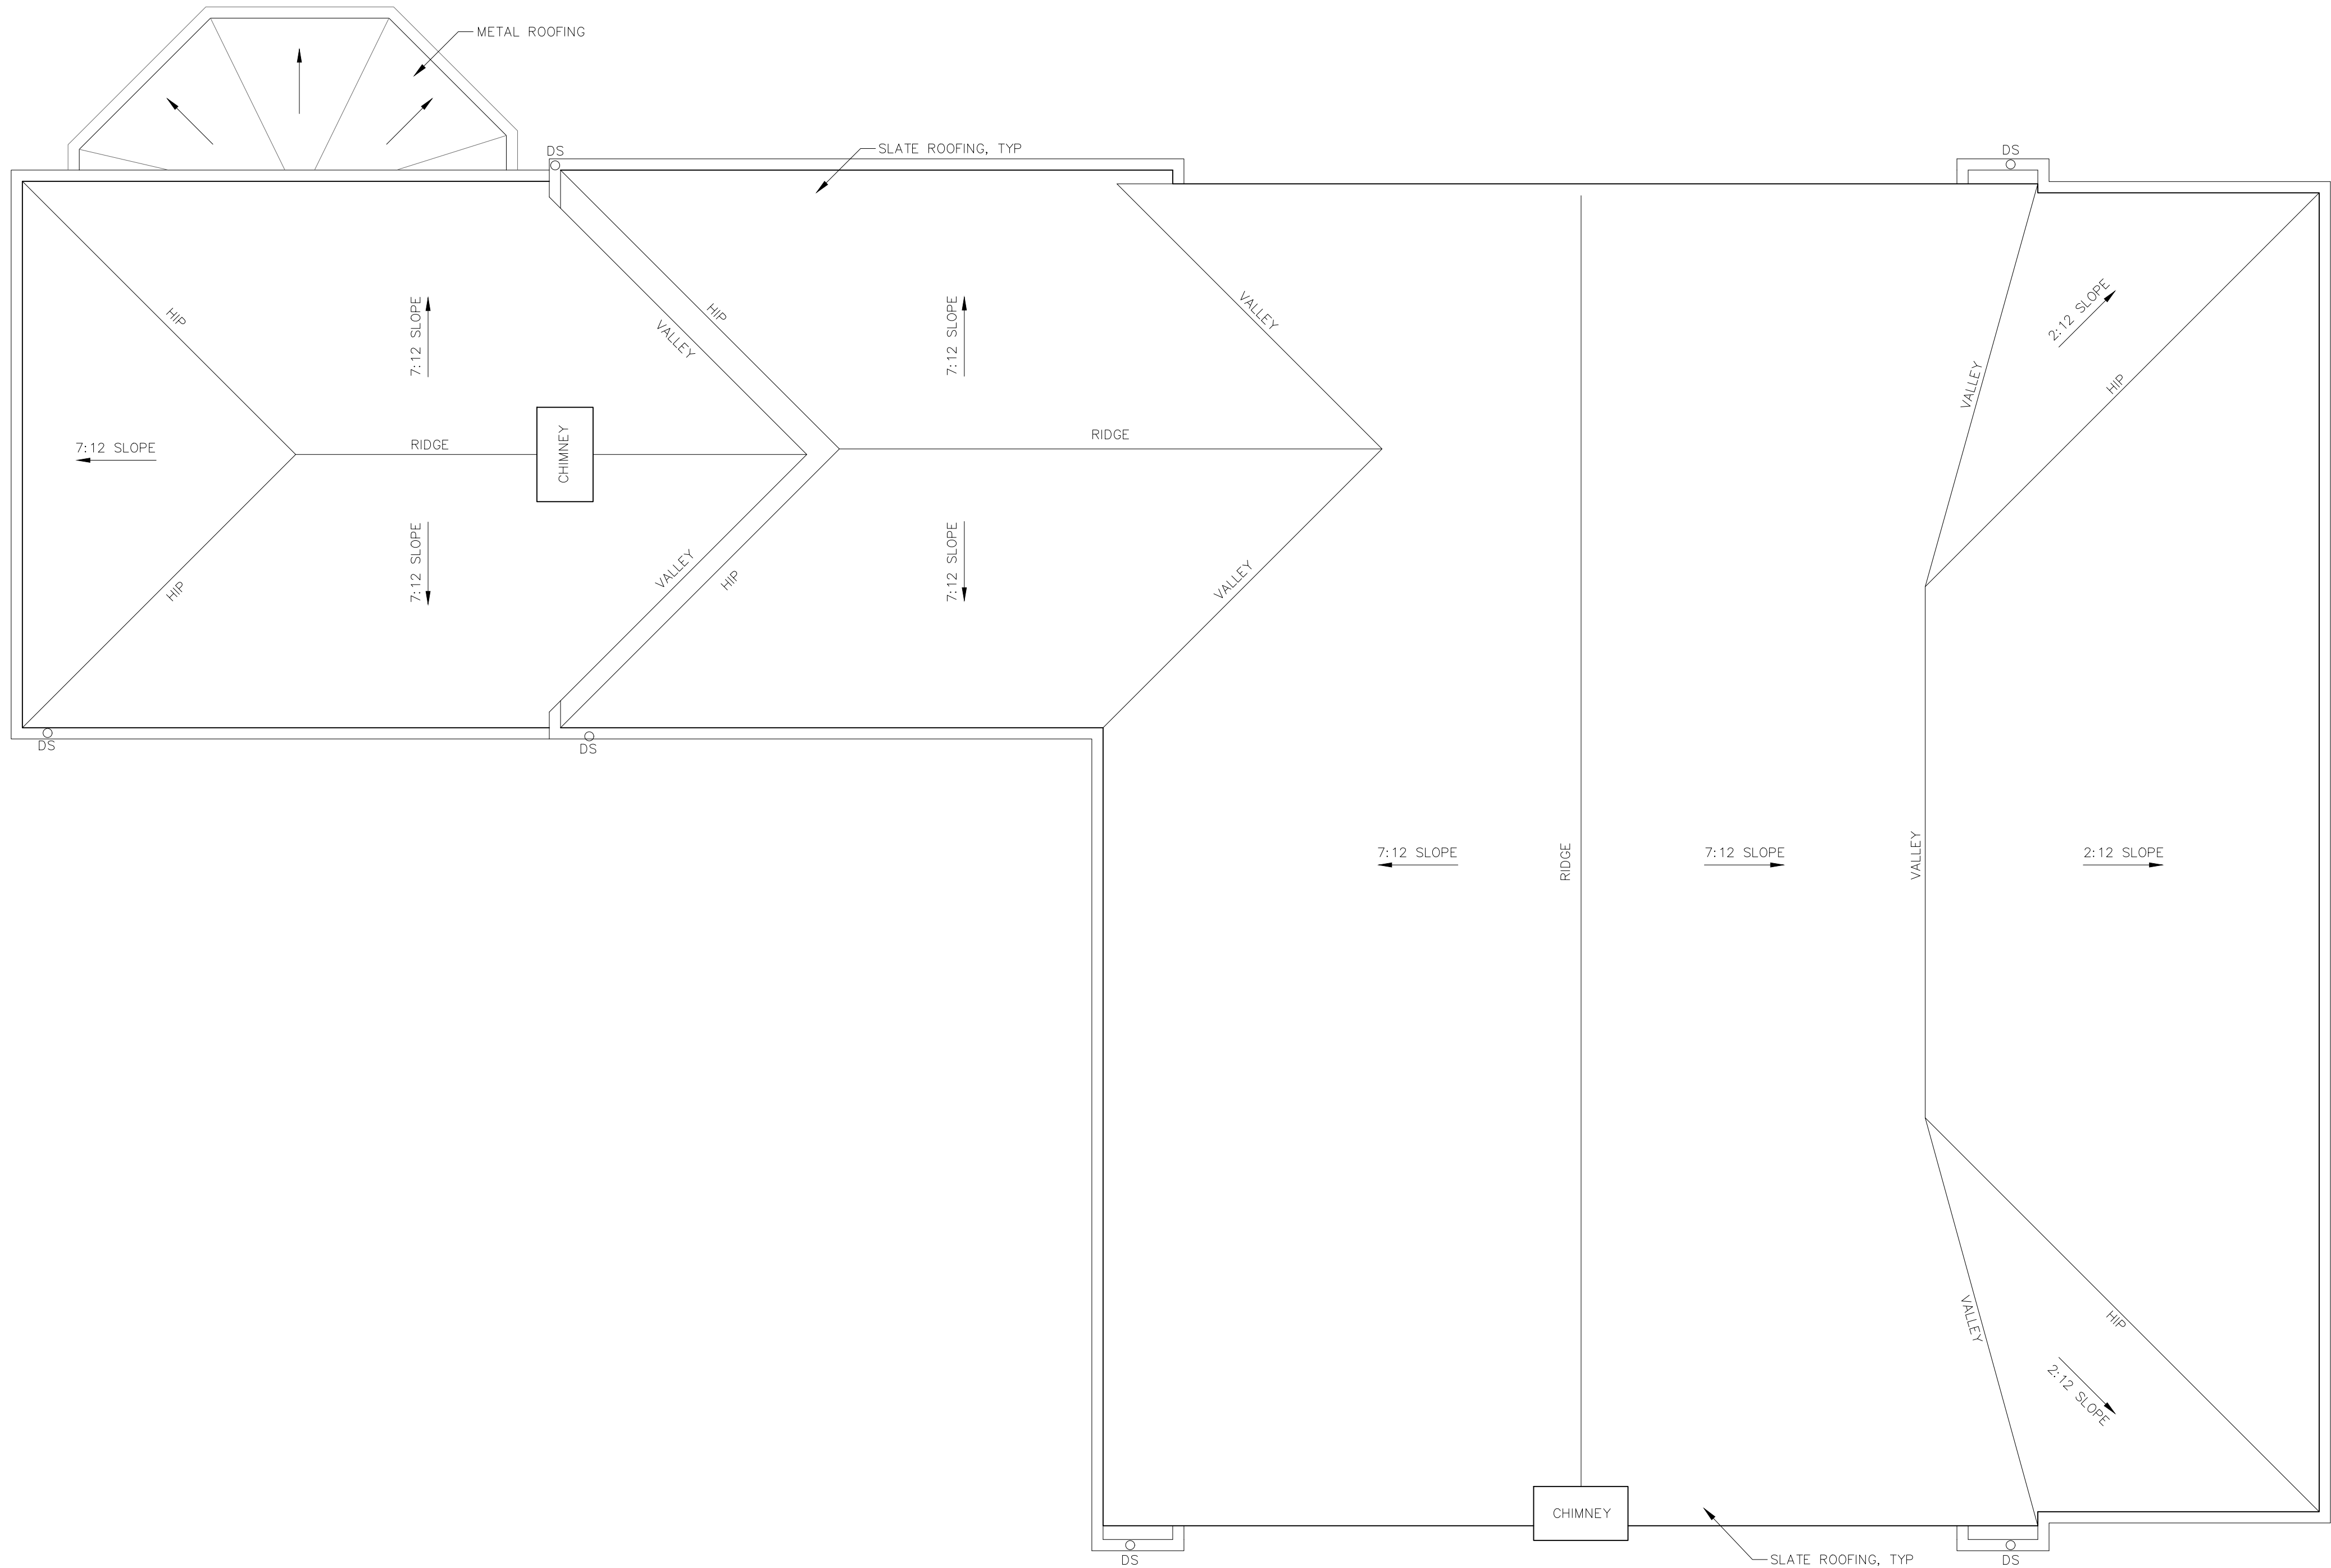

As BUILT

PROFESSIONALS

www.asbuiltprofessionals.com

A DIVISION OF:

AEC

CONSULTANTS INC

844.272.8458

844 A S B U I L T

© 2019 AEC CONSULTANTS INC

ARCHITECTURAL AS BUILT


Nashville, TN 37204

01	100% SUBMISSION	SEE COVER SHEET
NO.	ISSUES REVISIONS	DATE
SHEET TITLE		
837 ROOF PLAN		
HL		PROJECT MANAGER
HL		PROJECT DIRECTOR
012317-1		PROJECT NUMBER
1/4"=1'-0"		SCALE
CL		DRAWN BY
SHEET NUMBER		
AB-4		



Nashville, TN 37204

AB-6

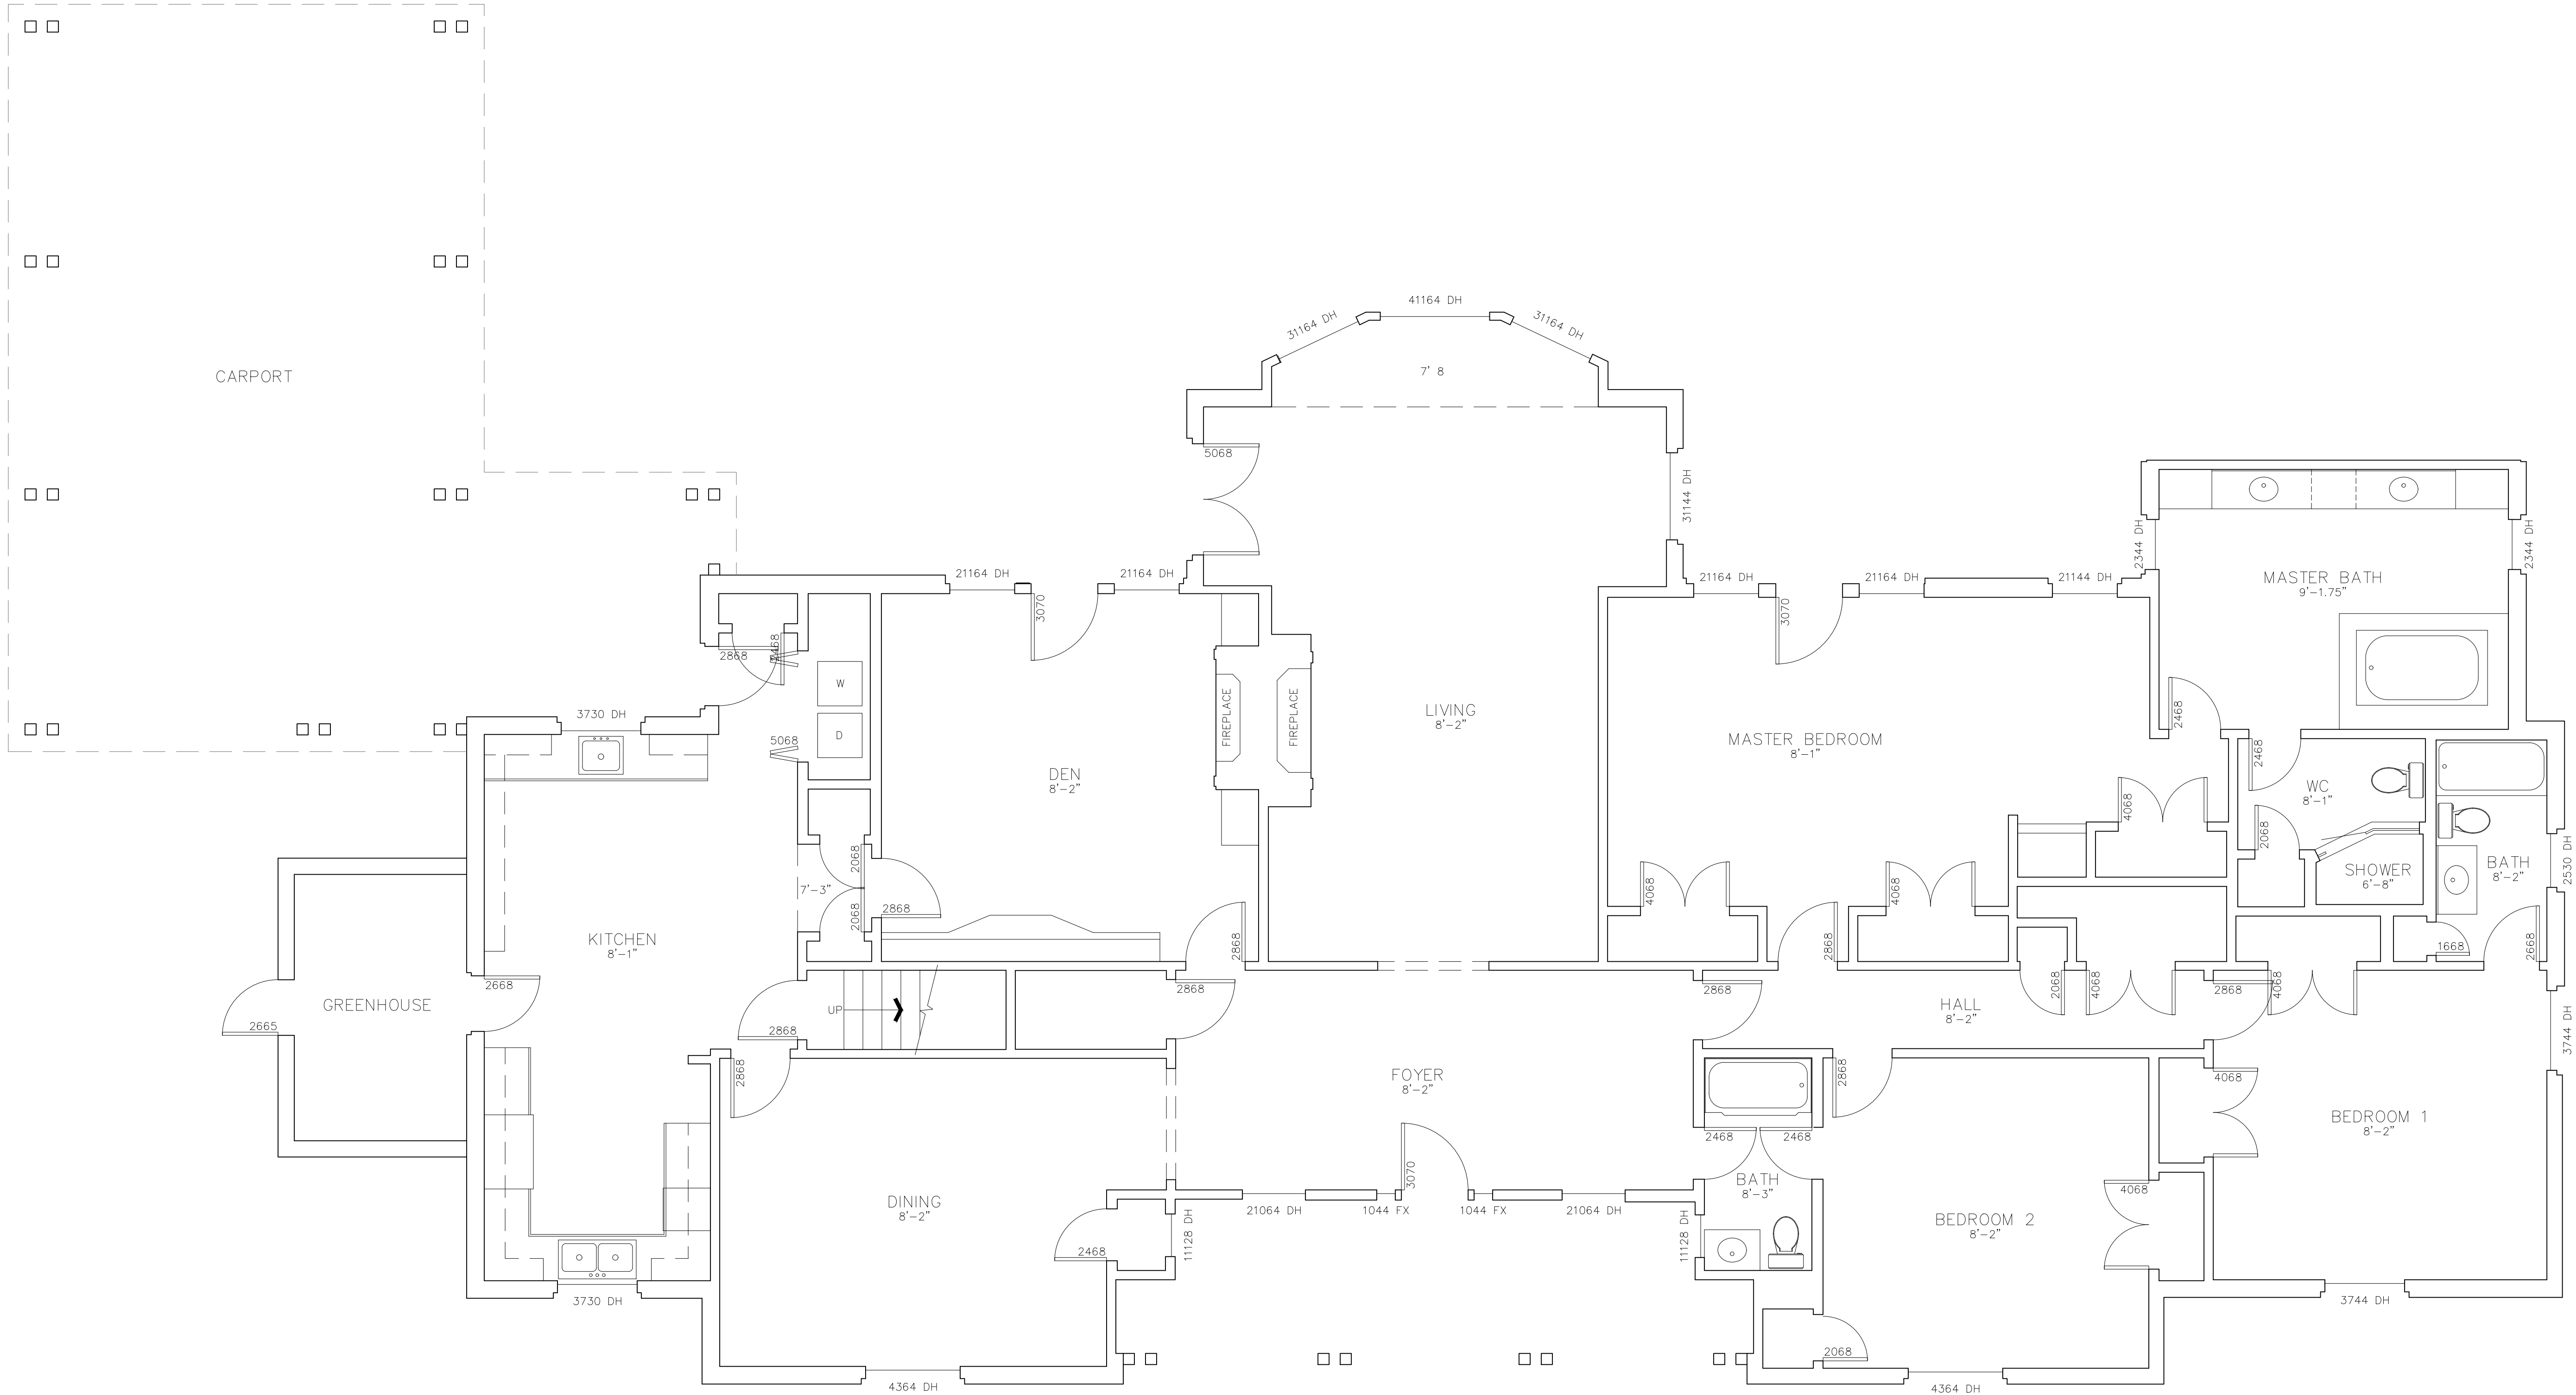

ARCHITECTURAL AS BUILT
Nashville, TN 37204


01	100% SUBMISSION	SEE COVER SHEET
NO.	ISSUES REVISIONS	DATE
		SHEET TITLE
831 FIRST FLOOR PLAN		
HL	PROJECT MANAGER	
HL	PROJECT DIRECTOR	
012317-1	PROJECT NUMBER	
1/4"=1'-0"	SCALE	
CL	DRAWN BY	
		SHEET NUMBER

[illegible]


HL	PROJECT MANAGER
HL	PROJECT DIRECTOR
012317-1	PROJECT NUMBER
1/4"=1'-0"	SCALE
CL	DRAWN BY
	SHEET NUMBER

SHEET NUMBER



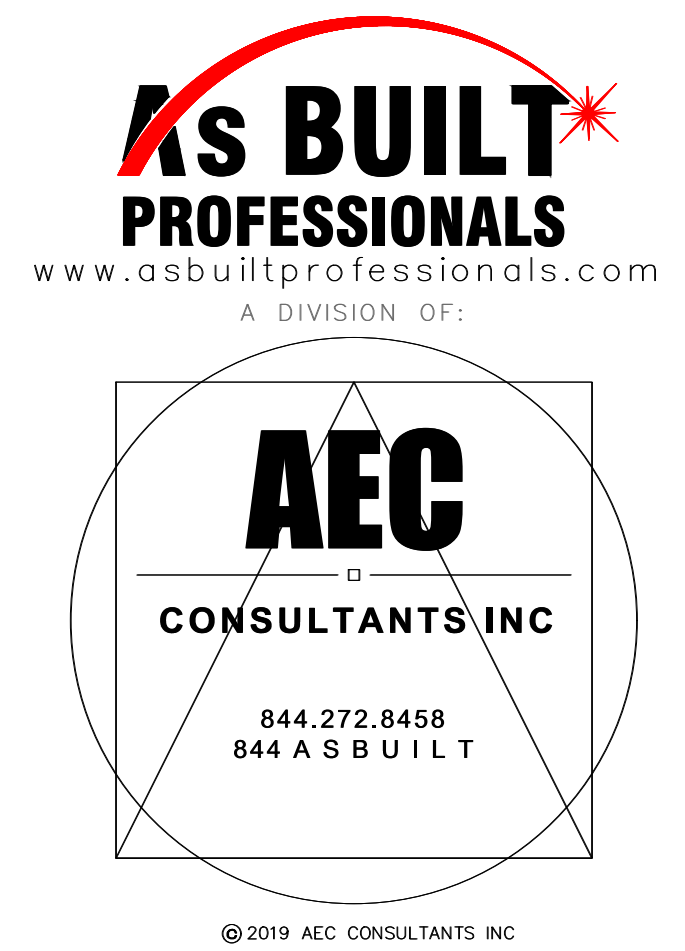


ARCHITECTURAL AS BUILT

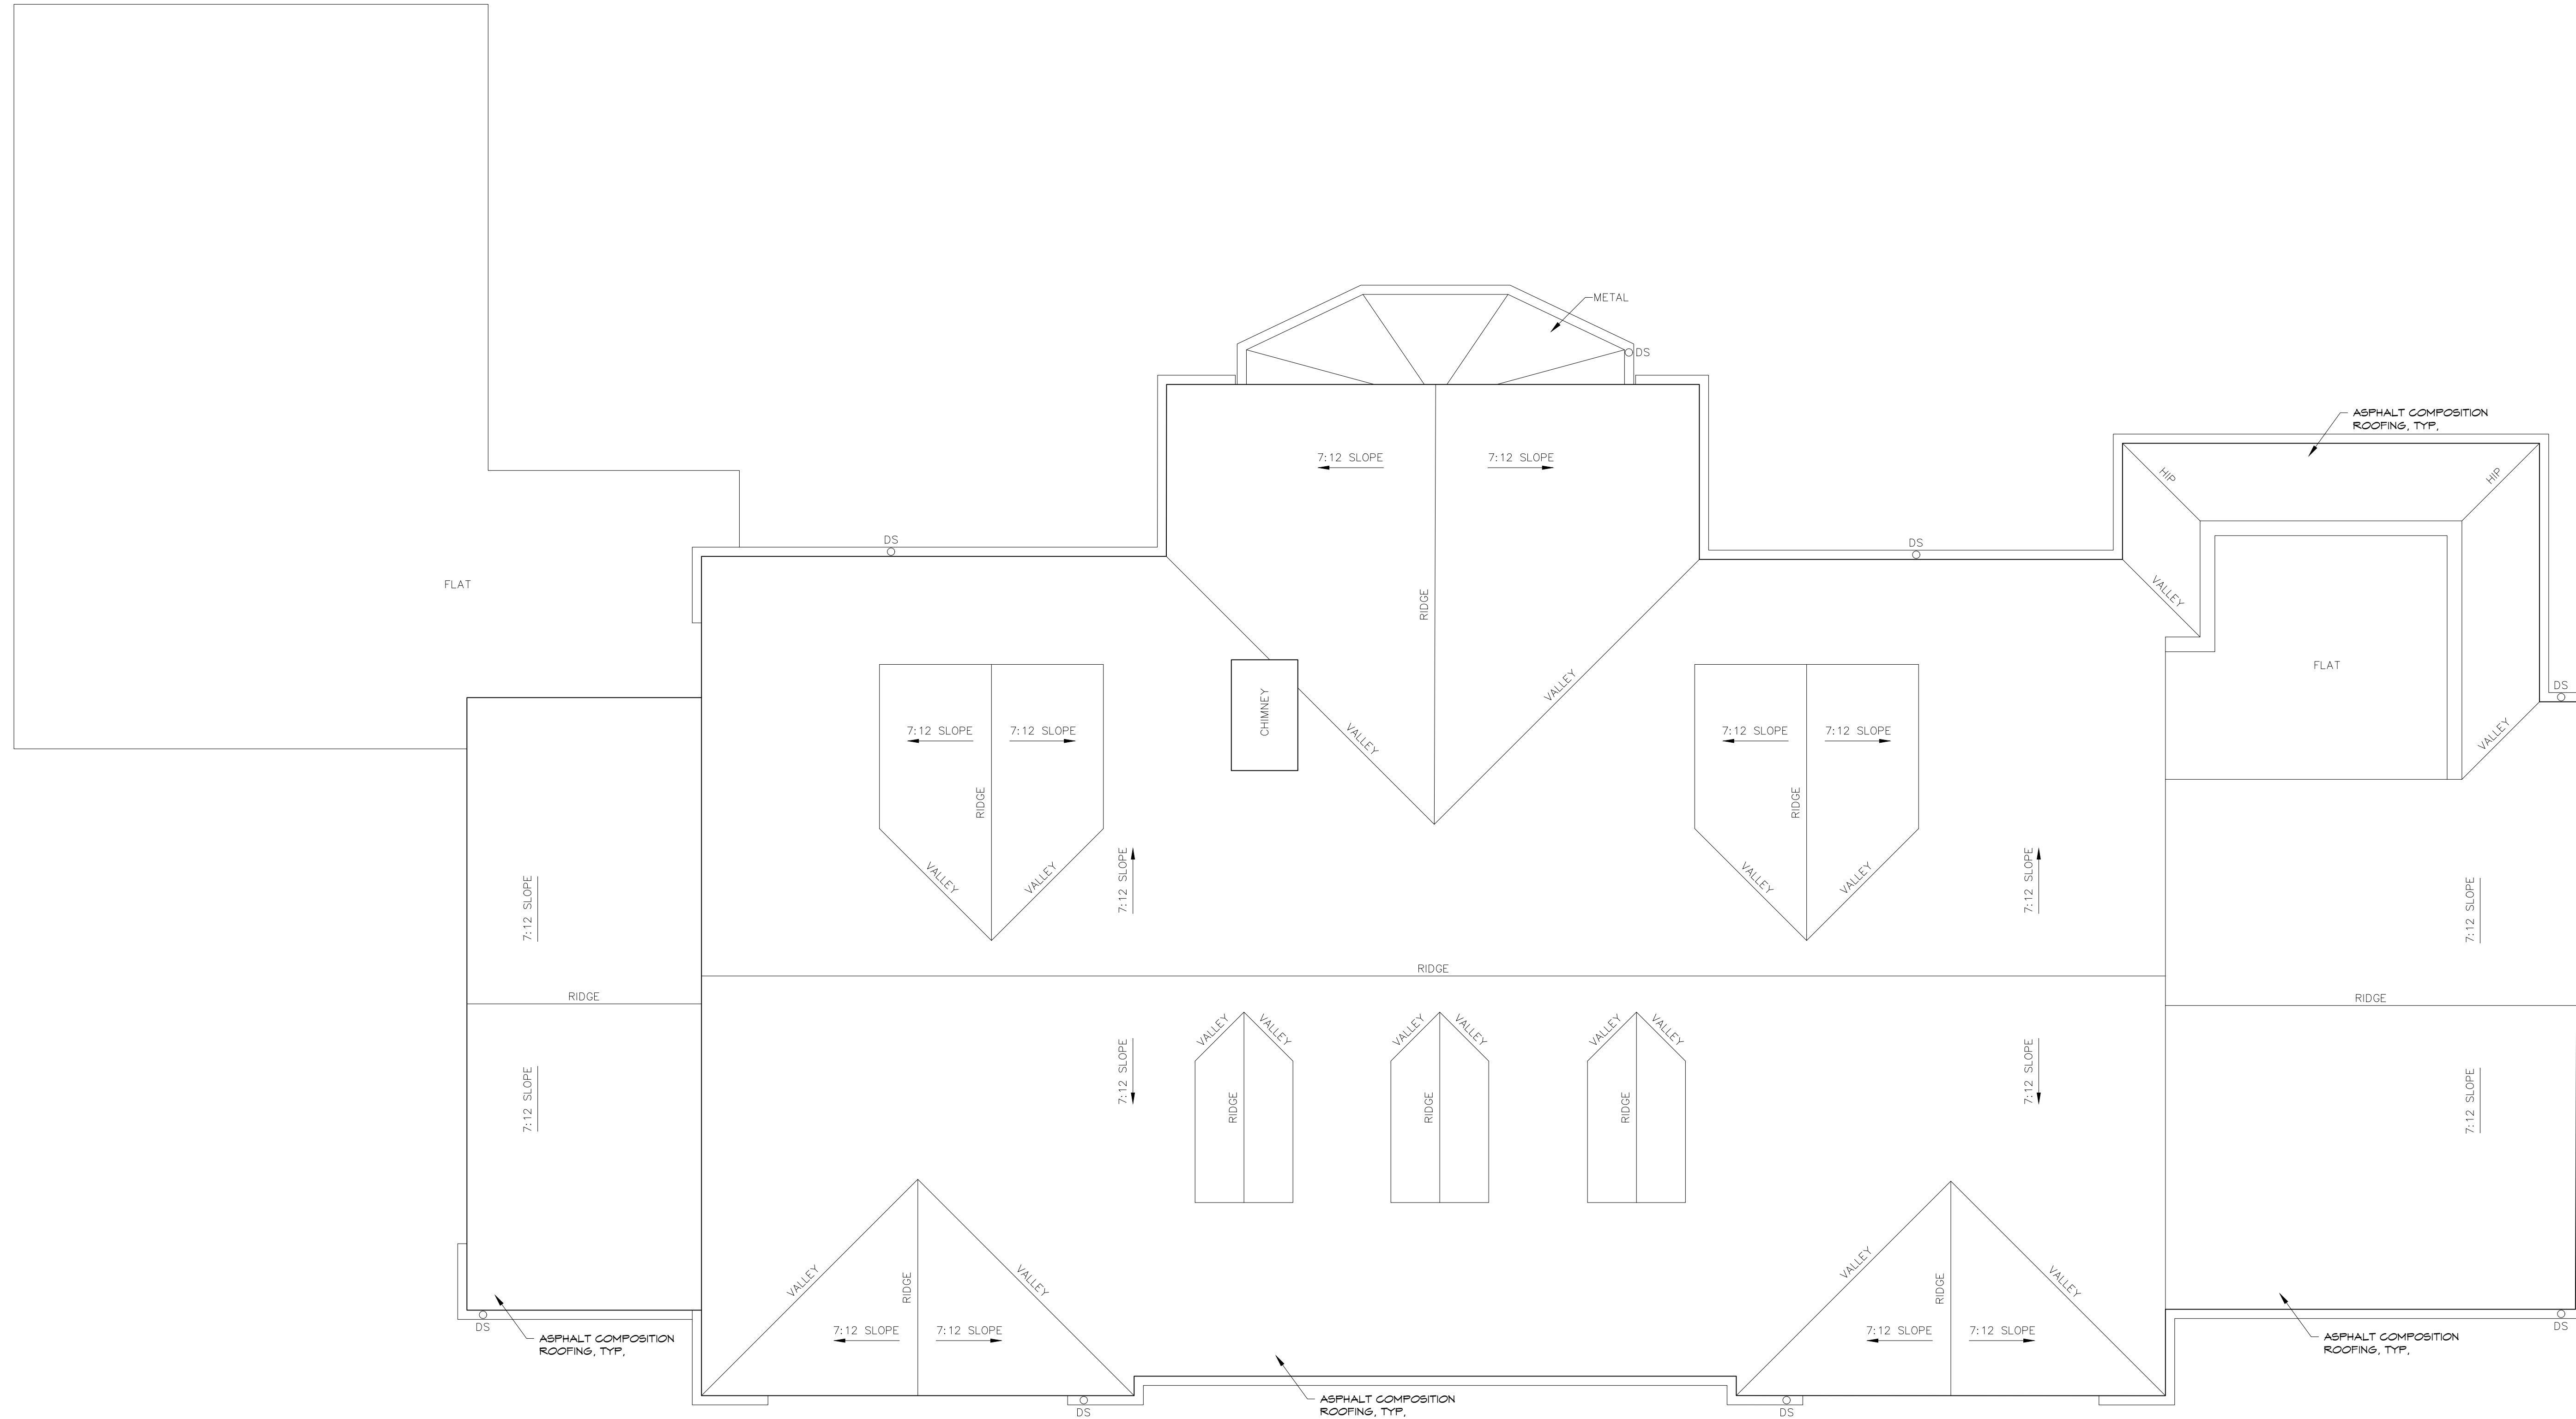

ROOF PLAN

01	100% SUBMISSION	SEE COVER SHEET
NO.	ISSUES REVISIONS	DATE
		SHEET TITLE
831 ROOF PLAN		
HL	PROJECT MANAGER	
HL	PROJECT DIRECTOR	
012317-1	PROJECT NUMBER	
1/4"=1'-0"		SCALE
CL	DRAWN BY	
		SHEET NUMBER
AB-9		

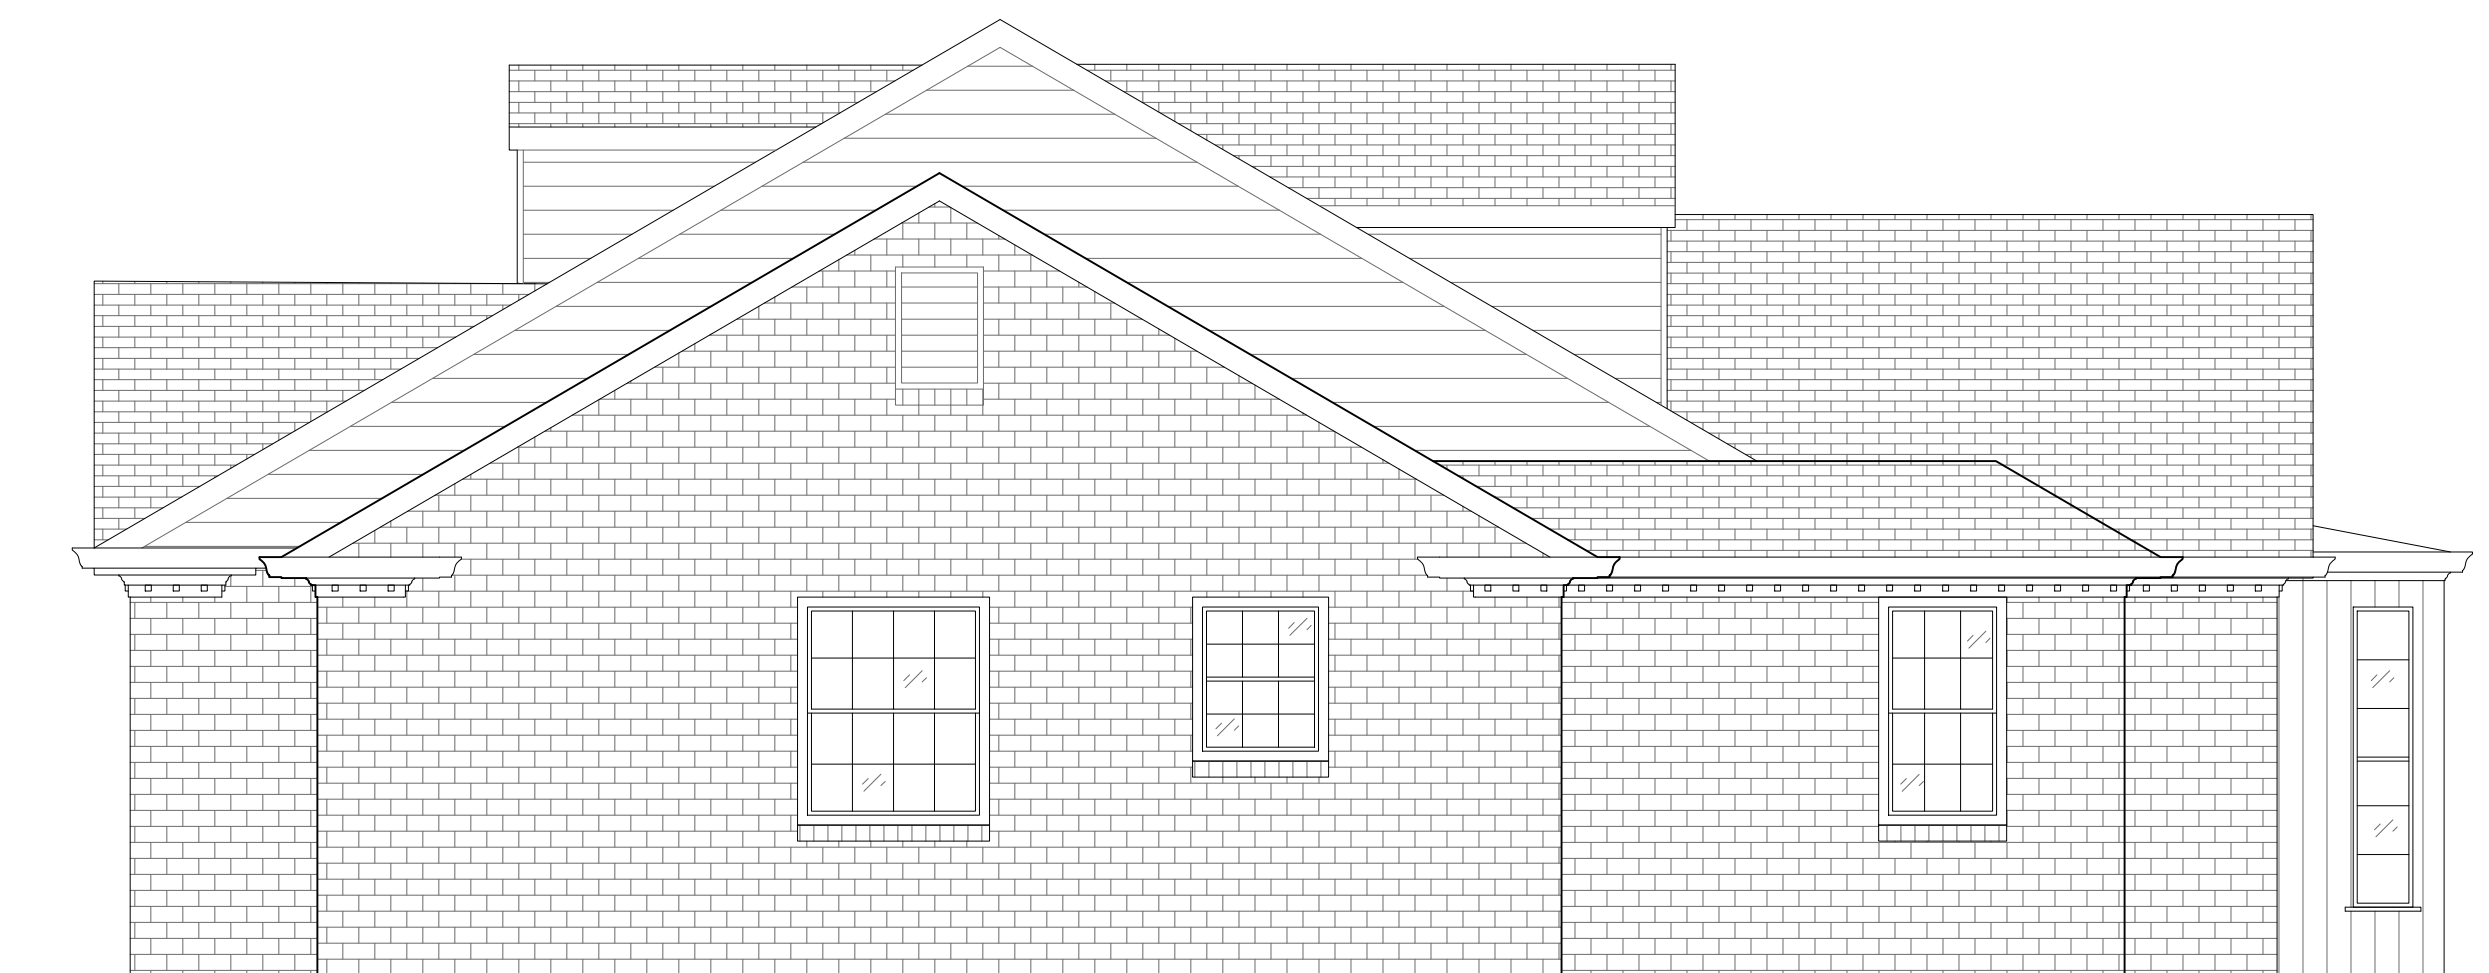

© 2019 AEC CONSULTANTS INC

ARCHITECTURAL AS BUILT

Nashville, TN 37204

01	100% SUBMISSION	SEE COVER SHEET
NO.	ISSUES REVISIONS	DATE
		SHEET TITLE

831 EXTERIOR ELEVATIONS

HL	PROJECT MANAGER
HL	PROJECT DIRECTOR
012317-1	PROJECT NUMBER
1/4"=1'-0"	SCALE
CL	DRAWN BY
	SHEET NUMBER

AB-10