
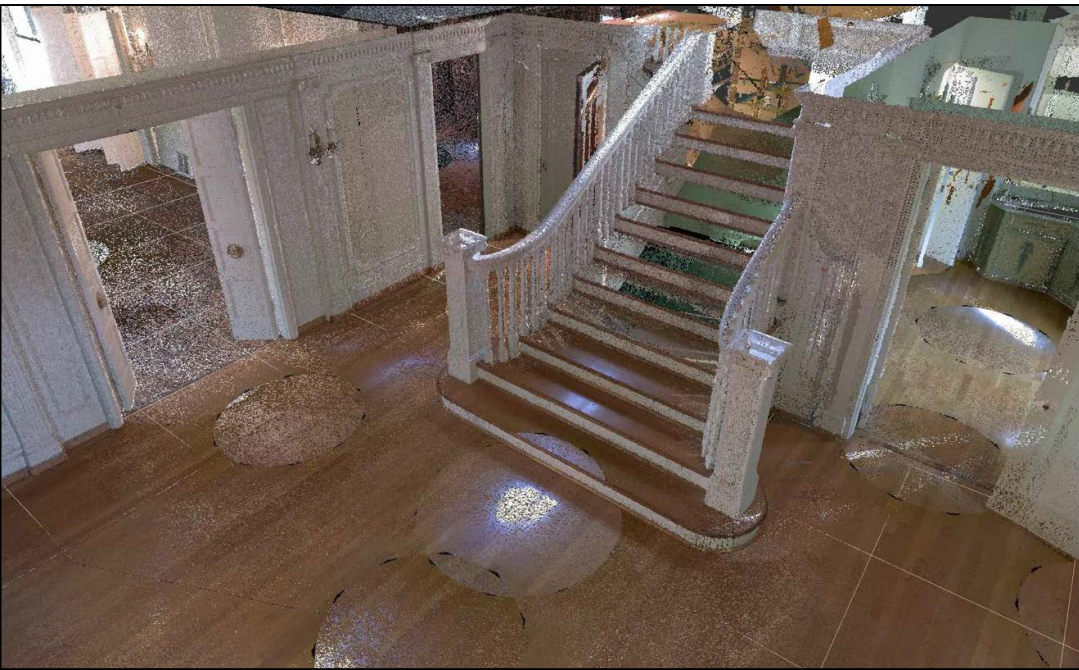


AS-BUILT DOCUMENTATION

ITALIAN RENAISSANCE RESIDENCE


Los Angeles, CA 90004

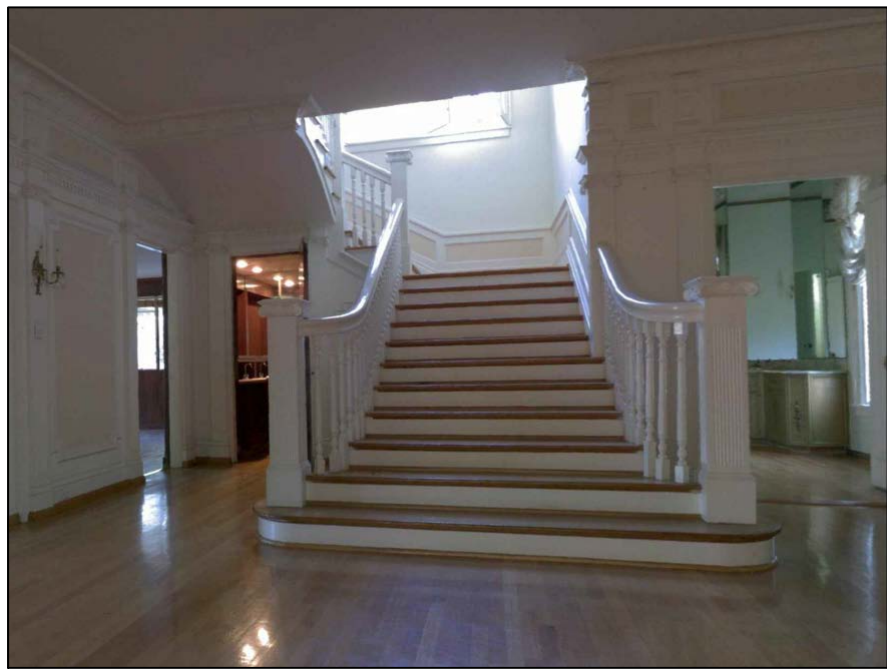

3D LIDAR POINT CLOUD 23

DRAWING INDEX

- C-1 COVER SHEET | DRAWING INDEX
- SL SYMBOLS LEGEND
- AB-1 EXTERIOR ELEVATIONS (RESIDENC
- AB-2 EXTERIOR ELEVATIONS (RESIDENC
- AB-3 BASEMENT FLOOR PLAN
- AB-4 FIRST FLOOR PLAN
- AB-5 SECOND FLOOR PLAN
- AB-6 ATTIC FLOOR PLAN
- AB-7 POOL CABANA FLOOR PLAN
- AB-8 GARAGE FIRST FLOOR PLAN
- AB-9 GARAGE SECOND FLOOR PLAN
- AB-10 ROOF PLAN (RESIDENCE)

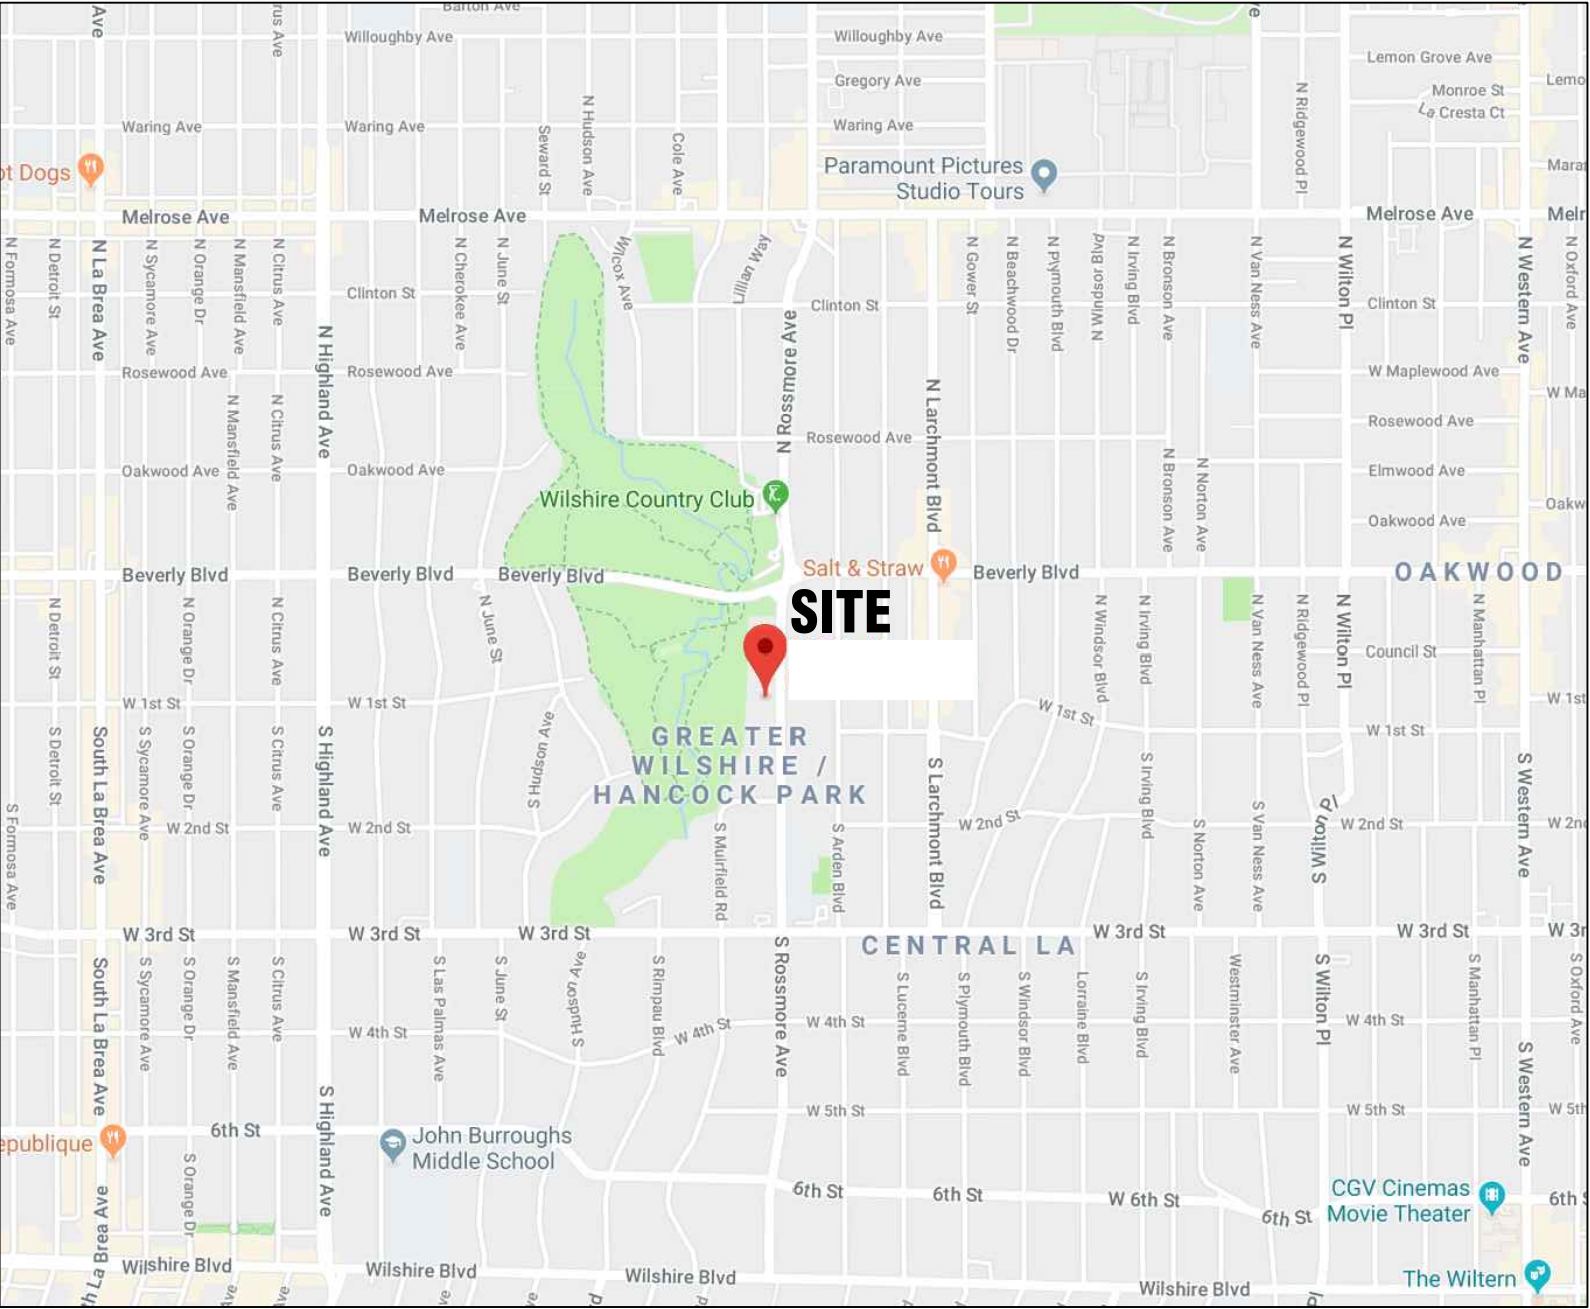

VICINITY MAP NTS

AREA DATA	
BASEMENT	576 S.F. ±
FIRST FLOOR	3,935 S.F. ±
SECOND FLOOR	3,288 S.F. ±
ATTIC	771 S.F. ±
CABANA	1,664 S.F. ±
GARAGE	1,614 S.F. ±
GRAND TOTAL	11,848 S.F. ±

As BUILT

PROFESSIONALS

www.asbuiltprofessionals.com

A DIVISION OF:

AEC

CONSULTANTS

INC

844.272.8458

844 ASBUILT

© 2018 AEC CONSULTANTS INC.

ARCHITECTURAL AS BUILT ITALIAN RENAISSANCE RESIDENCE

Los Angeles, CA 90004

COVER SHEET

HL	PROJECT MANAGER
HL	PROJECT DIRECTOR
012518-1	PROJECT NUMBER
	SCALE
CL	DRAWN BY
	SHEET NUMBER

C-1

100% SUBMITTAL


SL




01	100% SUBMISSION	SEE COVER SHEET
NO.	ISSUES REVISIONS	DATE
		SHEET TITLE
FRONT / REAR ELEVATIONS		
HL	PROJECT MANAGER	
HL	PROJECT DIRECTOR	
012518-1	PROJECT NUMBER	
1/4"=1'-0"		
CL	DRAWN BY	
		SHEET NUMBER



01	100% SUBMISSION	SEE COVER SHEET
NO.	ISSUES REVISIONS	DATE
		SHEET TITLE
SIDE ELEVATIONS		
H/L		PROJECT MANAGER
H/L		PROJECT DIRECTOR
012518-1		PROJECT NUMBER
1/4"=1'-0"		SCALE
CL		DRAWN BY
		SHEET NUMBER
AB-2		

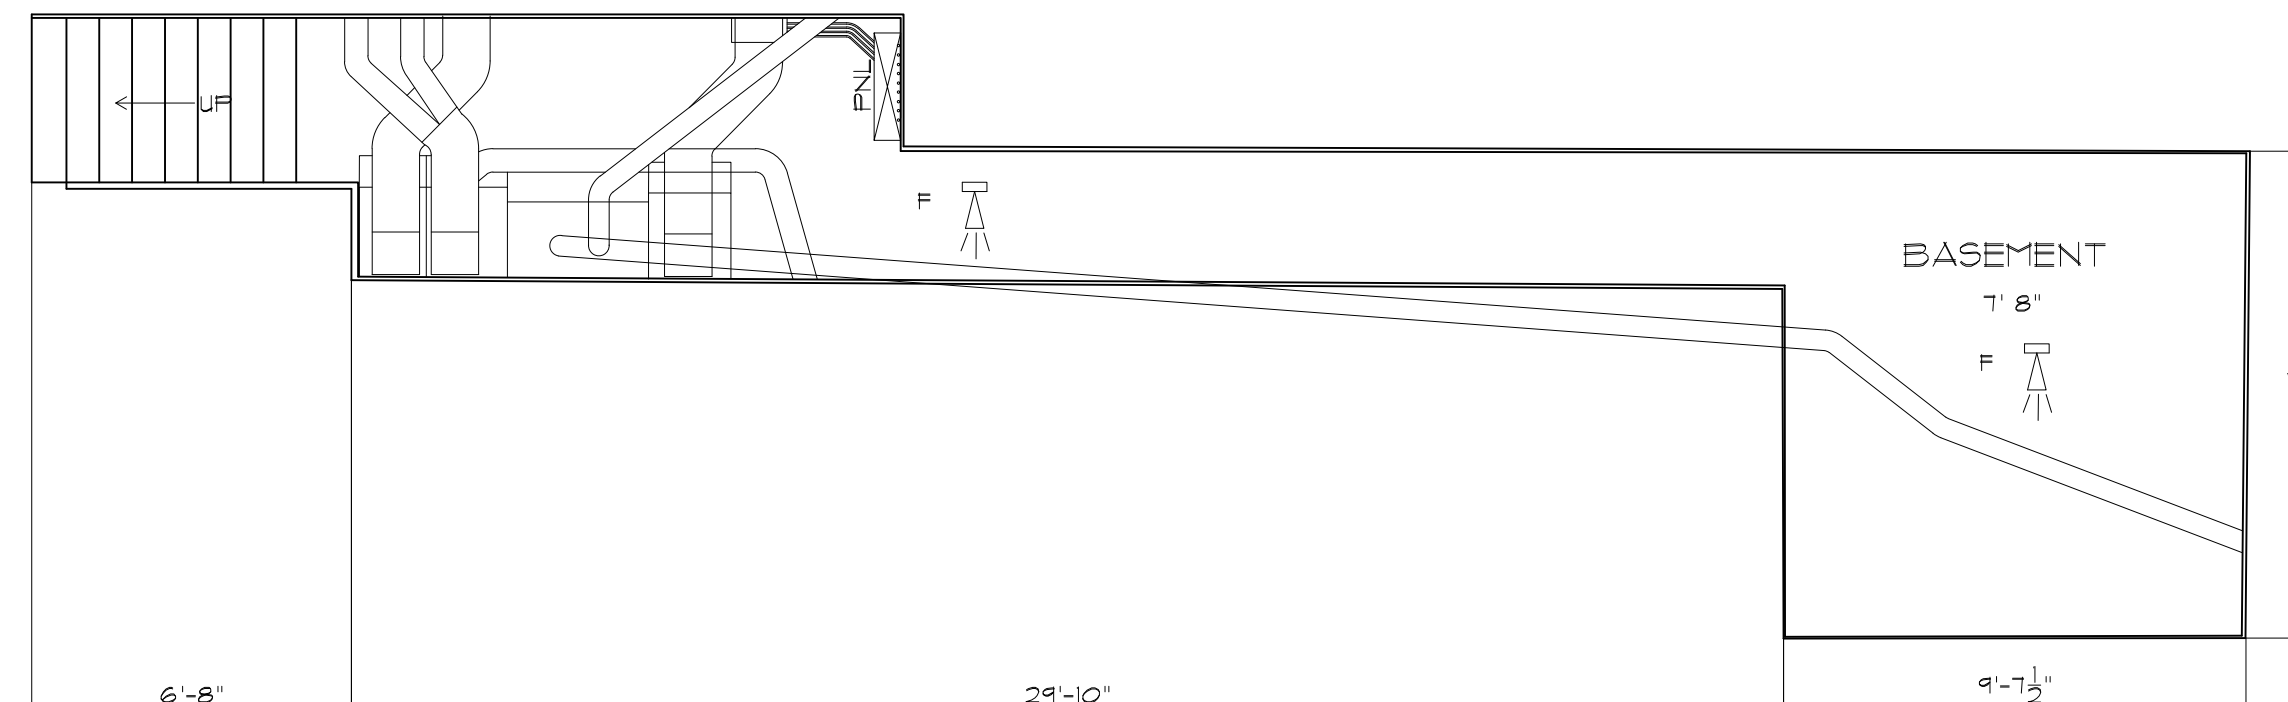

BASEMENT 1 FLOOR PLAN

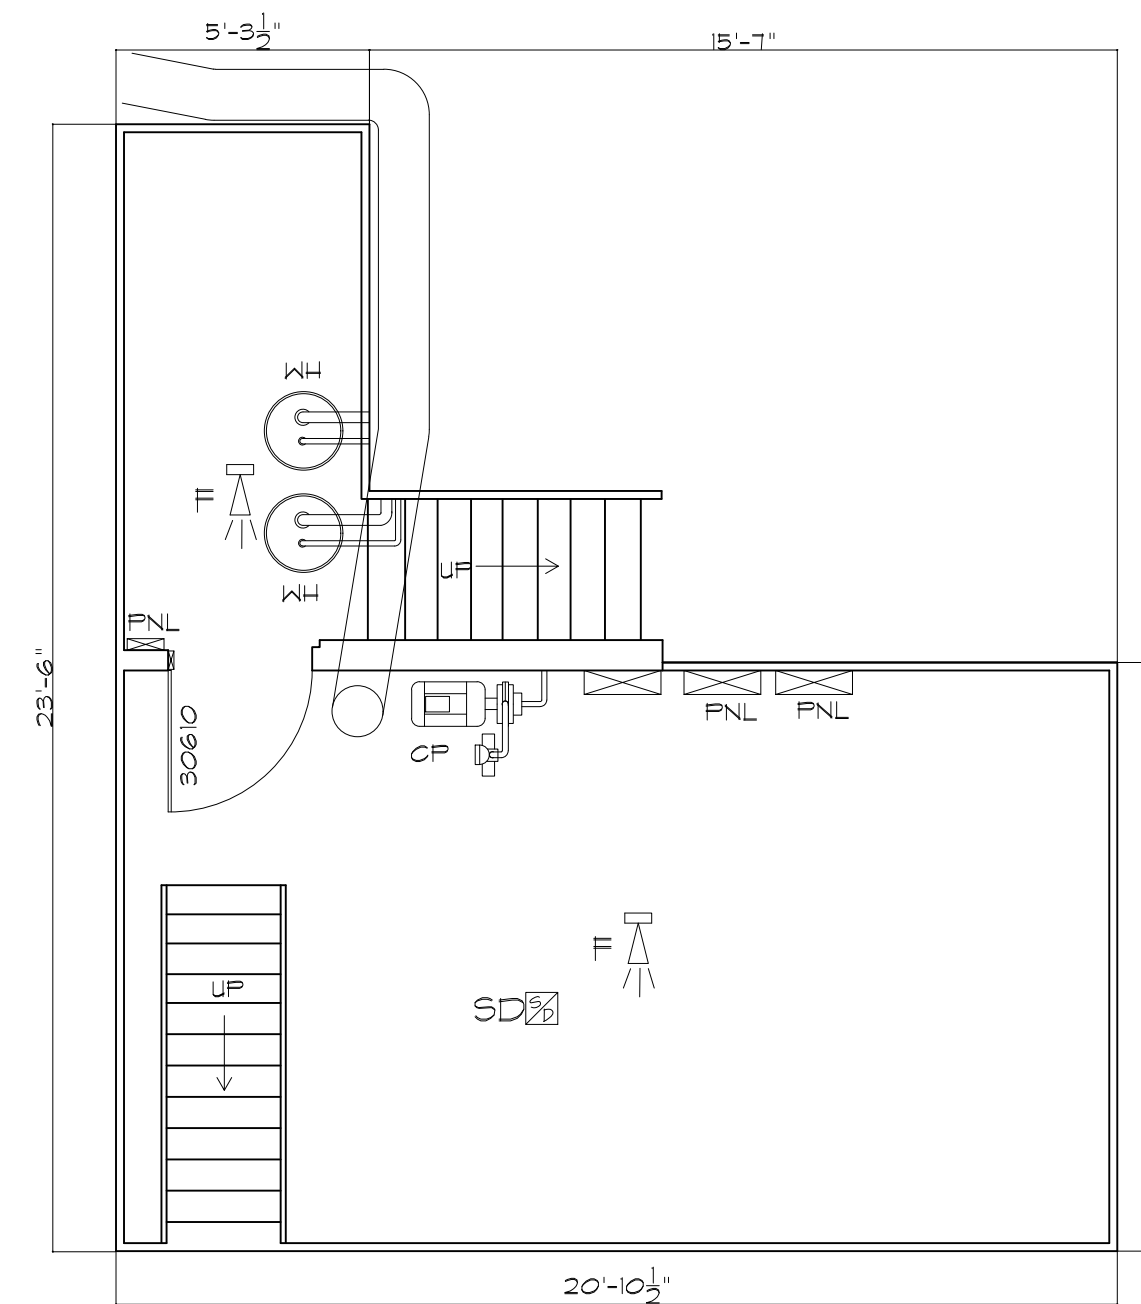


BASEMENT 2 FLOOR PLAN



**ARCHITECTURAL AS BUILT
ITALIAN RENAISSANCE RESIDENCE**

01	100% SUBMISSION	SEE COVER SHEET
NO.	ISSUES REVISIONS	DATE
		SHEET TITLE
BASEMENT FLOOR PLANS		
HL	PROJECT MANAGER	
HL	PROJECT DIRECTOR	
012518-1	PROJECT NUMBER	
1/4"=1'-0"	SCALE	
CL	DRAWN BY	
		SHEET NUMBER
AB-3		

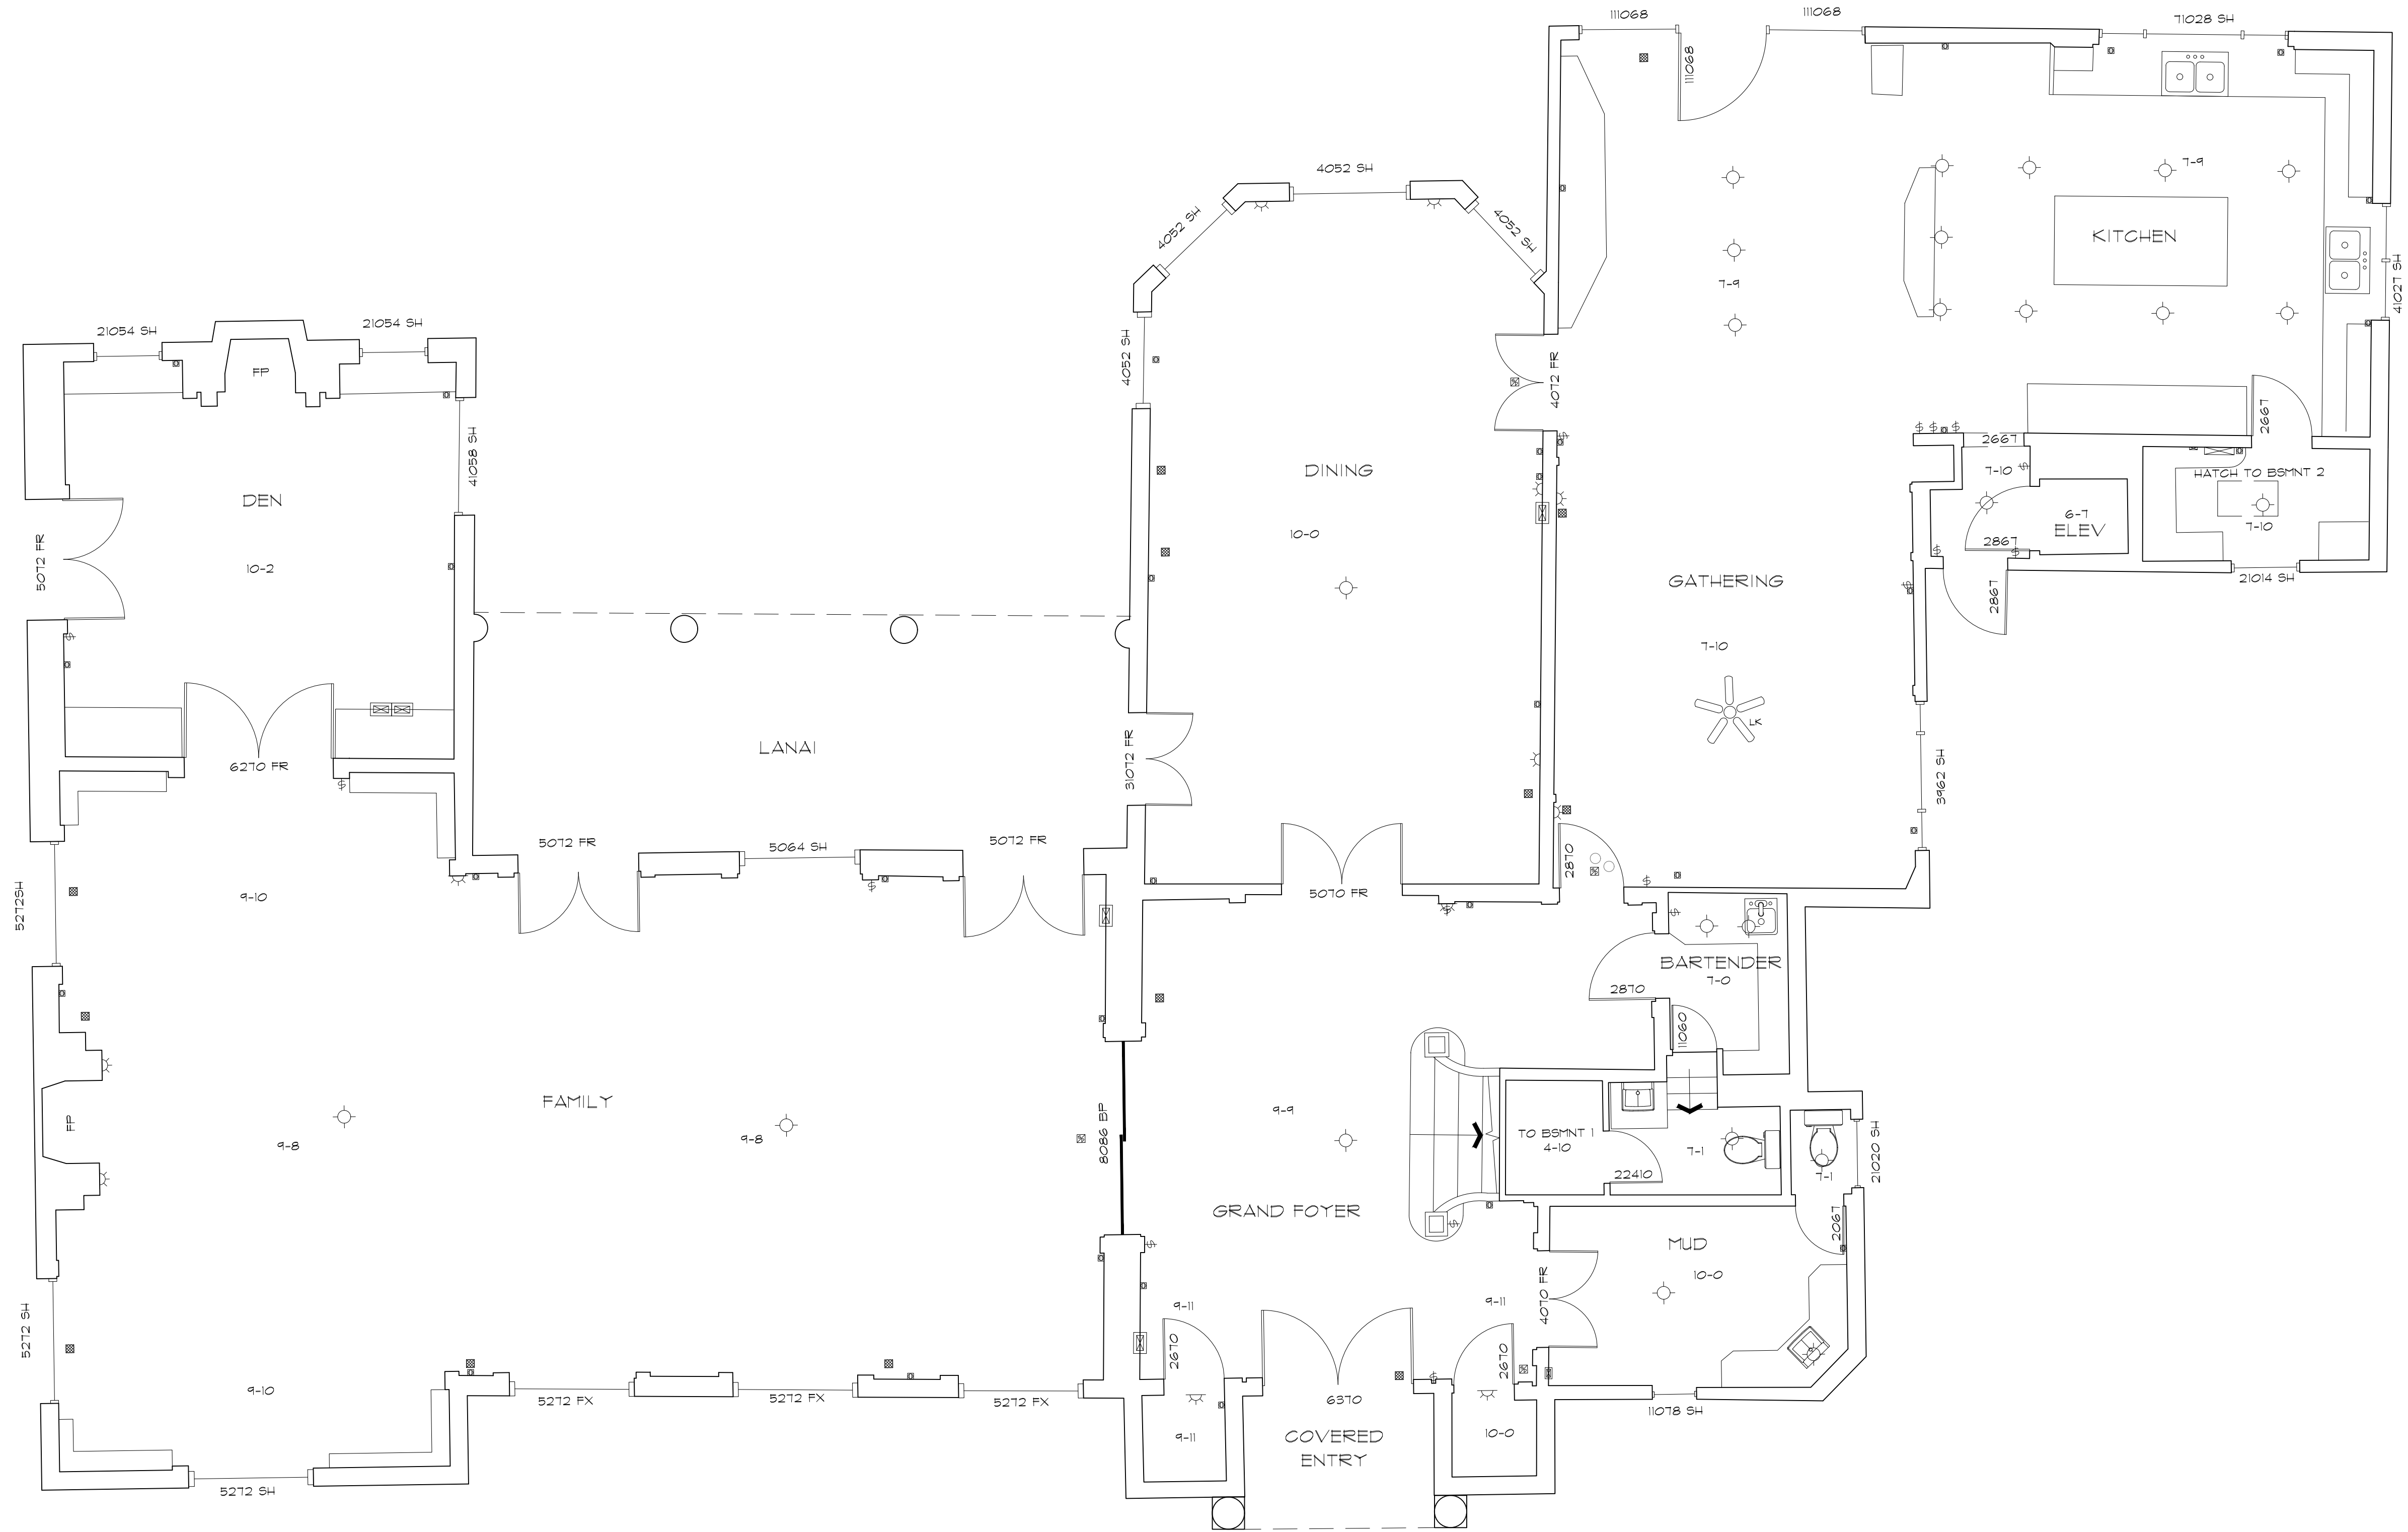

FIRST FLOOR PLAN (RESIDENCE)

**ARCHITECTURAL AS BUILT
ITALIAN RENAISSANCE RESIDENCE**

Los Angeles, CA 90004


01	100% SUBMISSION	SEE COVER SHEET
NO.	ISSUES REVISIONS	DATE
		SHEET TITLE
FIRST FLOOR PLAN		
HL	PROJECT MANAGER	
HL	PROJECT DIRECTOR	
012518-1	PROJECT NUMBER	
1/4"=1'-0"		SCALE
CL	DRAWN BY	
		SHEET NUMBER



01	100% SUBMISSION	SEE COVER SHEET
NO.	ISSUES REVISIONS	DATE
		SHEET TITLE
SECOND FLOOR PLAN		
HL		PROJECT MANAGER
HL		PROJECT DIRECTOR
012518-1		PROJECT NUMBER
1/4"=1'-0"		SCALE
CL		DRAWN BY
		SHEET NUMBER
AB-5		



**ARCHITECTURAL AS BUILT
ITALIAN RENAISSANCE RESIDENCE**

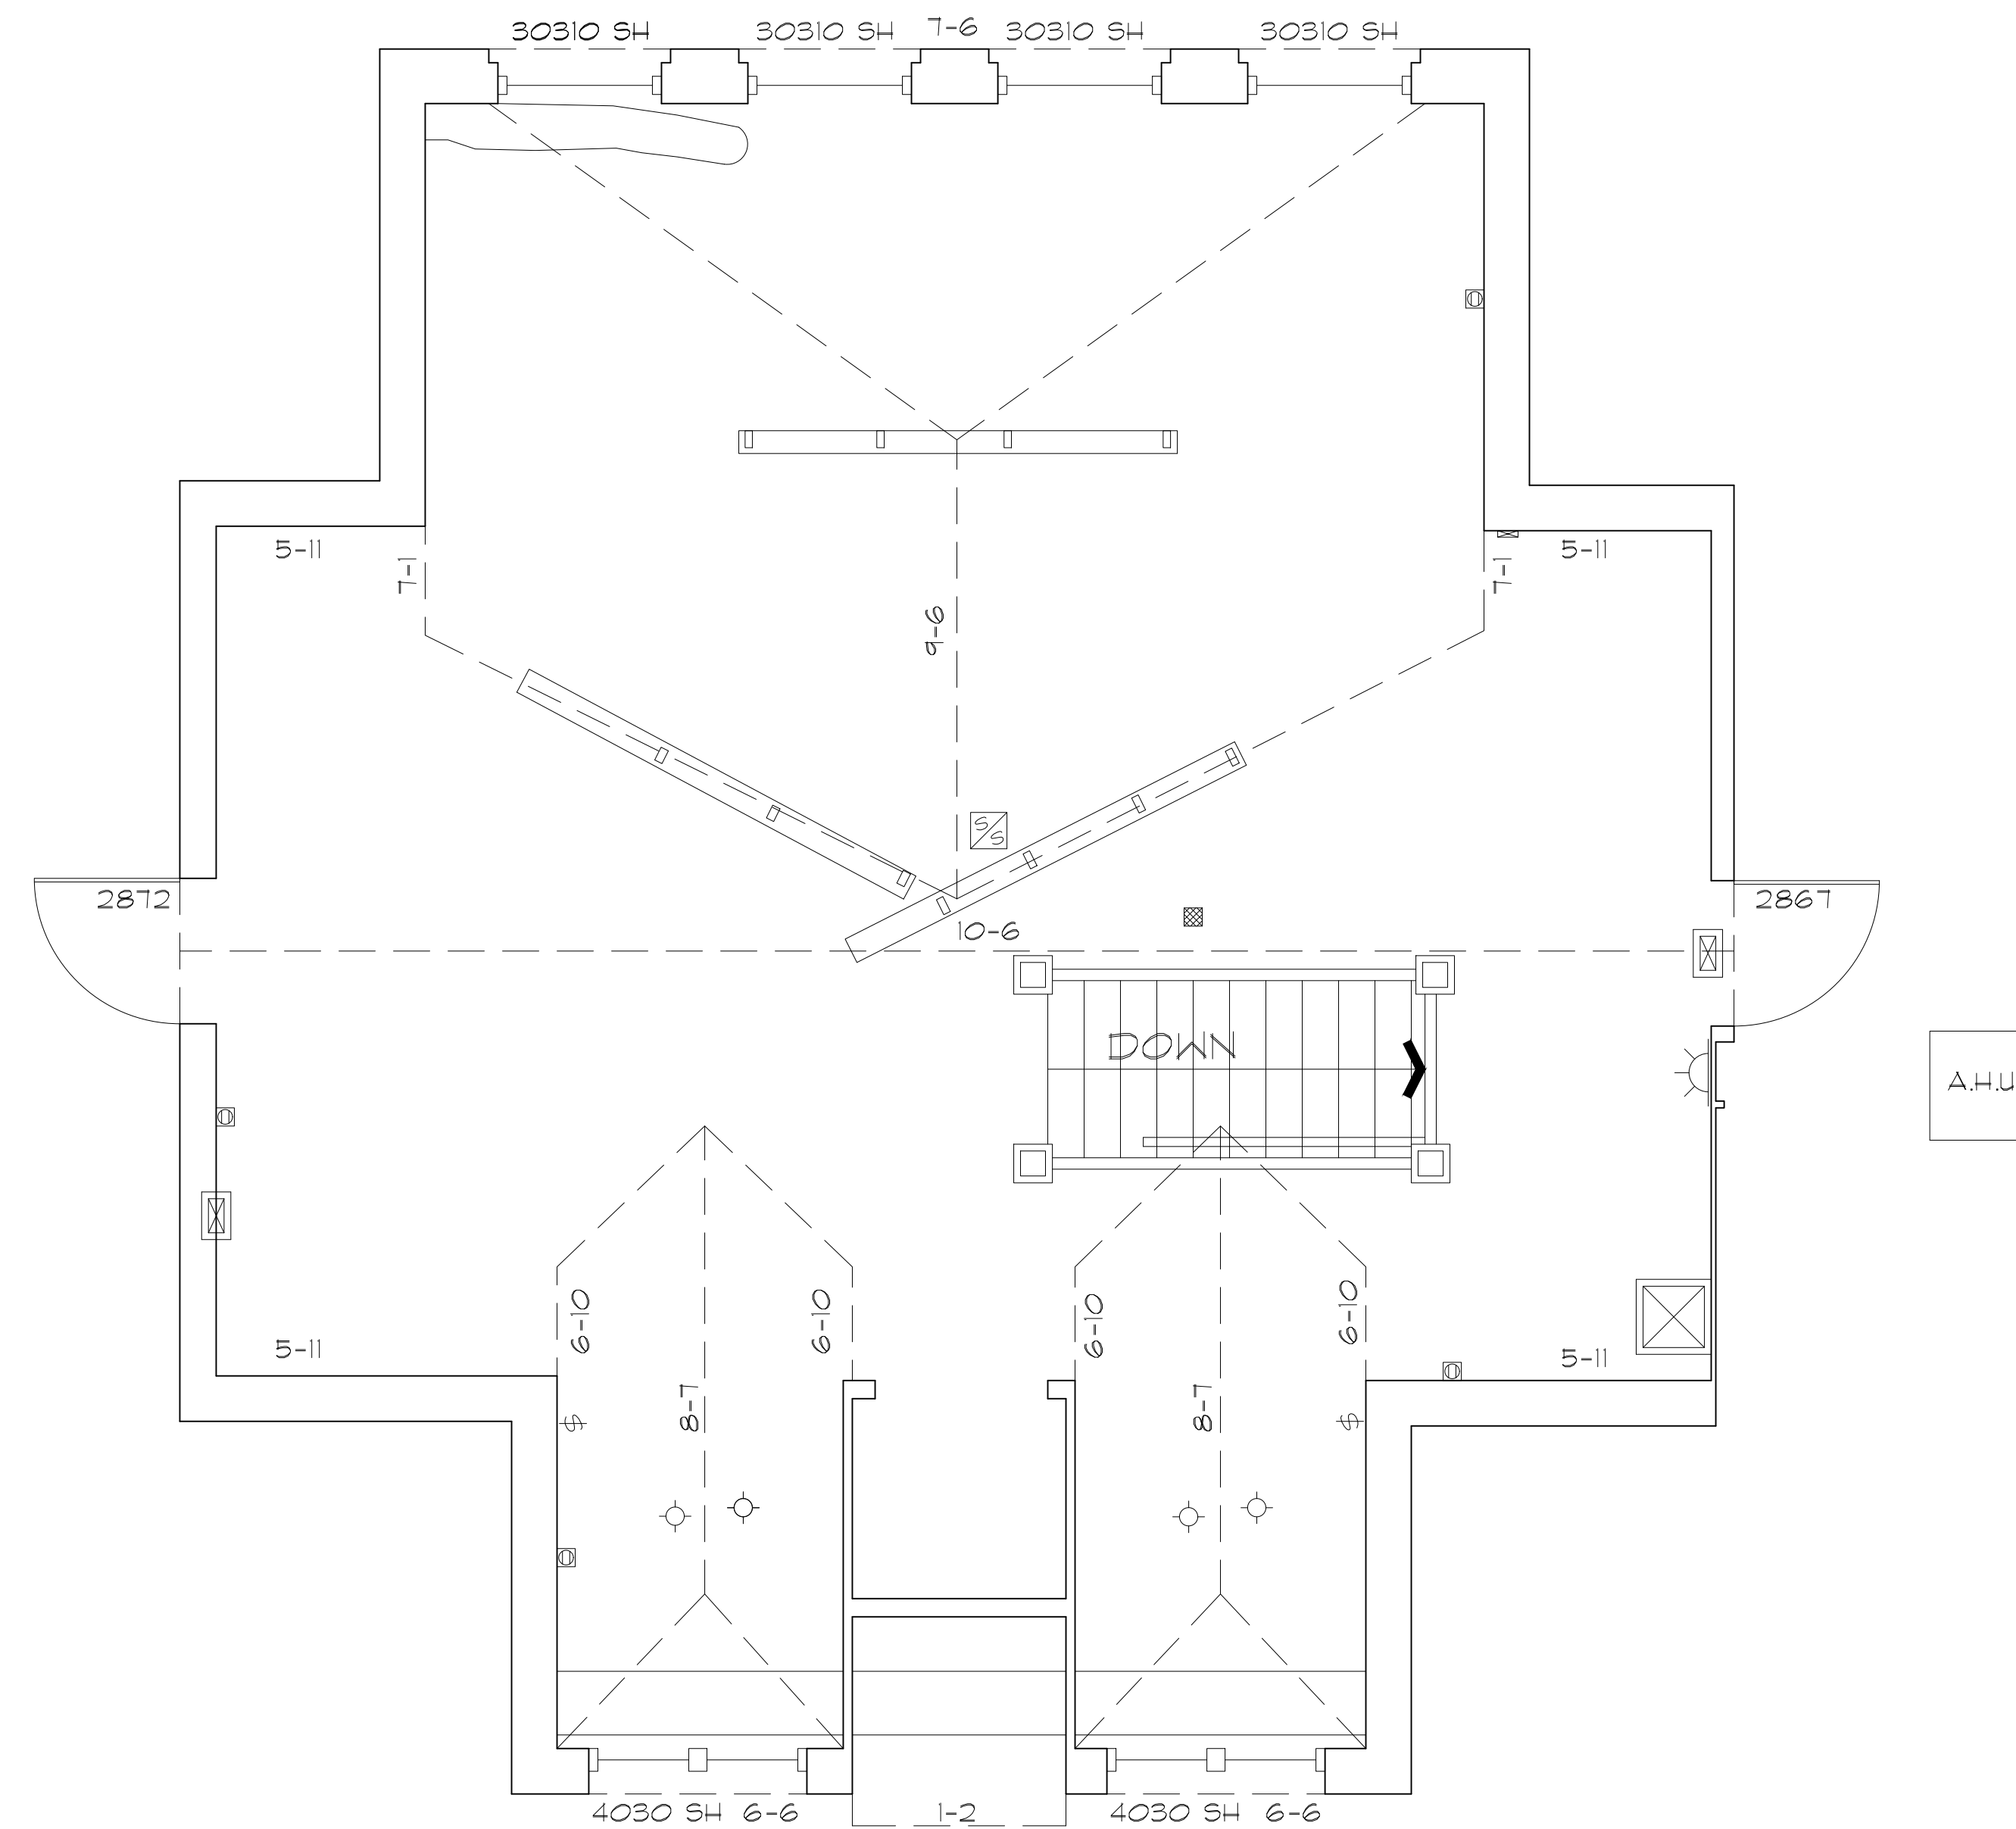


ATTIC FLOOR PLAN (RESIDENCE)

01	100% SUBMISSION	SEE COVER SHEET
NO.	ISSUES REVISIONS	DATE
		SHEET TITLE
ATTIC FLOOR PLAN		
H/L	PROJECT MANAGER	
H/L	PROJECT DIRECTOR	
012518-1	PROJECT NUMBER	
3/8"=1'-0"		SCALE
CL	DRAWN BY	
		SHEET NUMBER
AB-6		




**ARCHITECTURAL AS BUILT
ITALIAN RENAISSANCE RESIDENCE**

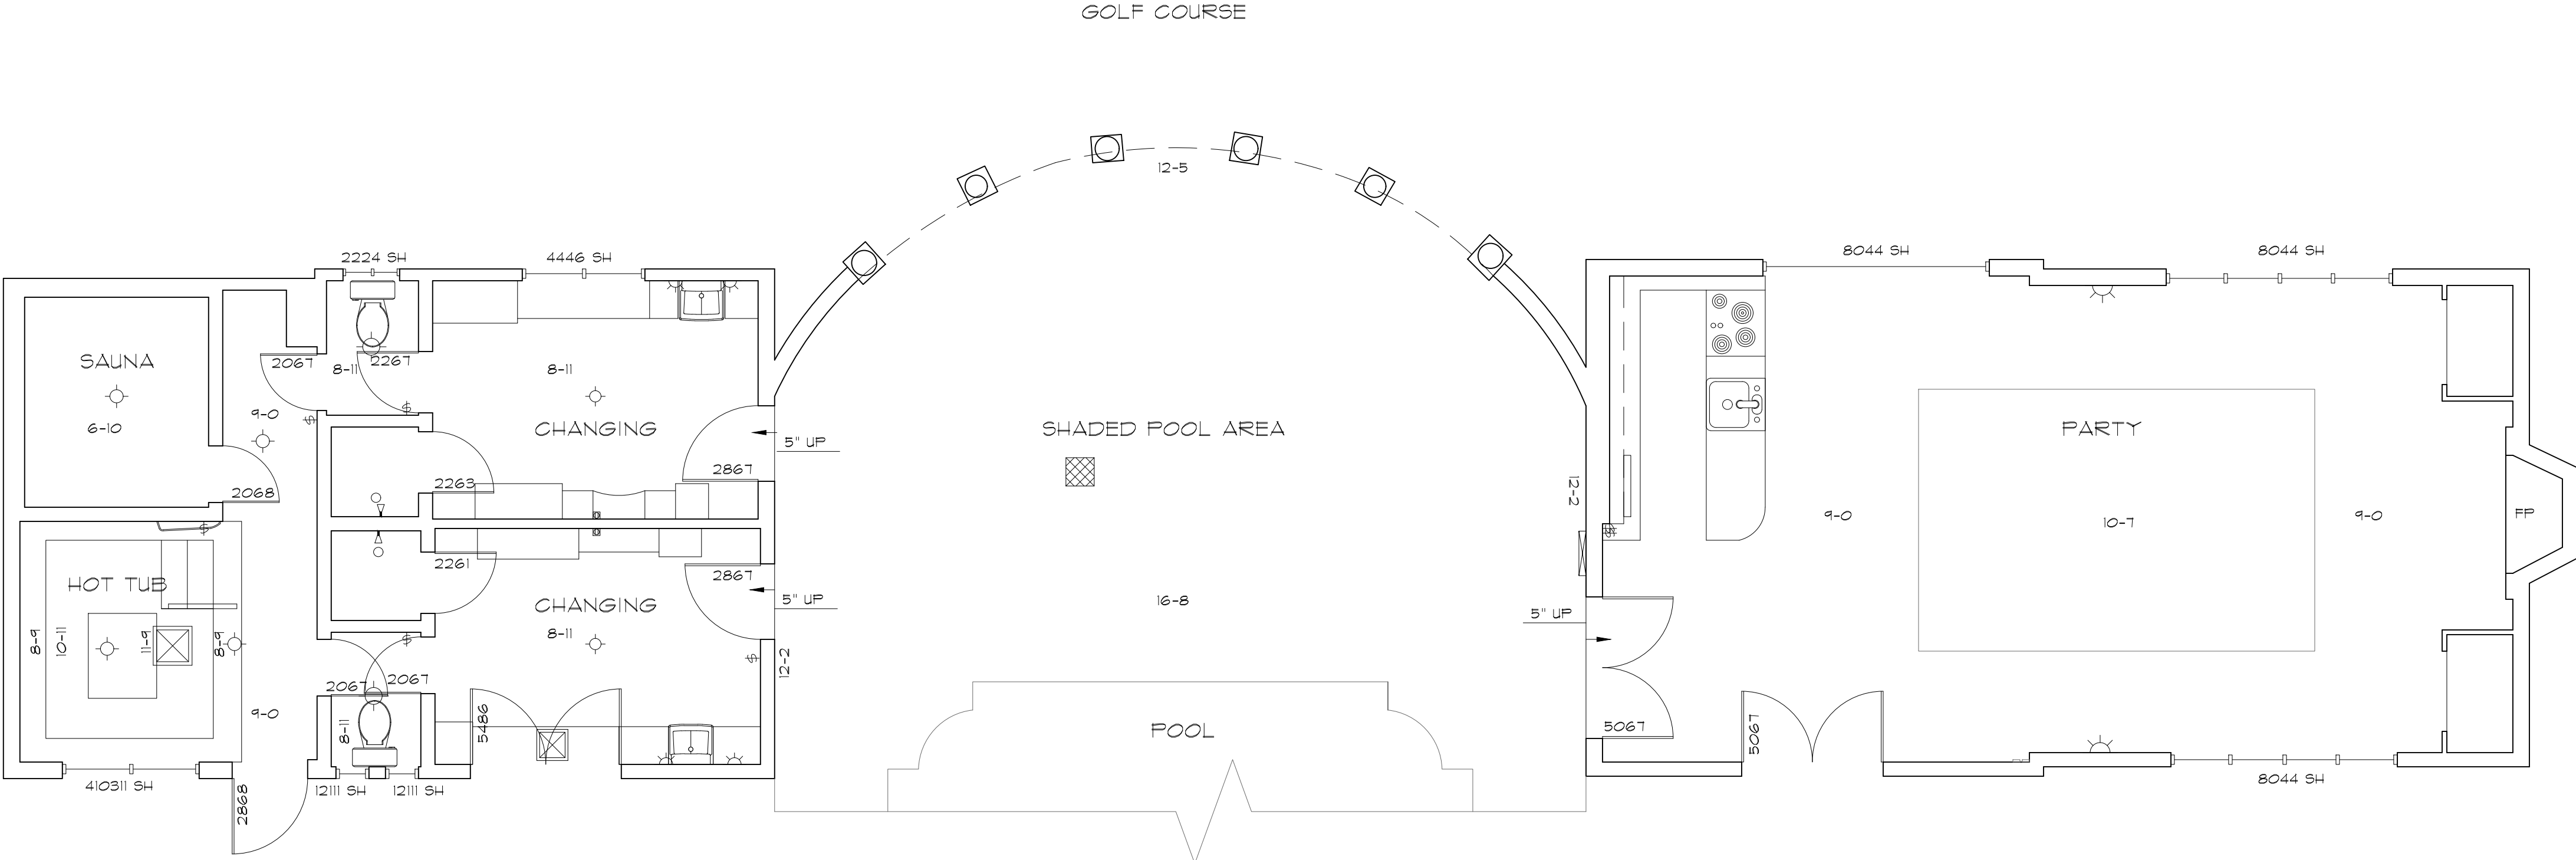

CABANA FLOOR PLAN

01	100% SUBMISSION	SEE COVER SHEET	
NO.	ISSUES REVISIONS	DATE	
		SHEET TITLE	
CABANA FLOOR PLAN			
HL	PROJECT MANAGER		
HL	PROJECT DIRECTOR		
012518-1	PROJECT NUMBER		
1/4"=1'-0"		SCALE	
CL	DRAWN BY		
		SHEET NUMBER	
AB-7			

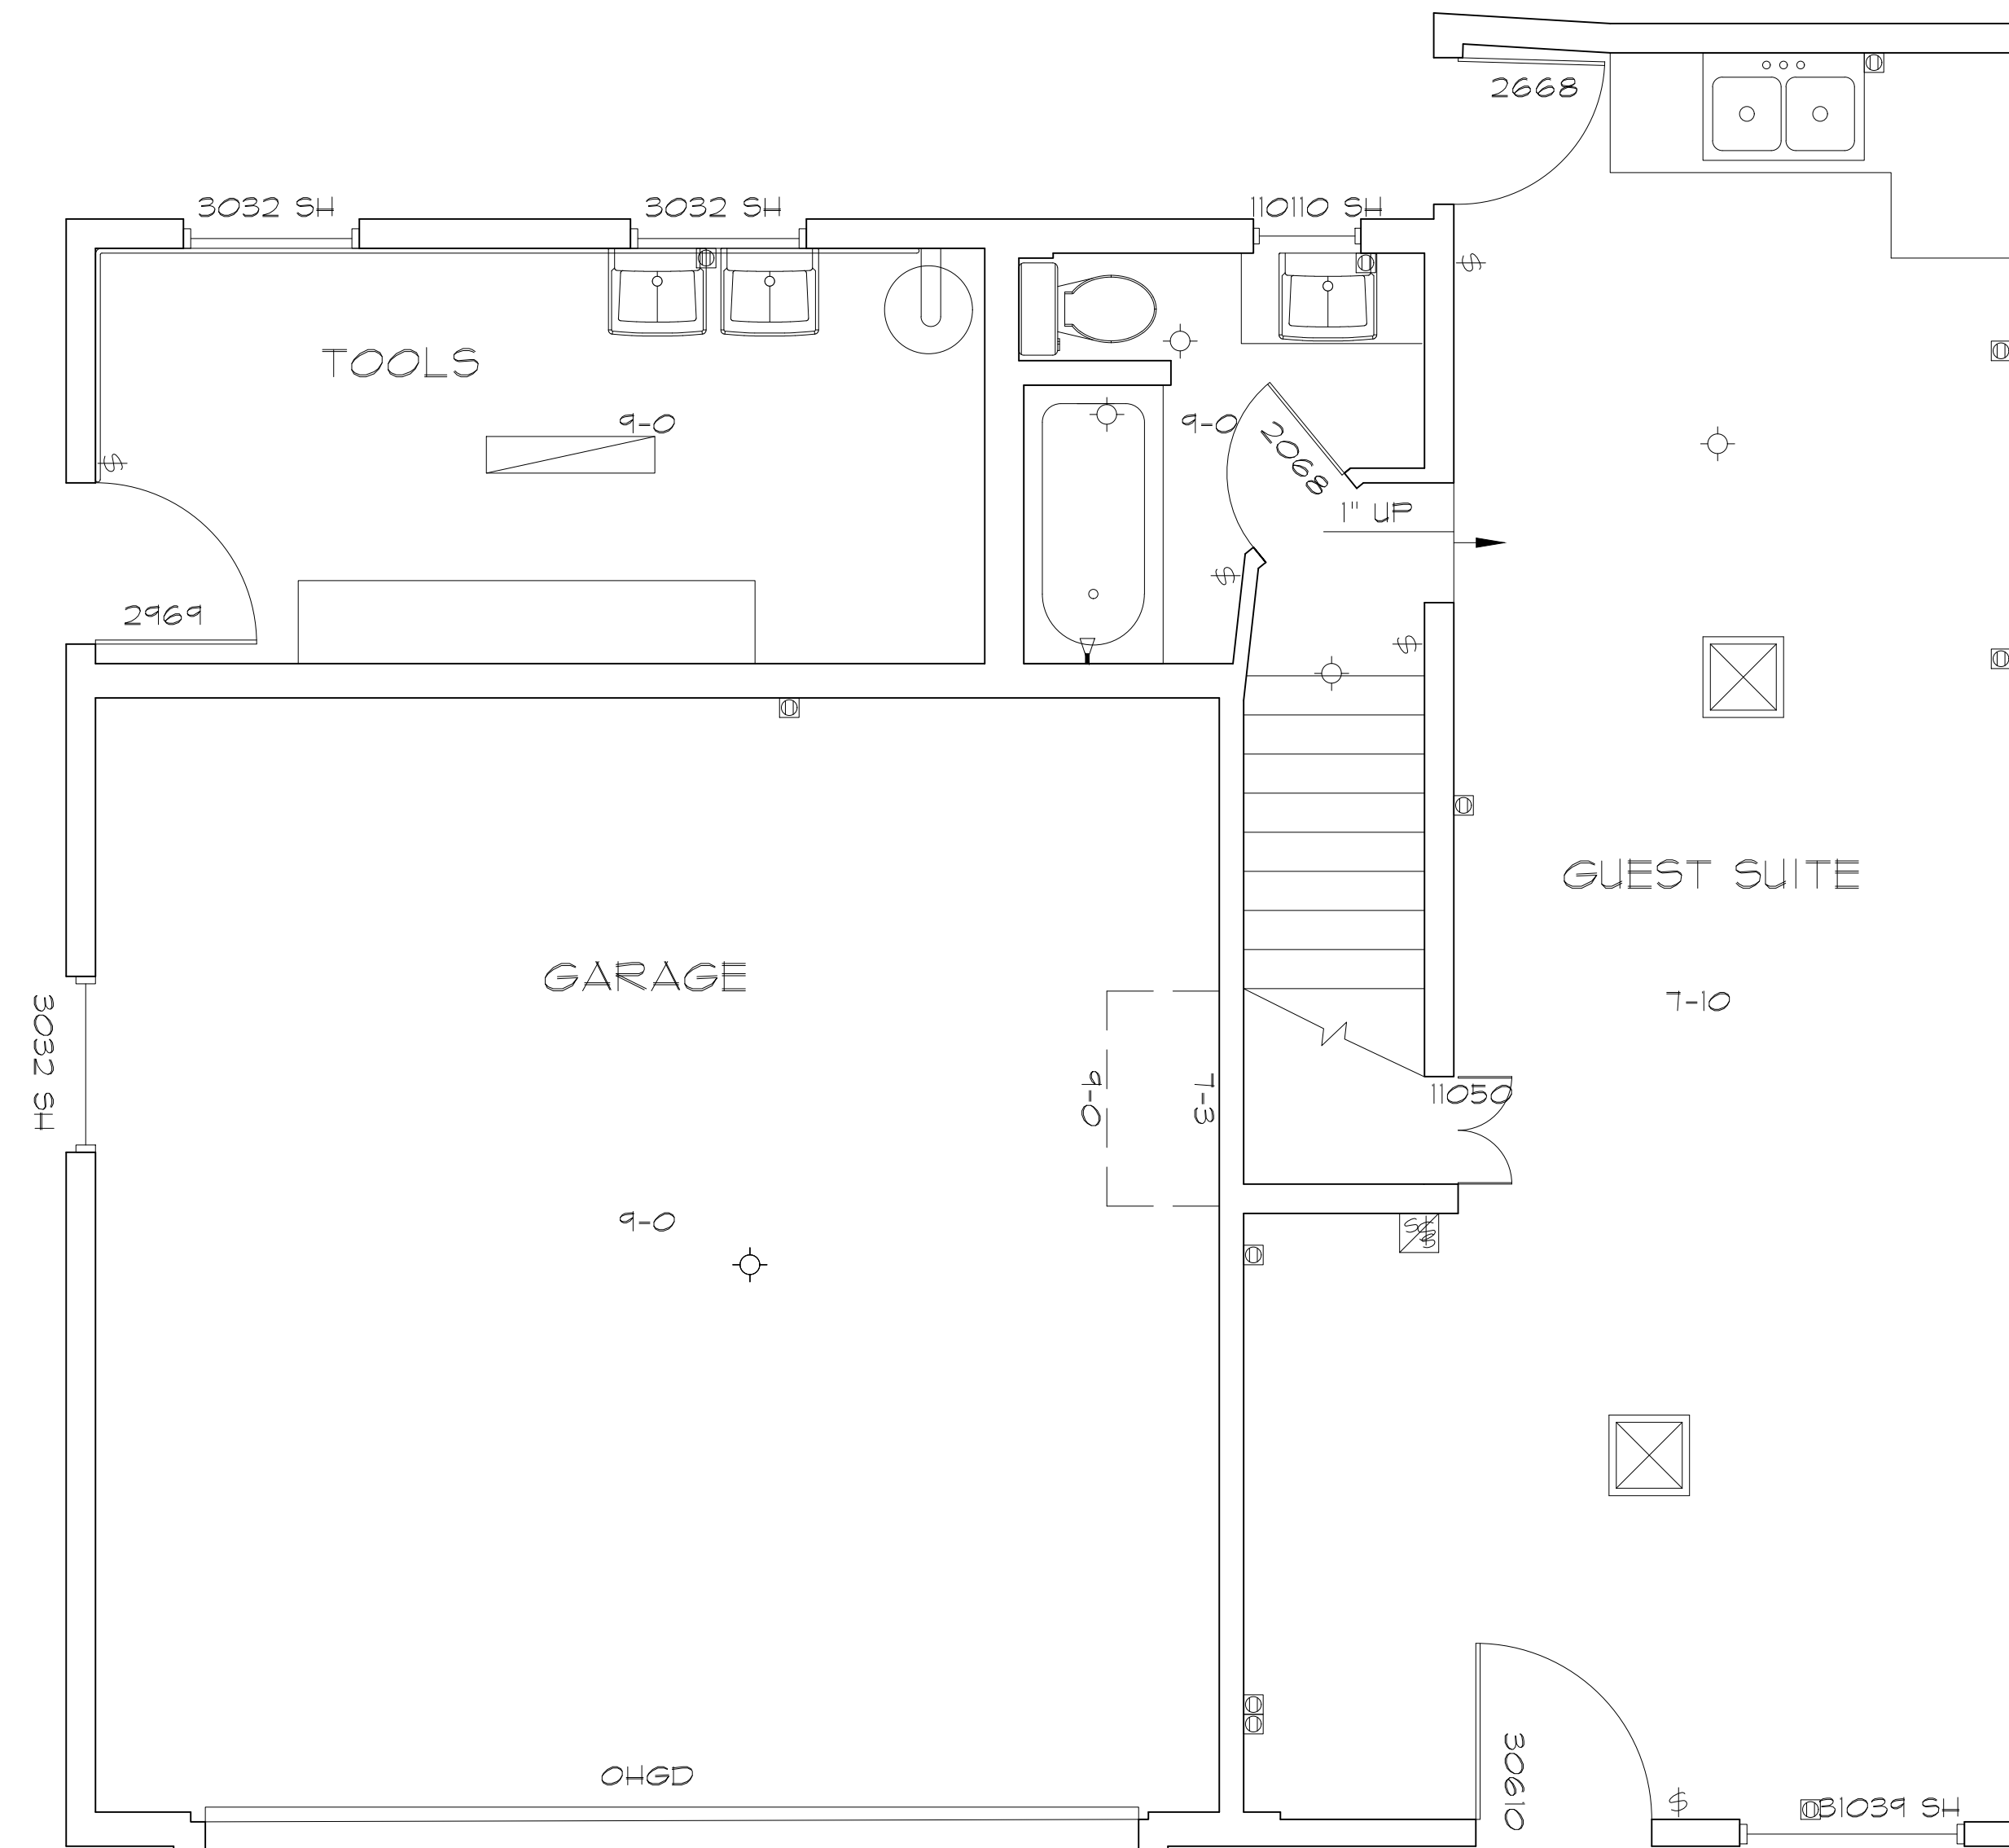

GARAGE FIRST FLOOR PLAN




**ARCHITECTURAL AS BUILT
ITALIAN RENAISSANCE RESIDENCE**

01	100% SUBMISSION	SEE COVER SHEET
NO.	ISSUES REVISIONS	DATE
		SHEET TITLE
GARAGE FIRST FLOOR		
HL	PROJECT MANAGER	
HL	PROJECT DIRECTOR	
012518-1	PROJECT NUMBER	
3/8"=1'-0"	SCALE	
CL	DRAWN BY	
		SHEET NUMBER
AB-8		




**ARCHITECTURAL AS BUILT
ITALIAN RENAISSANCE RESIDENCE**

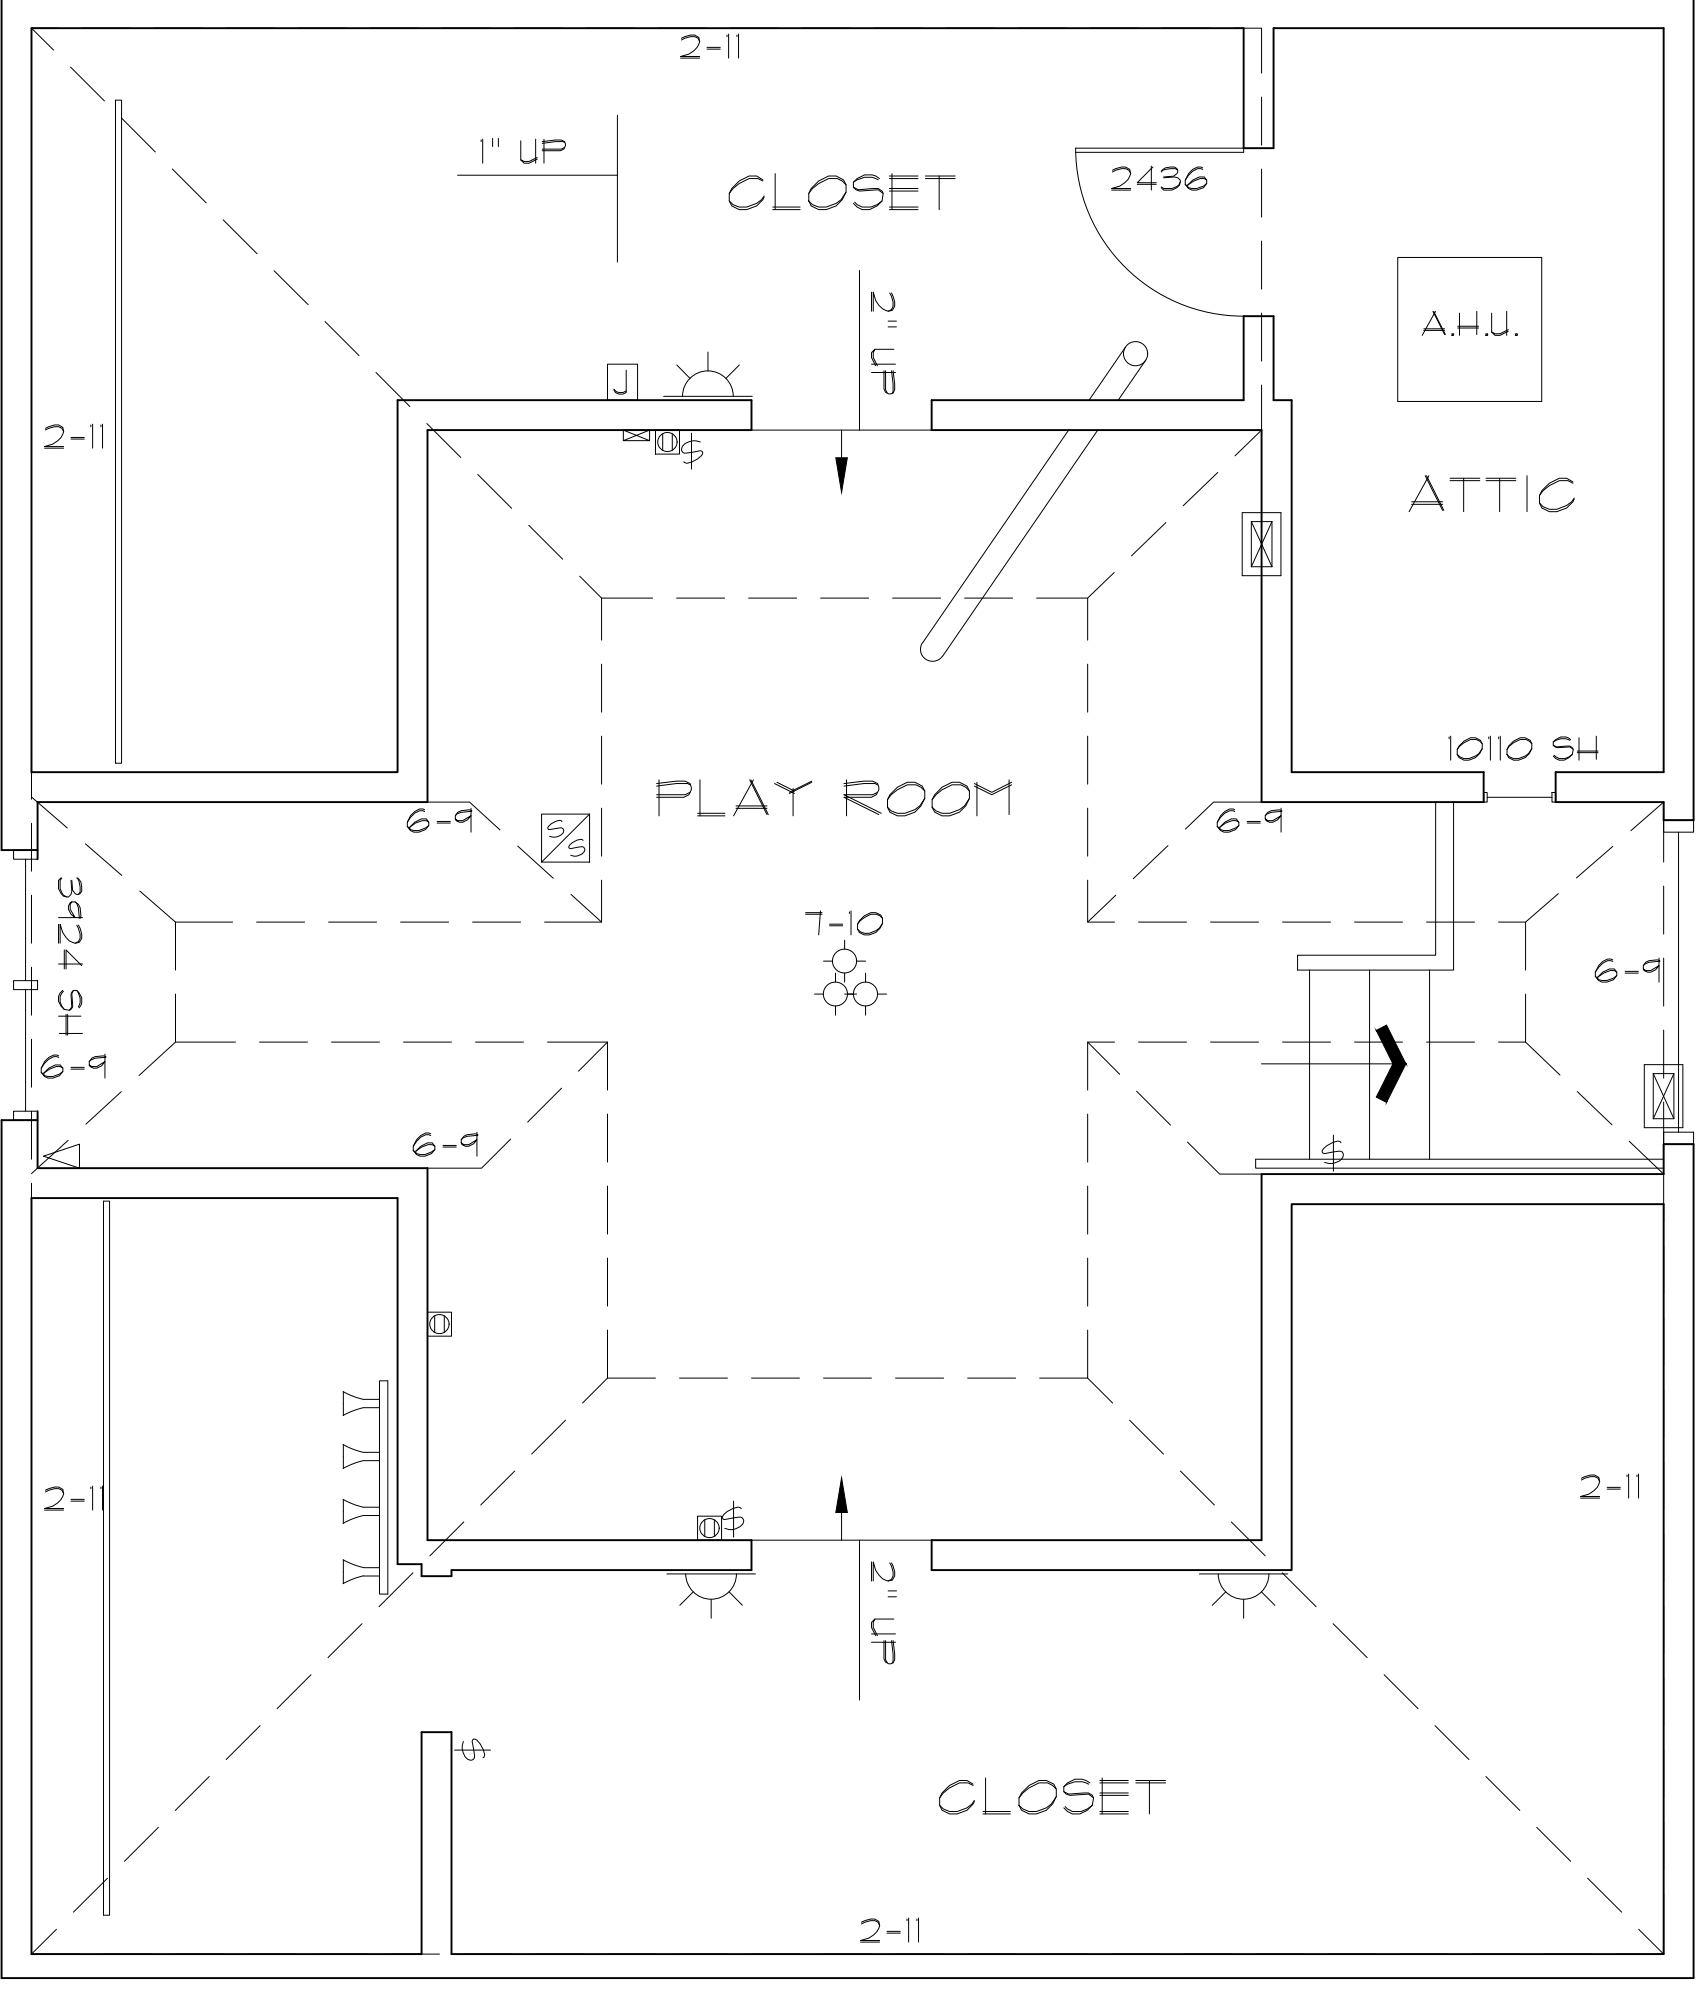

GARAGE SECOND FLOOR PLAN

01	100% SUBMISSION	SEE COVER SHEET
NO.	ISSUES REVISIONS	DATE
		SHEET TITLE
GARAGE SECOND FLOOR		
HL	PROJECT MANAGER	
HL	PROJECT DIRECTOR	
012518-1	PROJECT NUMBER	
3/8"=1'-0"		SCALE
CL	DRAWN BY	
		SHEET NUMBER
AB-9		

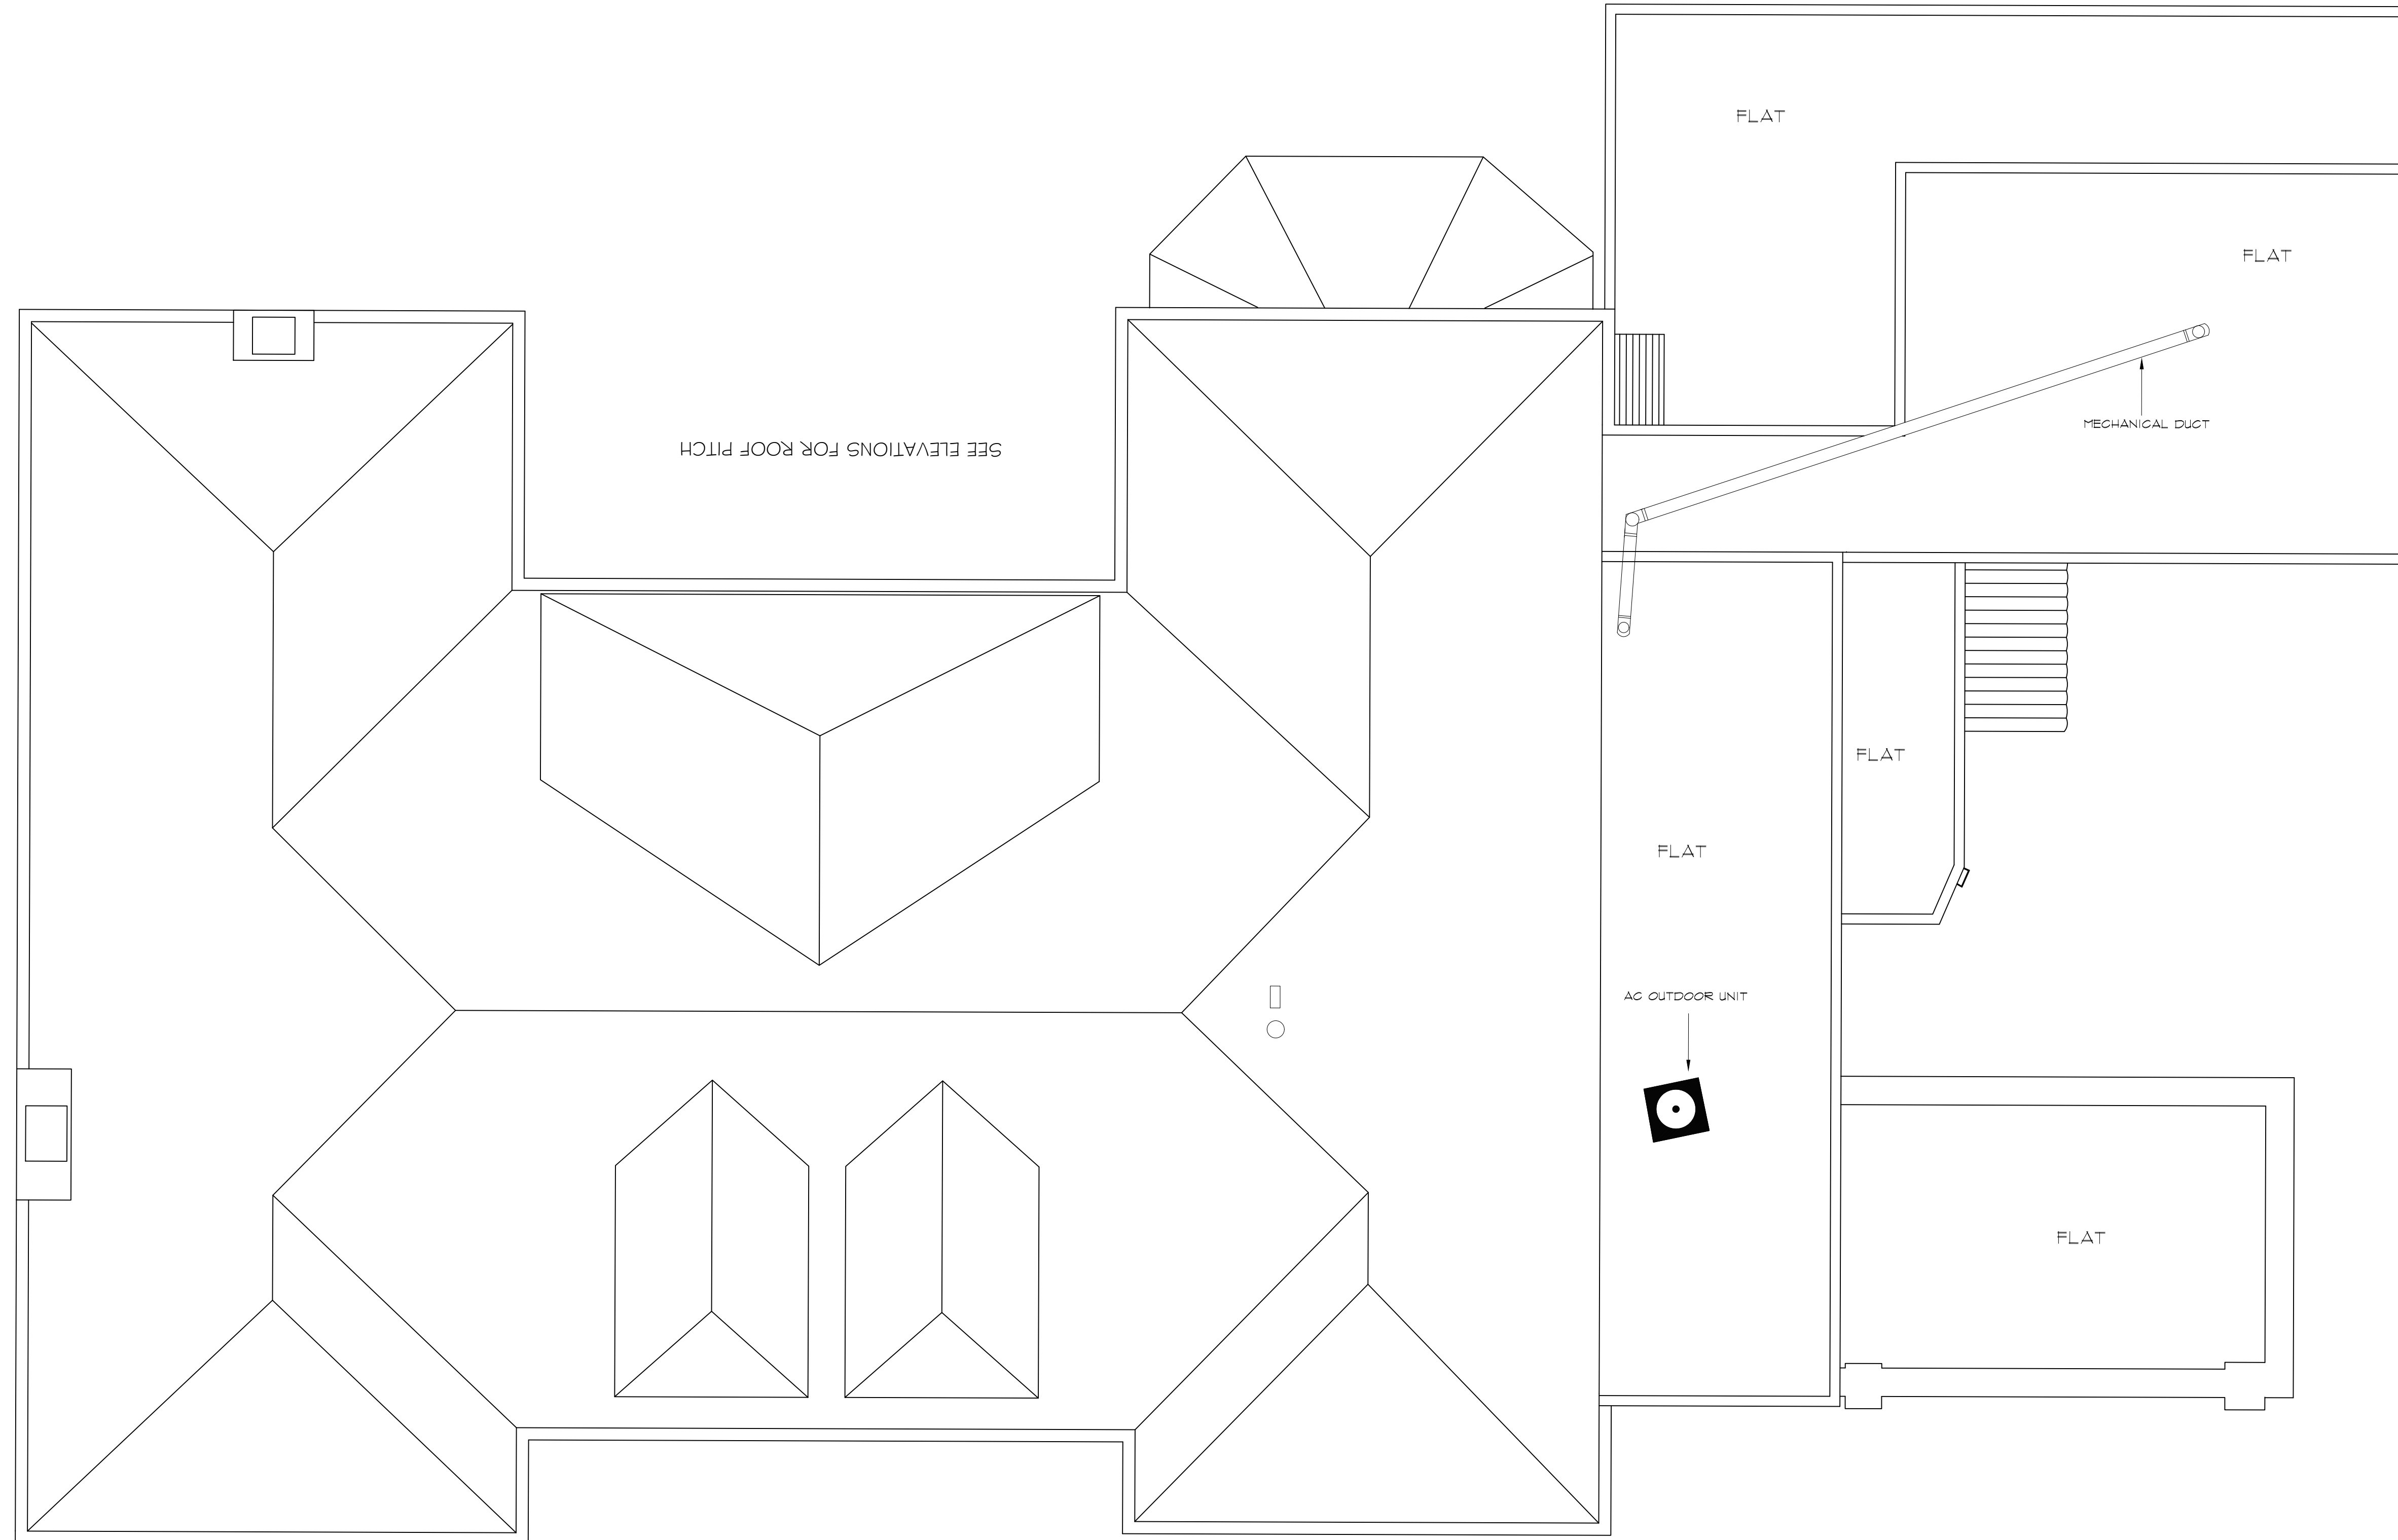

ROOF PLAN



**ARCHITECTURAL AS BUILT
ITALIAN RENAISSANCE RESIDENCE**

01	100% SUBMISSION	SEE COVER SHEET
NO.	ISSUES REVISIONS	DATE
		SHEET TITLE
ROOF PLAN		
HL	PROJECT MANAGER	
HL	PROJECT DIRECTOR	
012518-1	PROJECT NUMBER	
1/4"=1'-0"		SCALE
CL	DRAWN BY	
		SHEET NUMBER
AB-10		