

C-1	COVER SHEET DRAWING INDEX
SL	SYMBOLS LEGEND
AB-1	FIRST FLOOR PLAN
AB-2	SECOND FLOOR PLAN
AB-3	THIRD FLOOR PLAN
AB-4	EXTERIOR ELEVATIONS
AB-5	EXTERIOR ELEVATIONS
AB-6	INTERIOR ELEVATIONS
AB-7	INTERIOR ELEVATIONS
AB-8	INTERIOR ELEVATIONS



VICINITY MAP

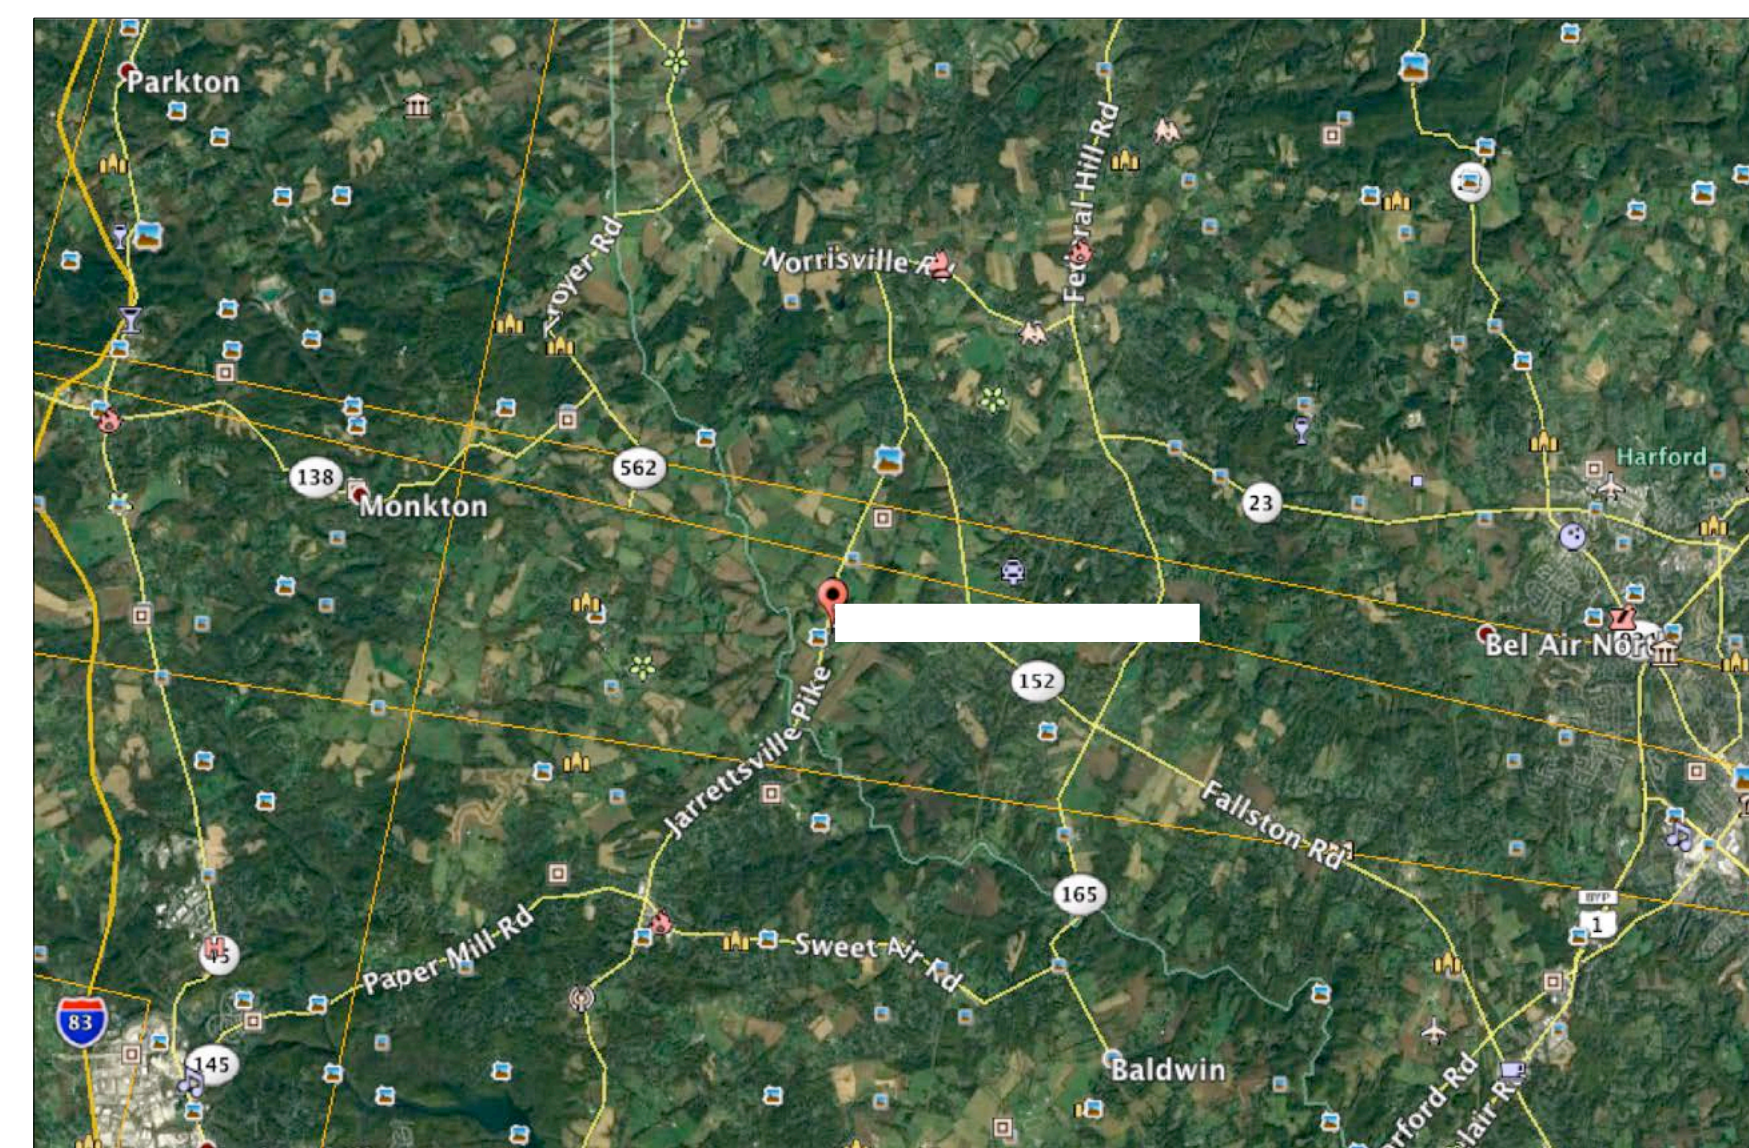

ARCHITECTURAL AS BUILT FOXFIRE FARM


MONKTON MARYLAND 21111


01	100% SUBMISSION	
NO.	ISSUES REVISIONS	DATE
		SHEET TITLE
COVER SHEET		
HL		PROJECT MANAGER
HL		PROJECT DIRECTOR
012317-1		PROJECT NUMBER
		SCALE
CL		DRAWN BY
		SHEET NUMBER
C-1		


SYMBOLS LEGEND

RCP

- 

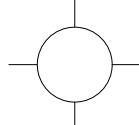
EXHAUST VENT
- 

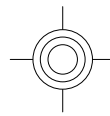
CEILING MOUNTED LIGHT FIXTURE
- 

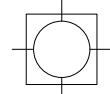
CEILING MOUNTED DIRECTIONAL LIGHT
- 

RECESSED CAN LIGHT
- 

EYEBALL OR SMALL CAN LIGHT
- 

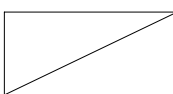PENDANT LIGHT
- 

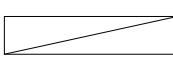INDIVIDUAL FLUOR. LAY-IN FIXTURE 4 BULB
- 

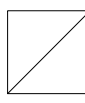INDIVIDUAL FLUOR. HANGING FIXTURE 2 BULB
- 


INDIVIDUAL FLUOR. FLUSH MOUNT FIXTURE 4 BULB
- 


CAMERA
- 

MOTION DET.
- 


SUPPLY VENT
- 


SUPPLY VENT
- 

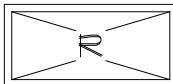RETURN VENT
- 

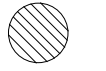
RETURN VENT
- 


SPEAKER

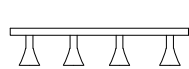- 

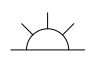
TRACK LIGHT OR VANITY LIGHT
- 

WALL-MOUNTED LIGHT FIXTURE
- 

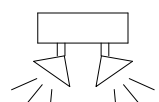
EMERGENCY EXIT SIGN
- 

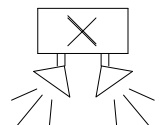
EMERGENCY EXIT LIGHT
- 

EMERGENCY EXIT LIGHT W/ SIGN
- 

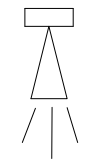LIGHTED STAIR SIGN
- 

FLOOD LIGHT
- 

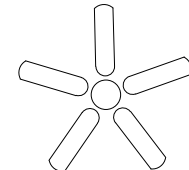PHOTO CELL
- 

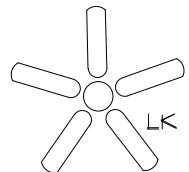CEILING FAN
- 

CEILING FAN W/ LIGHT KIT
- 7-2-6

CEILING HEIGHT AND TRIM 7'-2" ABOVE FLOOR BELOW WITH 6" CROWN MOULDING. NOTE: ALL CEILINGS NOT LABELED ARE PLASTER. CEILINGS SHOWN WITH A GRID ARE LAY IN ACOUSTICAL TILE..
- 

JUNCTION BOX

ELECTRIC

- 


DATA OUTLET
- 

TELEPHONE JACK
- 


ELECTRIC SWITCH
- 


CABLE TELEVISION OUTLET
- 

DUPLEX RECEPTACLE OUTLET
- 

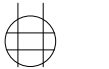
SPECIAL PURPOSE CONNECTION OR OUTLET
- 

QUADRUPLEX RECEPTACLE OUTLET
- 

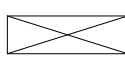FLOOR DUPLEX RECEPTACLE OUTLET
- 

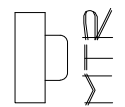ELECTRIC PANEL
- 

ELECTRIC METER
- 

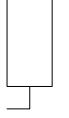BUTTON SWITCH
- 

DISCONNECT SWITCH
- 

GROUND/FLOOR LIGHT
- 

KEY PAD

FIRE PROTECTION

- 

FIRE EXTINGUISHER
- 

FIRE PULL
- 

FIRE ALARM (HORN/SRTOBE)
- 

SMOKE DETECTOR
- 

SMOKE ALARM SPEAKER
- 

SPRINKLER HEAD CEILING MOUNT
- 

SPRINKLER HEAD WALL MOUNT

MEP

- 

THERMOSTAT
- 

FLOOR DRAIN
- 

VALVE
- 

HOSE BIB
- 

WATER SUPPLY
- 

SUSPENDED GAS HEATER

MISC

- 

BOLLARD

7-2-6

CEILING HEIGHT AND TRIM 7'-2" ABOVE FLOOR BELOW WITH 6" CROWN MOULDING. NOTE: ALL CEILINGS NOT LABELED ARE PLASTER. CEILINGS SHOWN WITH A GRID ARE LAY IN ACOUSTICAL TILE..

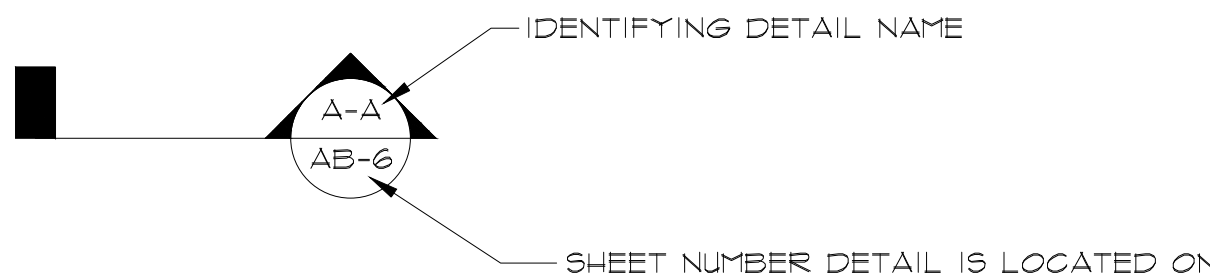
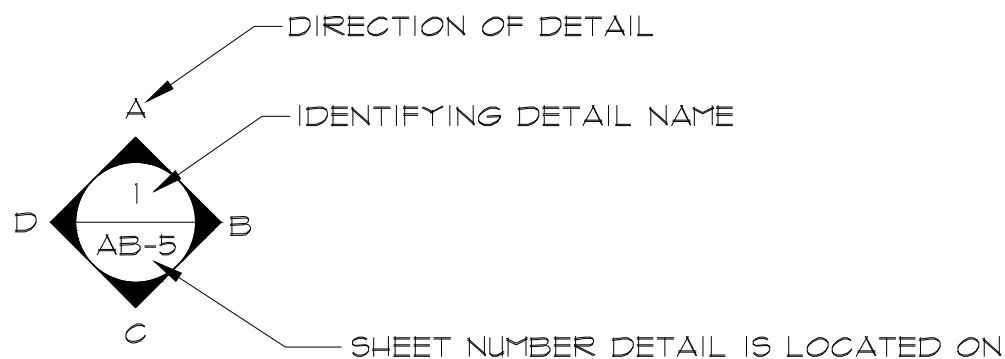
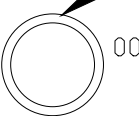
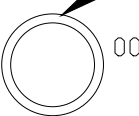


PHOTO DOCUMENTATION LEGEND


- 

INDICATES LOCATION OF CAMERA
- 


INDICATES DIRECTION OF CAMERA LENS AND CORRESPONDING PHOTO / VIDEO NUMBER


TYPES OF DOCUMENTATION

- 

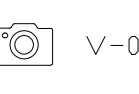GROUND BASED PHOTO
- 

GROUND BASED VIDEO
- 

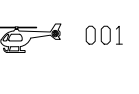360° SPHERICAL PHOTO
- 

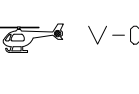AERIAL BASED PHOTO
- 

AERIAL BASED VIDEO

As BUILT
PROFESSIONALS

A DIVISION OF:

AEC

CONSULTANTS INC

www.aecconsultantsinc.com

844.272.8458

© 2011 AEC CONSULTANTS INC

ARCHITECTURAL AS BUILT
FOXFIRE FARM

MONKTON MARYLAND 21111

01 100% SUBMISSION

NO. ISSUES | REVISIONS

DATE

SHEET TITLE

HL PROJECT MANAGER

HL PROJECT DIRECTOR

012317-1 PROJECT NUMBER

NOT TO SCALE

CL DRAWN BY


SHEET NUMBER

SL



MONKTON MARYLAND 21111

AB-1

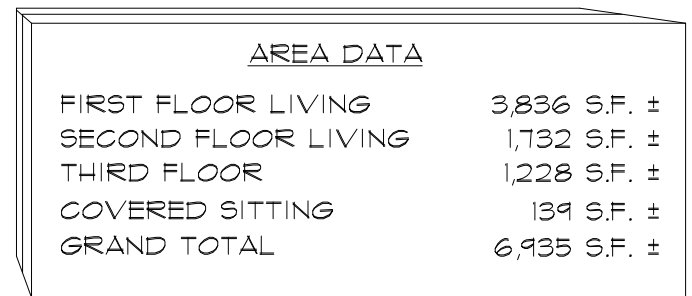

FIRST FLOOR PLAN

7-2-6 CEILING HEIGHT AND TRIM
7'-2" ABOVE FLOOR BELOW
WITH 6" CROWN MOULDING.
NOTE: ALL CEILINGS NOT
LABELED ARE PLASTER.
CEILINGS SHOWN WITH A GRID
ARE LAY IN ACOUSTICAL TILE..


A DIVISION OF:

CONSULTANTS INC

844.272.8458

**ARCHITECTURAL AS BUILT
FOXFIRE FARM**

MONKTON MARYLAND 21111

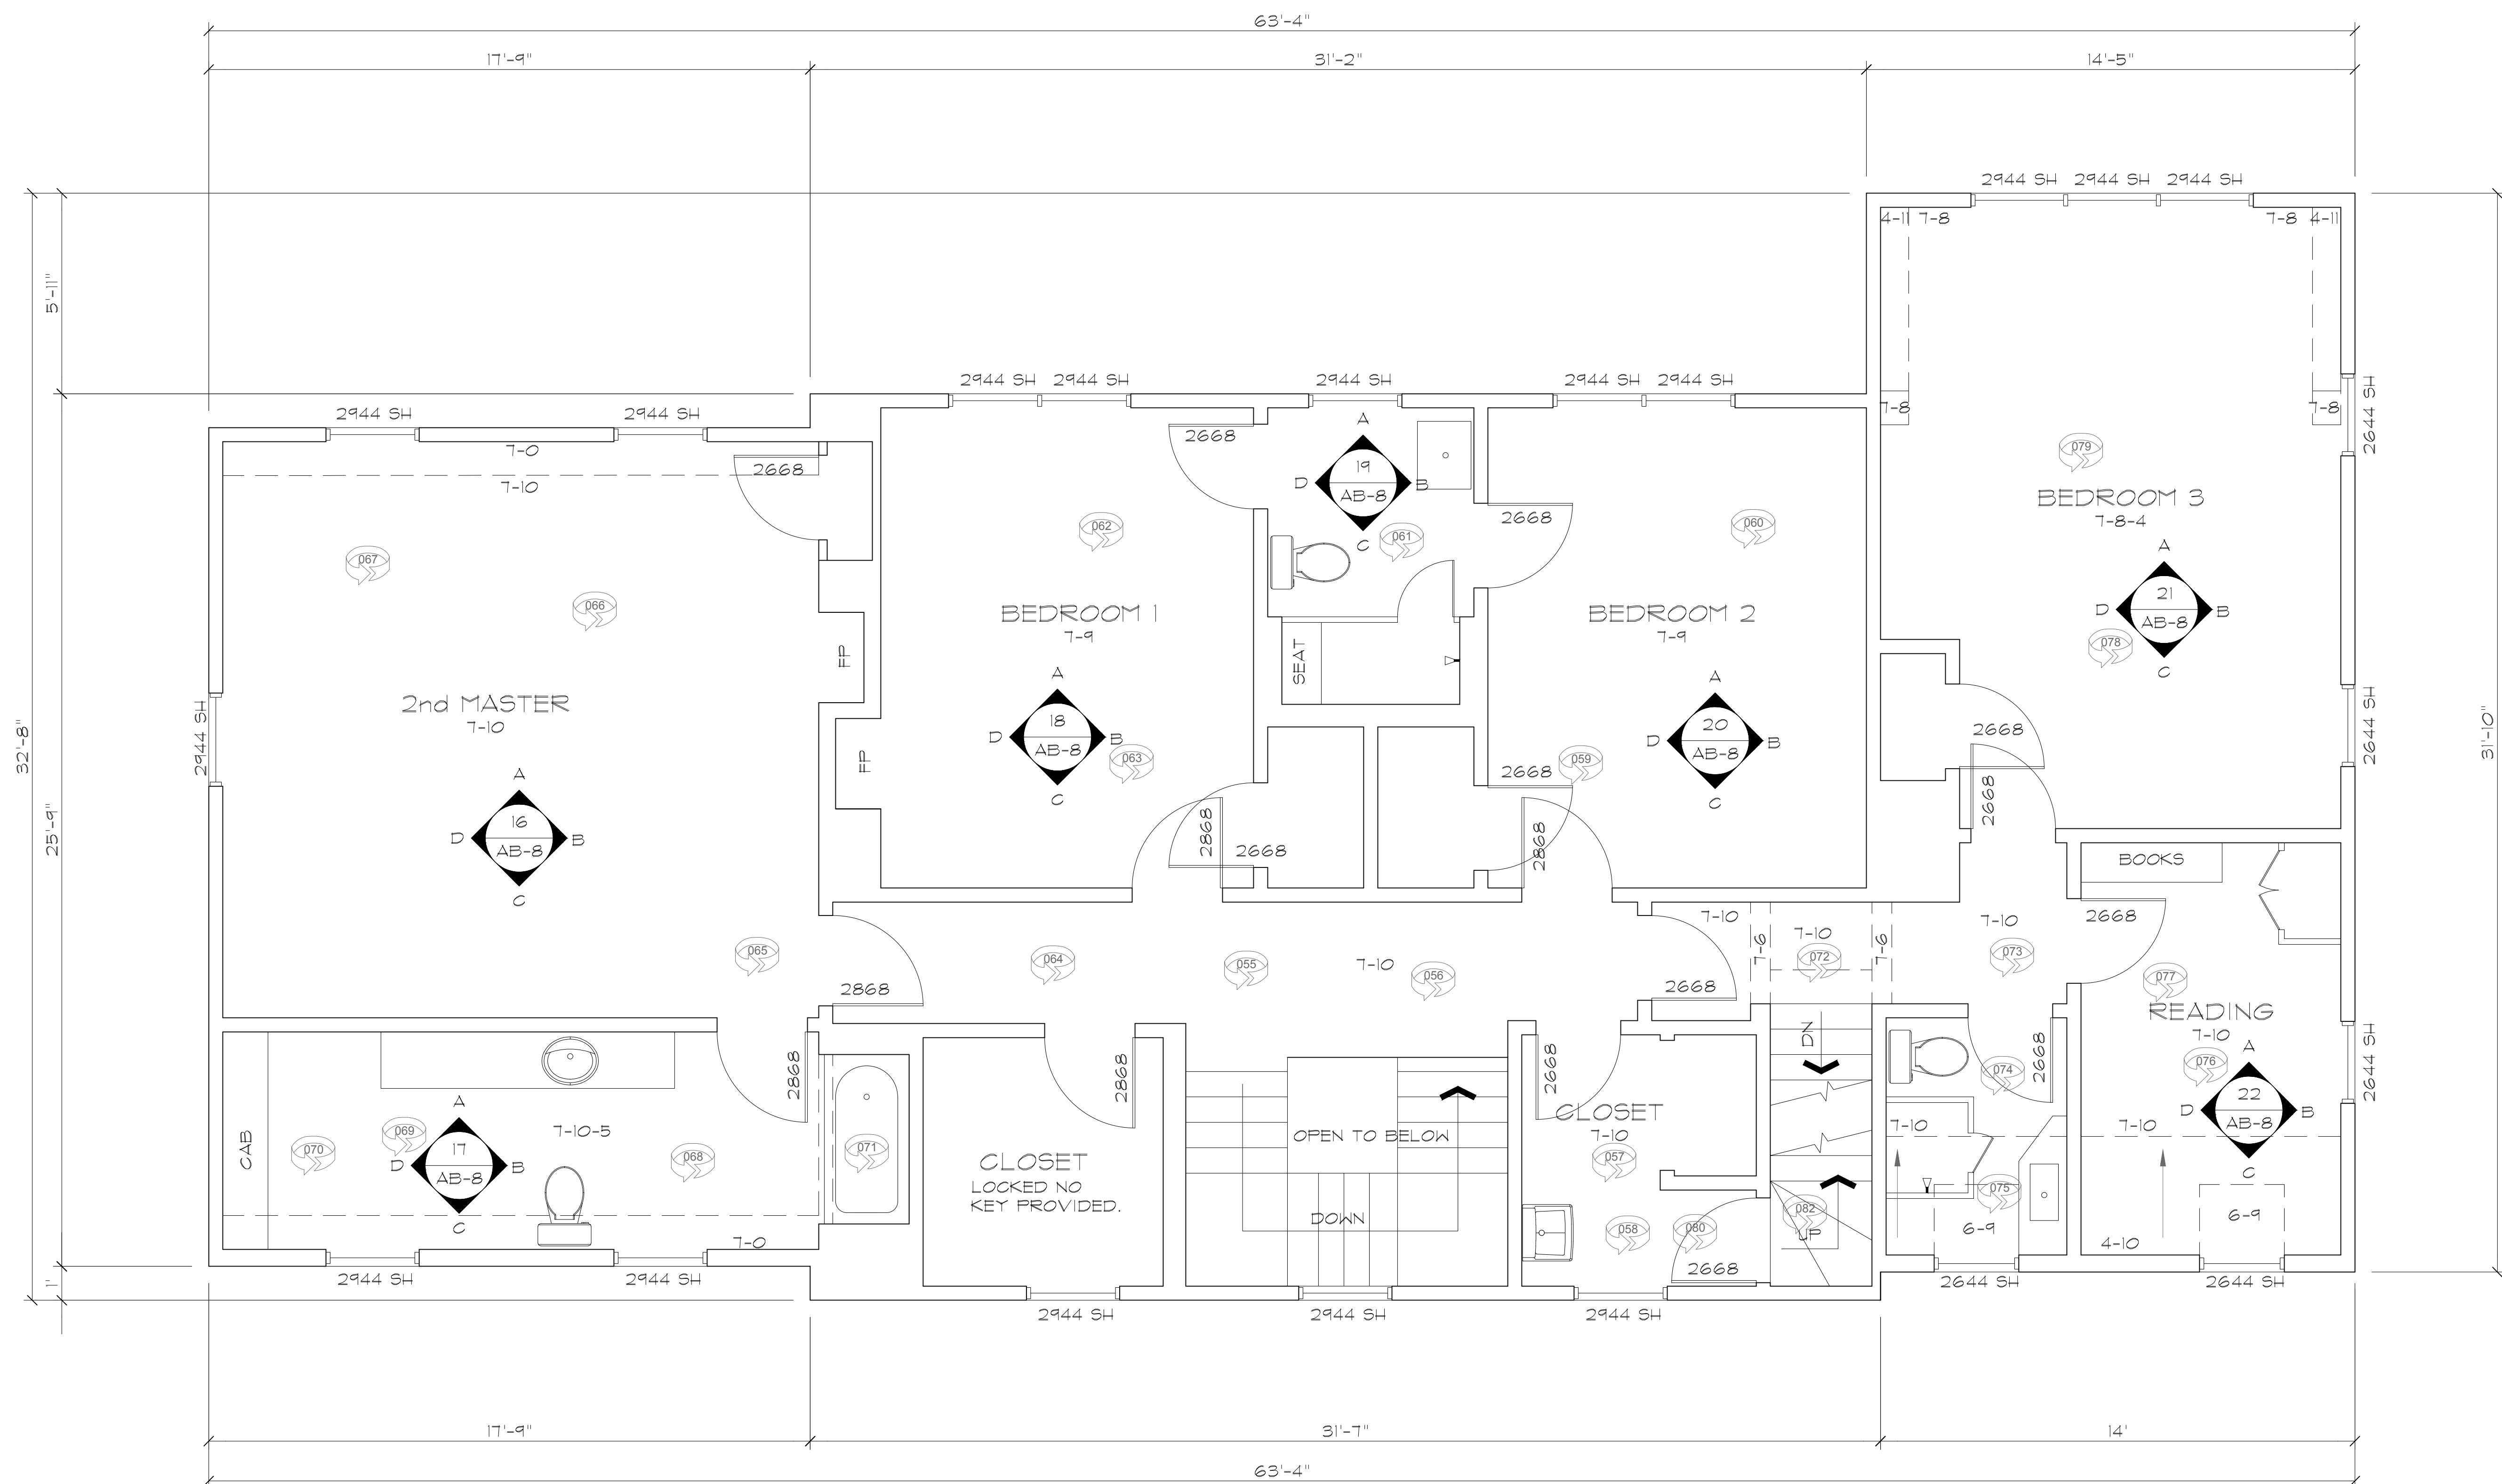


SECOND FLOOR PLAN

01	100% SUBMISSION	
NO.	ISSUES REVISIONS	DATE
		SHEET TITLE
H/L		PROJECT MANAGER
H/L		PROJECT DIRECTOR
012317-1		PROJECT NUMBER
3/8"=1'-0"		SCALE
CL		DRAWN BY
		SHEET NUMBER

AB-2

7-2-6

CEILING HEIGHT AND TRIM
7'-2" ABOVE FLOOR BELOW
WITH 6" CROWN MOULDING.
NOTE: ALL CEILINGS NOT
LABELED ARE PLASTER.
CEILINGS SHOWN WITH A GRID
ARE LAY IN ACOUSTICAL TILE..

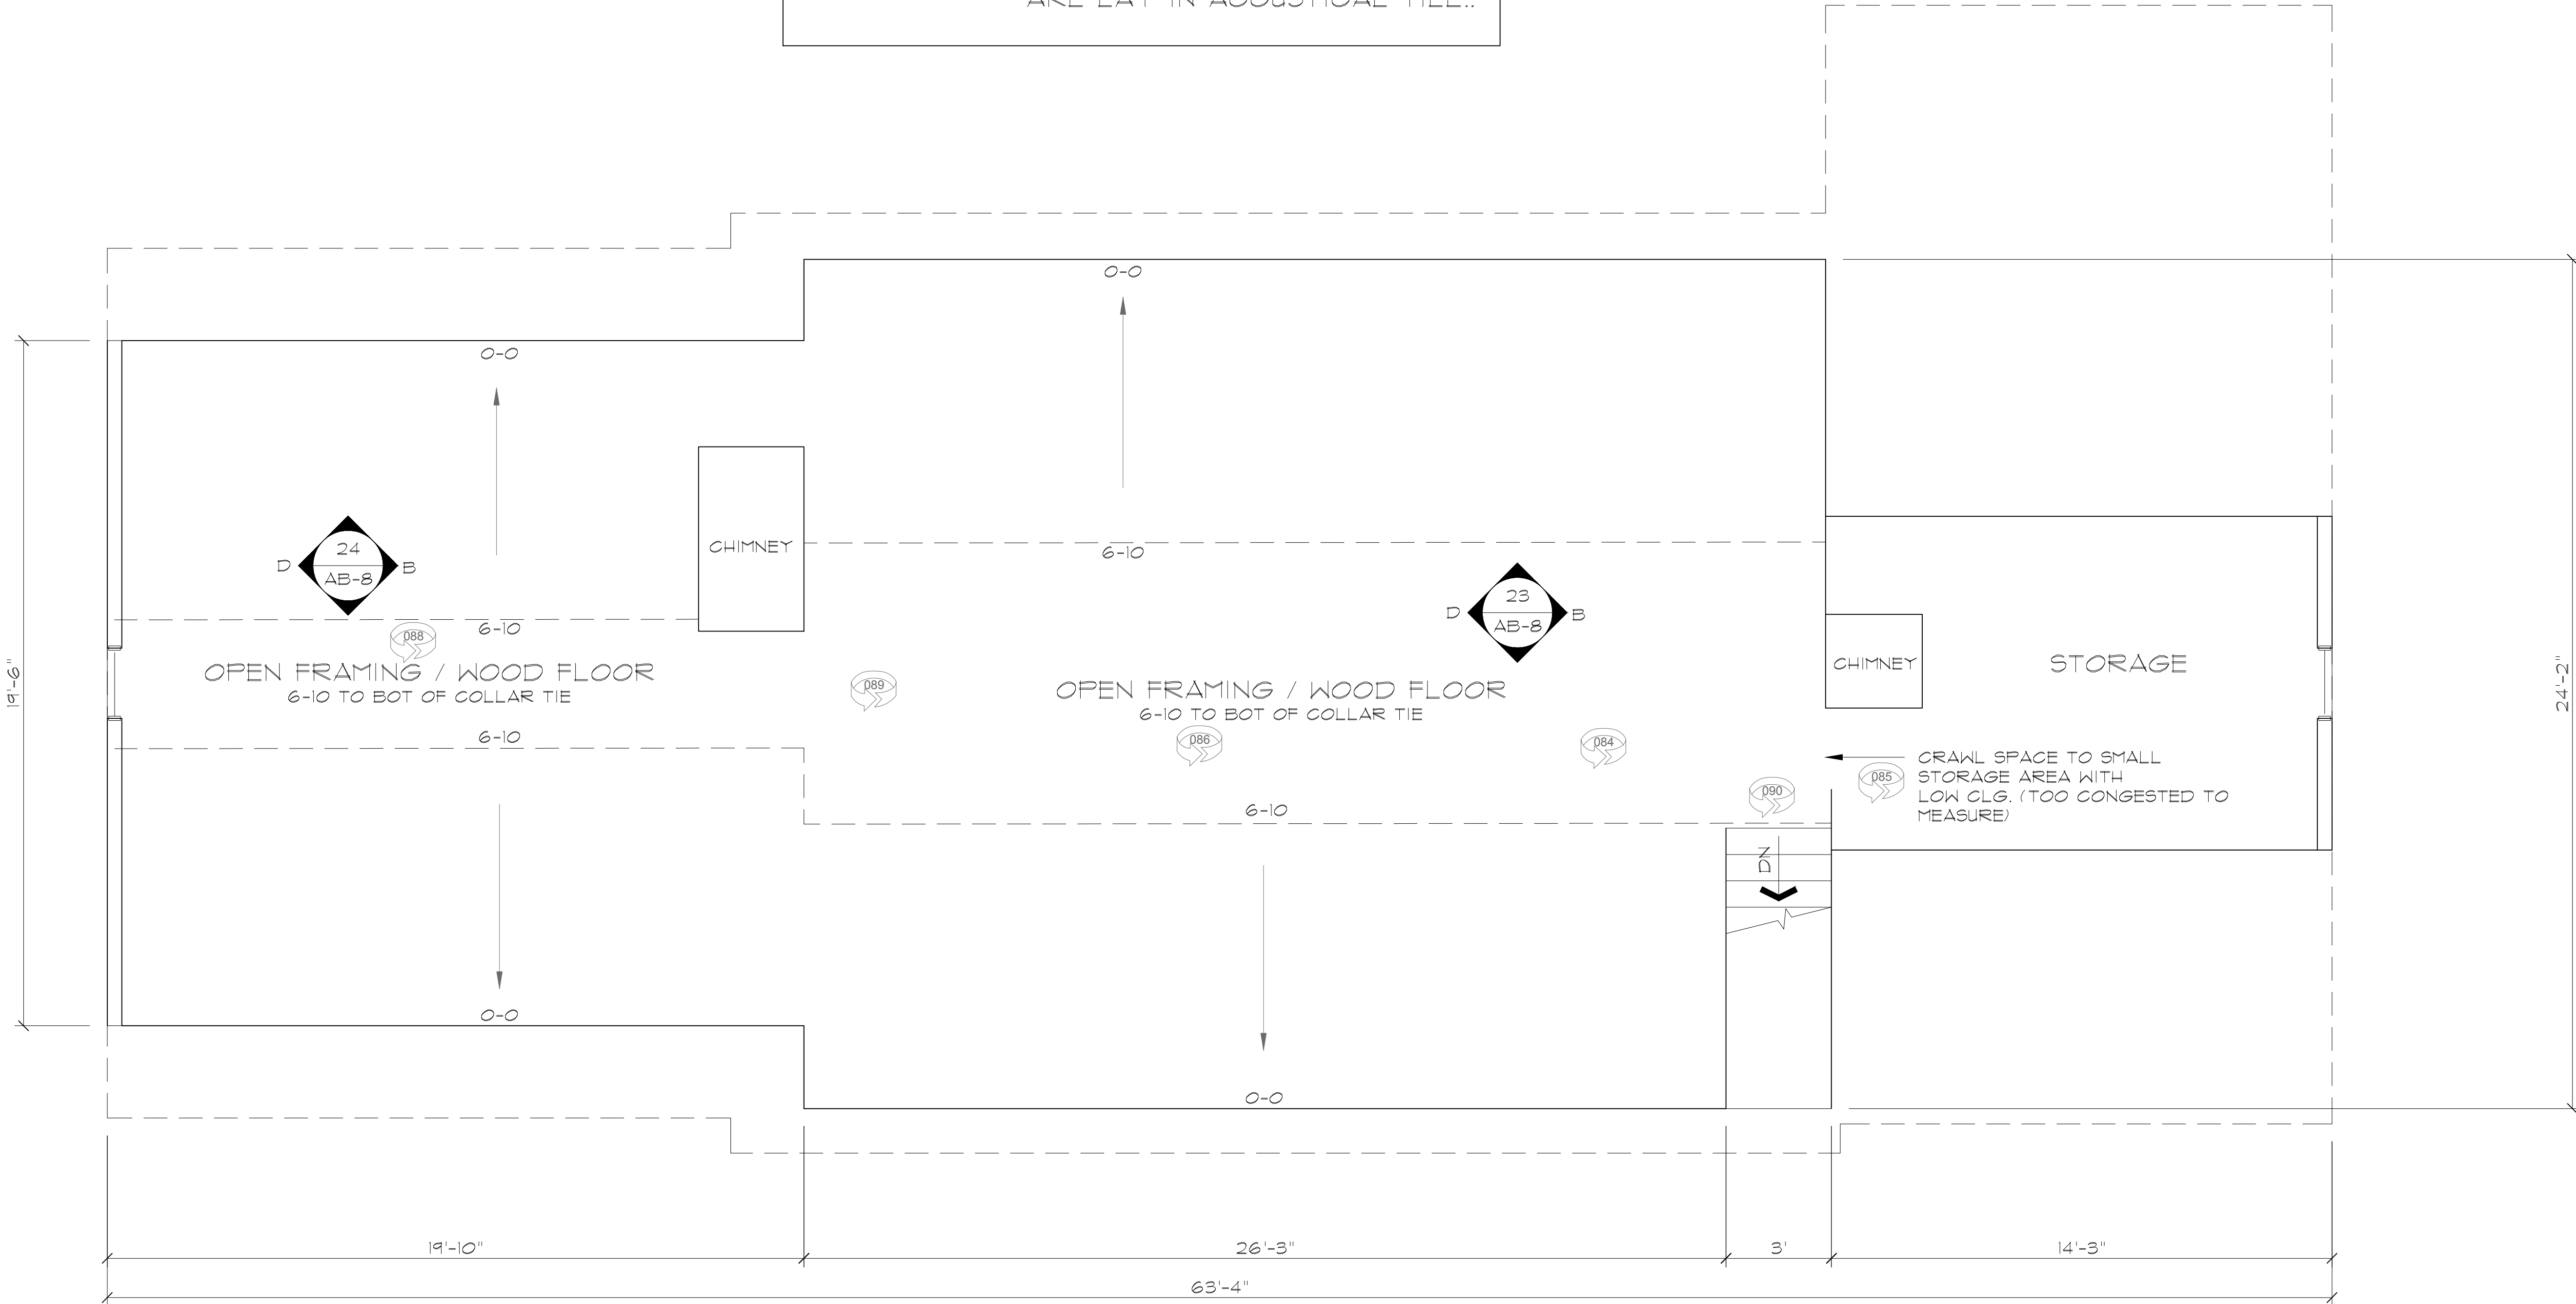

THIRD FLOOR PLAN



A DIVISION OF:




© 2017 AEC CONSULTANTS INC

ARCHITECTURAL AS BUILT FOXFIRE FARM


MUNKION MARYLAND ZIIII

01	100% SUBMISSION
NO.	ISSUES REVISIONS
SHEET TITLE	
HL	PROJECT MANAGER
HL	PROJECT DIRECTOR
012317-1	PROJECT NUMBER
SCALE	
CL	DRAWN BY
SHEET NUMBER	

AB-3

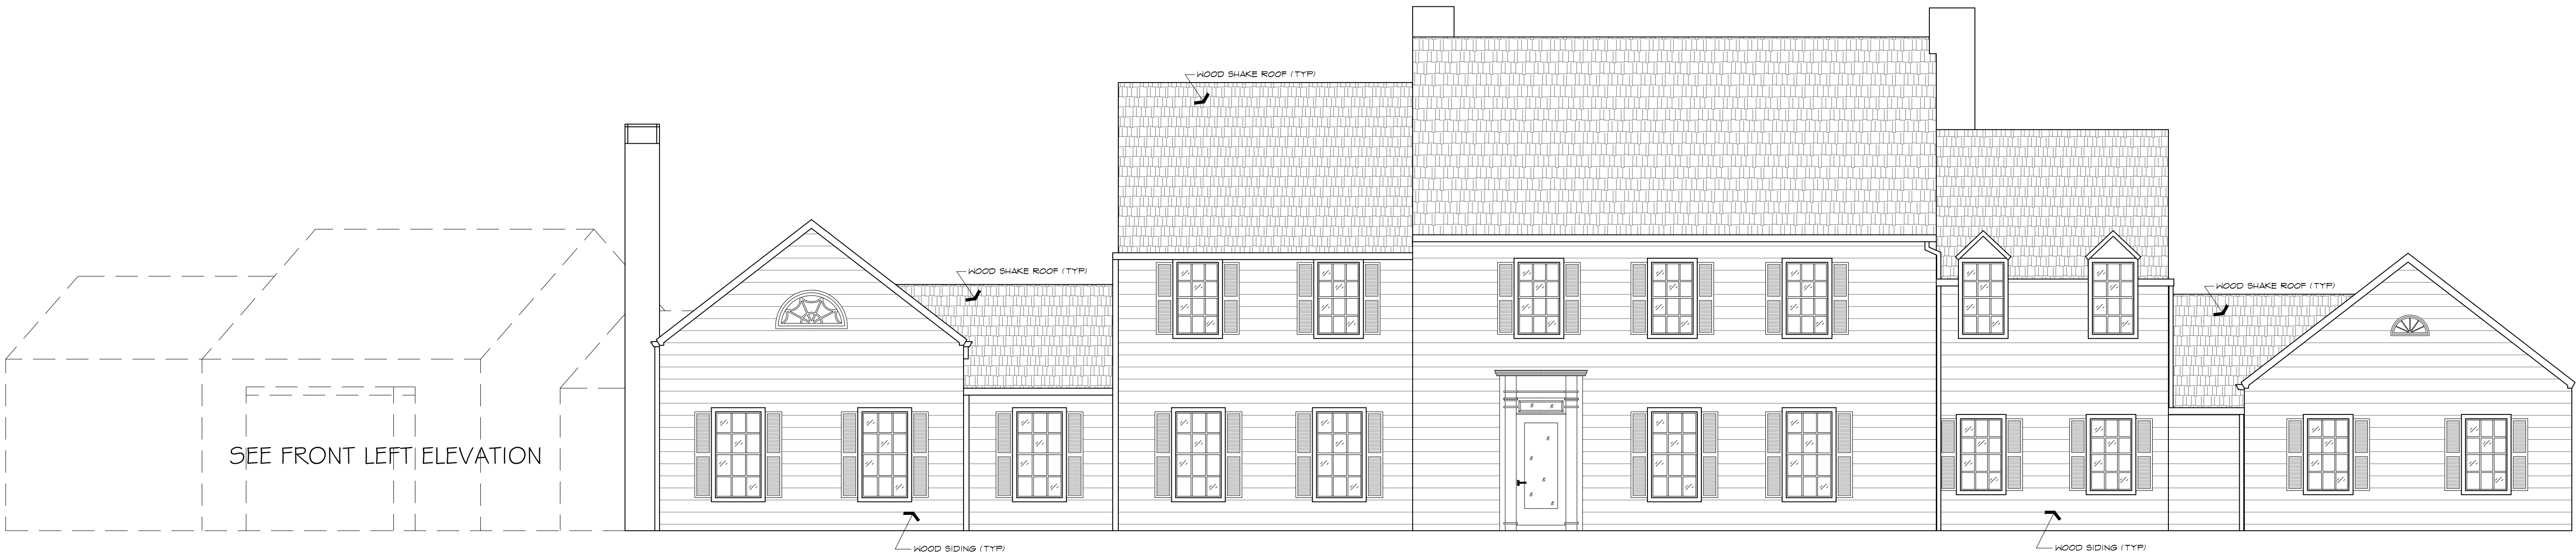

FRONT RIGHT ELEVATION

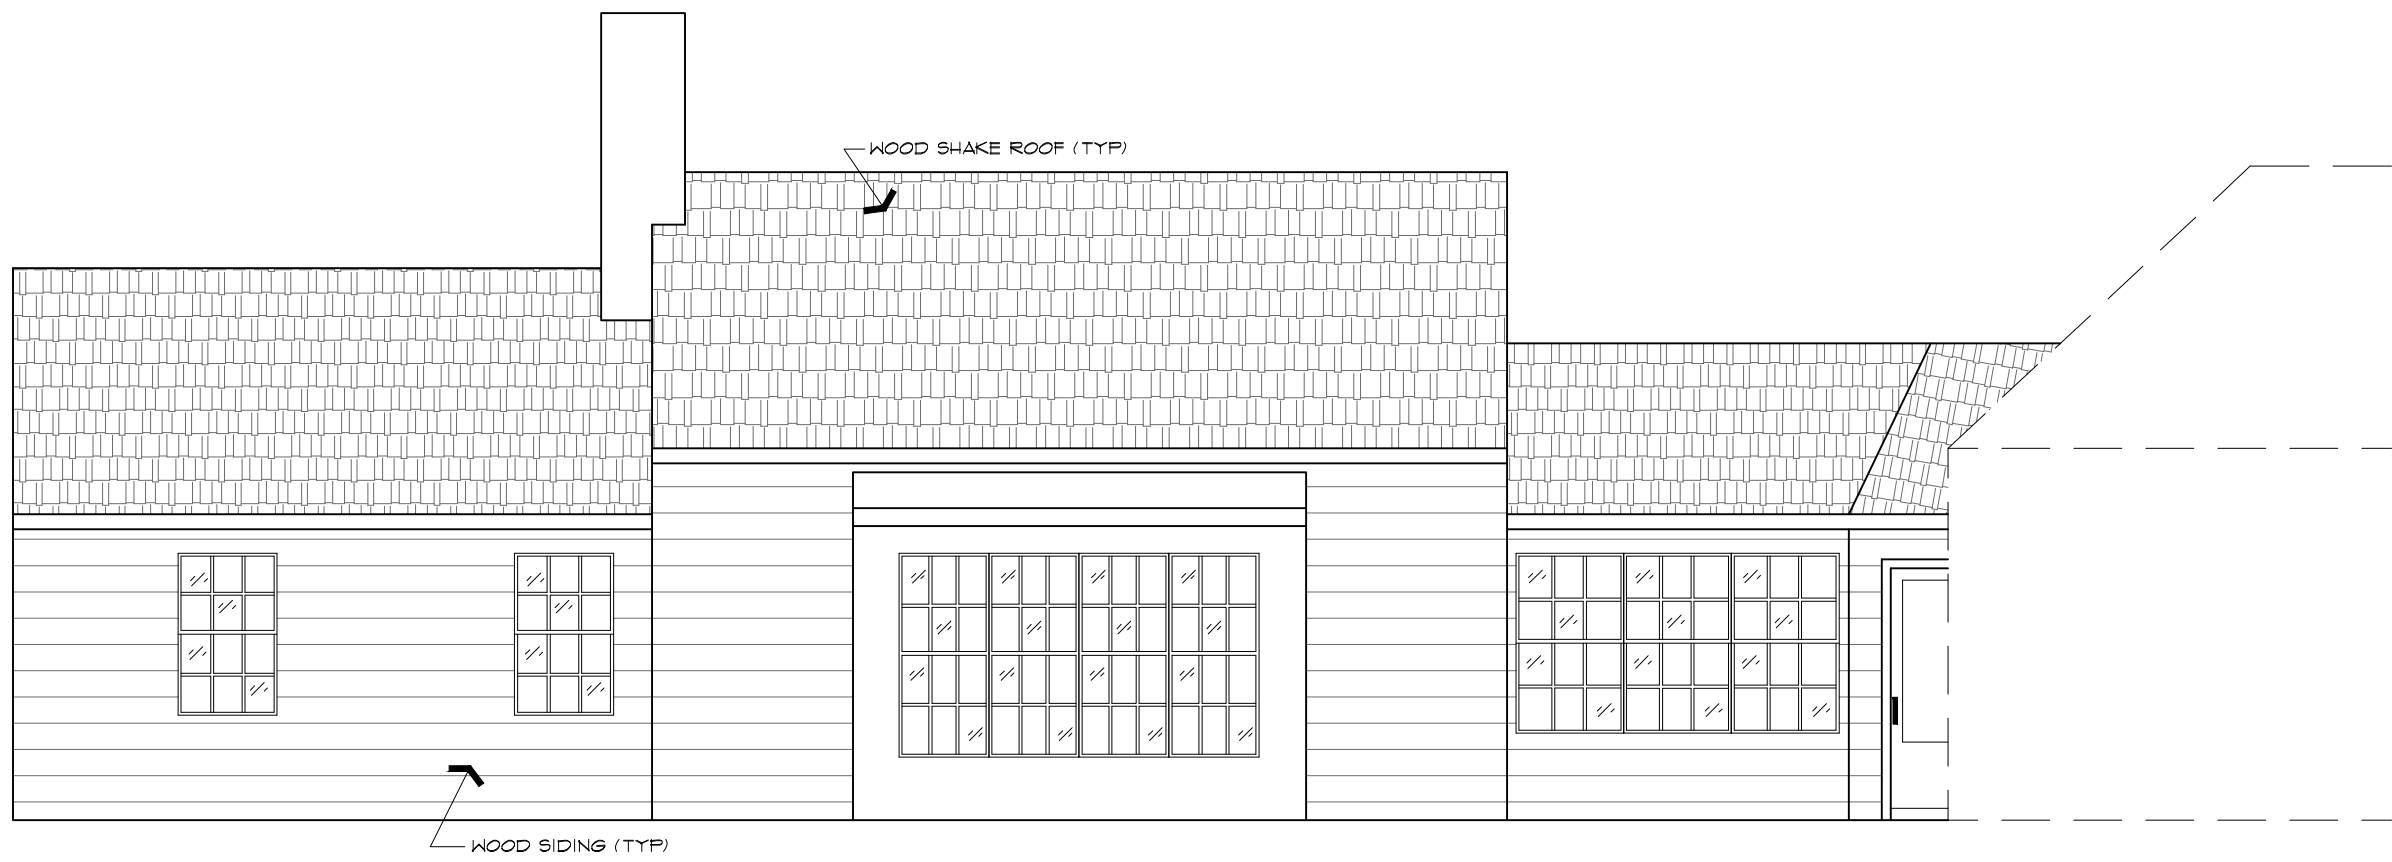

FRONT LEFT ELEVATION

As BUILT
PROFESSIONALS

A DIVISION OF:



© 2011 AEC CONSULTANTS INC

ARCHITECTURAL AS BUILT FOXFIRE FARM

MONKTON MARYLAND 21111

01 100% SUBMISSION
NO. ISSUES | REVISIONS

DATE

SHEET TITLE

HL PROJECT MANAGER

HL PROJECT DIRECTOR

012317-1 PROJECT NUMBER

3/16"=1'-0"

SCALE


CL DRAWN BY

SHEET NUMBER

AB-4



REAR LEFT ELEVATION

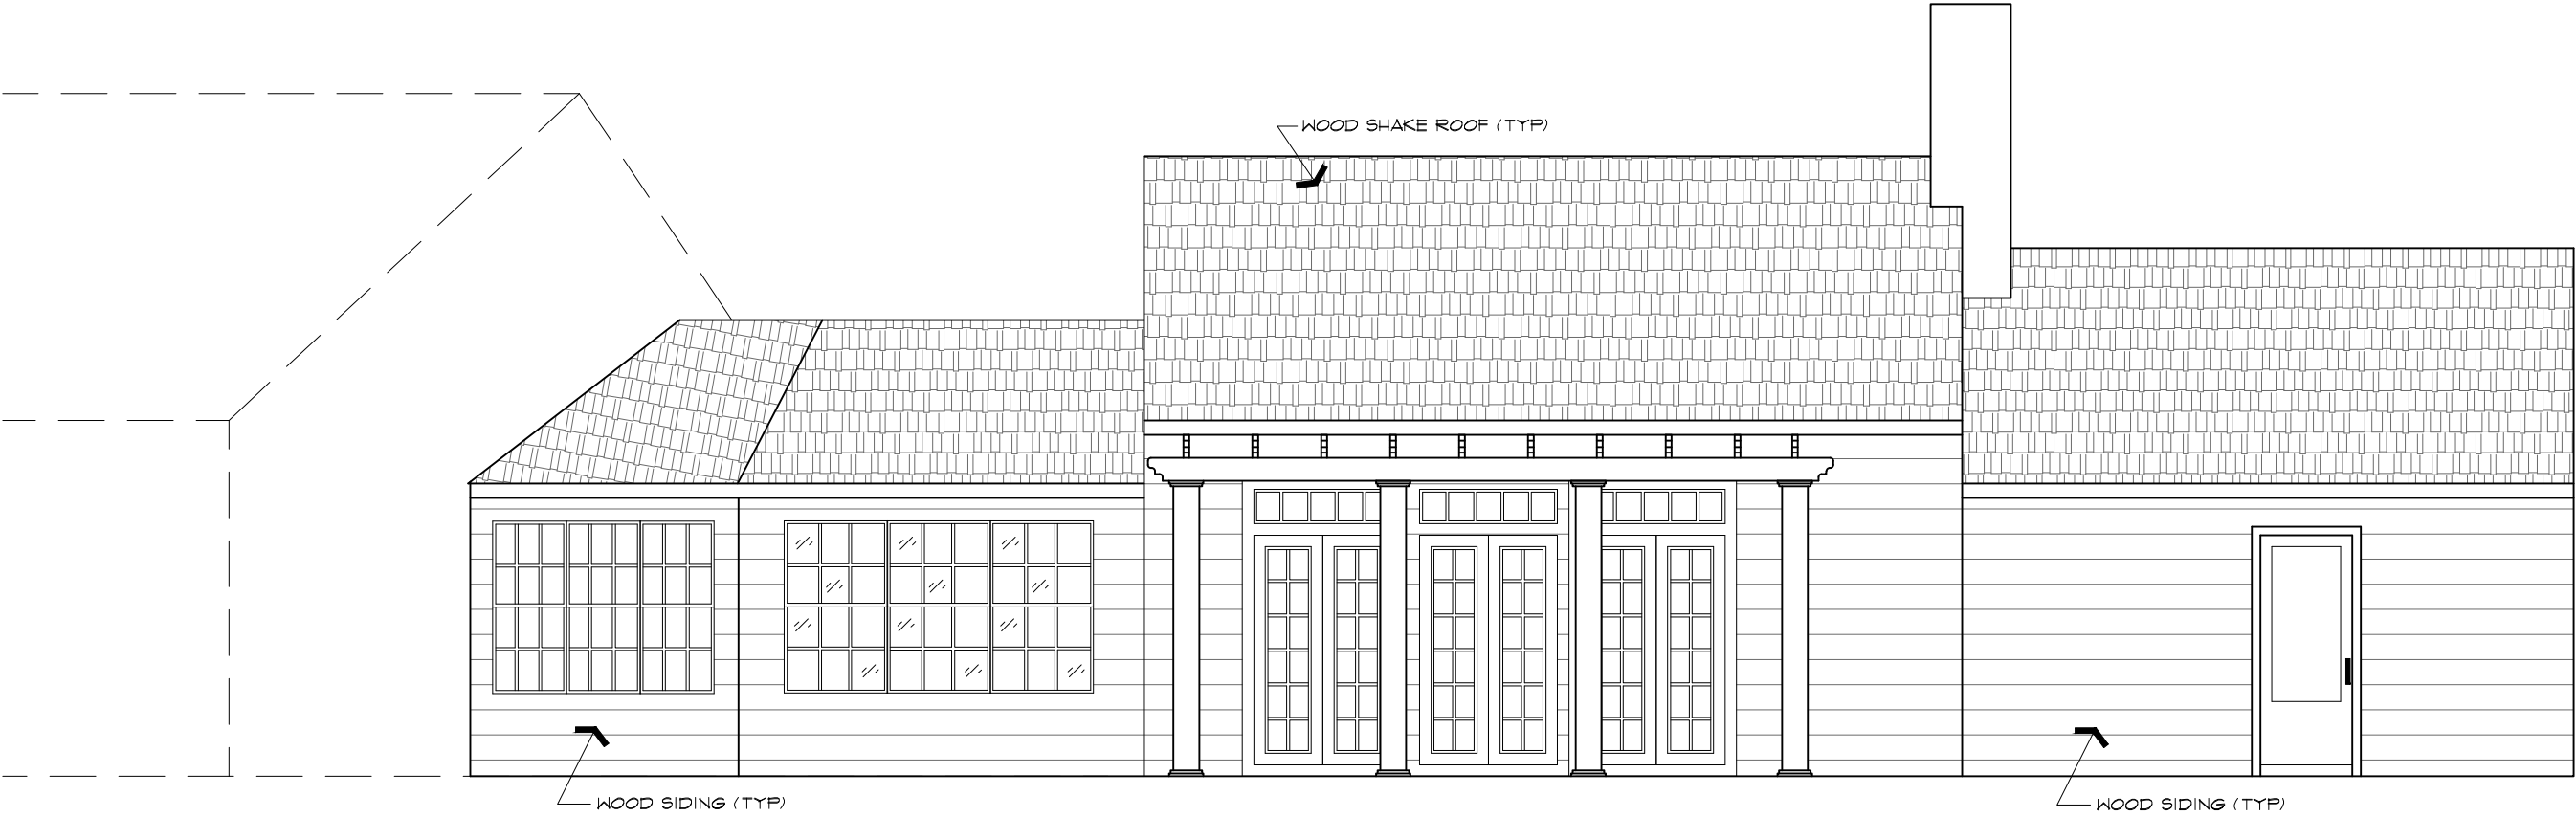

REAR RIGHT ELEVATION

As BUILT
PROFESSIONALS

A DIVISION OF:

AEC

CONSULTANTS INC

www.aecconsultantsinc.com

844.272.8458

© 2011 AEC CONSULTANTS INC

ARCHITECTURAL AS BUILT

FOXFIRE FARM

MONKTON MARYLAND 21111

01	100% SUBMISSION	
NO.	ISSUES REVISIONS	DATE
		SHEET TITLE
HL		PROJECT MANAGER
HL		PROJECT DIRECTOR
012317-1		PROJECT NUMBER
3/16"=1'-0"		SCALE
CL		DRAWN BY
		SHEET NUMBER

AB-5

A line drawing of a door with a handle and a lock, set within a frame. The door has a handle and a lock, and is shown in a slightly open position. The frame is simple and rectangular.

This architectural drawing shows the front elevation of a building. It features a gabled roof with a dashed line indicating the peak. The facade is composed of a large, plain rectangular section on the right and a smaller, more detailed section on the left. This left section contains a door with a transom window above it, both featuring decorative grid patterns. The entire structure is framed by a simple border.

WINDOW SEAT

WOOD CLG

WOOD CLG

The diagram shows two window units side-by-side, both labeled "WOOD CLG". The left unit is a large window with a 3x4 grid of 12 small panes. The right unit is a smaller window with a 2x3 grid of 6 small panes. Both units have a decorative base and are set within a larger frame.

WOOD CLG

WOOD CLG

WOOD CLG

A simple line drawing of a building facade. It features a large rectangular window on the left and a door on the right. The door has a small handle and a lock. The building is represented by a few simple lines, suggesting a minimalist architectural style.

A line drawing of a door with a handle, labeled "WOOD SEAT". The door has a six-pane design with two vertical rectangular panes in the center and four smaller square panes at the top. A small black dot represents the handle. The label "WOOD SEAT" is written in a box to the right of the door.

The diagram shows a window on the left with a closed shutter, indicated by a small black dot. To the right of the window is a radiator with a label that reads "HEAT".



As BUILT
PROFESSIONALS

A DIVISION OF:

AEC

CONSULTANTS INC

www.aecconsultantsinc.com


844.272.8458

© 2017 AEC CONSULTANTS INC


MONKTON MARYLAND 21111

01	100% SUBMISSION	
NO.	ISSUES REVISIONS	DATE
		SHEET TITLE
HL		PROJECT MANAGER
HL		PROJECT DIRECTOR
012317-1		PROJECT NUMBER
1/4"=1'-0"		SCALE
CL		DRAWN BY
		SHEET NUMBER

 
AB-6




INTERIOR ELEVATION 8-A

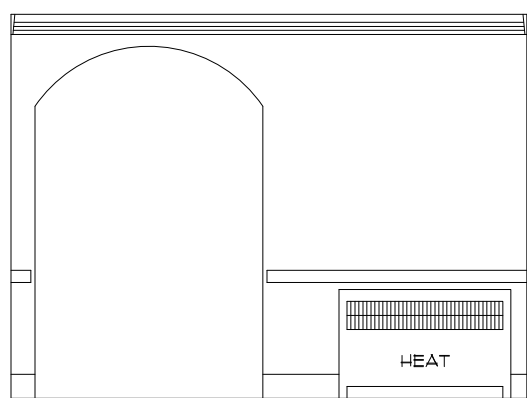

INTERIOR ELEVATION 8-B

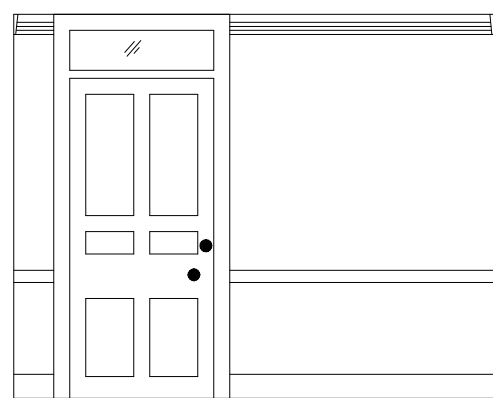


INTERIOR ELEVATION 8-C

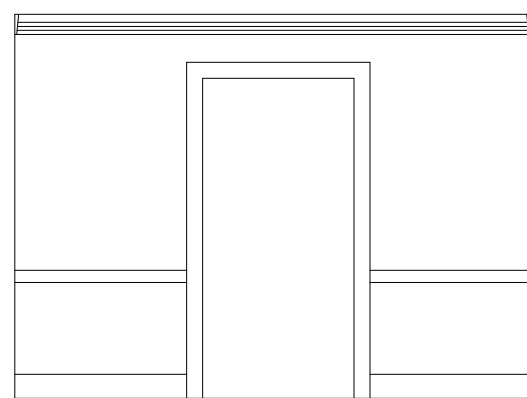


INTERIOR ELEVATION 8-D




INTERIOR ELEVATION 9-A

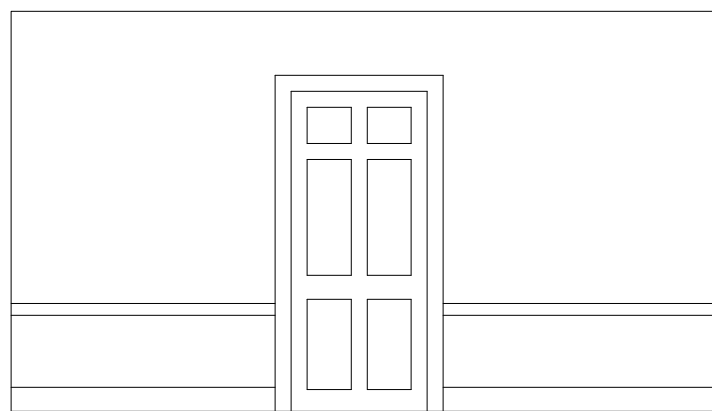

INTERIOR ELEVATION 9-B

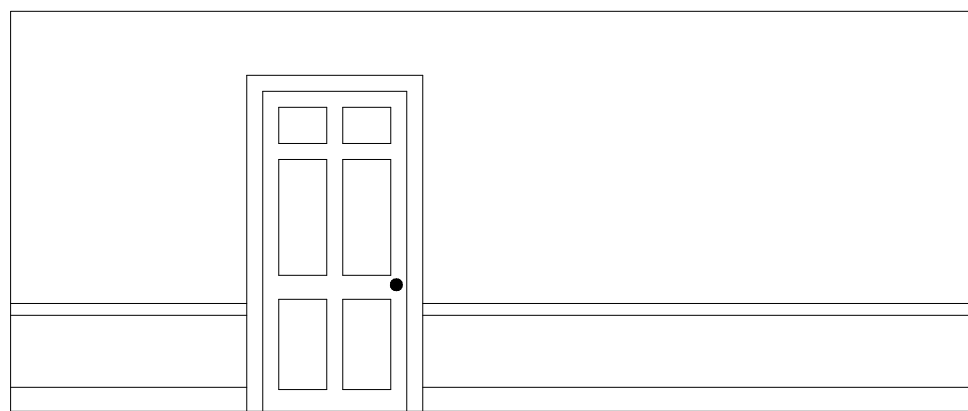

INTERIOR ELEVATION 9-C

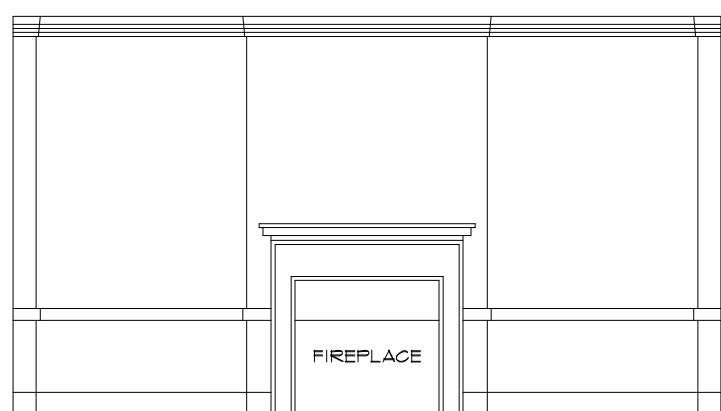


INTERIOR ELEVATION 9-D



INTERIOR ELEVATION 10-A



INTERIOR ELEVATION 10-B

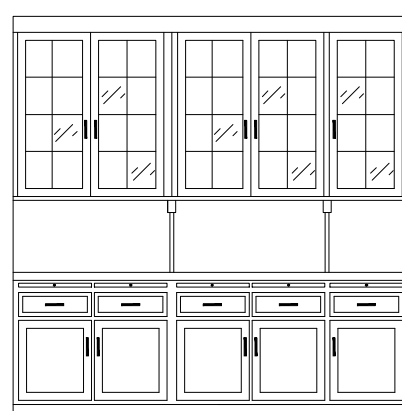


INTERIOR ELEVATION 10-C




INTERIOR ELEVATION 10-D



INTERIOR ELEVATION 11-A

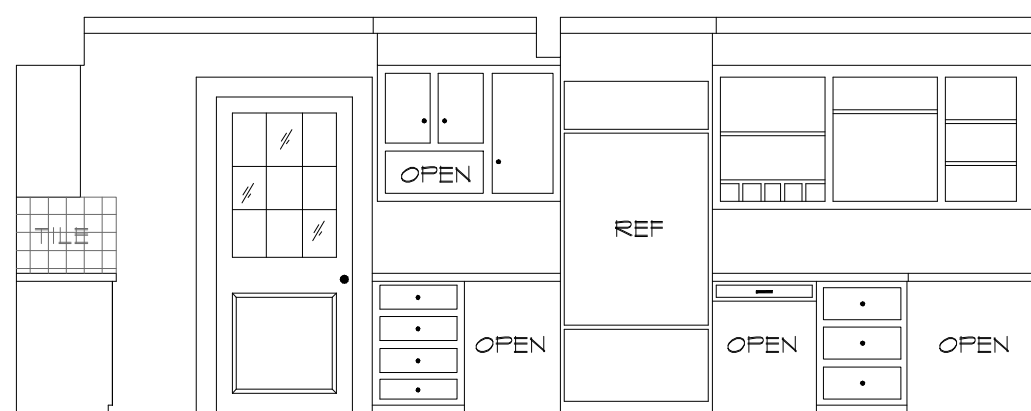


INTERIOR ELEVATION 11-B

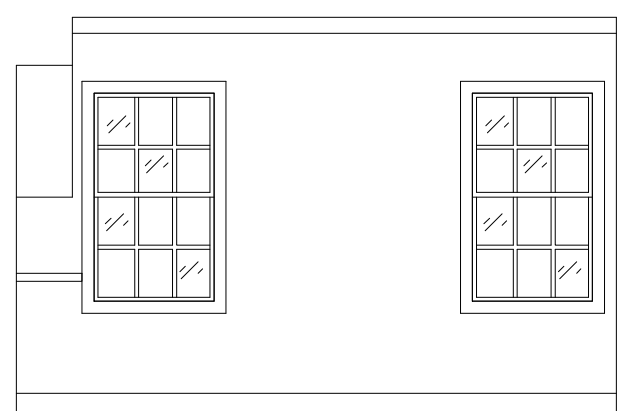


INTERIOR ELEVATION 11-C




INTERIOR ELEVATION 11-D

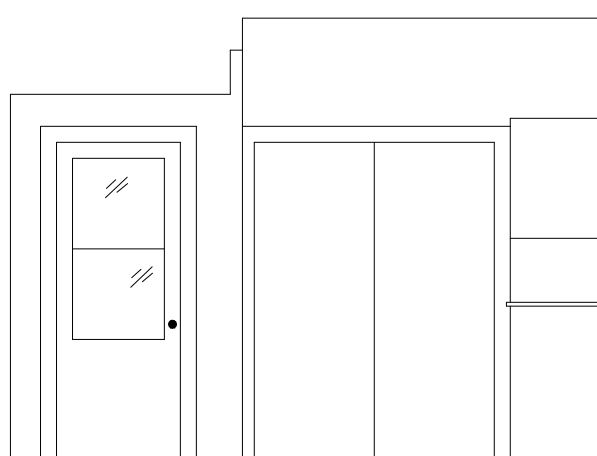


INTERIOR ELEVATION 13-A
WOOD WALLS AND CEILING

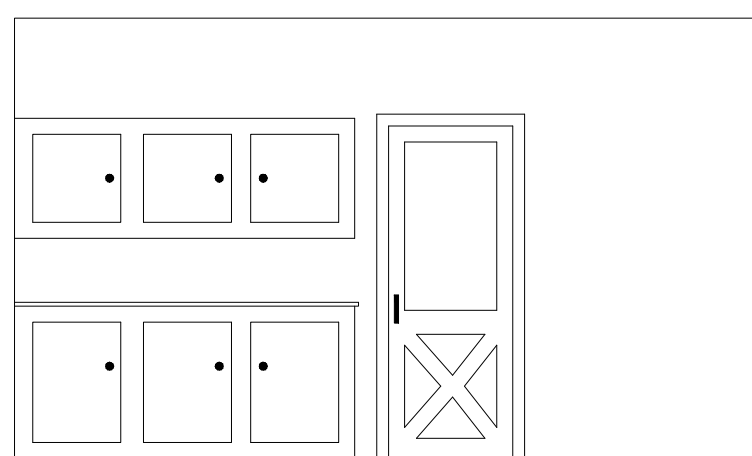


INTERIOR ELEVATION 13-B
WOOD WALLS AND CEILING

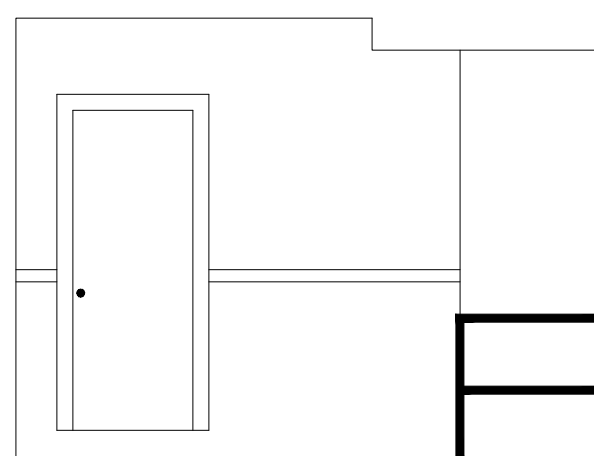

INTERIOR ELEVATION 13-C
WOOD WALLS AND CEILING

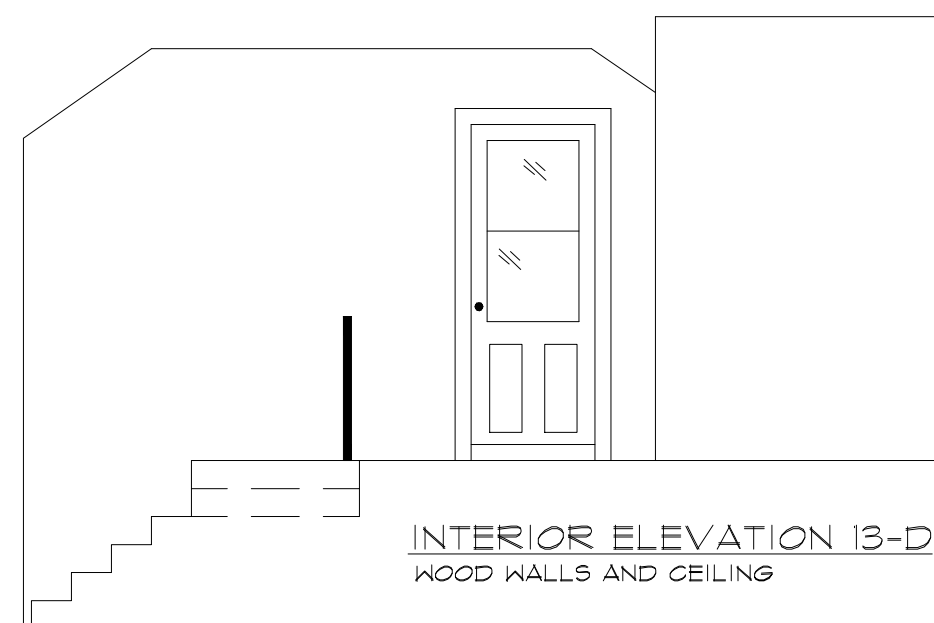

INTERIOR ELEVATION 13-D
WOOD WALLS AND CEILING

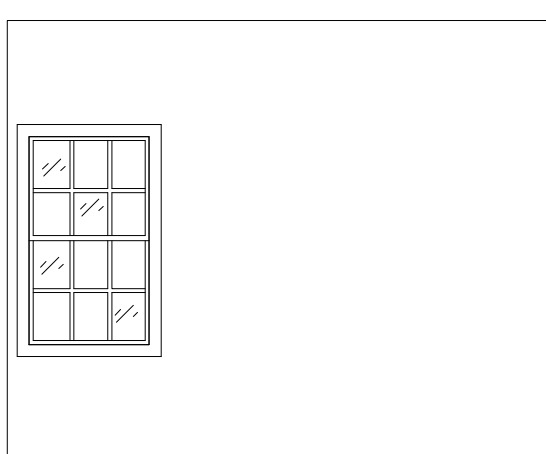


INTERIOR ELEVATION 14-A
WOOD WALLS AND CEILING




INTERIOR ELEVATION 14-B
WOOD WALLS AND CEILING



INTERIOR ELEVATION 15-A

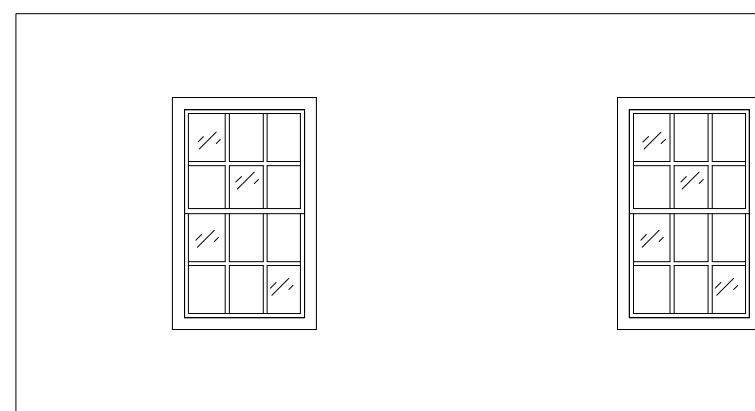

INTERIOR ELEVATION 15-C

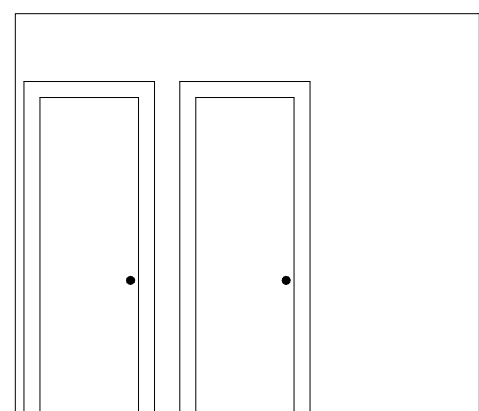

INTERIOR ELEVATION 15-D

AS BUILT
PROFESSIONALS

A DIVISION OF:

AEC

CONSULTANTS INC

www.aecconsultantsinc.com

844.272.8458


© 2011 AEC CONSULTANTS INC

ARCHITECTURAL AS BUILT
FOXFIRE FARM


MONKTON MARYLAND 21111

01	100% SUBMISSION	
NO.	ISSUES REVISIONS	DATE
		SHEET TITLE
HL		PROJECT MANAGER
HL		PROJECT DIRECTOR
012317-1		PROJECT NUMBER
1/4"=1'-0"		SCALE
CL		DRAWN BY
		SHEET NUMBER

AB-7

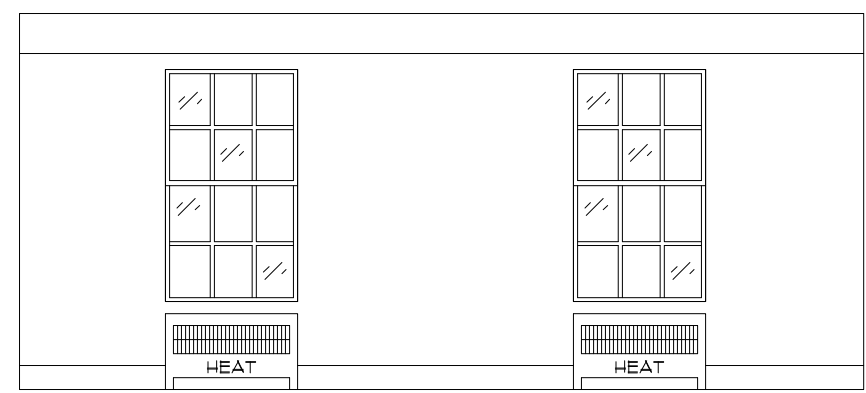


INTERIOR ELEVATION 16-A

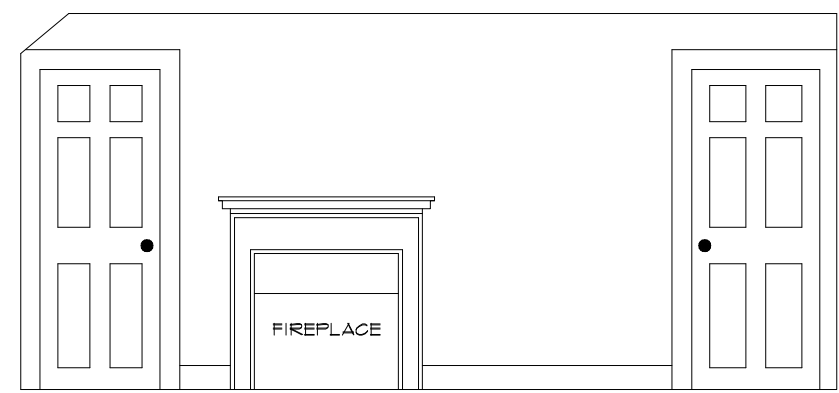


INTERIOR ELEVATION 16-B




INTERIOR ELEVATION 16-C

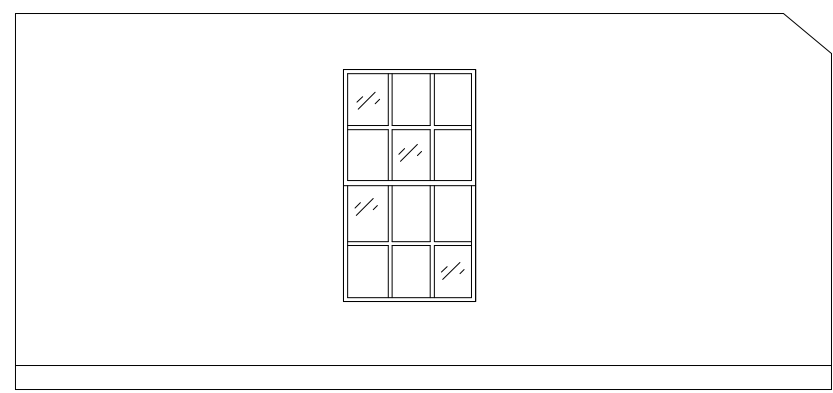


INTERIOR ELEVATION 16-D

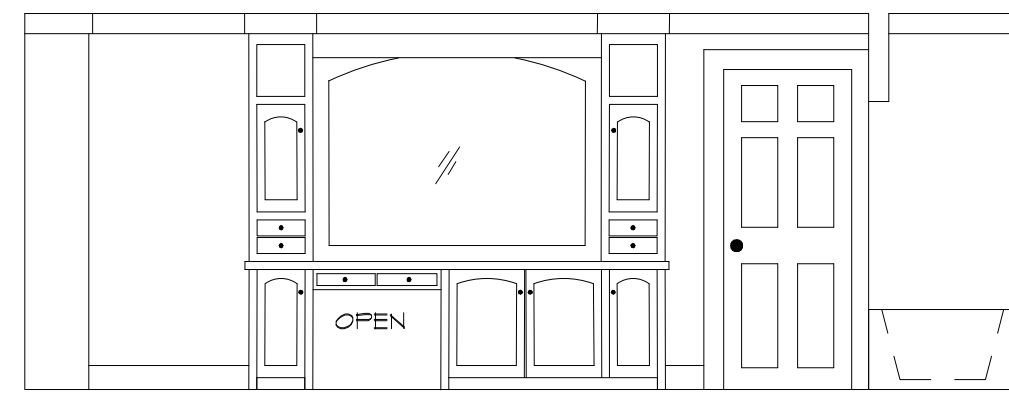


INTERIOR ELEVATION 17-A

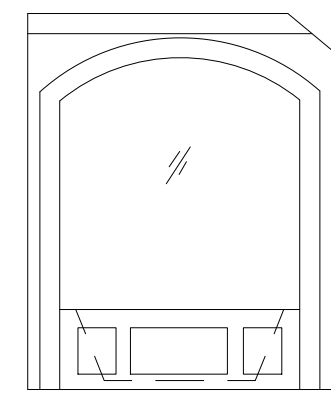


INTERIOR ELEVATION 17-B

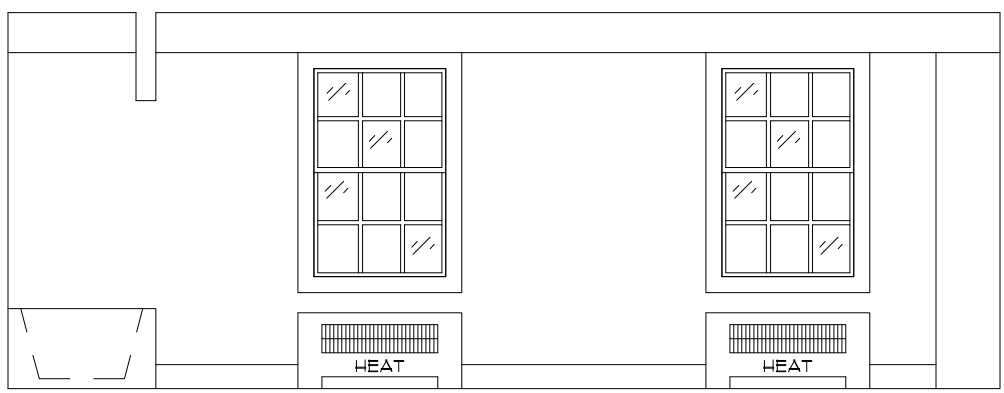


INTERIOR ELEVATION 17-A

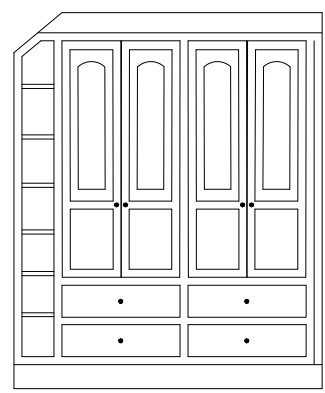


INTERIOR ELEVATION 17-D

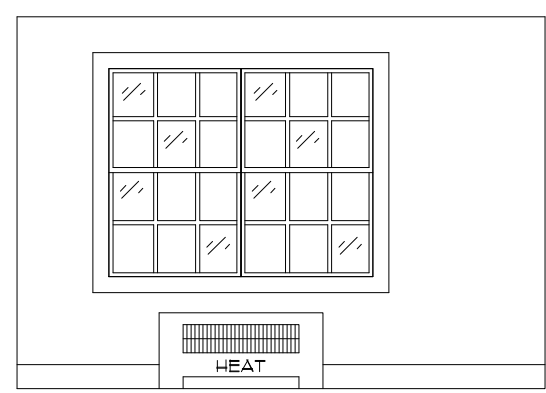


INTERIOR ELEVATION 18-A

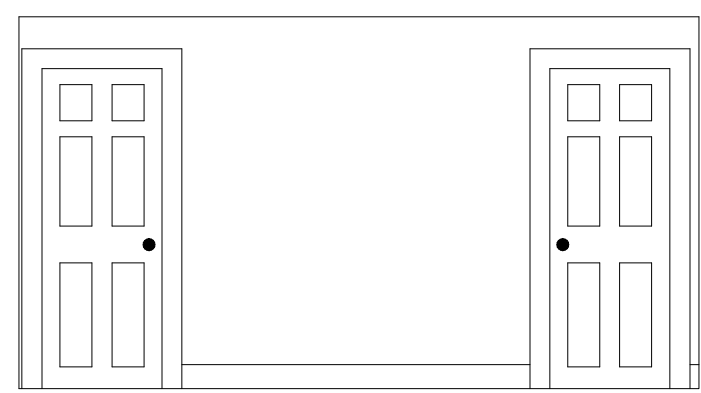


INTERIOR ELEVATION 18-B

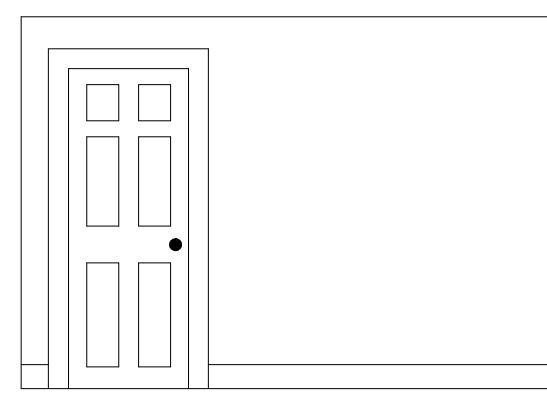


INTERIOR ELEVATION 18-C

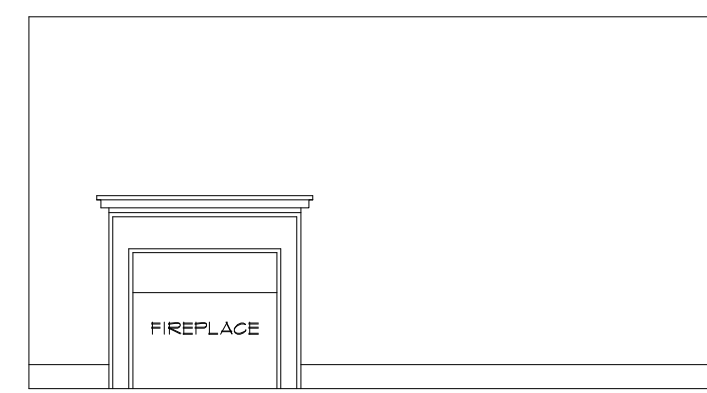


INTERIOR ELEVATION 18-D

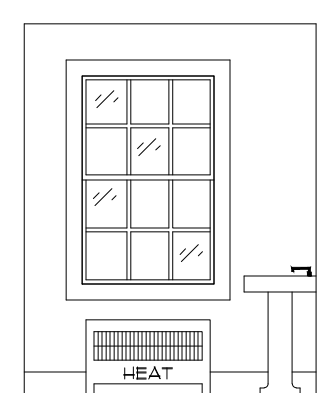


INTERIOR ELEVATION 19-A

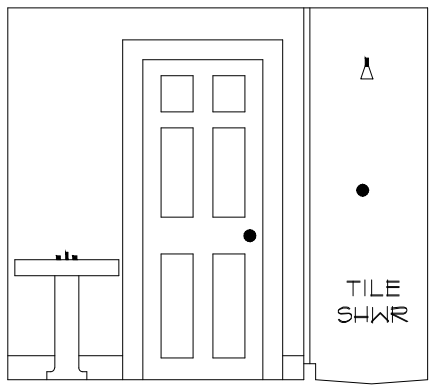


INTERIOR ELEVATION 19-B

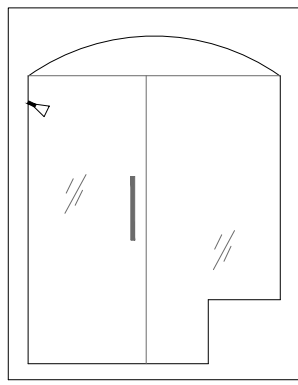


INTERIOR ELEVATION 19-C

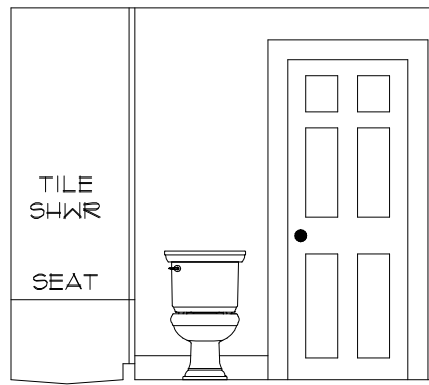


INTERIOR ELEVATION 19-D

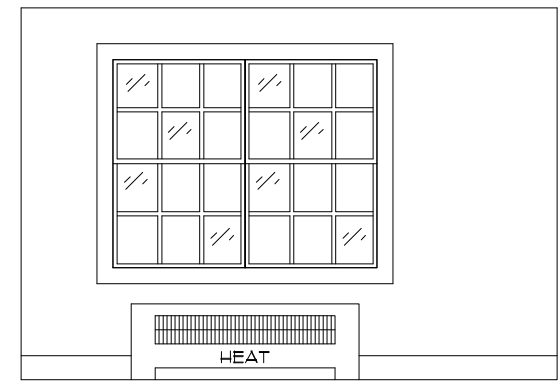


INTERIOR ELEVATION 20-A

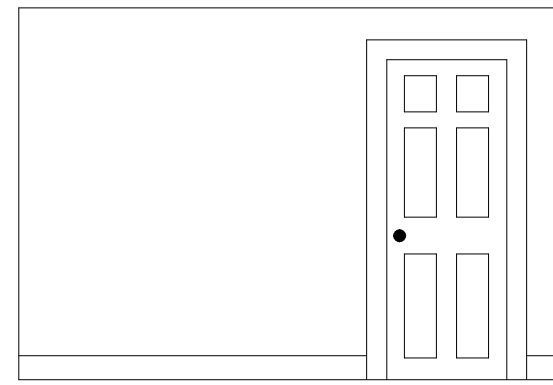


INTERIOR ELEVATION 20-C

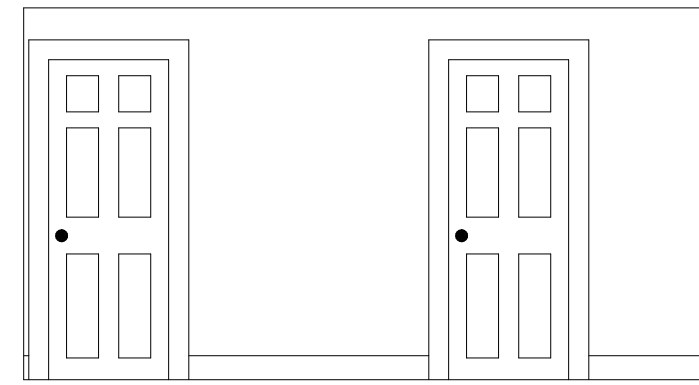


INTERIOR ELEVATION 20-D

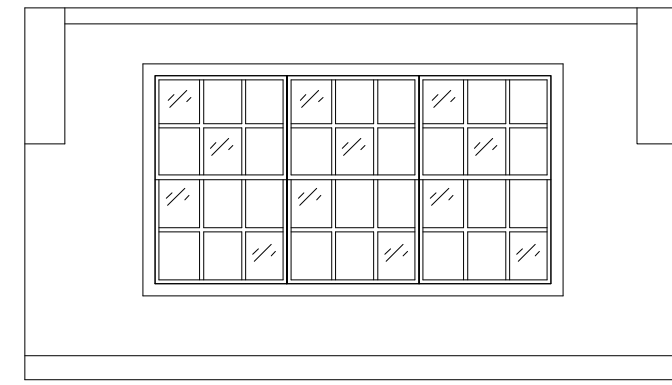


INTERIOR ELEVATION 21-A

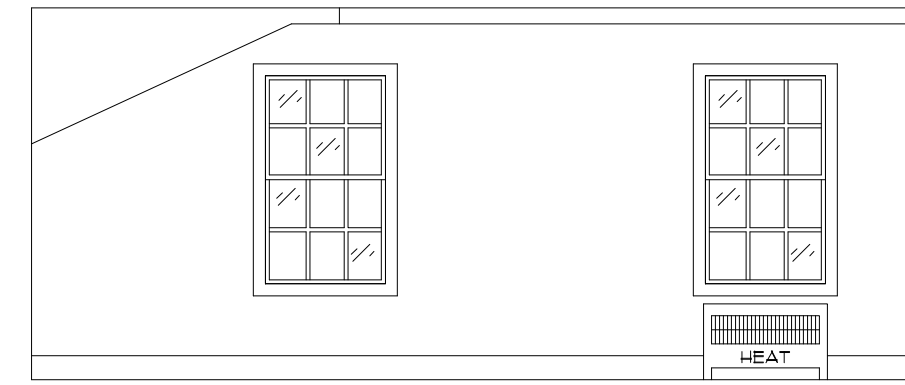


INTERIOR ELEVATION 21-B

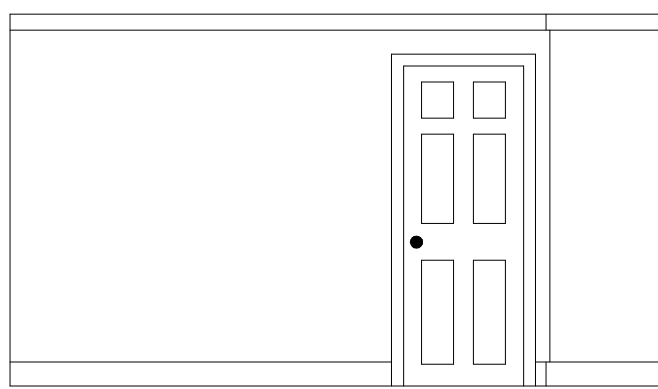


INTERIOR ELEVATION 21-C

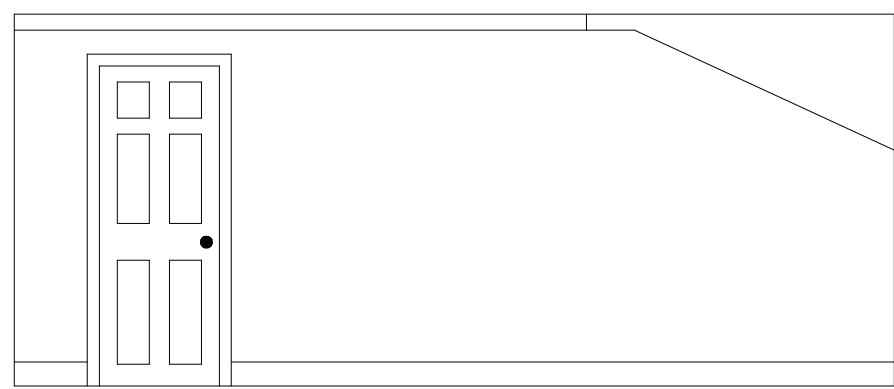


INTERIOR ELEVATION 21-D

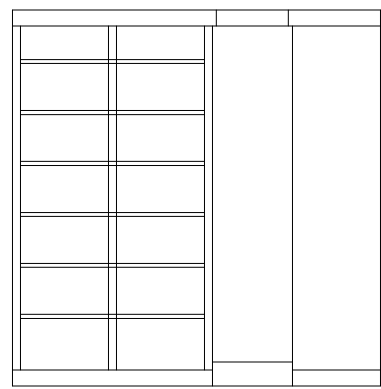


INTERIOR ELEVATION 22-A

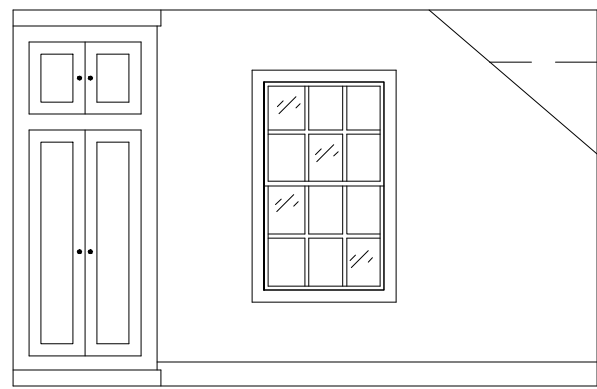


INTERIOR ELEVATION 22-B

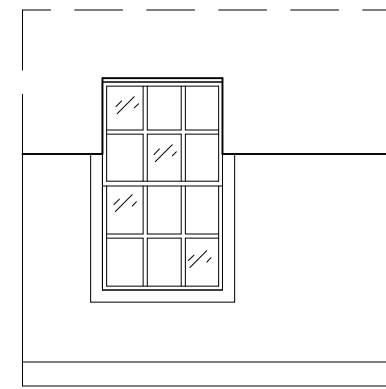


INTERIOR ELEVATION 22-C

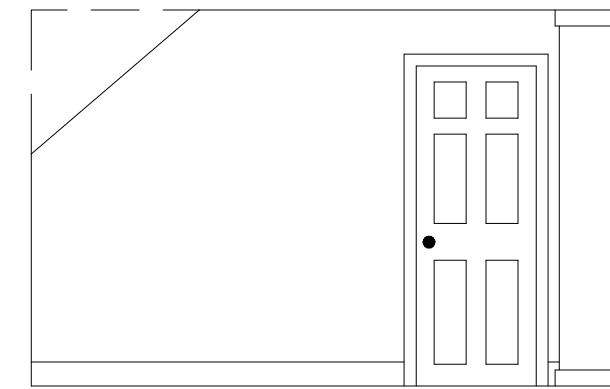


INTERIOR ELEVATION 22-D

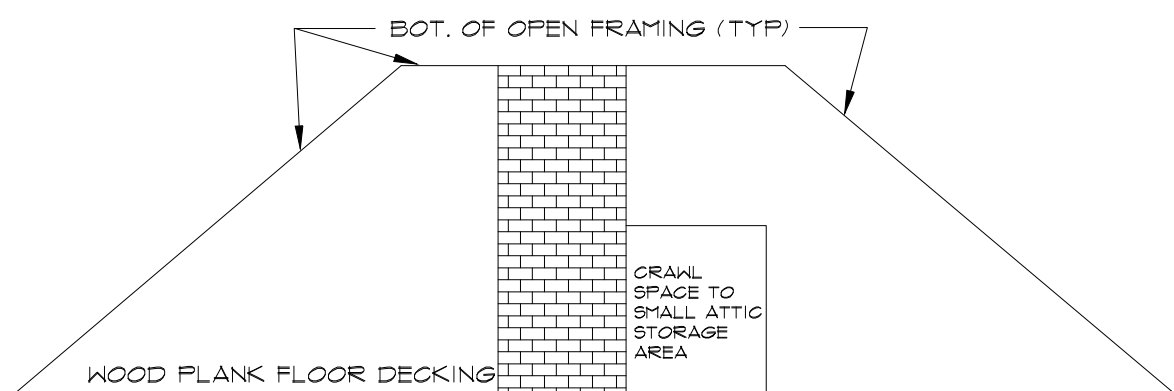


INTERIOR ELEVATION 23-B

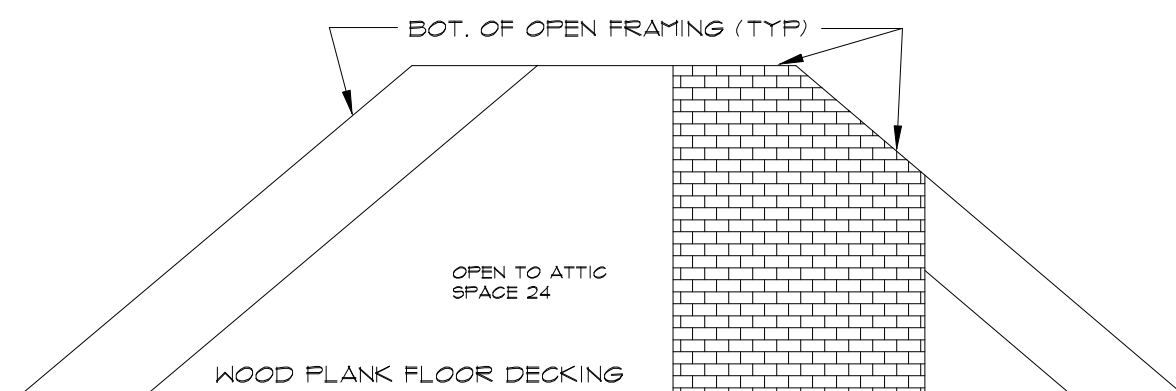

INTERIOR ELEVATION 23-D

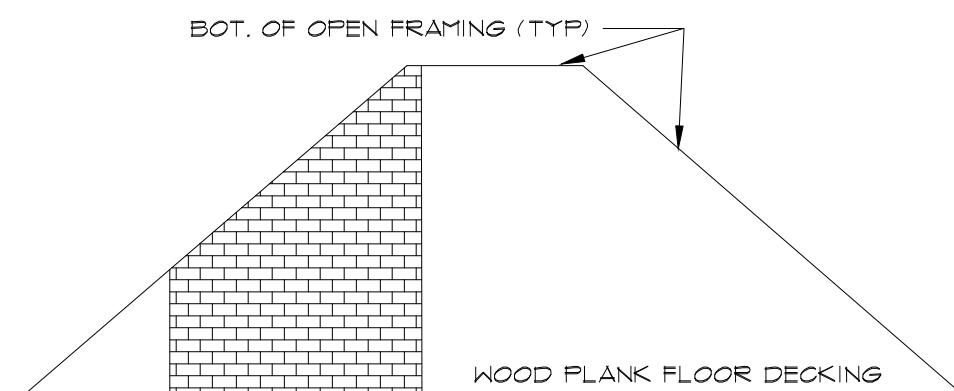

INTERIOR ELEVATION 24-B

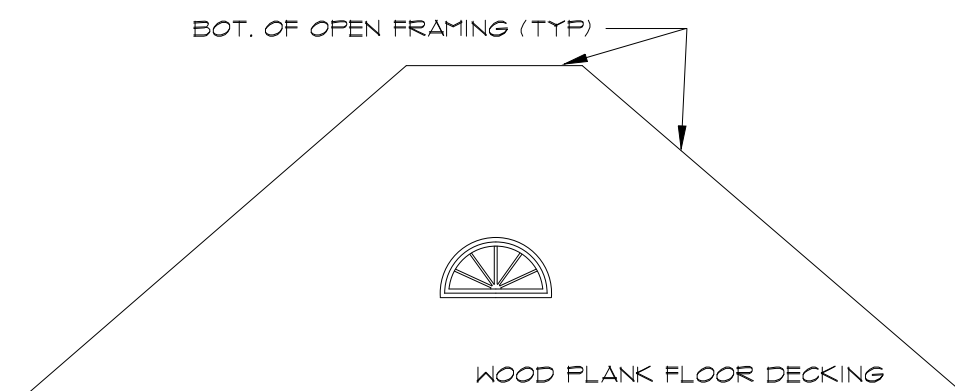

INTERIOR ELEVATION 24-D

As BUILT
PROFESSIONALS
A DIVISION OF:

AEC
CONSULTANTS INC
www.aecconsultantsinc.com
844.272.8458

© 2011 AEC CONSULTANTS INC

ARCHITECTURAL AS BUILT
FOX FIRE FARM
MONKTON MARYLAND 21111

01	100% SUBMISSION	
NO.	ISSUES REVISIONS	DATE
SHEET TITLE		

HL	PROJECT MANAGER
HL	PROJECT DIRECTOR
012317-1	PROJECT NUMBER
1/4"=1'-0"	SCALE
CL	DRAWN BY
	SHEET NUMBER

AB-8