


AS-BUILT DOCUMENTATION

Nashville, TN

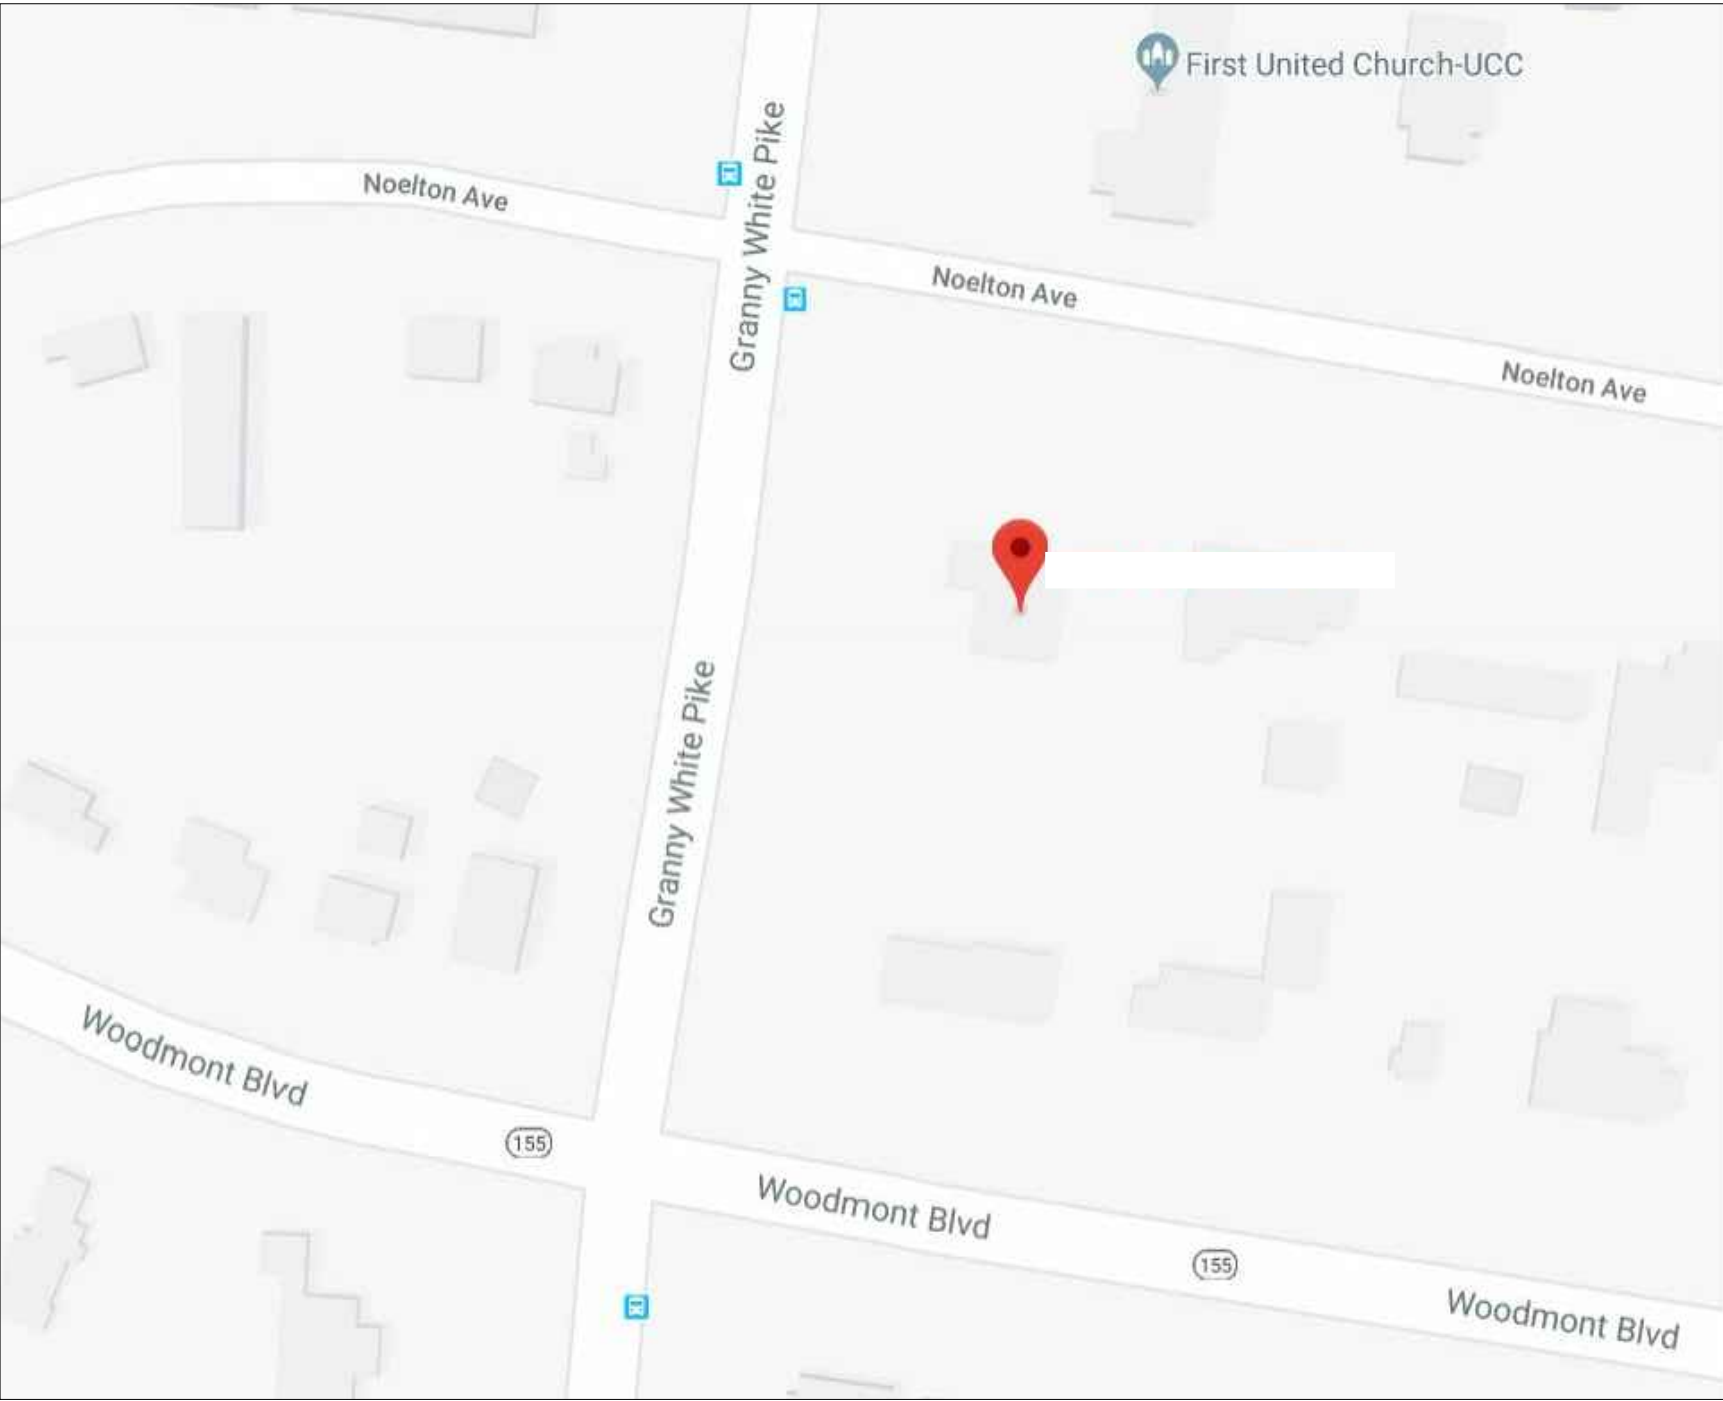

VICINITY MAP
NTS

AREA DATA	
BASEMENT	110 S.F. ±
FIRST FLOOR	1,947 S.F. ±
SECOND FLOOR	1,165 S.F. ±
ATTIC	232 S.F. ±
GRAND TOTAL	3,454 S.F. ±

DRAWING INDEX

C-1	COVER SHEET DRAWING INDEX
SL	SYMBOLS LEGEND
AB-1	BASEMENT & FIRST FLOOR PLAN
AB-2	SECOND FLOOR PLAN
AB-3	FIRST FLOOR REFLECTED CEILING PLAN
AB-4	SECOND FLOOR REFLECTED CEILING PLAN
AB-5	FIRST FLOOR INTERIOR ELEVATIONS
AB-6	SECOND FLOOR INTERIOR ELEVATIONS

As BUILT

PROFESSIONALS

www.asbuiltprofessionals.com

A DIVISION OF:

AEC

CONSULTANTS

INC

844-272-8458

AS BUILT

844-272-8458

LT

© 2017 AEC CONSULTANTS, INC.


ARCHITECTURAL AS BUILT

Nashville, TN

100% SUBMITTAL

01	100% SUBMISSION	SEE COVER SHEET
NO.	ISSUES REVISIONS	DATE
SHEET TITLE		
COVER SHEET		
HL	PROJECT MANAGER	
HL	PROJECT DIRECTOR	
012317-1	PROJECT NUMBER	
	SCALE	
CL	DRAWN BY	
	SHEET NUMBER	

C-1

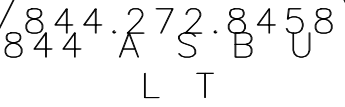

Nashville, TN

SHEET TITLE	
BASEMENT & FIRST FLOOR PLAN	
HL	PROJECT MANAGER
HL	PROJECT DIRECTOR
012317-1	PROJECT NUMBER
1/4"=1'-0"	SCALE
CL	DRAWN BY
SHEET NUMBER	

AB-1







01	100% SUBMISSION	SEE COVER SHEET
NO.	ISSUES REVISIONS	DATE

SHEET TITLE	
SECOND FLOOR PLAN	
HL	PROJECT MANAGER
HL	PROJECT DIRECTOR
012317-1	PROJECT NUMBER
1/4"=1'-0"	
	SCALE
CL	DRAWN BY
	SHEET NUMBER

AB-2

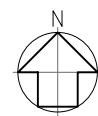


SECOND FLOOR

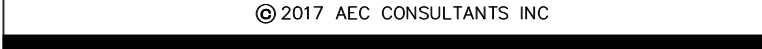

100% SUBMISSION	SEE COVER SHEET
ISSUES REVISIONS	DATE

AB-3

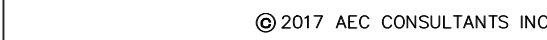[illegible]

SHEET TITLE

H	PROJECT MANAGER
---	-----------------


H	PROJECT DIRECTOR
---	------------------

012317-1	PROJECT NUMBER
----------	----------------




























1/4"=1'-0" SCALE

CL DRAWN BY

SHEET NUMBER

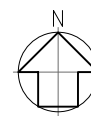

SECOND FLOOR REFLECTED CEILING PLAN

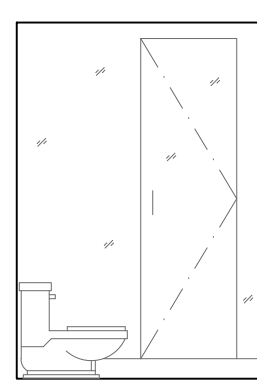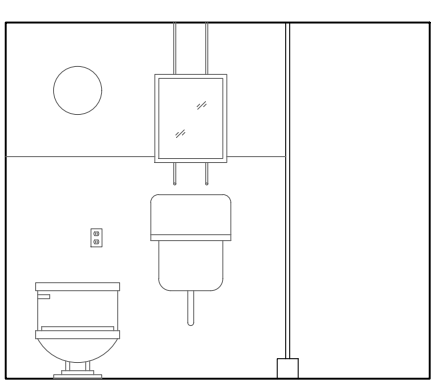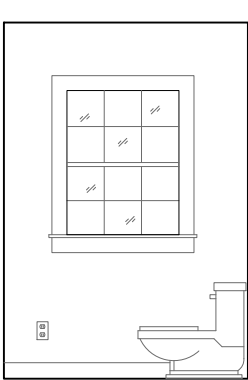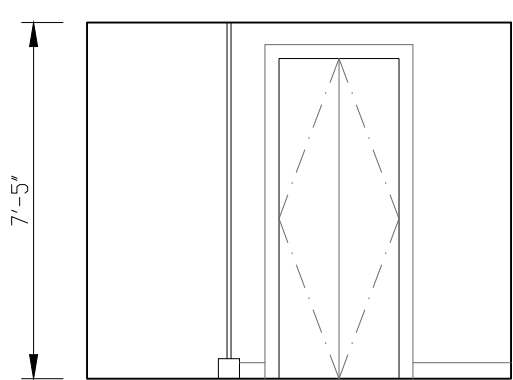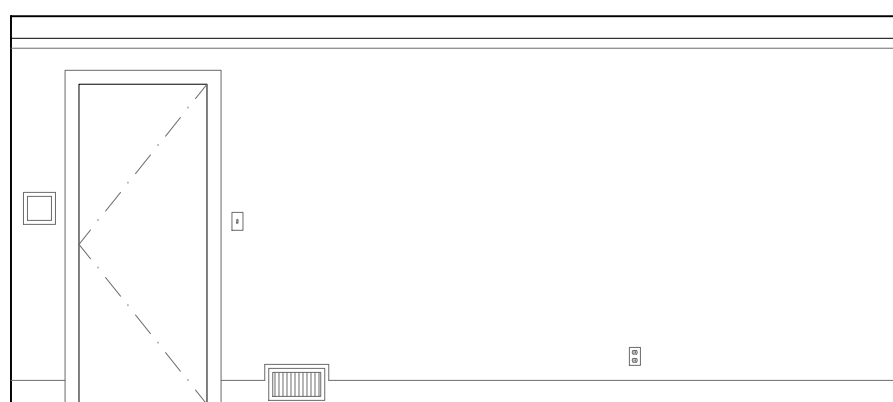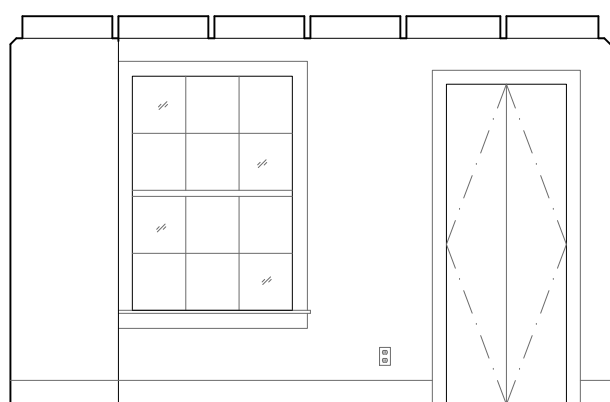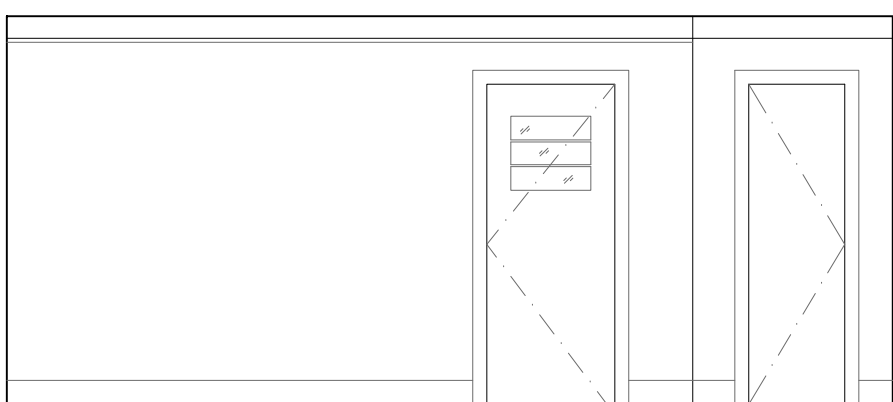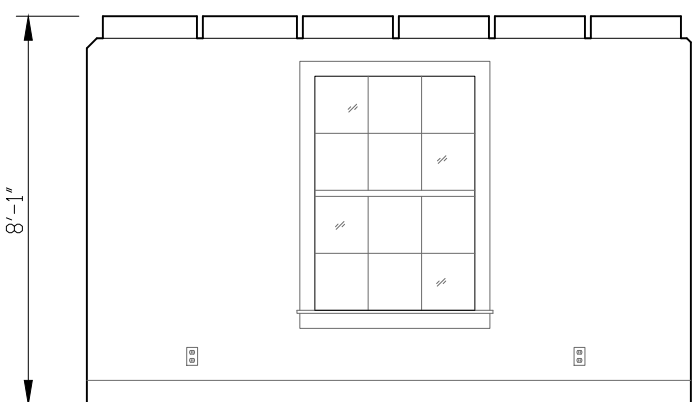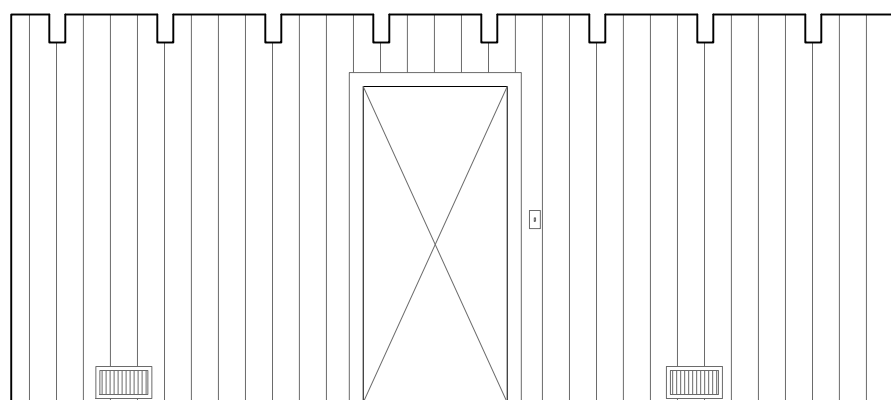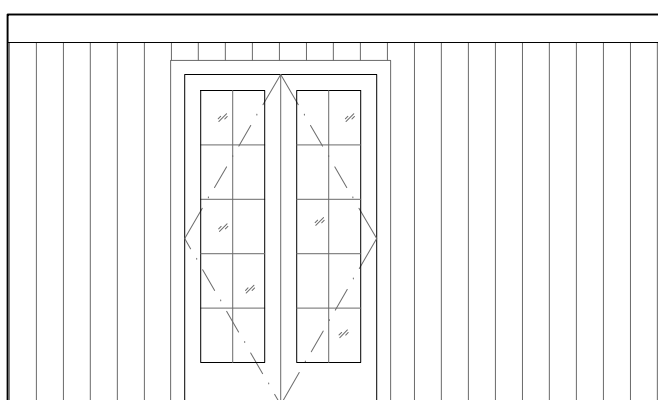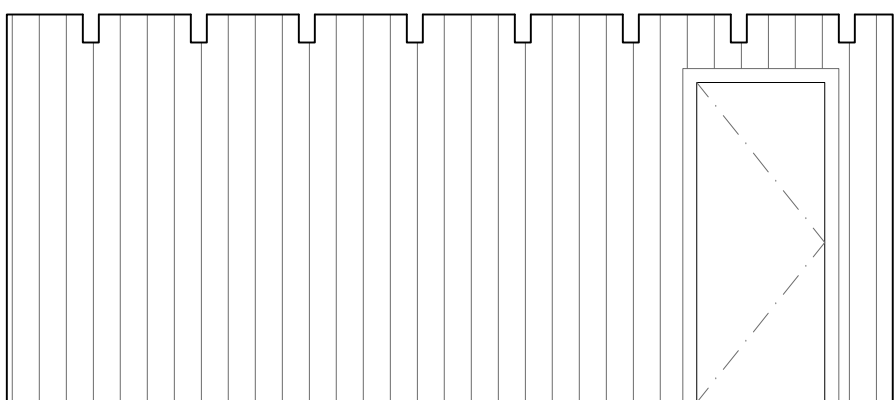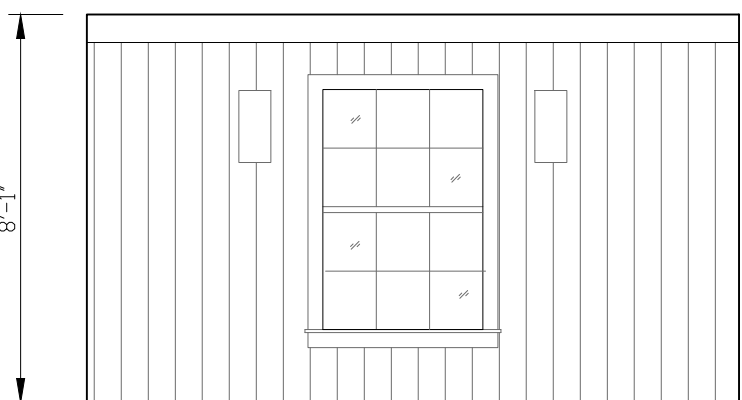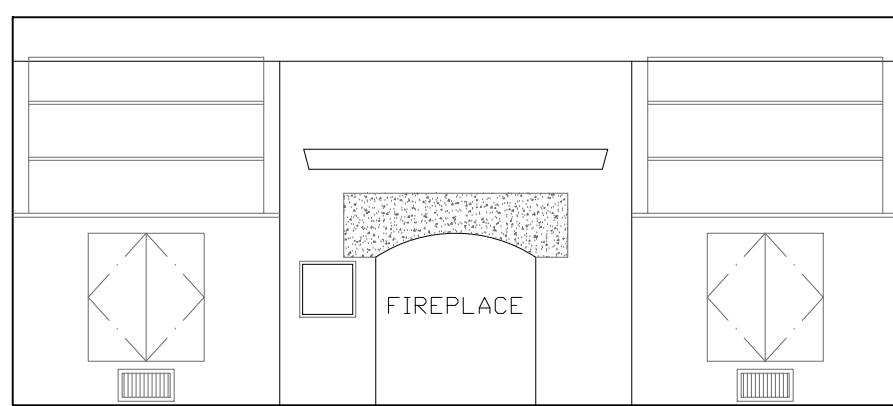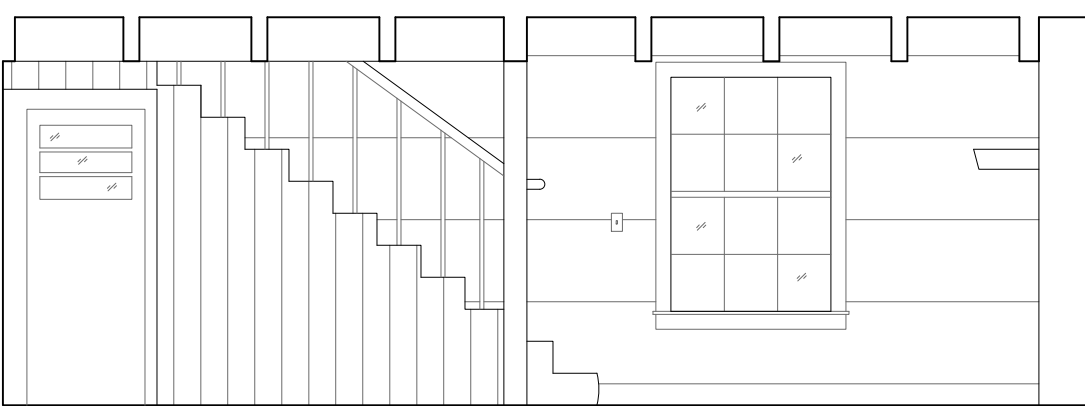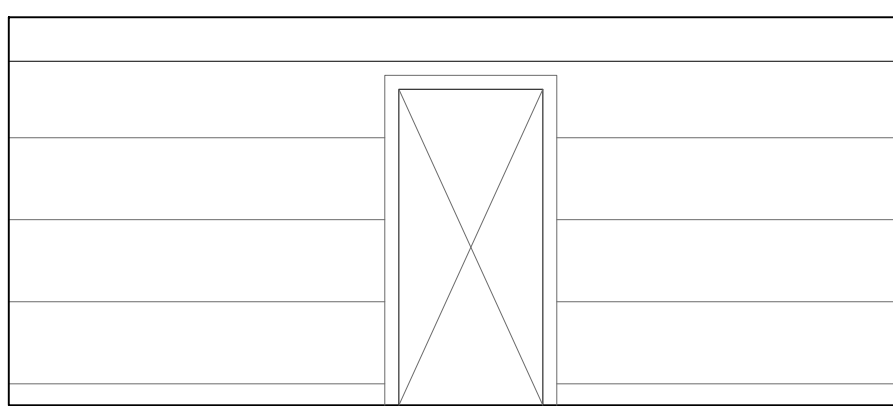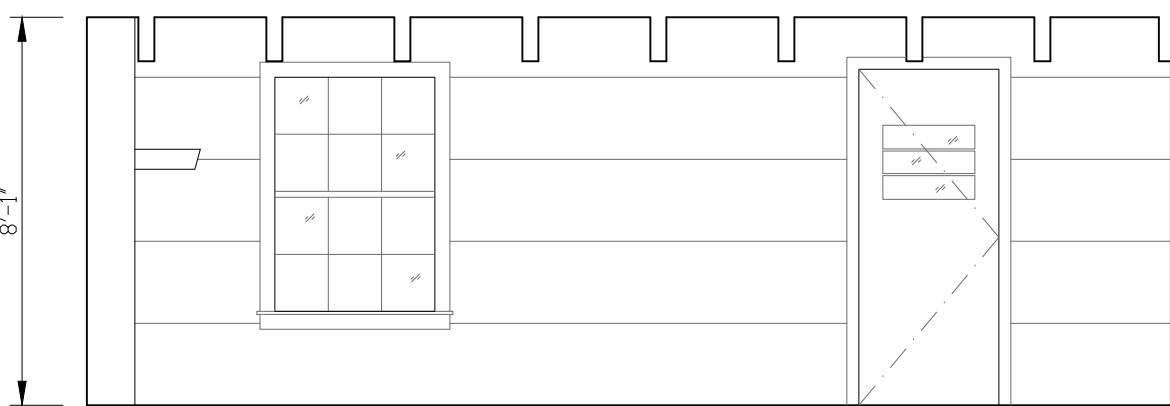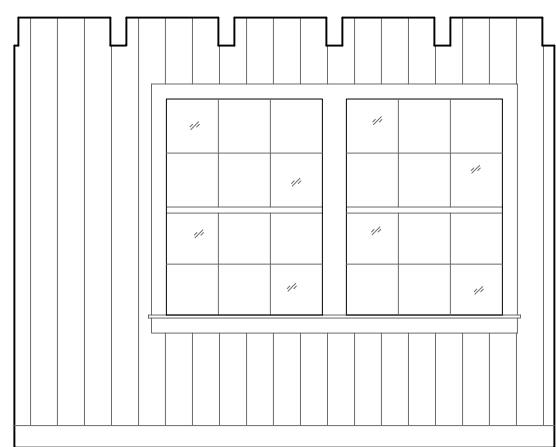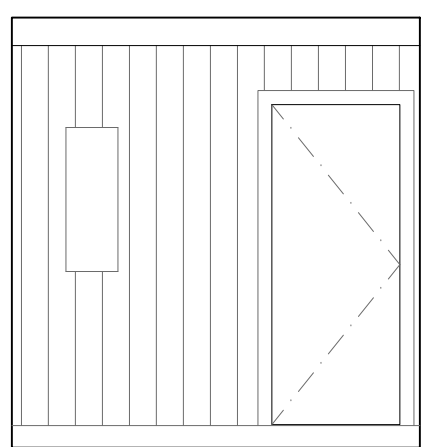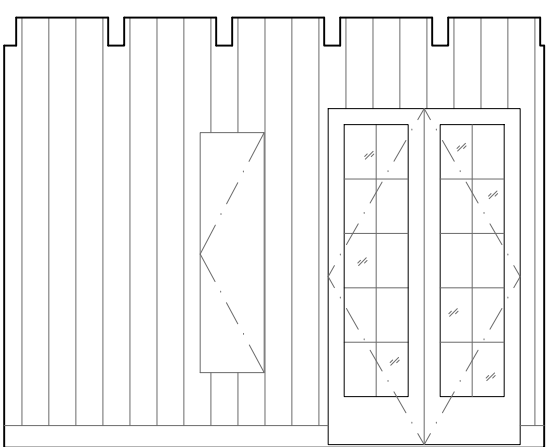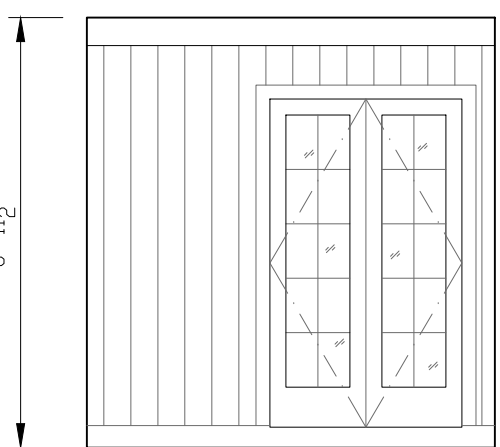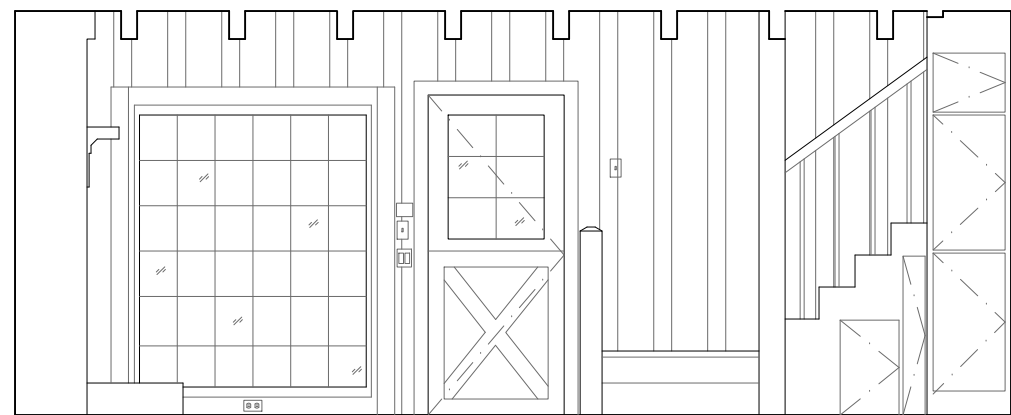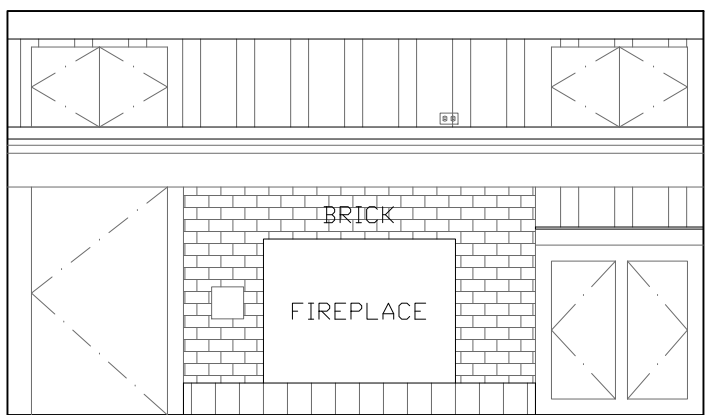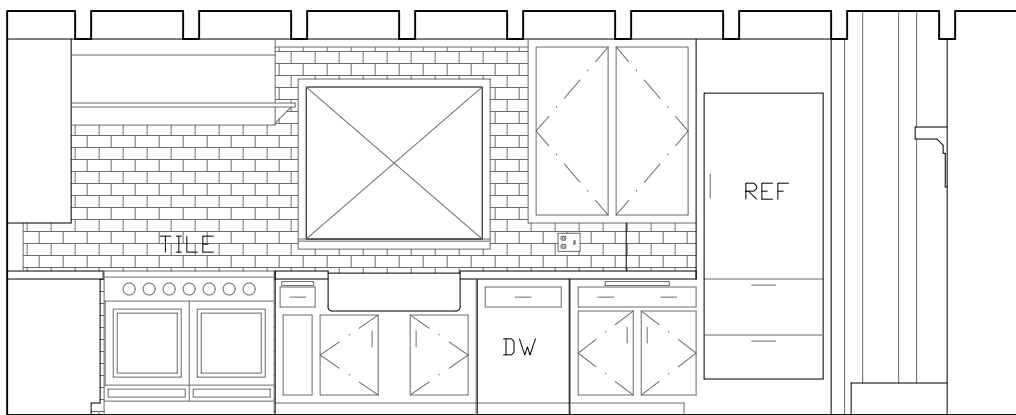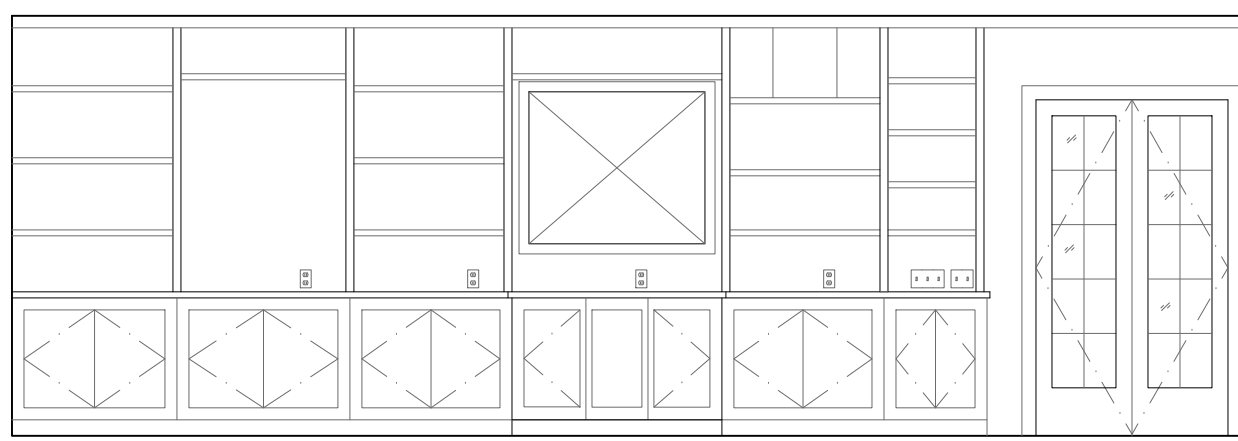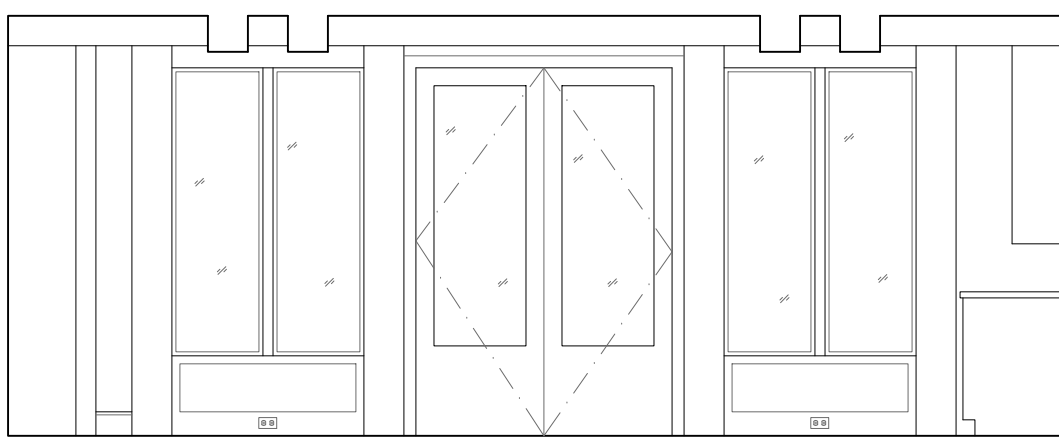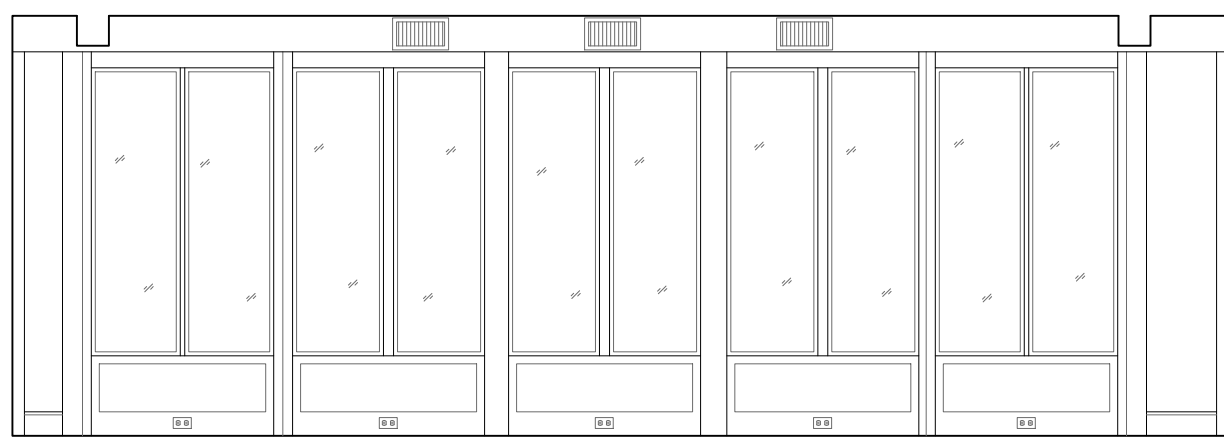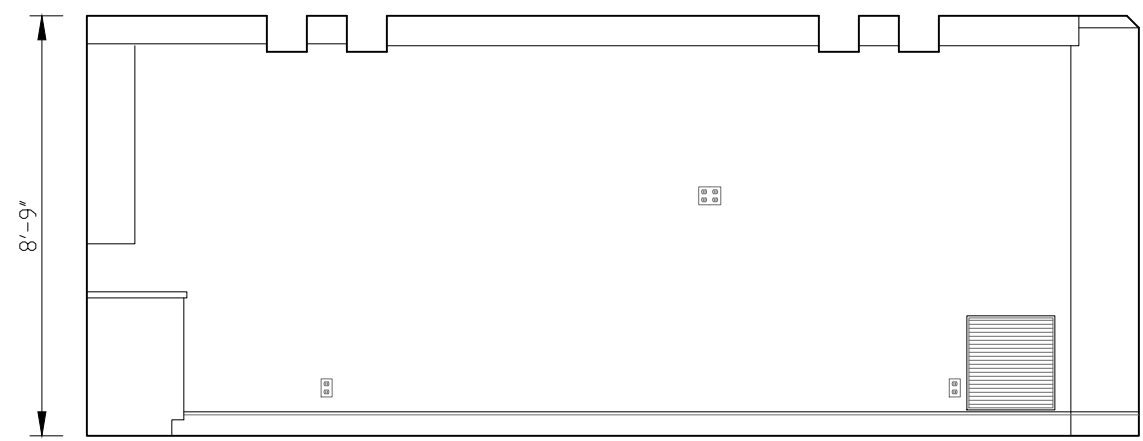

© 2017 AEC CONSULTANTS INC

ARCHITECTURAL AS BUILT





























Nashville, TN

01	100% SUBMISSION	SEE COVER SHEET
NO.	ISSUES REVISIONS	DATE

INTERIOR ELEVATIONS

HL	PROJECT MANAGER
HL	PROJECT DIRECTOR
012317-1	PROJECT NUMBER
1/4"=1'-0"	SCALE
CL	DRAWN BY
	SHEET NUMBER

AB-5

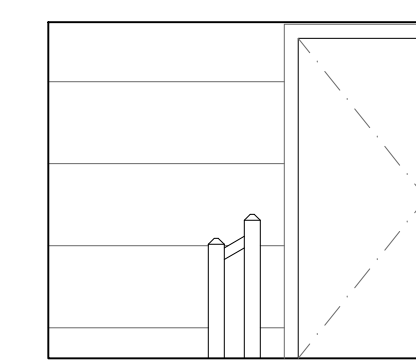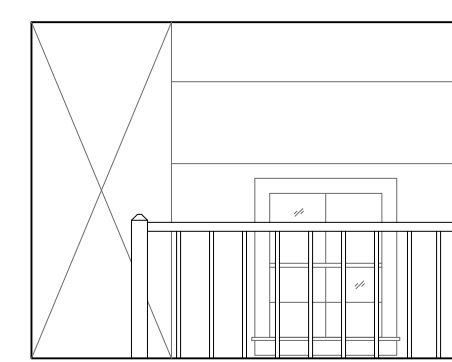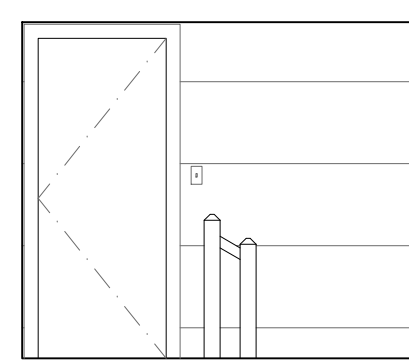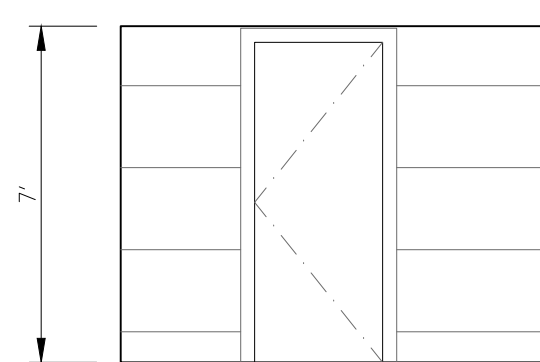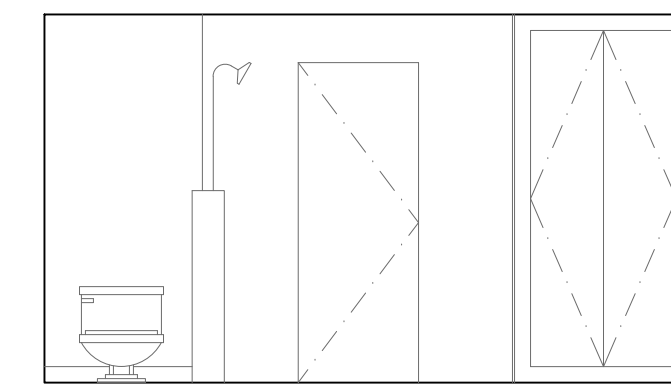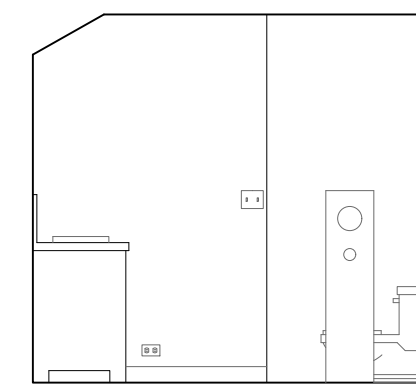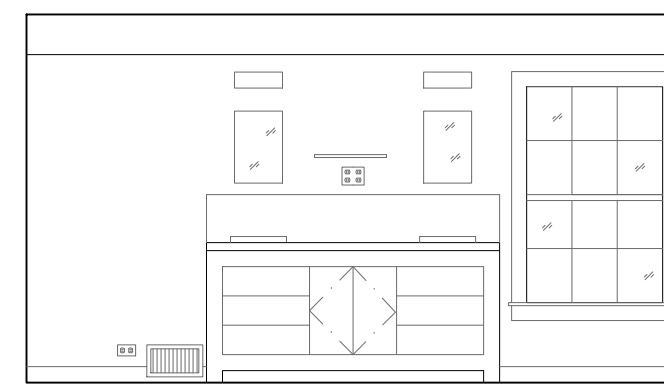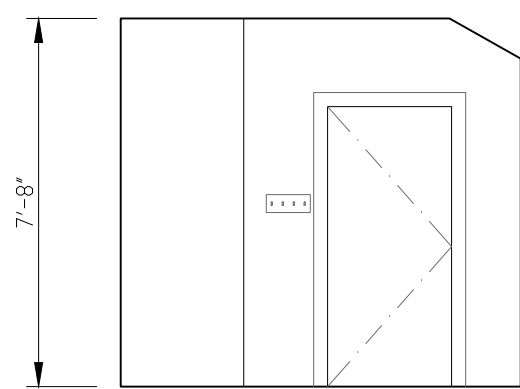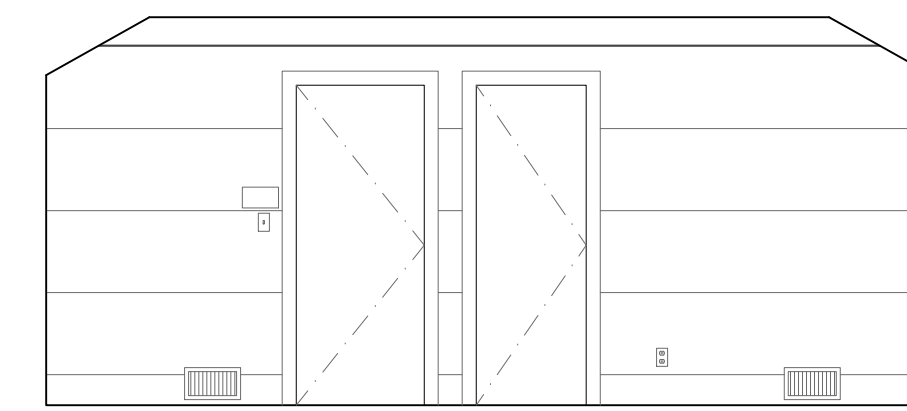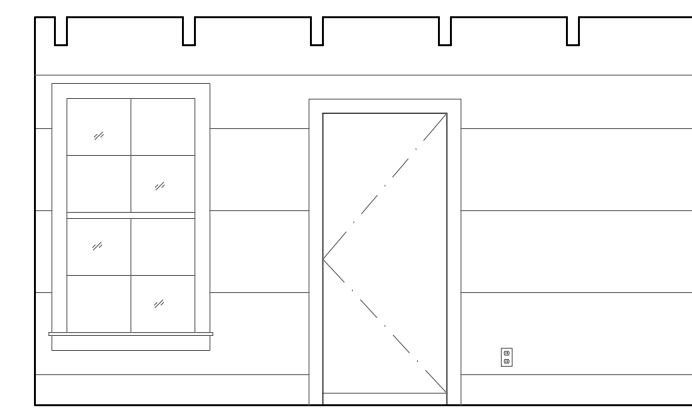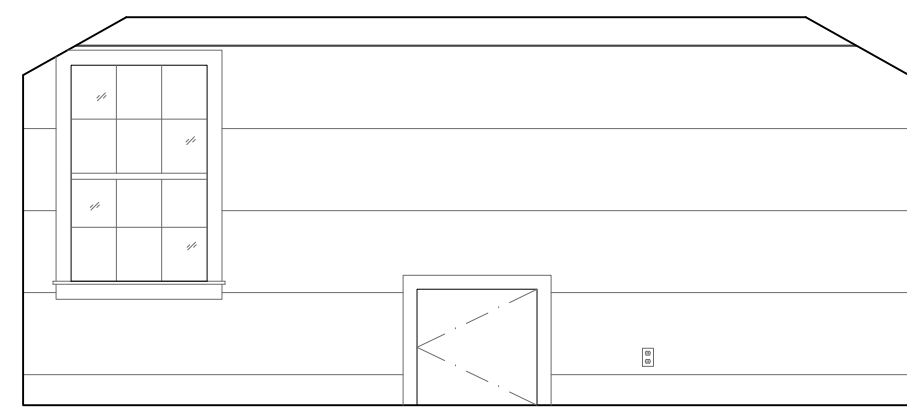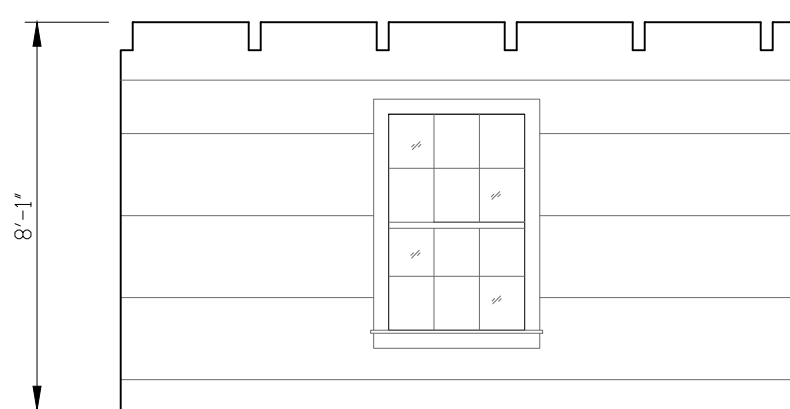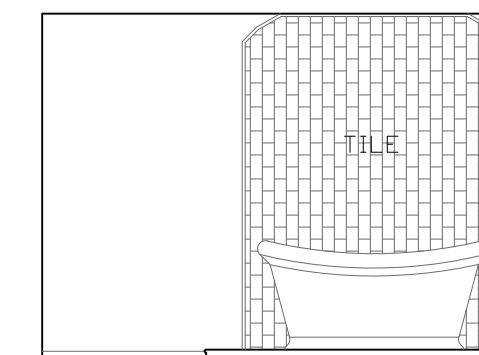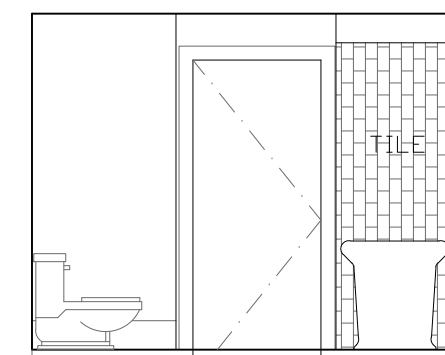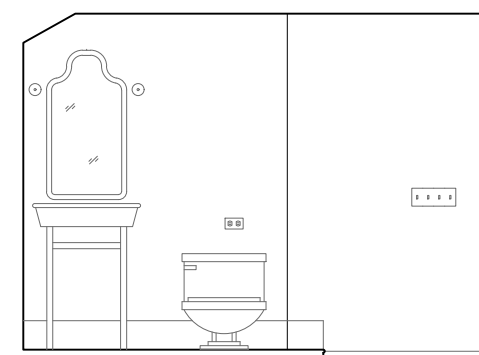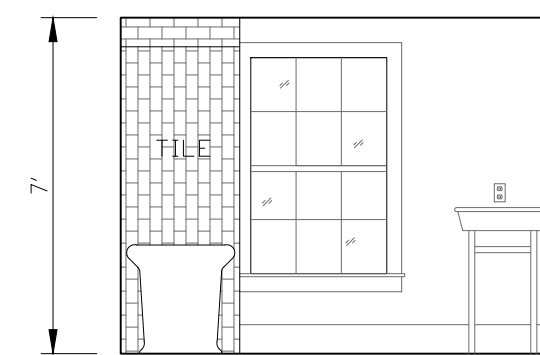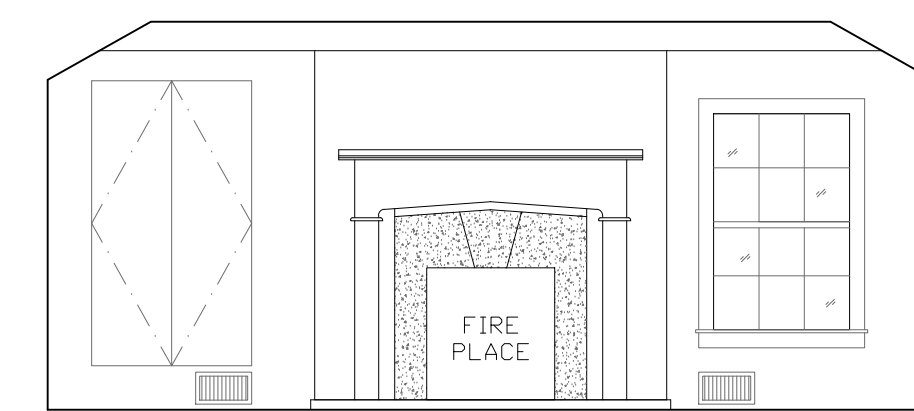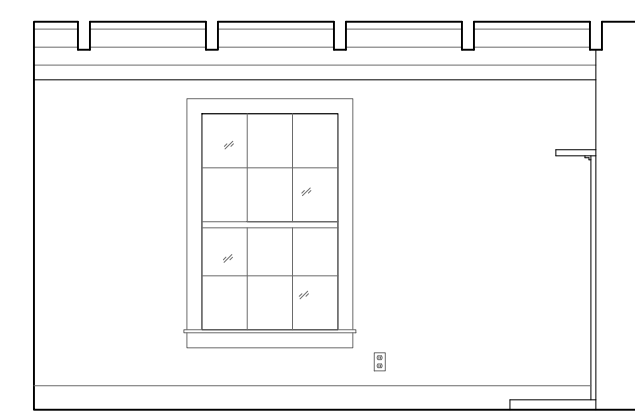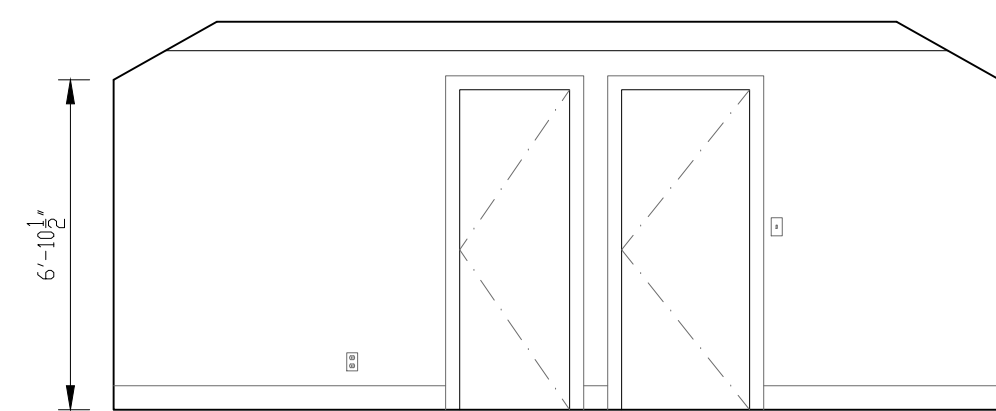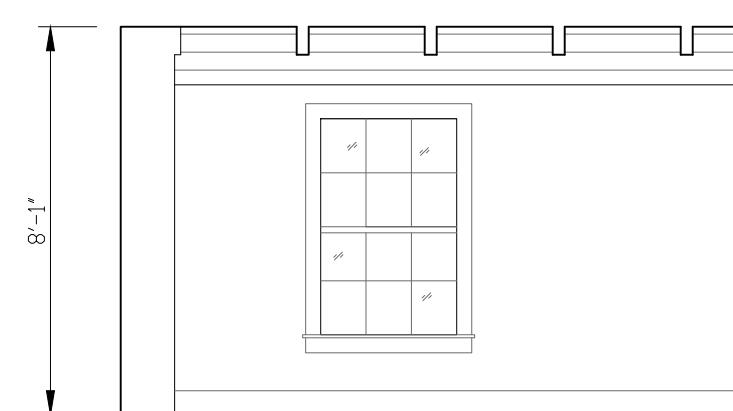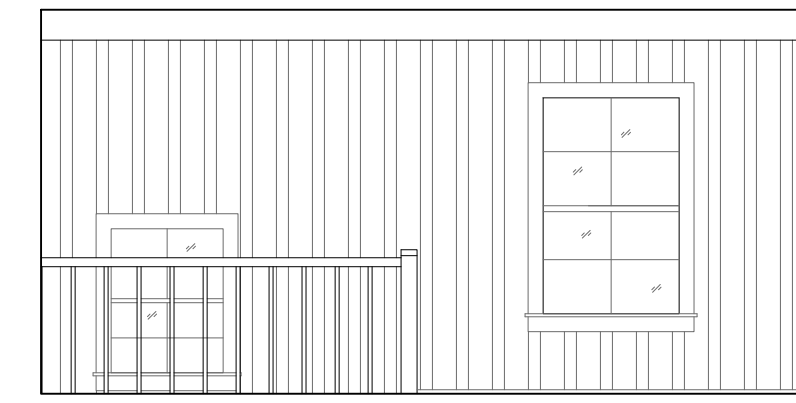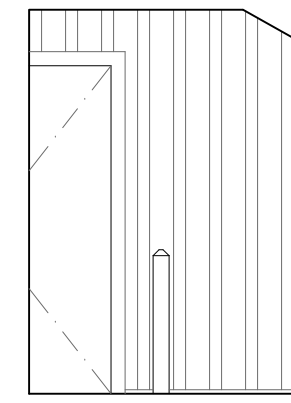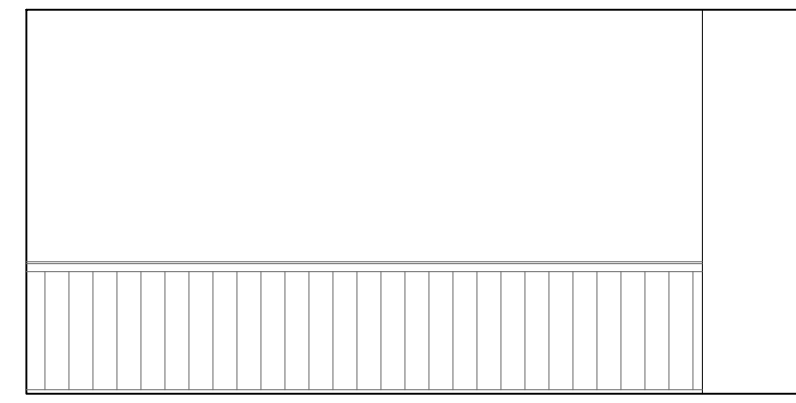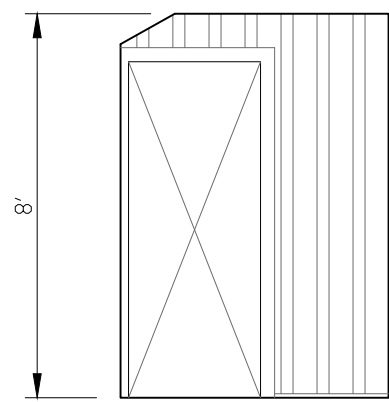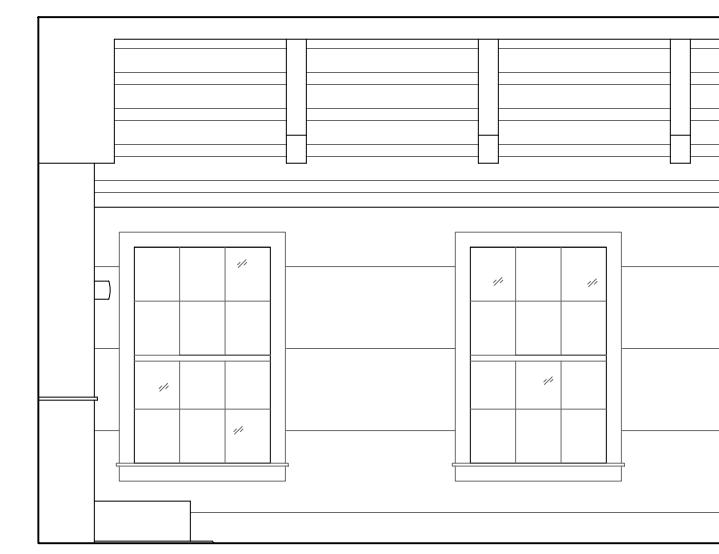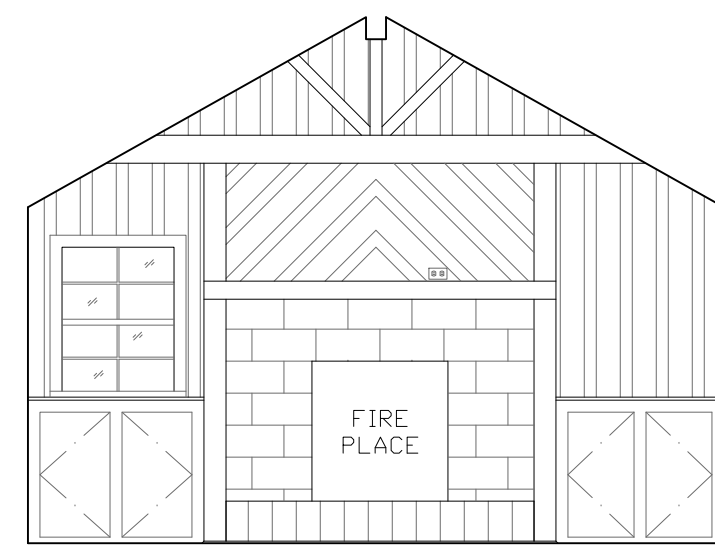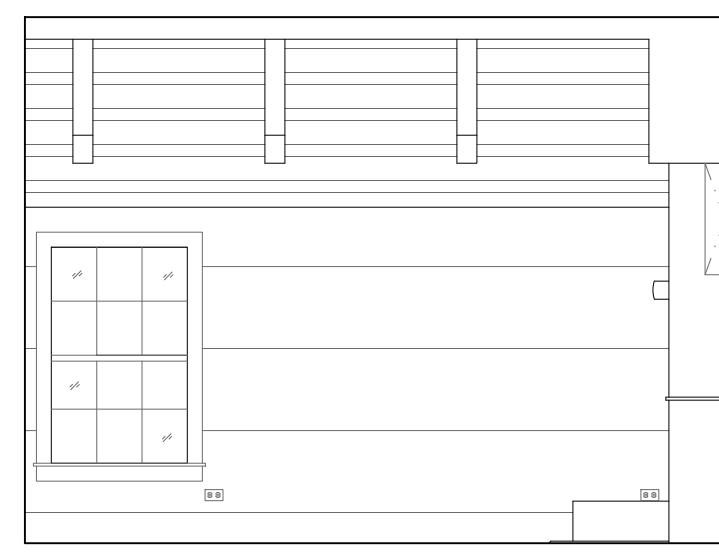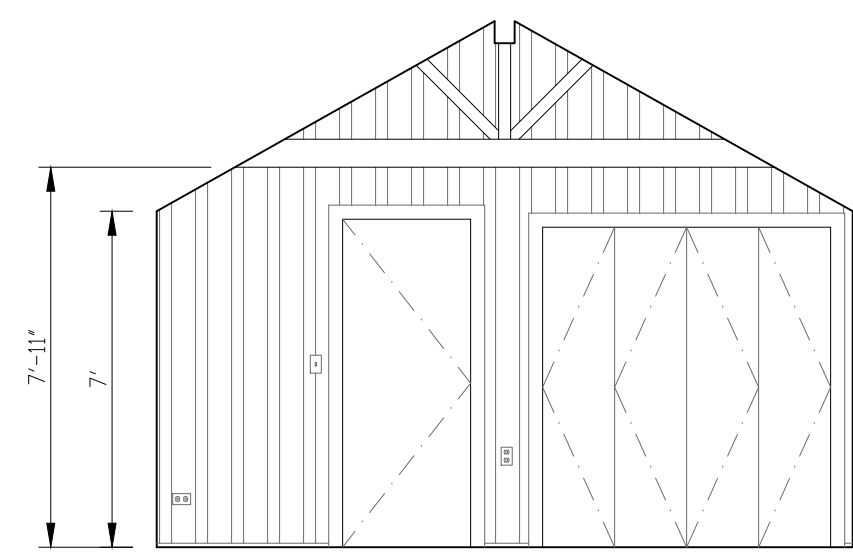

ARCHITECTURAL AS BUILT

Nashville, TN

[illegible]