


AS-BUILT DOCUMENTATION

Nashville, TN 37215

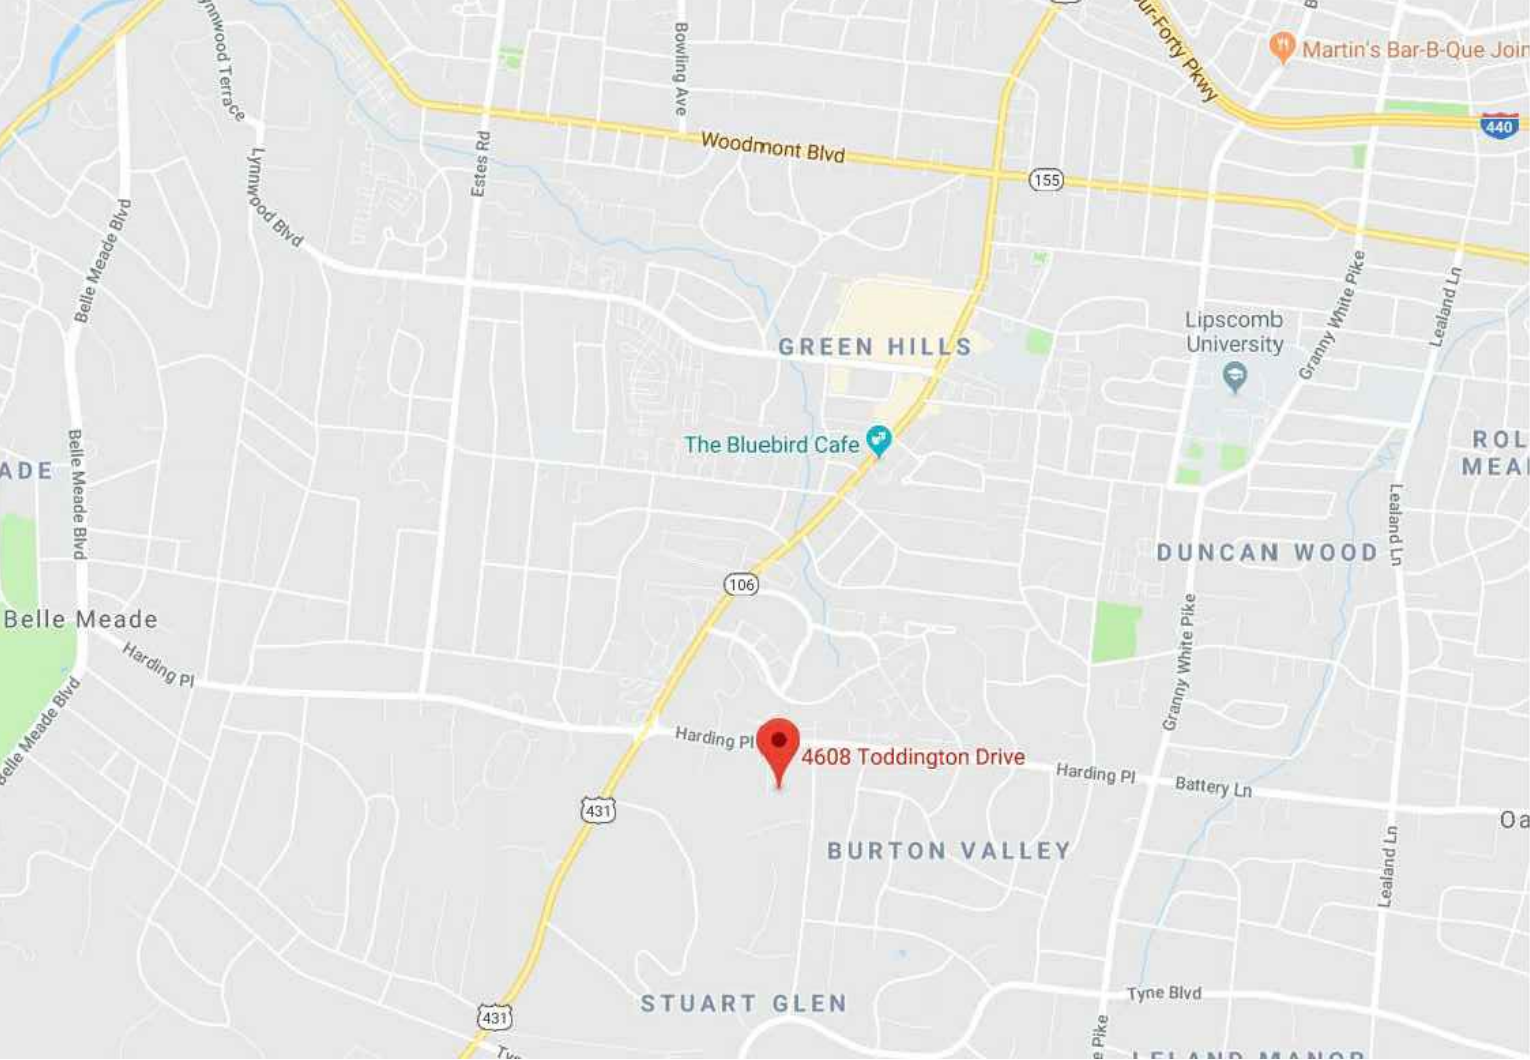

VICINITY MAP NTS

AREA DATA	
BASEMENT FLOOR	1404 SQ. FT. ±
GARAGE	818 SQ. FT. ±
STORAGE	326 SQ. FT. ±
FIRST FLOOR	2545 SQ. FT. ±
GRAND TOTAL	5094 SQ. FT. ±

DRAWING INDEX

C-1	COVER SHEET DRAWING INDEX
SL	SYMBOLS LEGEND
AB-1	FIRST FLOOR PLAN
AB-2	BASEMENT PLAN
AB-3	ROOF PLAN
AB-4	EXTERIOR ELEVATIONS
AB-5	INTERIOR ELEVATIONS
AB-6	INTERIOR ELEVATIONS
AB-7	INTERIOR ELEVATIONS
AB-8	INTERIOR ELEVATIONS

AS BUILT

PROFESSIONALS

www.asbuiltprofessionals.com

A DIVISION OF:

AEC

CONSULTANTS INC

844.272.8458

844 AS BUILT

© 2019 AEC CONSULTANTS INC

ARCHITECTURAL AS BUILT

Nashville, TN 37215


100% SUBMITTAL

01	100% SUBMISSION	SEE COVER SHEET
NO.	ISSUES REVISIONS	DATE
		SHEET TITLE
COVER SHEET		
HL	PROJECT MANAGER	
HL	PROJECT DIRECTOR	
012317-1	PROJECT NUMBER	
	SCALE	
CL	DRAWN BY	
	SHEET NUMBER	
C1		


SL

ARCHITECTURAL AS BUILT

Nashville, TN 37215

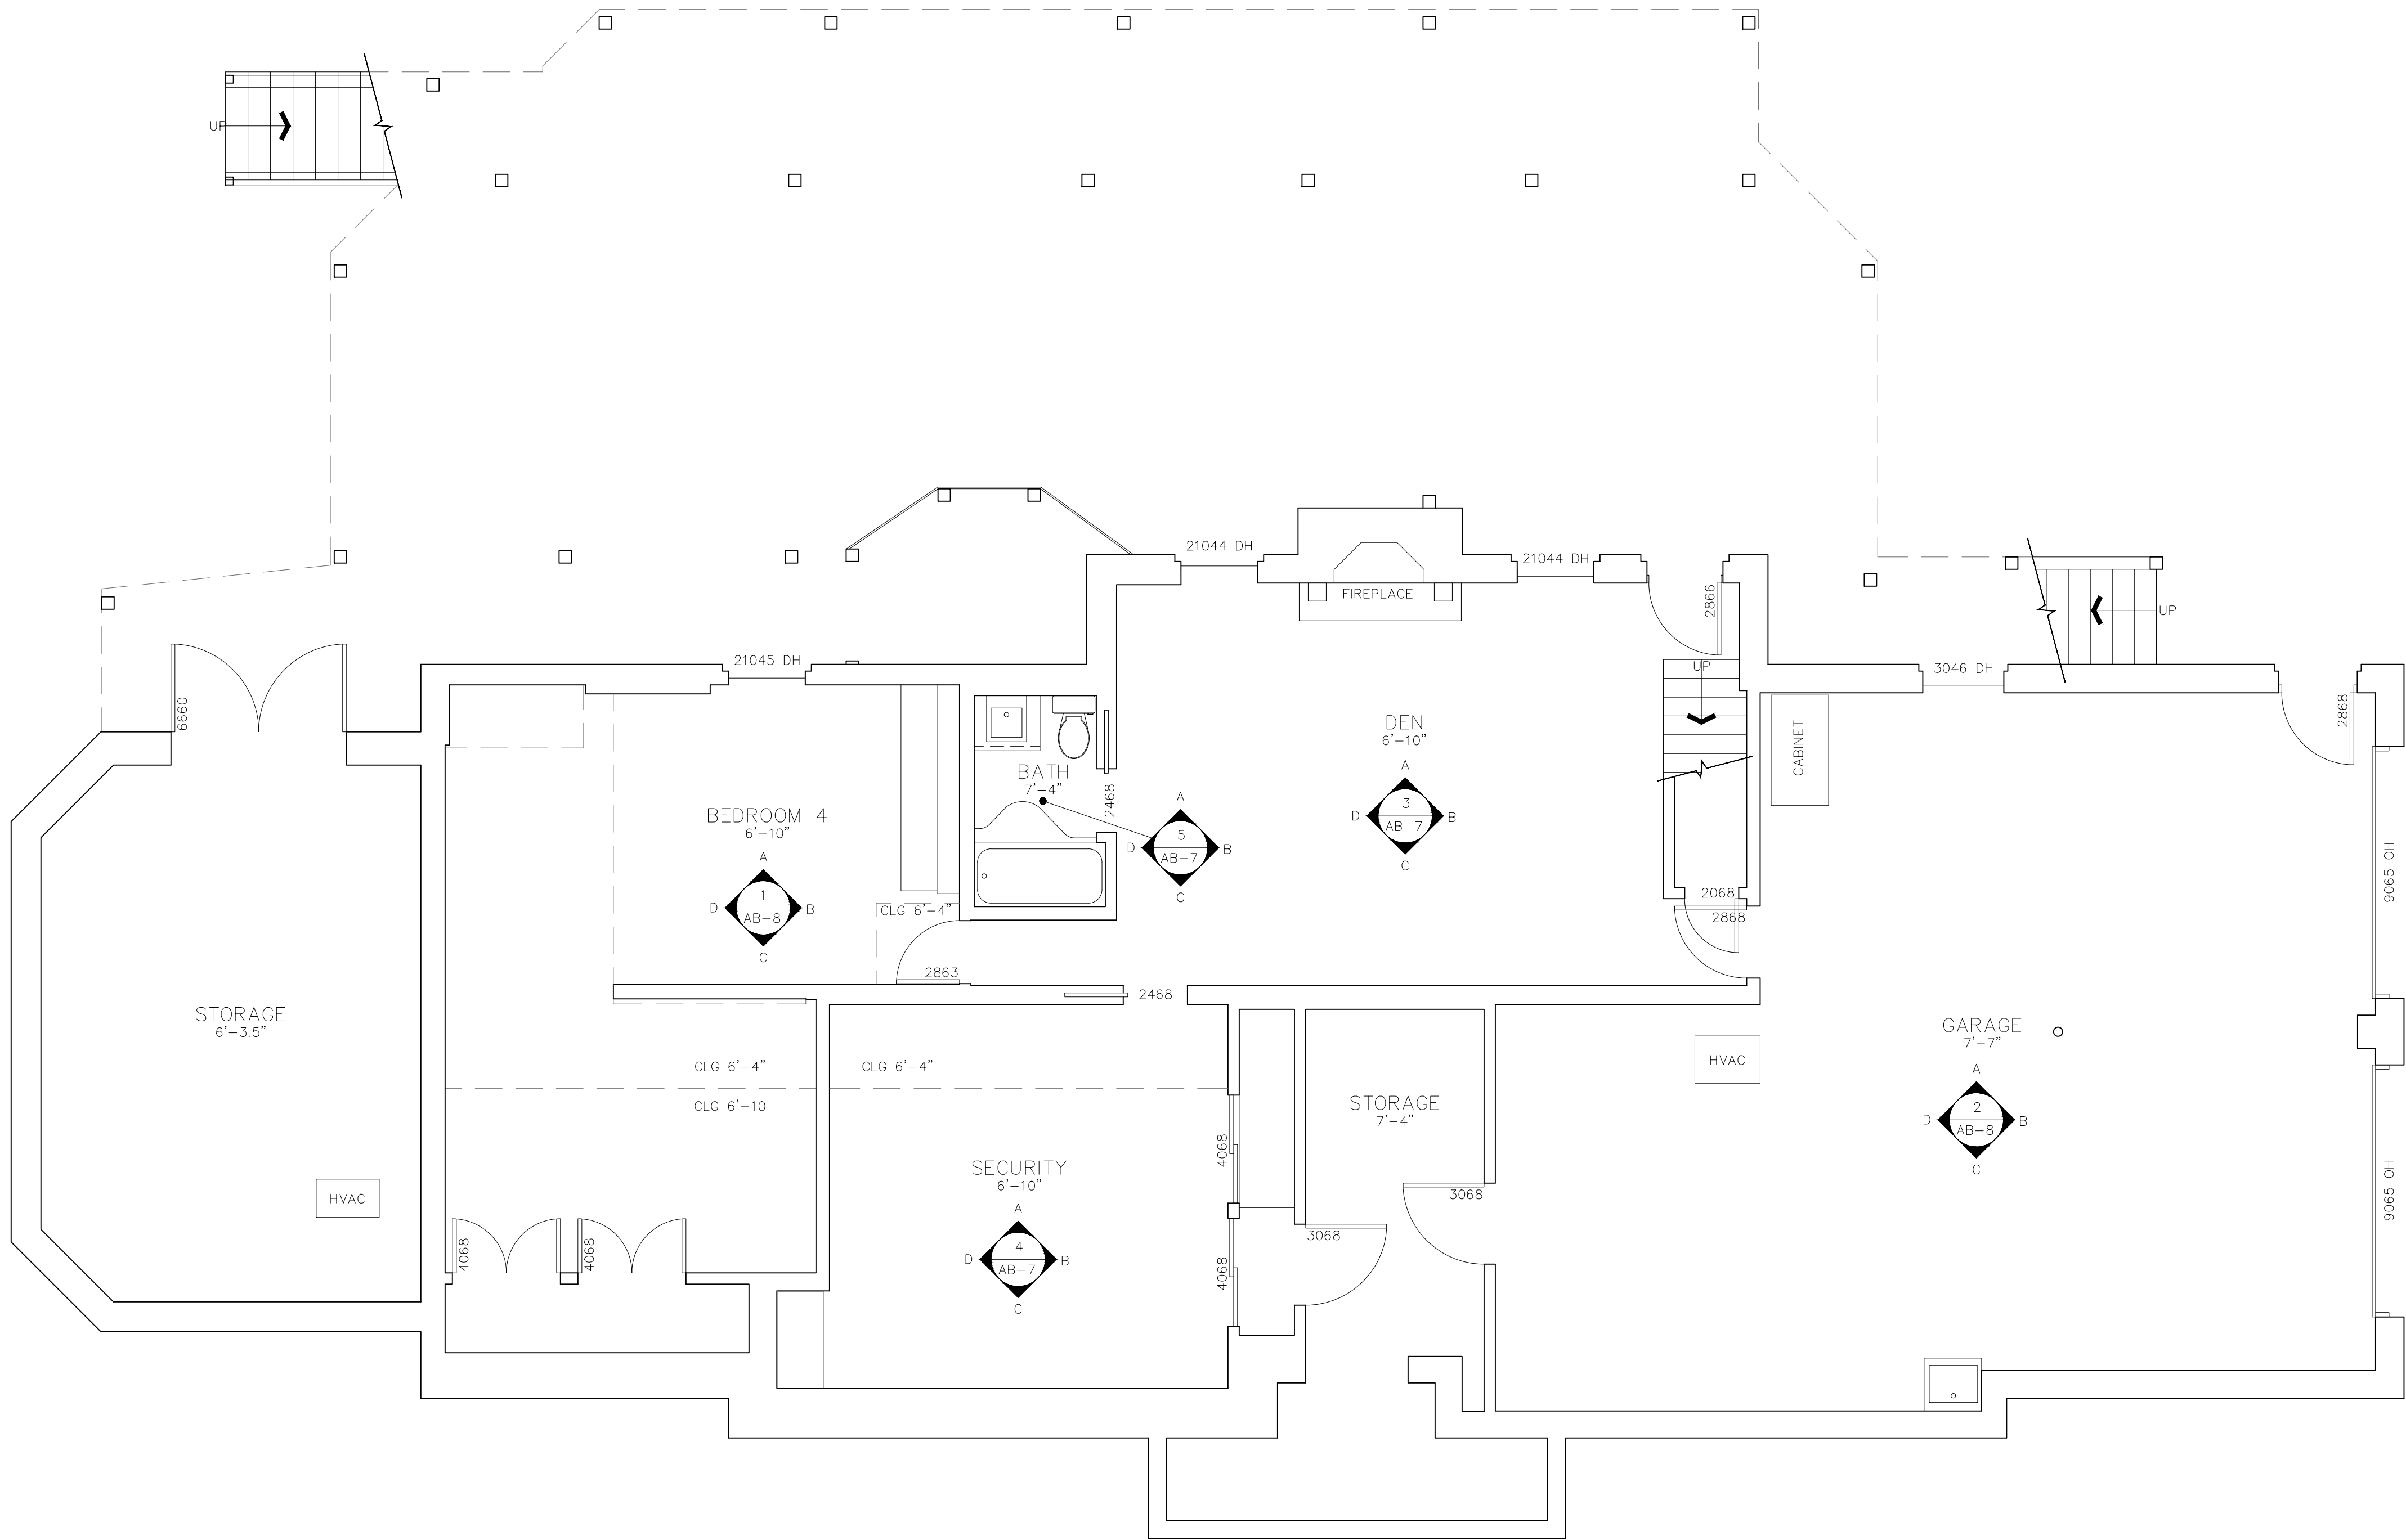



01	100% SUBMISSION	SEE COVER SHEET
NO.	ISSUES REVISIONS	DATE
		SHEET TITLE
BASEMENT PLAN		
HL	PROJECT MANAGER	
HL	PROJECT DIRECTOR	
012317-1	PROJECT NUMBER	
1/4"=1'-0"	SCALE	
CL	DRAWN BY	
	SHEET NUMBER	
AB-2		

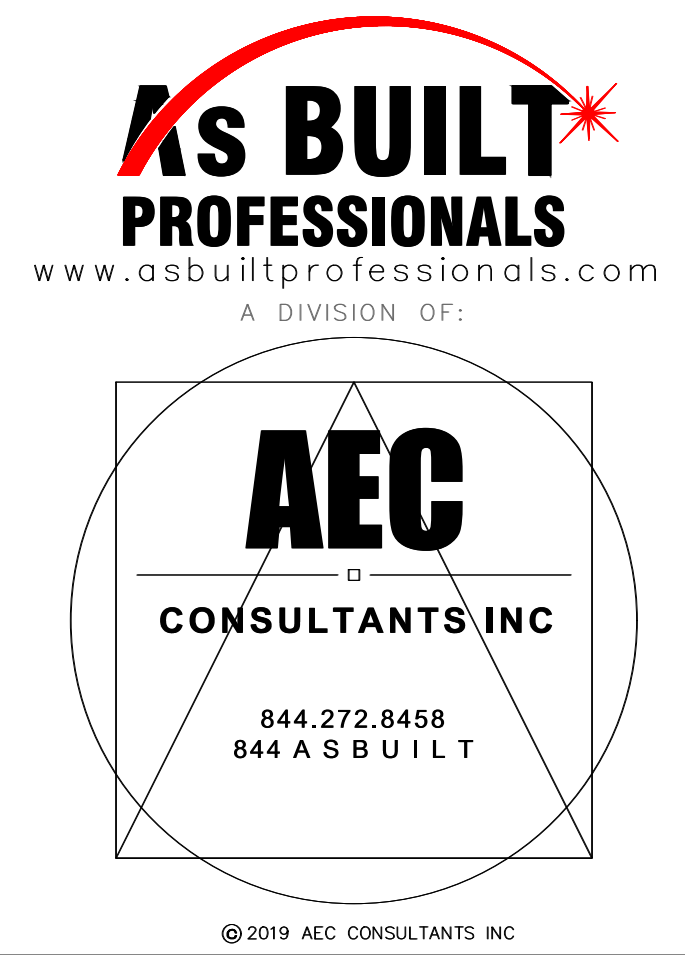

ARCHITECTURAL AS BUILT

Nashville, TN 37215





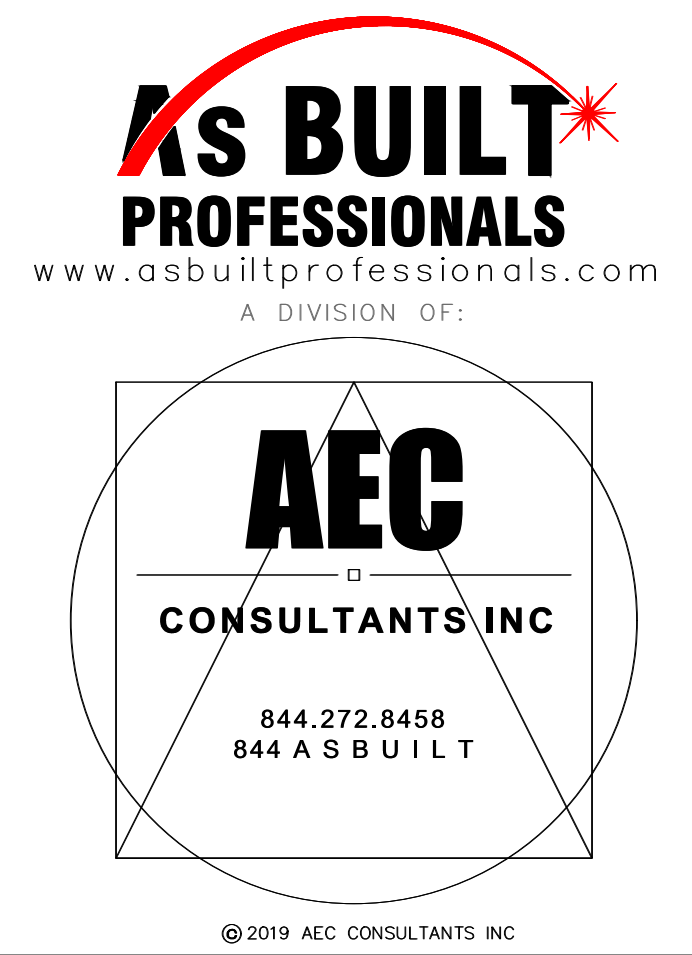
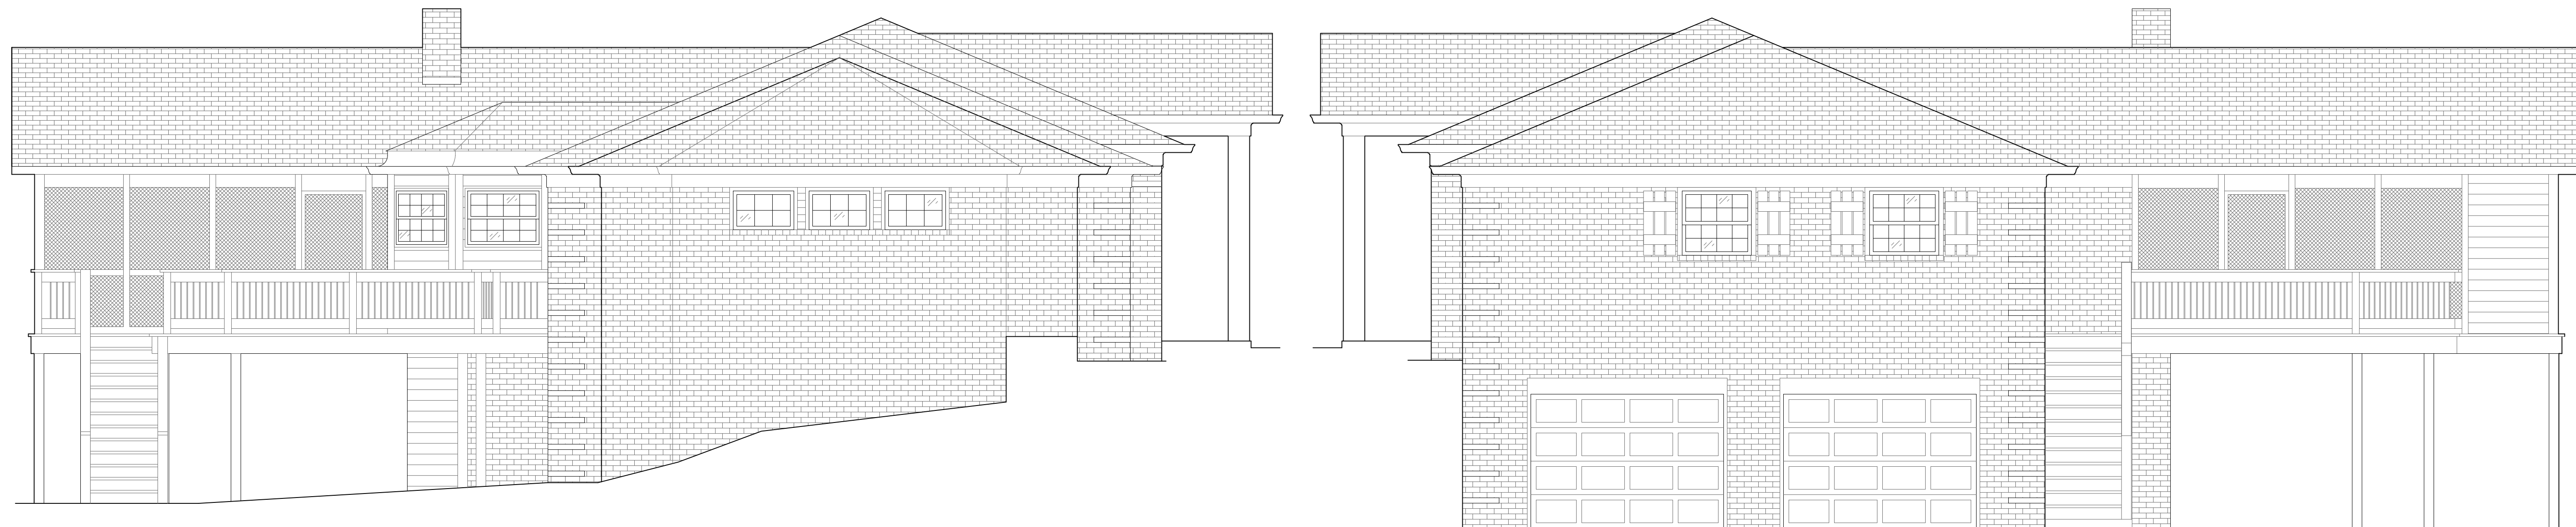


ARCHITECTURAL AS BUILT





Nashville, TN 37215

Nashville, TN 37215





01	100% SUBMISSION	SEE COVER SHEET
NO.	ISSUES REVISIONS	DATE
		SHEET TITLE
EXTERIOR ELEVATIONS		
HL	PROJECT MANAGER	
HL	PROJECT DIRECTOR	
012317-1	PROJECT NUMBER	
1/4"=1'-0"	SCALE	
CL	DRAWN BY	
		SHEET NUMBER
AB-4		

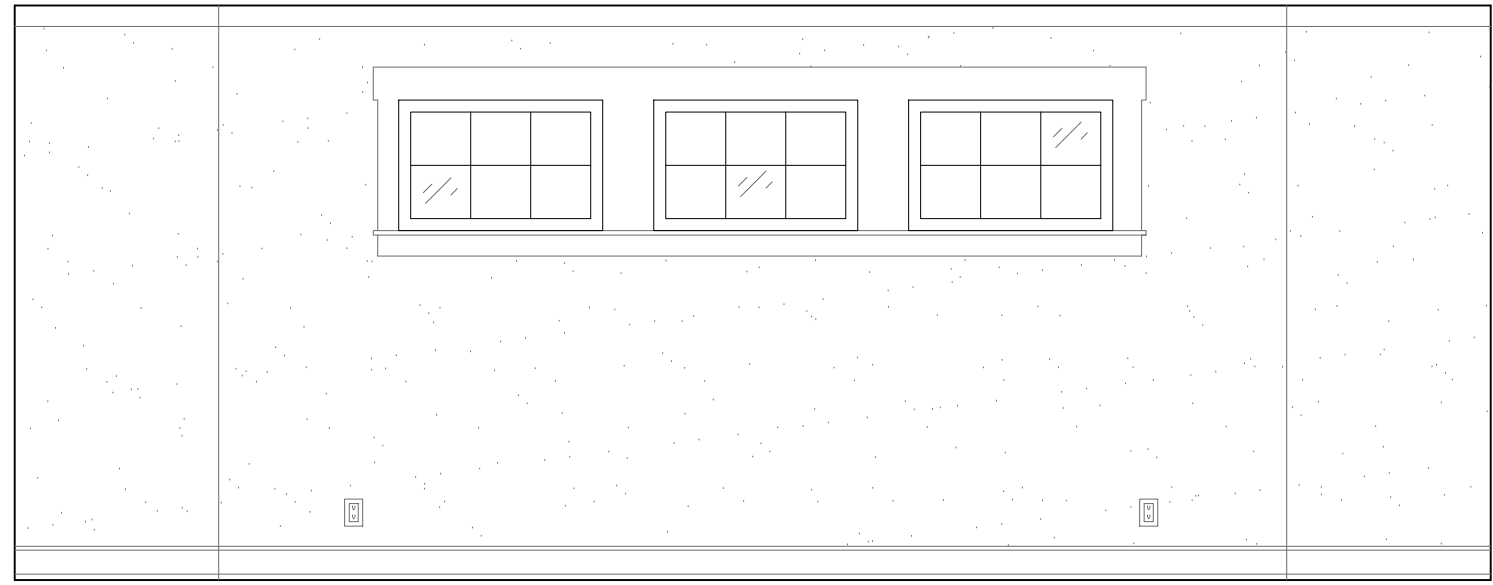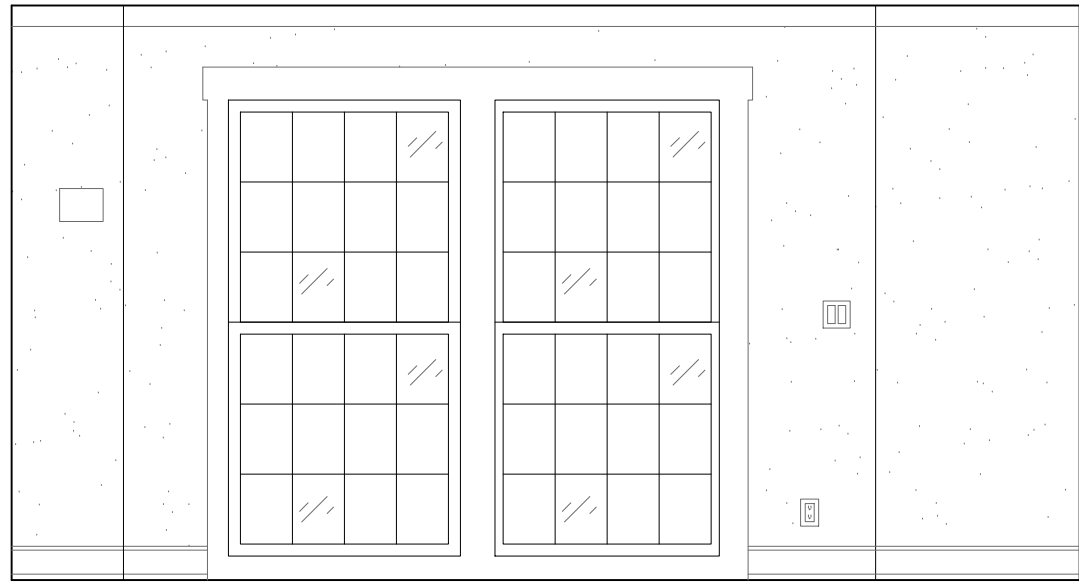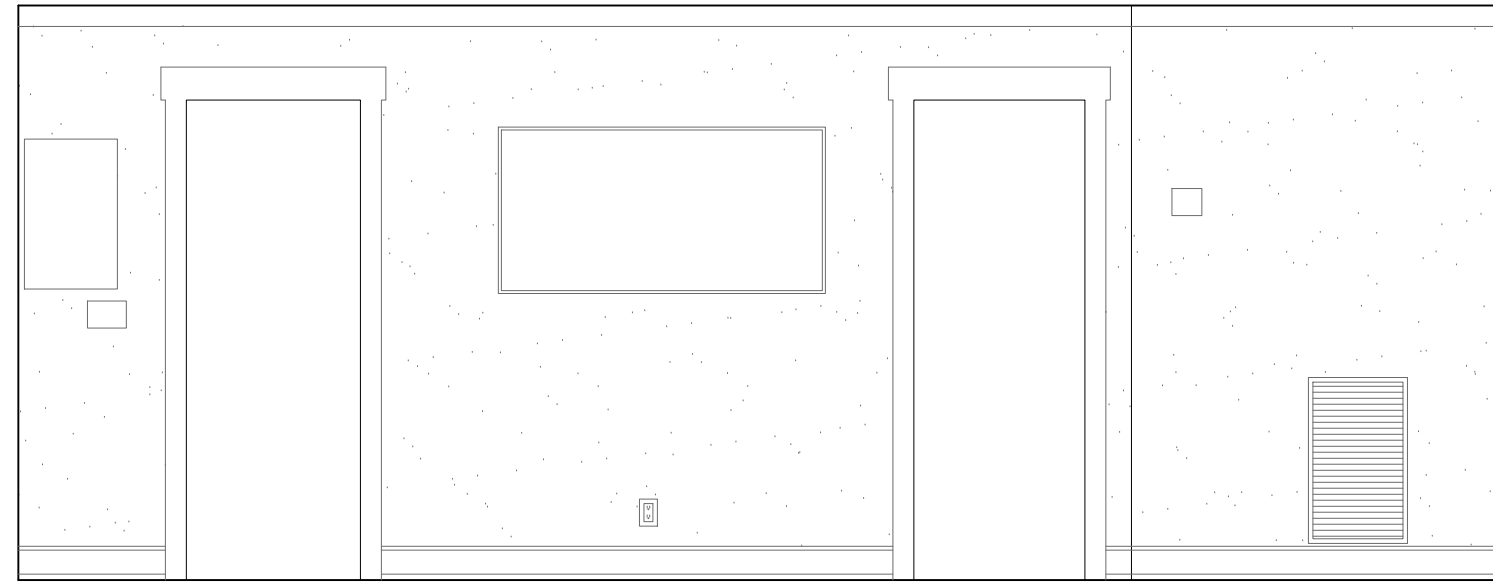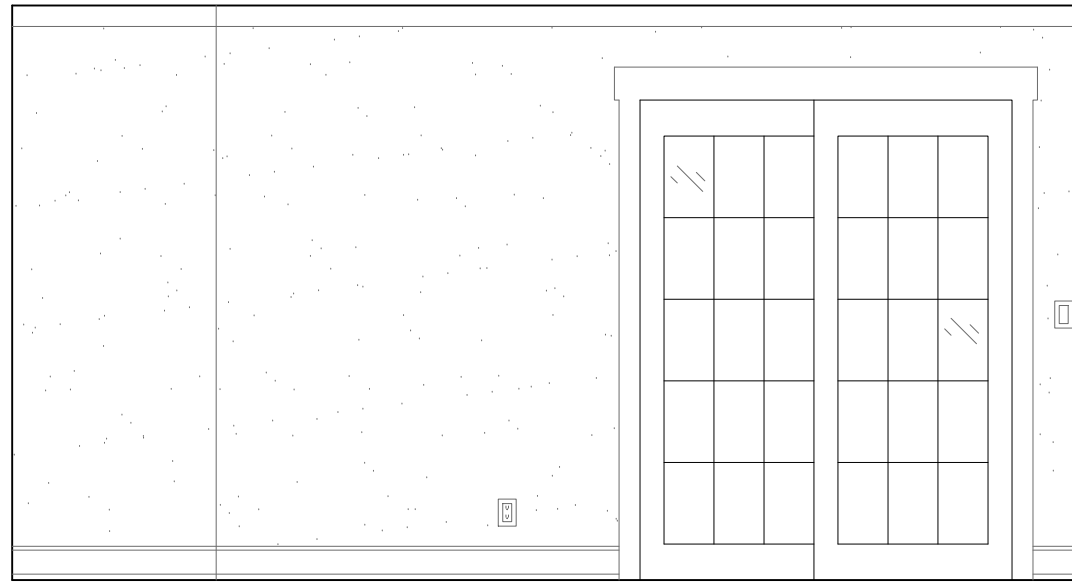





1 MASTER BEDROOM

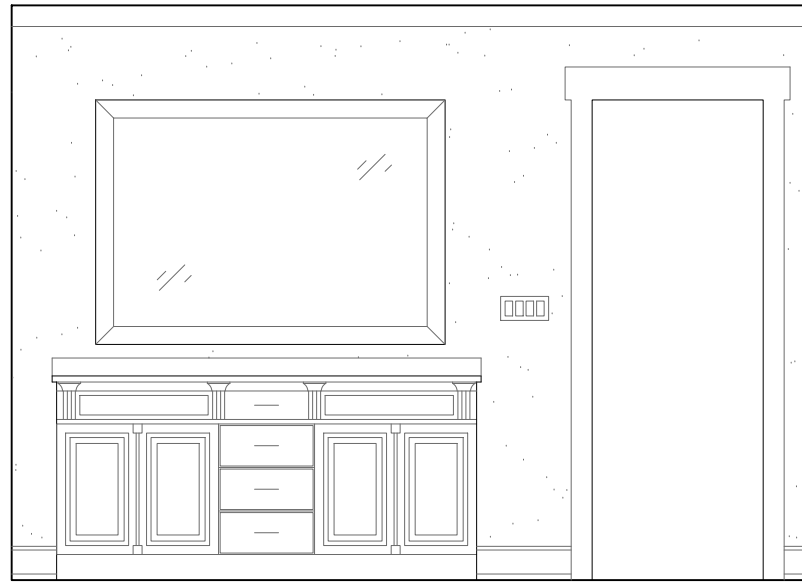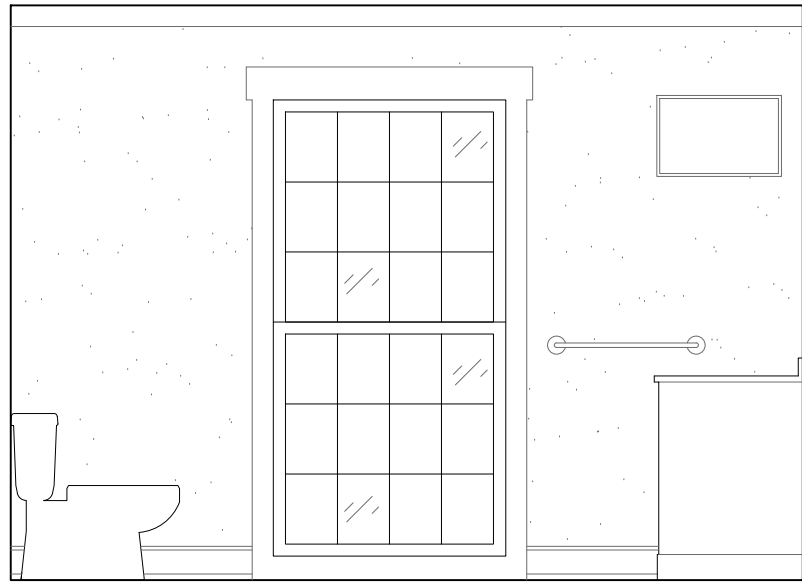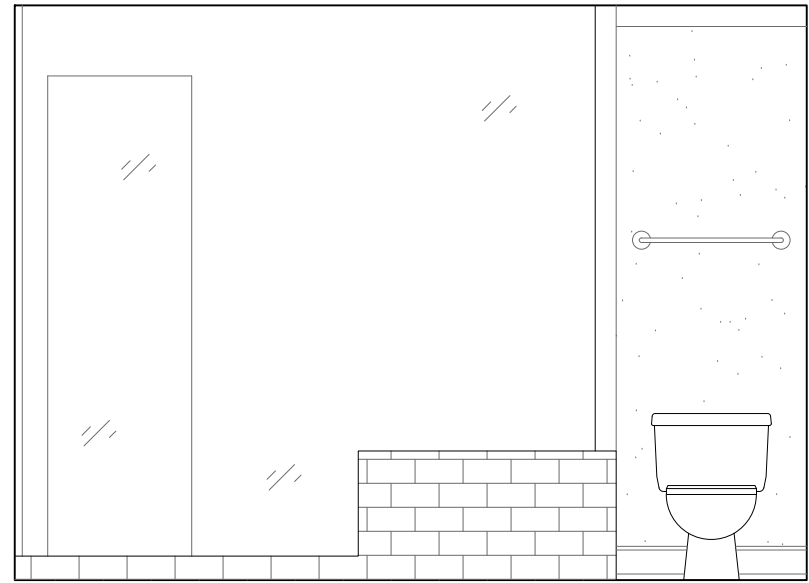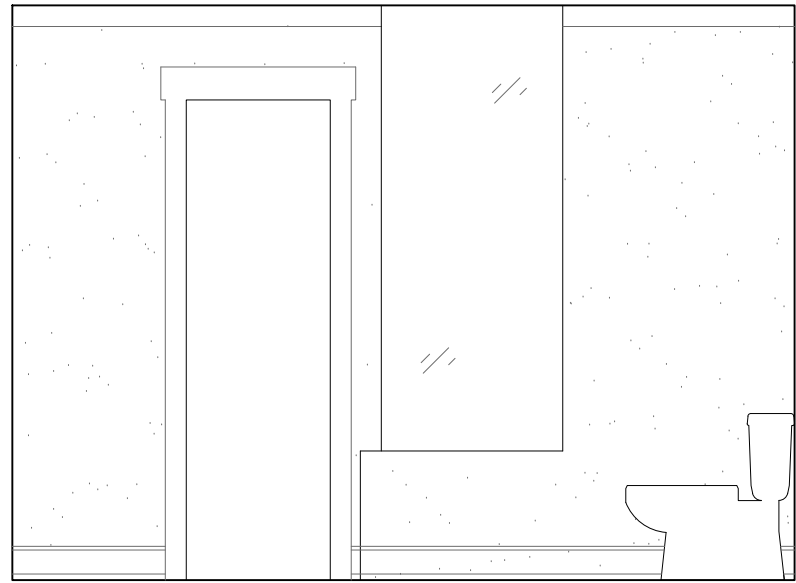



2 MASTER BATH

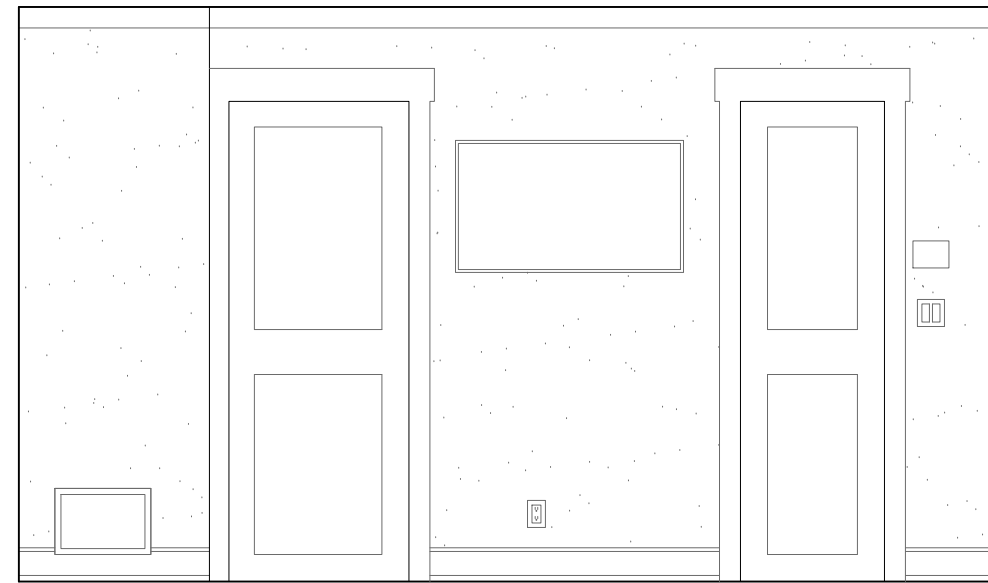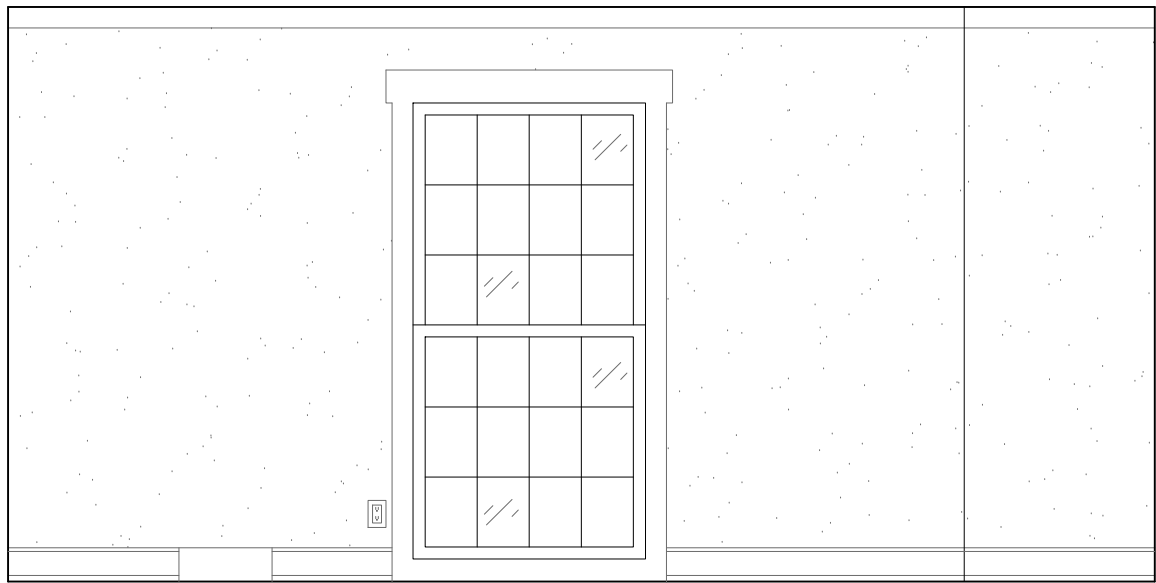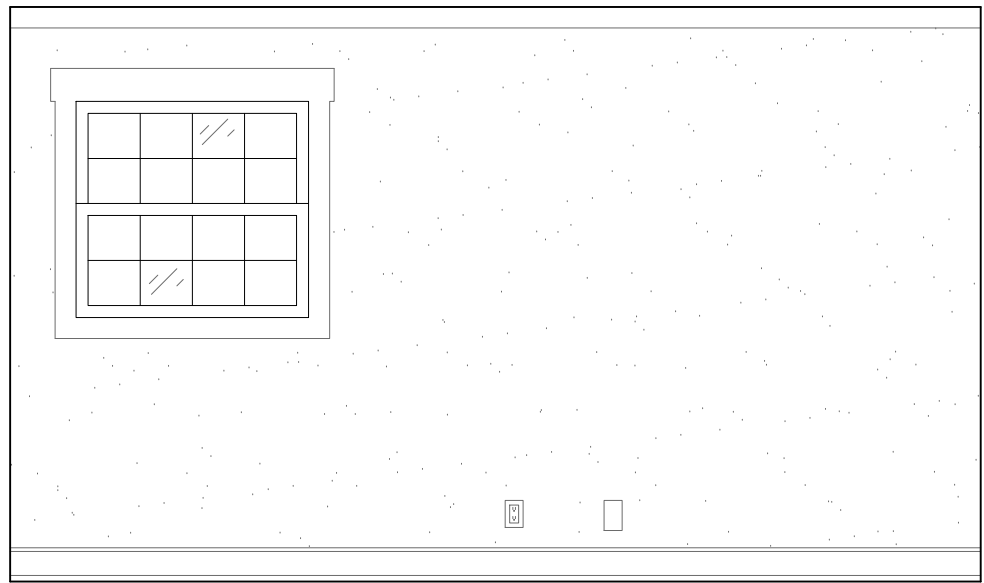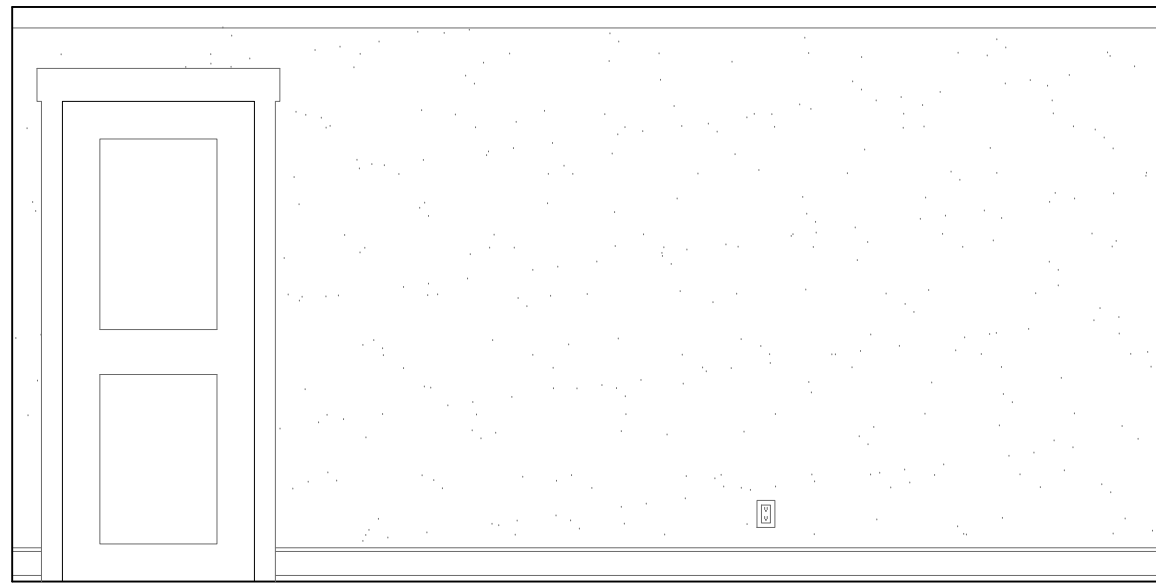

3 BEDROOM 1

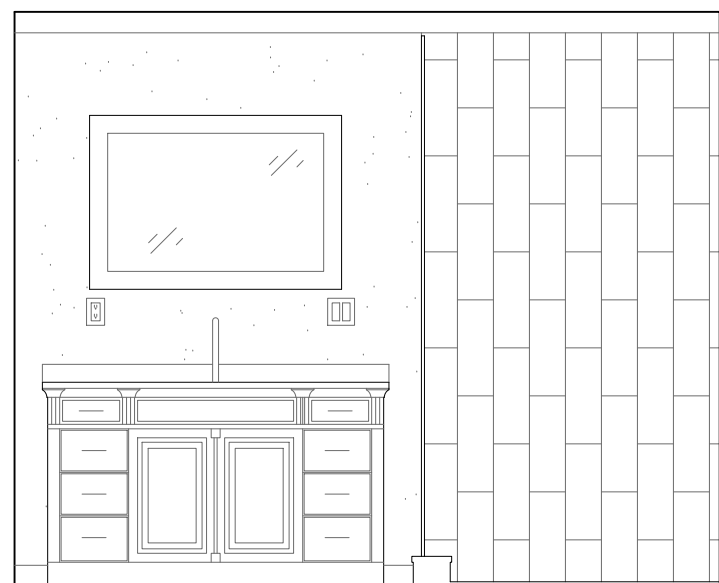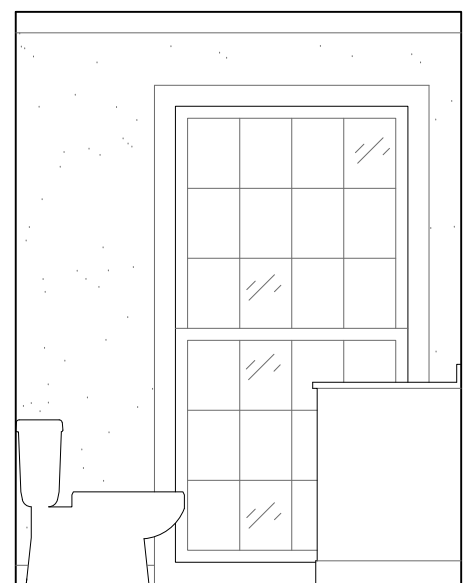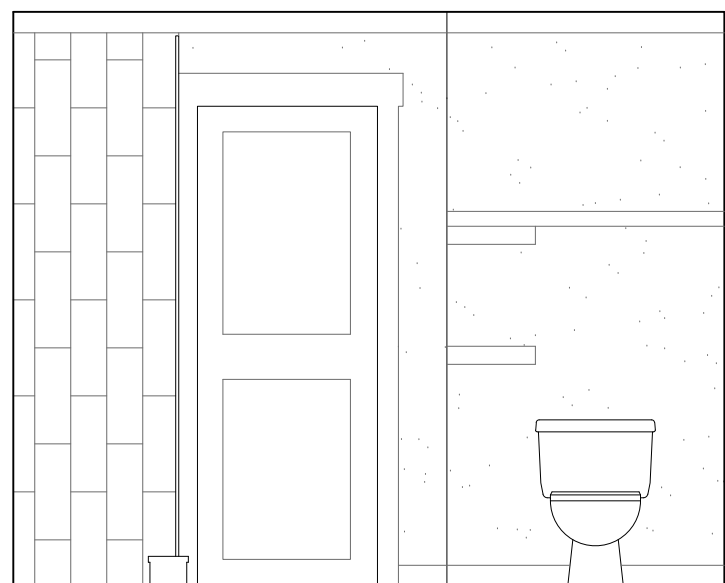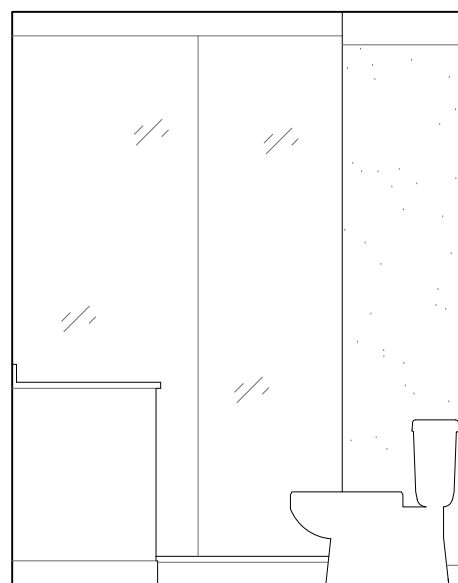

4 BEDROOM 1 BATH

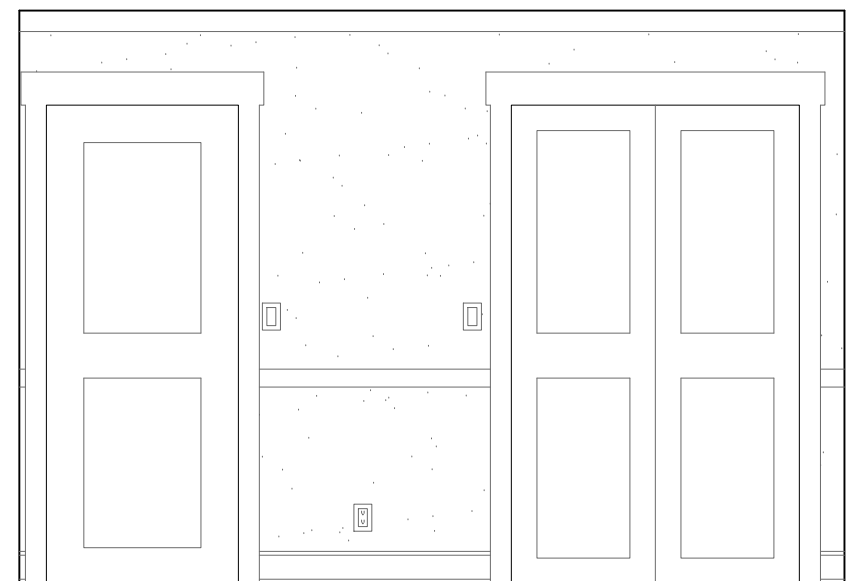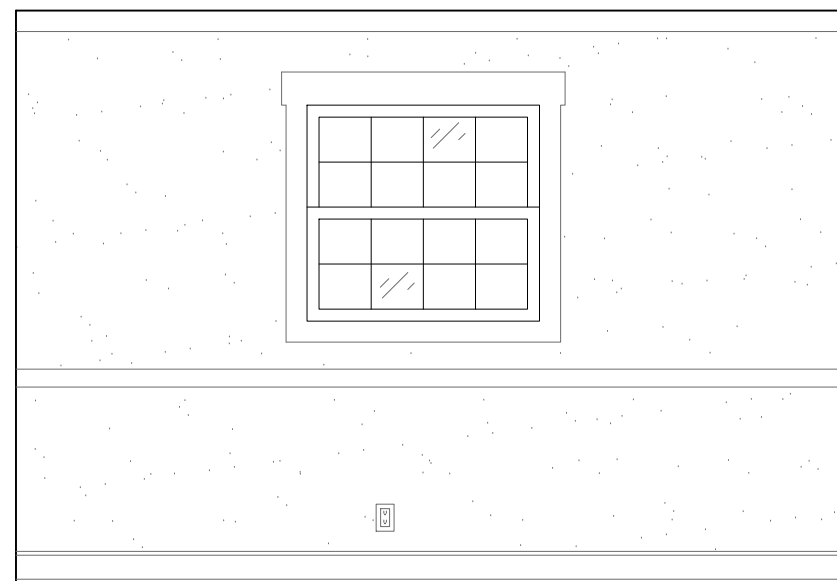

5 BEDROOM 2

As BUILT

PROFESSIONALS

www.asbuiltprofessionals.com

A DIVISION OF:

AEC

CONSULTANTS INC

844.272.8458


844 A S B U I L T

© 2019 AEC CONSULTANTS INC


ARCHITECTURAL AS BUILT

Nashville, TN 37215

01	100% SUBMISSION	SEE COVER SHEET
NO.	ISSUES REVISIONS	DATE
SHEET TITLE		
INTERIOR ELEVATIONS		
HL		PROJECT MANAGER
HL		PROJECT DIRECTOR
012317-1		PROJECT NUMBER
3/8"=1'-0"		SCALE
CL		DRAWN BY
SHEET NUMBER		
AB-6		

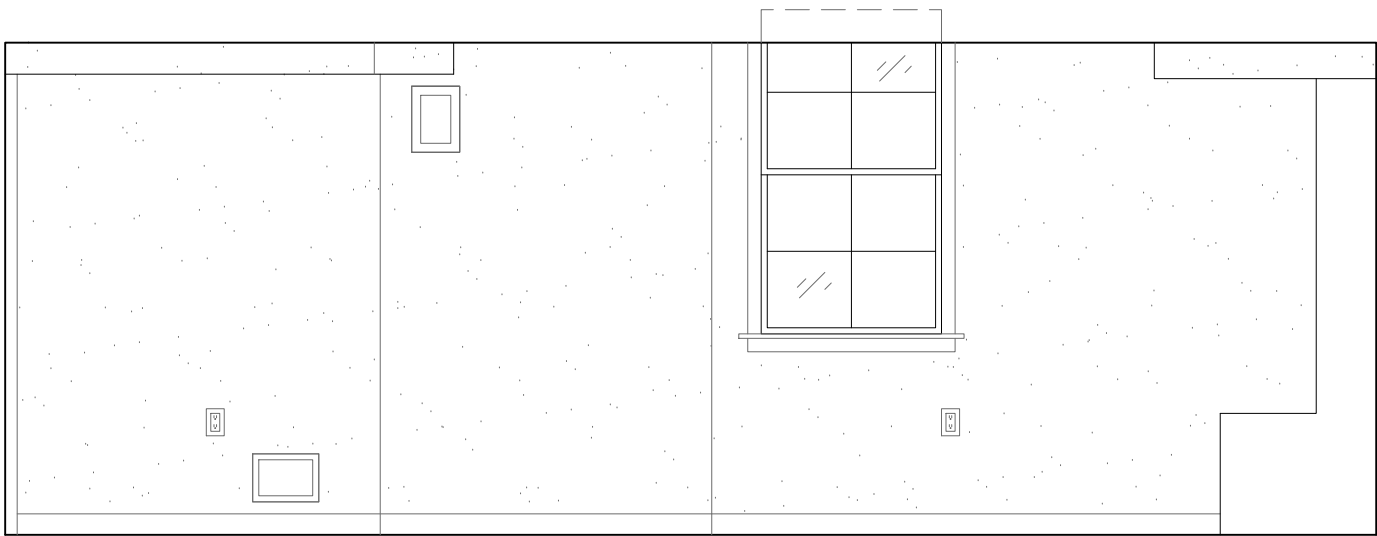


A

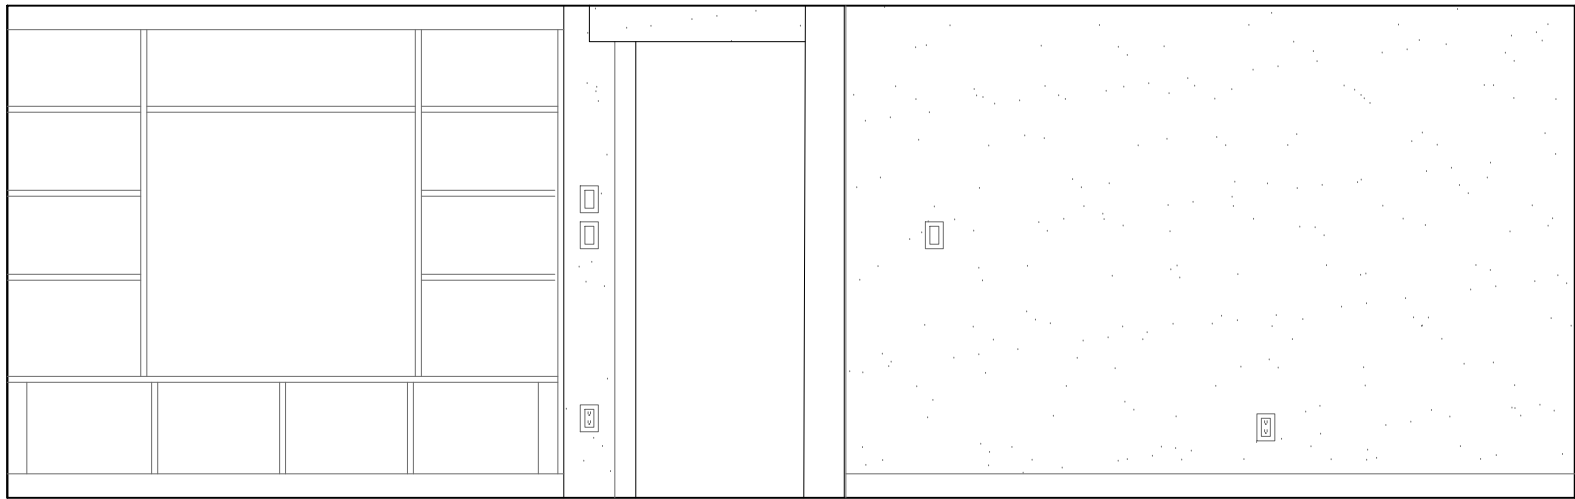


B

1

BEDROOM 4

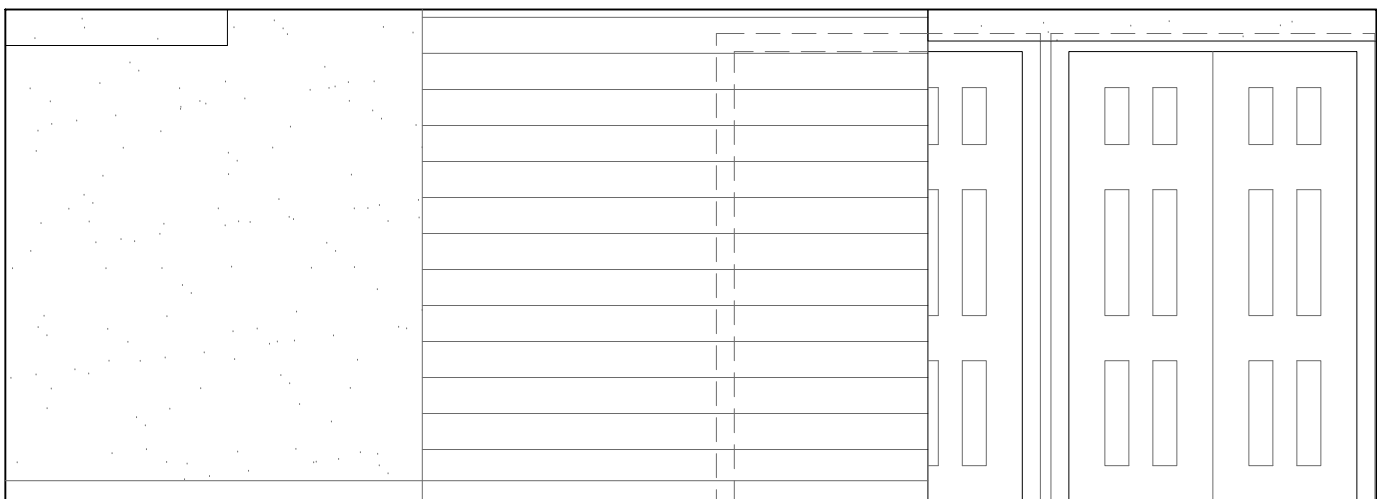


C

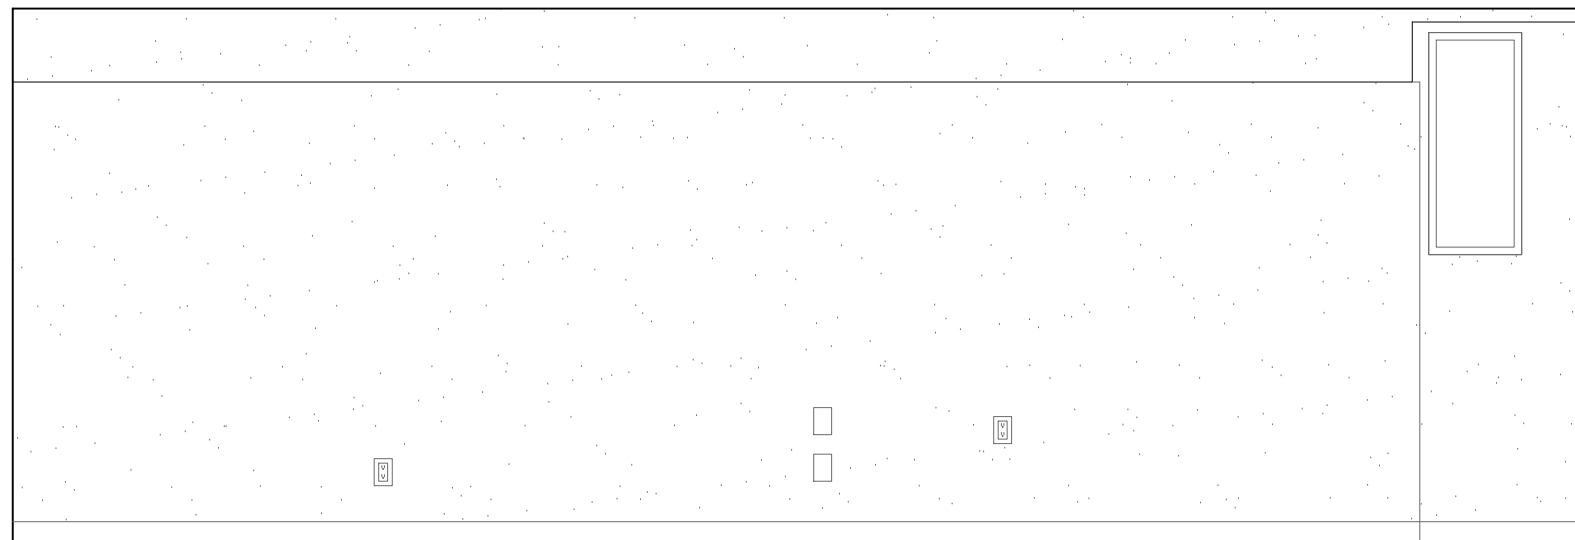


D

1

BEDROOM 4

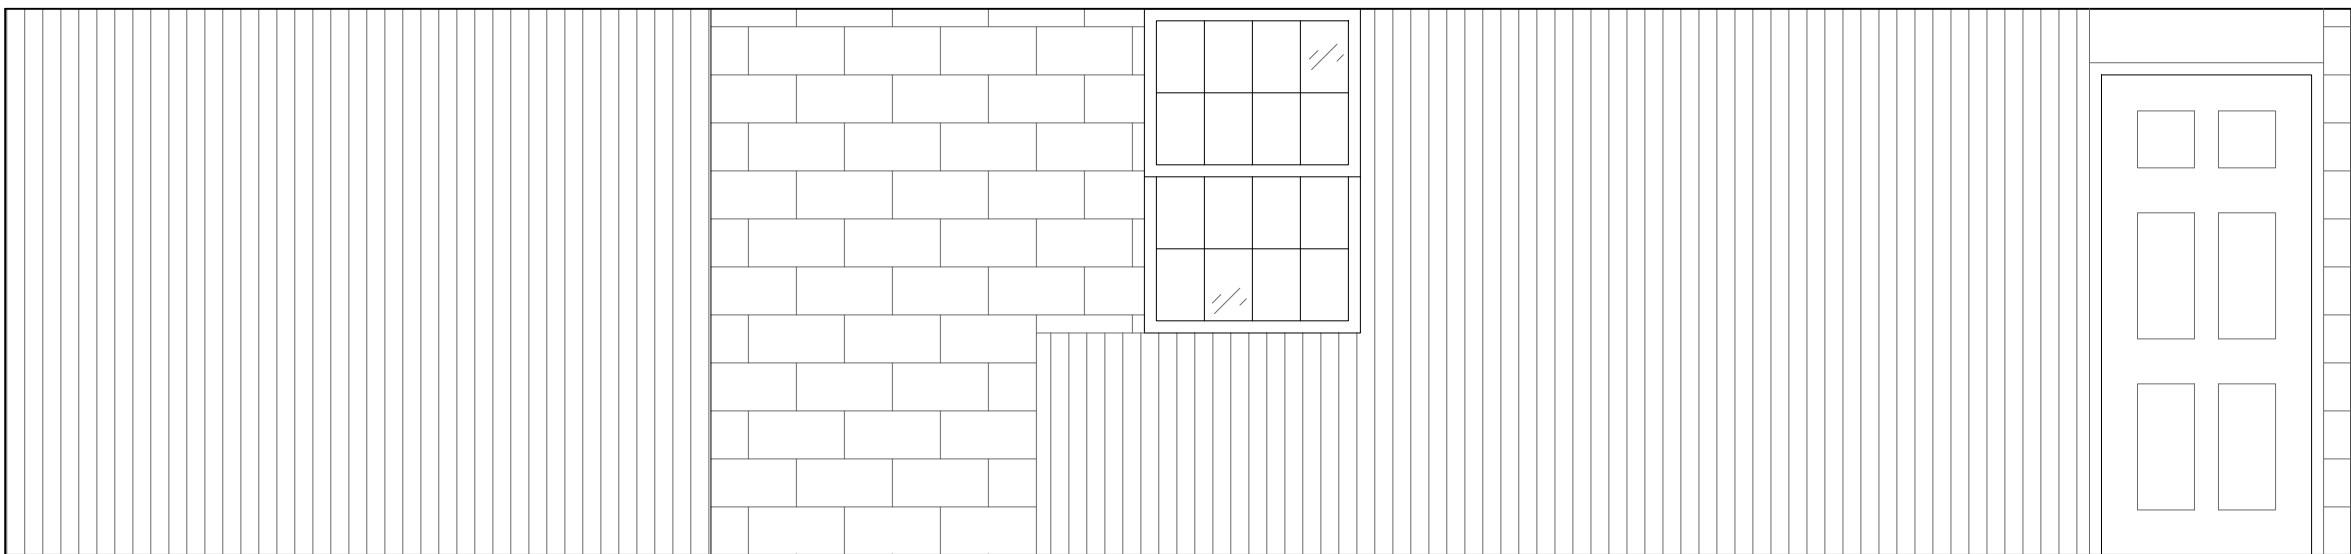


A

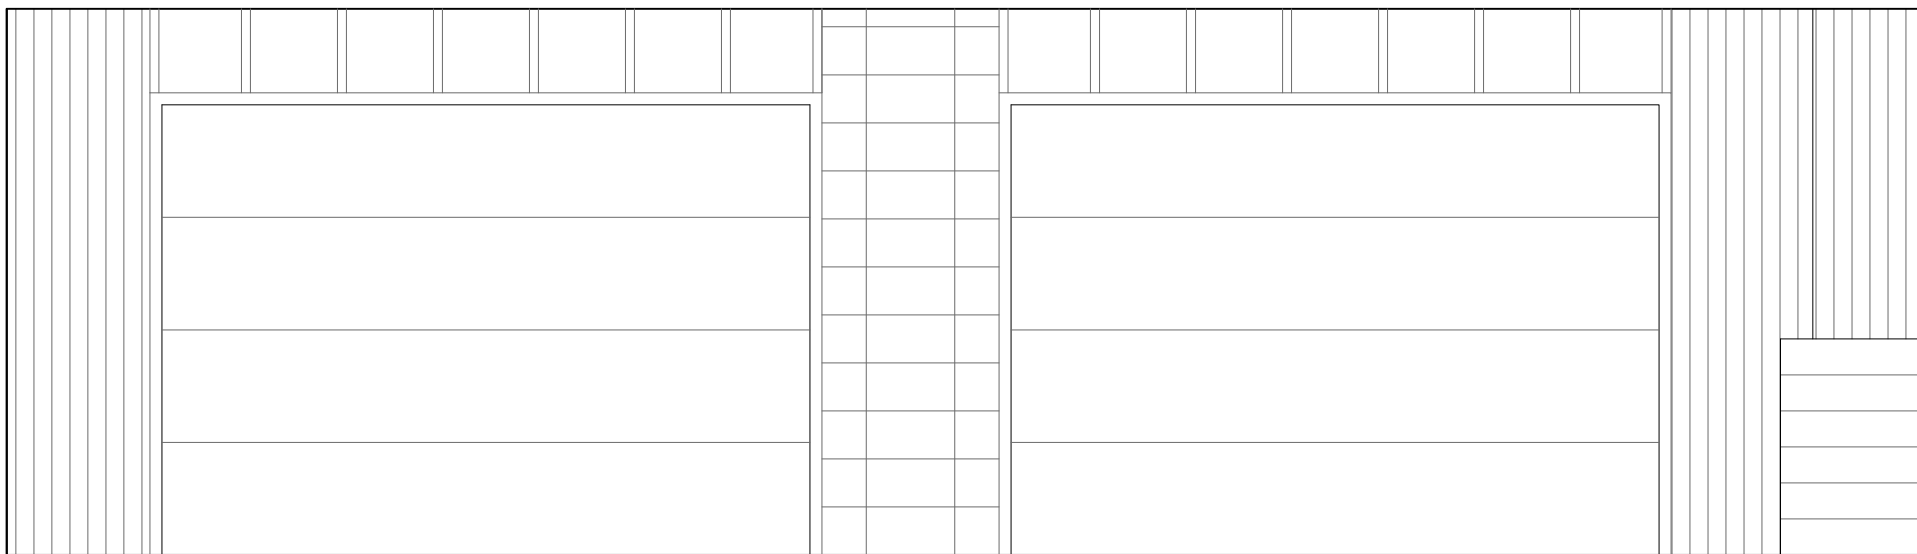


B

2

GARAGE

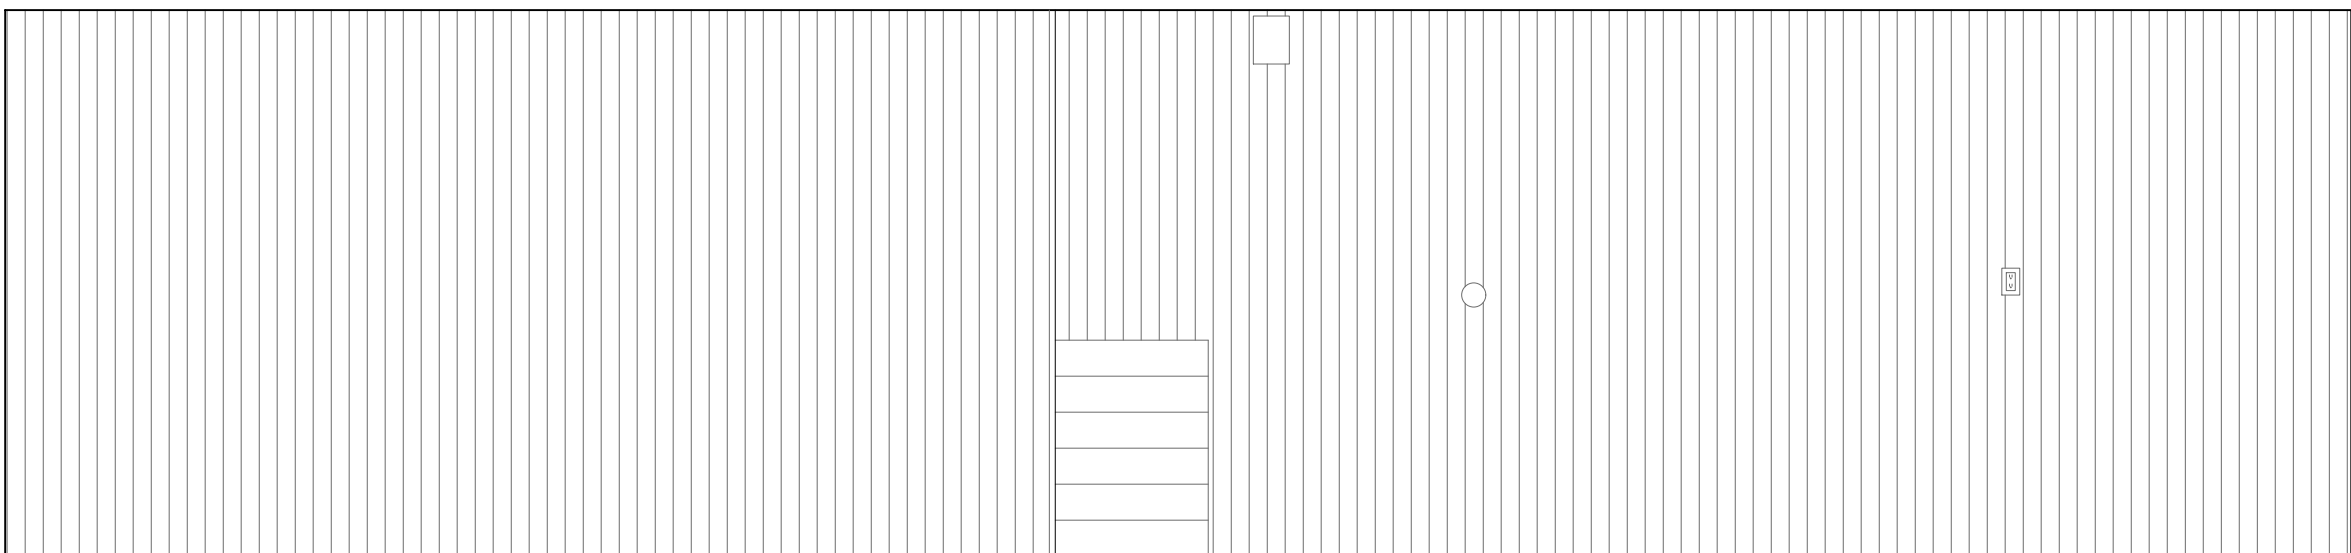

C

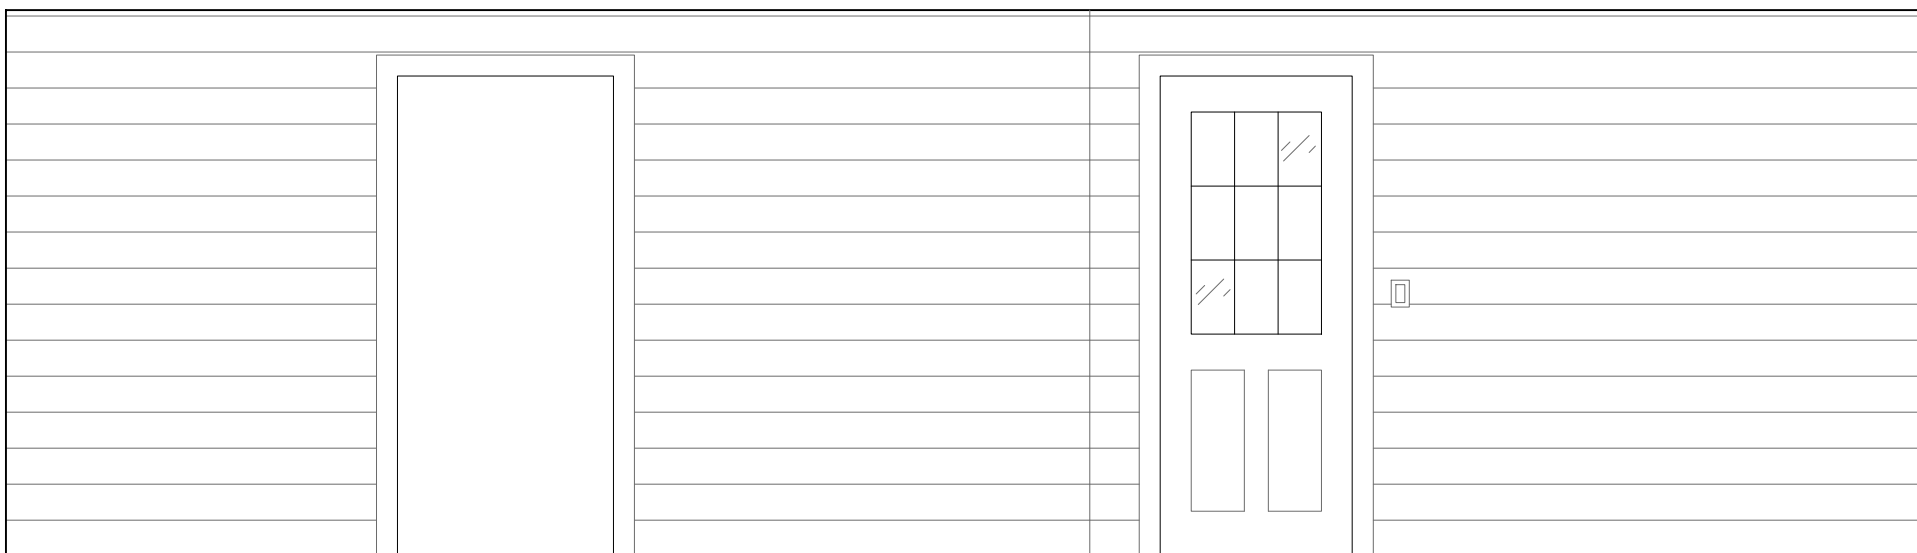

D

2

GARAGE



© 2019 AEC CONSULTANTS INC

ARCHITECTURAL AS BUILT
Nashville, TN 37215

01	100% SUBMISSION	SEE COVER SHEET
NO.	ISSUES REVISIONS	DATE

SHEET TITLE	
INTERIOR ELEVATIONS	
HL	PROJECT MANAGER
HL	PROJECT DIRECTOR
012317-1	PROJECT NUMBER
3/8"=1'-0"	SCALE
CL	DRAWN BY
SHEET NUMBER	

AB-8