


AUSTIN, TEXAS 78746




100% SUBMITTAL

C-1	COVER SHEET DRAWING INDEX
AB-1	SCHEDULES AND SYMBOLS LEGEND
AB-2	FIRST FLOOR WITH ELECTRICAL / RCP
AB-3	SECOND FLOOR WITH ELECTRICAL / RCP
AB-4	ELEVATIONS
AB-5	ELEVATIONS
AB-6	LONGITUDINAL AND TRANSVERSE SECTIONS
AB-7	ROOF PLAN AND OBSERVABLE TYPICAL EXTERIOR WALL SECTION

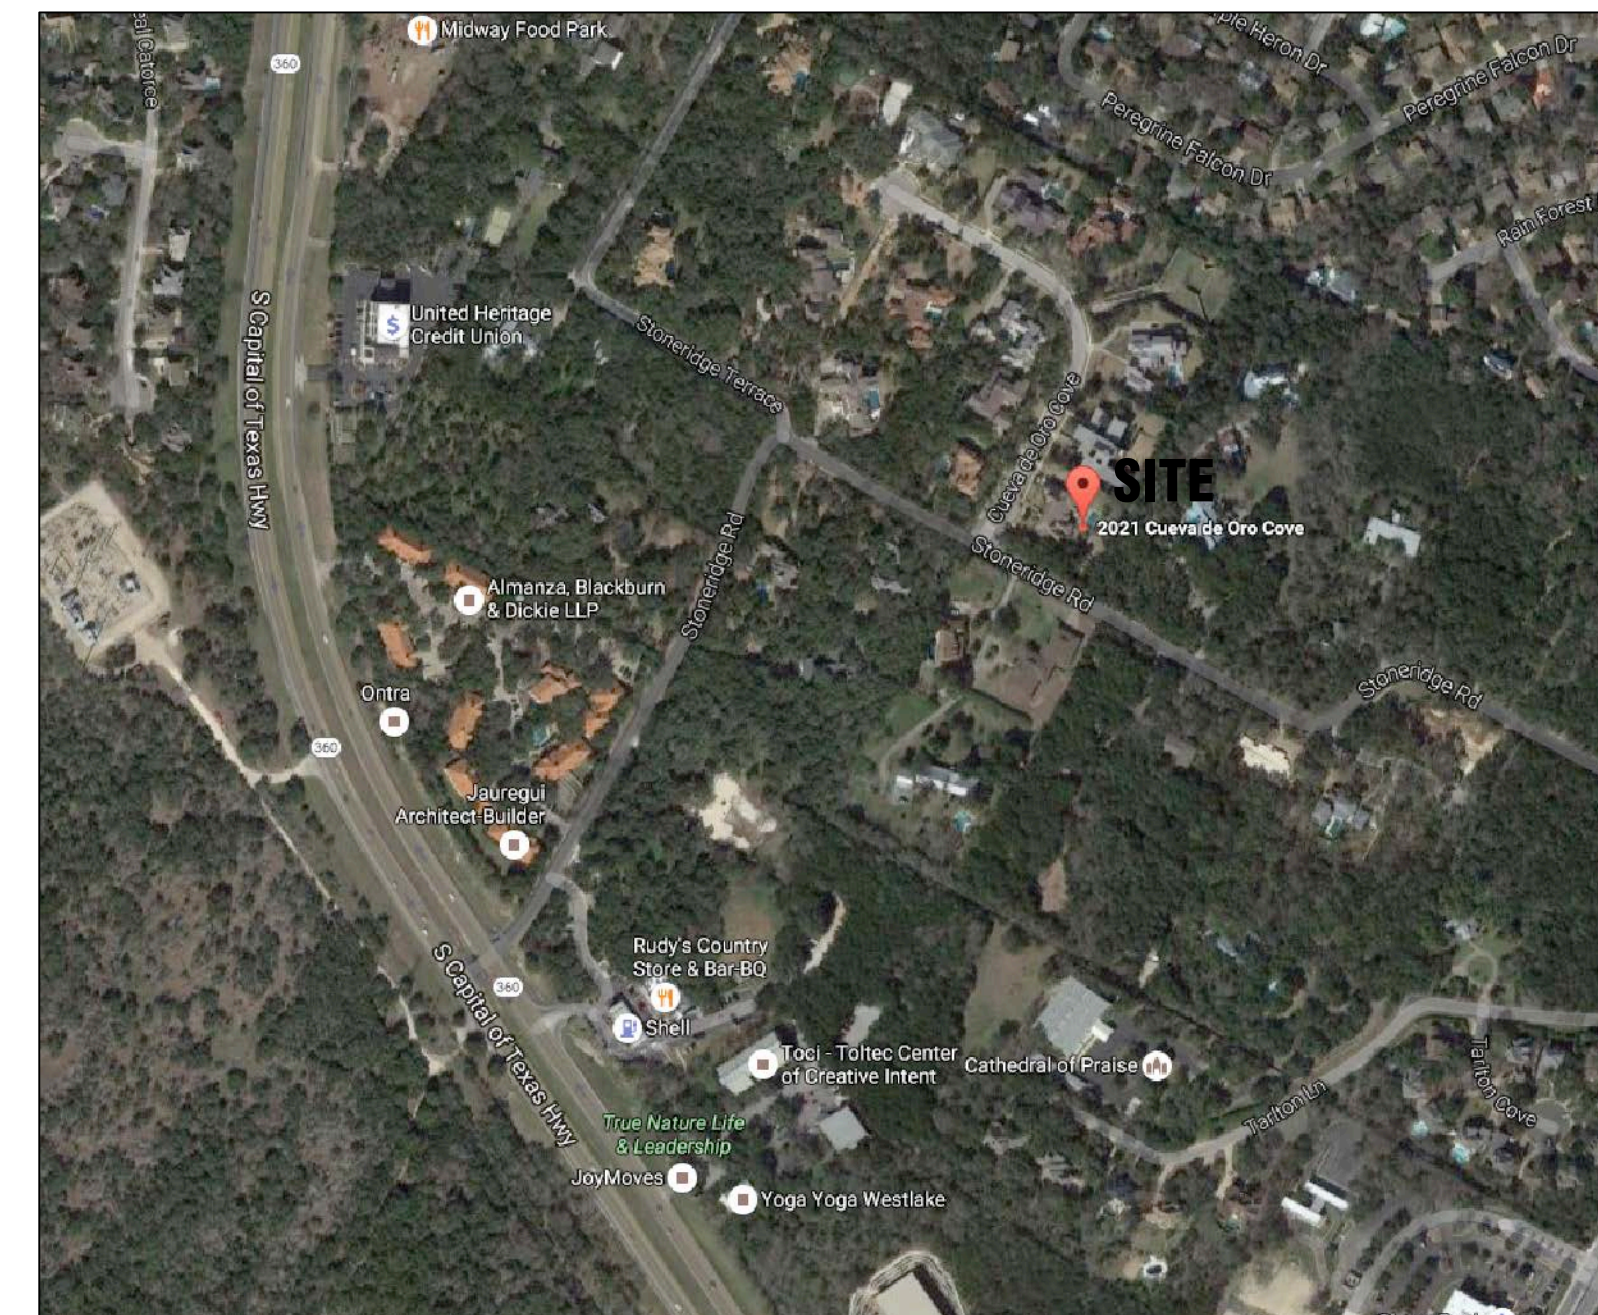

 **VICINITY MAP**
NTS

Ks BUILT PROFESSIONALS A DIVISION OF: AEC CONSULTANTS INC www.aecconsultantsinc.com 844.272.8458 © 2016 AEC CONSULTANTS INC		
ARCHITECTURAL AS BUILT RESIDENCE		
AUSTIN, TEXAS 78746		
O1	100% SUBMISSION	
NO.	ISSUES REVISIONS	DATE
		SHEET TITLE
COVER SHEET		
HL	PROJECT MANAGER	
HL	PROJECT DIRECTOR	
9-2-16-1	PROJECT NUMBER	
AS NOTED	SCALE	
CL	DRAWN BY	
		SHEET NUMBER
C-1		

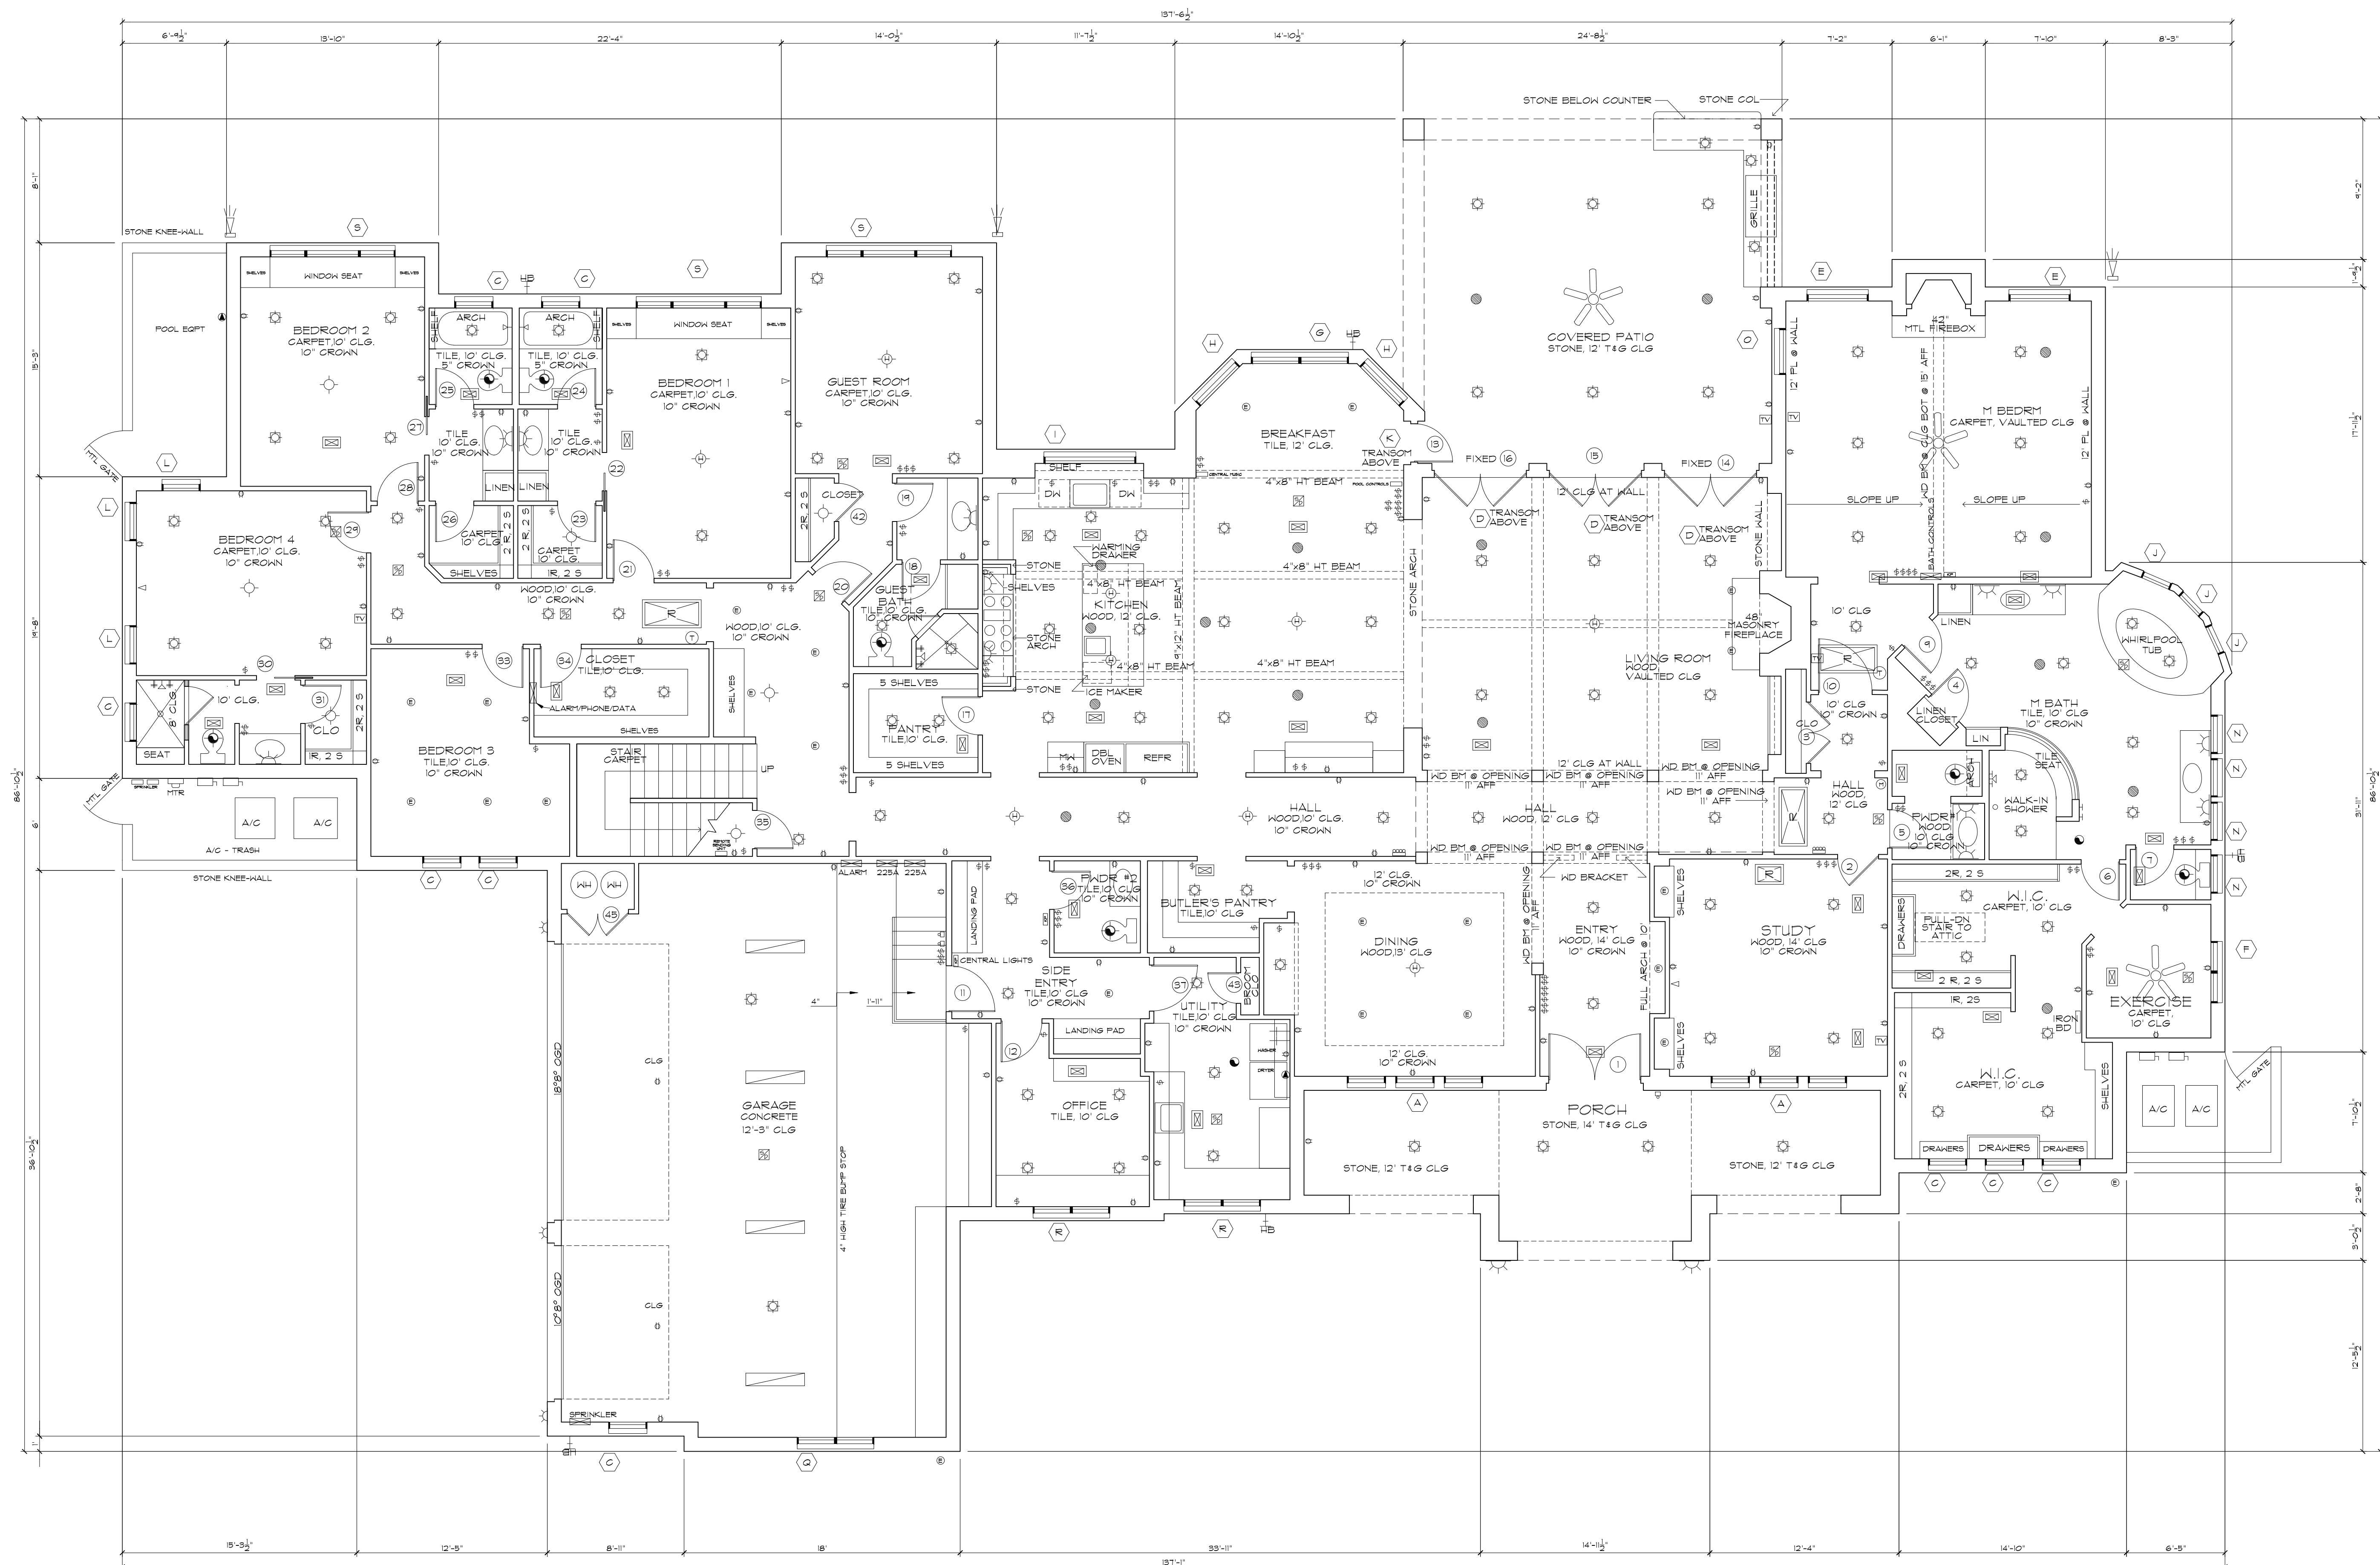

**ARCHITECTURAL AS BUILT
RESIDENCE**

SHEET TITLE	
HL	PROJECT MANAGER
HL	PROJECT DIRECTOR
9-2-16-1	PROJECT NUMBER
AS NOTED	SCALE
CL	DRAWN BY
	SHEET NUMBER





AUSTIN, TEXAS 78746





SCALE 3/16" = 1'-0"

AB-3

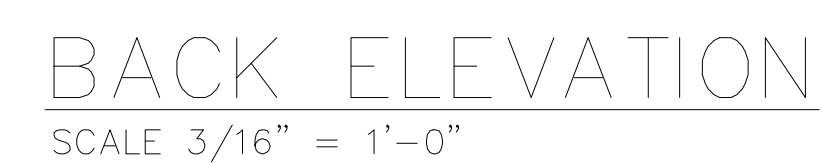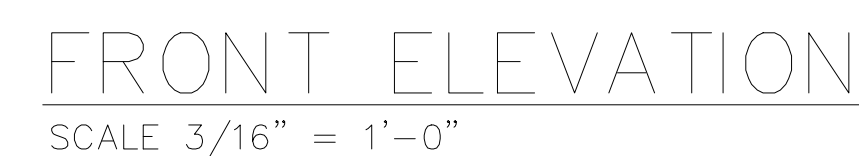


**ARCHITECTURAL AS BUILT
RESIDENCE**

AB-4

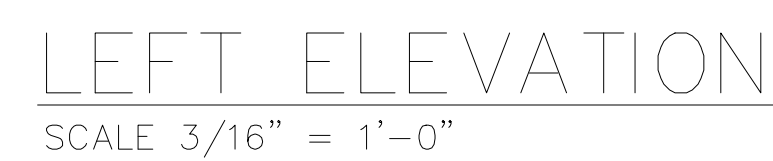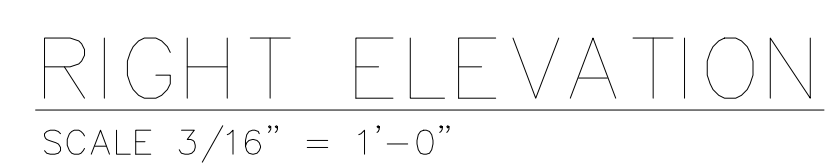


AUSTIN, TEXAS 78746

AB-5

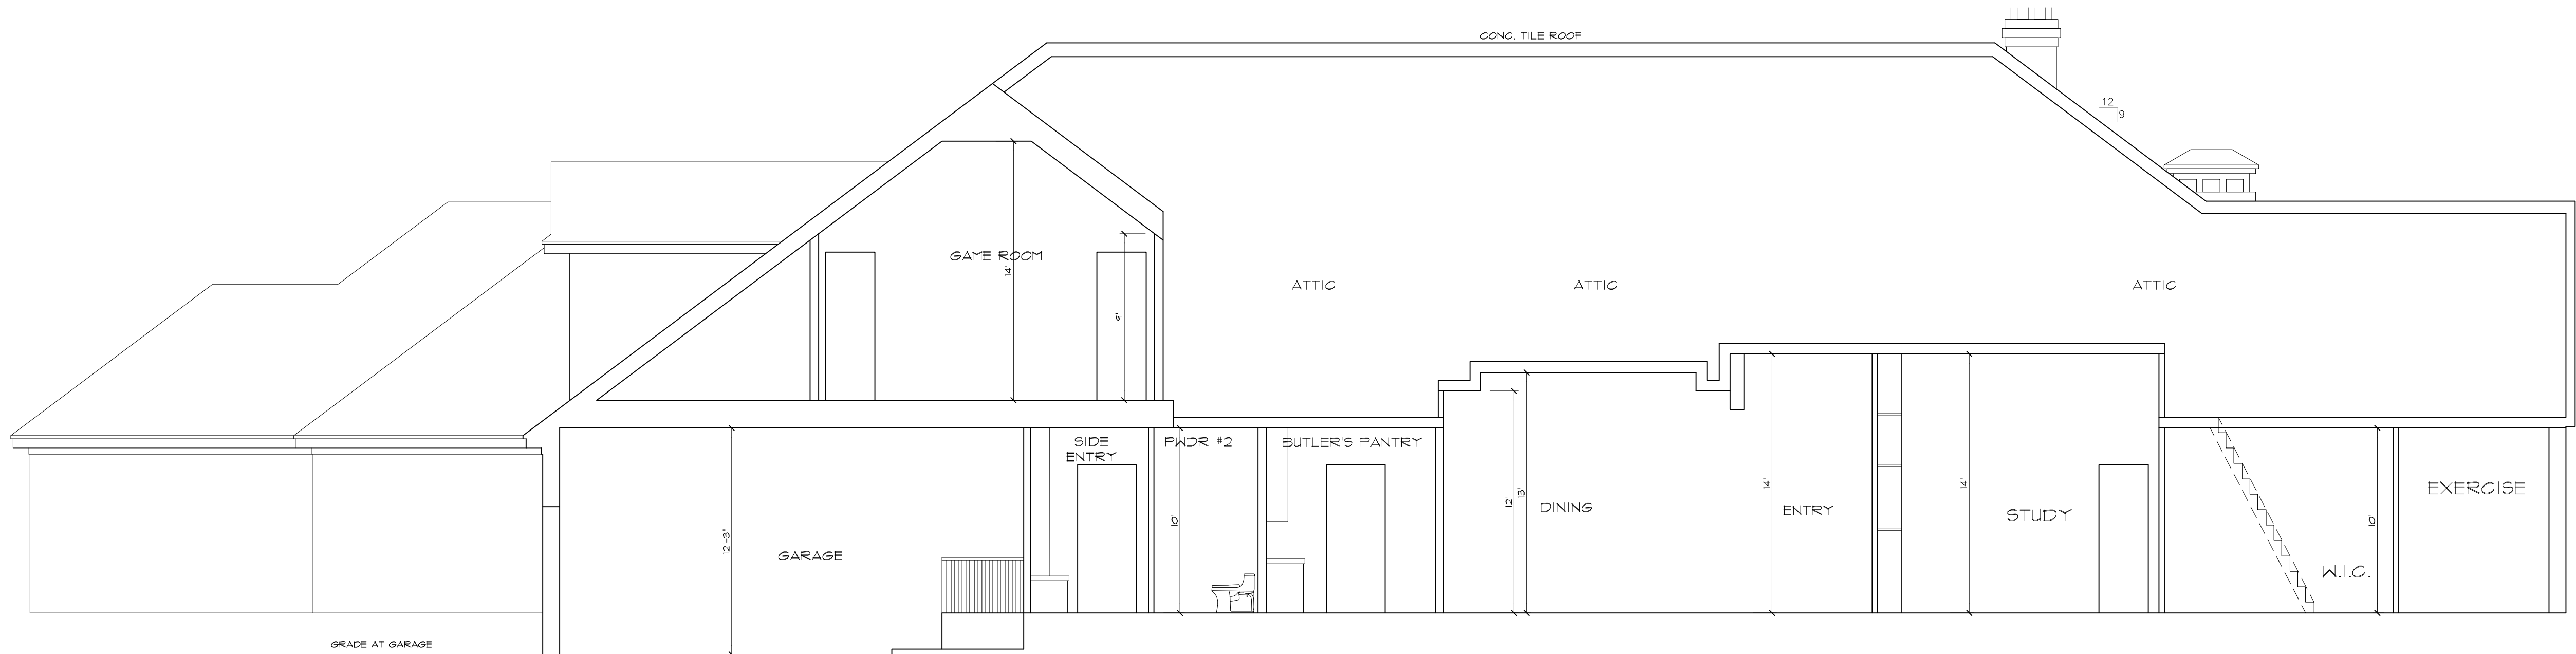


OBSERVABLE LONGITUDINAL BUILDING SECTION
SCALE: 3/16" = 1'-0"

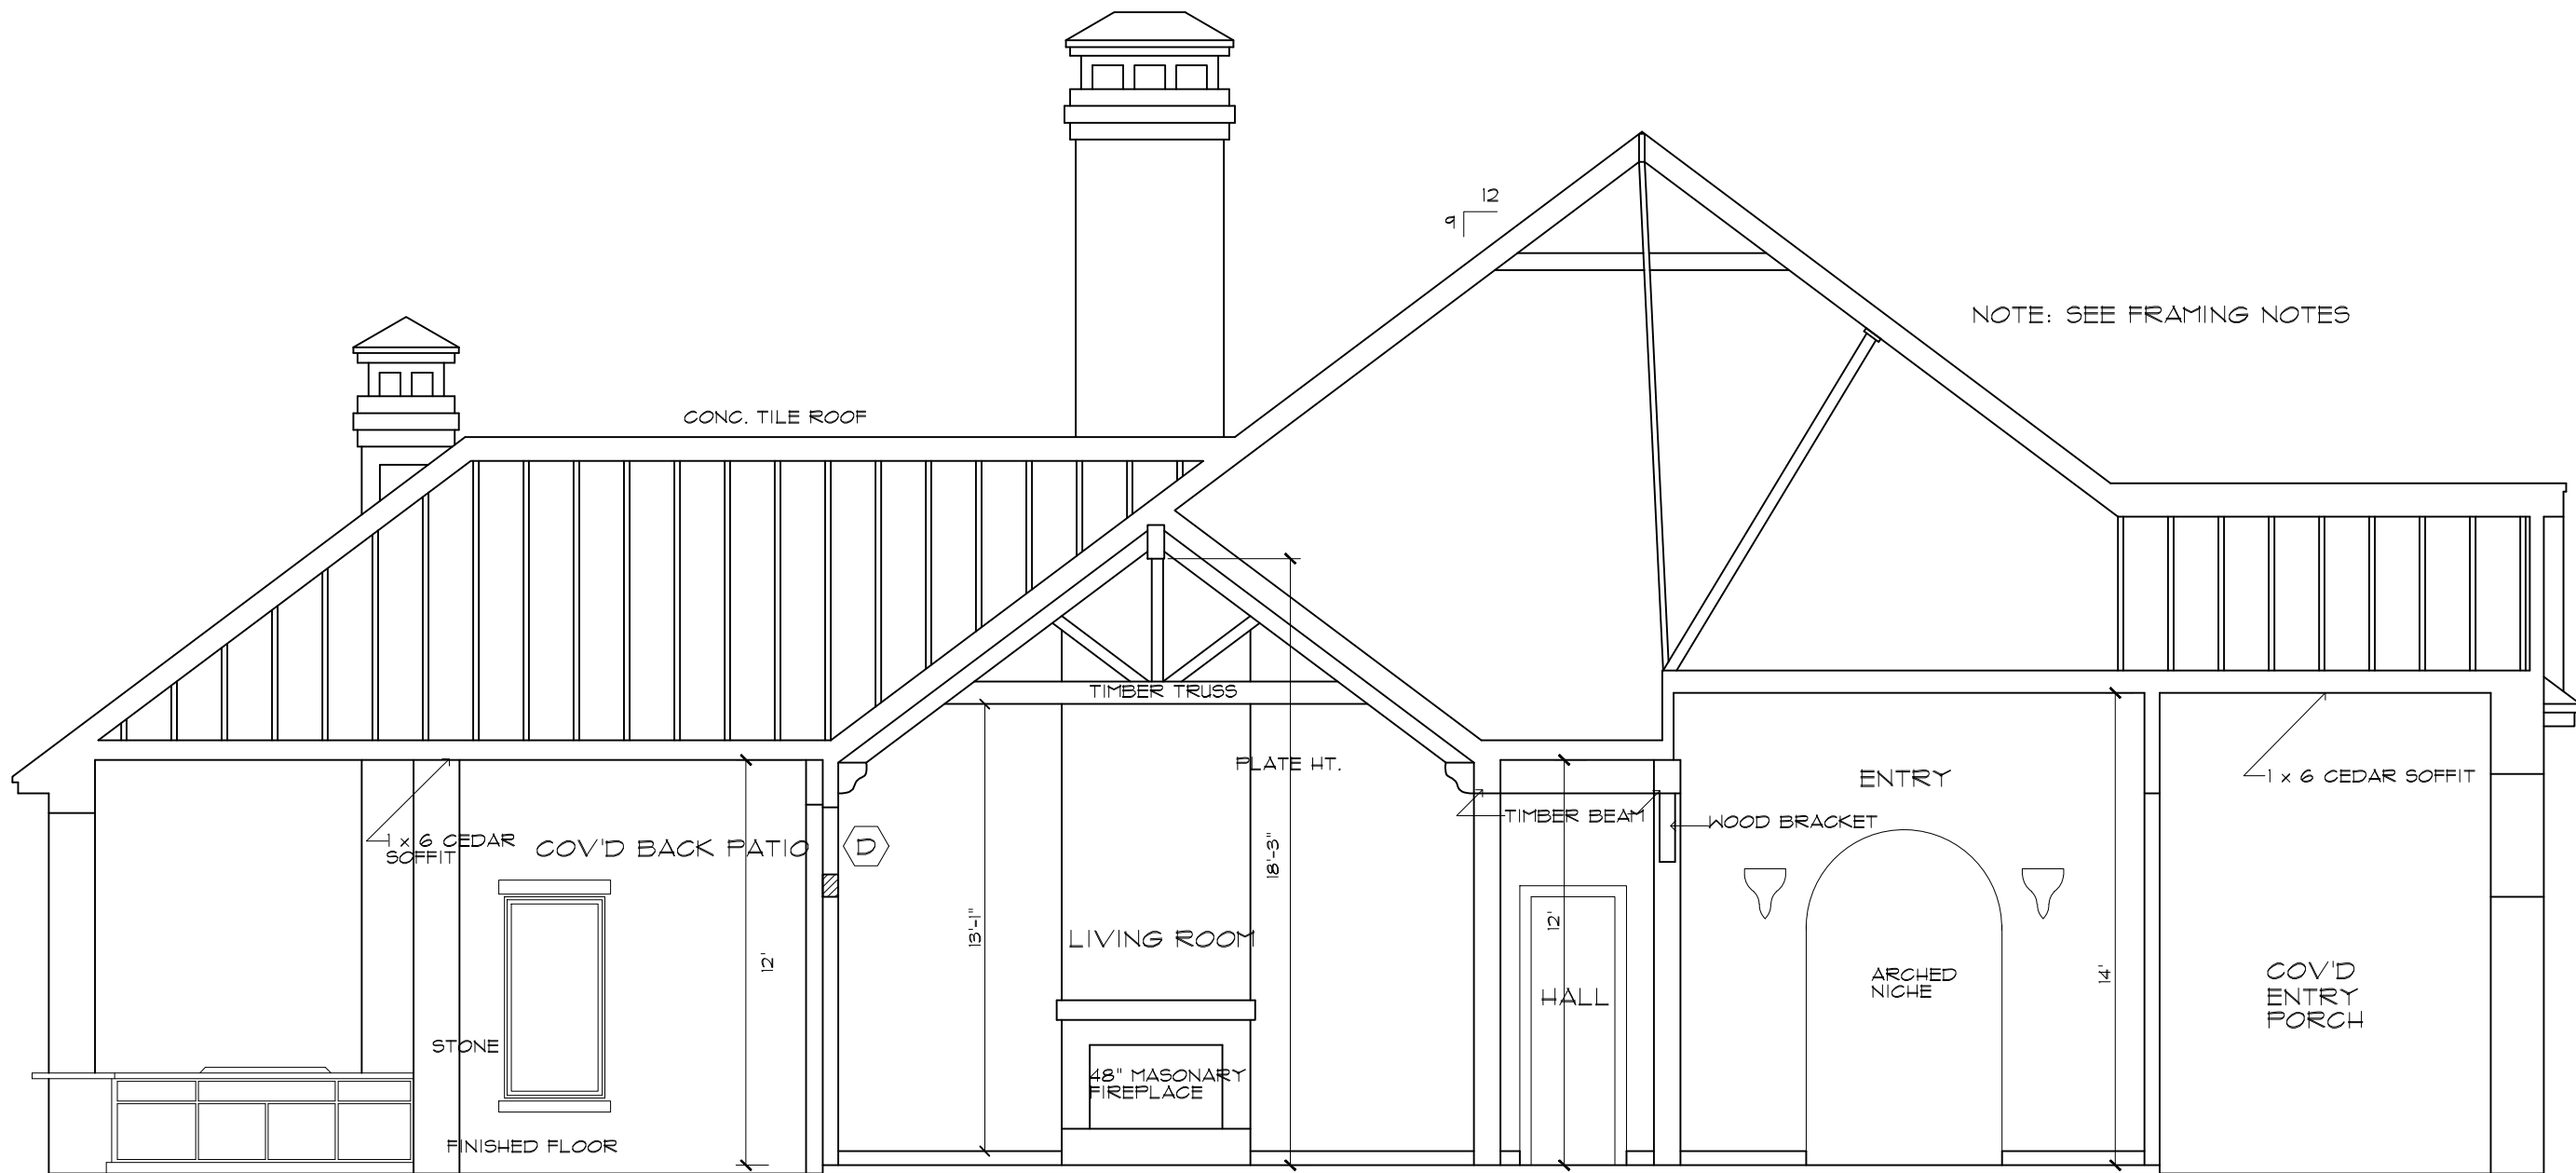

OBSERVABLE TRANSVERSE BUILDING SECTION WITH ATTIC FRAMING NOTES
SCALE: 3/16" = 1'-0"

ATTIC FRAMING NOTES:
ROOF PITCH = 31° (4/12)
TYPICAL HAND FRAMING AS FOLLOWS:
RAFTER FRAMING = 2x8 @ 16" O.C.
COLLAR TIE = 2x6
HIP AND RIDGE = 2x10
BOTTOM CHORD = 2x8
VERTICAL BRACING FOR MAIN ROOF IS AT THE APPROXIMATE MIDPOINT OF THE RAFTER AND IS (2) 2x4'S FROM RAFTER TO TOP OF BEARING WALL BELOW @ 32" O.C.
VERTICAL BRACING FOR MAIN ROOF RIDGE IS 2x4 @ 6'-8" O.C. AND IS NOT CONSISTENT.

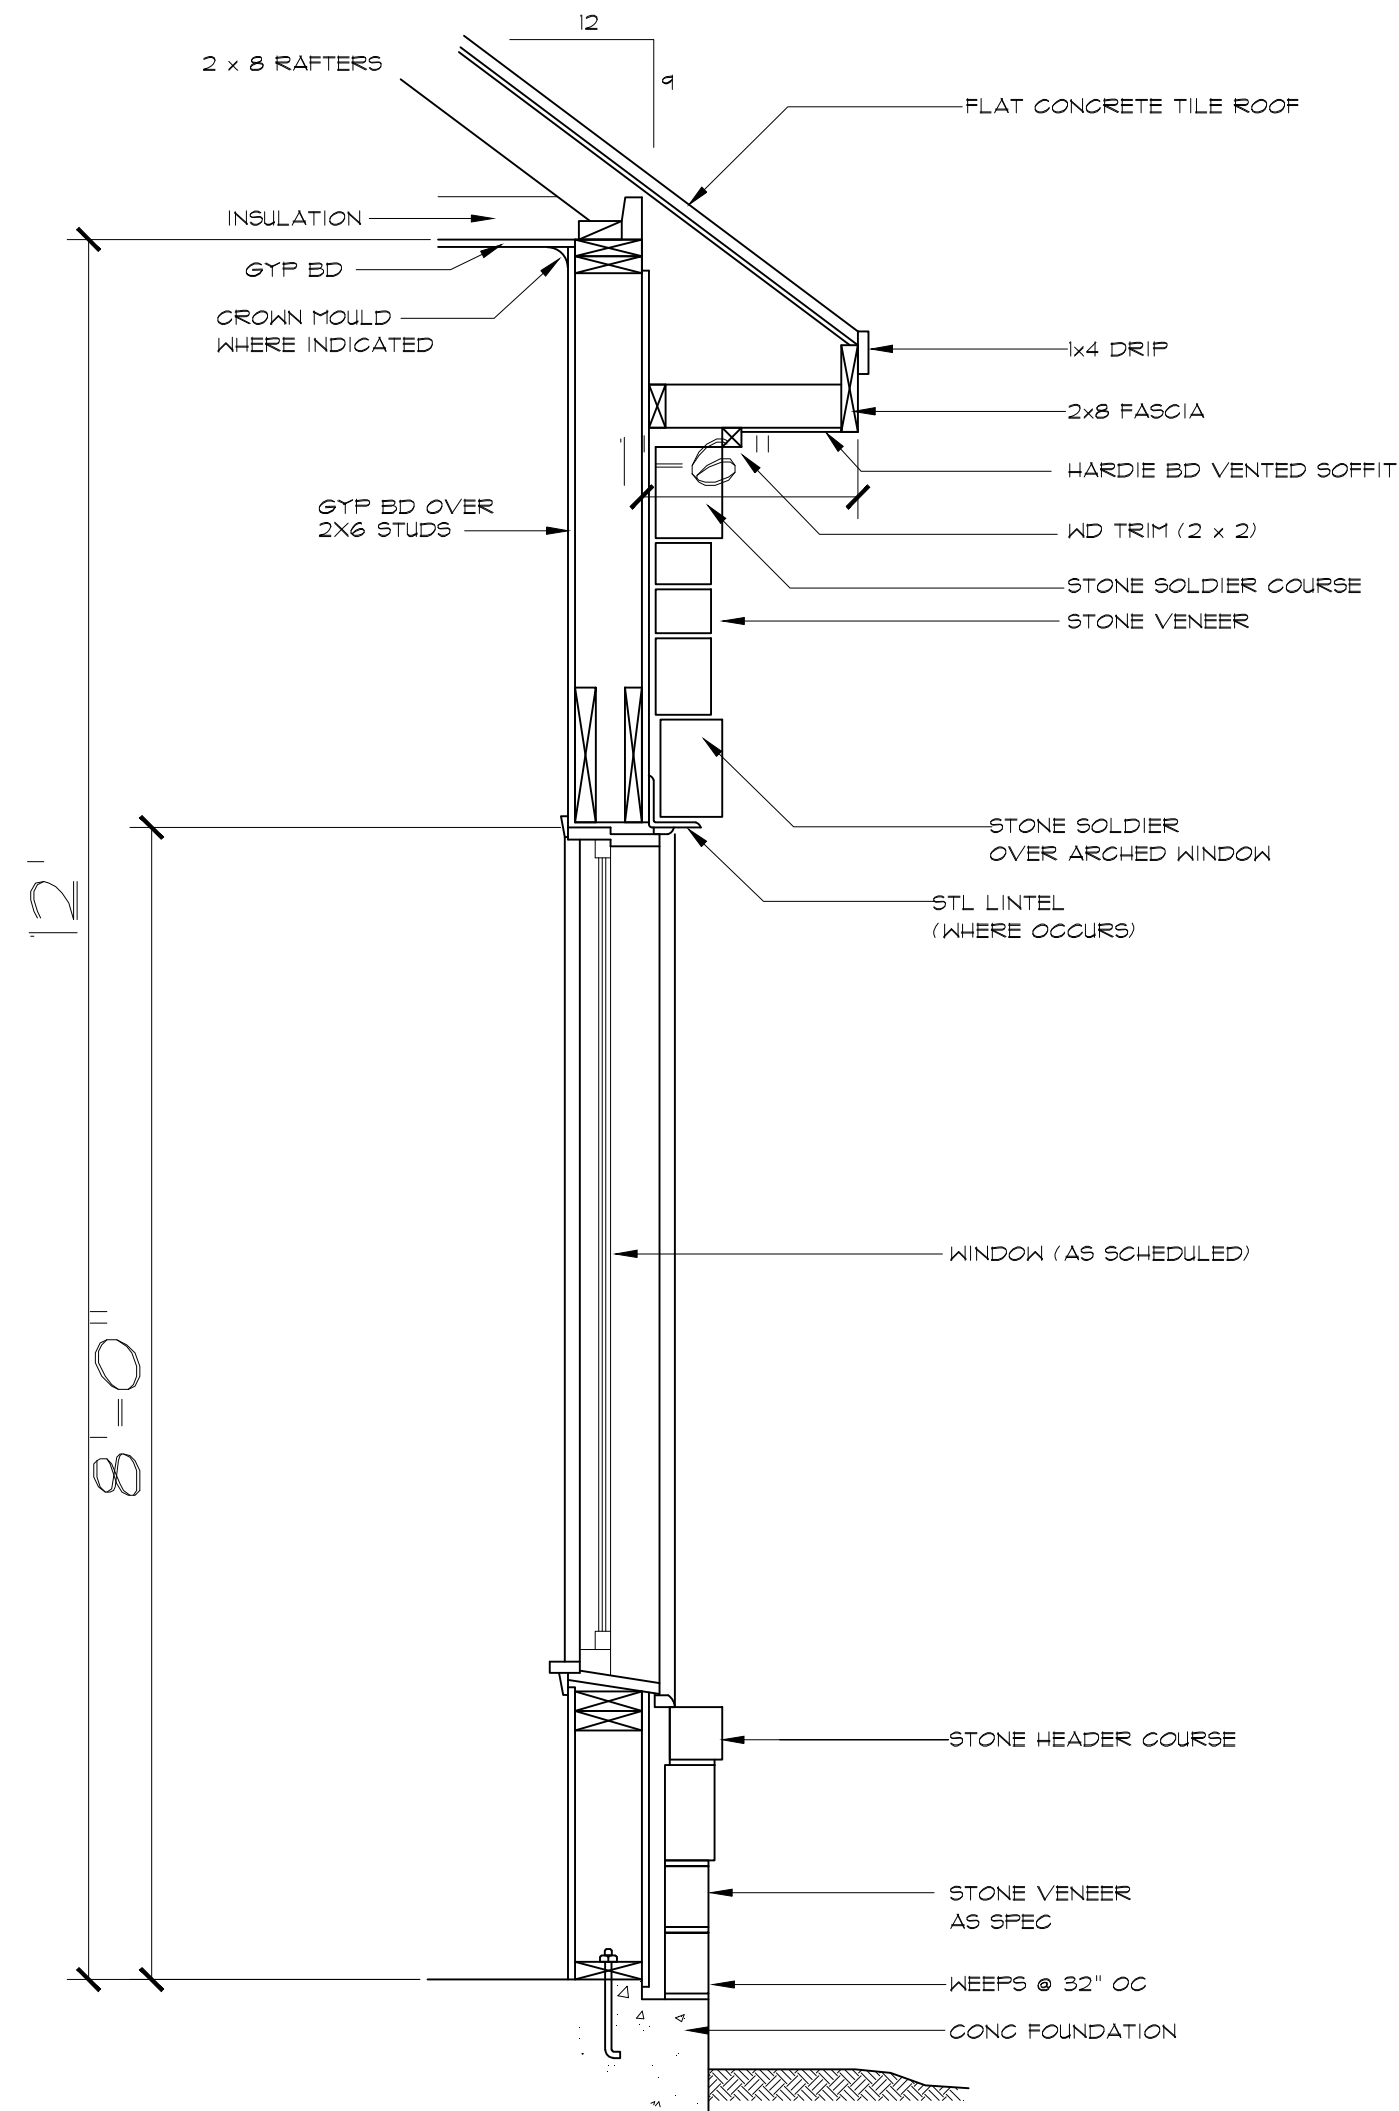

TYPICAL
WALL SECTION (OBSERVABLE)
3/4" = 1'-0"

AS BUILT
PROFESSIONALS

A DIVISION OF:

AEC

CONSULTANTS INC

www.aecconsultantsinc.com

844.272.8458


© 2016 AEC CONSULTANTS INC

ARCHITECTURAL AS BUILT
RESIDENCE

AUSTIN, TEXAS 78746

01	100% SUBMISSION	
NO.	ISSUES REVISIONS	DATE
SHEET TITLE		
HL	PROJECT MANAGER	
HL	PROJECT DIRECTOR	
9-2-16-1	PROJECT NUMBER	
AS NOTED	SCALE	
CL	DRAWN BY	
SHEET NUMBER		

AB-6

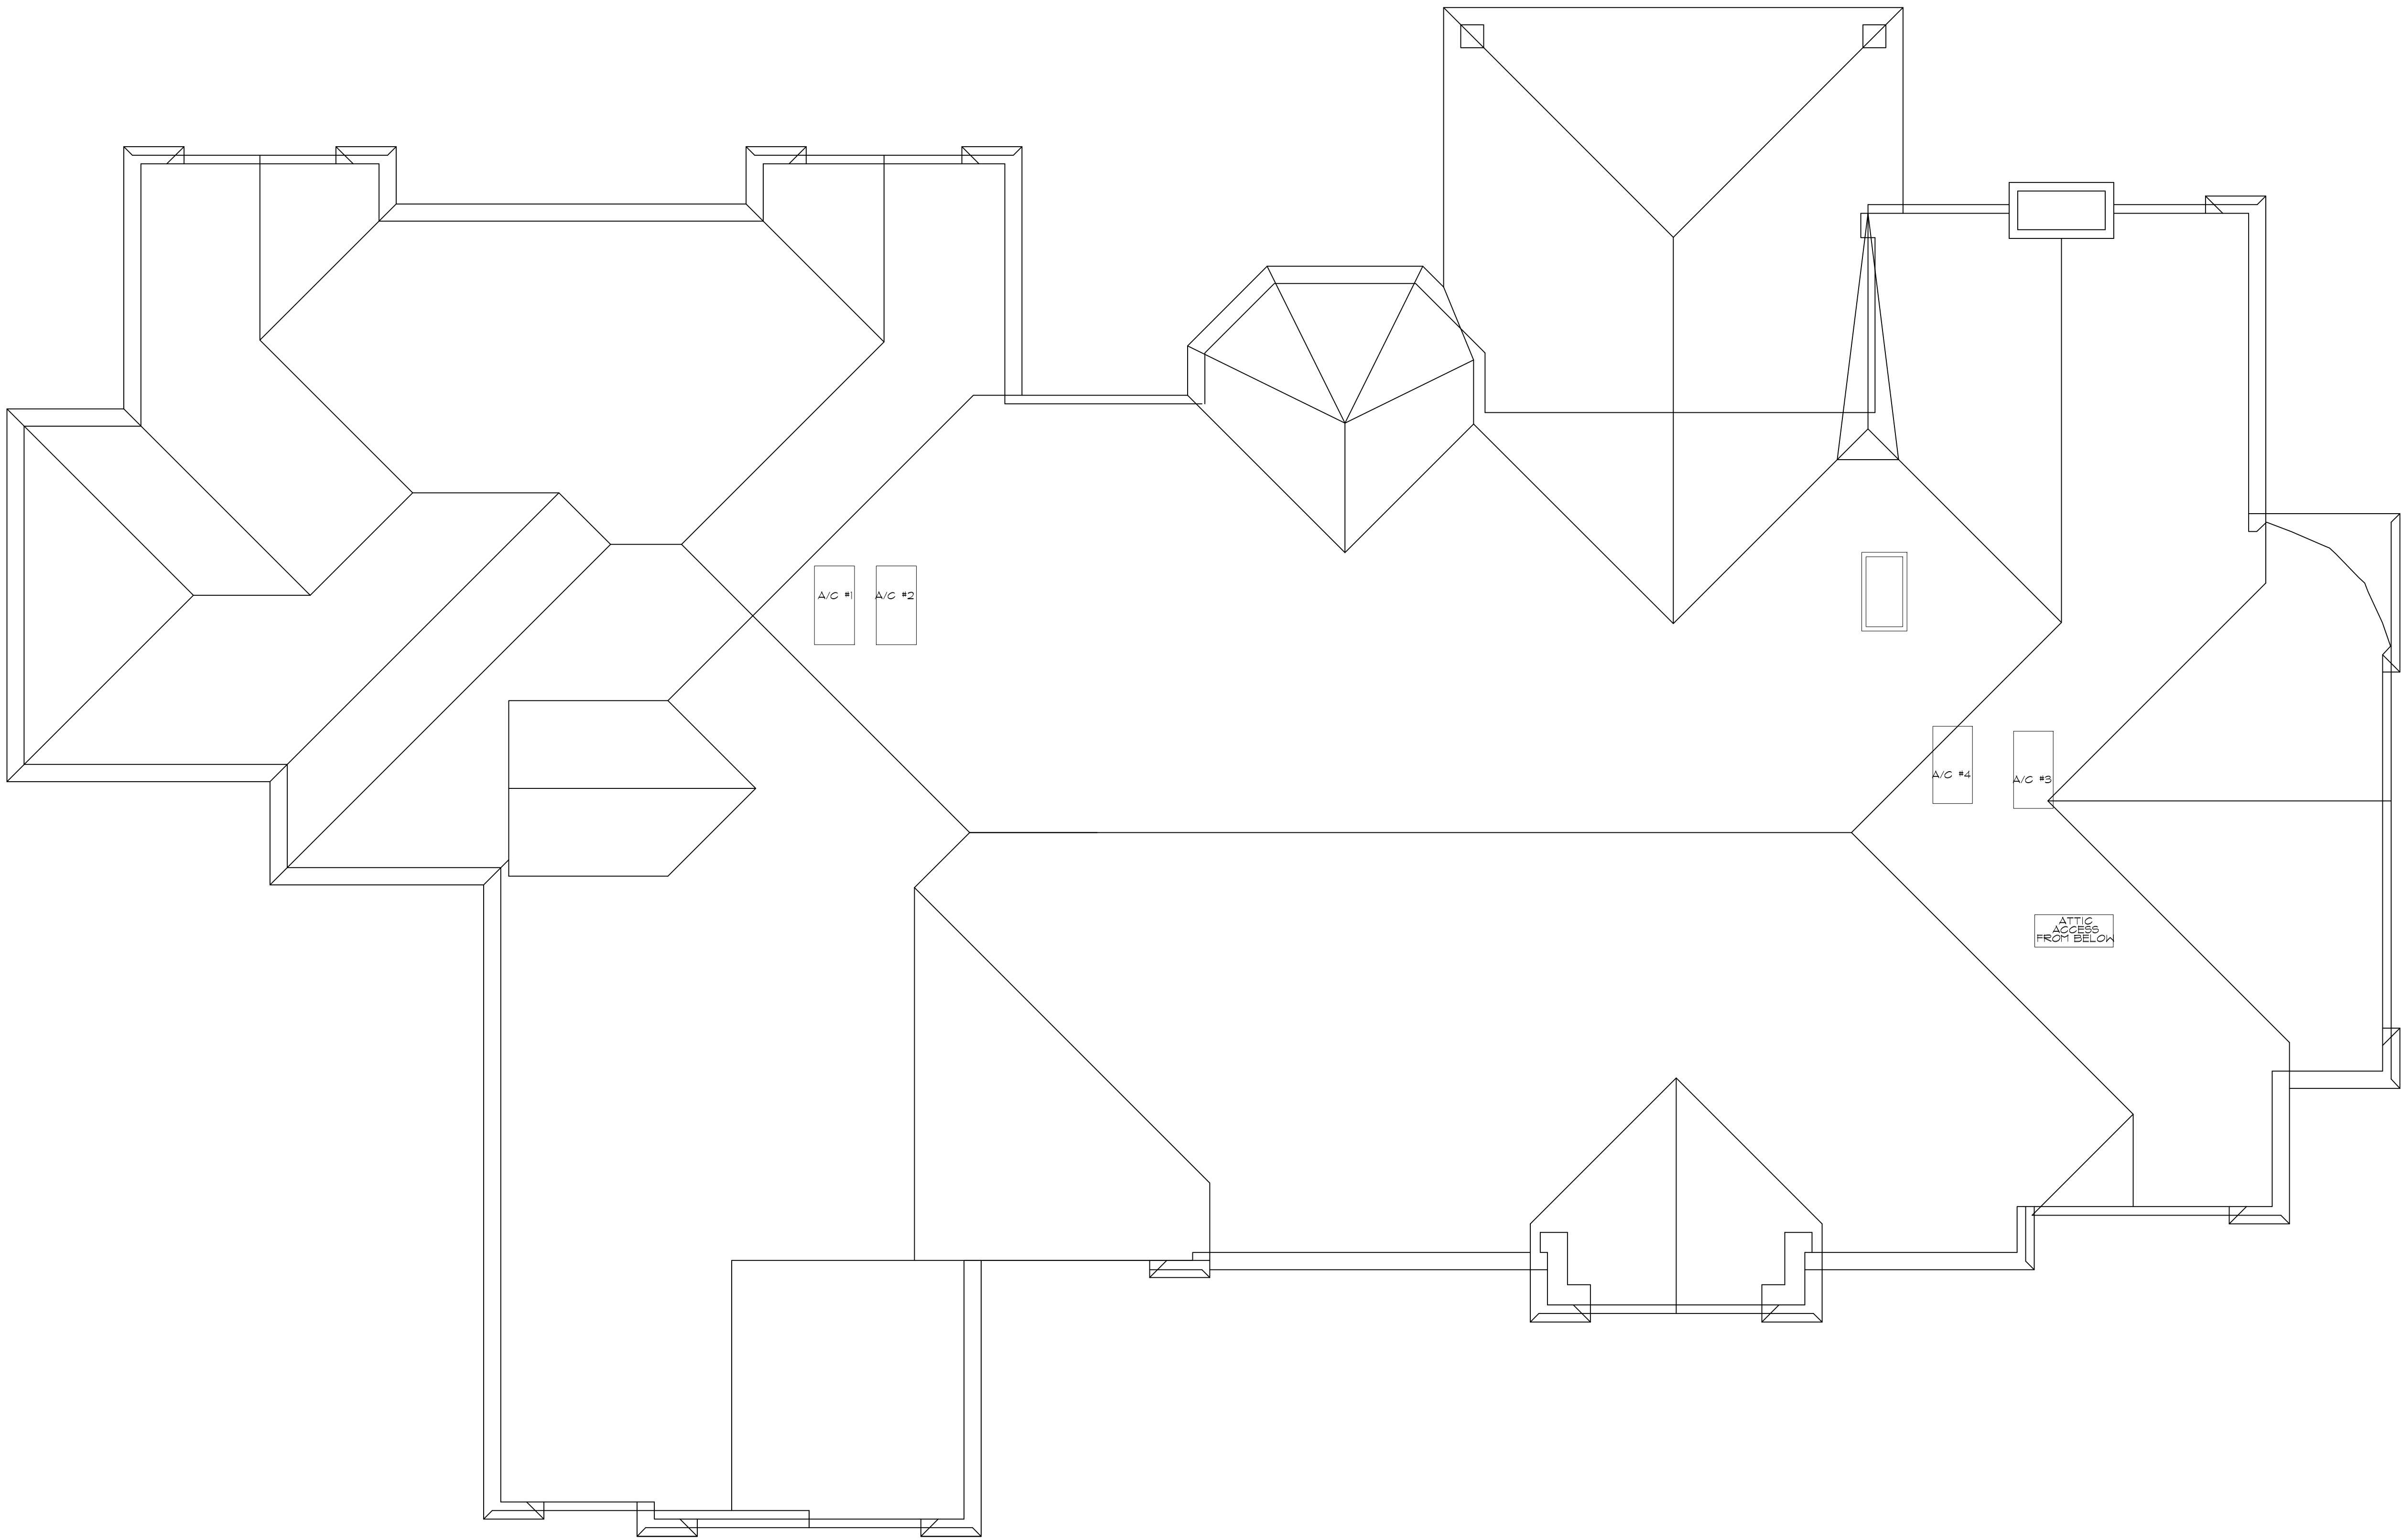

ROOF PLAN (ROOF PITCH 37° - 9:12)

SCALE 3/16" = 1'-0"

As BUILT
PROFESSIONALS

A DIVISION OF:



© 2016 AEC CONSULTANTS INC

ARCHITECTURAL AS BUILT
RESIDENCE

AUSTIN, TEXAS 78746

01 100% SUBMISSION

NO. ISSUES | REVISIONS

DATE

SHEET TITLE

HL

PROJECT MANAGER

HL

PROJECT DIRECTOR

9-2-16-1

PROJECT NUMBER

AS NOTED

SCALE

CL

DRAWN BY

AB-7

SHEET NUMBER